



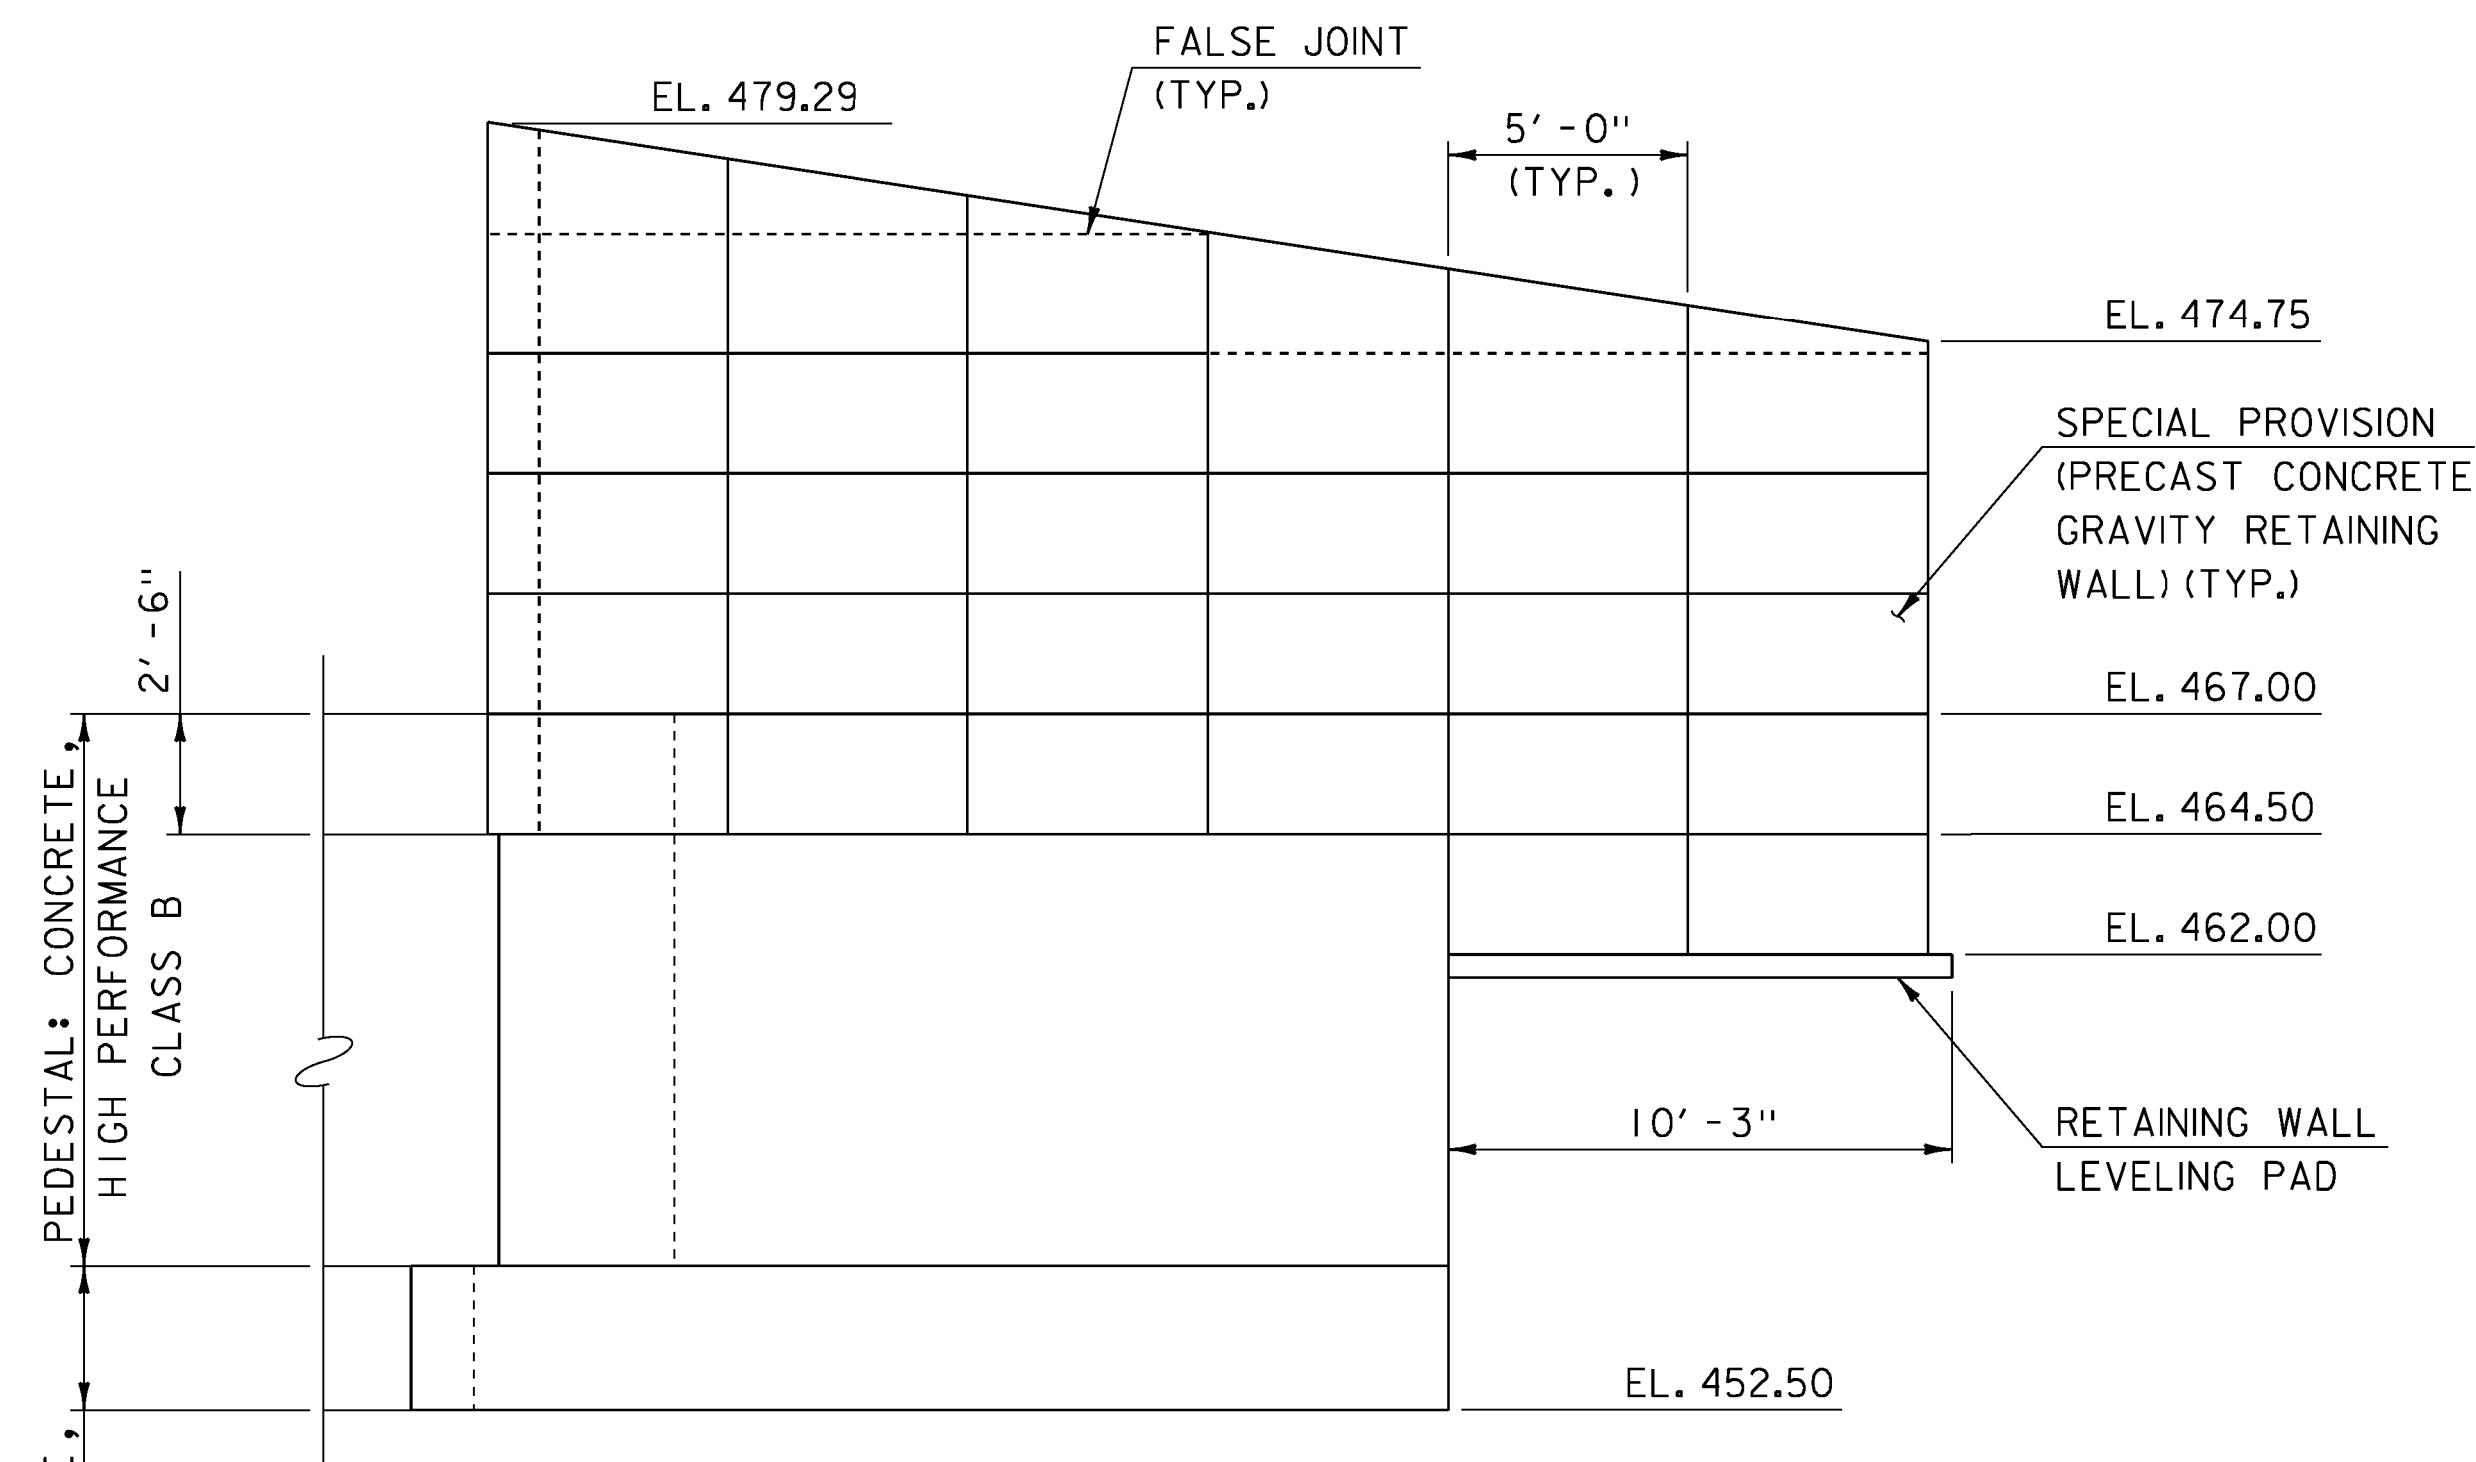


WINGWALL NO. 1 ELEVATION

SCALE: 1/4" = 1' - 0"

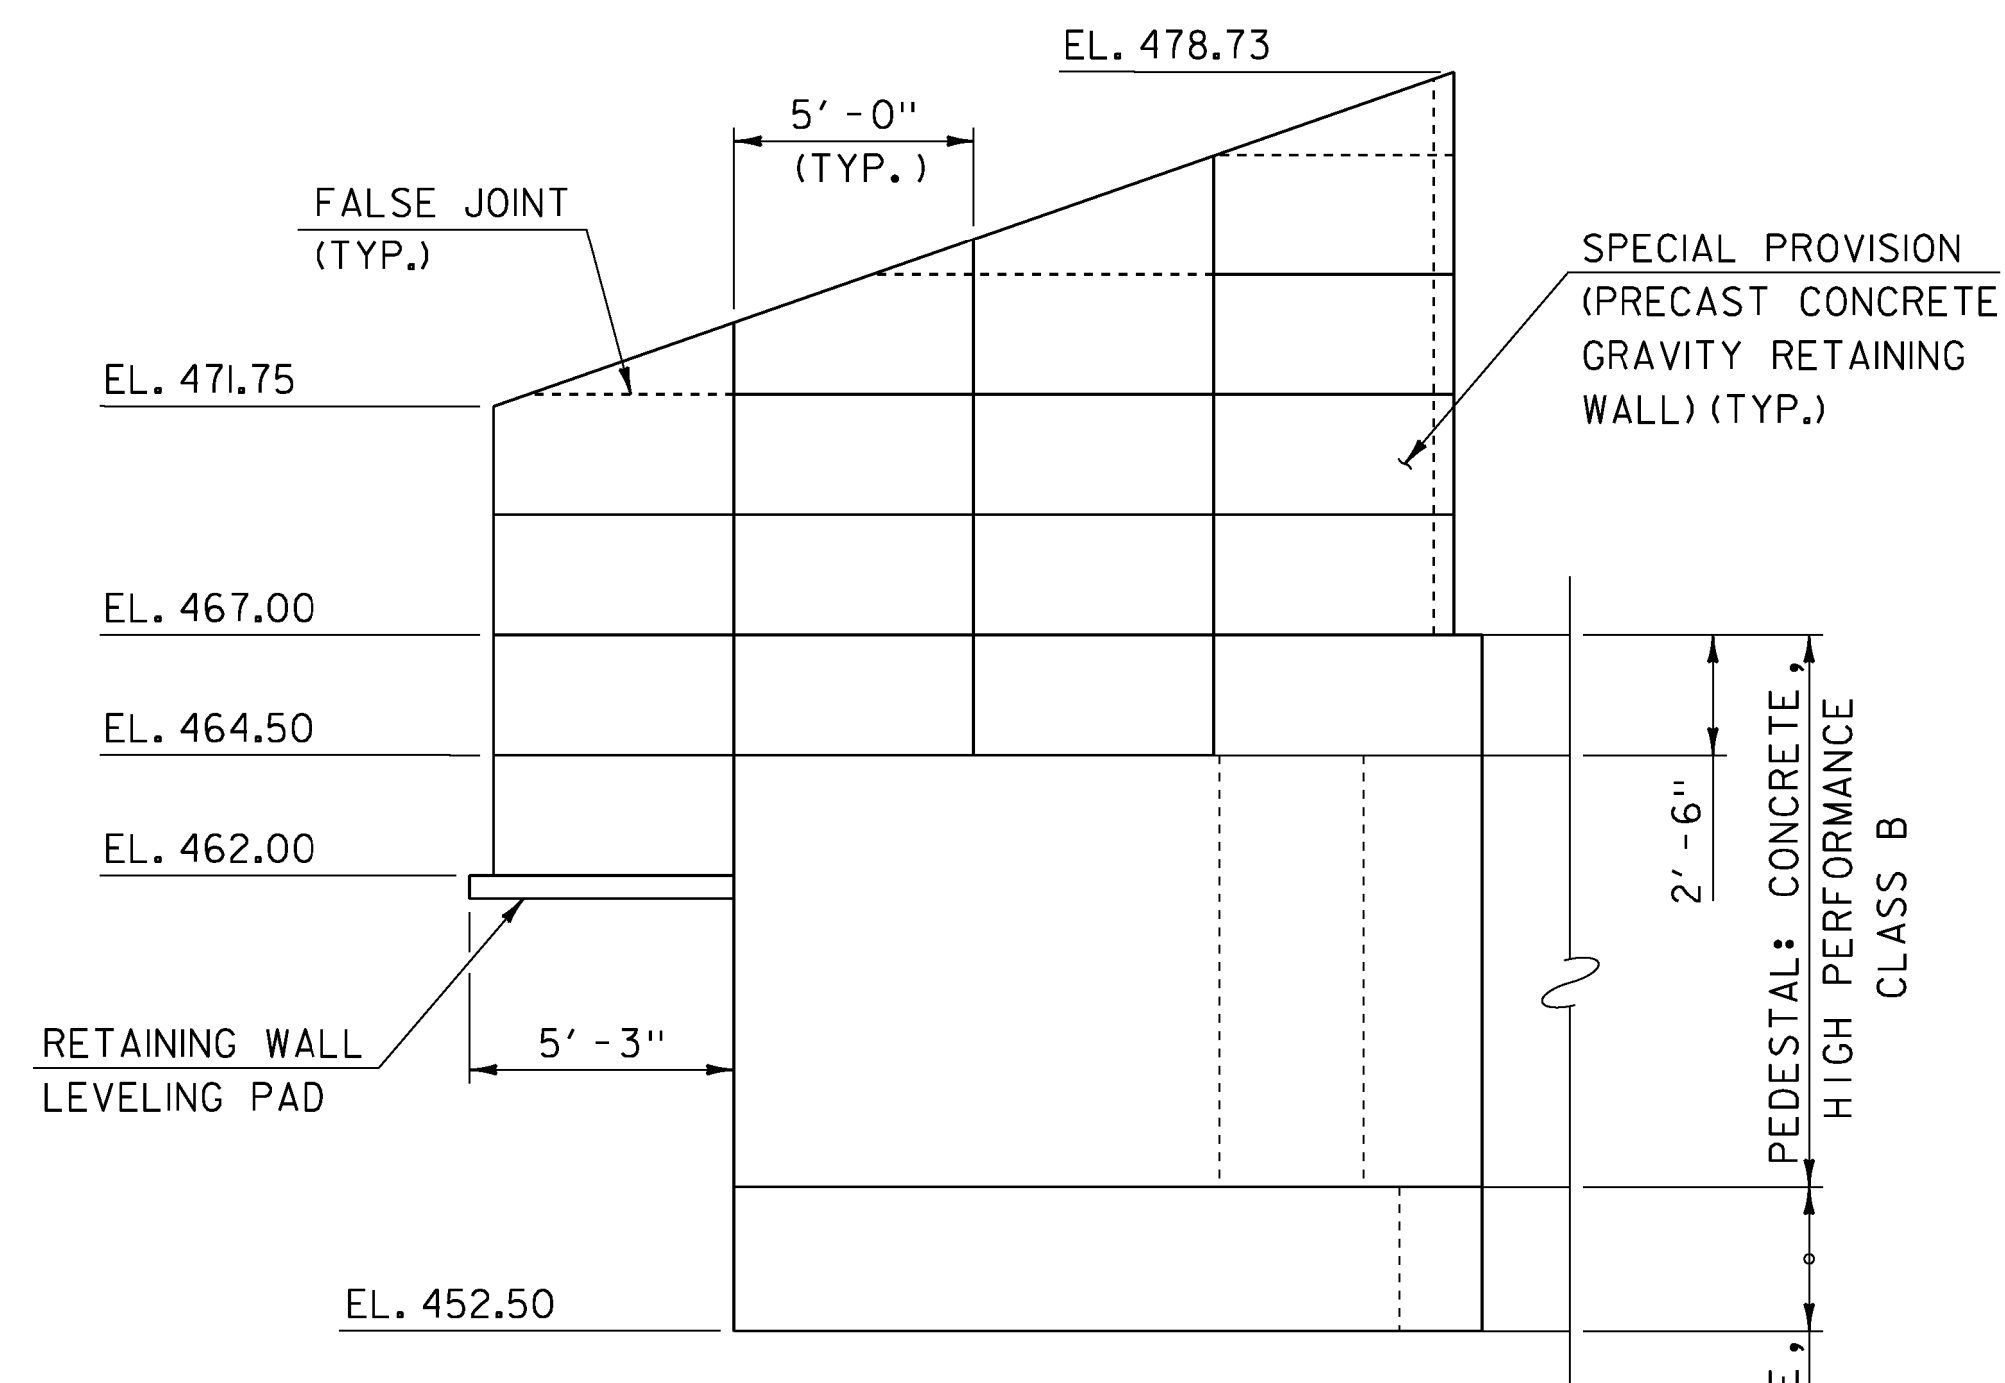


WINGWALL NO. 2 ELEVATION

SCALE: 1/4" = 1' - 0"

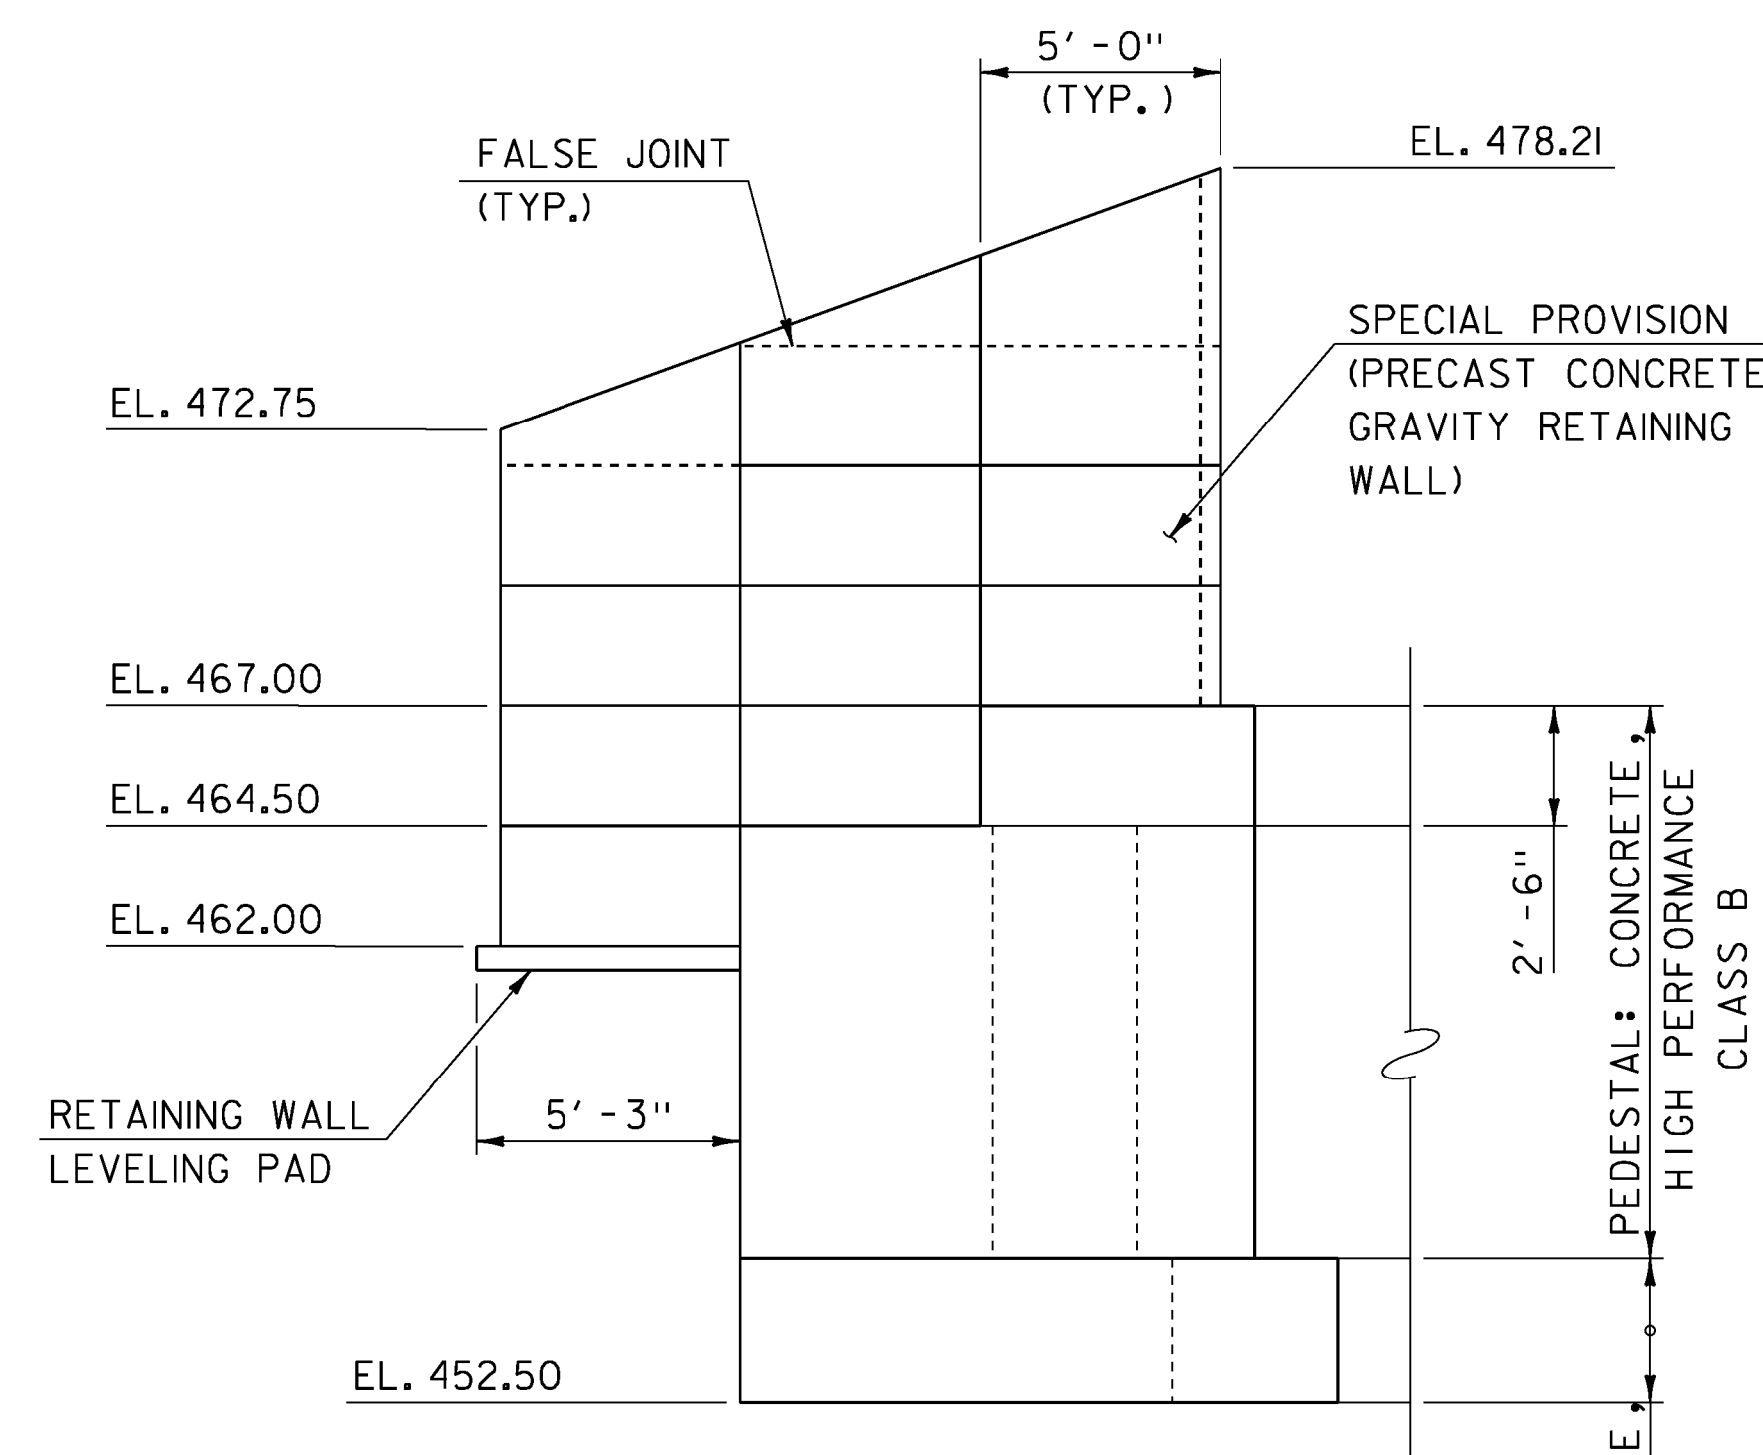

WINGWALL NO. 3 ELEVATION

SCALE: 1/4" = 1' - 0"

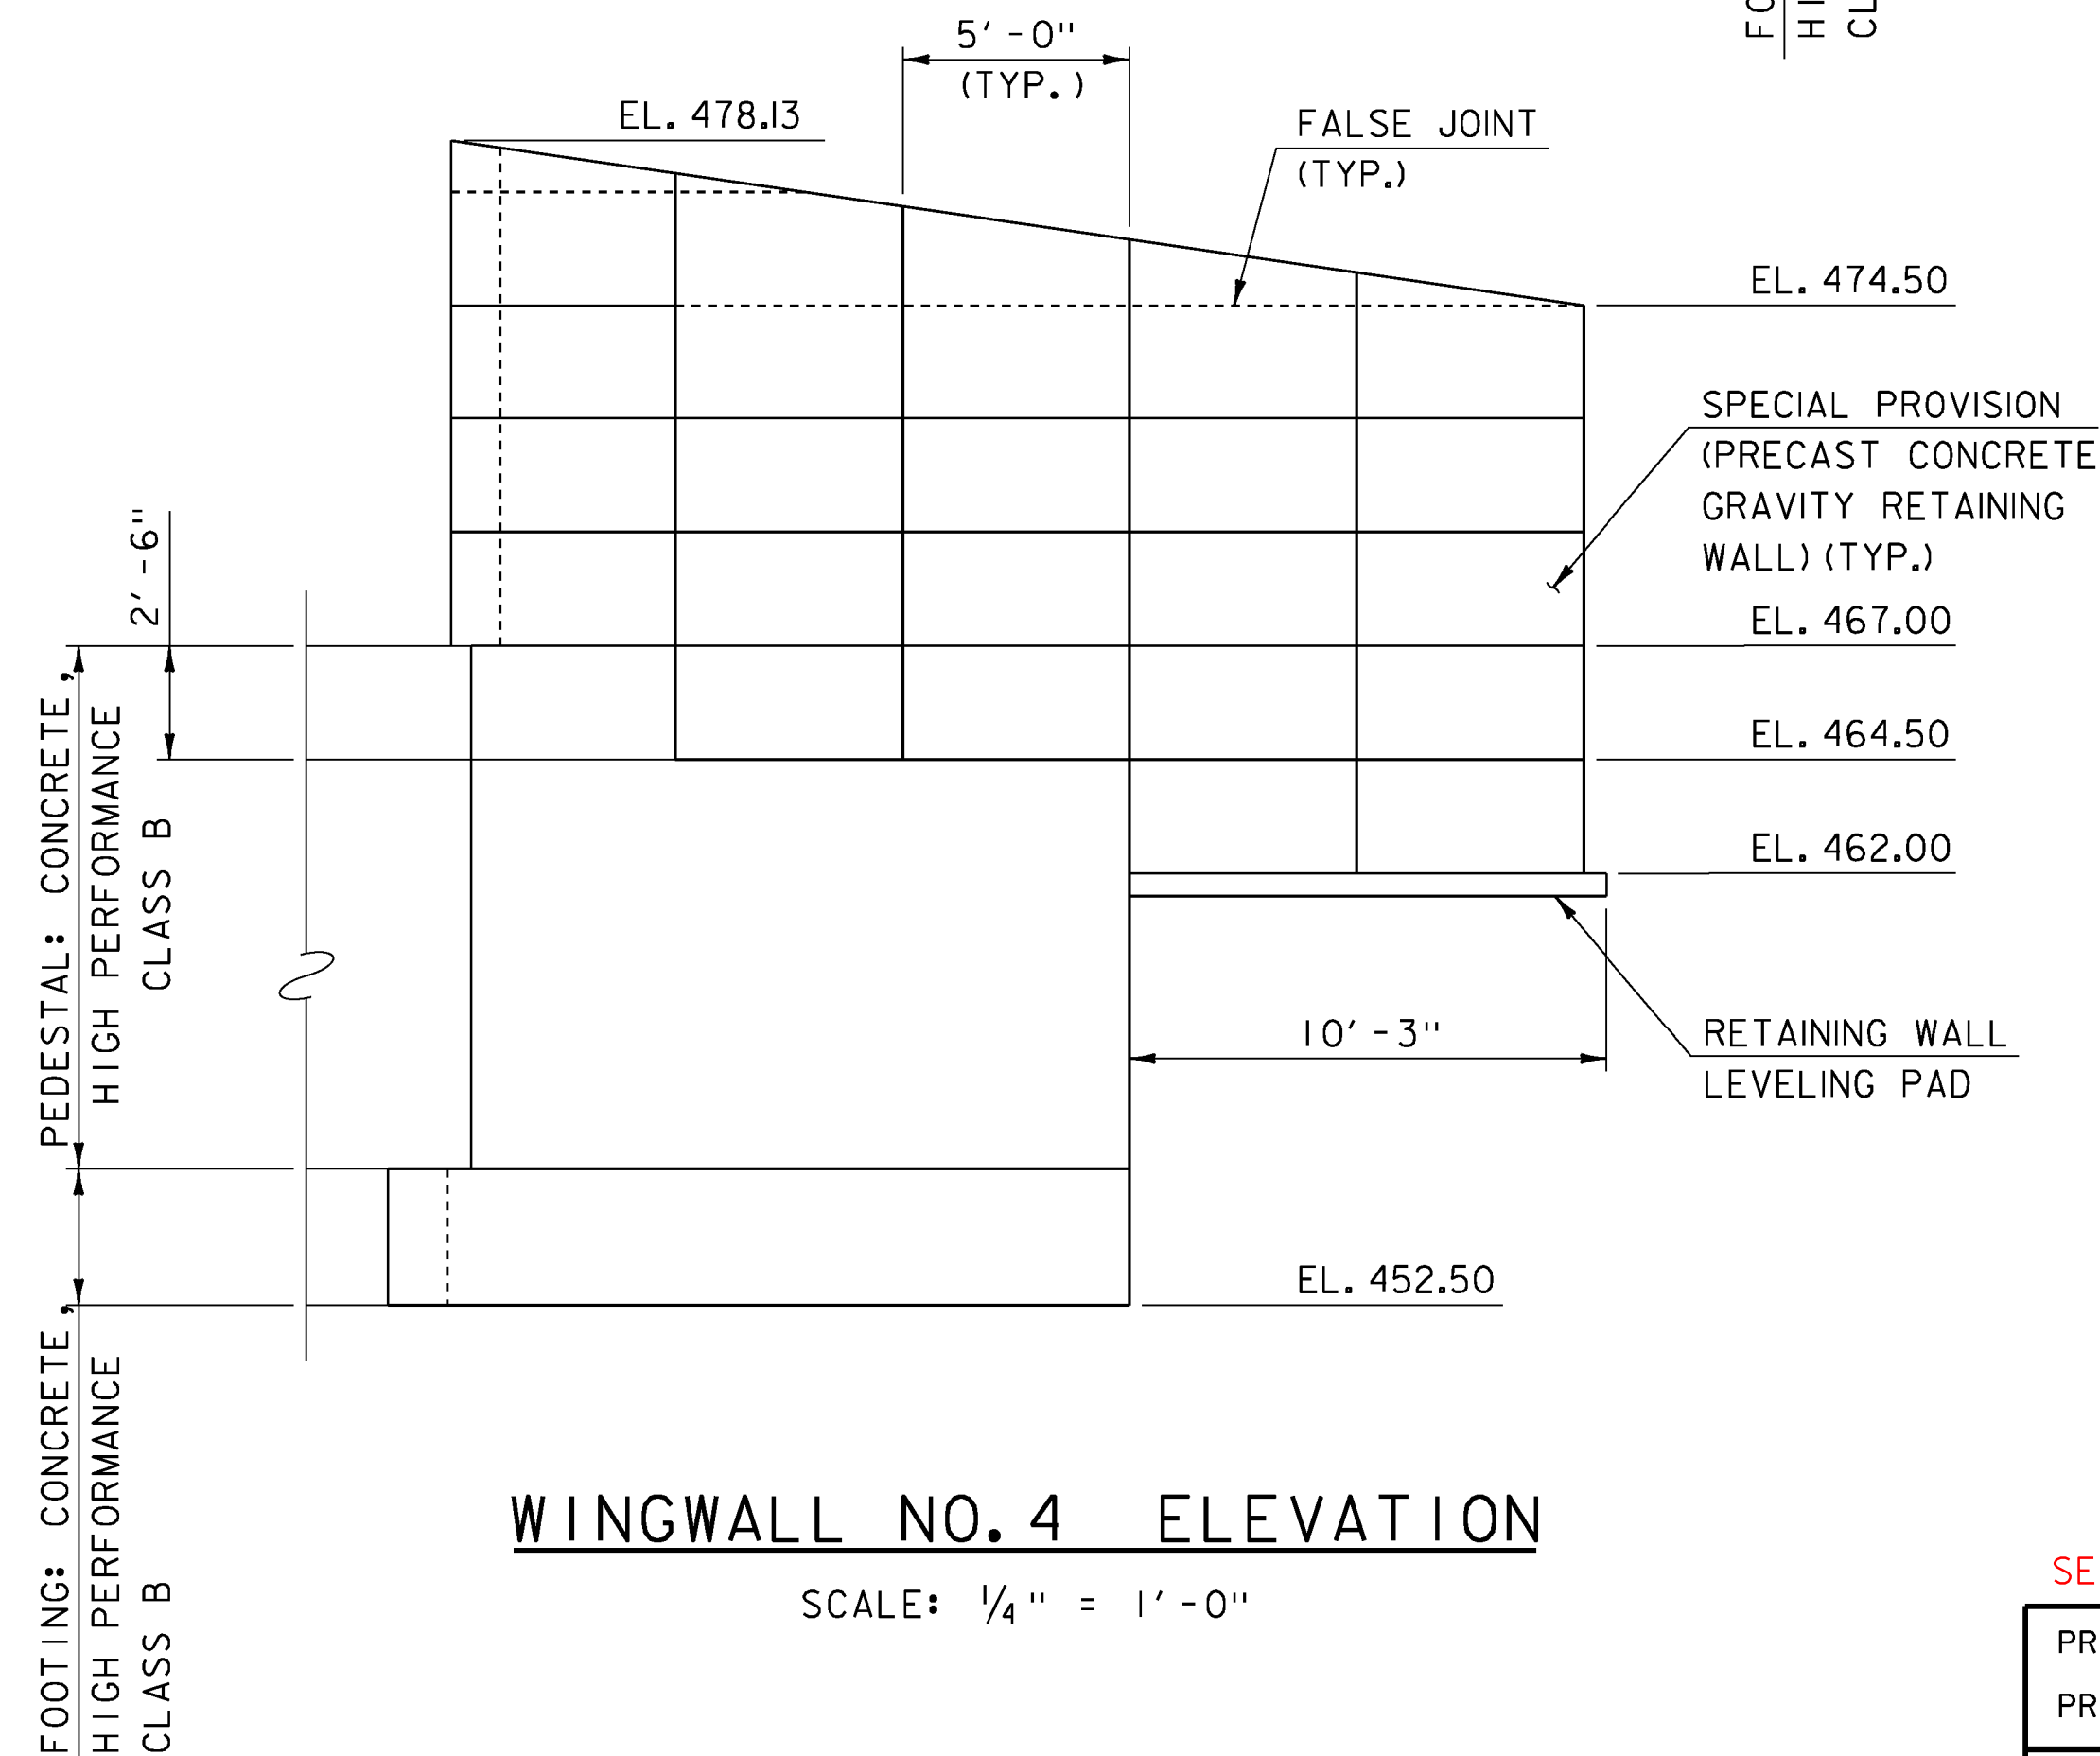

WINGWALL NO. 4 ELEVATION

SCALE: 1/4" = 1' - 0"

SEE CONTRACTOR SUBMITTAL PLAN INCLUDED.

PROJECT NAME: FAIRFIELD
PROJECT NUMBER: BRO 1448(38)

FILE NAME: z11j072sub2.dgn
PROJECT LEADER: D. LANDRY
DESIGNED BY: T. TRAVER
RETAINING WALL DETAILS

PLOT DATE: 01-NOV-2013
DRAWN BY: P. DUSTIN
CHECKED BY: T. KENDRICK
SHEET 32 OF 41

