



STATE OF VERMONT
AGENCY OF TRANSPORTATION

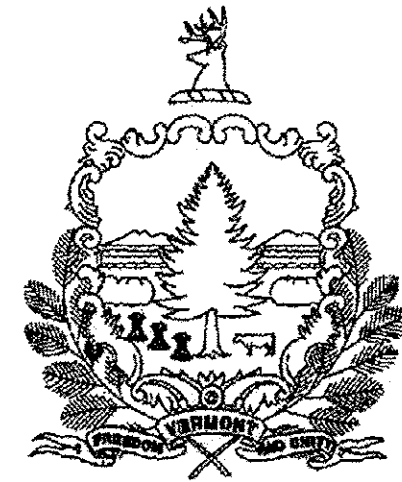

PROPOSED IMPROVEMENT
BRIDGE PROJECT
TOWN OF RICHFORD
COUNTY OF FRANKLIN

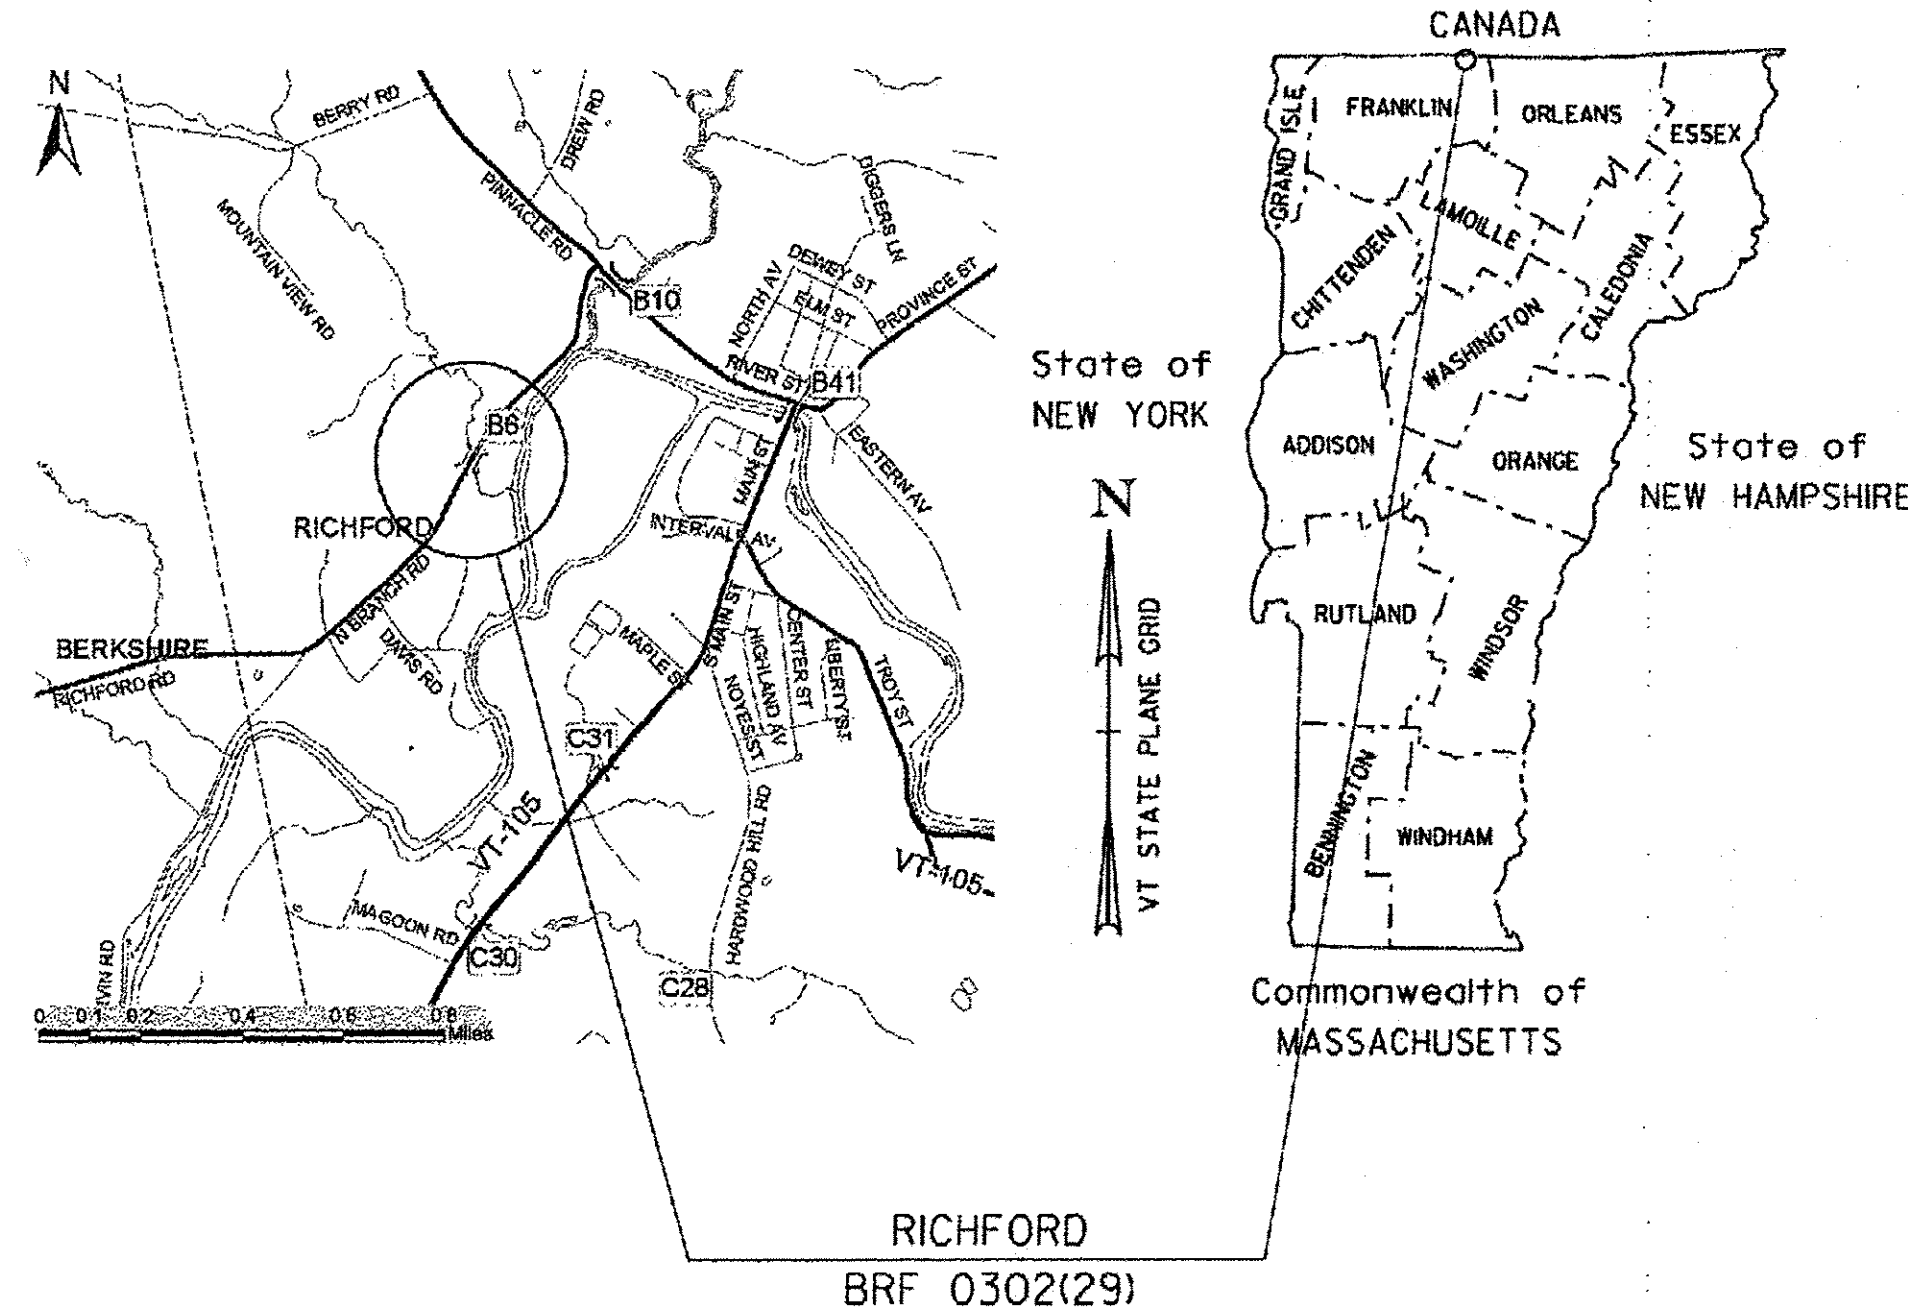

RECORD PLANS

CONTRACTOR: G. W. TATRO CONSTRUCTION - JEFFERSONVILLE, VT

RESIDENT ENGINEER: SCOTT WHEATLEY

CONSTRUCTION BEGAN: JULY 30, 2015

CONSTRUCTION COMPLETE: AUGUST 27, 2015

RECORD PLANS BY: SCOTT WHEATLEY & AARON JAMES

I HEREBY CERTIFY THAT ALL THE CONSTRUCTION REQUIRED BY THIS SET OF DRAWINGS HAS BEEN ACCOMPLISHED AS INDICATED HEREIN.

BY Scott Wheatley RESIDENT ENGINEER

DATE July 29, 2016

NOTE: Any further information concerning final quantities, amounts or other details relative to this project may be found at Central Files in the electronic archives.

ROUTE NO : TH 3 (FAS 0302)(RURAL MAJOR COLLECTOR) BRIDGE NO : 6


PROJECT LOCATION : BEGINNING AT A POINT ON TH 3, APPROXIMATELY 1.2 MILES WEST OF THE JUNCTION WITH TH 1.

PROJECT DESCRIPTION : REPLACEMENT OF THE EXISTING BRIDGE WITH A CONCRETE ARCH AND RELATED ROADWAY AND CHANNEL WORK.

LENGTH OF STRUCTURE : 28.00 FEET.


LENGTH OF ROADWAY : 147.00 FEET.

LENGTH OF PROJECT : 175.00 FEET.

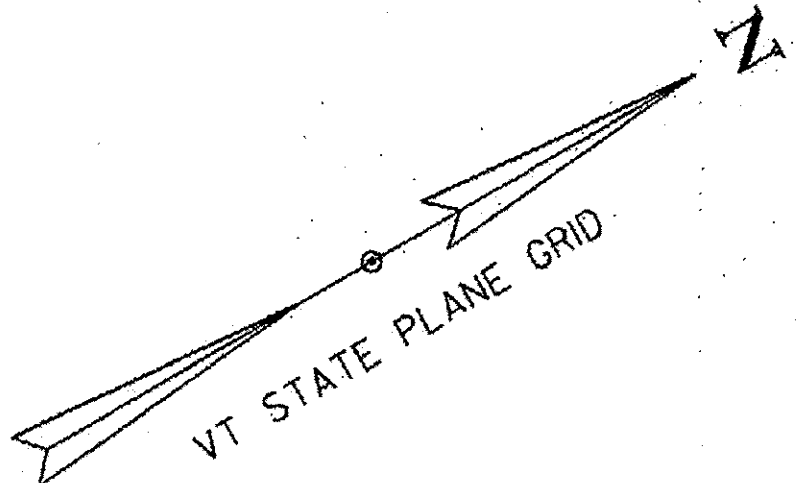

CONSTRUCTION IS TO BE CARRIED ON IN ACCORDANCE WITH THESE PLANS AND THE STANDARD SPECIFICATIONS FOR CONSTRUCTION DATED 2011, AS APPROVED BY THE FEDERAL HIGHWAY ADMINISTRATION ON JULY 20, 2011 FOR USE ON THIS PROJECT, INCLUDING ALL SUBSEQUENT REVISIONS AND SUCH REVISED SPECIFICATIONS AND SPECIAL PROVISIONS AS ARE INCORPORATED IN THESE PLANS.

QUALITY ASSURANCE PROGRAM : LEVEL 2	
SURVEYED BY :	L. ORVIS
SURVEYED DATE :	4/9/2012
DATUM	
VERTICAL	NAVD88
HORIZONTAL	NAD (83) 1996

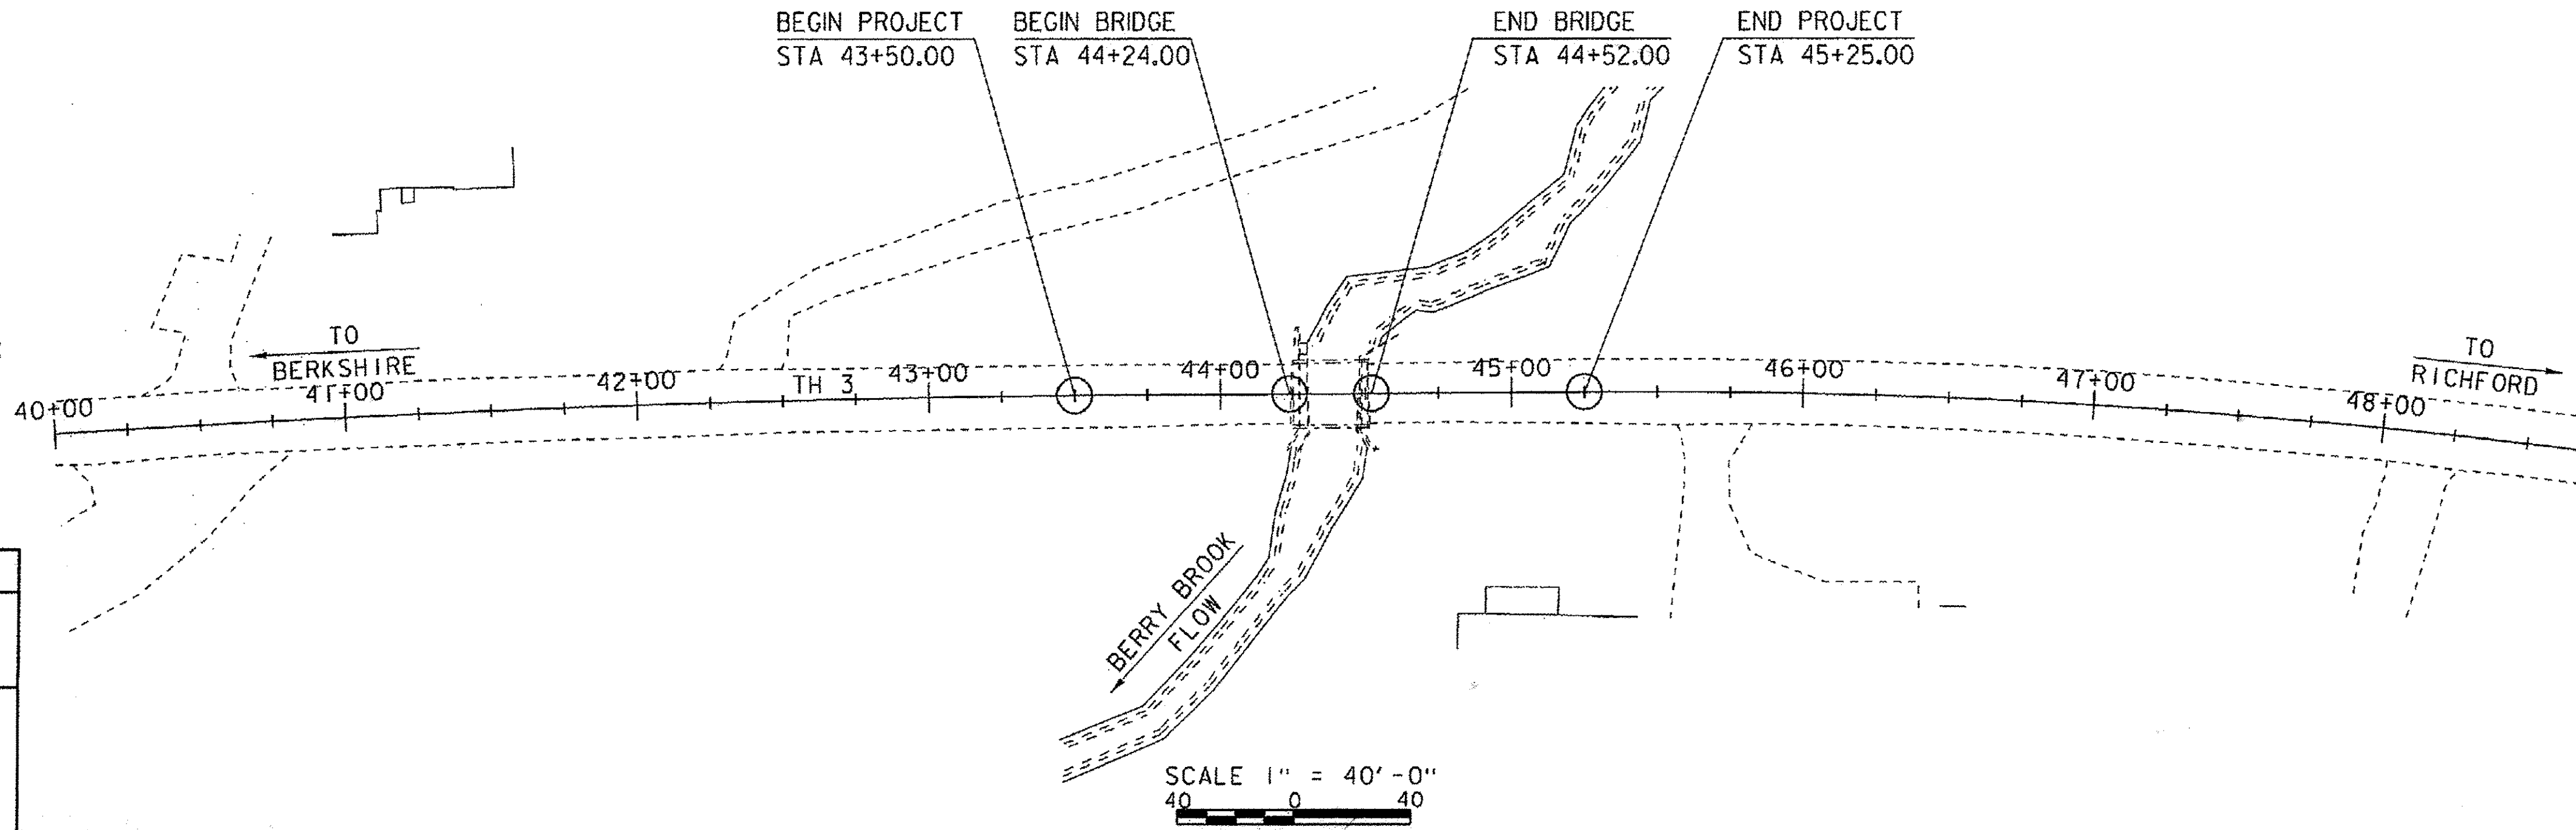

DIRECTOR OF PROJECT DELIVERY

APPROVED [Signature] DATE 12/12/2014

PROJECT MANAGER : CAROLYN CARLSON, P.E.

PROJECT NAME : RICHFORD

PROJECT NUMBER : BRF 0302 (29)

SHEET 1 OF 36 SHEETS

STATE OF VERMONT
AGENCY OF TRANSPORTATION

PRELIMINARY INFORMATION SHEET (BRIDGE)

Version

LRFD

INDEX OF SHEETS

PLAN SHEETS

1
2
3
4
5 - 6
7
8
9
10
11
12
13
14
15 - 21
22
23
24
25 - 28
29 - 30
31
32
33
34
35 - 36

TITLE
PRELIMINARY INFORMATION
TYPICAL SECTIONS
PROJECT NOTES
QUANTITY 1 & 2
BRIDGE QUANTITY
CONVENTIONAL SYMBOLOLOGY LEGEND
TIE
LAYOUT
TH 3 PROFILE AND TRANSITION DIAGRAMS
UTILITY LAYOUT
SIGNS & PAVEMENT MARKING LAYOUT
BORING INFORMATION
BORING LOGS 1 - 7
PLAN AND ELEVATION
BRIDGE LAYOUT AND WALL SECTIONS
BRIDGE ELEVATIONS
MAINLINE CROSS SECTIONS
CHANNEL CROSS SECTIONS
EPSC NARRATIVE
EPSC EXISTING CONDITIONS
EPSC DURING CONSTRUCTION
EPSC FINAL CONDITIONS
EPSC DETAILS

STANDARDS LIST

E-193
G-1
G-1D
G-19
S-360A
S-360B
S-363
T-1
T-10
T-17
T-28
T-30
T-31
T-42
T-45

PAVEMENT MARKING DETAILS
STEEL BEAM GUARDRAIL DETAILS (POST, DELINEATOR, TYPICALS)
STEEL BEAM GUARDRAIL DETAILS (END TERMINAL, ANCHOR, MEDIAN)
GENERIC GRADING PLANS FOR GUARDRAIL END TERMINALS
BRIDGE RAILING, GALVANIZED 2 RAIL BOX BEAM
GUARDRAIL APPROACH SECTION, GALVANIZED 2 RAIL BOX BEAM
THRIE BEAM TO STANDARD STEEL BEAM TRANSITION SECTION
TRAFFIC CONTROL GENERAL NOTES
CONVENTIONAL ROADS CONSTRUCTION APPROACH SIGNING
TRAFFIC CONTROL MISCELLANEOUS DETAILS
CONSTRUCTION SIGN DETAILS
CONSTRUCTION SIGN DETAILS
CONSTRUCTION SIGN DETAILS
BRIDGE NUMBER PLAQUE
SQUARE TUBE SIGN POST AND ANCHOR

08-18-1995
02-10-2014
02-10-2014
11-15-2002
04-23-2012
04-23-2012
04-23-2012
08-06-2012
08-06-2012
04-09-2014
01-02-2013

STRUCTURES DETAIL SHEETS

SD-501.00
SD-502.00

CONCRETE DETAILS AND NOTES
CONCRETE DETAILS AND NOTES

5/7/2010
5/7/2010

TRAFFIC DATA

YEAR	ADT	DHV	% D	% T	ADTT	
						20 year ESAL for flexible pavement from 2015 to 2035 : 882,000
2015	830	120	56	13.9	120	40 year ESAL for flexible pavement from 2015 to 2055 : 1,946,000
2035	880	120	56	17.5	160	Design Speed : 50 mph

FINAL HYDRAULIC REPORT

HYDROLOGIC DATA

Date: February 2014

DRAINAGE AREA : 4.7 sq. mi.
CHARACTER OF TERRAIN : Hilly, mixture of open and forested land cover
STREAM CHARACTERISTICS : Sinuous, aluvial with low banks to floodplain relief
NATURE OF STREAMBED : Mostly sand, gravel and silt with some cobbles

PEAK FLOW DATA

Q 2.33 =	250 cfs	Q 50 =	800 cfs
Q 10 =	500 cfs	Q 100 =	950 cfs
Q 25 =	650 cfs	Q 500 =	1330 cfs

DATE OF FLOOD OF RECORD: Unknown
ESTIMATED DISCHARGE: Unknown
WATER SURFACE ELEV.: Unknown
NATURAL STREAM VELOCITY: @ Q50 = 8.0 fps
ICE CONDITIONS : Light to moderate
DEBRIS: Light to moderate
DOES THE STREAM REACH MAXIMUM HIGHWATER ELEV. RAPIDLY? No
IS ORDINARY RISE RAPID? No
IS STAGE AFFECTED BY UPSTREAM OR DOWNSTREAM CONDITIONS? Yes
IF YES, DESCRIBE: Flood flows on the Missisquoi River may back up through this site.
That was not considered in this final hydraulics. Water elevations may be higher than shown.

WATERSHED STORAGE: < 1%
HEADWATERS: UNIFORM: X
IMMEDIATELY ABOVE SITE:

EXISTING STRUCTURE INFORMATION
STRUCTURE TYPE: Single span concrete T-beam bridge
YEAR BUILT: 1900
CLEAR SPAN(NORMAL TO STREAM): 21'
VERTICAL CLEARANCE ABOVE STREAMBED: 5'
WATERWAY OF FULL OPENING: 125 sq. ft.
DISPOSITION OF STRUCTURE: Remove and replace with new structure
TYPE OF MATERIAL UNDER SUBSTRUCTURE: See boring logs

WATER SURFACE ELEVATIONS AT:

Q2.33 =	429.9'	VELOCITY =	5.9 fps
Q10 =	431.3'	"	7.5 fps
Q25 =	431.9'	"	7.6 fps
Q50 =	433.4'	"	8.0 fps
Q100 =	433.9'	"	9.1 fps

LONG TERM STREAMBED CHANGES: Scour through bridge area.

IS THE ROADWAY OVERTOPPED BELOW Q100: No
FREQUENCY: Above Q100
RELIEF ELEVATION: 436.2'
DISCHARGE OVER ROAD @Q100: 0 cfs

UPSTREAM STRUCTURE
TOWN: Richford
DISTANCE: 4,500'
HIGHWAY #: TH 8
STRUCTURE #: 26
CLEAR SPAN: Not available
CLEAR HEIGHT: NA
YEAR BUILT: Not available
FULL WATERWAY: NA
STRUCTURE TYPE: Not available

DOWNSTREAM STRUCTURE
TOWN: Richford
DISTANCE: 800'
HIGHWAY #: Confluence Missisquoi River
STRUCTURE #:
CLEAR SPAN:
CLEAR HEIGHT:
YEAR BUILT:
FULL WATERWAY:
STRUCTURE TYPE:

LRFR LOAD RATING FACTORS

LOADING LEVELS	TRUCK						
	H-20	HL-93	3S2	6 AXLE	3A. STR.	4A. STR.	5A. SEM
TONNAGE	20	36	36	66	30	34.5	38
INVENTORY							
POSTING							
OPERATING							
COMMENTS:							

PROPOSED STRUCTURE

STRUCTURE TYPE: Single span precast concrete structure

CLEAR SPAN(NORMAL TO STREAM): 26'
VERTICAL CLEARANCE ABOVE STREAMBED: 6'
WATERWAY OF FULL OPENING: 175 sq. ft.

WATER SURFACE ELEVATIONS AT:

Q2.33 =	429.8'	VELOCITY=	5.9 fps
Q10 =	431.0'	"	7.5 fps
Q25 =	431.4'	"	7.6 fps
Q50 =	431.7'	"	8.0 fps
Q100 =	431.9'	"	8.4 fps

IS THE ROADWAY OVERTOPPED BELOW Q100: No
FREQUENCY: Above Q100
RELIEF ELEVATION: 436.6'
DISCHARGE OVER ROAD @Q100: 0 cfs

AVERAGE LOW ELEVATION OF SUPERSTRUCTURE: 433.6'
VERTICAL CLEARANCE: @ Q50 = 1.9'

SCOUR: Contraction scour = 3' at Q100 and 4' at Q200.

REQUIRED CHANNEL PROTECTION: Stone Fill, Type II

PERMIT INFORMATION
AVERAGE DAILY FLOW: 10 cfs
ORDINARY LOW WATER: 5 cfs
ORDINARY HIGH WATER: 110 cfs
DEPTH OR ELEVATION: Depth = 0.5'
Depth = 2.0'

TEMPORARY BRIDGE REQUIREMENTS
STRUCTURE TYPE: No temporary bridge required.
CLEAR SPAN (NORMAL TO STREAM):
VERTICAL CLEARANCE ABOVE STREAMBED:
WATERWAY AREA OF FULL OPENING:



ADDITIONAL INFORMATION

TRAFFIC MAINTENANCE NOTES
1. MAINTAIN TRAFFIC ON AN OFF SITE DETOUR.
2. TRAFFIC SIGNALS ARE NOT NECESSARY.
3. SIDEWALKS ARE NOT NECESSARY




DESIGN VALUES

1. DESIGN LIVE LOAD	HL-93
2. FUTURE PAVEMENT	dp: 0.0 INCH
3. DESIGN SPAN	L: 26.00 FT
4. MIN. MID-SPAN POS. CAMBER @ RELEASE (PRESTRESSED UNITS)	Δ: ---
5. PRESTRESSING STRAND	fy: ---
6. PRESTRESSED CONCRETE STRENGTH	f'c: ---
7. PRESTRESSED CONCRETE RELEASE STRENGTH	f'ci: ---
8. CONCRETE, HIGH PERFORMANCE CLASS AA	f'c: ---
9. CONCRETE, HIGH PERFORMANCE CLASS A	f'c: ---
10. CONCRETE, HIGH PERFORMANCE CLASS B	f'c: ---
11. CONCRETE, CLASS C	f'c: 3.0 KSI
12. REINFORCING STEEL	fy: 60 KSI
13. STRUCTURAL STEEL AASHTO M270	fy: ---
SEE PROJECT NOTES SHEET FOR INFORMATION -- 0.14 KCF	
14. NOMINAL BEARING RESISTANCE OF SOIL	qn: ---
15. SOIL BEARING RESISTANCE FACTOR (REFER TO AASHTO LRFD)	φ: 0.45
16. NOMINAL BEARING RESISTANCE OF ROCK	qn: ---
17. ROCK BEARING RESISTANCE FACTOR (REFER TO AASHTO LRFD)	φ: ---
18. PILE RESISTANCE FACTOR	φ: ---
19. LATERAL PILE DEFLECTION	Δ: ---
20. BASIC WIND SPEED	V3s: ---
21. MINIMUM GROUND SNOW LOAD	pg: ---
22. SEISMIC DATA	PGA: 0 Ss: --- S1: ---
23.	---
24.	---
25.	---
26.	---

PROJECT NAME: RICHFORD
PROJECT NUMBER: BRF 0302(29)
FILE NAME: s12j158pi.xls
PROJECT LEADER: C. CARLSON
DESIGNED BY: H. SALLS
PLOT DATE: 1/6/2015
DRAWN BY: R. PELLETT
CHECKED BY: H. SALLS
PRELIMINARY INFORMATION
SHEET 2 OF 36

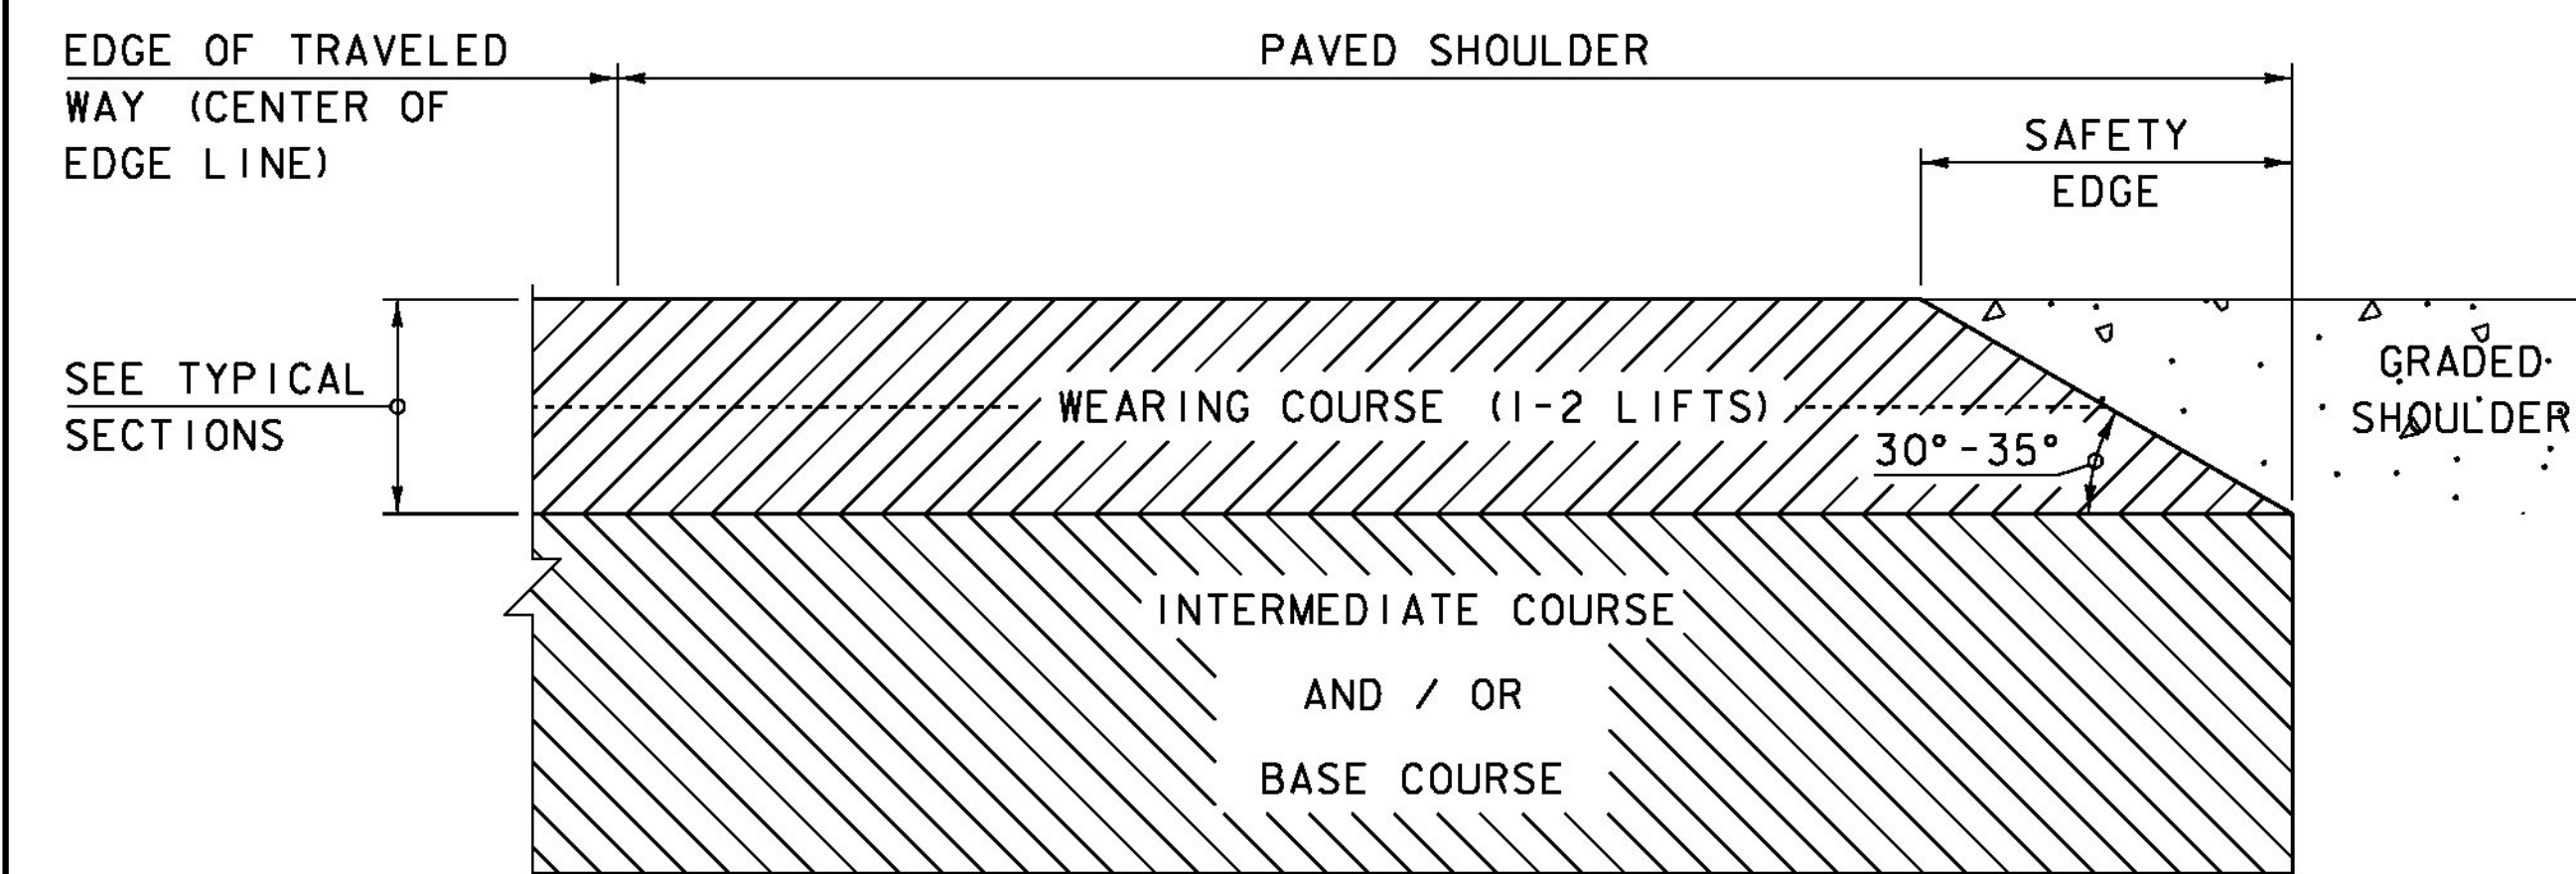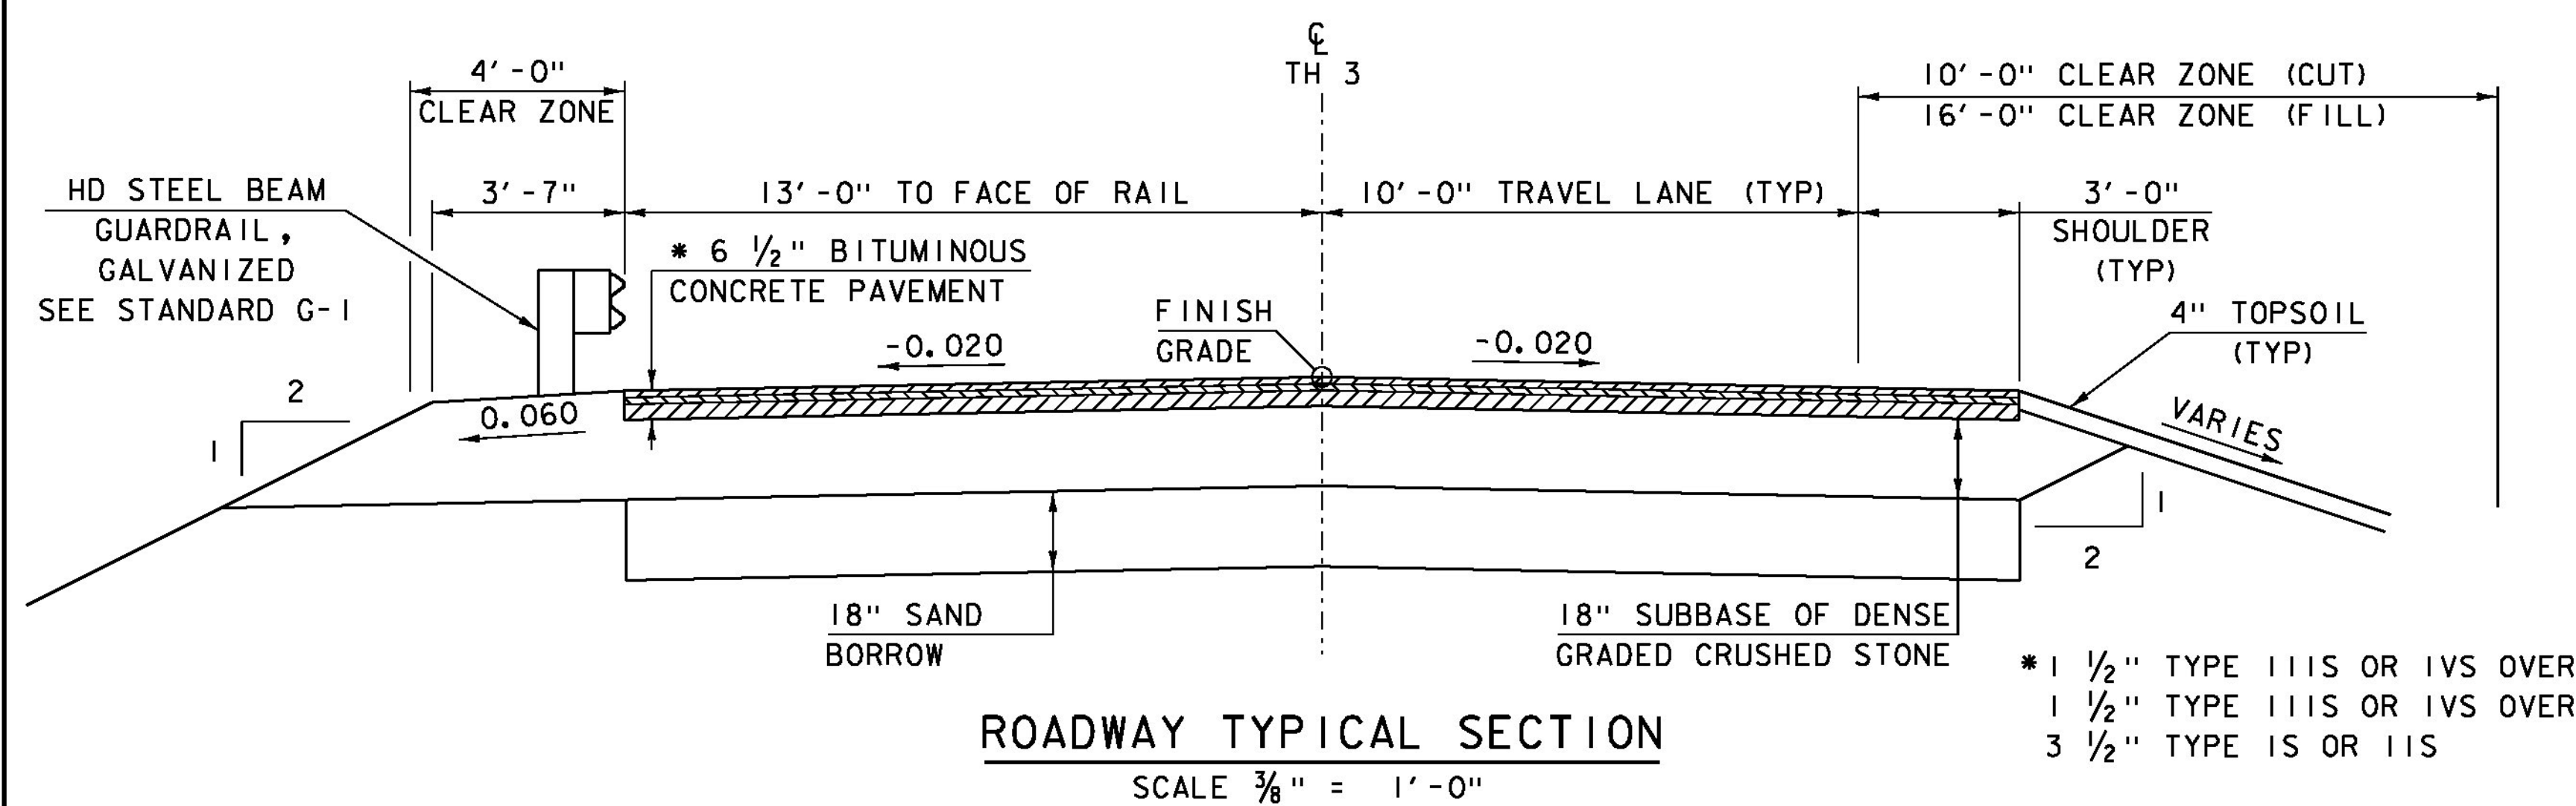

1. THE EDGE OF PAVEMENT SHALL BE FORMED IN SUCH A WAY THAT THE BITUMINOUS CONCRETE PAVEMENT IS EXTRUDED OR COMPRESSED TO FORM THE 30 TO 35 DEGREE ANGLE. DEVICES THAT SIMPLY STRIKE-OFF THE MIX WITHOUT PROVIDING ANY COMPACTIVE EFFORT WILL NOT BE ALLOWED.
2. THE PAVED SHOULDER EXTENDS FROM THE EDGE OF TRAVELED WAY TO THE EDGE OF THE WEARING COURSE, INCLUDING THE "SAFETY EDGE".

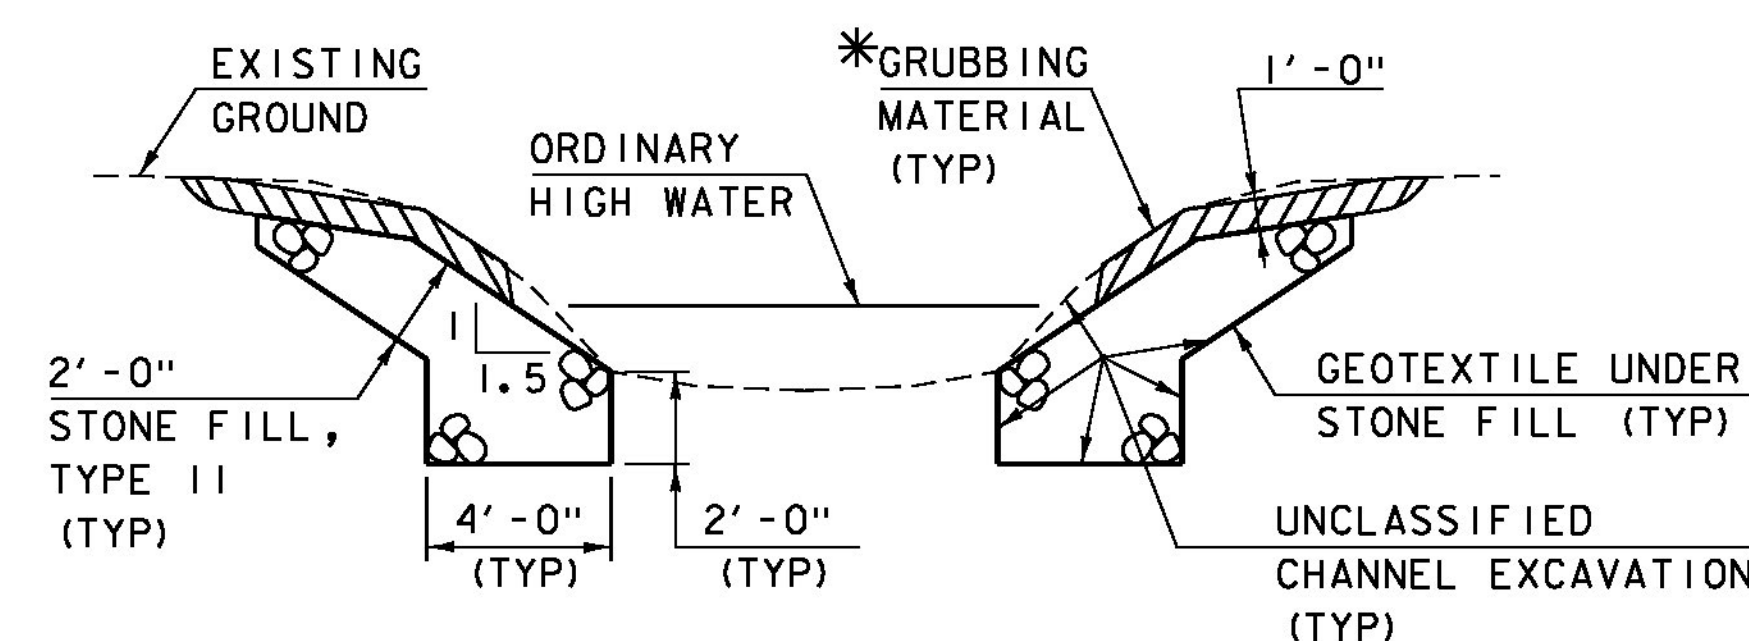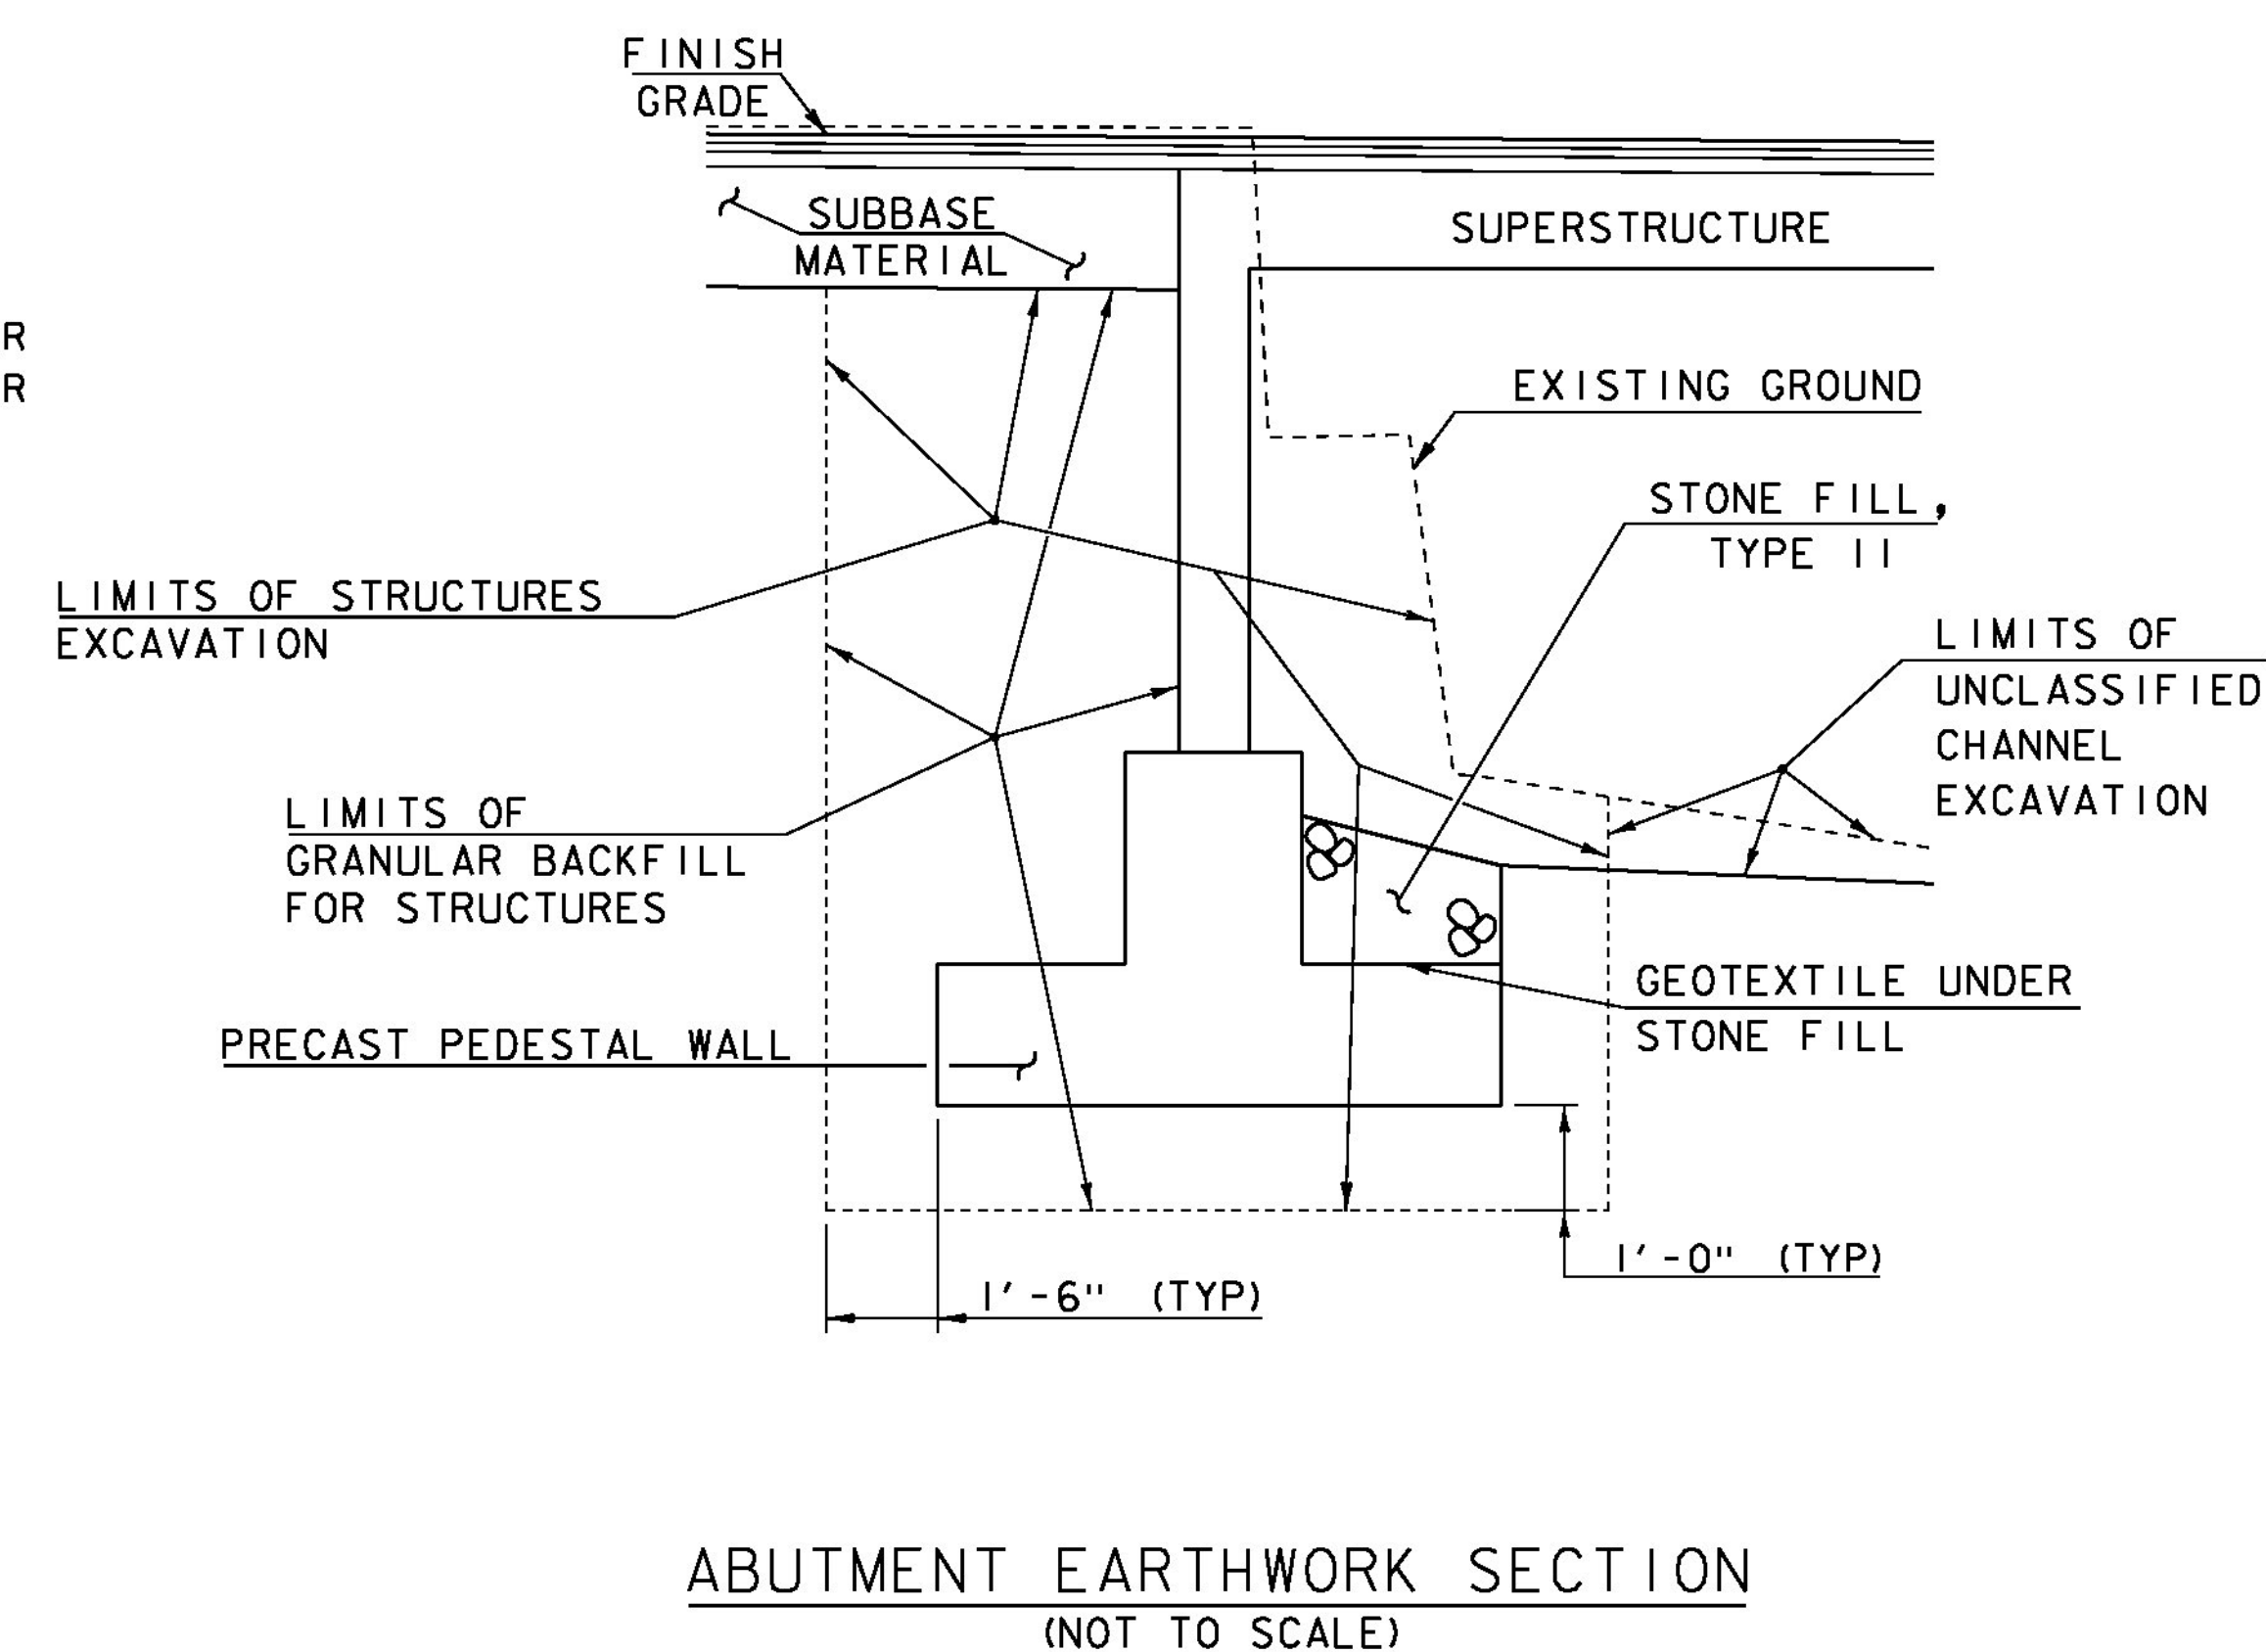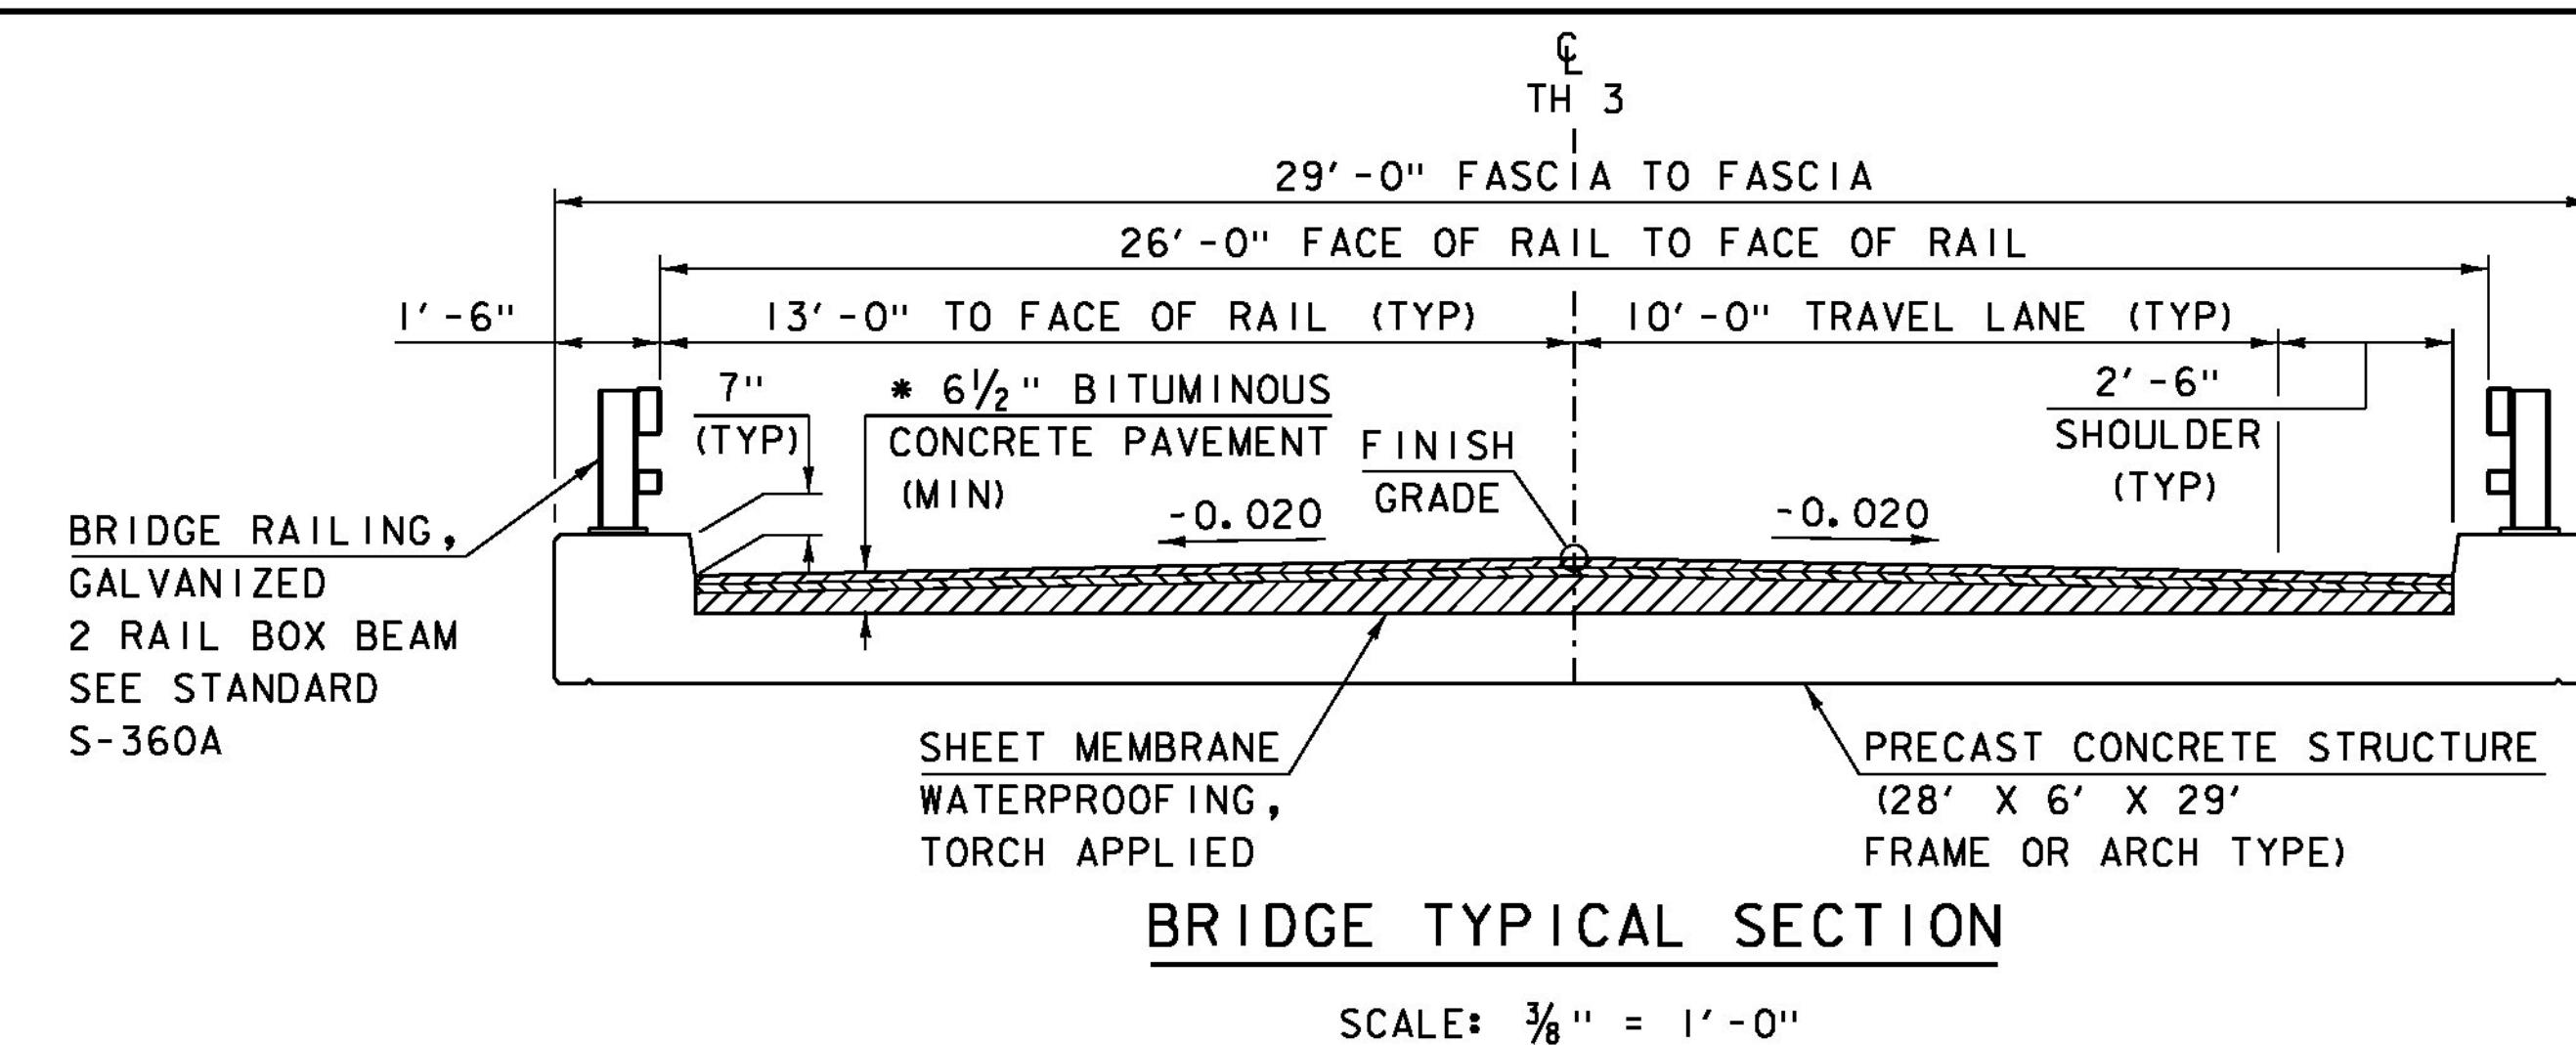

*WHENEVER CHANNEL SLOPE INTERSECTS ROADWAY SUBBASE, GRUBBING MATERIAL SHALL BEGIN AT THE BOTTOM OF SUBBASE.

MATERIAL TOLERANCES (IF USED ON PROJECT)	
SURFACE	
- PAVEMENT (TOTAL THICKNESS)	+/- 1/4"
- AGGREGATE SURFACE COURSE	+/- 1/2"
SUBBASE	+/- 1"
SAND BORROW	+/- 1"

PROJECT NAME:	RICHFORD
PROJECT NUMBER:	BRF 0302(29)
FILE NAME:	sl2j158+yp.dgn
PROJECT LEADER:	C. CARLSON
DESIGNED BY:	H. SALLS
TYPICAL SECTIONS	
PLOT DATE:	11-DEC-2014
DRAWN BY:	R. PELLETT
CHECKED BY:	H. SALLS
SHEET	3 OF 36

GENERAL

1. THE CONTRACTOR WILL BE ALLOWED TO CLOSE THE ROAD TO TRAFFIC FOR INSTALLATION OF THE NEW STRUCTURE. SEE THE SPECIAL PROVISIONS FOR ADDITIONAL INFORMATION AND REQUIREMENTS.
2. ALL MATERIALS AND CONSTRUCTION SHALL CONFORM TO THE STATE OF VERMONT AGENCY OF TRANSPORTATION STANDARD SPECIFICATIONS FOR CONSTRUCTION DATED 2011, AND ITS LATEST REVISIONS, THE AASHTO LRFD BRIDGE DESIGN SPECIFICATIONS 2012, AND ITS LATEST REVISIONS, AND THE VTRANS STRUCTURES DESIGN MANUAL.
3. ALL PRECAST CONCRETE COMPONENTS INCLUDING THE FOOTINGS, PEDESTAL WALLS, RIGID FRAME OR ARCH, HEADWALLS, WINGWALLS AND ALL CONNECTIONS BETWEEN THESE COMPONENTS SHALL BE DESIGNED BY THE PRECAST FABRICATOR. THE DESIGN CRITERIA USED FOR THIS PROJECT IS INDICATED BELOW.
4. DESIGN CRITERIA:
- | | |
|--|----------------------------------|
| DESIGN LIVE LOAD:
FILL OVER THE STRUCTURE: | HL - 93
6 INCHES MINIMUM |
| FOUNDATION SOIL PARAMETERS
UNIT WEIGHT:
FRICTION ANGLE: | 125 PCF
36 DEGREES |
| COEFFICIENT OF FRICTION
FORMED CONCRETE AGAINST SOIL: | 0.35 |
| RETAINED SOIL PARAMETERS
UNIT WEIGHT:
FRICTION ANGLE: | 140 PCF
35 DEGREES |
| COEFFICIENT OF FRICTION
CONCRETE CAST AGAINST SOIL:
FORMED AGAINST SOIL: | 0.55
0.45 |
| NOMINAL BEARING RESISTANCE: | 10 KSF FOR FOOTING WIDTHS > 6 FT |
5. ALL DIMENSIONS SHOWN IN THE PLANS ARE HORIZONTAL OR VERTICAL AND ARE GIVEN AT 68 DEGREES FAHRENHEIT, UNLESS NOTED OTHERWISE.
6. ITEM 529.15 "REMOVAL OF STRUCTURE" SHALL INCLUDE THE REMOVAL OF THE EXISTING SUPERSTRUCTURE AND ANY PORTION OF THE EXISTING ABUTMENTS NOT REMOVED UNDER STRUCTURE EXCAVATION OR UNCLASSIFIED CHANNEL EXCAVATION.
7. THE DESIGN SHALL INCLUDE THE EFFECTS OF ALL LOADS, INCLUDING BUT NOT LIMITED TO LIVE LOAD, EARTH SURCHARGE AND HYDROSTATIC PRESSURE.
8. THE FABRICATOR SHALL BE RESPONSIBLE FOR SUPPLYING THE STATE WITH THE LRFR LOAD RATING FACTORS TO COMPLETE THE CHART SHOWN ON THE PRELIMINARY INFORMATION SHEET.

CONCRETE AND REINFORCING STEEL

9. THE RIGID FRAME OR ARCH, HEADWALLS AND WINGWALLS SHALL BE PRECAST CONCRETE CONFORMING TO SECTION 540 AND WILL BE PAID FOR UNDER THE APPROPRIATE 540 CONTRACT ITEM.
10. ALL ELEMENTS OF THE PRECAST STRUCTURE(S) SHALL BE DESIGNED BY THE PRECAST SUPPLIER, INCLUDING THE ANCHORAGE AND CONNECTIONS BETWEEN ELEMENTS. ALL ELEMENTS SHALL BE INSTALLED IN ACCORDANCE WITH THE FABRICATOR'S RECOMMENDATIONS. THE CONTRACTOR SHALL SUBMIT FABRICATION DRAWINGS FOR THE PRECAST RIGID FRAME OR ARCH IN ACCORDANCE WITH SECTION 105. IN ADDITION TO FABRICATION DRAWINGS, THE FABRICATOR SHALL PROVIDE A LOAD RATING AND SUPPORTING CALCULATIONS IN ACCORDANCE WITH THE AASHTO SPECIFICATIONS REFERENCED IN GENERAL NOTE 1 AND THE VTRANS STRUCTURES DESIGN MANUAL, 2010. THE RATING AND SUPPORTING CALCULATIONS SHALL BE SIGNED, STAMPED AND DATED BY A PROFESSIONAL ENGINEER LICENSED TO PRACTICE ENGINEERING IN THE STATE OF VERMONT. NOTE THAT THE FABRICATOR ASSUMES ALL LIABILITY FOR THE ADEQUACY AND ACCURACY OF THE RIGID FRAME OR ARCH DESIGN AND LOAD RATING.
11. WATER REPELLENT, SILANE SHALL BE FURNISHED IN ACCORDANCE WITH SECTION 514 AND SHALL BE SHOP APPLIED TO ALL EXPOSED CONCRETE SURFACES, EXCEPT THE UNDERSIDE OF THE STRUCTURE BETWEEN THE DRIP NOTCHES. ALL WORK IS INCIDENTAL TO THE APPROPRIATE 540 CONTRACT ITEM.

12. ALL EXPOSED EDGES OF CONCRETE SHALL BE CHAMFERED 1" x 1".
13. REINFORCING STEEL PLACEMENT TOLERANCES SHALL BE:
SPACING: +/- 1 INCH
CLEARANCE: +/- 1/4 INCH
14. PRECAST TOLERANCES:
HEIGHT/WIDTH: +/- 1/4 INCH
LENGTH: +/- 1/2 INCH
15. ALL REINFORCING STEEL IN THE PRECAST PEDESTAL WALLS AND FOOTINGS SHALL MEET THE REQUIREMENTS OF SECTION 507 FOR LEVEL I REINFORCING.
16. ALL REINFORCING STEEL IN THE PRECAST RIGID FRAME OR ARCH, WINGWALLS AND HEADWALLS SHALL MEET THE REQUIREMENTS OF SECTION 507 FOR LEVEL II REINFORCING.
17. PAYMENT FOR REINFORCING STEEL WILL BE INCLUDED IN THE UNIT BID PRICE FOR THE APPROPRIATE SECTION 540 CONTRACT ITEM.
18. THE PROPOSED STRUCTURE SHALL BE A THREE-SIDED RIGID FRAME OR ARCH WITH A MINIMUM CLEAR SPAN OF 26'. THE LUMP SUM COST FOR ITEM 540.10 "PRECAST CONCRETE STRUCTURE (28'-0" x 6'-0" x 29'-0" FRAME OR ARCH TYPE) SHALL INCLUDE THE PRECAST RIGID FRAME OR ARCH AND MECHANICAL CONNECTIONS.
19. THE PRECAST STRUCTURE DETAILS ARE SHOWN FOR REFERENCE ONLY. THE ACTUAL DIMENSIONS AND CONFIGURATION WILL BE DEPENDENT ON THE FABRICATOR. THE INSIDE CLEAR DIMENSION SHALL BE 26' - 0" AND THE RISE SHALL BE 6' - 0".
20. NO HOLES SHALL BE DRILLED IN THE RIGID FRAME OR ARCH WITHOUT THE APPROVAL OF THE FABRICATOR AND VTRANS.
21. THE USE OF EQUIPMENT AND THE METHOD OF BACKFILLING AROUND THE BURIED STRUCTURE SHALL BE IN ACCORDANCE WITH THE MANUFACTURER'S RECOMMENDATION. CARE SHALL BE TAKEN WHEN BACKFILLING AGAINST JOINT SEALING MATERIALS.
22. JOINTS BETWEEN ALL ABUTTING PRECAST UNITS SHALL BE WATERTIGHT AND MECHANICALLY CONNECTED.

TRAFFIC CONTROL

23. THE CONTRACTOR SHALL BE RESPONSIBLE FOR THE DESIGN AND INSTALLATION OF A SITE SPECIFIC TRAFFIC CONTROL PLAN FOR ALL STAGES OF CONSTRUCTION. THE CONTRACTOR SHALL SUBMIT DETAILED TRAFFIC CONTROL PLANS TO THE RESIDENT ENGINEER FOR APPROVAL PER SUBSECTION 105.03. ALL COSTS SHALL BE INCLUDED IN ITEM 900.645 SPECIAL PROVISION (TRAFFIC CONTROL, ALL-INCLUSIVE).
24. THE TOWN SHALL BE RESPONSIBLE FOR SIGNING THE DETOUR; THE CONTRACTOR SHALL GIVE THE TOWN 21 DAYS NOTICE PRIOR TO ANY ROAD CLOSURE.
25. FOR MORE INFORMATION SEE THE SPECIAL PROVISIONS.

PROJECT NAME: RICHFORD	
PROJECT NUMBER: BRF 0302(29)	
FILE NAME: sl2j158pnote.dgn	PLOT DATE: 12-JAN-2015
PROJECT LEADER: C. CARLSON	DRAWN BY: R. PELLETT
DESIGNED BY: H. SALLS	CHECKED BY: H. SALLS
PROJECT NOTES	SHEET 4 OF 36

STATE OF VERMONT AGENCY OF TRANSPORTATION												QUANTITY SHEET 1											
SUMMARY OF ESTIMATED QUANTITIES												TOTALS		DESCRIPTIONS						DETAILED SUMMARY OF QUANTITIES			
									ROADWAY	EROSION CONTROL	BRIDGE	FULL C.E. ITEMS	GRAND TOTAL	FINAL	UNIT	ITEMS	ITEM NUMBER	ROUND	QUANTITIES	UNIT	ITEMS		
									1				1		LS	CLEARING AND GRUBBING, INCLUDING INDIVIDUAL TREES AND STUMPS	201.10				EARTHWORKS SUMMARY		
									670				670		CY	COMMON EXCAVATION	203.15				FILL AVAILABLE		
											50		50		CY	UNCLASSIFIED CHANNEL EXCAVATION	203.27		670	CY	COMMON EXCAVATION (670 x 1.0)		
																			15	CY	UNCLASSIFIED CHANNEL EXCAVATION (50 x 0.3)		
									160				160		CY	SAND BORROW	203.31		228	CY	STRUCTURE EXCAVATION (760 x 0.3)		
									80				80		CY	GRANULAR BORROW	203.32		2	CY	ROUNDING		
									1				1		CY	TRENCH EXCAVATION OF EARTH, EXPLORATORY (N.A.B.I.)	204.22				TOTAL FILL AVAILABLE		
											760		760		CY	STRUCTURE EXCAVATION	204.25		92	CY	FACTORED FILL (80 x 1.15)		
											280		280		CY	GRANULAR BACKFILL FOR STRUCTURES	204.30		3	CY	ROUNDING		
									250				250		SY	COLD PLANING, BITUMINOUS PAVEMENT	210.10		95	CY	TOTAL FILL REQUIRED		
									450				450		CY	SUBBASE OF DENSE GRADED CRUSHED STONE	301.35		820	CY	TOTAL WASTE		
									7				7		CWT	EMULSIFIED ASPHALT	404.65						
									1				1		LU	PRICE ADJUSTMENT, ASPHALT CEMENT (N.A.B.I.)	406.50				N.A.B.I. = NOT A BID ITEM		
											78		78		SY	SHEET MEMBRANE WATERPROOFING, TORCH APPLIED	519.20						
									56				56		LF	JOINT SEALER, HOT POURED	524.11						
											56		56		LF	BRIDGE RAILING, GALVANIZED 2 RAIL BOX BEAM	525.33						
											1		1		EACH	REMOVAL OF STRUCTURE (600 SF - EST.)	529.15						
											1		1		LS	PRECAST CONCRETE STRUCTURE (28' X 6' X 29' FRAME OR ARCH TYPE)	540.10						
											1		1		LS	PRECAST CONCRETE STRUCTURE (PEDESTAL WALL ABUTMENT #1)	540.10						
											1		1		LS	PRECAST CONCRETE STRUCTURE (PEDESTAL WALL ABUTMENT #2)	540.10						
											1		1		LS	PRECAST CONCRETE STRUCTURE (WINGWALL #1)	540.10						
											1		1		LS	PRECAST CONCRETE STRUCTURE (WINGWALL #2)	540.10						
											1		1		LS	PRECAST CONCRETE STRUCTURE (WINGWALL #3)	540.10						
											1		1		LS	PRECAST CONCRETE STRUCTURE (WINGWALL #4)	540.10						
											90		90		CY	STONE FILL, TYPE II	613.11						
									160				160		LF	CAST-IN-PLACE CONCRETE CURB, TYPE B	616.28						
									555				555		LF	REMOVING AND RESETTING FENCE	620.50						
									208				208		LF	HD STEEL BEAM GUARDRAIL, GALVANIZED	621.21						
									4				4		EACH	ANCHOR FOR STEEL BEAM RAIL	621.60						
									4				4		EACH	GUARDRAIL APPROACH SECTION, GALVANIZED 2 RAIL BOX BEAM	621.72						
									109				109		LF	REMOVAL AND DISPOSAL OF GUARDRAIL	621.80						
									25				25		HR	UNIFORMED TRAFFIC OFFICERS	630.10						
									400				400		HR	FLAGGERS	630.15						
												1	1		LS	FIELD OFFICE, ENGINEERS	631.10						
												1	1		LS	TESTING EQUIPMENT, CONCRETE	631.16						
												1	1		LS	TESTING EQUIPMENT, BITUMINOUS	631.17						
												3000	3000		DL	FIELD OFFICE TELEPHONE (N.A.B.I.)	631.26						
									1				1		LS	MOBILIZATION/DEMObILIZATION	635.11						
									750				750		LF	4 INCH YELLOW LINE	646.21						
											170		170		SY	GEOTEXTILE UNDER STONE FILL	649.31						
										55			55		SY	GEOTEXTILE FOR SILT FENCE, WOVEN WIRE REINFORCED	649.515						
																					PROJECT NAME: RICHFORD		
																					PROJECT NUMBER: BRF 0302(29)		
															FILE NAME: sl2j158qs.dgn		PLOT DATE: 06-JAN-2015						
															PROJECT LEADER: C. CARLSON		DRAWN BY: R. PELLETT						
															DESIGNED BY: H. SALLS		CHECKED BY: H. SALLS						
															QUANTITY I		SHEET 5 OF 36						

QUANTITY SHEET 2

PROJECT NAME: RICHFORD	
PROJECT NUMBER: BRF 0302(29)	
FILE NAME: s12J158qs.dgn	PLOT DATE: 06-JAN-2015
PROJECT LEADER: C. CARLSON	DRAWN BY: R. PELLETT
DESIGNED BY: H. SALLS	CHECKED BY: H. SALLS
QUANTITY 2	SHEET 6 OF 36

BRIDGE QUANTITY SHEET 1

[illegible]

PROJECT NAME:	RICHFORD		
PROJECT NUMBER:	BRF 0302(29)		
FILE NAME:	sl2j158qs.dgn	PLOT DATE:	06-JAN-2015
PROJECT LEADER:	C. CARLSON	DRAWN BY:	R. PELLETT
DESIGNED BY:	H. SALLS	CHECKED BY:	H. SALLS
BRIDGE QUANTITY		SHEET	7 OF 36

GENERAL INFORMATION

SYMBOLGY LEGEND NOTE

THE SYMBOLGY ON THIS SHEET IS INTENDED TO COVER STANDARD CONVENTIONAL SYMBOLGY. THE SYMBOLGY IS USED FOR EXISTING & PROPOSED FEATURES WITH HEAVIER LINEWEIGHT, IN COMBINATION WITH PROJECT ANNOTATION, AS NOTED ON PROJECT PLAN SHEETS. THIS LEGEND SHEET COVERS THE BASICS. SYMBOLGY ON PLANS MAY VARY, PLAN ANNOTATIONS AND NOTES SHOULD BE USED TO CLARIFY AS NEEDED.

R. O. W. ABBREVIATIONS (CODES) & SYMBOLS

POINT	CODE	DESCRIPTION
	CH	CHANNEL EASEMENT
	CONST	CONSTRUCTION EASEMENT
	CUL	CULVERT EASEMENT
	D&C	DISCONNECT & CONNECT
	DIT	DITCH EASEMENT
	DR	DRAINAGE EASEMENT
	DRIVE	DRIVEWAY EASEMENT
	EC	EROSION CONTROL
	HWY	HIGHWAY EASEMENT
	I&M	INSTALL & MAINTAIN EASEMENT
	LAND	LANDSCAPE EASEMENT
	R&RES	REMOVE & RESET
	R&REP	REMOVE & REPLACE
	SR	SLOPE RIGHT
	UE	UTILITY EASEMENT
	(P)	PERMANENT EASEMENT
	(T)	TEMPORARY EASEMENT
■	BNDNS	BOUND SET
▣	BNDNS	BOUND TO BE SET
●	IPNS	IRON PIN SET
◎	IPNS	IRON PIN TO BE SET
⊠	CALC	EXISTING ROW POINT
○	PROW	PROPOSED ROW POINT
[LENGTH]		LENGTH CARRIED ON NEXT SHEET

COMMON TOPOGRAPHIC POINT SYMBOLS

POINT	CODE	DESCRIPTION
⌘	APL	BOUND APPARENT LOCATION
◻	BM	BENCHMARK
▣	BND	BOUND
▣	CB	CATCH BASIN
⊕	COMB	COMBINATION POLE
▣	DITHR	DROP INLET THROATED DNC
⊕	EL	ELECTRIC POWER POLE
◉	FPOLE	FLAGPOLE
○	GASFIL	GAS FILLER
○	GP	GUIDE POST
×	GSO	GAS SHUT OFF
◉	GUY	GUY POLE
◉	GUYW	GUY WIRE
×	GV	GATE VALUE
⊗	H	TREE HARDWOOD
△	HCTRL	CONTROL HORIZONTAL
△	HVCTRL	CONTROL HORIZ. & VERTICAL
◇	HYD	HYDRANT
◉	IP	IRON PIN
◉	IPIPE	IRON PIPE
⊕	LI	LIGHT - STREET OR YARD
⊕	MB	MAILBOX
○	MH	MANHOLE (MH)
▣	MM	MILE MARKER
◉	PM	PARKING METER
▣	PMK	PROJECT MARKER
◉	POST	POST STONE/WOOD
⊕	RRSIG	RAILROAD SIGNAL
⊕	RRSL	RAILROAD SWITCH LEVER
⊕	S	TREE SOFTWOOD
◉	SAT	SATELLITE DISH
⊗	SHRUB	SHRUB
◉	SIGN	SIGN
⊕	STUMP	STUMP
◉	TEL	TELEPHONE POLE
◉	TIE	TIE
⊕	TSIGN	SIGN W/DOUBLE POST
⊕	VCTRL	CONTROL VERTICAL
◉	WELL	WELL
×	WSO	WATER SHUT OFF

THESE ARE COMMON VAOT SURVEY POINT SYMBOLS FOR EXISTING FEATURES, ALSO USED FOR PROPOSED FEATURES WITH HEAVIER LINEWEIGHT, IN COMBINATION WITH PROPOSED ANNOTATION.

PROPOSED GEOMETRY CODES

CODE	DESCRIPTION
PC	POINT OF CURVATURE
PI	POINT OF INTERSECTION
CC	CENTER OF CURVE
PT	POINT OF TANGENCY
PCC	POINT OF COMPOUND CURVE
PRC	POINT OF REVERSE CURVE
POB	POINT OF BEGINNING
POE	POINT OF ENDING
STA	STATION PREFIX
AH	AHEAD STATION SUFFIX
BK	BACK STATION SUFFIX
D	CURVE DEGREE OF (100FT)
R	CURVE RADUIS OF
T	CURVE TANGENT LENGTH
L	CURVE LENGTH OF
E	CURVE EXTERNAL DISTANCE

UTILITY SYMBOLGY

UNDERGROUND UTILITIES

— UGU —		UTILITY (GENERIC-UNKNOWN)
— UT —		TELEPHONE
— UE —		ELECTRIC
— UC —		CABLE (TV)
— UEC —		ELECTRIC+CABLE
— UET —		ELECTRIC+TELEPHONE
— UCT —		CABLE+TELEPHONE
— UECT —		ELECTRIC+CABLE+TELEP.
— G —		GAS LINE
— W —		WATER LINE
— S —		SANITARY SEWER (SEPTIC)

ABOVE GROUND UTILITIES (AERIAL)

— AGU —		UTILITY (GENERIC-UNKNOWN)
— T —		TELEPHONE
— E —		ELECTRIC
— C —		CABLE (TV)
— EC —		ELECTRIC+CABLE
— ET —		ELECTRIC+TELEPHONE
— AER E&T —		ELECTRIC+TELEPHONE
— CT —		CABLE+TELEPHONE
— ECT —		ELECTRIC+CABLE+TELEP.
— .. —		UTILITY POLE GUY WIRE

PROJECT CONSTRUCTION SYMBOLGY

PROJECT DESIGN & LAYOUT SYMBOLGY

— -- —	CZ —	CLEAR ZONE
—————		PLAN LAYOUT MATCHLINE

PROJECT CONSTRUCTION FEATURES

△ — △ — △ — △	TOP OF CUT SLOPE
○ — ○ — ○ — ○	TOE OF FILL SLOPE
⊗ ⊗ ⊗ ⊗ ⊗ ⊗	STONE FILL
-----	BOTTOM OF DITCH
-----	CULVERT PROPOSED
-----	STRUCTURE SUBSURFACE
PDF — PDF —	PROJECT DEMARCATION FENCE
BF — x — x — BF — x —	BARRIER FENCE
xxxxxxxxxxxxxxxxxxxx	TREE PROTECTION ZONE (TPZ)
//////////	STRIPING LINE REMOVAL
~~~~~	SHEET PILES

CONVENTIONAL BOUNDARY SYMBOLGY

BOUNDARY LINES

—————	TOWN LINE	TOWN BOUNDARY LINE
—————	COUNTY LINE	COUNTY BOUNDARY LINE
—————	STATE LINE	STATE BOUNDARY LINE
——— / ———		PROPOSED STATE R.O.W. (LIMITED ACCESS)
——— / ———		PROPOSED STATE R.O.W.
——— / ———		STATE ROW (LIMITED ACCESS)
——— / ———		STATE ROW
——— / ———		TOWN ROW
— . . . . . —		PERMANENT EASEMENT LINE (P)
— - - - - —		TEMPORARY EASEMENT LINE (T)
— — — — —		SURVEY LINE
+ ——— + ——— +		PROPERTY LINE (P/L)
P ——— P ———		
L ——— L ———		
SR ——— SR ——— SR ———		SLOPE RIGHTS
6f ——— 6f ———		6F PROPERTY BOUNDARY
4f ——— 4f ———		4F PROPERTY BOUNDARY
HAZ ——— HAZ ———		HAZARDOUS WASTE

EPSC LAYOUT PLAN SYMBOLGY

EPSC MEASURES

ONNOONNOONNO	FILTER CURTAIN
— x — x — x — x —	SILT FENCE
— x — x — x — x —	SILT FENCE WOVEN WIRE
▶ —▶ —▶ —▶ —▶	CHECK DAM
▣	DISTURBED AREAS REQUIRING RE-VEGETATION
⊗	EROSION MATTING

SEE EPSC DETAIL SHEETS FOR ADDITIONAL SYMBOLGY

ENVIRONMENTAL RESOURCES

———	WETLAND BOUNDARY
-----	RIPARIAN BUFFER ZONE
-----	WETLAND BUFFER ZONE
-----	SOIL TYPE BOUNDARY
——— T&E ———	THREATENED & ENDANGERED SPECIES
HAZ ——— HAZ ———	HAZARDOUS WASTE AREA
——— AG ———	AGRICULTURAL LAND
——— HABITAT ———	FISH & WILDLIFE HABITAT
——— FLOOD PLAIN ———	FLOOD PLAIN
——— OHW ———	ORDINARY HIGH WATER (OHW)
———	STORM WATER
———	USDA FOREST SERVICE LANDS
———	WILDLIFE HABITAT SUIT/CONN

ARCHEOLOGICAL & HISTORIC

——— ARCH ———	ARCHEOLOGICAL BOUNDARY
——— HISTORIC DIST ———	HISTORIC DISTRICT BOUNDARY
——— HISTORIC ———	HISTORIC AREA
Ⓜ	HISTORIC STRUCTURE

CONVENTIONAL TOPOGRAPHIC SYMBOLGY

EXISTING FEATURES

-----	ROAD EDGE PAVEMENT
-----	ROAD EDGE GRAVEL
-----	DRIVEWAY EDGE
-----	DITCH
-----	FOUNDATION
x — x — x — x —	FENCE (EXISTING)
□ — □ — □ — □ —	FENCE WOOD POST
○ — ○ — ○ — ○ —	FENCE STEEL POST
~~~~~	GARDEN
○ — ○ — ○ — ○ —	ROAD GUARDRAIL
	RAILROAD TRACKS
-----	CULVERT (EXISTING)
-----	STONE WALL
-----	WALL
~~~~~	WOOD LINE
~~~~~	BRUSH LINE
~~~~~	HEDGE
~~~~~	BODY OF WATER EDGE
~~~~~	LEDGE EXPOSED

PROJECT NAME:	RICHFORD
PROJECT NUMBER:	BRF 0302(29)
FILE NAME:	sl2j158legend.dgn
PROJECT LEADER:	C. CARLSON
DESIGNED BY:	AOT
CONVENTIONAL SYMBOLGY LEGEND	
PLOT DATE:	11-DEC-2014
DRAWN BY:	M.LONGSTREET
CHECKED BY:	H. SALLS
SHEET	8 OF 36



GPS CONTROL POINTS






____HVCTRL #1____  
5600 VOLTS  
NORTH = 905682.149  
EAST = 1595379.726  
ELEV. = 485.449

STATION MARK IS A VERTICAL CONTROL DISK WITH SETTING: STAINLESS STEEL ROD W/O SLEEVE (10 FT.+) DISK FROM: NGS THE MARK IS STAMPED: U 49 1978 SATELLITE; THE SITE IS SUITABLE FOR GPS OBSERVATIONS PGI387' RECOVERED IN GOOD CONDITION. IT IS 0.8 M (2.6 FT) NORTHWEST OF A PGI387' STEEL WITNESS POST.

____HVCTRL #2____  
U 49  
NORTH = 906242.748  
EAST = 1593803.722  
ELEV. = 446.210

GENERAL LOCATION, RICHFORD, VT. TO REACH FROM THE INTERSECTION OF VT ROUTE 105 AND VT ROUTE 139 IN RICHFORD VILLAGE GO SOUTHEAST ALONG VT ROUTE 105 FOR 0.2 MI(0.3 KM) TO THE INTERSECTION OF NOYES STREET LEFT, TURN LEFT AND GO SOUTH ALONG NOYES STREET FOR 0.4 MI(0.6 KM) TO THE INTERSECTION OF A PAVED DRIVE LEFT LEADING TO STAIRS UNLIMITED INC. CONTINUE STRAIGHT AHEAD AND GO SOUTHWEST ALONG NOYES STREET FOR ABOUT 20 M (65.6 FT) TO THE SITE OF THE MARK ON THE RIGHT. THE MARK IS SET FLUSH WITH GROUND SURFACE IN THE TOP OF A 30 CM DIAMETER CONCRETE MONUMENT POURED 1.3 M (4.3 FT) DEEP. THE MARK IS 6.9 M (22.6 FT) NORTHWEST OF AND ABOUT 1.0 M (3.3 FT) LOWER THAN THE CENTERLINE OF NOYES STREET, 15.2 M (49.9 FT) WEST NORTHWEST OF AN UNNUMBERED POLE, 18.1 M (59.4 FT) WEST OF A CAST IRON GATE POST WITH AN ATTACHED MAILBOX, 46.3 M (151.9 FT) WEST SOUTHWEST OF THE WEST CORNER OF AN ELL ON THE STAIRS UNLIMITED INC. BUILDING, AND 1.2 M (3.9 FT) SOUTHEAST OF A 5600 VOLT ELECTRIC FENCE AND A FIBERGLASS WITNESS POST.

TRAVERSE TIES

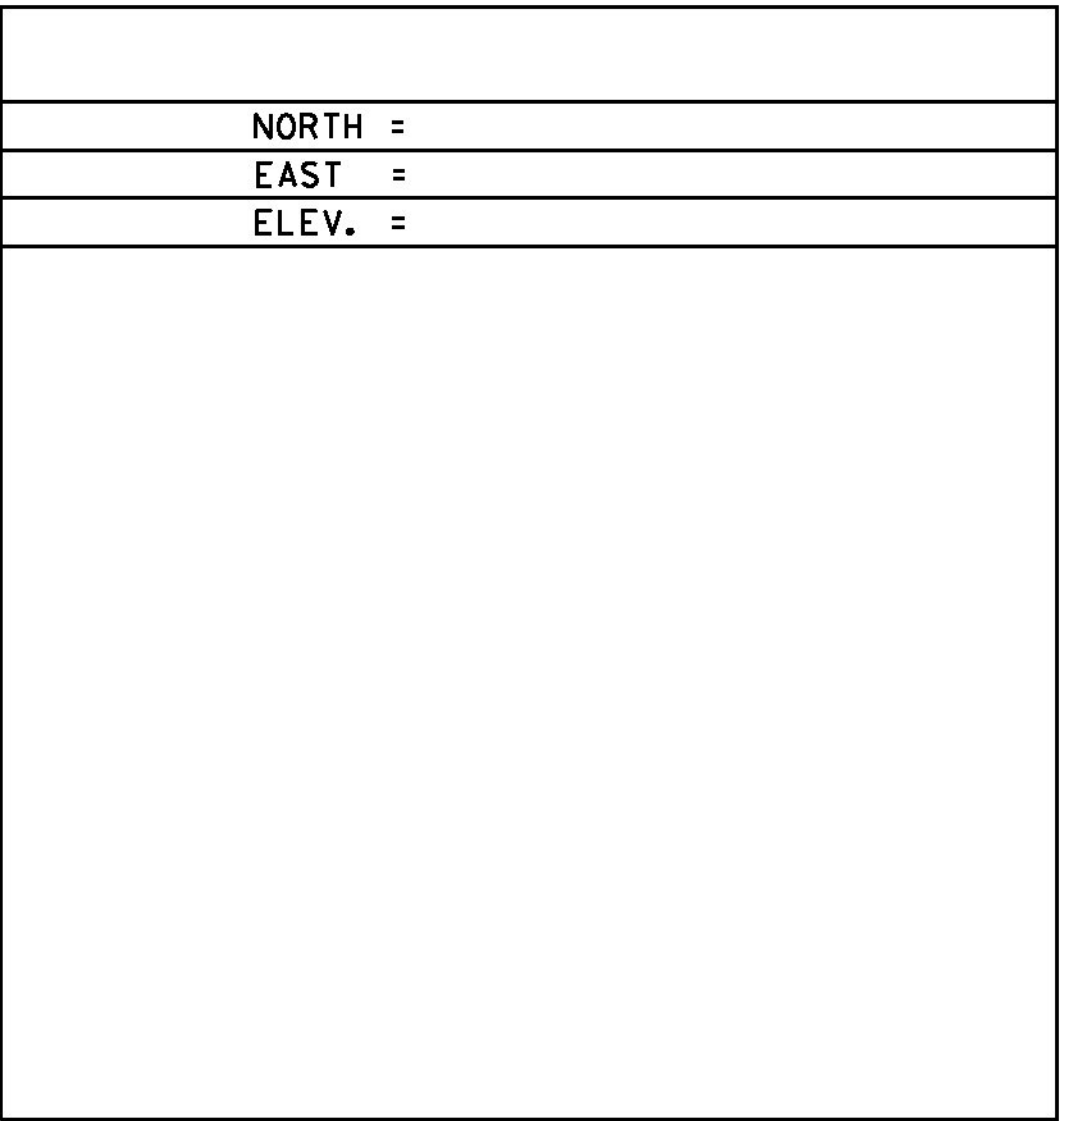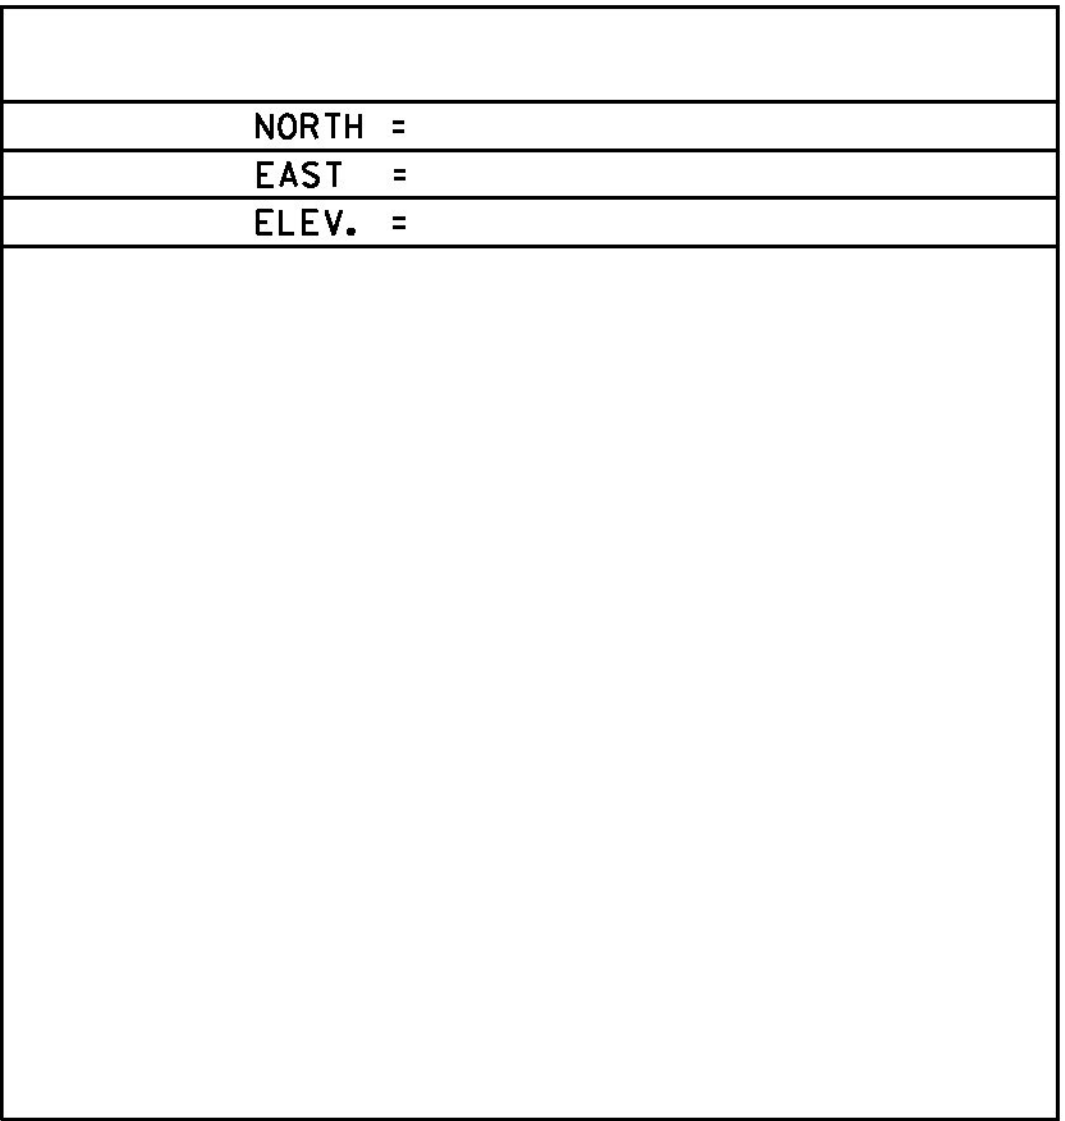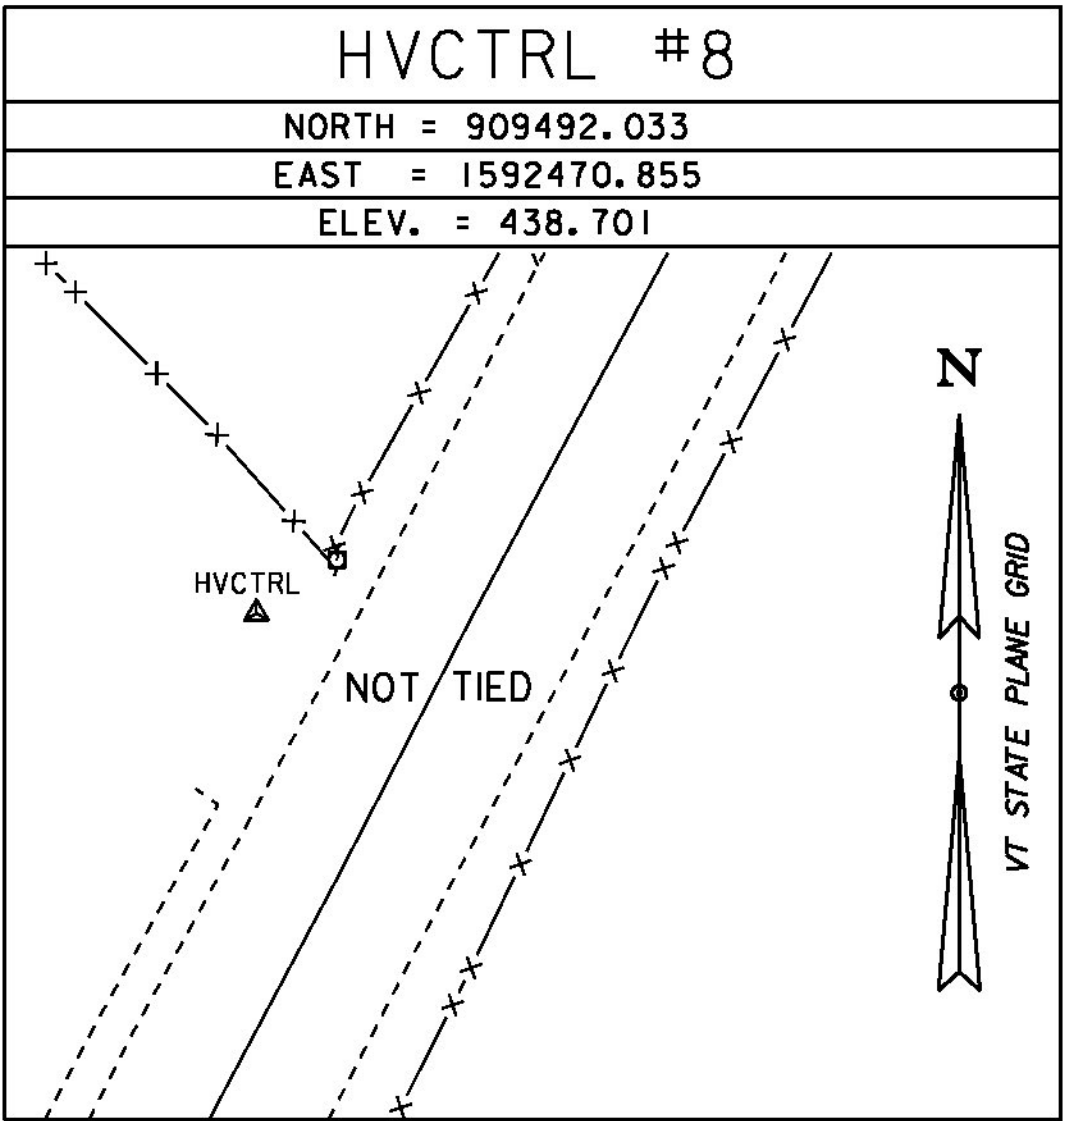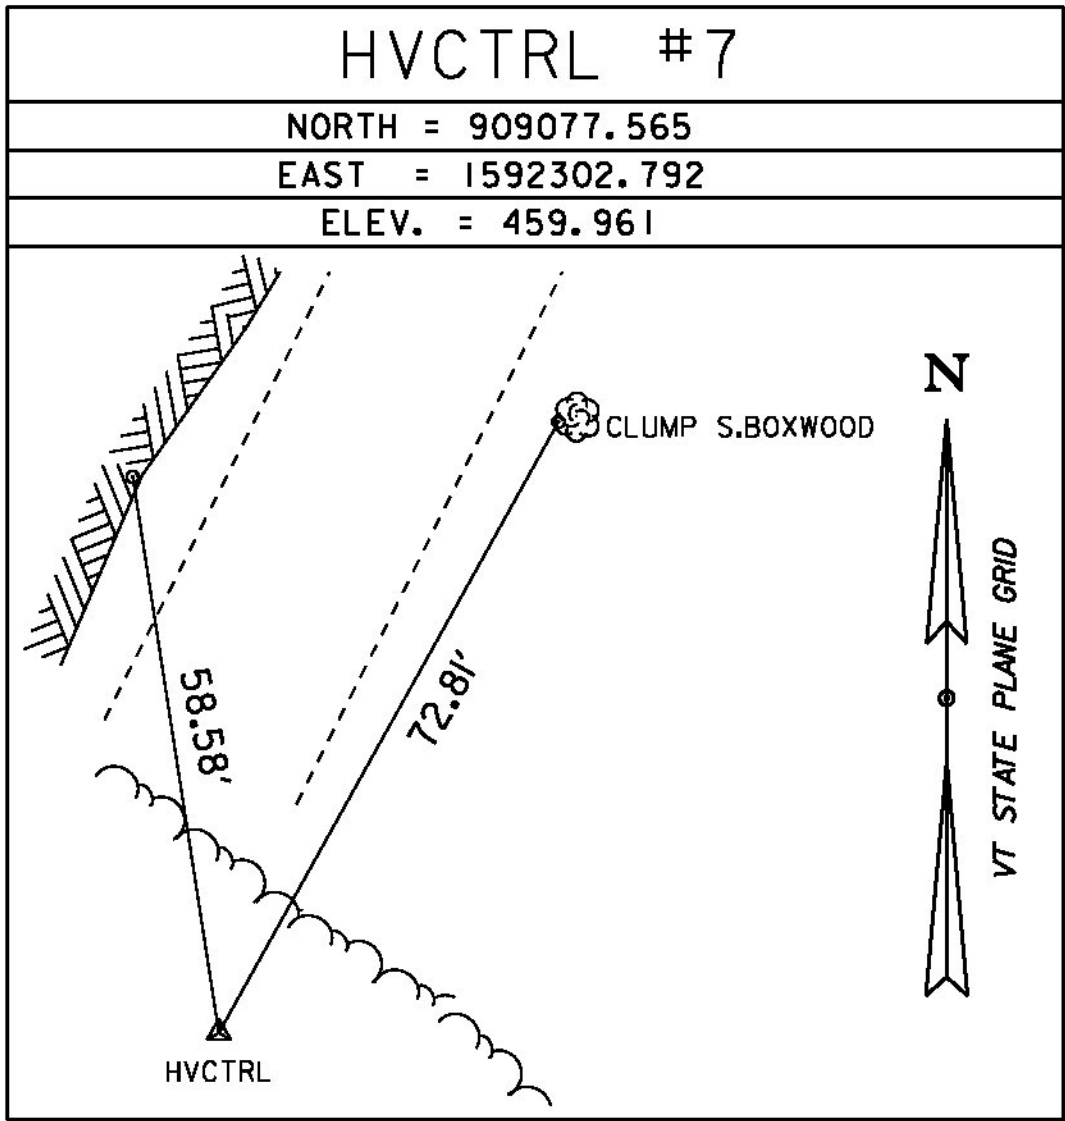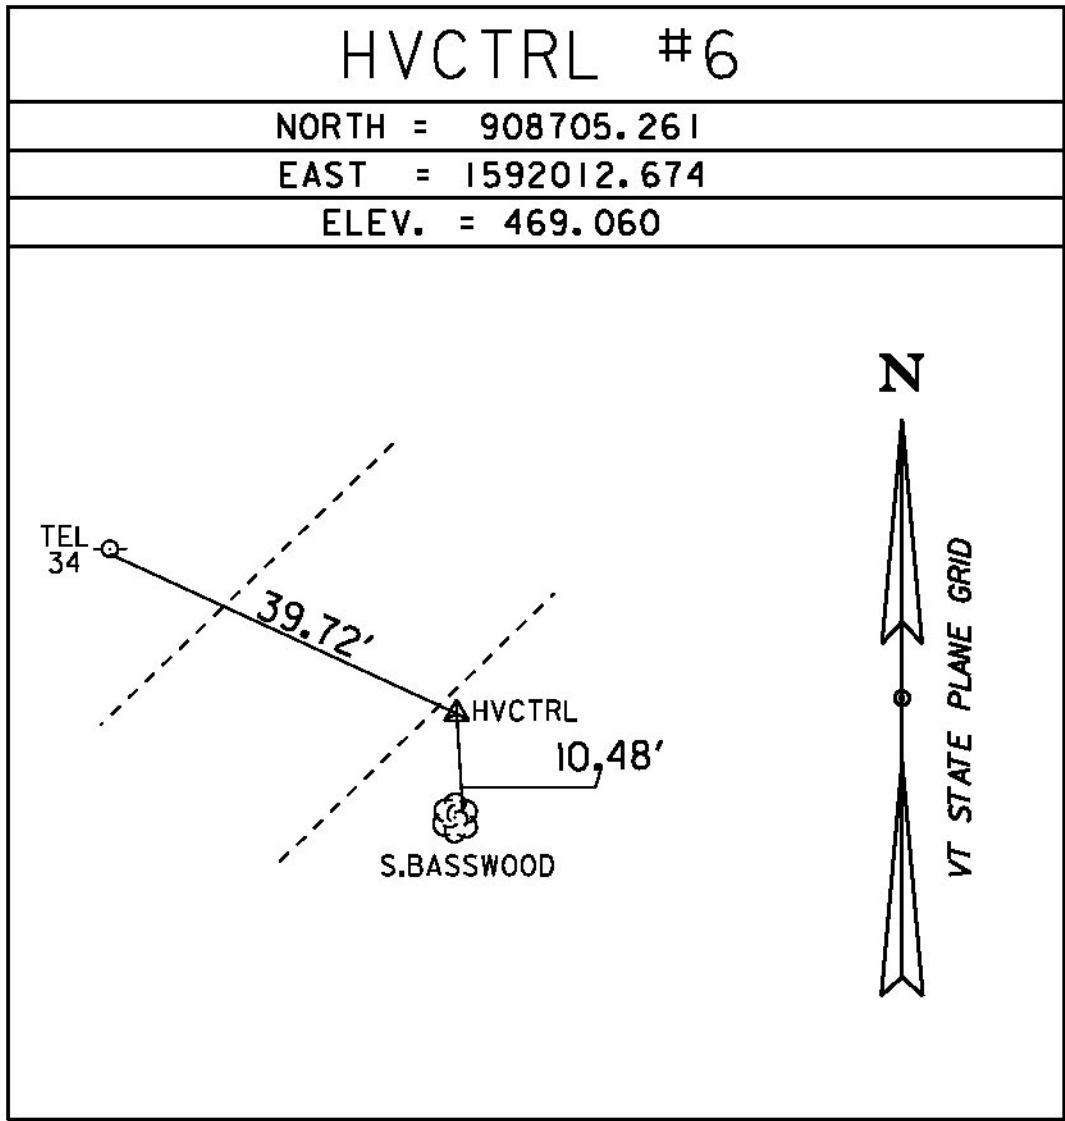

* Main Traverse Completed 4/17/09 by R. Bullock P.C. & R. Bockus

ALIGNMENT TIES

TOWN HIGHWAY 3			
	STATION	NORTHING	EASTING
PC	40+00.00	909322.5958	1592404.8065
PI	41+86.52	909490.0381	1592486.9783
	Radius:	6500.00	
	Delta:	3°17'14.35" Right	
	Degree of Curvature(Arc):	0°52'53.30"	
	Length:	372.93	
	Tangent:	186.52	
	Chord:	372.88	
	Middle Ordinate:	2.67	
	External:	2.68	
PT	43+72.93		
PC	45+24.77		
PI	47+35.93		
	Radius:	2600.00	
	Delta:	9°17'10.58" Right	
	Degree of Curvature(Arc):	2°12'13.26"	
	Length:	421.40	
	Tangent:	211.16	
	Chord:	420.94	
	Middle Ordinate:	8.53	
	External:	8.56	
PT	49+35.62		
POE	49+46.16		

DATUM	
VERTICAL	NAVD 88
HORIZONTAL	NAD 83 (1996)
ADJUSTMENT	TRAVERSE

PROJECT NAME: RICHFORD	
PROJECT NUMBER: BRF 0302(29)	
FILE NAME: sl2j158+1e.dgn	PLOT DATE: 11-DEC-2014
PROJECT LEADER: C. CARLSON	DRAWN BY: S. DONOVAN
DESIGNED BY: H. SALLS	CHECKED BY: H. SALLS
TIE	SHEET 9 OF 36



CURVE (1)  
DELTA = 3°14'56"  
D = 0°52'53"  
R = 6500.00'  
T = 184.34'  
L = 368.57'  
E = 2.61'

HD STEEL BEAM GUARDRAIL, GALVANIZED  
STA 43+44.92 LT - STA 43+88.67 LT  
STA 43+44.92 RT - STA 43+88.67 RT  
STA 44+87.33 LT - STA 45+31.08 LT  
STA 44+87.33 RT - STA 45+31.08 RT

GUARDRAIL APPROACH SECTION,  
GALVANIZED 2 RAIL BOX BEAM  
STA 43+88.67 LT - STA 44+24.00 LT  
STA 43+88.67 RT - STA 44+24.00 RT  
STA 44+52.00 LT - STA 44+87.33 LT  
STA 44+52.00 RT - STA 44+87.33 RT

BRIDGE RAILING, GALVANIZED  
2 RAIL BOX BEAM  
STA 44+24.00 LT - STA 44+52.00 LT  
STA 44+24.00 RT - STA 44+52.00 RT

REMOVING AND RESETTING FENCE *  
STA 42+50.00 LT - STA 44+17.00 LT  
STA 42+50.00 RT - STA 44+23.00 RT  
STA 44+51.00 RT - STA 44+75.00 RT  
STA 44+52.00 LT - STA 46+25.00 LT

* FENCING WILL BE RESET AT A LOCATION  
AGREED UPON W/ THE PROPERTY OWNER  
AND ENGINEER IN THE FIELD



CONSTRUCT 5' PAVED APRON  
STA 45+59.00 RT - STA 45+77.00 RT

REMOVAL AND DISPOSAL OF GUARDRAIL  
STA 43+98.79 LT - STA 44+78.62 LT  
STA 43+98.45 RT - STA 44+77.92 RT

CAST-IN-PLACE CONCRETE CURB, TYPE B  
STA 43+83.58 LT - STA 44+24.00 LT  
STA 44+52.00 LT - STA 44+92.00 LT  
STA 43+83.58 RT - STA 44+24.00 RT  
STA 44+52.00 RT - STA 44+92.00 RT

ANCHOR FOR STEEL BEAM RAIL  
STA 43+50.98 LT & RT  
STA 45+23.80 LT & RT

CURVE (2)  
DELTA = 9°03'14"  
D = 2°12'13"  
R = 2600.00'  
T = 205.85'  
L = 410.85'  
E = 8.14'

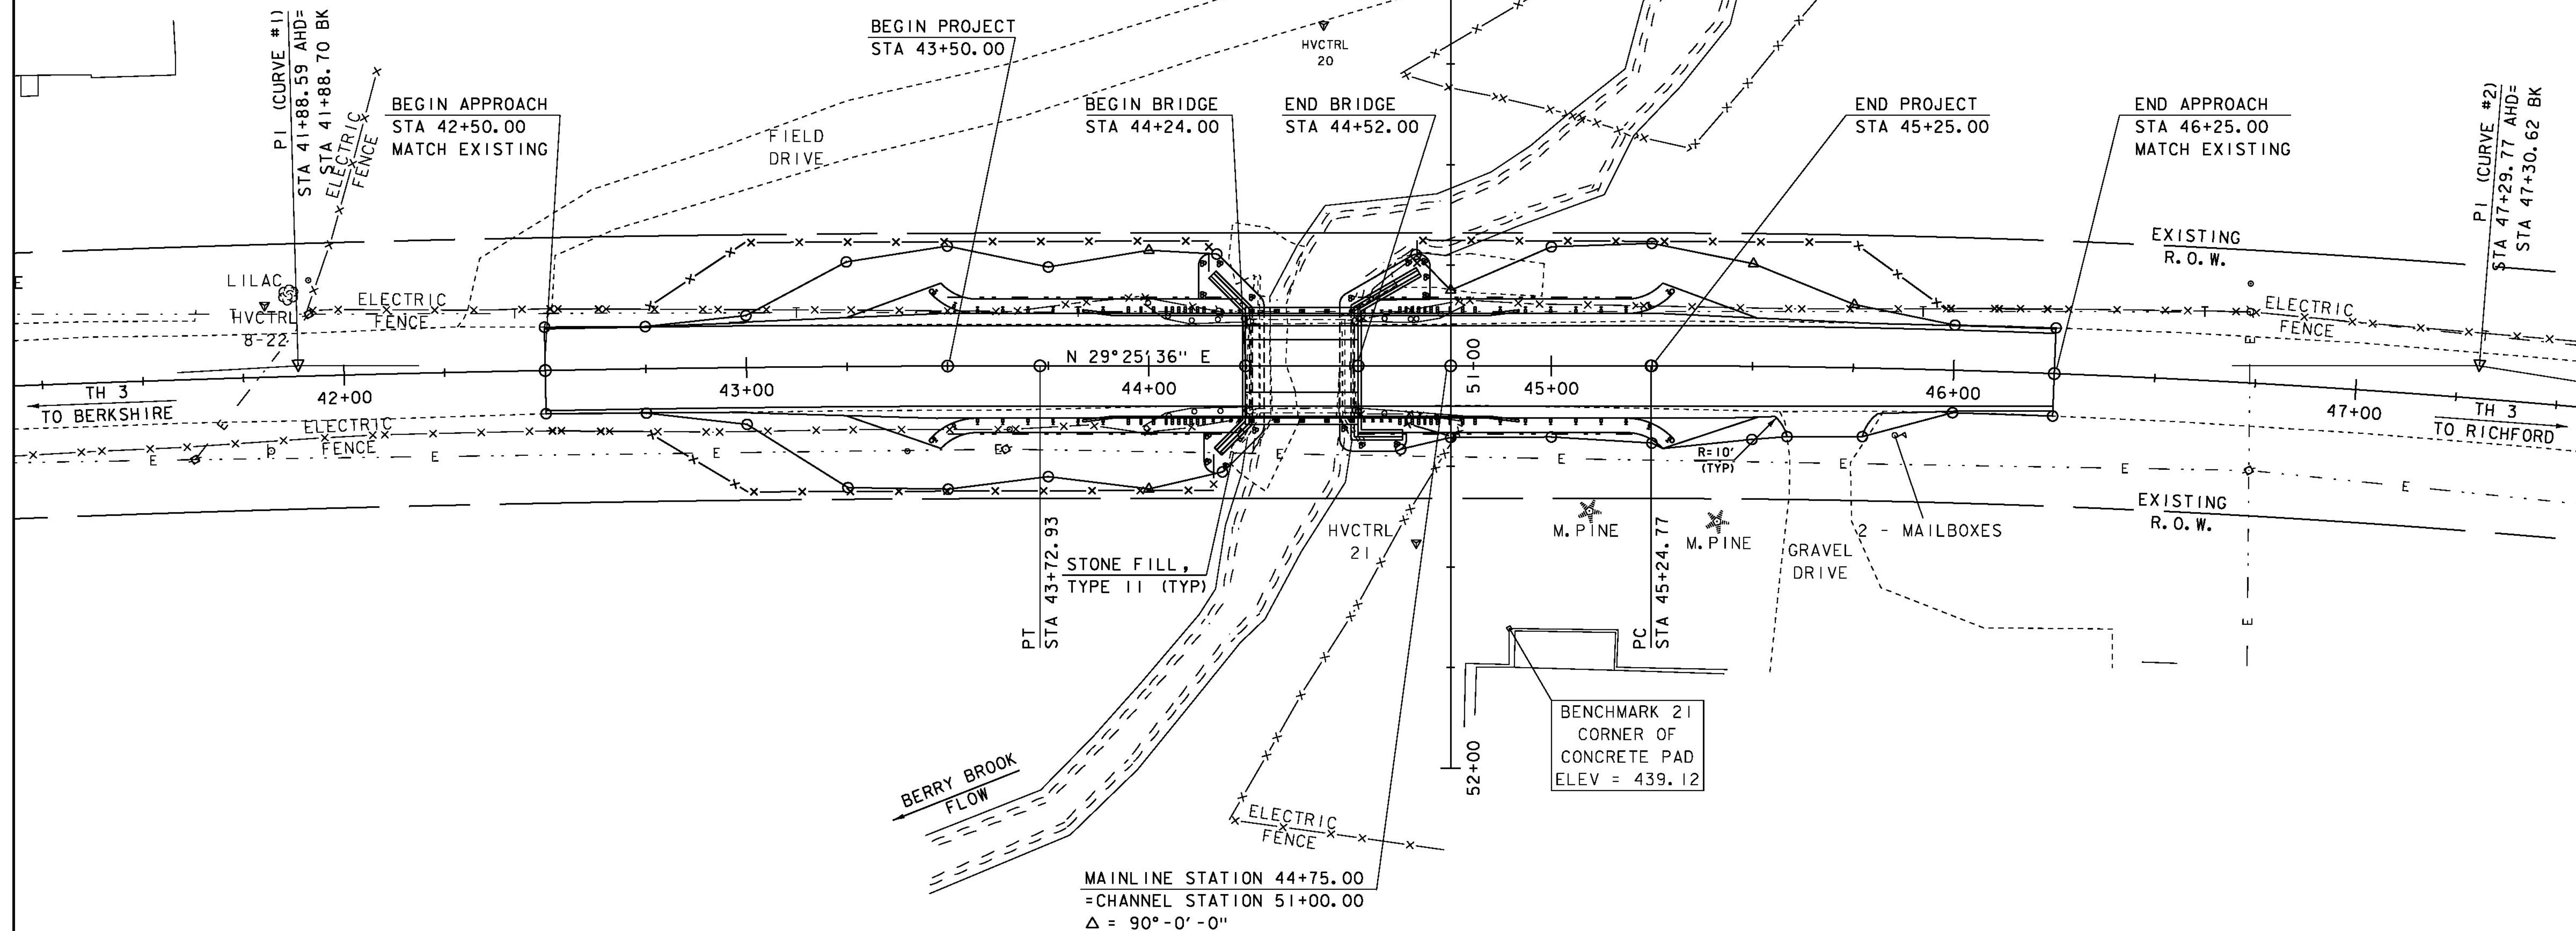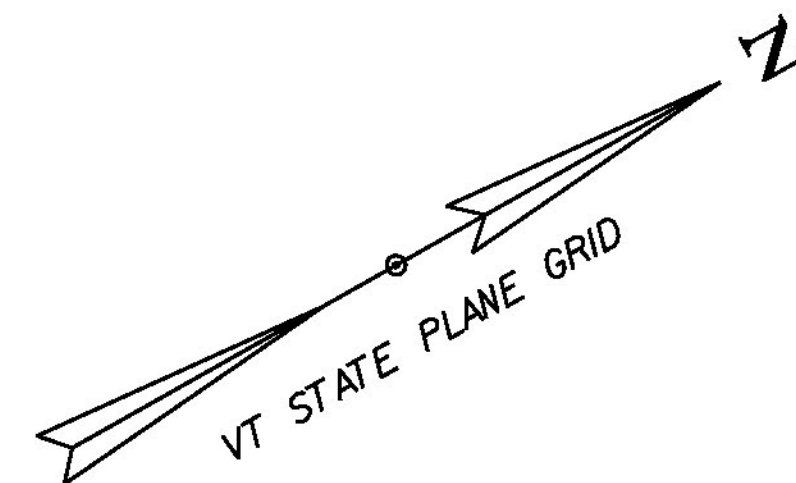

EXISTING BRIDGE DATA  
SINGLE SPAN CONCRETE T-BEAM  
BRIDGE BUILT IN 1900  
BRIDGE LENGTH = 24 FT.  
WATERWAY AREA = 125 SF


SCALE 1" = 20' - 0"  
20 0 20

PROJECT NAME: RICHFORD  
PROJECT NUMBER: BR 0302(29)

FILE NAME: sl2j158bdr.dgn  
PROJECT LEADER: C. CARLSON  
DESIGNED BY: H. SALLS  
LAYOUT

PLOT DATE: 11-DEC-2014  
DRAWN BY: R. PELLETT  
CHECKED BY: H. SALLS  
SHEET 10 OF 36




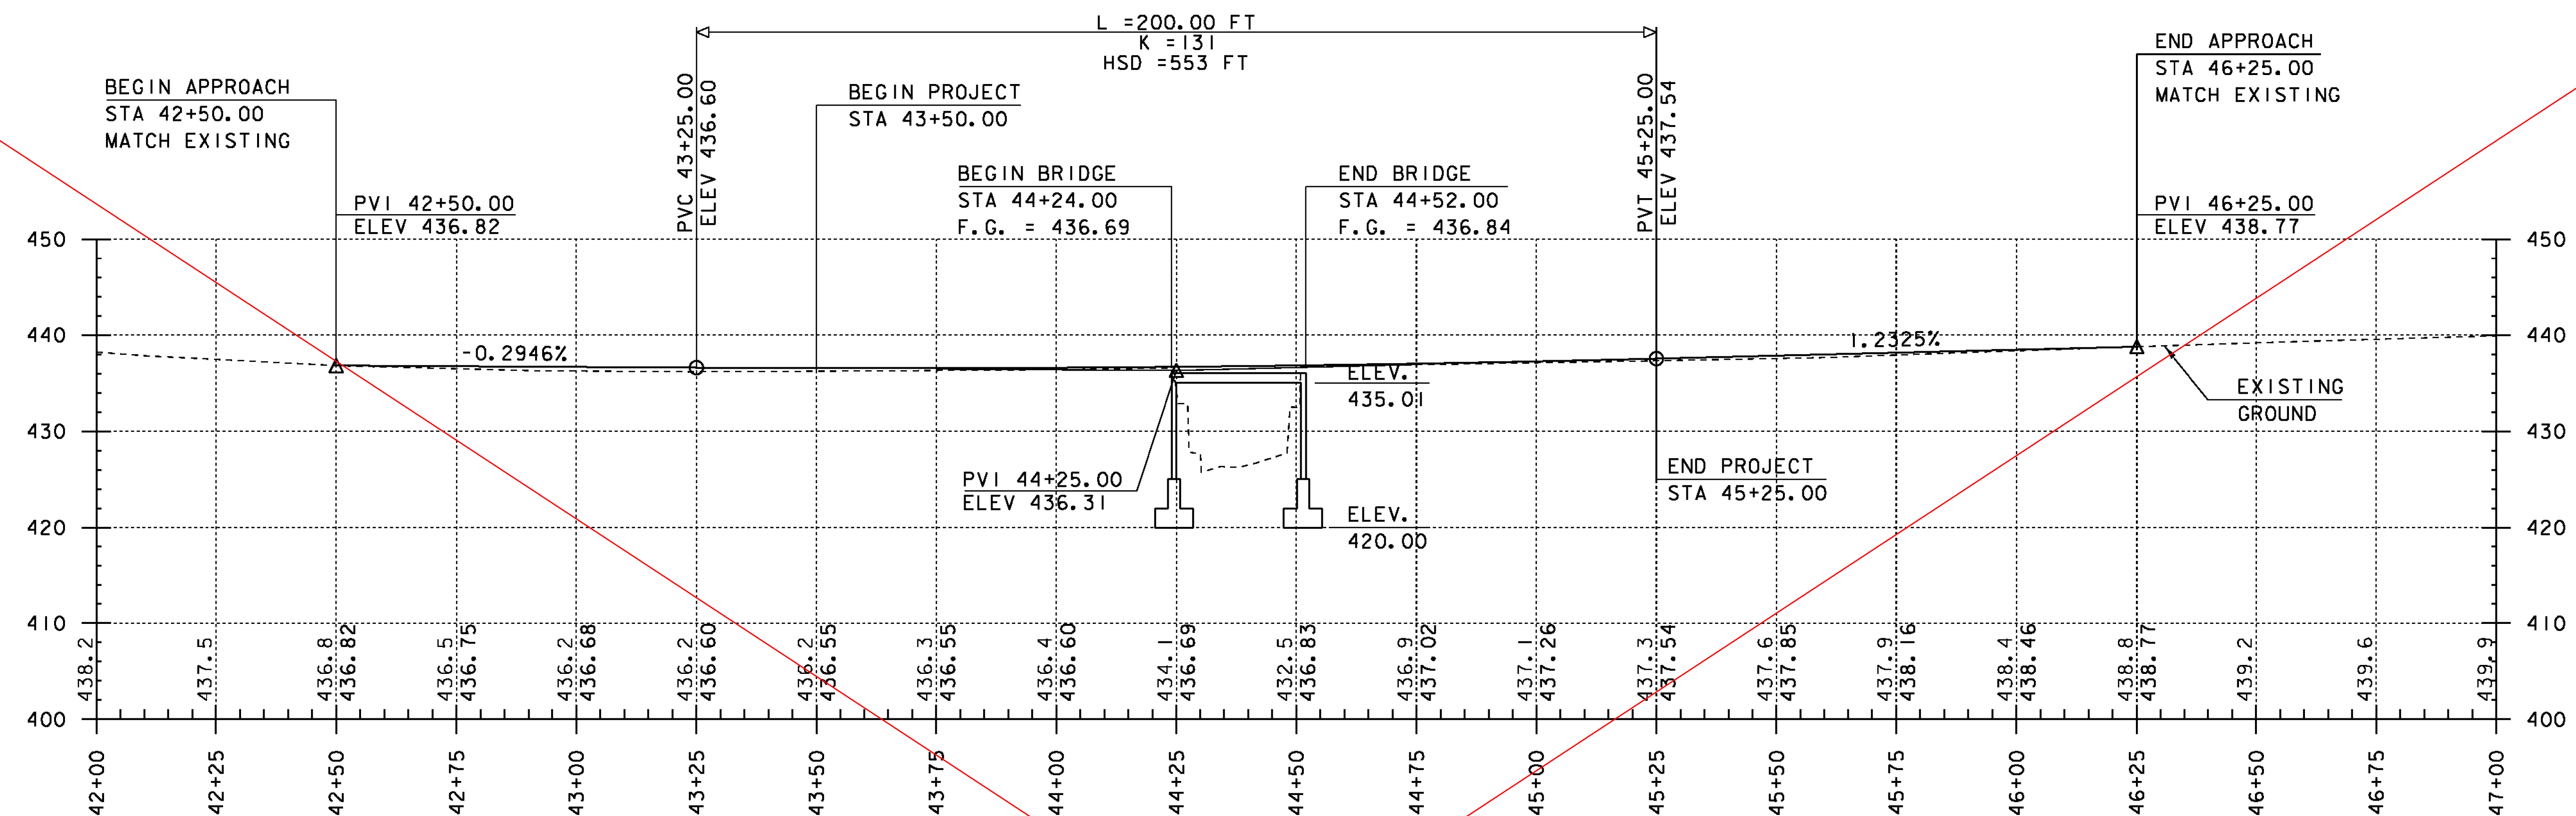

### TH3 PROFILE

SCALE: HORIZONTAL 1"=20'-0"  
VERTICAL 1"=10'-0"


NOTE:  
GRADES SHOWN TO THE NEAREST TENTH ARE EXISTING GROUND ALONG  $\bar{C}$   
GRADES SHOWN TO THE NEAREST HUNDREDTH ARE FINISH GRADE ALONG  $\bar{C}$

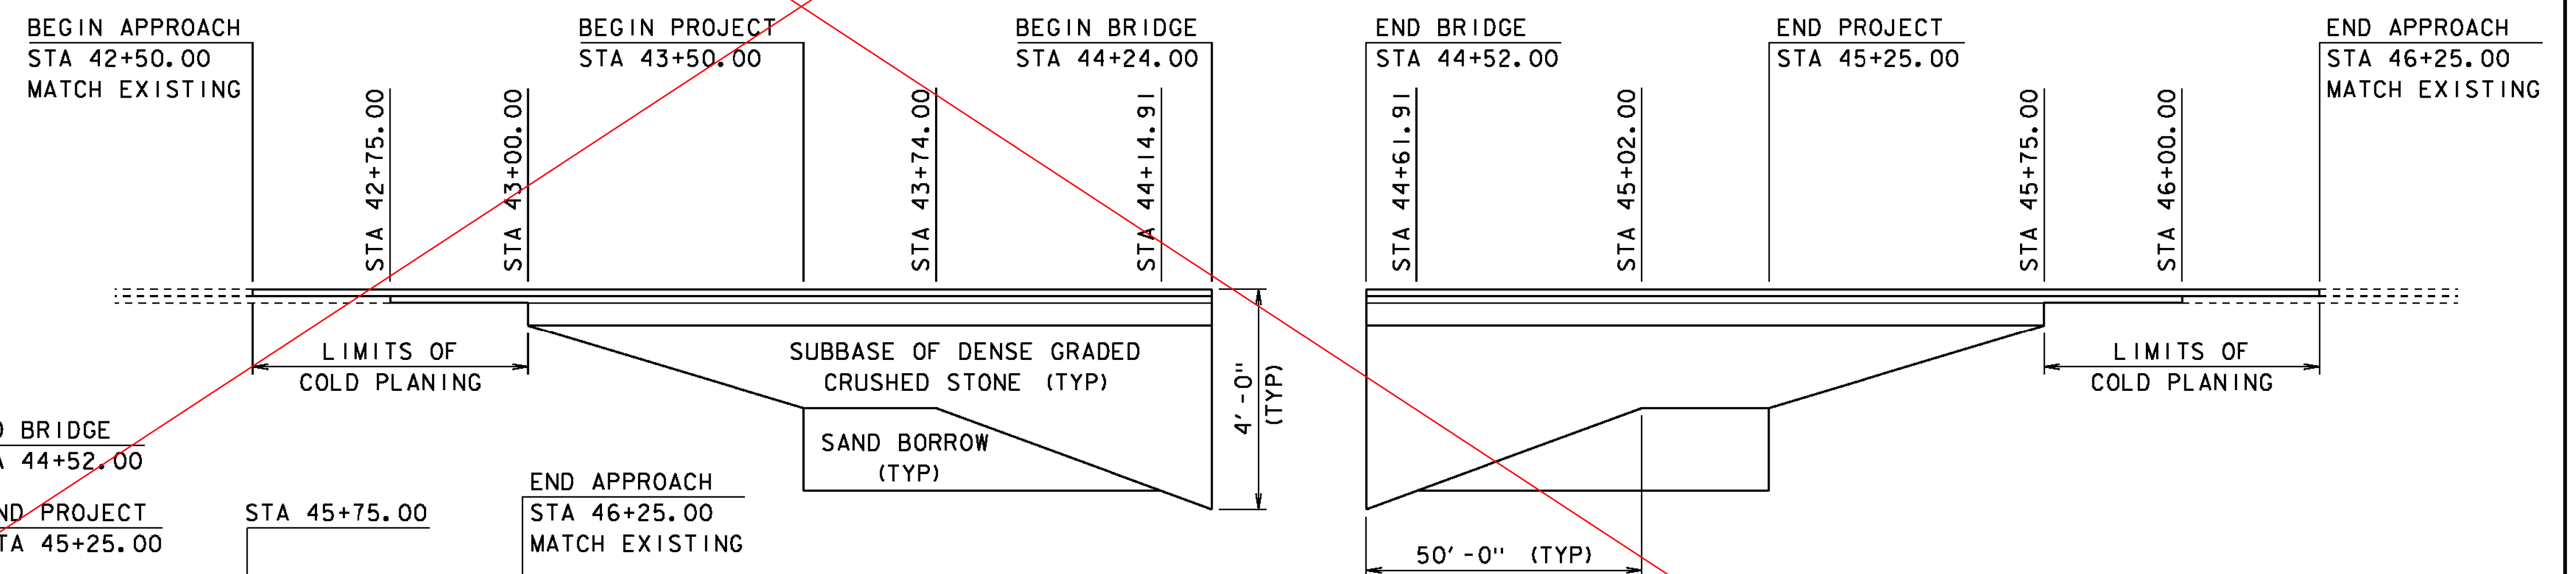

### MATERIAL TRANSITION DIAGRAM

HOR. SCALE 1" = 20'-0"  
NO VERT. SCALE

NOTE:  
SEE ROADWAY TYPICAL SECTION FOR THICKNESSES OF:  
BITUMINOUS CONCRETE PAVEMENT,  
SUBBASE OF DENSE GRADED CRUSHED STONE  
& SAND BORROW

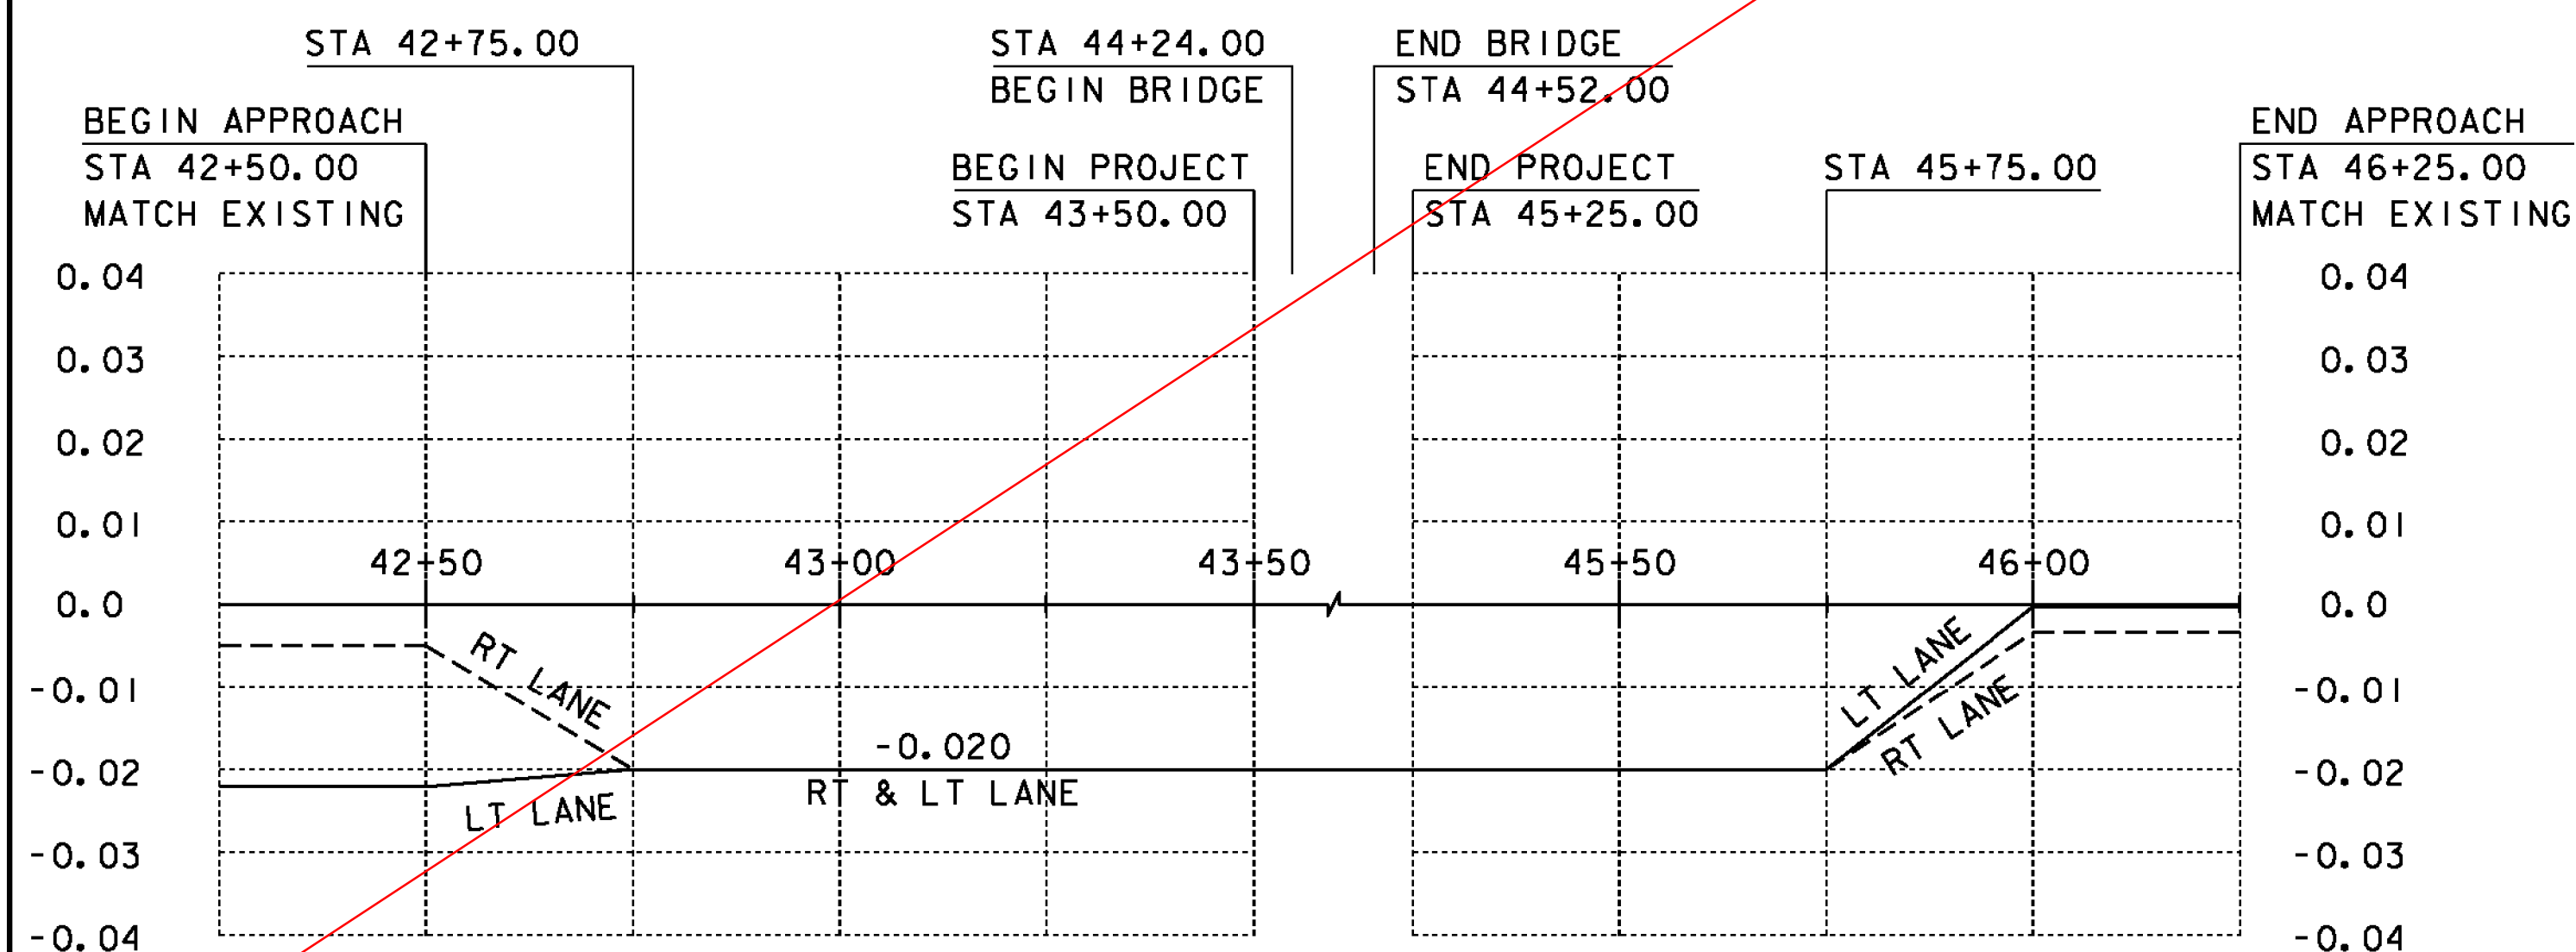

### BANKING DIAGRAM

HOR. SCALE 1" = 20'-0"  
NO VERT. SCALE




PROJECT NAME: RICHFORD  
PROJECT NUMBER: BRF 0302(29)

FILE NAME: sl2j58pro.dgn  
PROJECT LEADER: C. CARLSON  
DESIGNED BY: H. SALLS  
TH 3 PROFILE AND TRANSITION DIAGRAMS

PLOT DATE: 11-DEC-2014  
DRAWN BY: R. PELLETT  
CHECKED BY: H. SALLS  
SHEET 11 OF 36

SEE PAGE IIR FOR REVISED TH3 PROFILE





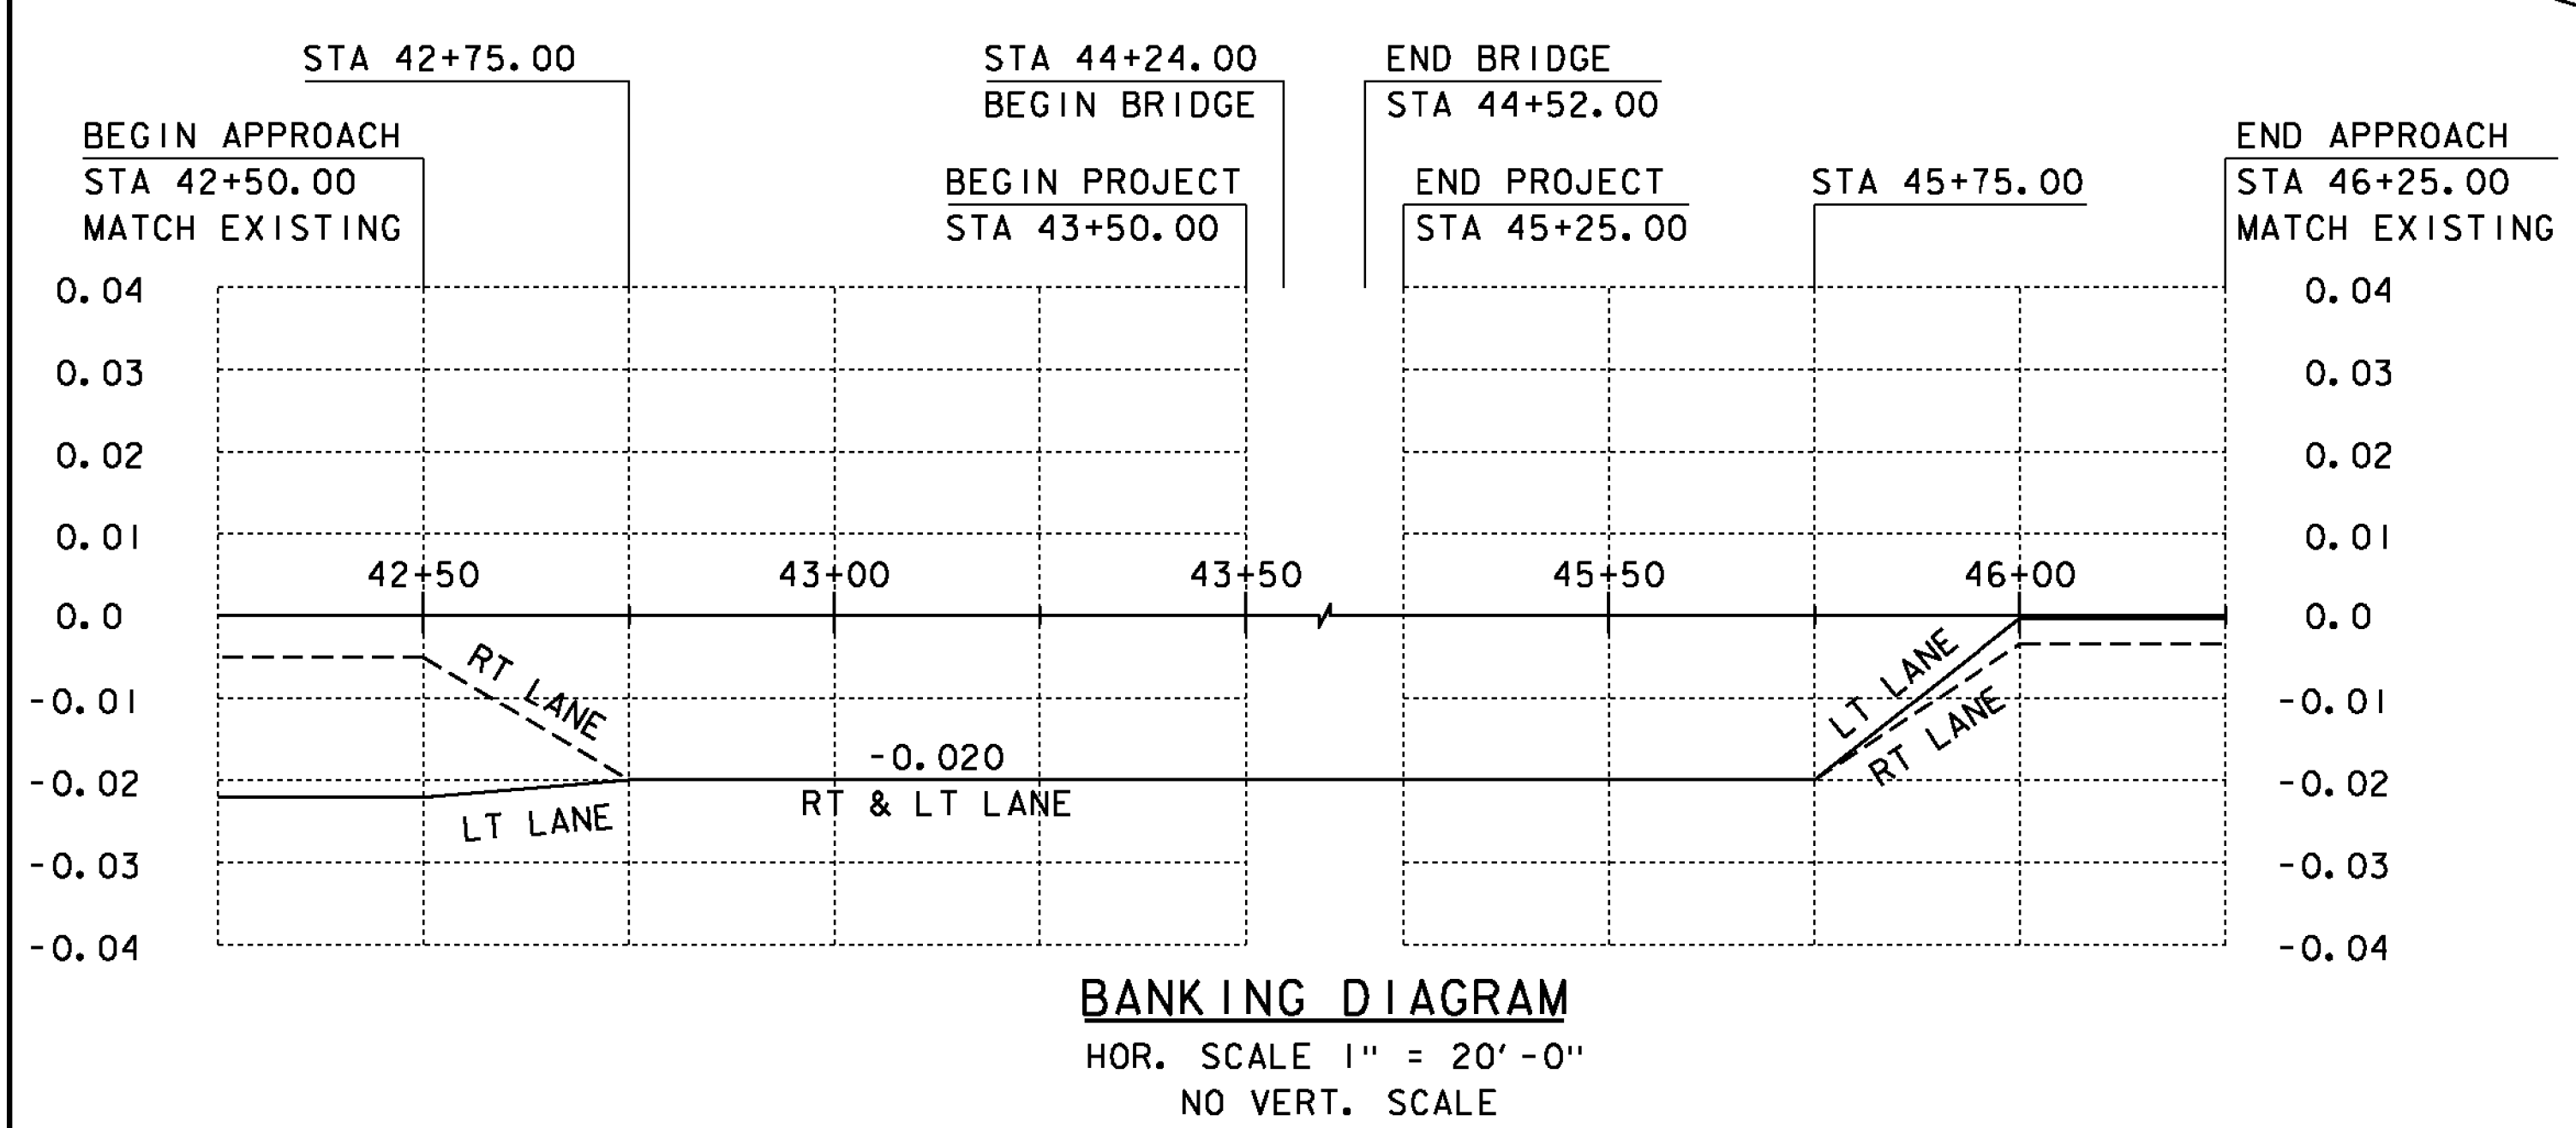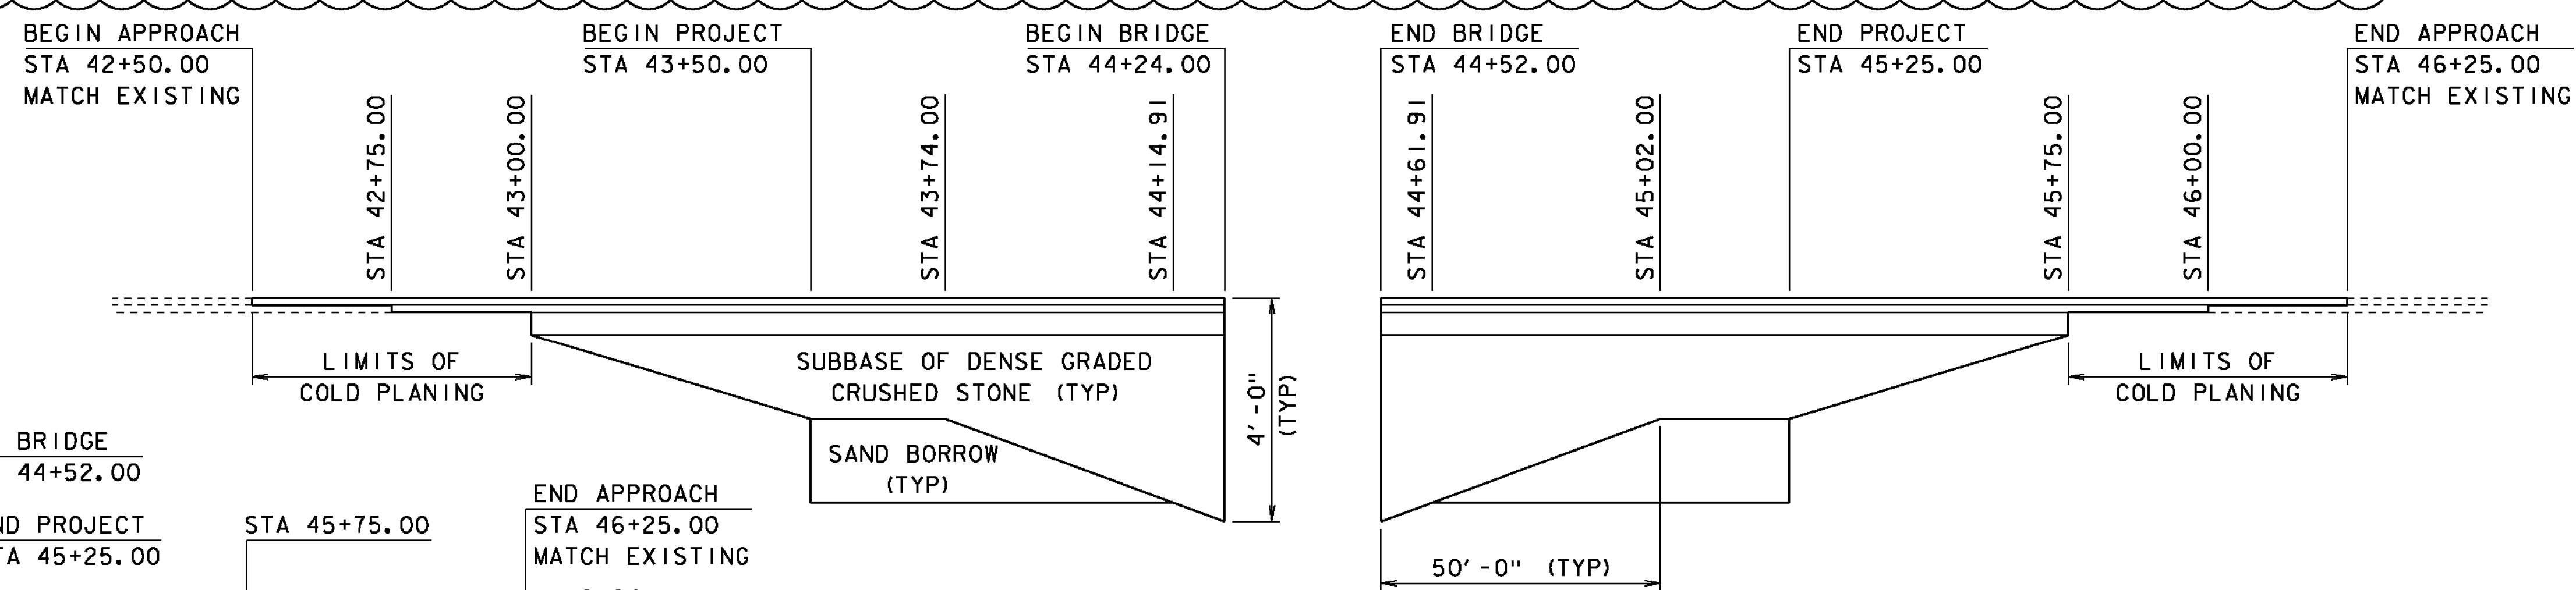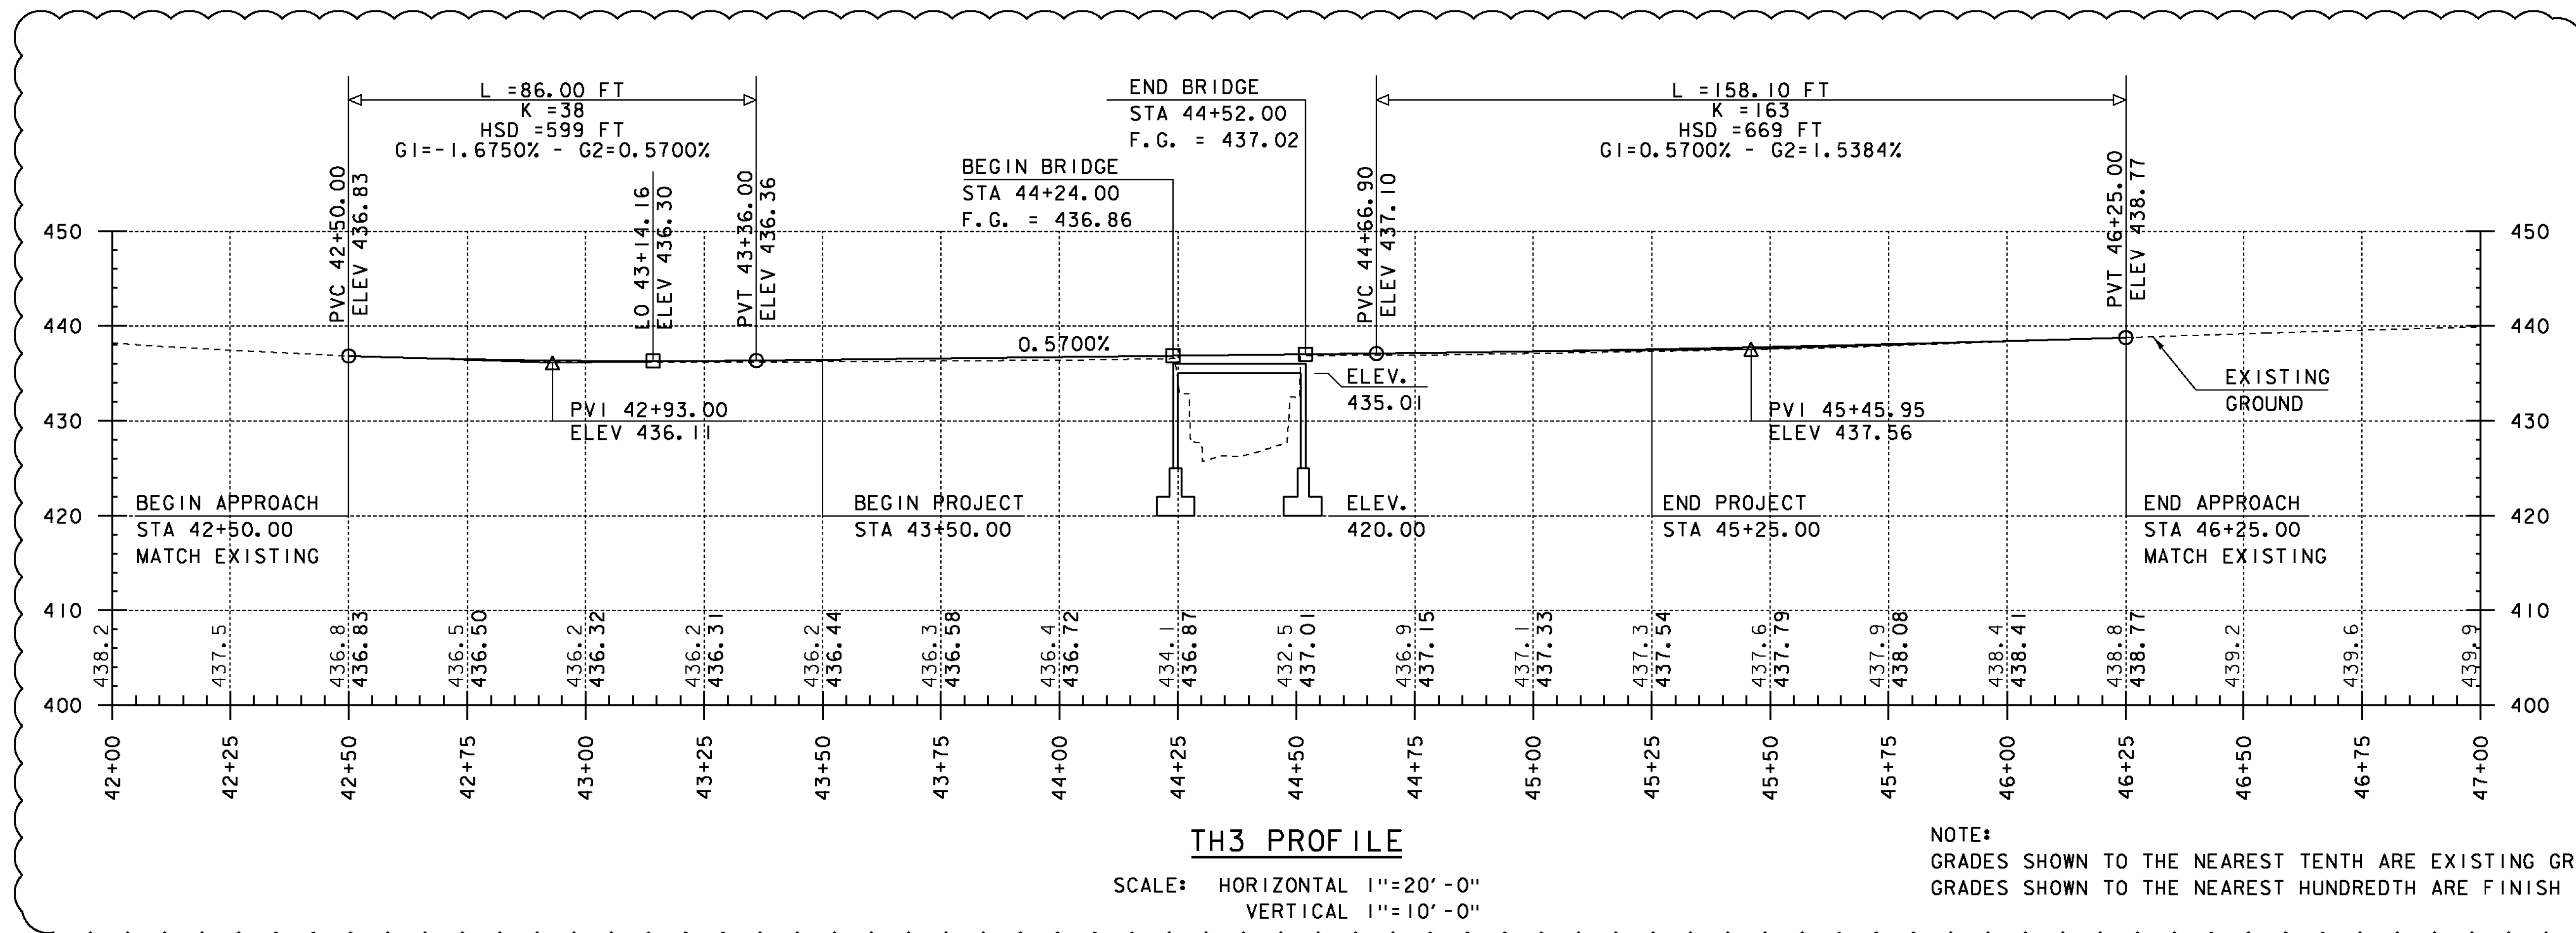

REVISION	DATE	DESCRIPTION	BY
1	06-03-2015	RAISED THE GRADE 2' OVER BRIDGE SAG CURVE REMOVED TANGENT ADDED	MCL

PROJECT NAME:	RICHFORD	FILE NAME:	sl2j158pro.dgn	PLOT DATE:	03-JUN-2015
PROJECT NUMBER:	BRF 0302(29)	PROJECT LEADER:	C. CARLSON	DRAWN BY:	R. PELLETT
		DESIGNED BY:	H. SALLS	CHECKED BY:	H. SALLS
		TH 3 PROFILE AND TRANSITION DIAGRAMS		SHEET	11 OF 36




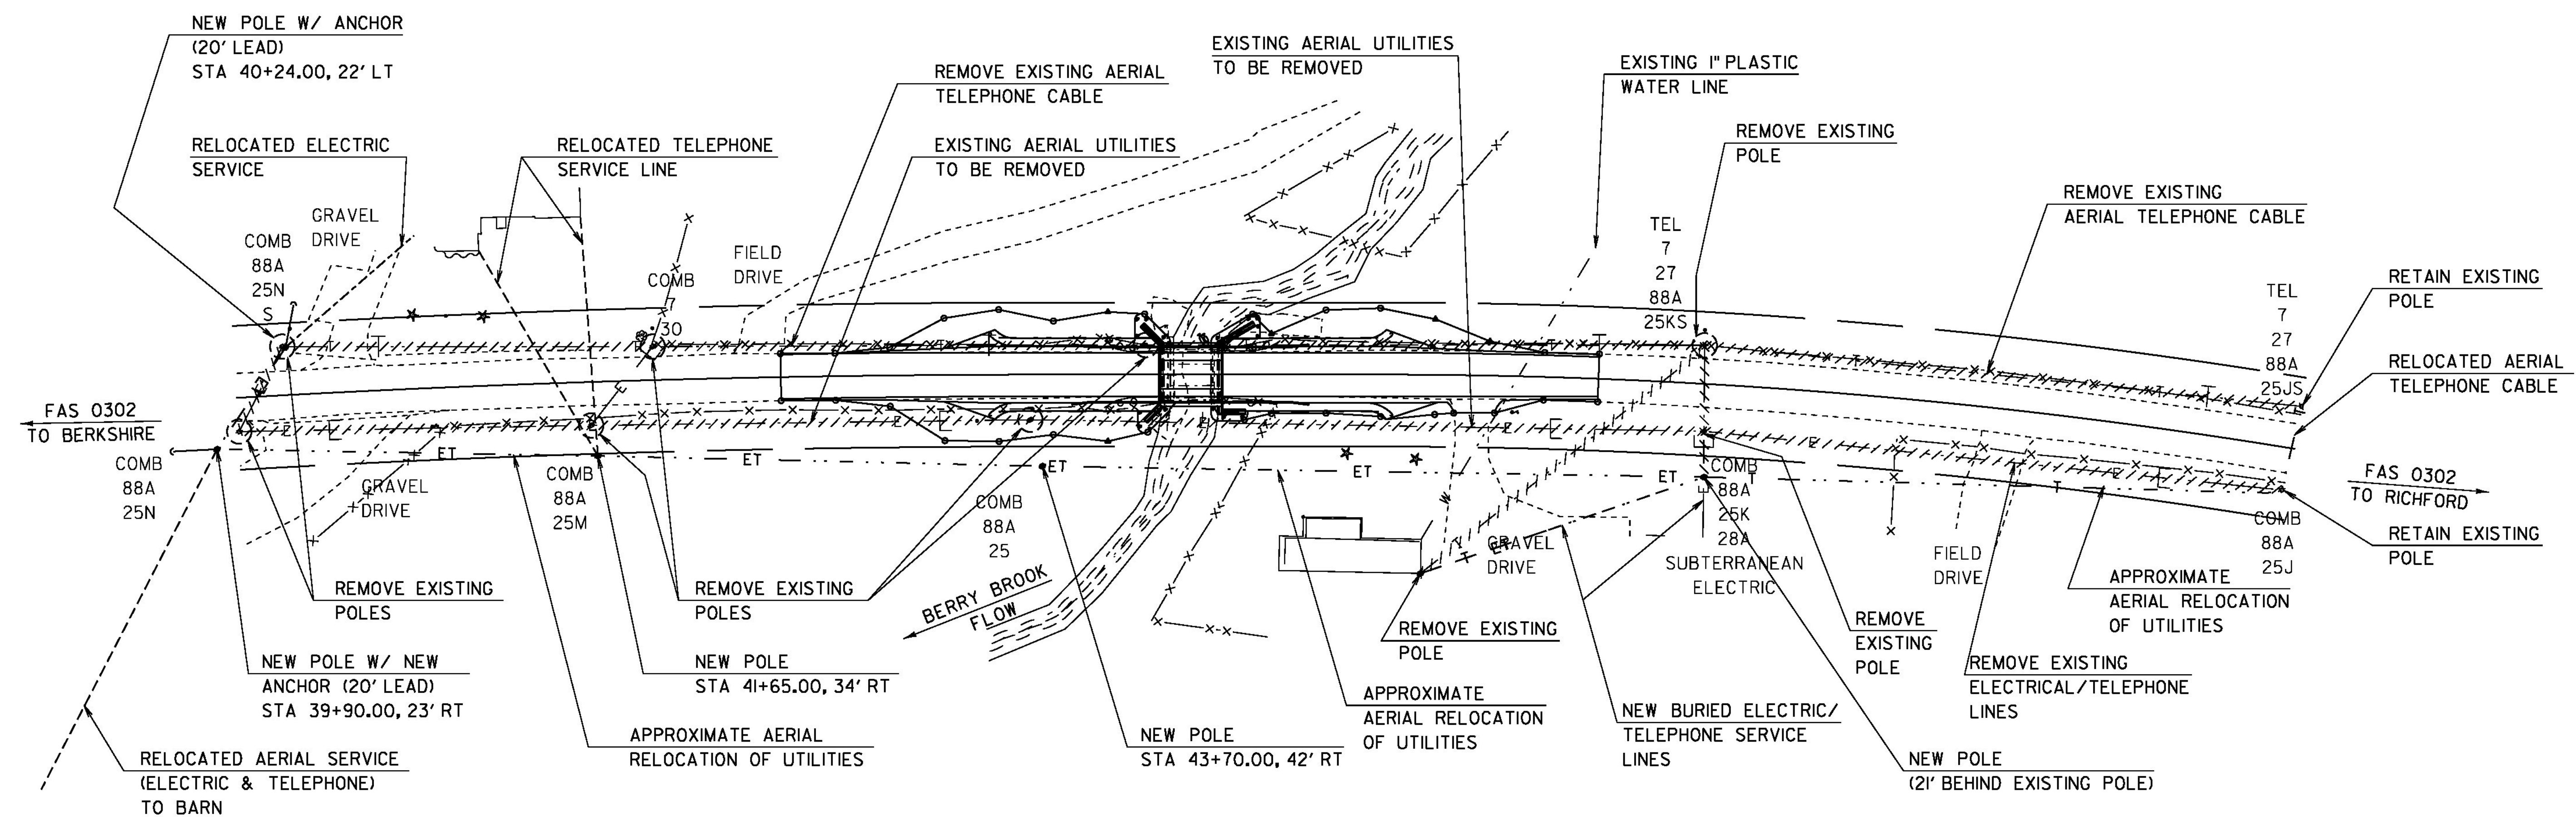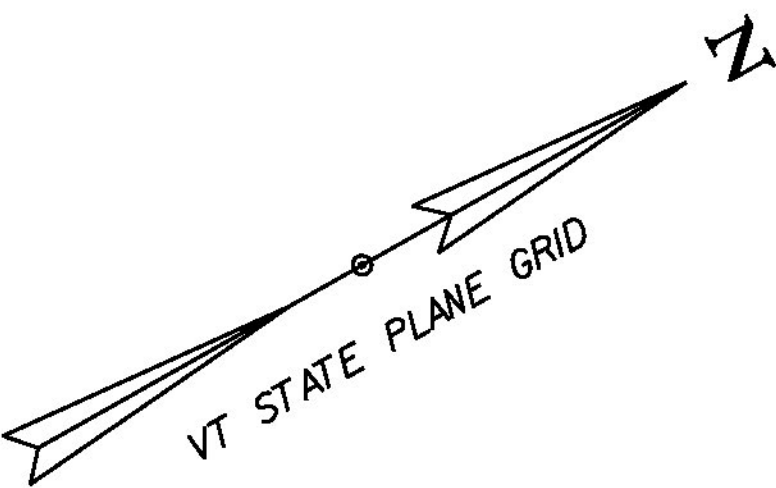


**NOTE:**

I. ALL UTILITY RELOCATION, REMOVAL AND NEW LINES AND POLES SHALL BE PERFORMED/INSTALLED BY THE UTILITY COMPANY OR A CONTRACTOR CONTRACTED BY THE UTILITY COMPANY TO PERFORM THE REQUIRED WORK. SEE THE UTILITY SPECIAL PROVISIONS FOR ADDITIONAL INFORMATION AND REQUIREMENTS.

PROJECT NAME: RICHFORD	
PROJECT NUMBER: BRF 0302(29)	
FILE NAME: sl2j158bdrutil.dgn	PLOT DATE: 11-DEC-2014
PROJECT LEADER: C. CARLSON	DRAWN BY: M. LONGSTREET
DESIGNED BY: H. SALLS	CHECKED BY: L. WHEELER
UTILITY LAYOUT	SHEET 12 OF 36

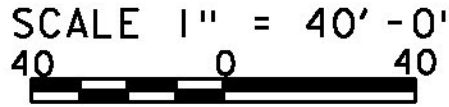




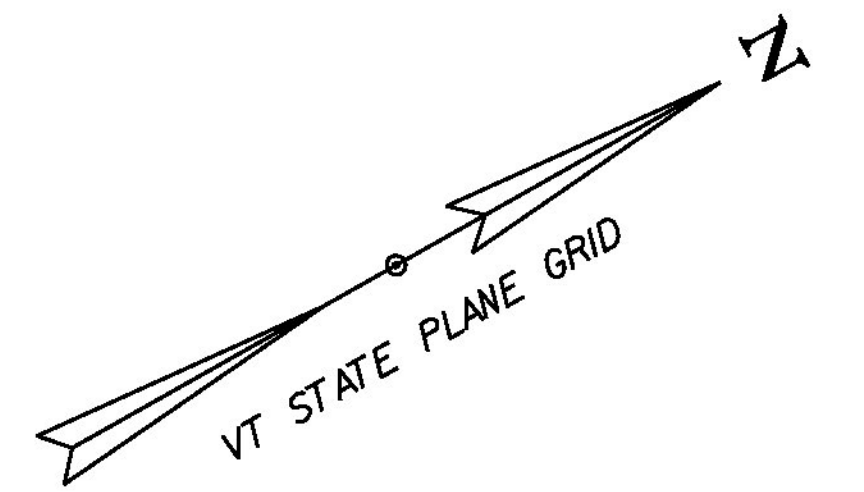

**REMOVING SIGNS**  
STA 41+80.52 RT  
STA 44+24.38 RT & LT  
STA 44+52.03 RT & LT  
STA 49+17.22 LT

**4 INCH YELLOW LINE**  
STA 42+50.00 - 46+25.00 CL

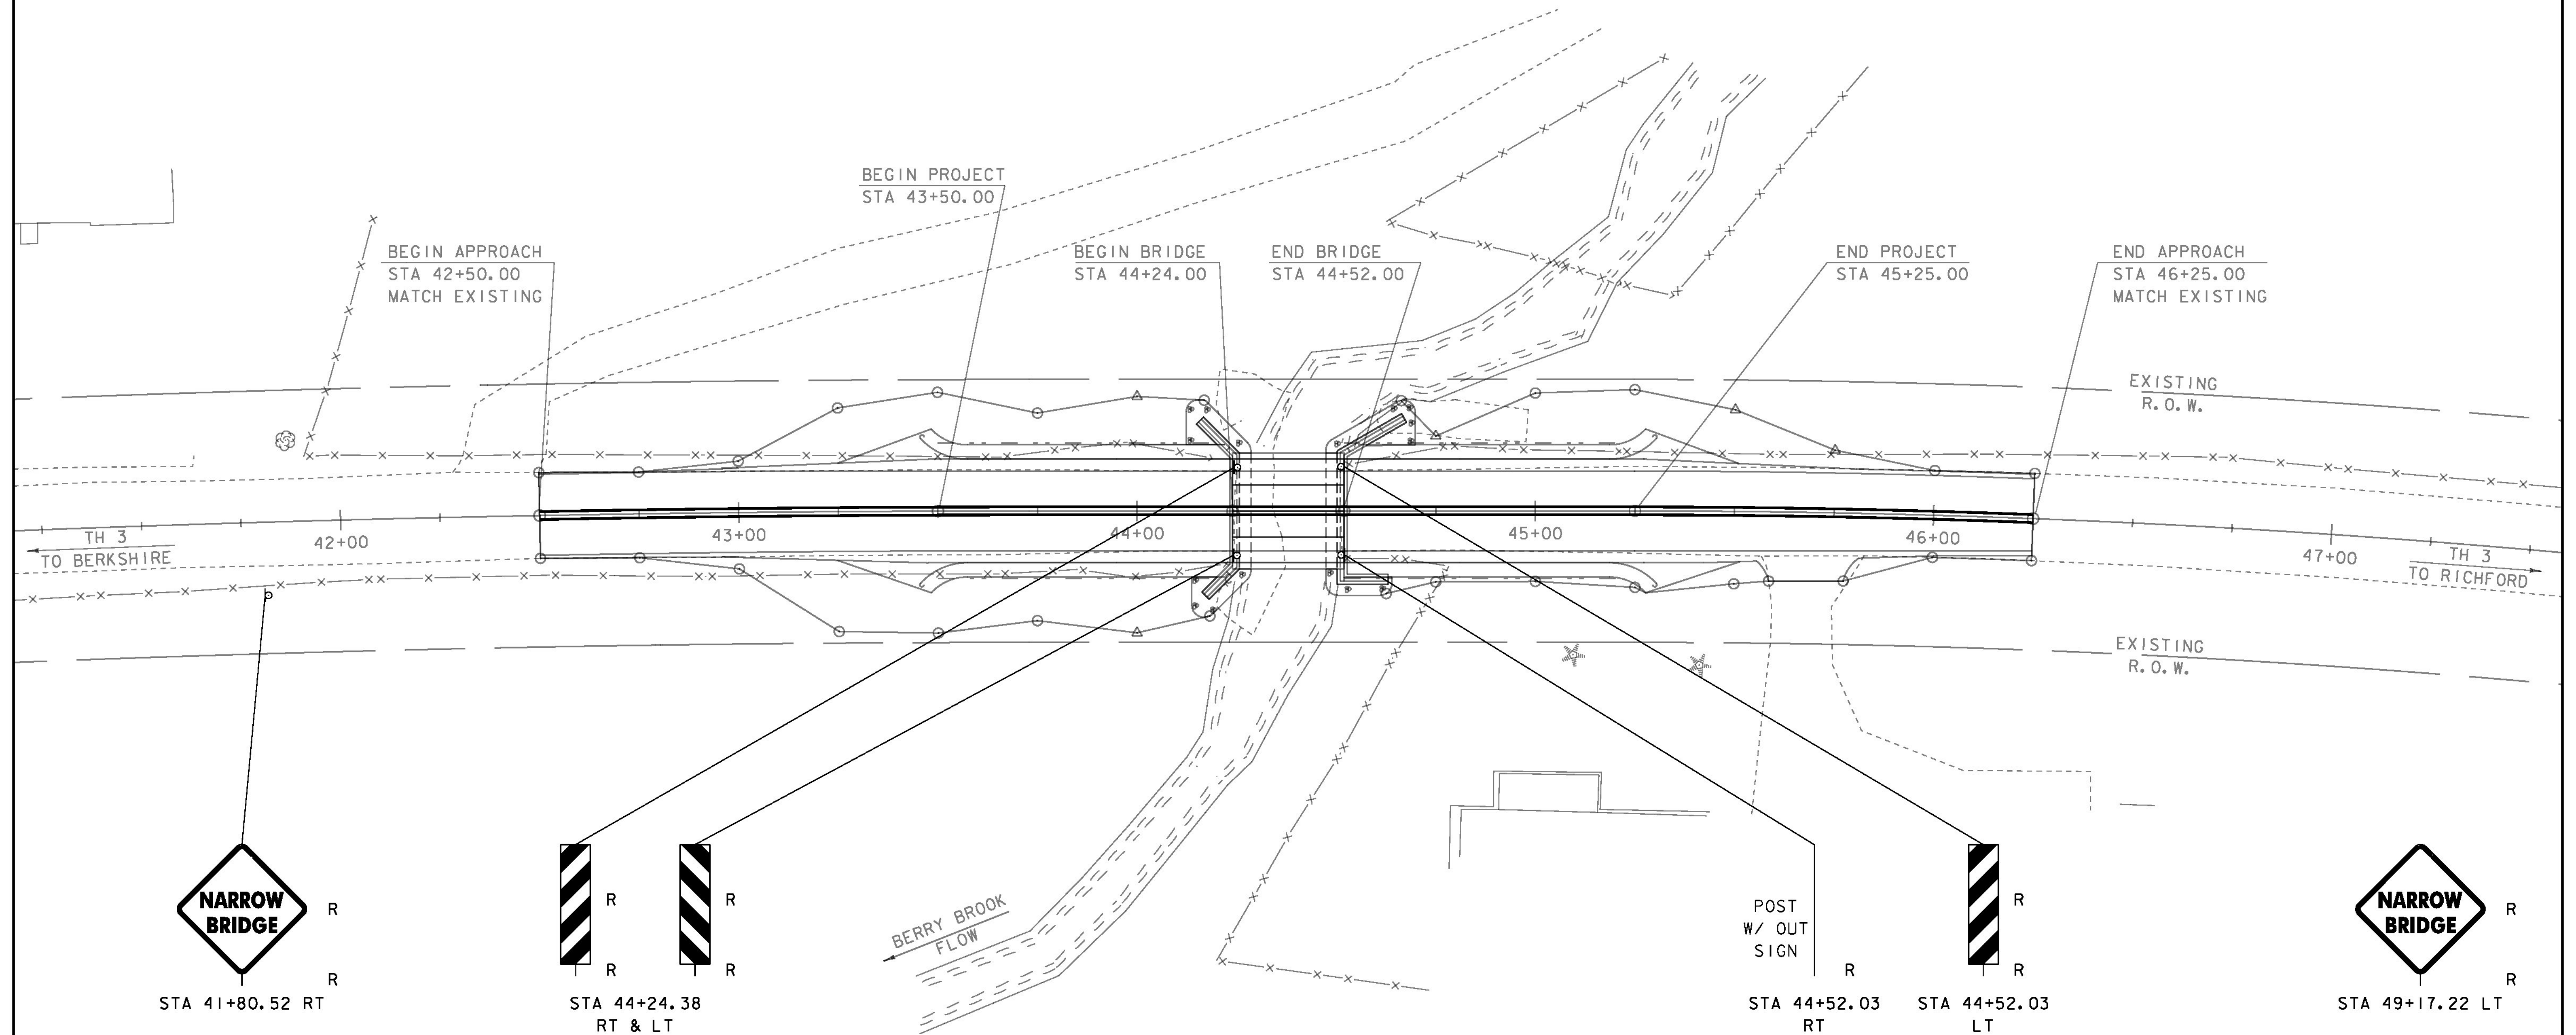

**LEGEND**  
R - REMOVE

SCALE 1" = 20' - 0"  
20 0 20

PROJECT NAME: RICHFORD	
PROJECT NUMBER: BRF 0302(29)	
FILE NAME: sl2j158bdrsign.dgn	PLOT DATE: 06-JAN-2015
PROJECT LEADER: C. CARLSON	DRAWN BY: R. PELLETT
DESIGNED BY: H. SALLS	CHECKED BY: H. SALLS
SIGNS & PAVEMENT MARKING LAYOUT	SHEET 13 OF 36



SOIL CLASSIFICATION

AASHTO	
A1	Gravel and Sand
A3	Fine Sand
A2	Silty or Clayey Gravel and Sand
A4	Silty Soil - Low Compressibility
A5	Silty Soil - Highly Compressible
A6	Clayey Soil - Low Compressibility
A7	Clayey Soil - Highly Compressible

ROCK QUALITY DESIGNATION

R.Q.D. (%)	ROCK DESCRIPTION
<25	Very Poor
25 to 50	Poor
51 to 75	Fair
76 to 90	Good
>90	Excellent

SHEAR STRENGTH

UNDRAINED SHEAR STRENGTH IN P.S.F.	CONSISTENCY
<250	Very Soft
250-500	Soft
500-1000	Med. Stiff
1000-2000	Stiff
2000-4000	Very Stiff
>4000	Hard



CORRELATION GUIDE OF "N" TO DENSITY/CONSISTENCY

DENSITY (GRANULAR SOILS)		CONSISTENCY (COHESIVE SOILS)	
N	DESCRIPTIVE TERM	N	DESCRIPTIVE TERM
<5	Very Loose	<2	Very Soft
5-10	Loose	2-4	Soft
11-24	Med. Dense	5-8	Med. Stiff
25-50	Dense	9-15	Stiff
>50	Very Dense	16-30	Very Stiff
		31-60	Hard
		>60	Very Hard

COMMONLY USED SYMBOLS

▼	Water Elevation
⊕	Standard Penetration Boring
⊕	Auger Boring
⊙	Rod Sounding
S	Sample
N	Standard Penetration Test Blow Count Per Foot For: 2" O.D. Sampler 1 3/8" I.D. Sampler Hammer Weight Of 140 Lbs. Hammer Fall Of 30"
VS	Field Vane Shear Test
US	Undisturbed Soil Sample
B	Blast
DC	Diamond Core
MD	Mud Drill
WA	Wash Ahead
HSA	Hollow Stem Auger
AX	Core Size 1 1/8"
BX	Core Size 1 3/8"
NX	Core Size 2 1/8"
M	Double Tube Core Barrel Used
LL	Liquid Limit
PL	Plastic Limit
PI	Plasticity Index
NP	Non Plastic
w	Moisture Content (Dry Wgt. Basis)
D	Dry
M	Moist
MTW	Moist To Wet
W	Wet
Sat	Saturated
Bo	Boulder
Gr	Gravel
Sa	Sand
Si	Silt
Cl	Clay
HP	Hardpan
Le	Ledge
NLTD	No Ledge To Depth
CNPF	Can Not Penetrate Further
TLOB	Top of Ledge Or Boulder
NR	No Recovery
Rec.	Recovery
%Rec.	Percent Recovery
ROD	Rock Quality Designation
CBR	California Bearing Ratio
<	Less Than
>	Greater Than
R	Refusal (N > 100)
VTSPG	NAD83 - See Note 7

COLOR			
blk	Black	pnk	Pink
bl	Blue	pu	Purple
brn	Brown	rd	Red
dk	Dark	tn	Tan
gry	Gray	wh	White
gn	Green	yel	Yellow
lt	Light	mltc	Multicolored
or	Orange		

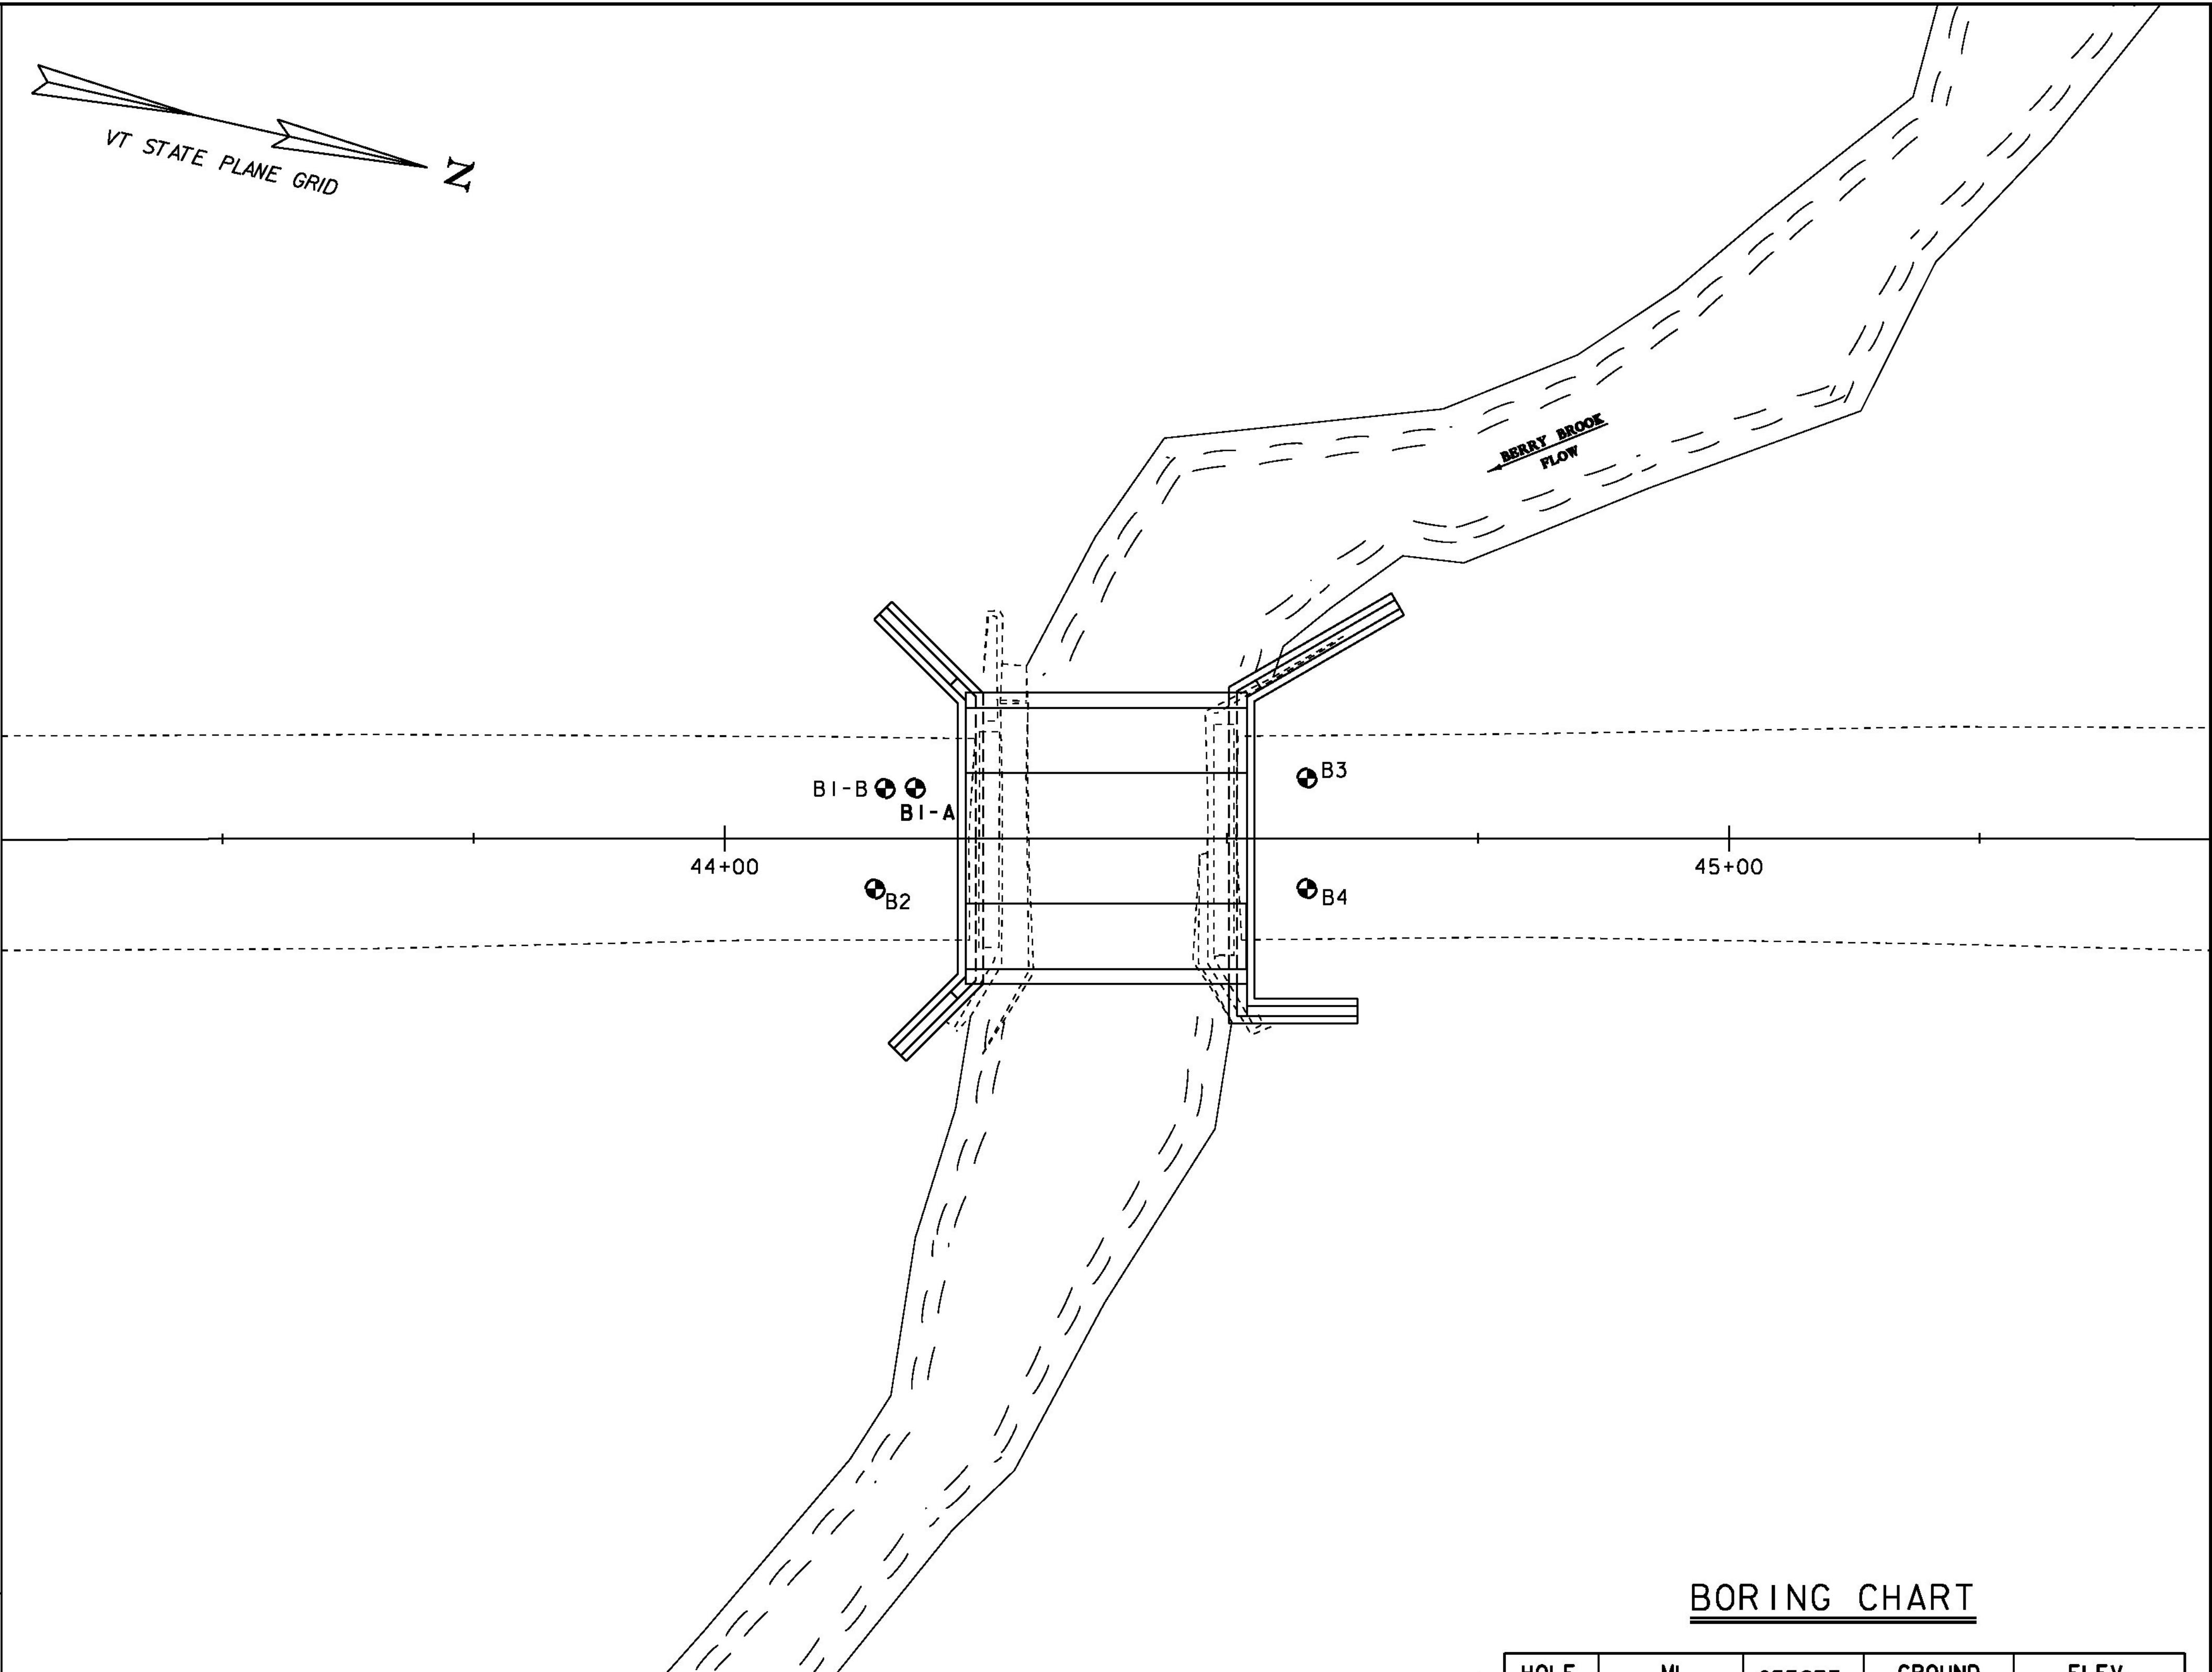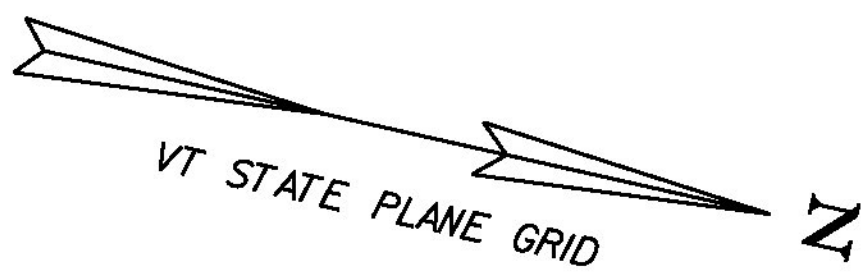

BORING CHART

HOLE NO.	ML STATION	OFFSET	GROUND ELEV.	ELEV. TLOB
B1-A	44+19.00	5' LT	436.50	395.50
B1-B	44+16.00	5' LT	436.50	395.50
B2	44+15.00	5' RT	436.50	396.50
B3	44+58.00	6' LT	437.00	392.00
B4	44+58.00	5' RT	437.00	388.00

PROJECT NAME: RICHFORD  
PROJECT NUMBER: BRF 0302(29)

FILE NAME: sl2j158bor.dgn  
PROJECT LEADER: C. CARLSON  
DESIGNED BY: H. SALLS  
BORING INFORMATION

PLOT DATE: 11-DEC-2014  
DRAWN BY: R. PELLETT  
CHECKED BY: H. SALLS  
SHEET 14 OF 36

GENERAL NOTES

- The subsurface explorations shown herein were made between 09/04/2013 and 09/09/2013 by the Agency.
- Soil and rock classifications, properties and descriptions are based on engineering interpretation from available subsurface information by the Agency and may not necessarily reflect actual variations in subsurface conditions that may be encountered between individual boring or sample locations.
- Observed water levels and/or conditions indicated are as recorded at the time of exploration and may vary according to the prevailing rainfall, methods of exploration and other factors.
- Engineering judgment was exercised in preparing the subsurface information presented herein. Analysis and interpretation of subsurface data was performed and interpreted for Agency design and estimating purposes. Presentation of the information in the Contract is intended to provide the Contractor access to the same data available to the Agency. The subsurface information is presented in good faith and is not intended as a substitute for personal investigation, independent interpretation, independent analysis or judgment by the Contractor.
- Pictorial structure details shown on the boring plan layout or soils profile are for illustrative purposes only and may not accurately portray final contract details.
- Terminology used on boring logs to describe the hardness, degree of weathering, and spacing of fractures, joints and other discontinuities in the bedrock is defined in the AASHTO Manual on Subsurface Investigations, 1988.
- Northing and Easting coordinates are shown in Vermont State Plane Grid North American Datum 1983 in meters and survey feet.

DEFINITIONS (AASHTO)

BEDROCK (LEDGE) - Rock in its native location of indefinite thickness.

BOULDER - A rock fragment with an average dimension > 12 inches.

COBBLE - Rock fragments with an average dimension between 3 and 12 inches.

GRAVEL - Rounded particles of rock < 3" and > 0.075" (#10 sieve).

SAND - Particles of rock < 0.075" (#10 sieve) and > 0.0025" (#200 sieve).

SILT - Soil < 0.0025" (#200 sieve), non or slightly plastic and exhibits no strength when air-dried.

CLAY - Fine grained soil, exhibits plasticity when moist and considerable strength when air-dried.

VARVED - Alternate layers of silt and clay.

HARDPAN - Extremely dense soil, cemented layer, not softened when wet.

MUCK - Soft organic soil (containing > 10% organic material).



MOISTURE CONTENT - Weight of water divided by dry weight of soil.

FLOWING SAND - Granular soil so saturated (loose) that it flows into drill casing during extraction of wash rod.

STRIKE - Angle from magnetic north to line of intersection of bed with a horizontal plane.

DIP - Inclination of bed with a horizontal plane.

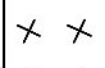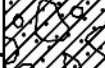

		STATE OF VERMONT AGENCY OF TRANSPORTATION MATERIALS & RESEARCH SECTION SUBSURFACE INFORMATION		BORING LOG		Boring No.: <b>B-1A/B</b>						
				Richford BRF 0302(29) Richford, VT GeoDesign # 750-09.13		Page No.: 1 of 3 Pin No.: 12j158 Checked By: JFW						
Boring Crew: J. Leonhardt (TransTech), A. Baribault (GeoDesign) Date Started: 9/04/13 Date Finished: 9/05/13 VTSPG NAD83: N 909695.07 ft E 1592596.89 ft Station: 44+19 Offset: 5' L Ground Elevation: 436.5 ft				Type: FJ I.D.: 4 in Hammer Wt: 140 lb Hammer Fall: 30 in Hammer/Rod Type: Auto/NWJ Rig: CME 550X ATV C _E = ~1.5		Casing Sampler SS Groundwater Observations (3) Date Depth (ft) Notes 09/04/13 See Note 3.						
Depth (ft)	Strata (1)	CLASSIFICATION OF MATERIALS (Description)	Run (Dip deg.)	Core Rec. % (RQD %)	Drill Rate minutes/ft	Blows/6" (N Value) (2)	Moisture Content %	Gravel %	Sand %	Fines %	LL %	PI %
5		6" Asphalt										
		S1 (0.5' to 2'): Medium dense, brown-gray fine to coarse SAND, little fine Gravel, little Silt, slightly moist. (Fill) Rec. = 1.0 ft (AASHTO M145 Classification: A-1-b.)				16-9-8 (17)	4.2	35.4	49.5	15.1	NP	NP
		S2 (2' to 4'): Medium dense, brown-gray fine to coarse SAND, some fine to coarse Gravel, little Silt, slightly moist. (Fill) Rec. = 1.42 ft (AASHTO M145 Classification: A-1-b.)				4-6-11-11 (17)	7.1	41.4	43.3	15.3	NP	NP
		S3 (4' to 6'): Medium dense, brown fine to coarse SAND and fine to coarse GRAVEL, little Silt, very moist to wet. (Fill) Rec. = 1.17 ft (AASHTO M145 Classification: A-1-b.)				10-9-6-5 (15)	10.2	49.5	35.6	14.9	NP	NP
		S4 (6' to 8'): Loose, brown fine to coarse SAND, some Silt, little fine Gravel, very moist. (Possible Fill) Rec. = 0.83 ft (AASHTO M145 Classification: A-2-4.)				4-5-4-5 (9)	15.7	21.6	49.9	28.5	NP	NP
10		S5 (9' to 11'): Loose, no recovery. Rec. = 0.0 ft				7-4-5-7 (9)						
		S6 (11' to 13'): Medium dense; S6A (Upper 5"): Brown fine to coarse SAND and SILT, trace fine Gravel (concentrated at top of sample), wet. S6B (Lower 3"): Gray SILT, trace fine Sand, wet. (Sand/Silt) Rec. = 0.67 ft (AASHTO M145 Classification: A-4.)	C1			7-6-6-6 (12)	28.7		2.3	97.7	NP	NP
15		C1 (13' to 13.7'): Hard, slightly weathered, gray with white QUARTZITE BOULDER. S7 (14' to 16'): Dense, greenish-gray fine to coarse GRAVEL and SILT, some fine to coarse Sand, moist. (Glacial Till) Rec. = 0.5 ft (AASHTO M145 Classification: A-2-4.) S8 (16' to 18'): Dense, gray fine to coarse SAND, some Silt, some fine Gravel, moist to wet. (Glacial Till) Rec. = 1.17 ft (AASHTO M145 Classification: A-2-4.) S9 (19' to 19.3'): Refusal, gray SILT, some fine to coarse Sand, some fine to coarse Gravel (fractured), wet. (Glacial Till) Rec. = 0.25 ft (AASHTO M145 Classification: A-4.) S10 (21' to 21.2'): Refusal, gray fine to coarse GRAVEL, some fine to coarse Sand, little Silt, wet. (Glacial Till) Rec. = 0.17 ft (AASHTO M145 Classification: A-1-b.)				16-18-20-24 (38) 9-19-19-16 (38) 80/3" (R) 80/2" (R)	10.5 10.4 8.5 7.5	48.1 39.0 38.4 63.1	17.5 31.5 23.4 20.0	34.4 29.5 38.2 16.9	NP NP NP NP	NP NP NP NP
25		S11 (24' to 24.5'): Refusal, gray SILT and fine to coarse SAND, trace fine Gravel, moist. (Glacial Till) Rec. = 0.5 ft (AASHTO M145 Classification: A-4.) S12 (29' to 29.5'): Refusal, gray SILT and fine to coarse SAND, little fine Gravel, moist. (Glacial Till) Rec. = 0.5 ft				100/6" (R) 100/6" (R)	8.5 9.0	14.9 18.1	31.7 29.9	53.4 52.0	NP NP	NP NP
Notes: 1. Stratification lines represent approximate boundary between material types. Transition may be gradual. 2. N Values have not been corrected for hammer energy. C _E is the hammer energy correction factor. 3. Water level readings have been made at times and under conditions stated. Fluctuations of groundwater may occur due to other factors than those present at the time measurements were made.												

BOTTOM OF  
FOOTING  
ELEV 420.00

GEODESIGN BORING LOG 750-09.13 RICHFORD VTTRANS.GPJ VERMONT AOT.GDT 10/9/13

		STATE OF VERMONT AGENCY OF TRANSPORTATION MATERIALS & RESEARCH SECTION SUBSURFACE INFORMATION		BORING LOG		Boring No.: <b>B-1A/B</b>						
				Richford BRF 0302(29) Richford, VT GeoDesign # 750-09.13		Page No.: 2 of 3 Pin No.: 12j158 Checked By: JFW						
Boring Crew: J. Leonhardt (TransTech), A. Baribault (GeoDesign) Date Started: 9/04/13 Date Finished: 9/05/13 VTSPG NAD83: N 909695.07 ft E 1592596.89 ft Station: 44+19 Offset: 5' L Ground Elevation: 436.5 ft				Type: FJ I.D.: 4 in Hammer Wt: 140 lb Hammer Fall: 30 in Hammer/Rod Type: Auto/NWJ Rig: CME 550X ATV C _E = ~1.5		Casing Sampler SS Groundwater Observations (3) Date Depth (ft) Notes 09/04/13 See Note 3.						
Depth (ft)	Strata (1)	CLASSIFICATION OF MATERIALS (Description)	Run (Dip deg.)	Core Rec. % (RQD %)	Drill Rate minutes/ft	Blows/6" (N Value) (2)	Moisture Content %	Gravel %	Sand %	Fines %	LL %	PI %
35		(AASHTO M145 Classification: A-4.)										
		S13 (34' to 35'): Refusal, gray fine to coarse SAND and SILT, little fine Gravel, wet. (Glacial Till) Rec. = 0.83 ft (AASHTO M145 Classification: A-4.)				58-100/5.5" (R)	12.2	18.0	46.3	35.7	NP	NP
		S14 (39' to 39.4'): Refusal, gray and greenish gray fine to coarse SAND and SILT, some fine Gravel, wet. Approximately 2" in spoon shoe of possible weathered bedrock. (Glacial Till) Rec. = 0.42 ft (AASHTO M145 Classification: A-2-4.)				100/5" (R)	11.8	35.2	30.4	34.4	NP	NP
40		Inferred Weathered Bedrock C2 (41' to 46'): Poor quality, gray-greenish gray, moderately hard, fine grained, moderately weathered PHYLLITE interbedded with Quartz, fracture angle approximately 45 to 90 degrees.	C2	93 (48)	3.5 5 4 5.5 6.5							
45		C3 (46' to 51'): Poor quality, greenish gray, moderately hard, fine grained, moderately weathered PHYLLITE, fracture angle approximately 60 to 80 degrees.	C3	87 (47)	4 5 6 6 8							
50		Hole stopped @ 51.0 ft B-1A abandoned; B-1B end of Core										
55		Remarks: 1) Hammer efficiency correction factor is assumed. Elevation, station and offset are estimated by GeoDesign from site plans provided by VTrans and taped measurements from existing features made in the field by GeoDesign personnel. They should be considered accurate only to the degree implied by the method of location used. 2) Sample S2 not performed in accordance with ASTM D1586, (sampled immediately after sample S1 without clearing the borehole with the roller bit) 3) Soil moisture descriptions may not accurately depict actual conditions due to wash and drive drilling methods. Wash water observed to be brown in color to approximately 11' deep, then turning gray by 13' deep. 4) Cored through a boulder from 13' to 13.7' deep. Lost water upon breaking through. Casing became out of alignment while attempting to drive through boulder. Abandoned location and moved to B-1B, offset 3.5' south/west. (approximate STA 44+16, 5' L)										
Notes: 1. Stratification lines represent approximate boundary between material types. Transition may be gradual. 2. N Values have not been corrected for hammer energy. C _E is the hammer energy correction factor. 3. Water level readings have been made at times and under conditions stated. Fluctuations of groundwater may occur due to other factors than those present at the time measurements were made.												

GEODESIGN BORING LOG 750-09.13 RICHFORD VTTRANS.GPJ VERMONT AOT.GDT 10/9/13

PROJECT NAME: RICHFORD	
PROJECT NUMBER: BRF 0302(29)	
FILE NAME: sl2j158bor.dgn	PLOT DATE: 11-DEC-2014
PROJECT LEADER: C. CARLSON	DRAWN BY: R. PELLETT
DESIGNED BY: H. SALLS	CHECKED BY: H. SALLS
BORING LOGS I	SHEET 15 OF 36



		STATE OF VERMONT AGENCY OF TRANSPORTATION MATERIALS & RESEARCH SECTION SUBSURFACE INFORMATION		BORING LOG		Boring No.: <b>B-1A/B</b>							
				Richford BRF 0302(29) Richford, VT GeoDesign # 750-09.13		Page No.: 3 of 3							
						Pin No.: 12j158							
						Checked By: JFW							
Boring Crew: J. Leonhardt (TransTech), A. Baribault (GeoDesign)				Casing		Sampler		Groundwater Observations ⁽³⁾					
Date Started: 9/04/13    Date Finished: 9/05/13				Type: FJ		SS		Date					
VTSPG NAD83: N 909695.07 ft    E 1592596.89 ft				I.D.: 4 in		2 in		Depth (ft)					
Station: 44+19    Offset: 5' L				Hammer Wt: 140 lb.		140 lb.		Notes					
Ground Elevation: 436.5 ft				Hammer Fall: 30 in.		30 in.		09/04/13    See Note 3.					
				Hammer/Rod Type: Auto/NWJ									
				Rig: CME 550X ATV		C _E = ~1.5							
Depth (ft)	Strata ⁽¹⁾	CLASSIFICATION OF MATERIALS (Description)		Run (Dip deg.)	Core Rec. % (RQD %)	Drill Rate minutes/ft	Blows/ft ⁽²⁾ (N Value)	Moisture Content %	Gravel %	Sand %	Fines %	LL %	PI %
65		5) Advanced casing in B-1B to 14' deep prior to continuing with soil sampling. 6) Noted occasional roller bit grinding/chatter below 18' deep, on inferred gravel. 7) Encountered inferred weathered bedrock at approximately 39.2' deep based on split spoon resistance. Roller bit penetration slowed to approximately 1 inch in 5 minutes at approximately 41' deep on inferred top of competent rock. Began rock core at 41' deep. 8) Used reduced drilling RPM and pressure for entire rock core. Encountered oscillations of drill string below 48' deep, most pronounced from 50' to 51' deep, where driller had to pause every 10 to 30 seconds to correct. 9) Grouted borehole with 1 bag portland cement, 1/2 bag bentonite powder, and 40 gallons water. Topped off borehole with approximately 3 inches of cold patch asphalt at the ground surface. 10) All visual descriptions are per the Burmister classification system. All lab gradations are per the AASHTO M 145 classification system.											
70													
75													
80													
85													
Notes:		1. Stratification lines represent approximate boundary between material types. Transition may be gradual. 2. N Values have not been corrected for hammer energy. C _E is the hammer energy correction factor. 3. Water level readings have been made at times and under conditions stated. Fluctuations of groundwater may occur due to other factors than those present at the time measurements were made.											

GEODESIGN BORING LOG 750-09.13 RICHFORD VTTRANS.GPJ VERMONT AOT.GDT 10/9/13

PROJECT NAME: RICHFORD	
PROJECT NUMBER: BRF 0302(29)	
FILE NAME: sl2j158bor.dgn	PLOT DATE: 11-DEC-2014
PROJECT LEADER: C. CARLSON	DRAWN BY: R. PELLETT
DESIGNED BY: H. SALLS	CHECKED BY: H. SALLS
BORING LOGS 2	SHEET 16 OF 36



BOTTOM OF  
FOOTING  
ELEV 420.00

GEODESIGN BORING LOG 750-09.13 RICHFORD VTRANS.GPJ VERMONT AOT.GDT 10/9/13

PROJECT NAME:	RICHFORD		
PROJECT NUMBER:	BRF 0302(29)		
FILE NAME:	si2j58bor.dgn	PLOT DATE:	11-DEC-2014
PROJECT LEADER:	C. CARLSON	DRAWN BY:	R. PELLETT
DESIGNED BY:	H. SALLS	CHECKED BY:	H. SALLS
BORING LOGS	3	SHEET	17 OF 36







		STATE OF VERMONT AGENCY OF TRANSPORTATION MATERIALS & RESEARCH SECTION SUBSURFACE INFORMATION		BORING LOG		Boring No.: <u>B-3</u>	
				Richford BRF 0302(29) Richford, VT GeoDesign # 750-09.13		Page No.: <u>3 of 3</u>	
						Pin No.: <u>12j158</u>	
						Checked By: <u>JFW</u>	
Boring Crew: J. Leonhardt (TransTech), A. Baribault (GeoDesign)				Casing	Sampler	Groundwater Observations ⁽³⁾	
Date Started: <u>9/05/13</u> Date Finished: <u>9/06/13</u>				Type: <u>FJ</u>	<u>N.A.</u>	Date	Depth (ft)
VTSPG NAD83: <u>N 909729.53 ft E 1592615.18 ft</u>				I.D.: <u>4 in</u>	<u>2 in</u>	09/06/13	9.7
Station: <u>44+58</u> Offset: <u>6' L</u>				Hammer Wt: <u>140 lb.</u>	<u>N.A.</u>	Notes	
Ground Elevation: <u>437 ft</u>				Hammer Fall: <u>30 in.</u>	<u>N.A.</u>	In casing (15 hrs.)	
				Hammer/Rod Type: <u>Auto/NWJ</u>			
				Rig: <u>CME 550X ATV</u>	<u>C_E = ~1.5</u>		
Depth (ft)	Strata ⁽¹⁾	CLASSIFICATION OF MATERIALS (Description)		Run (Dip deg.)	Core Rec. % (RQD %)	Drill Rate minutes/ft	Blows/6" (N Value) ⁽²⁾
							Moisture Content %
							Gravel %
							Sand %
							Fines %
65							
70							
75							
80							
85							
Notes:		1. Stratification lines represent approximate boundary between material types. Transition may be gradual. 2. N Values have not been corrected for hammer energy. C _E is the hammer energy correction factor. 3. Water level readings have been made at times and under conditions stated. Fluctuations of groundwater may occur due to other factors than those present at the time measurements were made.					



		STATE OF VERMONT AGENCY OF TRANSPORTATION MATERIALS & RESEARCH SECTION SUBSURFACE INFORMATION		BORING LOG		Boring No.: <b>B-4</b>							
				Richford BRF 0302(29) Richford, VT GeoDesign # 750-09.13		Page No.: 1 of 3							
						Pin No.: 12j158							
						Checked By: JFW							
Boring Crew: J. Leonhardt (TransTech), A. Baribault (GeoDesign)				Casing		Sampler		Groundwater Observations ⁽³⁾					
Date Started: 9/03/13 Date Finished: 9/04/13				Type: FJ		SS		Date		Depth (ft)		Notes	
VTSPG NAD83: N 909724.13 ft E 1592624.76 ft				I.D.: 4 in		2 in		09/03/13		10.0		Wet sample	
Station: 44+58 Offset: 5' R				Hammer Wt: 140 lb.		140 lb.		09/04/13		9.5		In Casing	
Ground Elevation: 437 ft				Hammer Fall: 30 in.		30 in.							
				Hammer/Rod Type: Auto/NWJ									
				Rig: CME 550X ATV		C _E = ~1.5							
Depth (ft)	Strata ⁽¹⁾	CLASSIFICATION OF MATERIALS (Description)		Run (Dip deg.)	Core Rec. % (RQD %)	Drill Rate minutes/ft	Blows/6" (N Value) ⁽²⁾	Moisture Content %	Gravel %	Sand %	Fines %	LL %	PI %
5		6" Asphalt					8-15-14 (29)	4.7	29.3	51.9	18.8	NP	NP
		S1 (0.5' to 2'): Medium dense, tan fine to coarse SAND, little fine Gravel, little Silt, slightly moist. (Roadbase Fill) Rec. = 1.08 ft (AASHTO M145 Classification: A-1-b.)					11-9-7-6 (16)	8.0	42.5	35.7	21.8	NP	NP
		S2 (2' to 4'): Medium dense, brown fine to coarse SAND, some fine to coarse Gravel, some Silt, moist. (Subbase Fill) Rec. = 1.0 ft (AASHTO M145 Classification: A-1-b.)					3-2-3-2 (5)	16.0	26.1	52.5	21.4	NP	NP
		S3 (4' to 6'): Loose, brown fine to coarse SAND, some Silt, little fine Gravel, moist. (Possible Fill) Rec. = 0.67 ft (AASHTO M145 Classification: A-2-4.)					4-3-1-3 (4)	23.2	8.5	59.4	32.1	NP	NP
10		S4 (6' to 8'): Loose, brown and gray fine to coarse SAND, some Silt, trace fine Gravel, very moist. (Possible Fill) Rec. = 1.08 ft (AASHTO M145 Classification: A-2-4.)					3-3-2-4 (5)	25.1	9.6	4.2	86.2	22	1
		S5 (9' to 11'): Loose, gray SILT, little fine to coarse Sand, trace fine Gravel (concentrated in top of sample), wet. (Silt / Sand) Rec. = 1.17 ft (AASHTO M145 Classification: A-4.)											
15		S6 (11' to 13'): Medium dense, gray SILT, some Clayey Silt, trace fine Sand, wet. (Silt / Sand) Rec. = 1.67 ft (AASHTO M145 Classification: A-4.)					4-6-5-6 (11)	27.9		1.3	98.7	25	6
		S7 (14' to 16'): Loose, gray SILT and Clayey SILT (laminated), trace fine Sand, wet. (Silt / Sand) Rec. = 1.67 ft (AASHTO M145 Classification: A-4.)					3-4-3-3 (7)	28.9		1.0	99.0	24	5
20		S8A ( 16' to 17') - Upper 8" of S8: Medium dense, gray SILT, trace Clayey Silt, trace fine Sand, wet. (Silt / Sand) Rec. = 1.0 ft (AASHTO M145 Classification: A-4.)					3-2-8-10 (10)	27.4		2.7	97.3	22	2
		S8B (17' to 18') - Lower 4" of S8: Medium dense, gray fine to coarse SAND, some Silt, some fine Gravel, wet. (Glacial Till) (AASHTO M145 Classification: A-2-4.)					9.9	41.0	30.6	28.4	NP	NP	
		S9 (19' to 21'): Dense, gray fine to coarse SAND, some fine to coarse Gravel, some Silt, moist to wet. (Glacial Till) Rec. = 1.33 ft (AASHTO M145 Classification: A-2-4.)											
		S10 (21' to 23'): Very dense, gray/green fine to coarse SAND and SILT, some fine Gravel, moist to wet. (Glacial Till) Rec. = 1.25 ft (AASHTO M145 Classification: A-2-4.)					24-29-27-28 (56)	10.0	32.7	32.0	35.3	NP	NP
25		S11 (24' to 24.4'): Refusal, gray SILT and fine to coarse SAND, some fine to coarse Gravel, moist to wet. (Glacial Till) Rec. = 0.42 ft (AASHTO M145 Classification: A-4.)					80/5.5" (R)	9.1	29.7	32.5	37.8	NP	NP
		S12 (29' to 29.4'): Refusal, gray SILT and fine to coarse Sand, trace fine Gravel, moist. (Glacial Till) Rec. = 0.42 ft					80/5.5" (R)	9.7	14.4	33.8	51.8	NP	NP
Notes: 1. Stratification lines represent approximate boundary between material types. Transition may be gradual. 2. N Values have not been corrected for hammer energy. C _E is the hammer energy correction factor. 3. Water level readings have been made at times and under conditions stated. Fluctuations of groundwater may occur due to other factors than those present at the time measurements were made.													

BOTTOM OF  
FOOTING  
ELEV 420.00

GEODESIGN BORING LOG 750-09.13 RICHFORD VTTRANS.GPJ VERMONT AOT.GDT 10/9/13


		STATE OF VERMONT AGENCY OF TRANSPORTATION MATERIALS & RESEARCH SECTION SUBSURFACE INFORMATION		BORING LOG		Boring No.: <b>B-4</b>							
				Richford BRF 0302(29) Richford, VT GeoDesign # 750-09.13		Page No.: 2 of 3							
						Pin No.: 12j158							
						Checked By: JFW							
Boring Crew: J. Leonhardt (TransTech), A. Baribault (GeoDesign)				Casing		Sampler		Groundwater Observations					
Date Started: 9/03/13 Date Finished: 9/04/13				Type: FJ		SS		Date		Depth (ft)		Notes	
VTSPG NAD83: N 909724.13 ft E 1592624.76 ft				I.D.: 4 in		2 in		09/03/13		10.0		Wet sample	
Station: 44+58 Offset: 5' R				Hammer Wt: 140 lb.		140 lb.		09/04/13		9.5		In Casing	
Ground Elevation: 437.0 ft				Hammer Fall: 30 in.		30 in.							
				Hammer/Rod Type: Auto/NWJ									
				Rig: CME 550X ATV		C _E = ~1.5							
Depth (ft)	Strata ⁽¹⁾	CLASSIFICATION OF MATERIALS (Description)		Run (Dip deg.)	Core Rec. % (RQD %)	Drill Rate minutes/ft	Blows/6" (N Value) ⁽²⁾	Moisture Content %	Gravel %	Sand %	Fines %	LL %	PI %
35		(AASHTO M145 Classification: A-4.)					80/4" (R)	9.3	29.0	26.9	44.1	NP	NP
		S13 (34' to 34.3'): Refusal, gray SILT, some fine to coarse Sand, some fine to coarse Gravel (fractured, platelike), moist. (Glacial Till) Rec. = 0.33 ft (AASHTO M145 Classification: A-4.)											
		S14 (39' to 39.2'): Refusal, gray and white SILT, some fine to coarse Gravel, some fine to coarse Sand, moist. (Glacial Till) Rec. = 0.25 ft (AASHTO M145 Classification: A-4.)											
		S15 (44' to 44.2'): Refusal, gray WEATHERED PHYLLITE. C1 (44' to 49'): Very poor quality, gray to greenish-gray, fine-grained weathered to extremely weathered (majority of core washed away) PHYLLITE, fracture angle estimated at 70 to 90 degrees.											
40		S16 (49' to 49.1'): Refusal, gray WEATHERED PHYLLITE with highly weathered zones. C2 (49' to 54'): Fair quality, greenish-gray fine grained, slightly to moderately weathered PHYLLITE, fracture angle approximately 45 to 70 degrees.					100/3" (R)	8.9	36.5	24.0	39.5	NP	NP
		S16 (49' to 49.1'): Refusal, gray WEATHERED PHYLLITE with highly weathered zones. C2 (49' to 54'): Fair quality, greenish-gray fine grained, slightly to moderately weathered PHYLLITE, fracture angle approximately 45 to 70 degrees.											
45		S15 (44' to 44.2'): Refusal, gray WEATHERED PHYLLITE. C1 (44' to 49'): Very poor quality, gray to greenish-gray, fine-grained weathered to extremely weathered (majority of core washed away) PHYLLITE, fracture angle estimated at 70 to 90 degrees.					100/2" (R)						
		S16 (49' to 49.1'): Refusal, gray WEATHERED PHYLLITE with highly weathered zones. C2 (49' to 54'): Fair quality, greenish-gray fine grained, slightly to moderately weathered PHYLLITE, fracture angle approximately 45 to 70 degrees.											
50		S16 (49' to 49.1'): Refusal, gray WEATHERED PHYLLITE with highly weathered zones. C2 (49' to 54'): Fair quality, greenish-gray fine grained, slightly to moderately weathered PHYLLITE, fracture angle approximately 45 to 70 degrees.					100/1" (R)	Top of Bedrock @ 49.0 ft					
		S16 (49' to 49.1'): Refusal, gray WEATHERED PHYLLITE with highly weathered zones. C2 (49' to 54'): Fair quality, greenish-gray fine grained, slightly to moderately weathered PHYLLITE, fracture angle approximately 45 to 70 degrees.											
55		C3 (54' to 59'): Poor quality, greenish-gray fine grained, moderately weathered PHYLLITE, fracturing approximately 70 to 90 degrees.					80 (25)						
		C3 (54' to 59'): Poor quality, greenish-gray fine grained, moderately weathered PHYLLITE, fracturing approximately 70 to 90 degrees.											
Hole stopped @ 59.0 ft													
Notes: 1. Stratification lines represent approximate boundary between material types. Transition may be gradual. 2. N Values have not been corrected for hammer energy. C _E is the hammer energy correction factor. 3. Water level readings have been made at times and under conditions stated. Fluctuations of groundwater may occur due to other factors than those present at the time measurements were made.													

BORING LOG 750-09.13 RICHFORD VTTRANS.GPJ VERMONT AOT.GDT 11/15/13








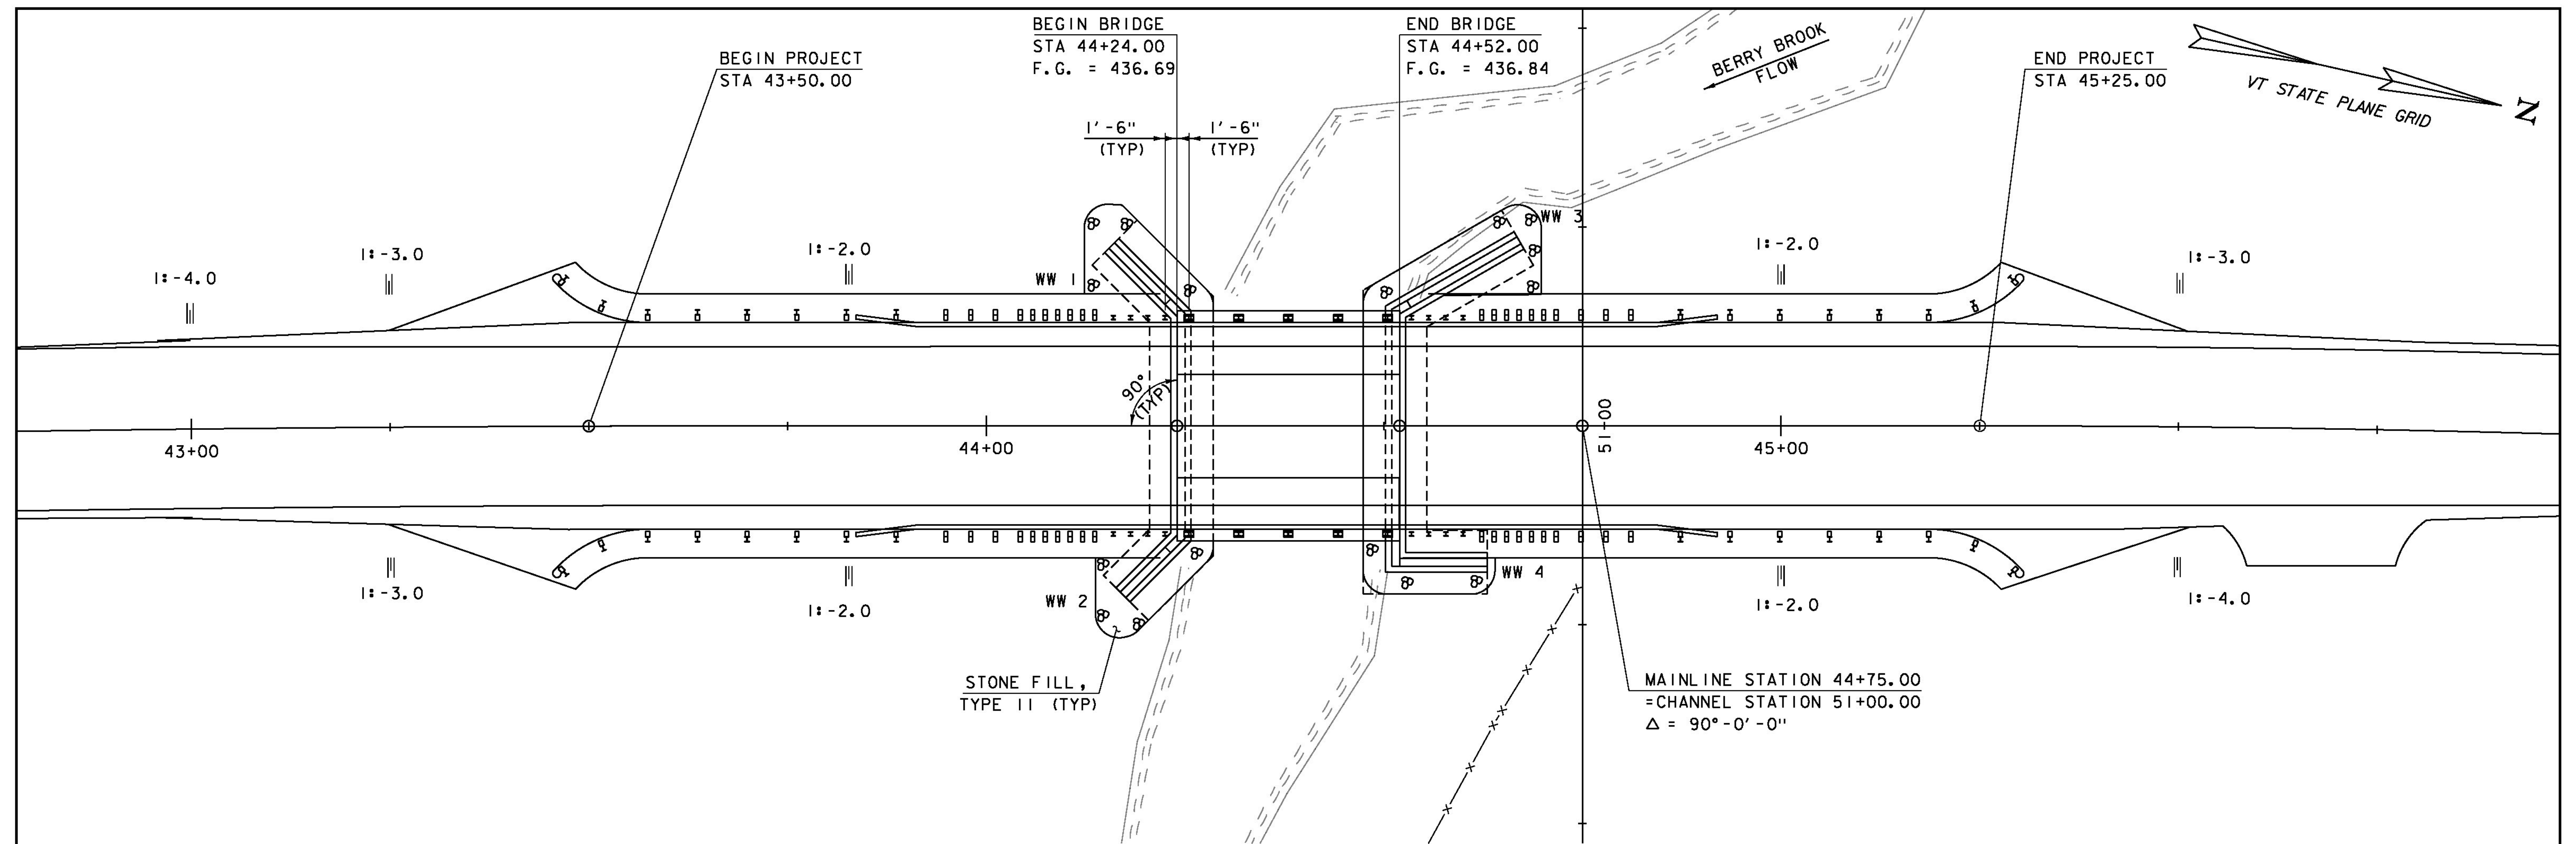

PLAN

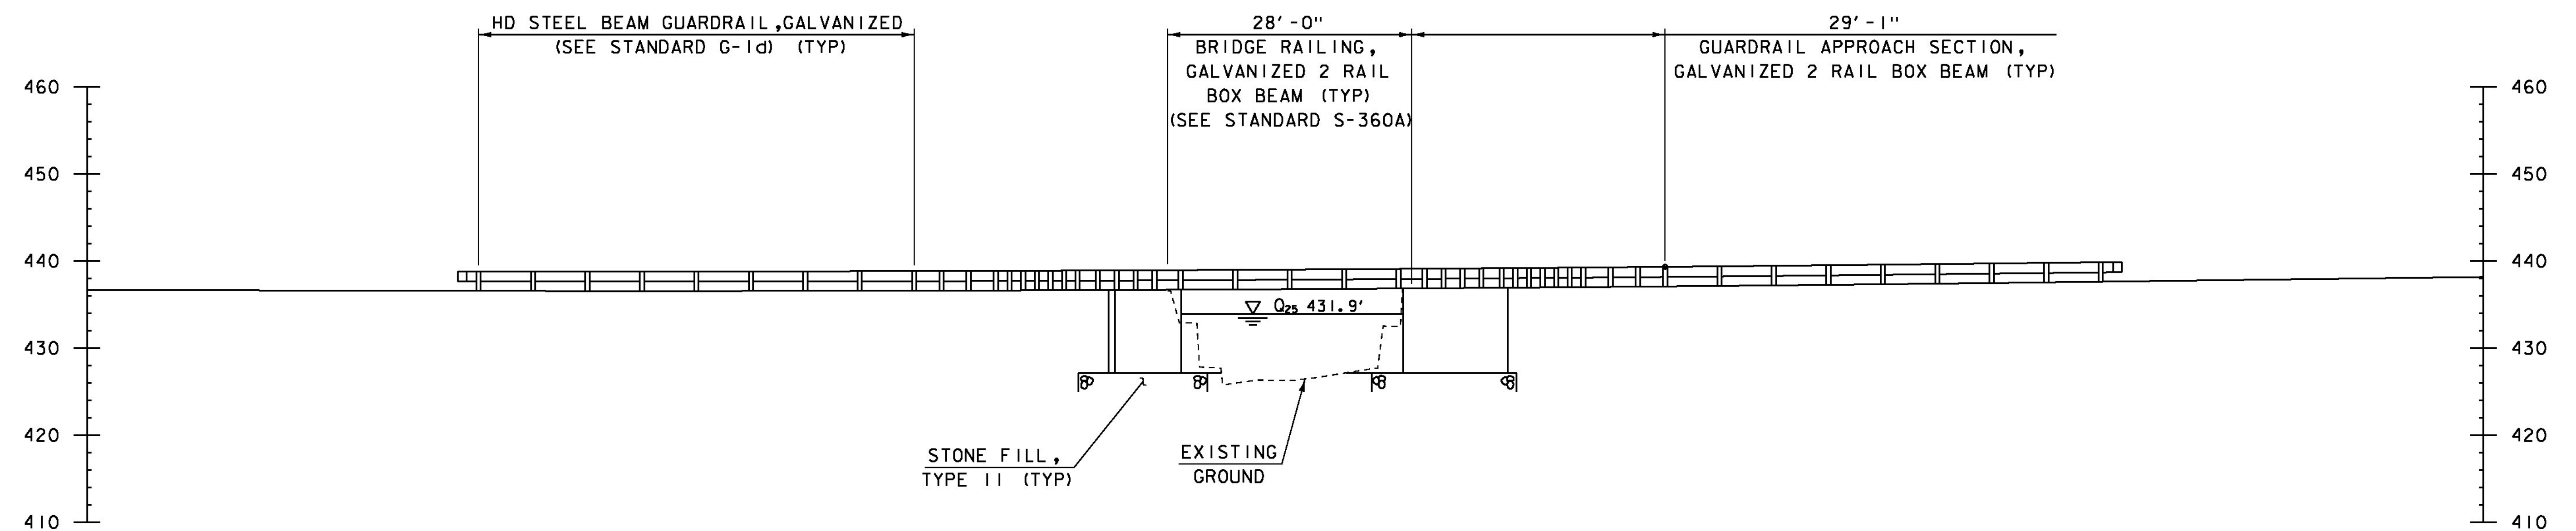


ELEVATION

SCALE 1" = 10'-0"  
 10 0 10


PROJECT NAME:	RICHFORD	PLOT DATE:	11-DEC-2014
PROJECT NUMBER:	BRF 0302(29)	DRAWN BY:	R. PELLETT
FILE NAME:	sl2j158pe.dgn	CHECKED BY:	H. SALLS
PROJECT LEADER:	C. CARLSON	SHEET	22 OF 36
DESIGNED BY:	H. SALLS		
PLAN AND ELEVATION			



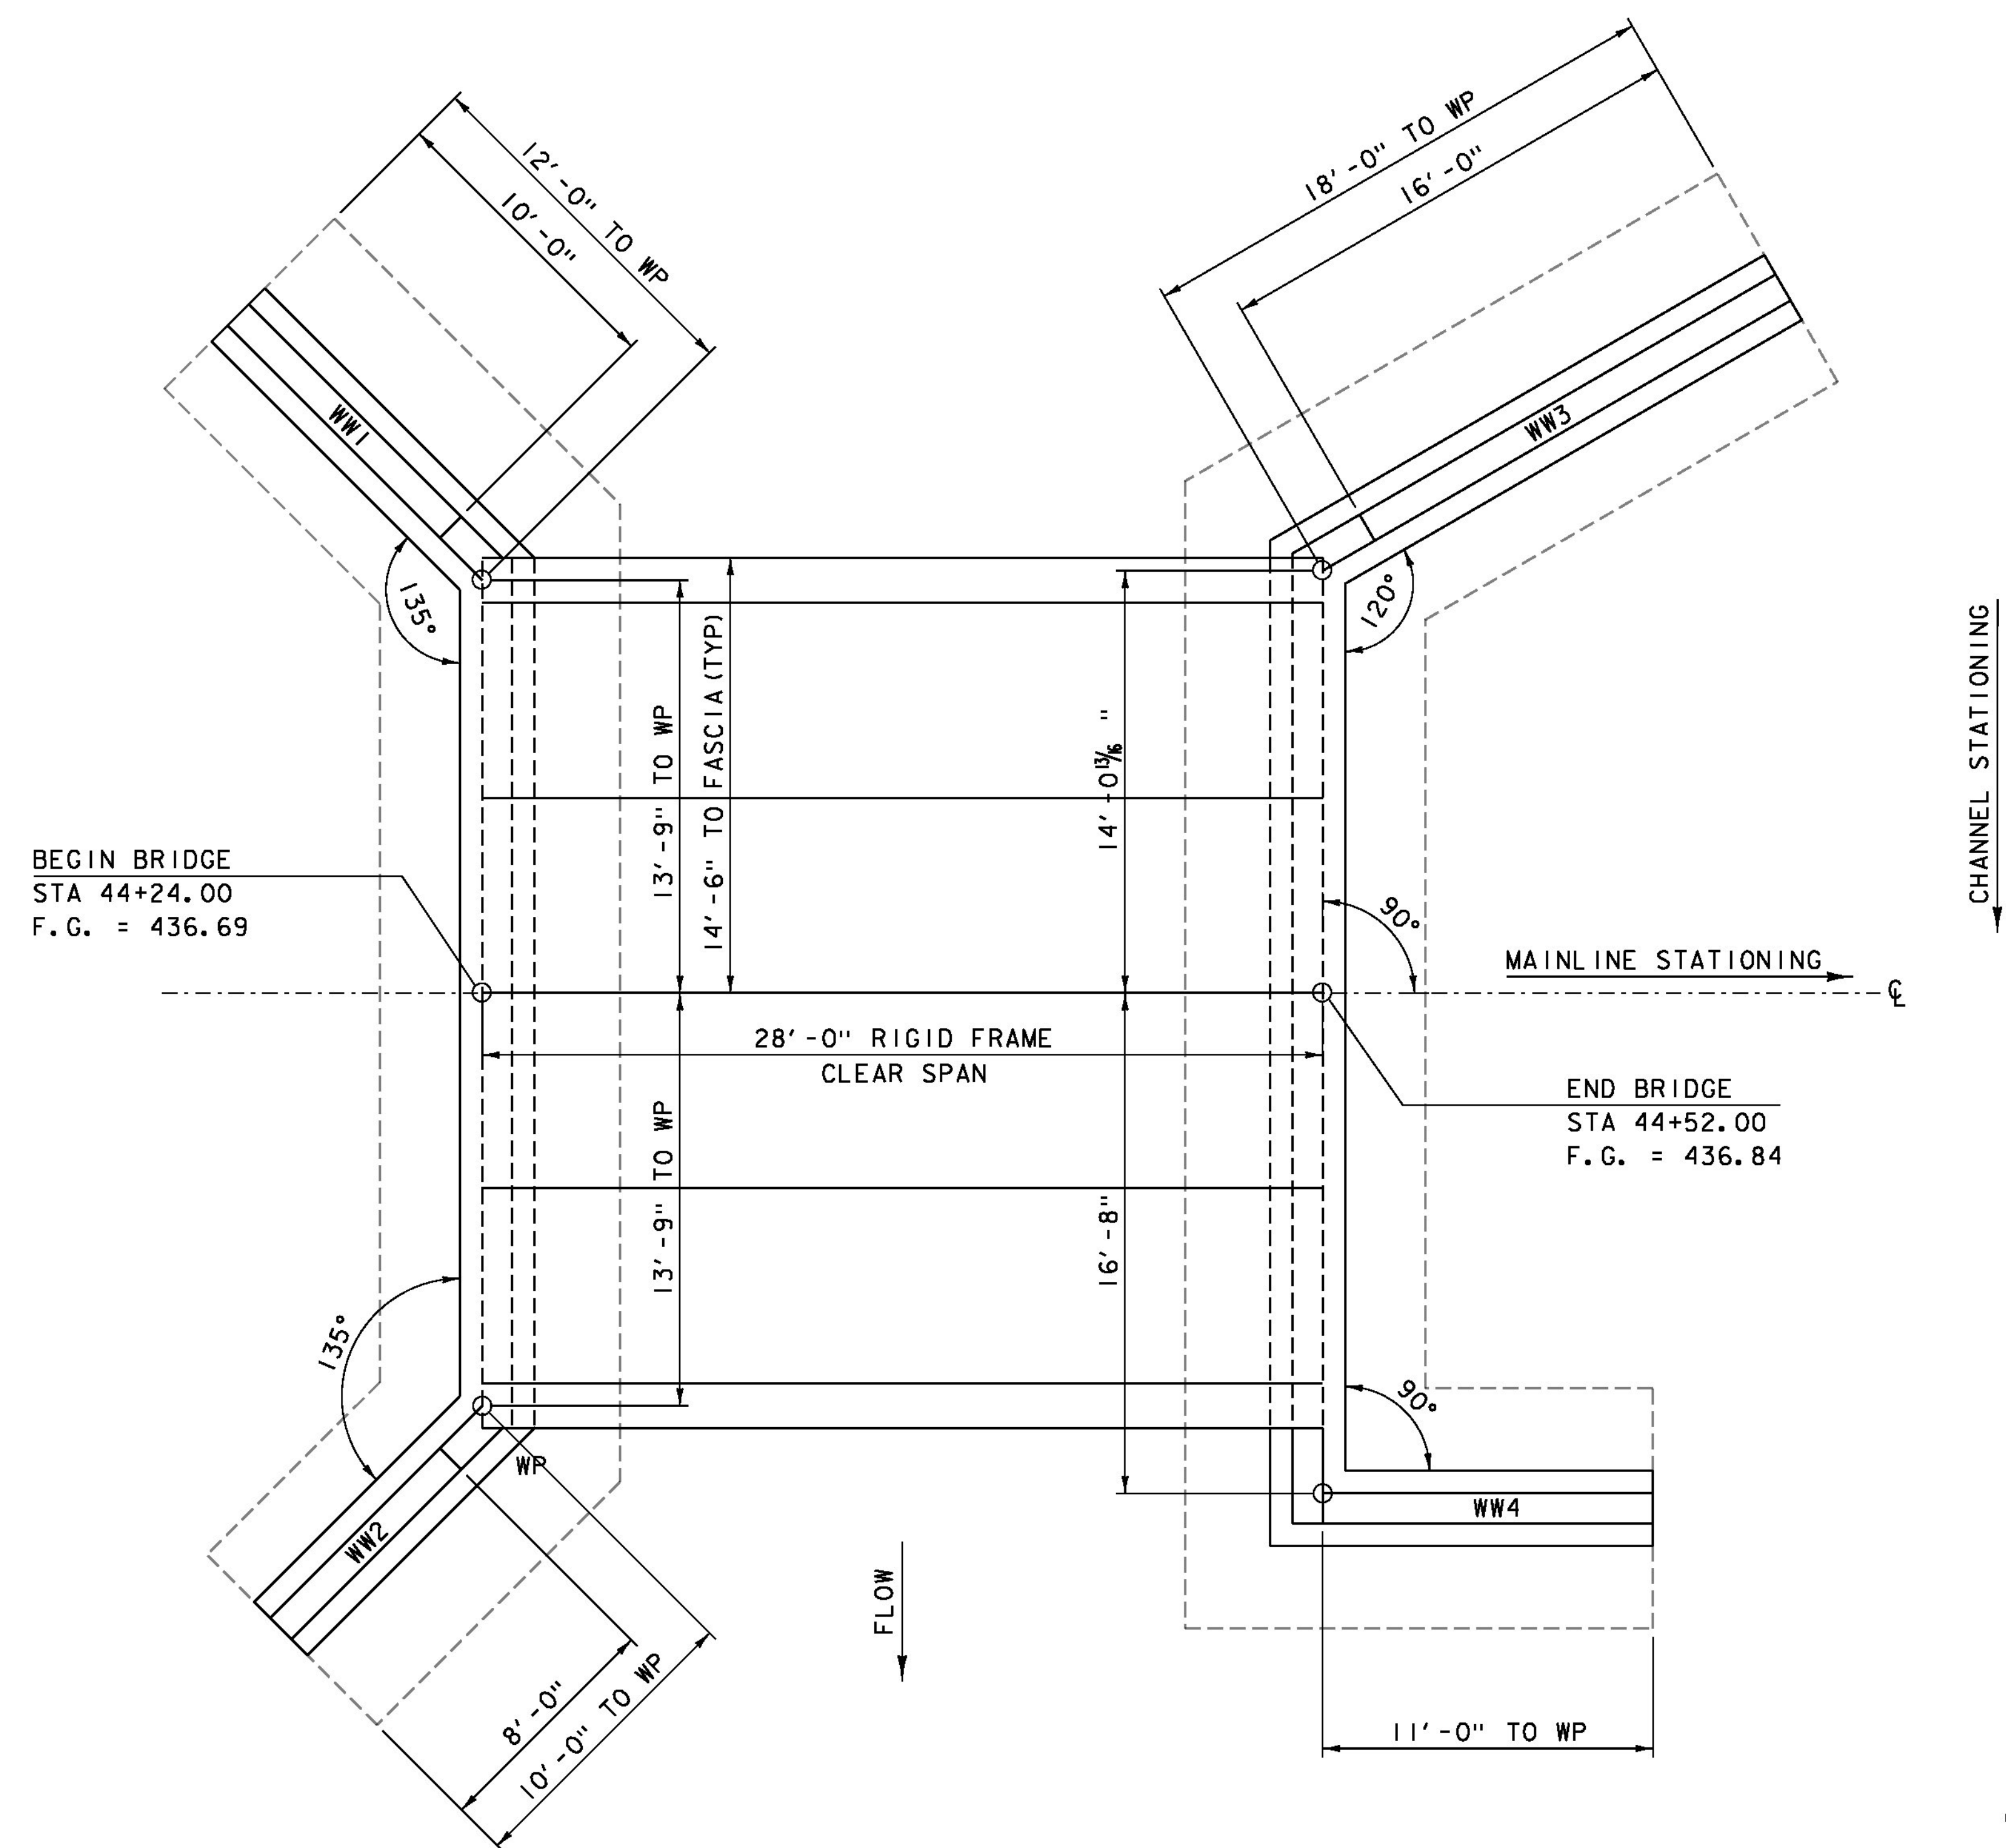


**BRIDGE LAYOUT**

SCALE 1/4" = 1'-0"

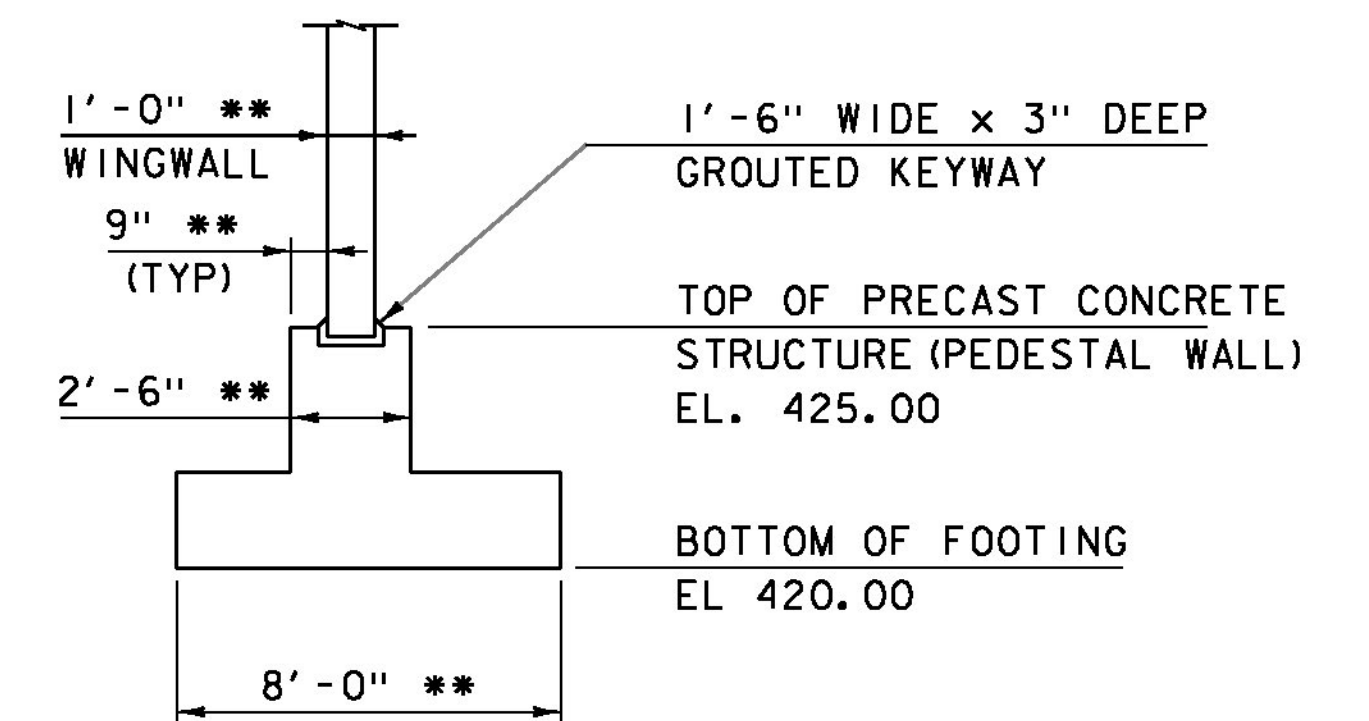

**WINGWALL SECTION**

SCALE 1/4" = 1'-0"

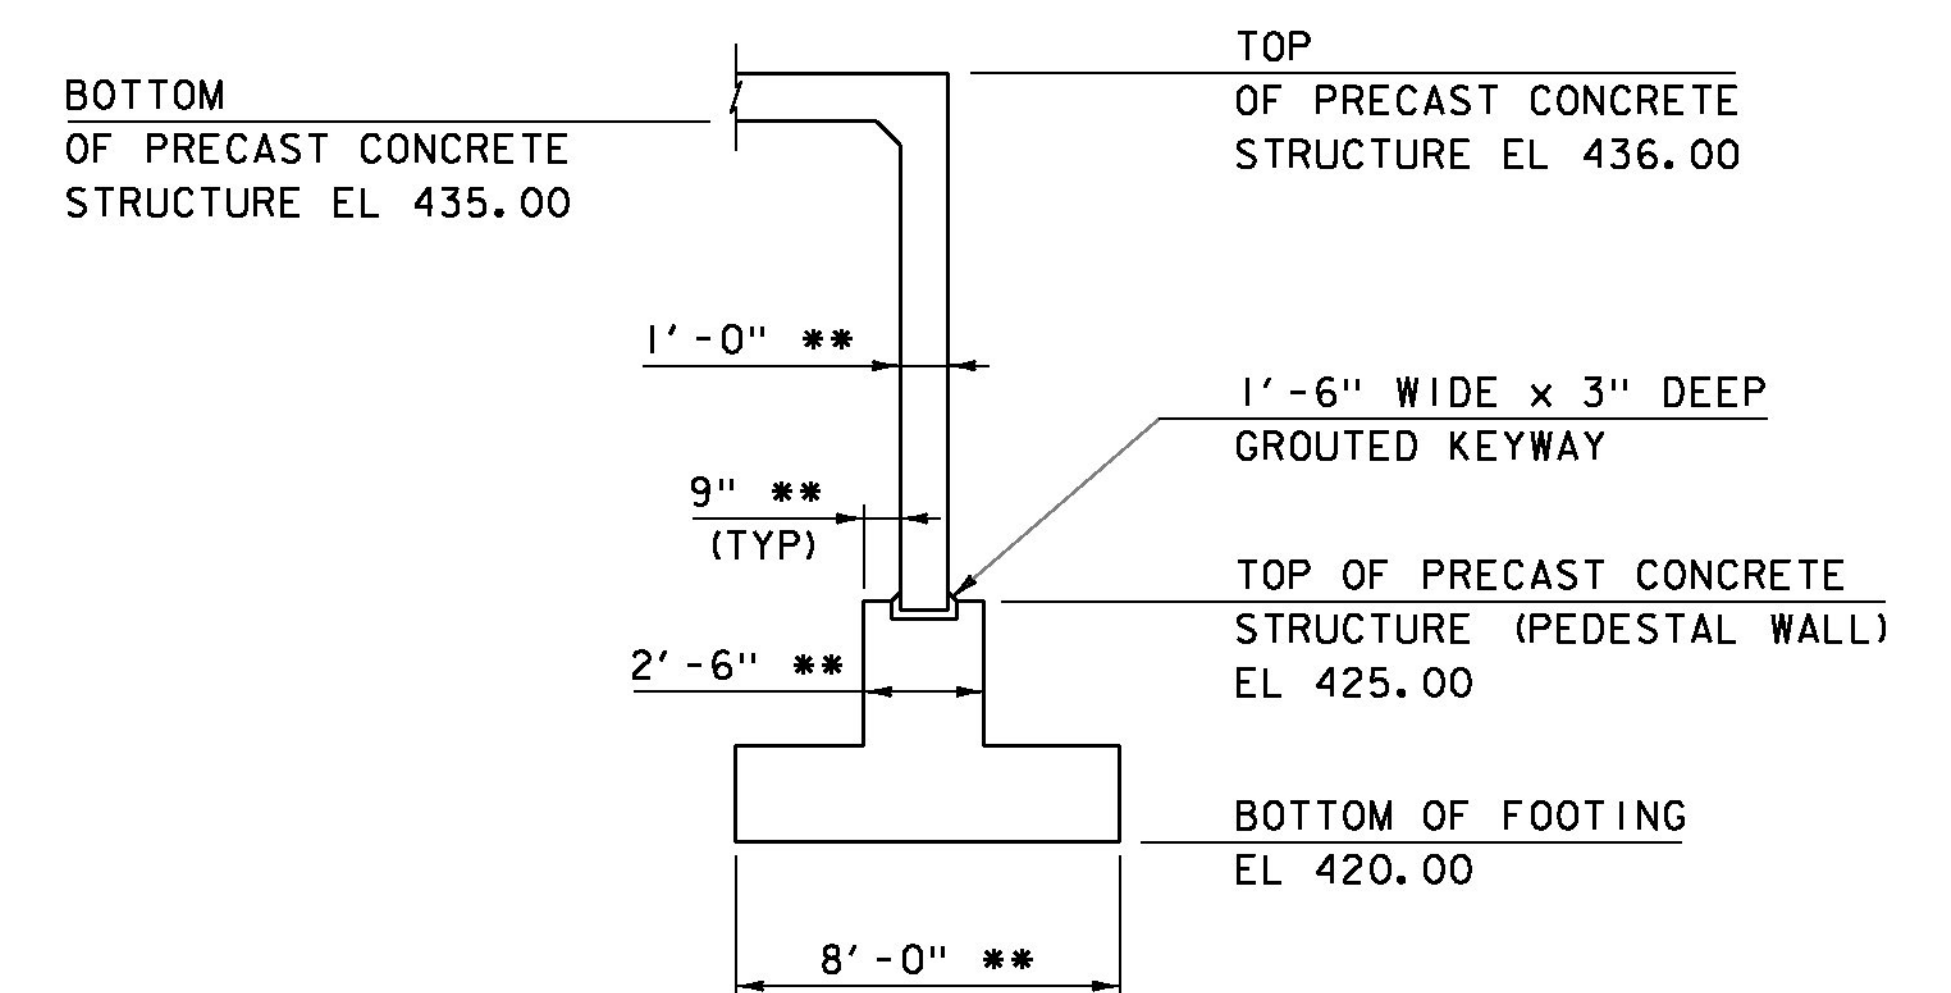


**PEDESTAL WALL SECTION**

SCALE 1/4" = 1'-0"

** DIMENSION SHOWN FOR ESTIMATING PURPOSES ONLY.  
ACTUAL DIMENSIONS TO BE DETERMINED BY THE  
FABRICATOR.


PROJECT NAME:	RICHFORD
PROJECT NUMBER:	BRF 0302(29)
FILE NAME: sl2j158sub.dgn	PLOT DATE: 11-DEC-2014
PROJECT LEADER: C. CARLSON	DRAWN BY: R. PELLETT
DESIGNED BY: H. SALLS	CHECKED BY: H. SALLS
BRIDGE LAYOUT AND WALL SECTIONS	SHEET 23 OF 36



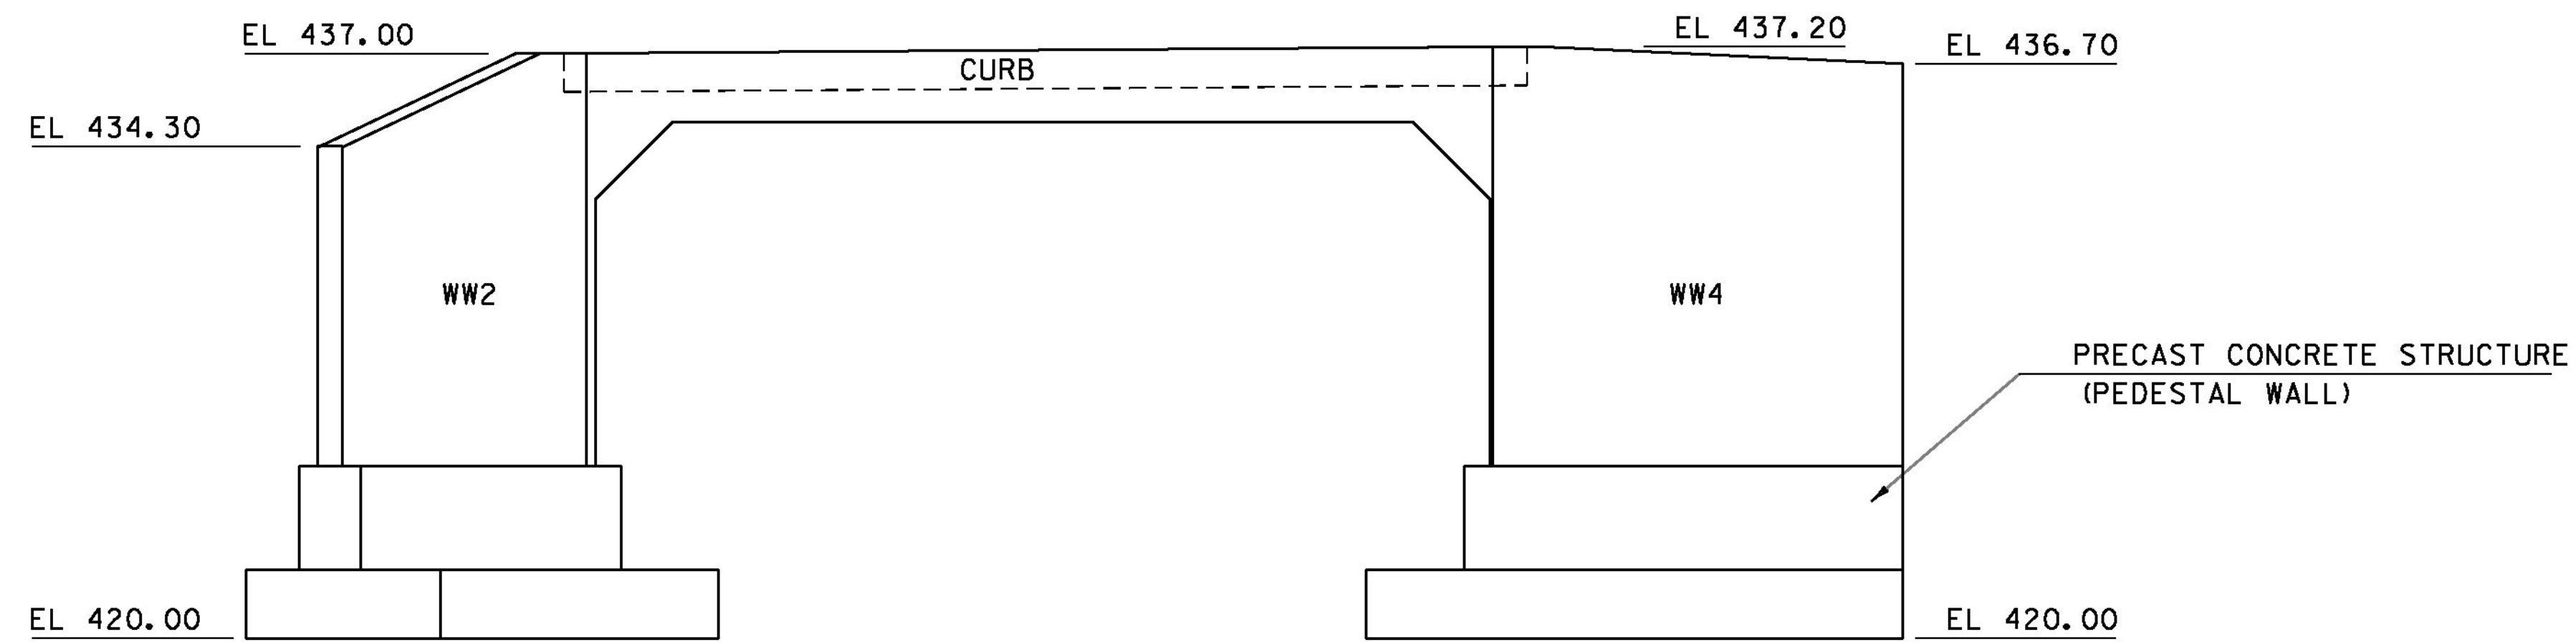

DOWNSTREAM ELEVATION LOOKING UPSTREAM

SCALE 1/4" = 1'-0"

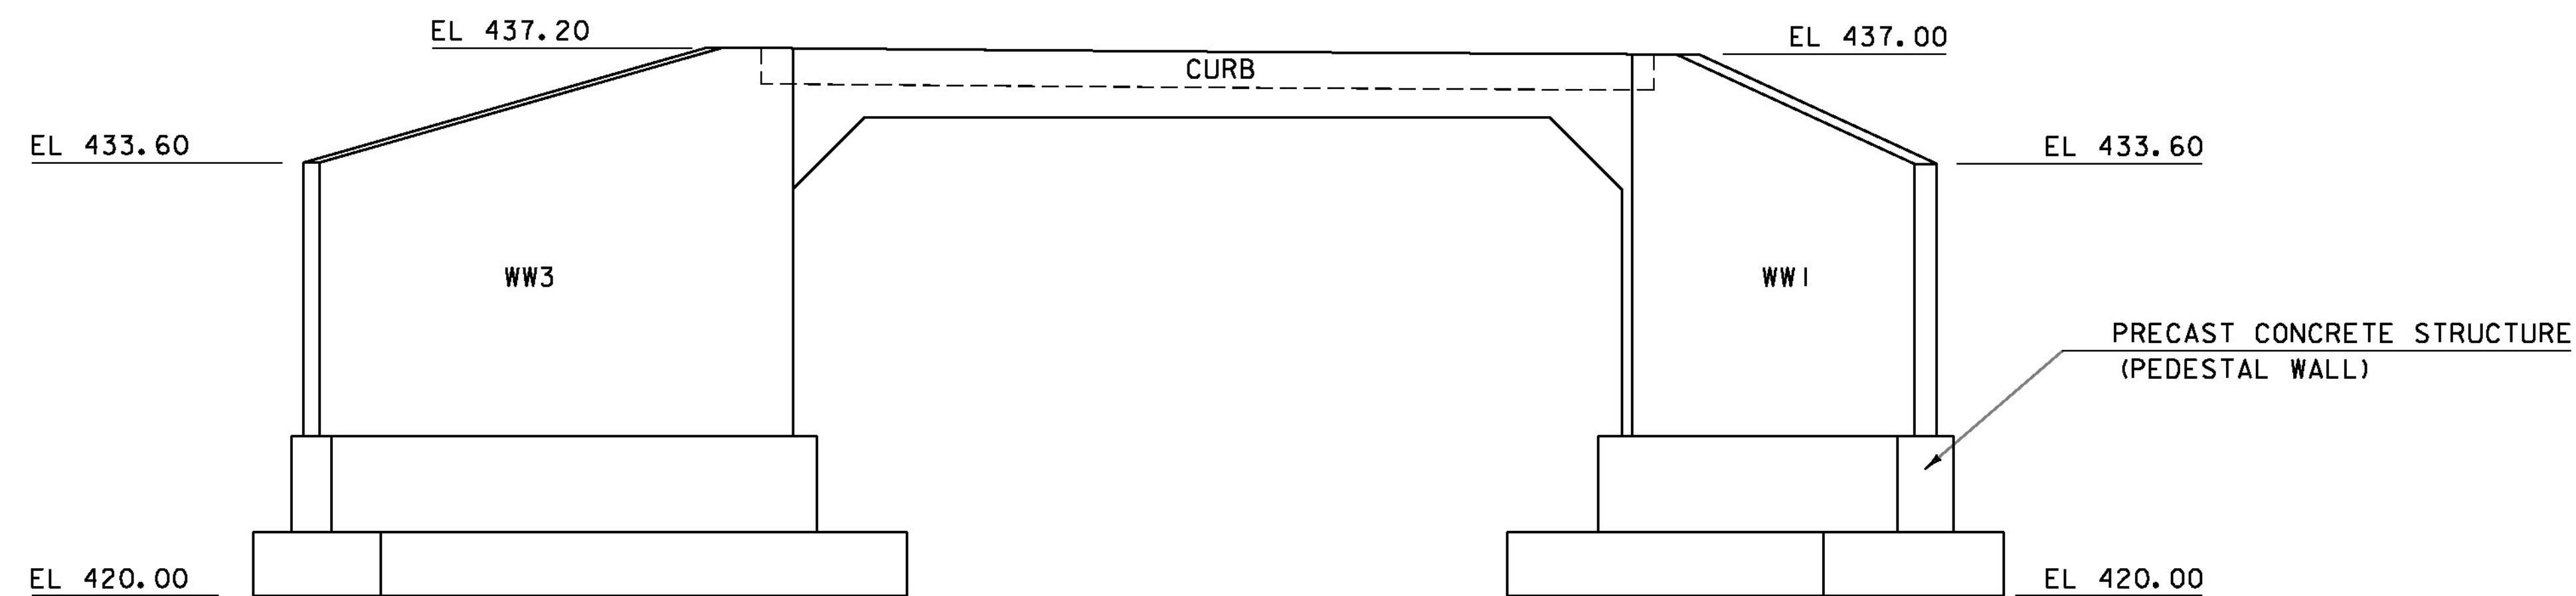


UPSTREAM ELEVATION LOOKING DOWNSTREAM


SCALE 1/4" = 1'-0"

PROJECT NAME: RICHFORD	
PROJECT NUMBER: BRF 0302(29)	
FILE NAME: sl2j158sub.dgn	PLOT DATE: 11-DEC-2014
PROJECT LEADER: C. CARLSON	DRAWN BY: R. PELLETT
DESIGNED BY: H. SALLS	CHECKED BY: H. SALLS
BRIDGE ELEVATIONS	SHEET 24 OF 36




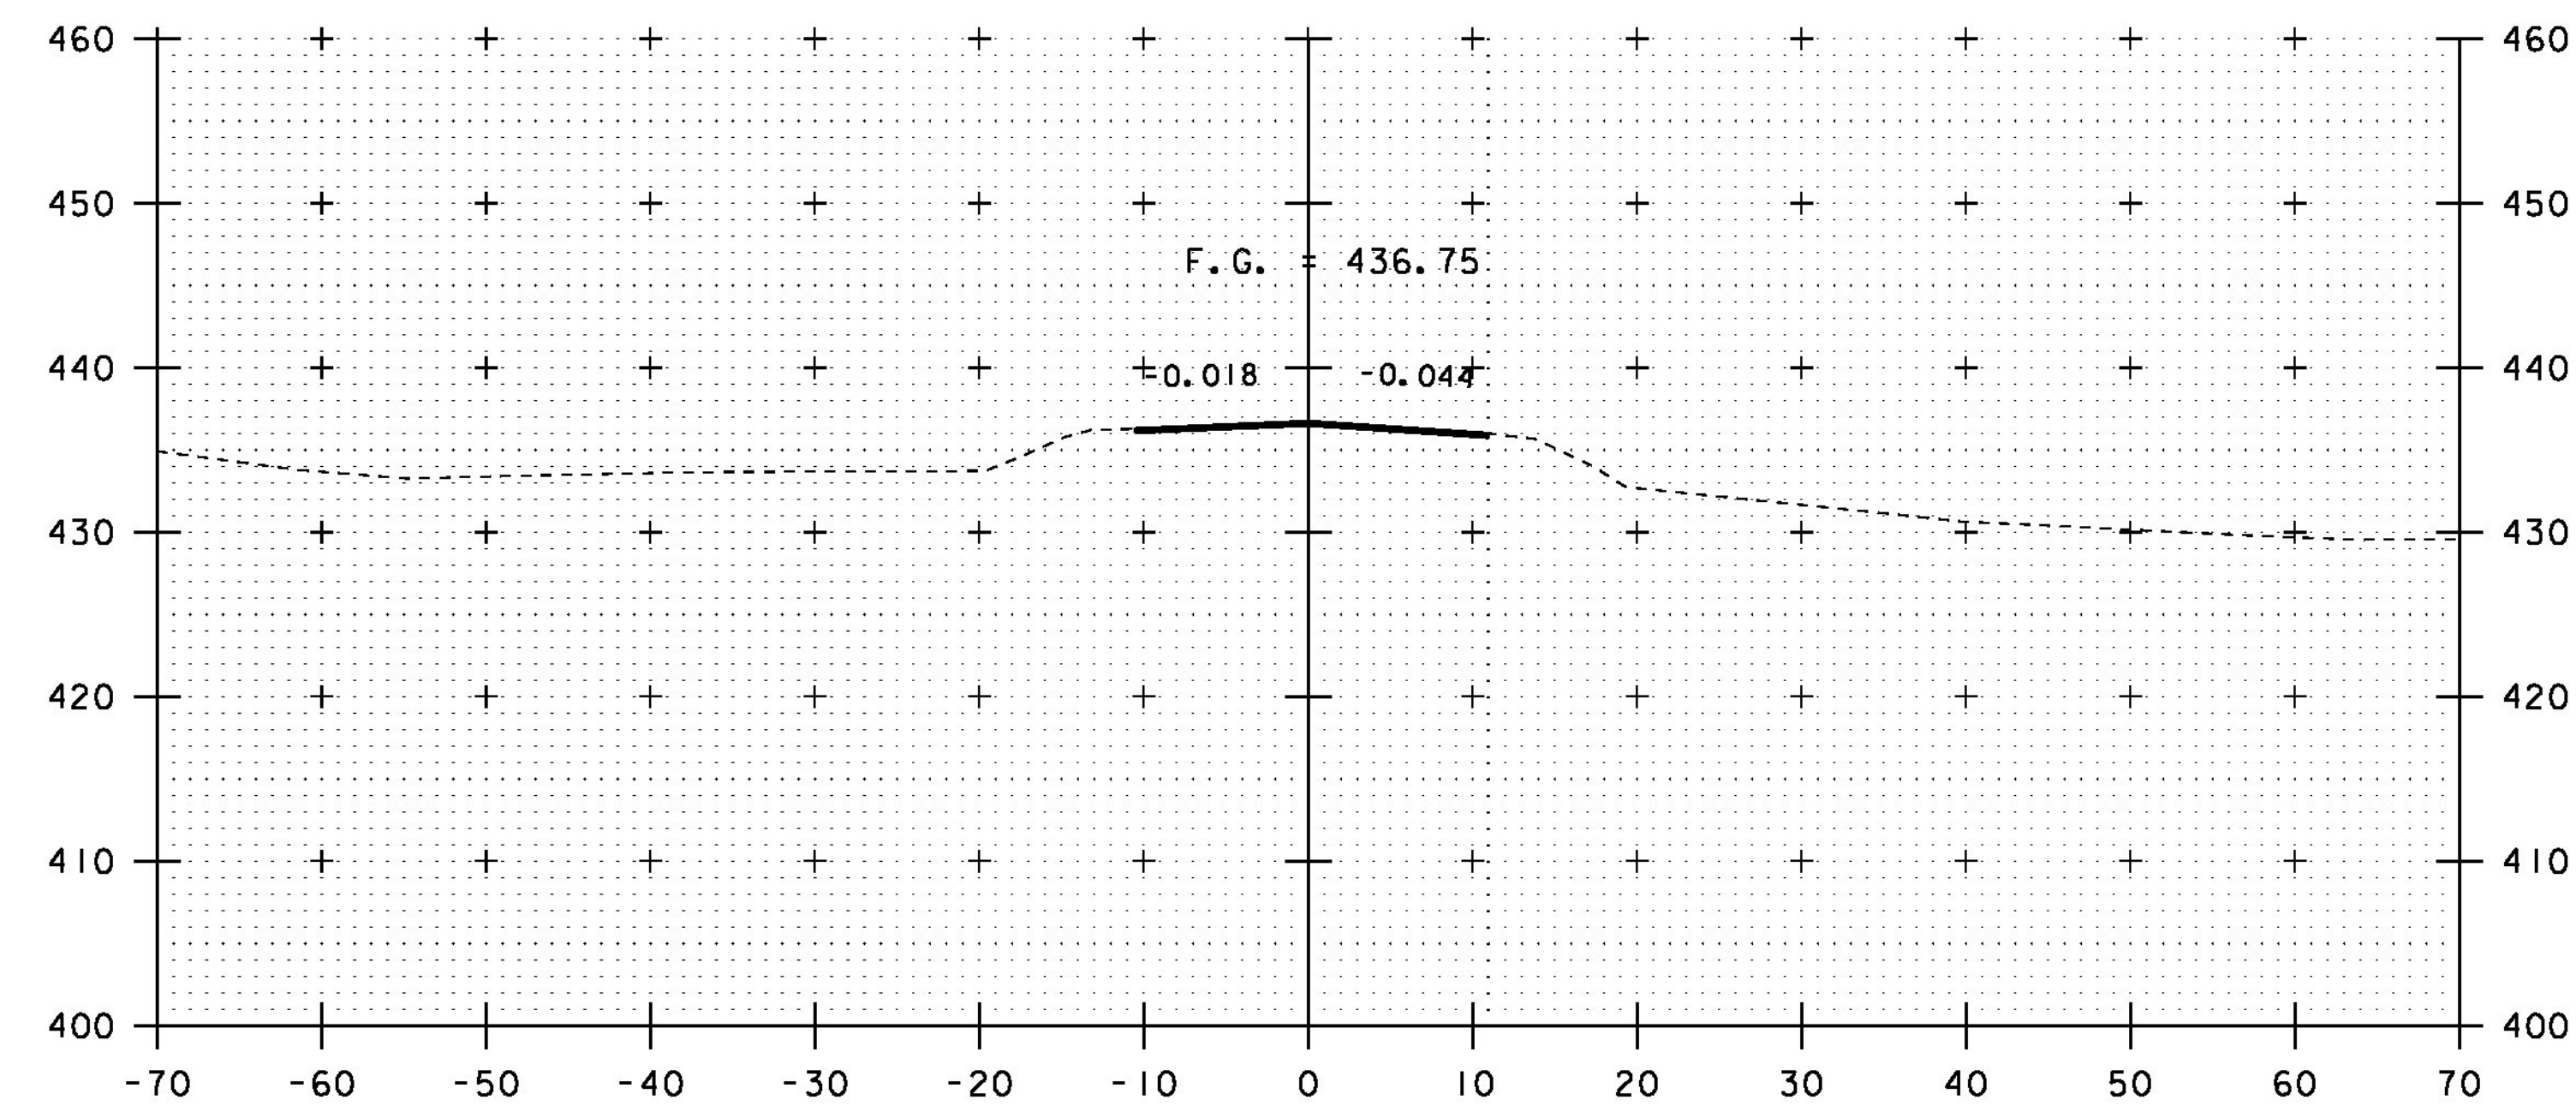


42+75

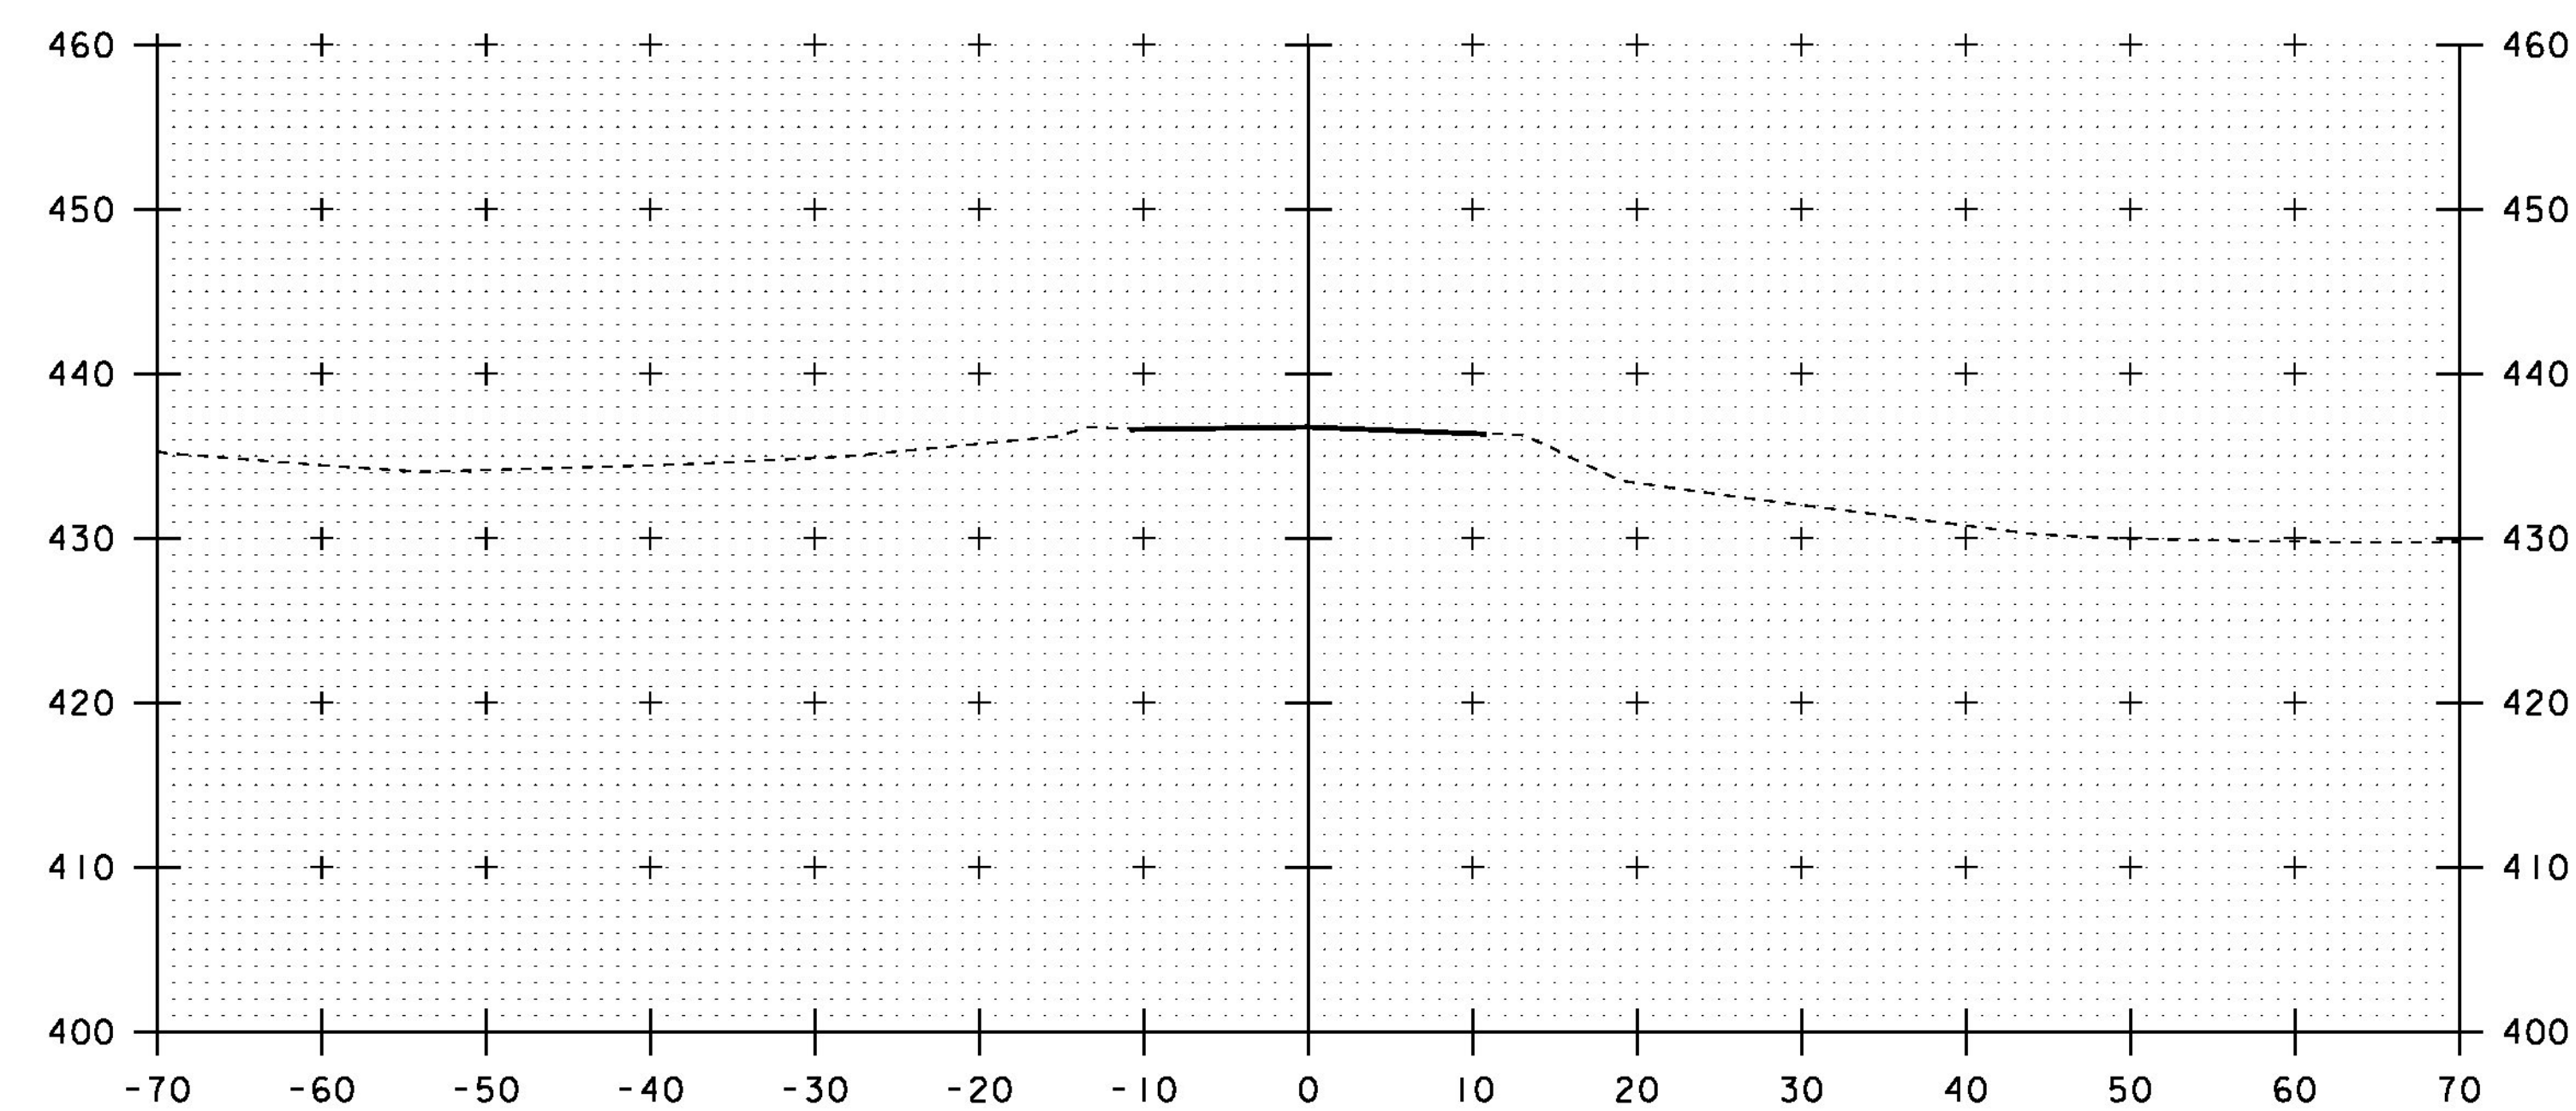

42+50  
BEGIN APPROACH  
MATCH EXISTING

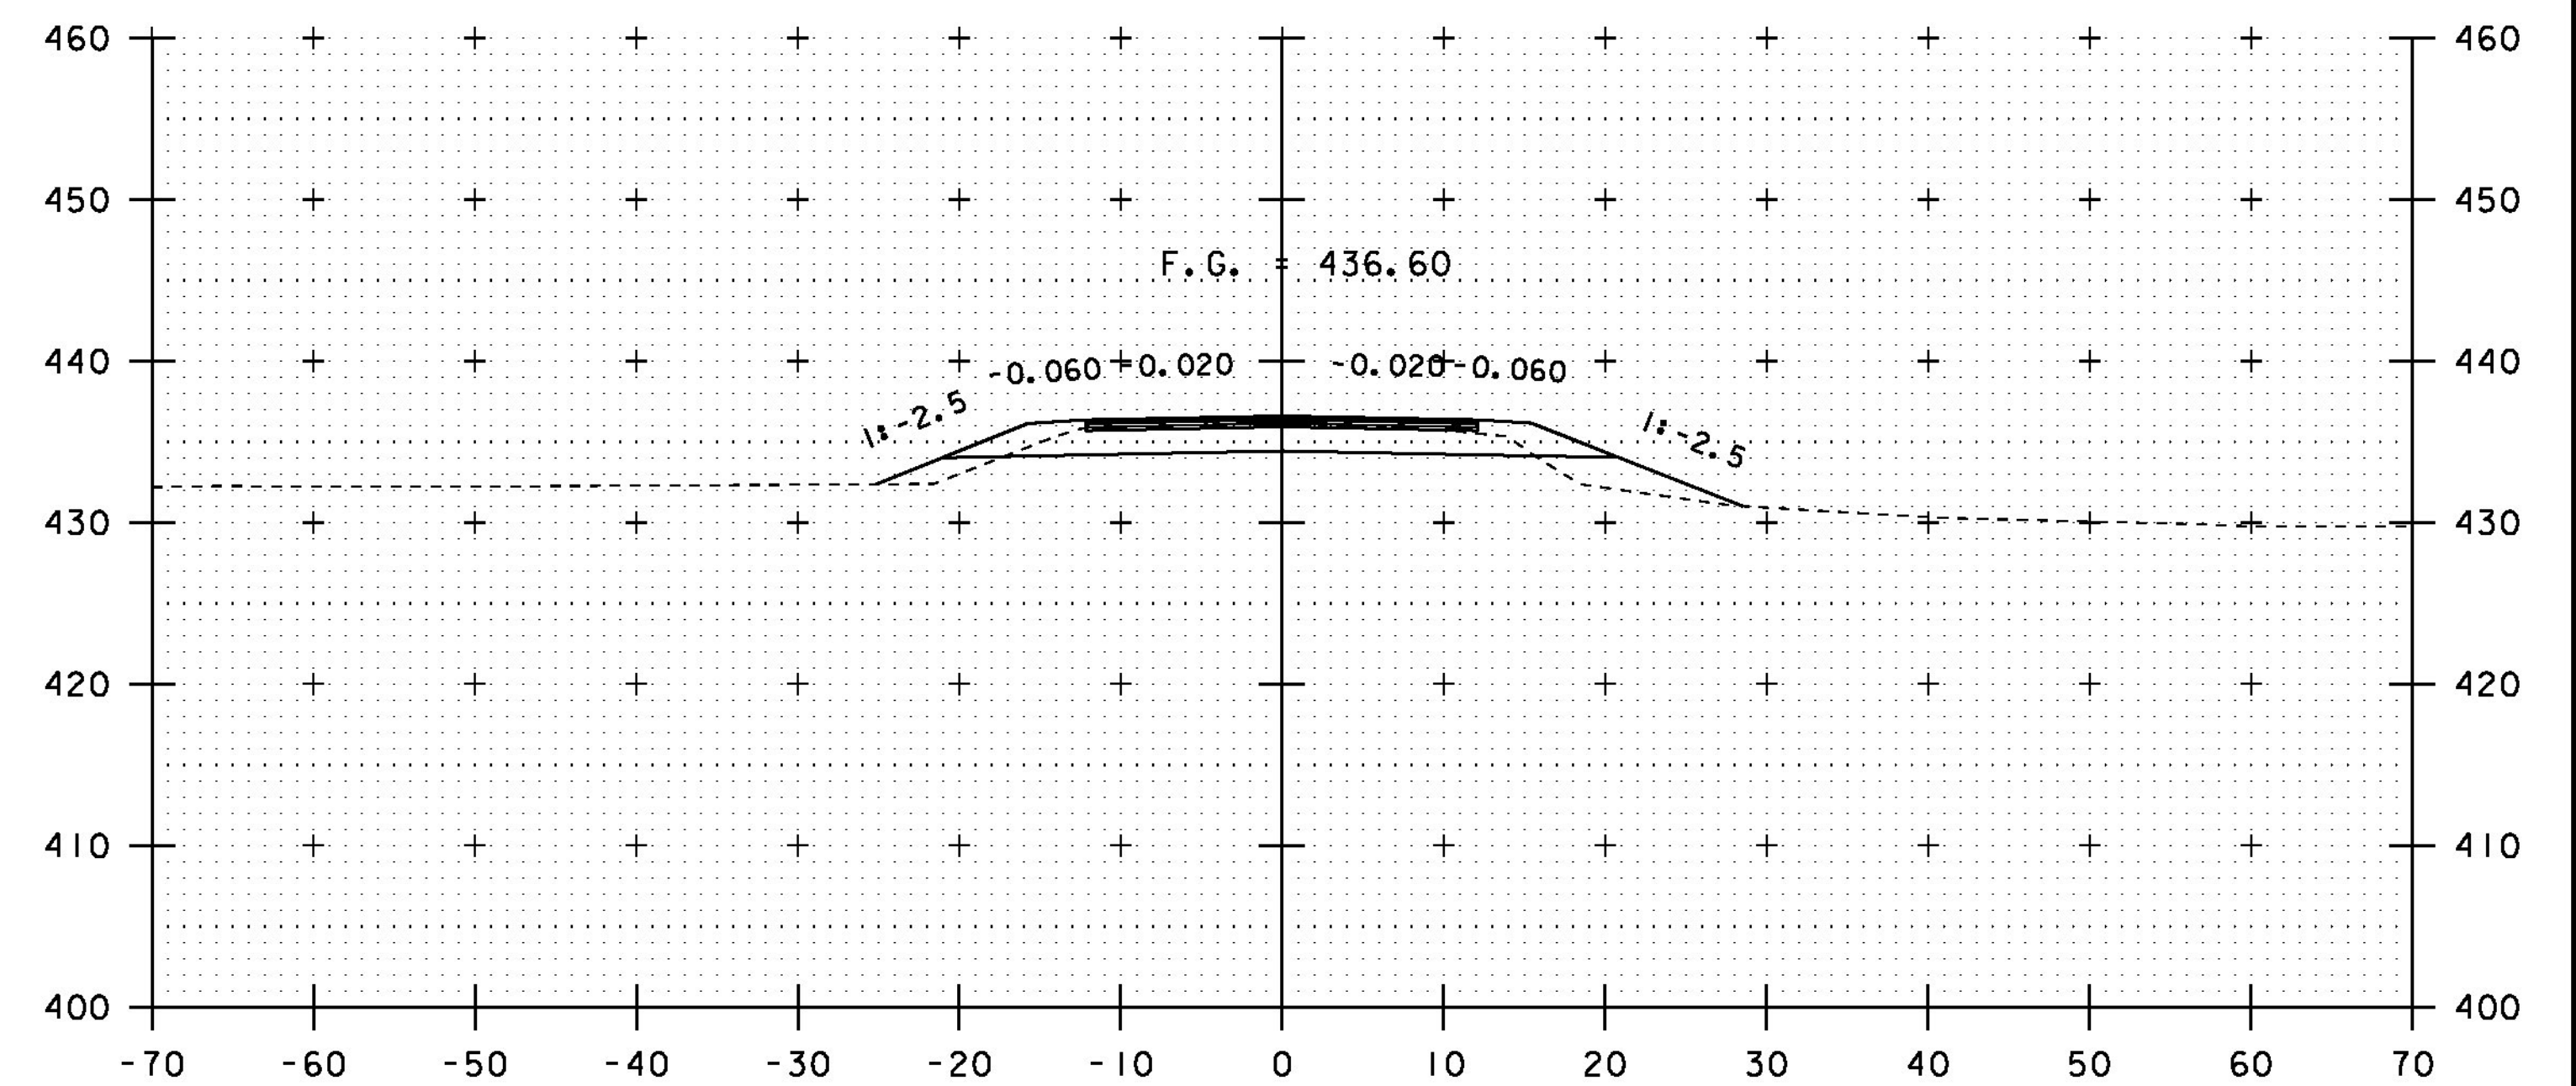

43+25

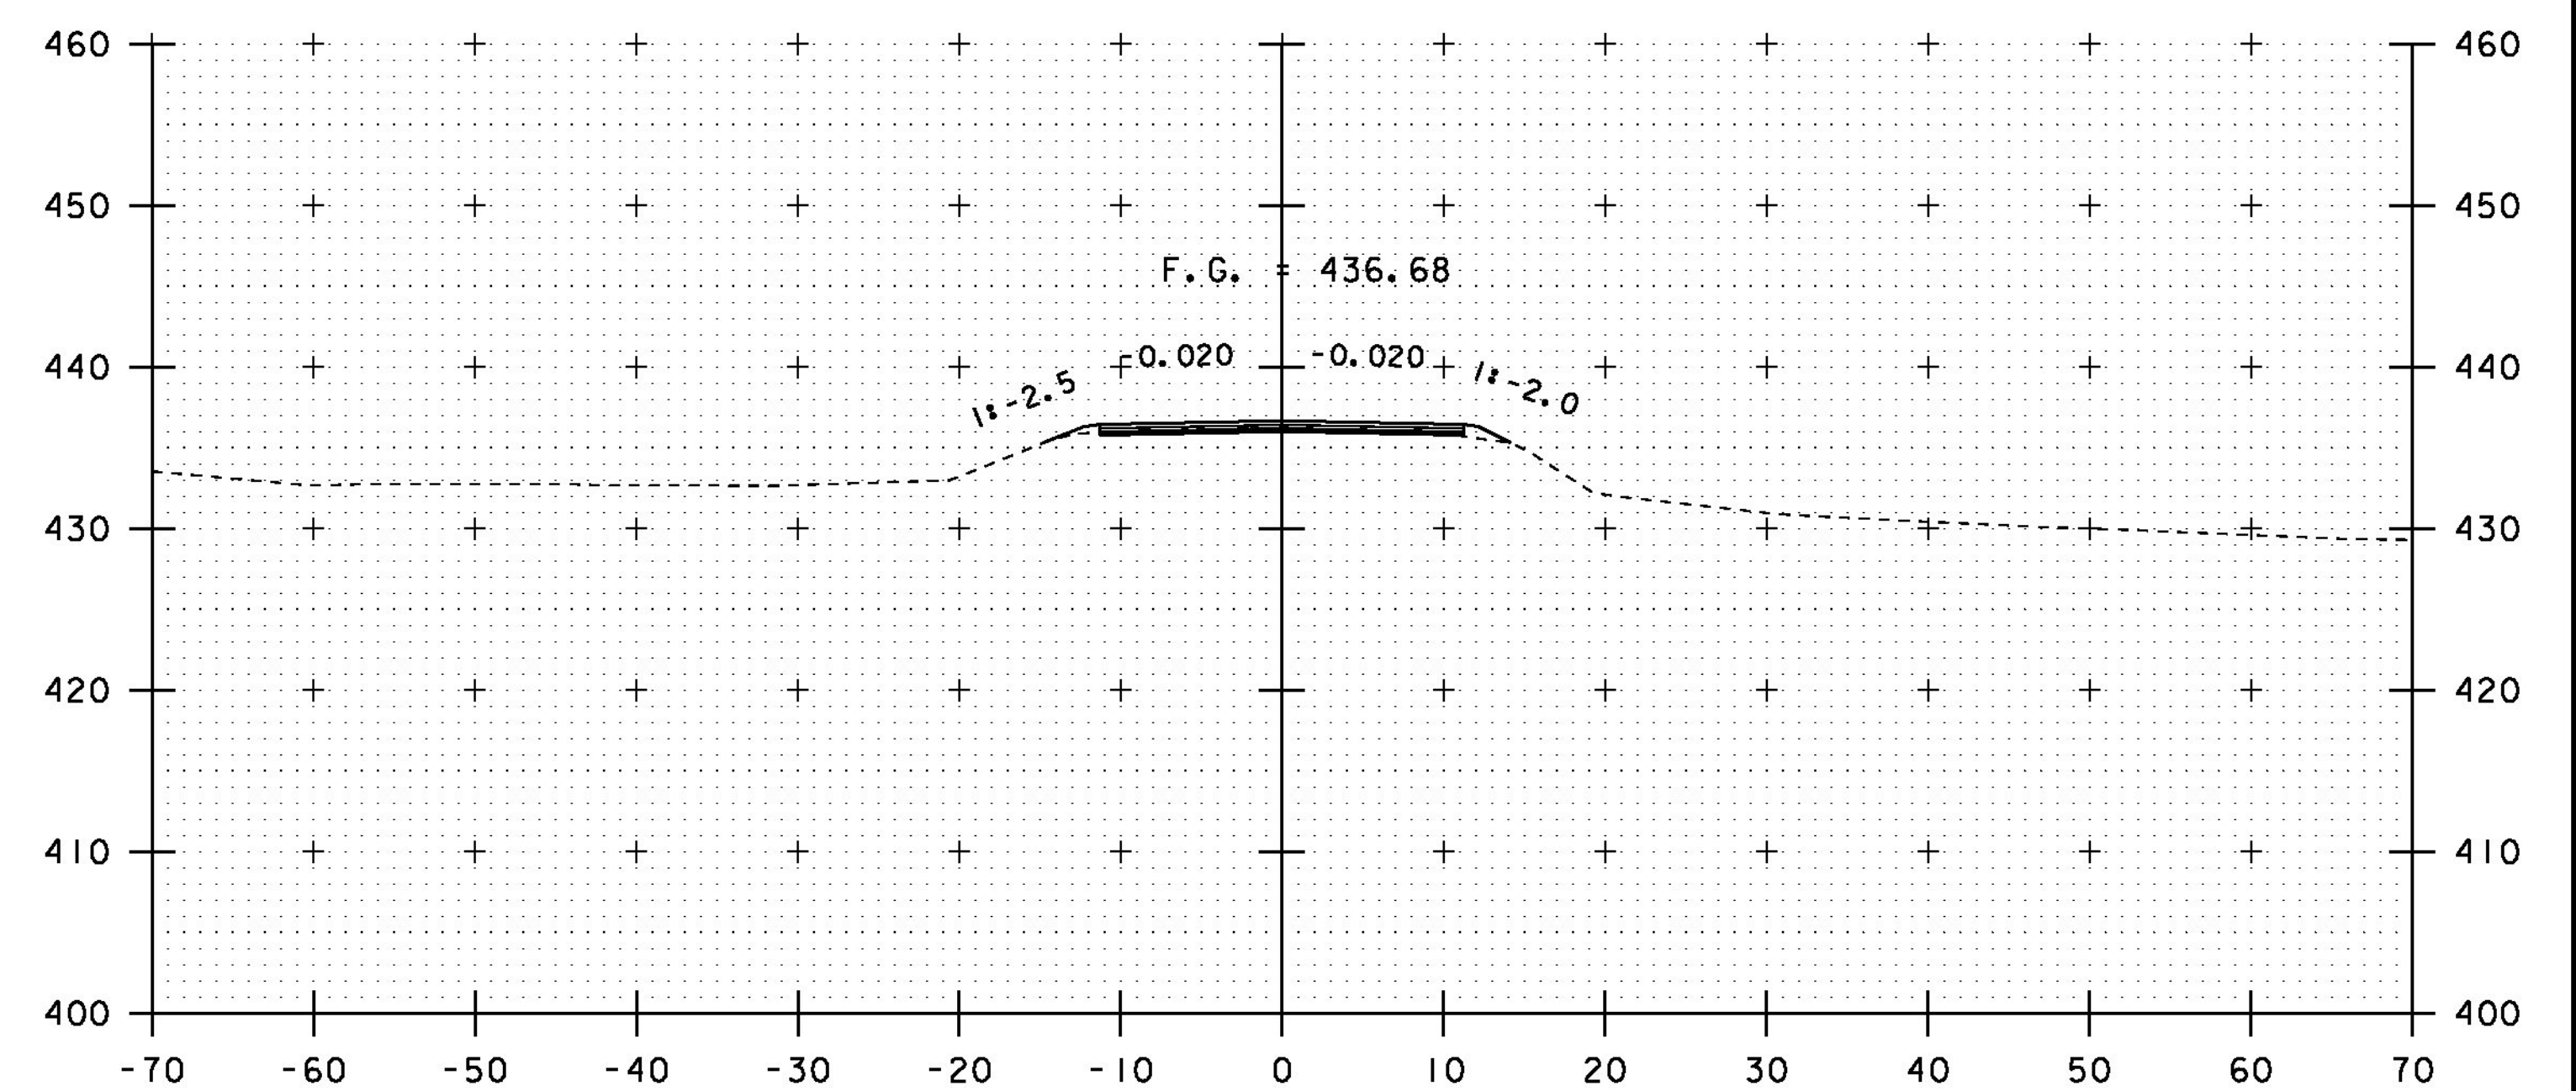

43+00


STA. 42+50 TO STA. 43+25

PROJECT NAME: RICHFORD	
PROJECT NUMBER: BRF 0302(29)	
FILE NAME: sl2j158xs.dgn	PLOT DATE: 11-DEC-2014
PROJECT LEADER: C. CARLSON	DRAWN BY: R. PELLETT
DESIGNED BY: H. SALLS	CHECKED BY: H. SALLS
MAINLINE CROSS SECTIONS 1	SHEET 25 OF 36









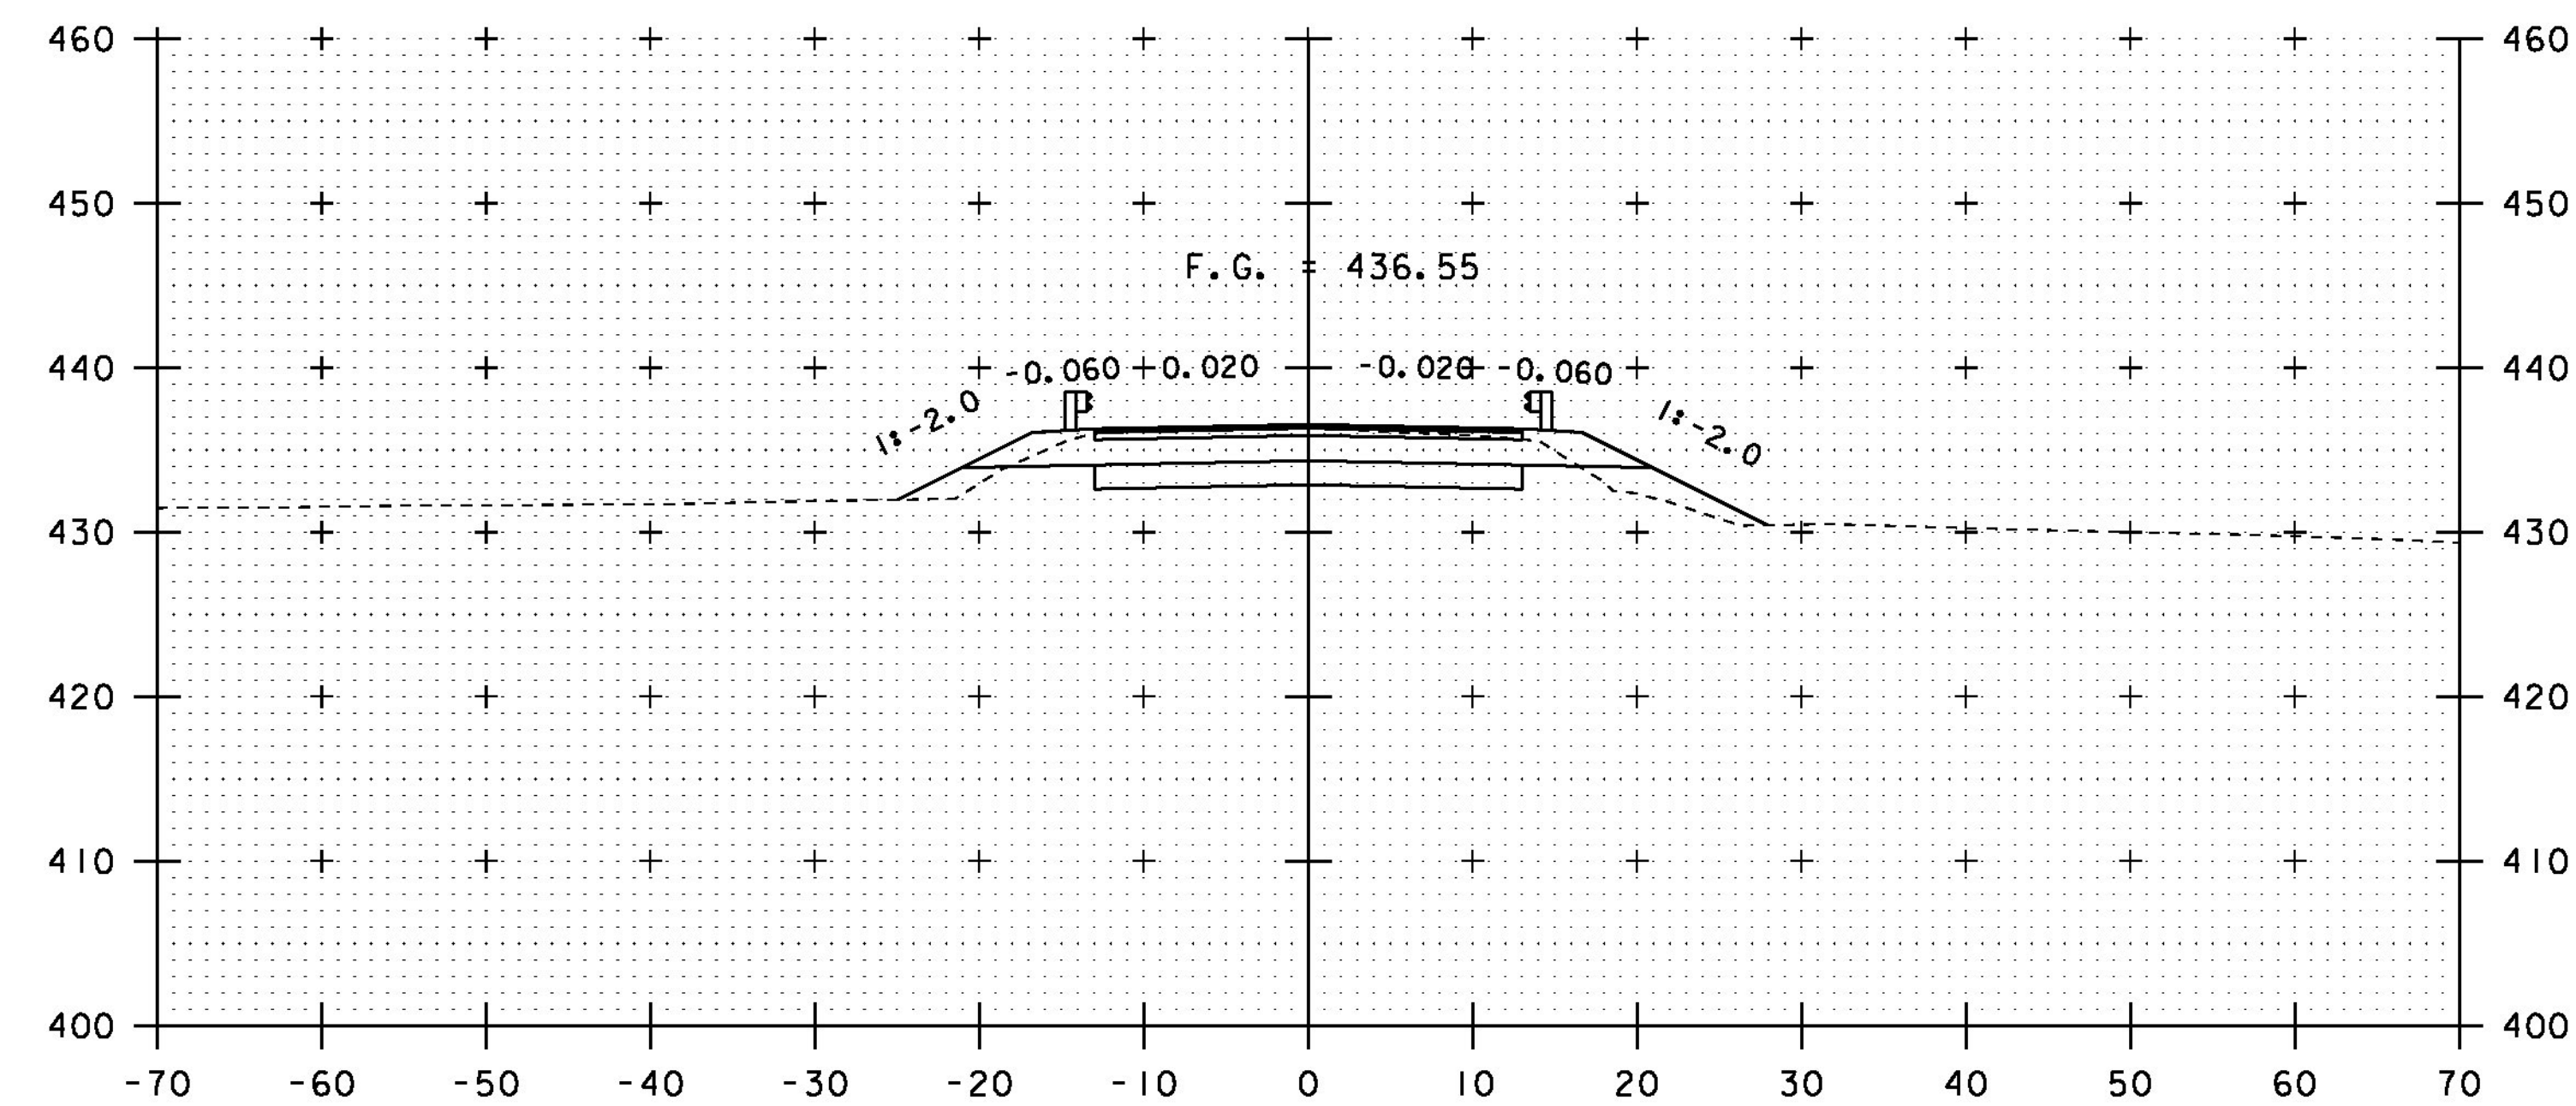


43+75

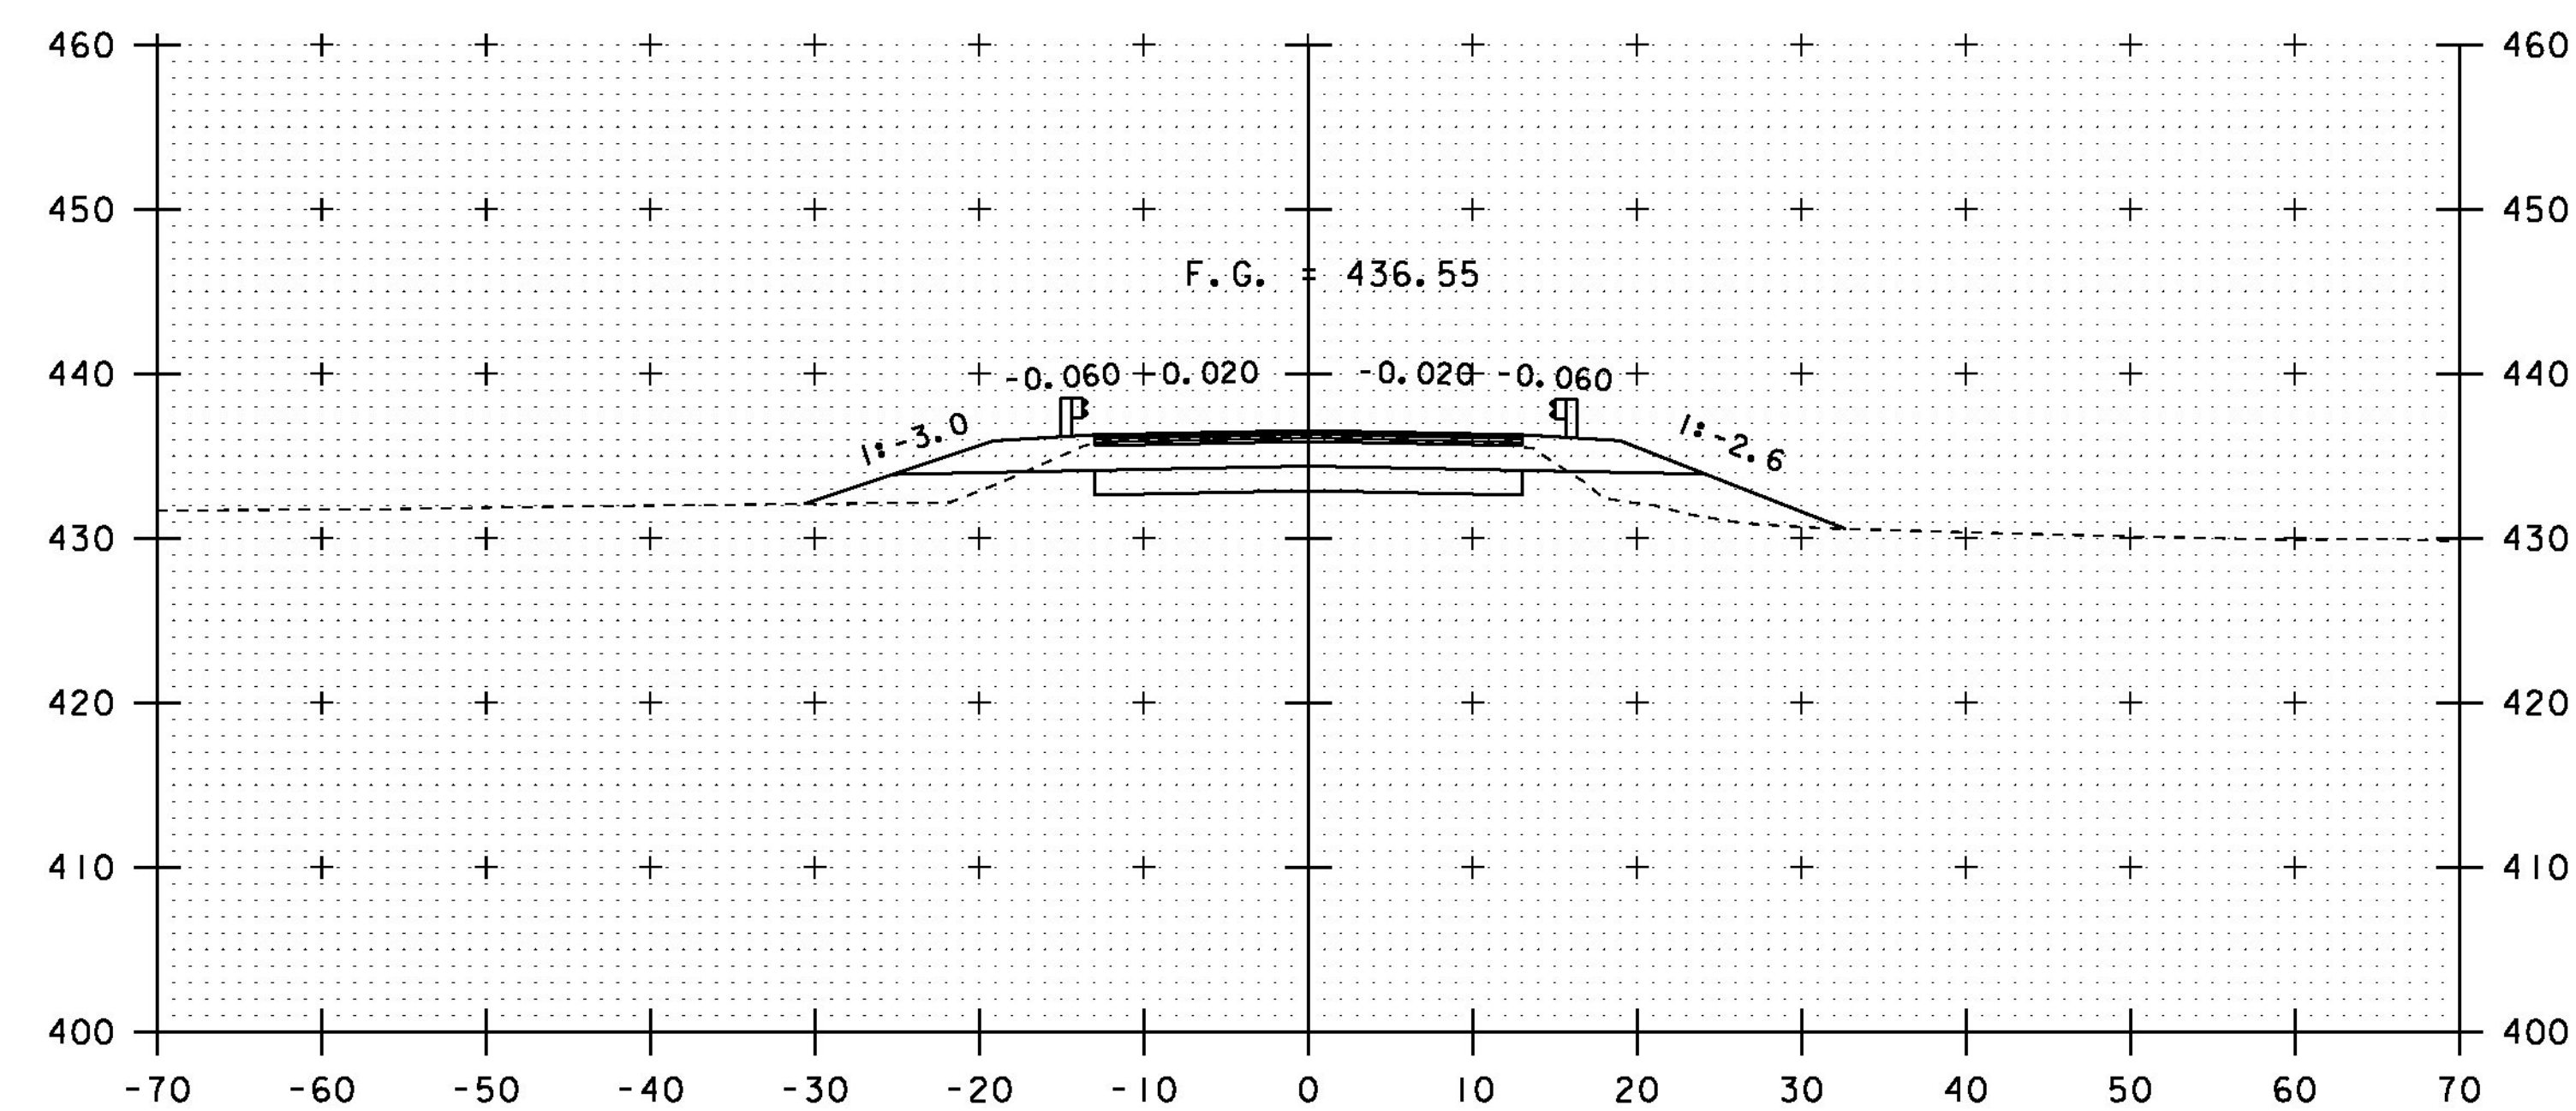

43+50  
BEGIN PROJECT

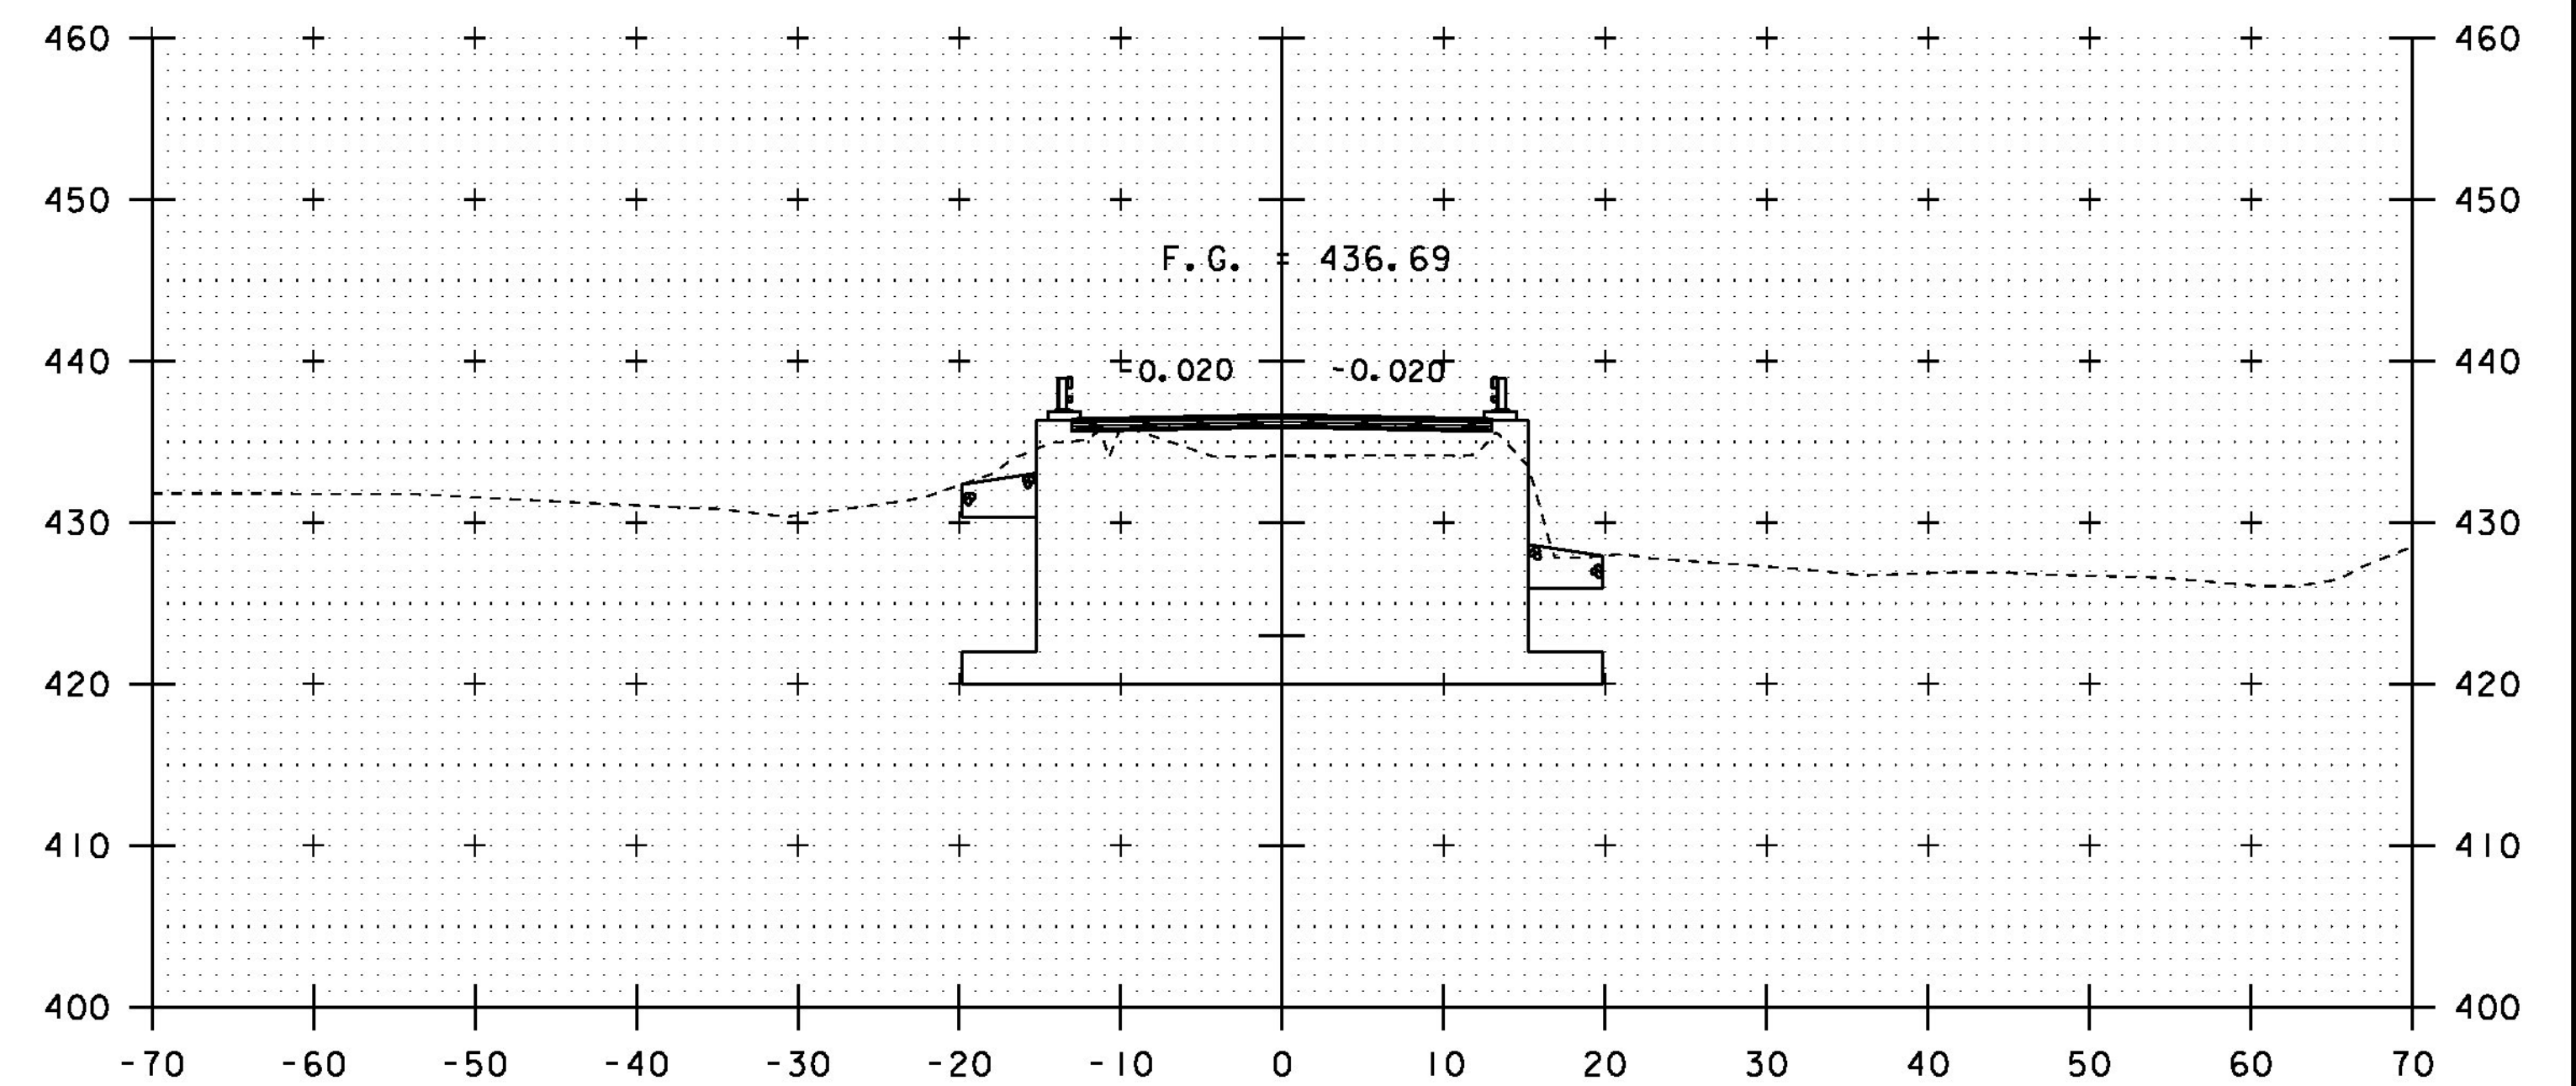

44+25  
STA 44+24 BEGIN BRIDGE

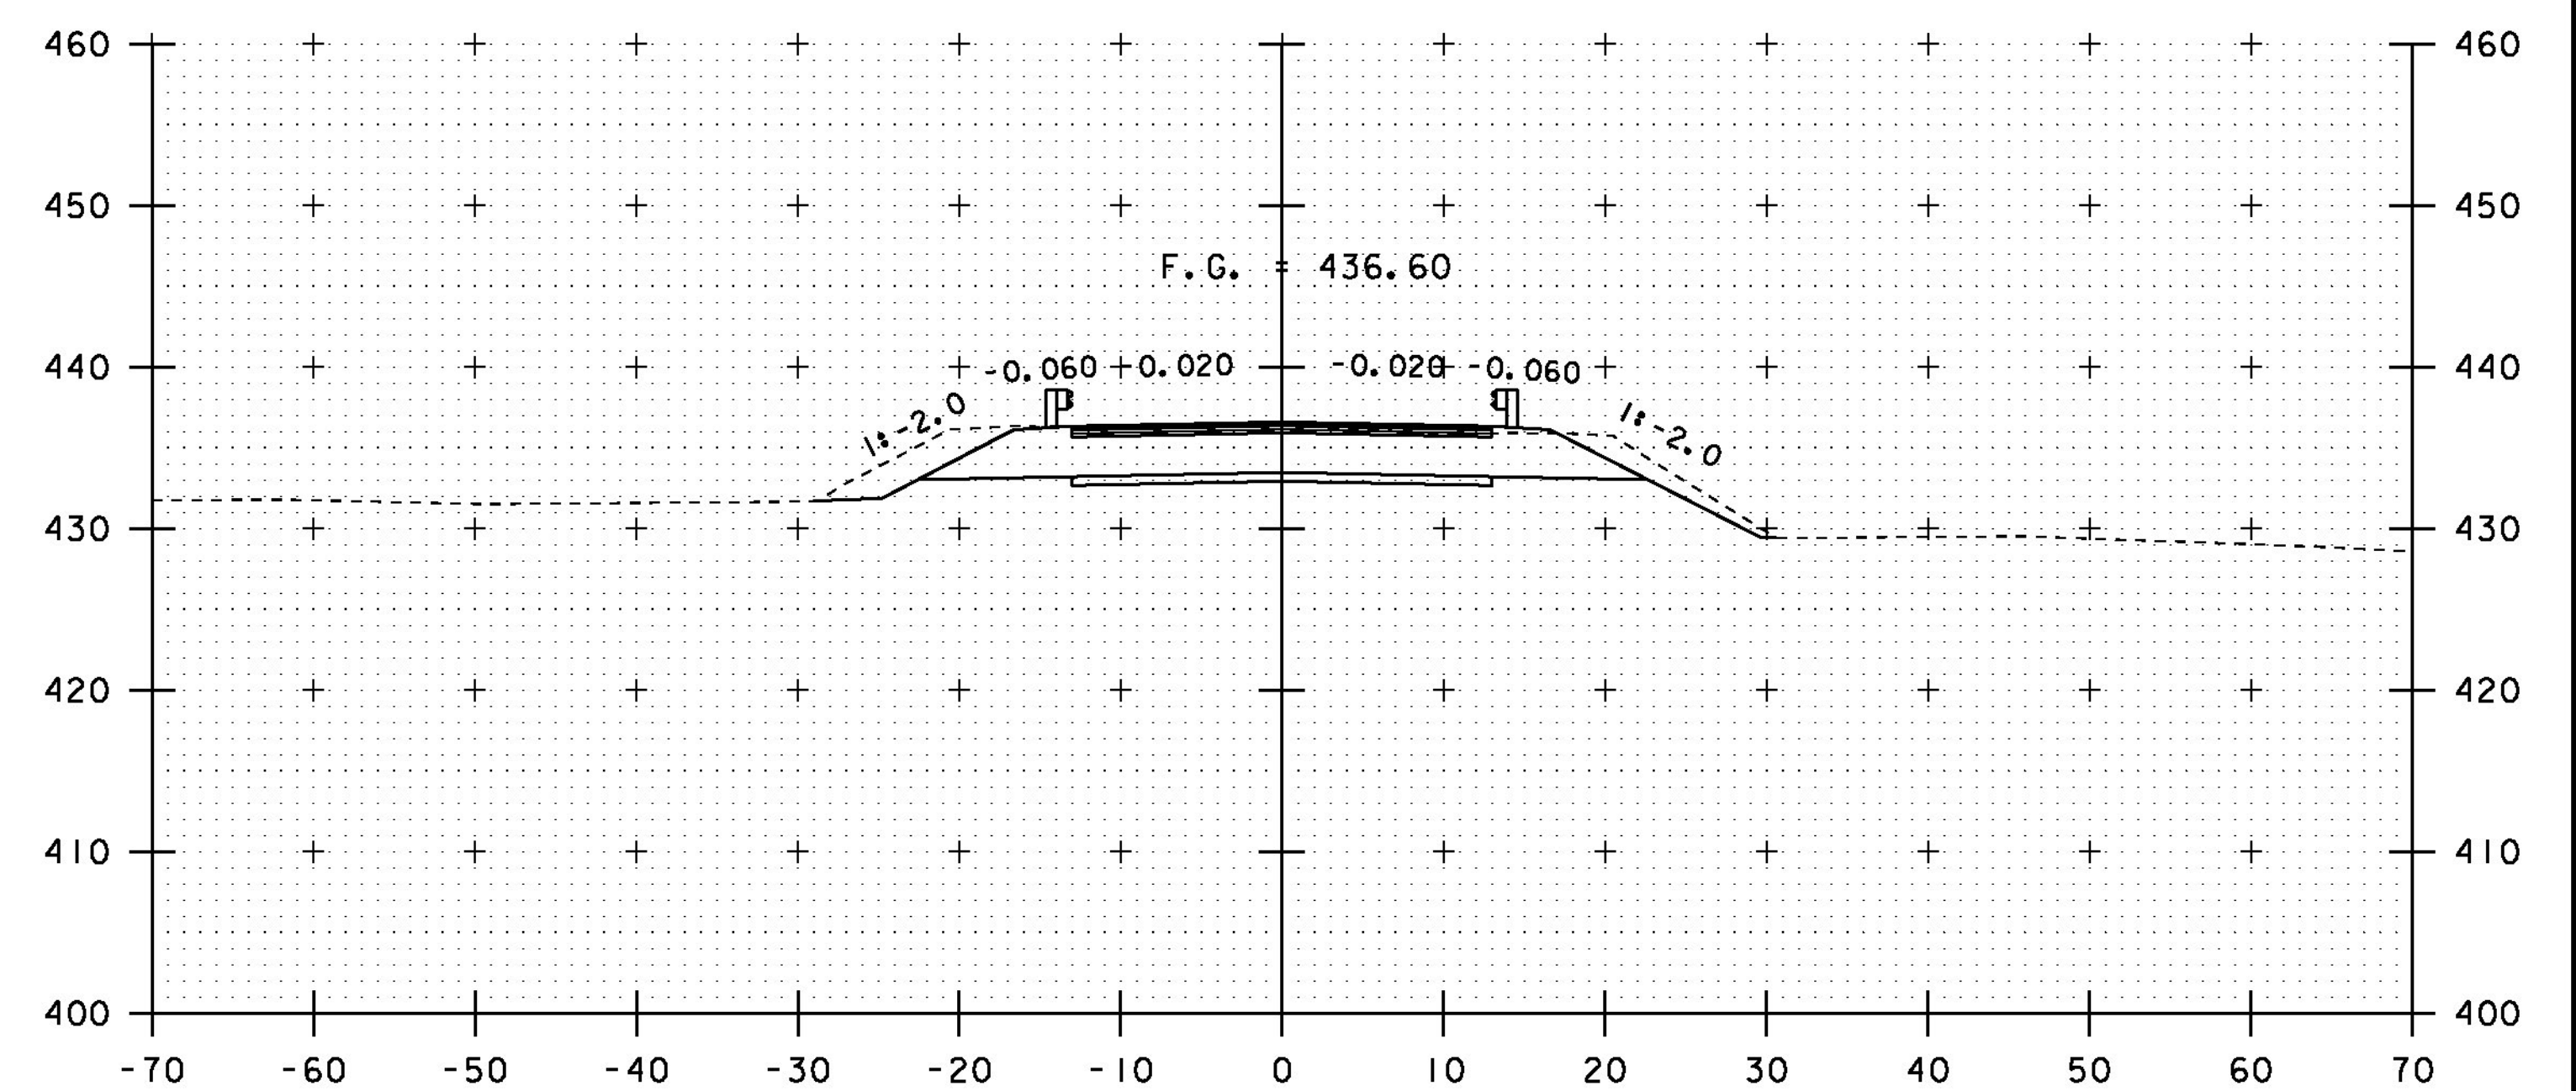


44+00





PROJECT NAME: RICHFORD	
PROJECT NUMBER: BRF 0302(29)	
FILE NAME: sl2j158xs.dgn	PLOT DATE: 11-DEC-2014
PROJECT LEADER: C. CARLSON	DRAWN BY: R. PELLETT
DESIGNED BY: H. SALLS	CHECKED BY: H. SALLS
MAINLINE CROSS SECTIONS 2	SHEET 26 OF 36

STA. 43+50 TO STA. 44+25



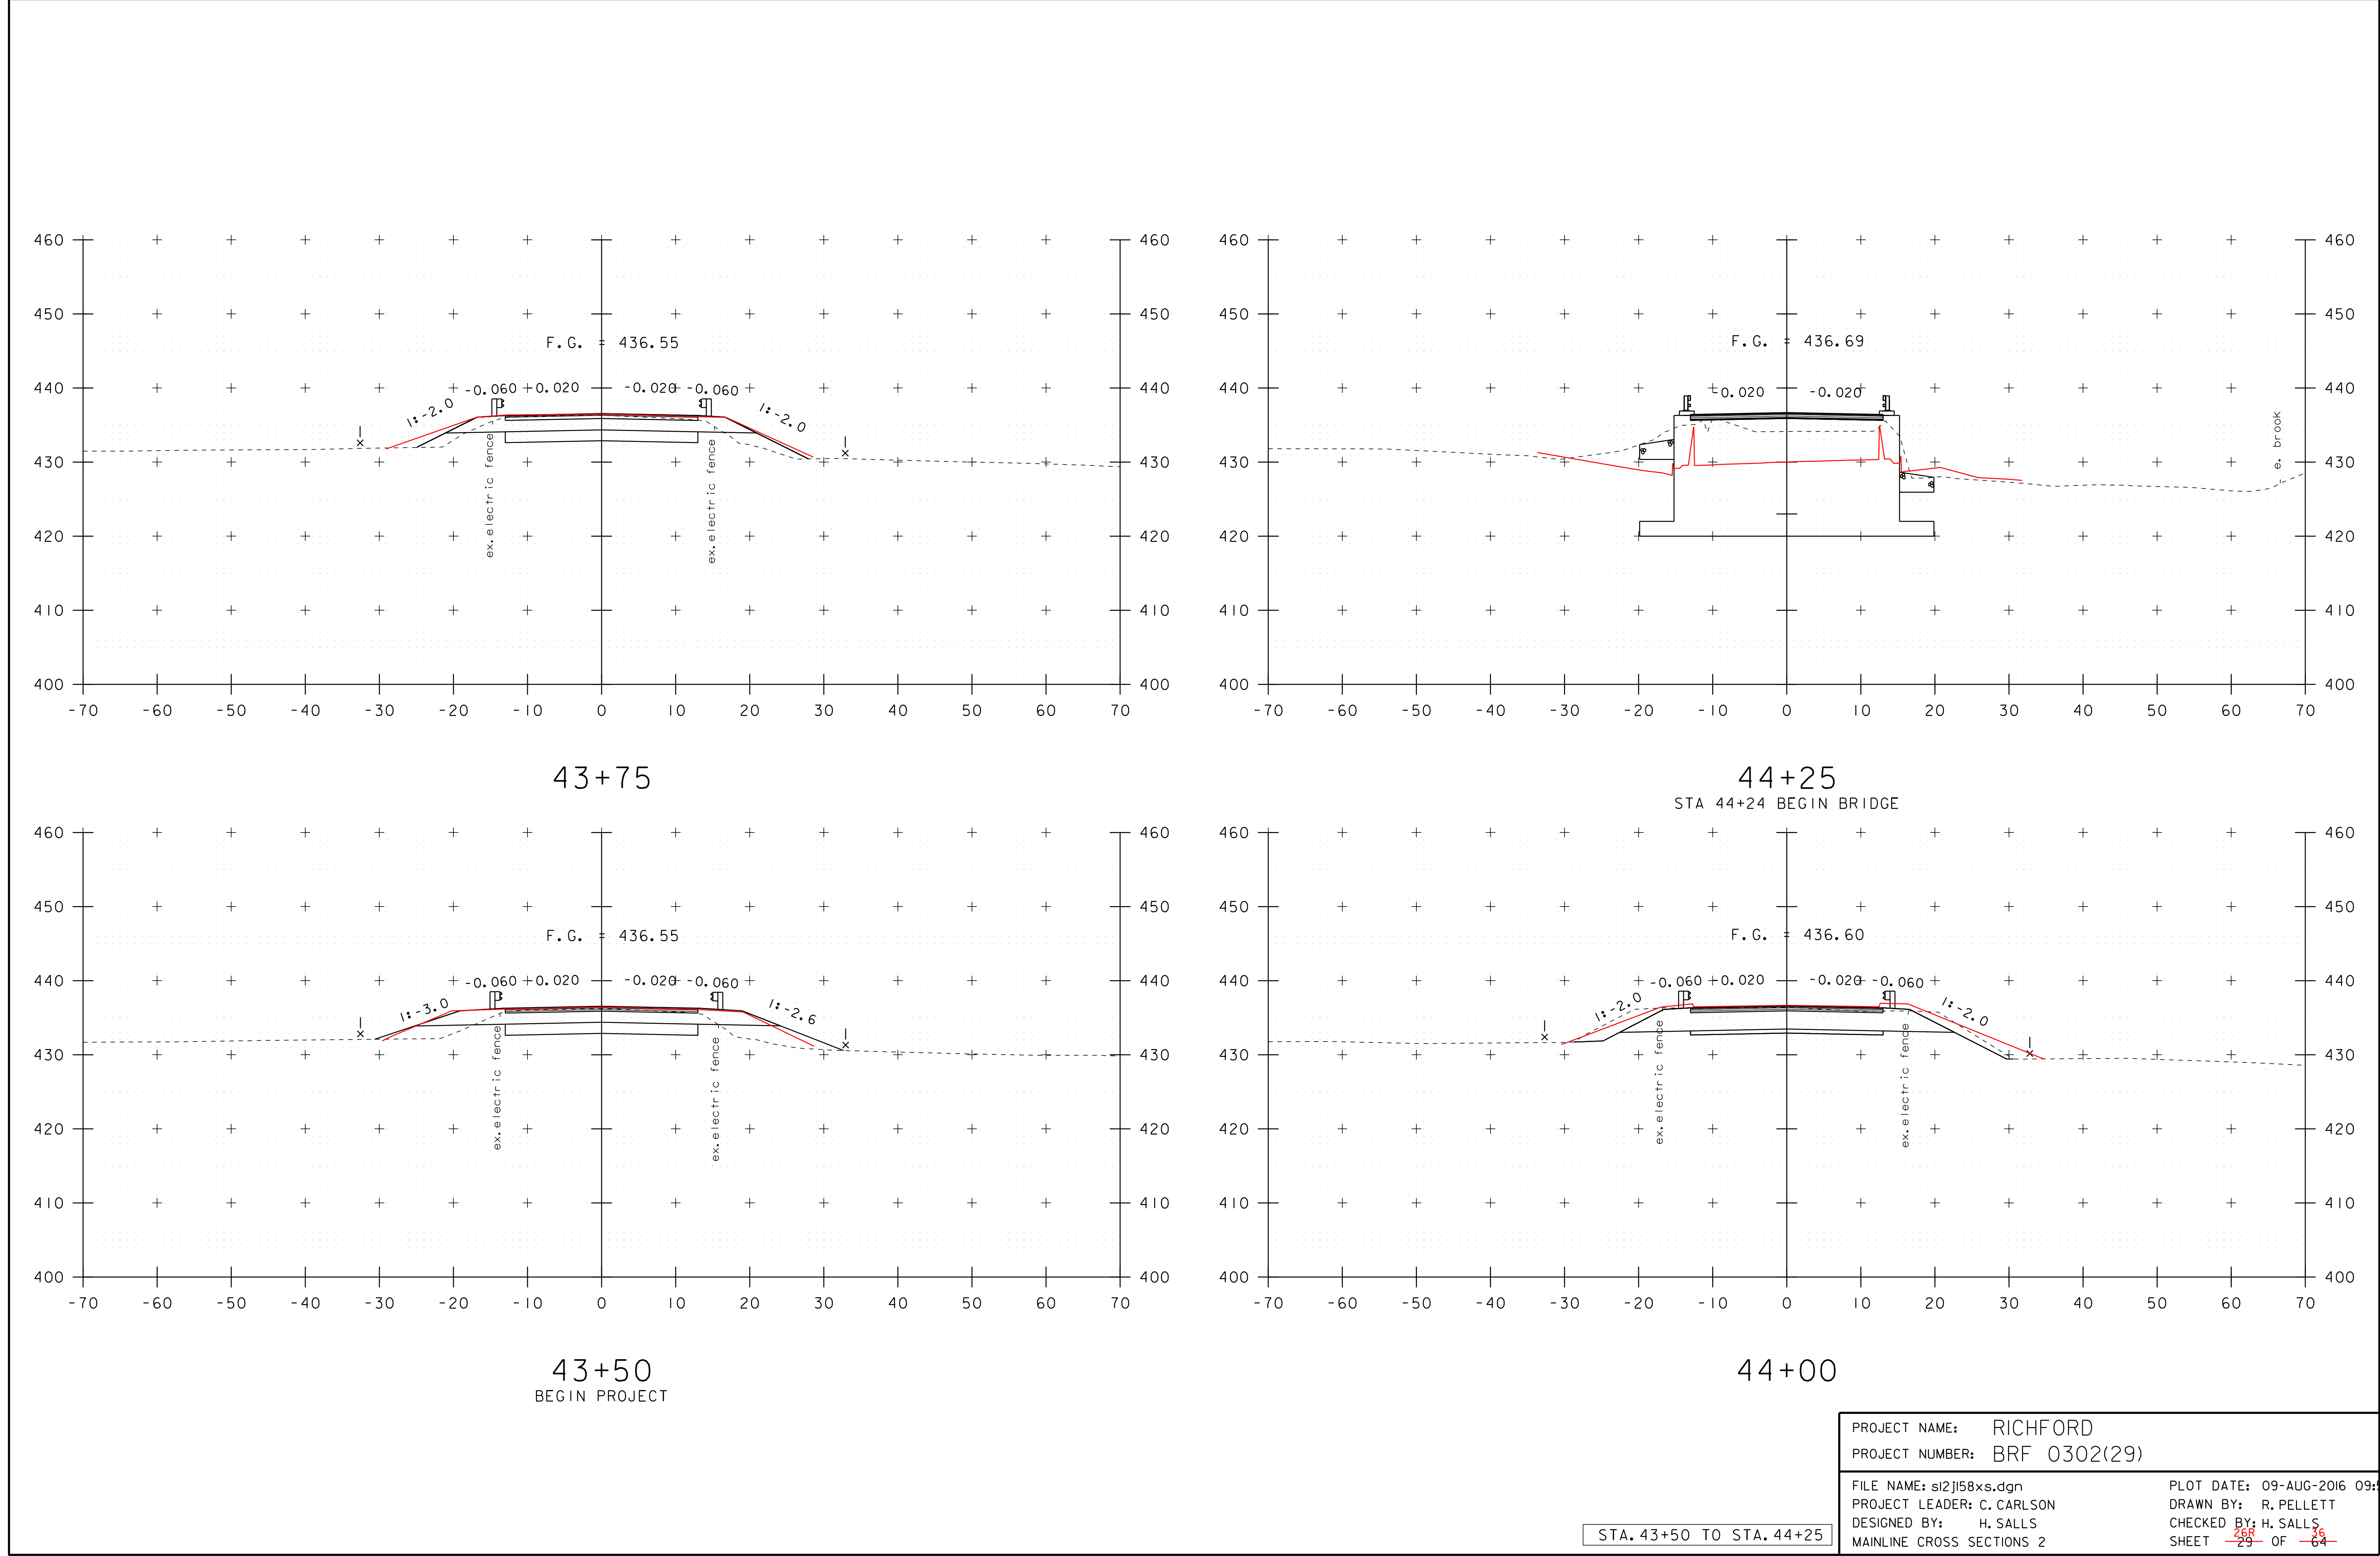



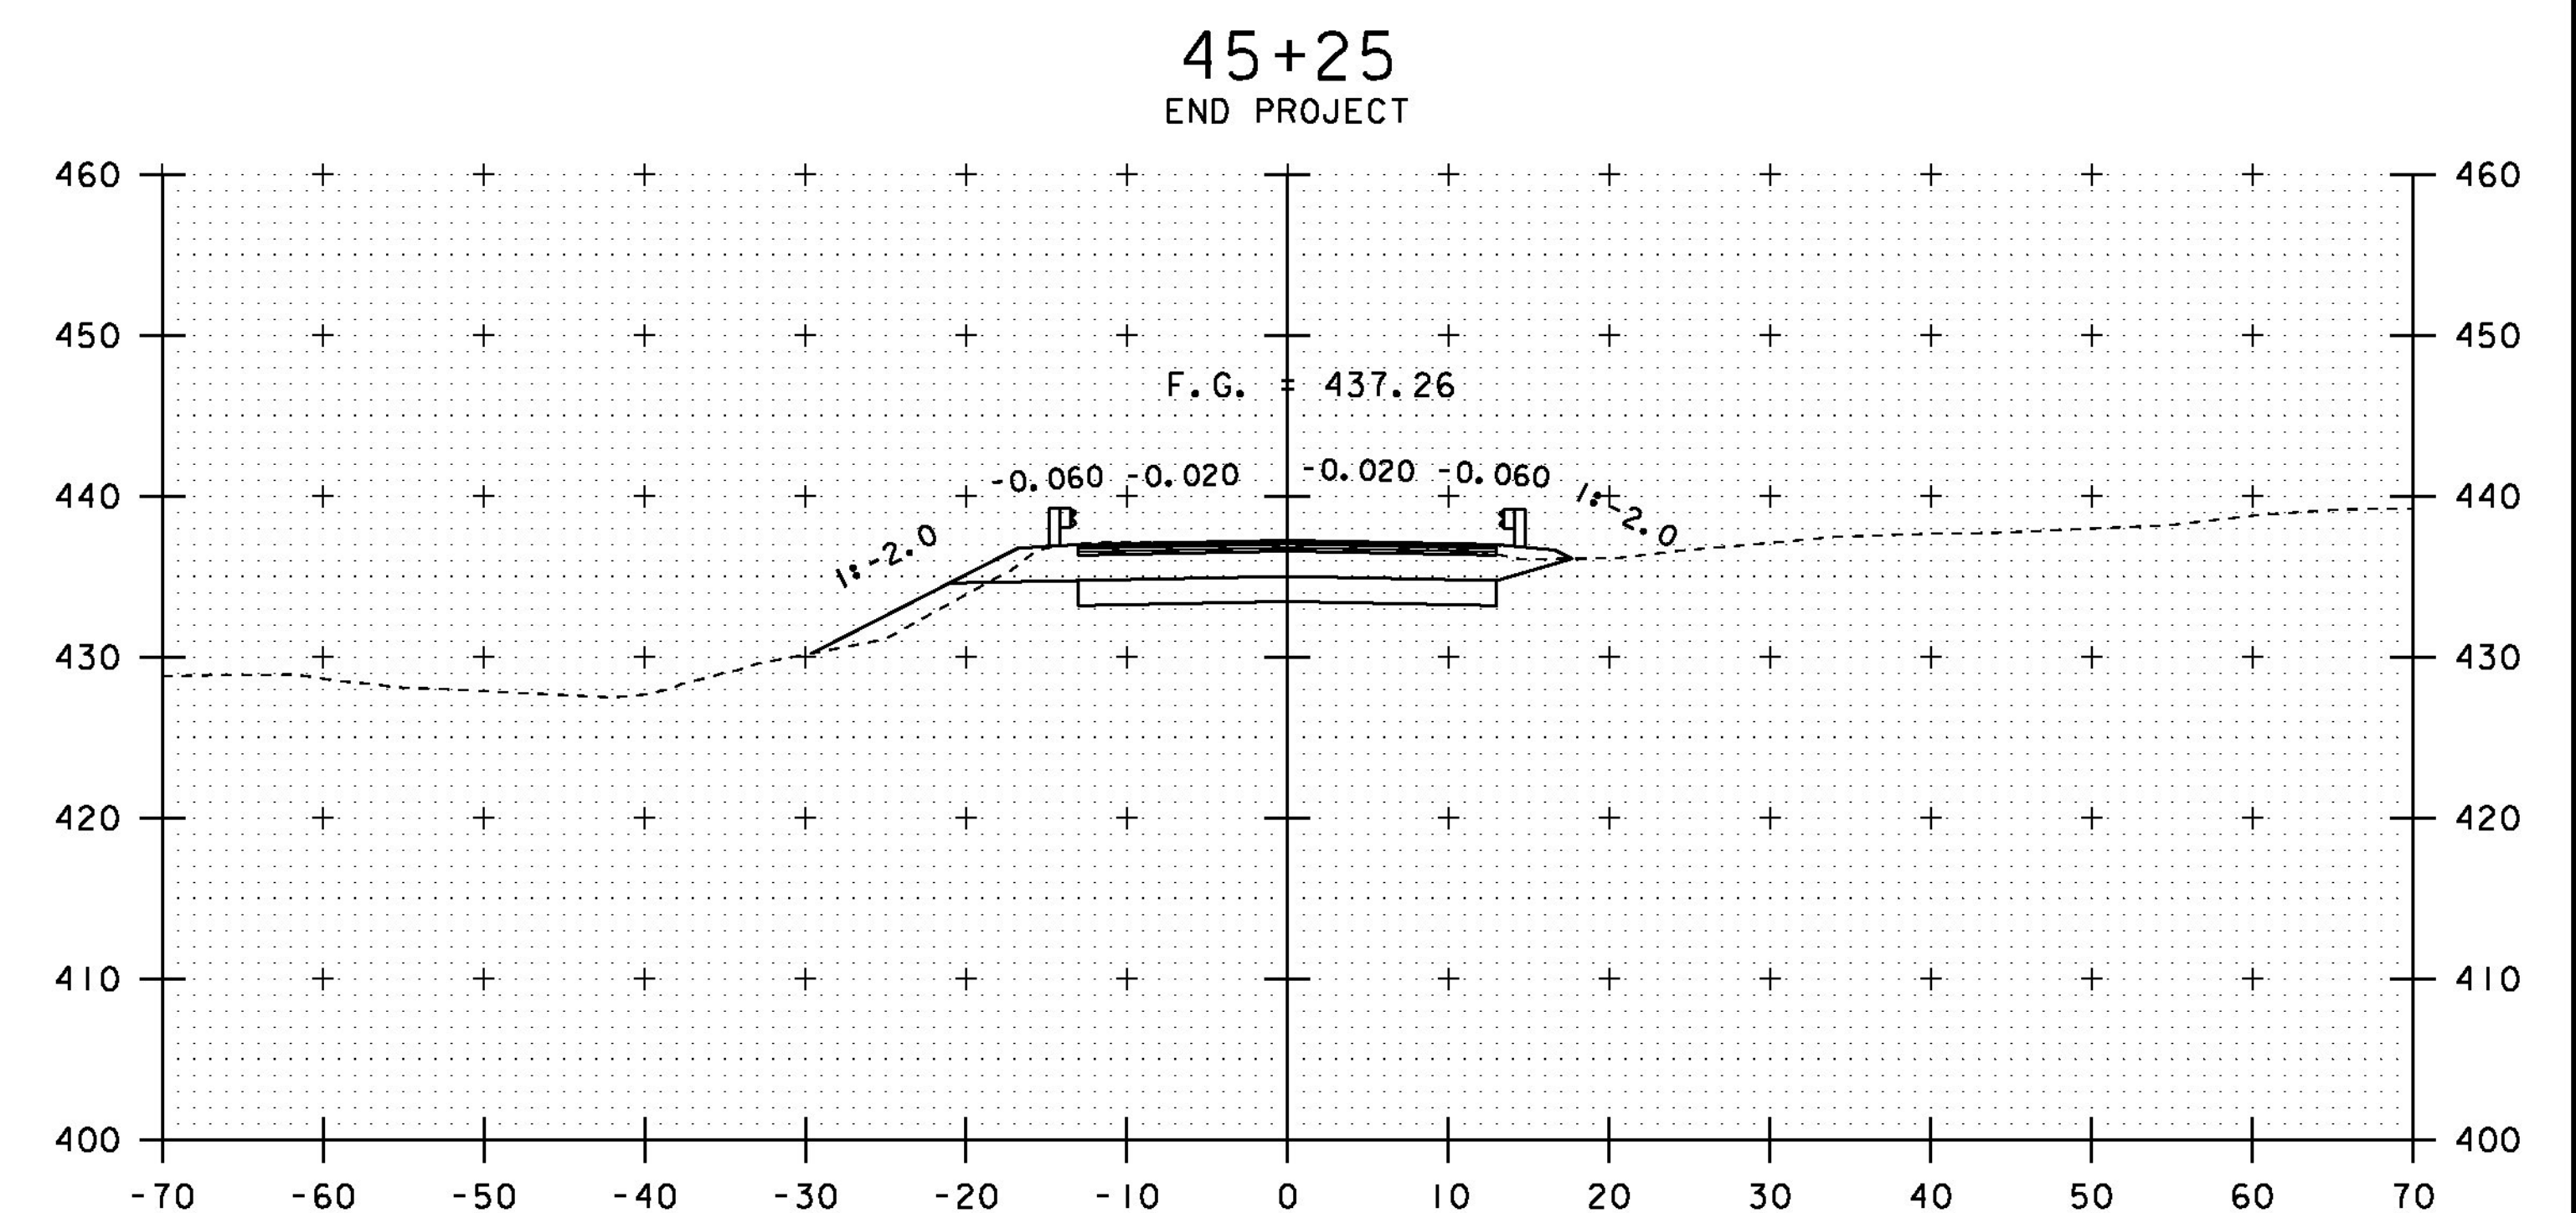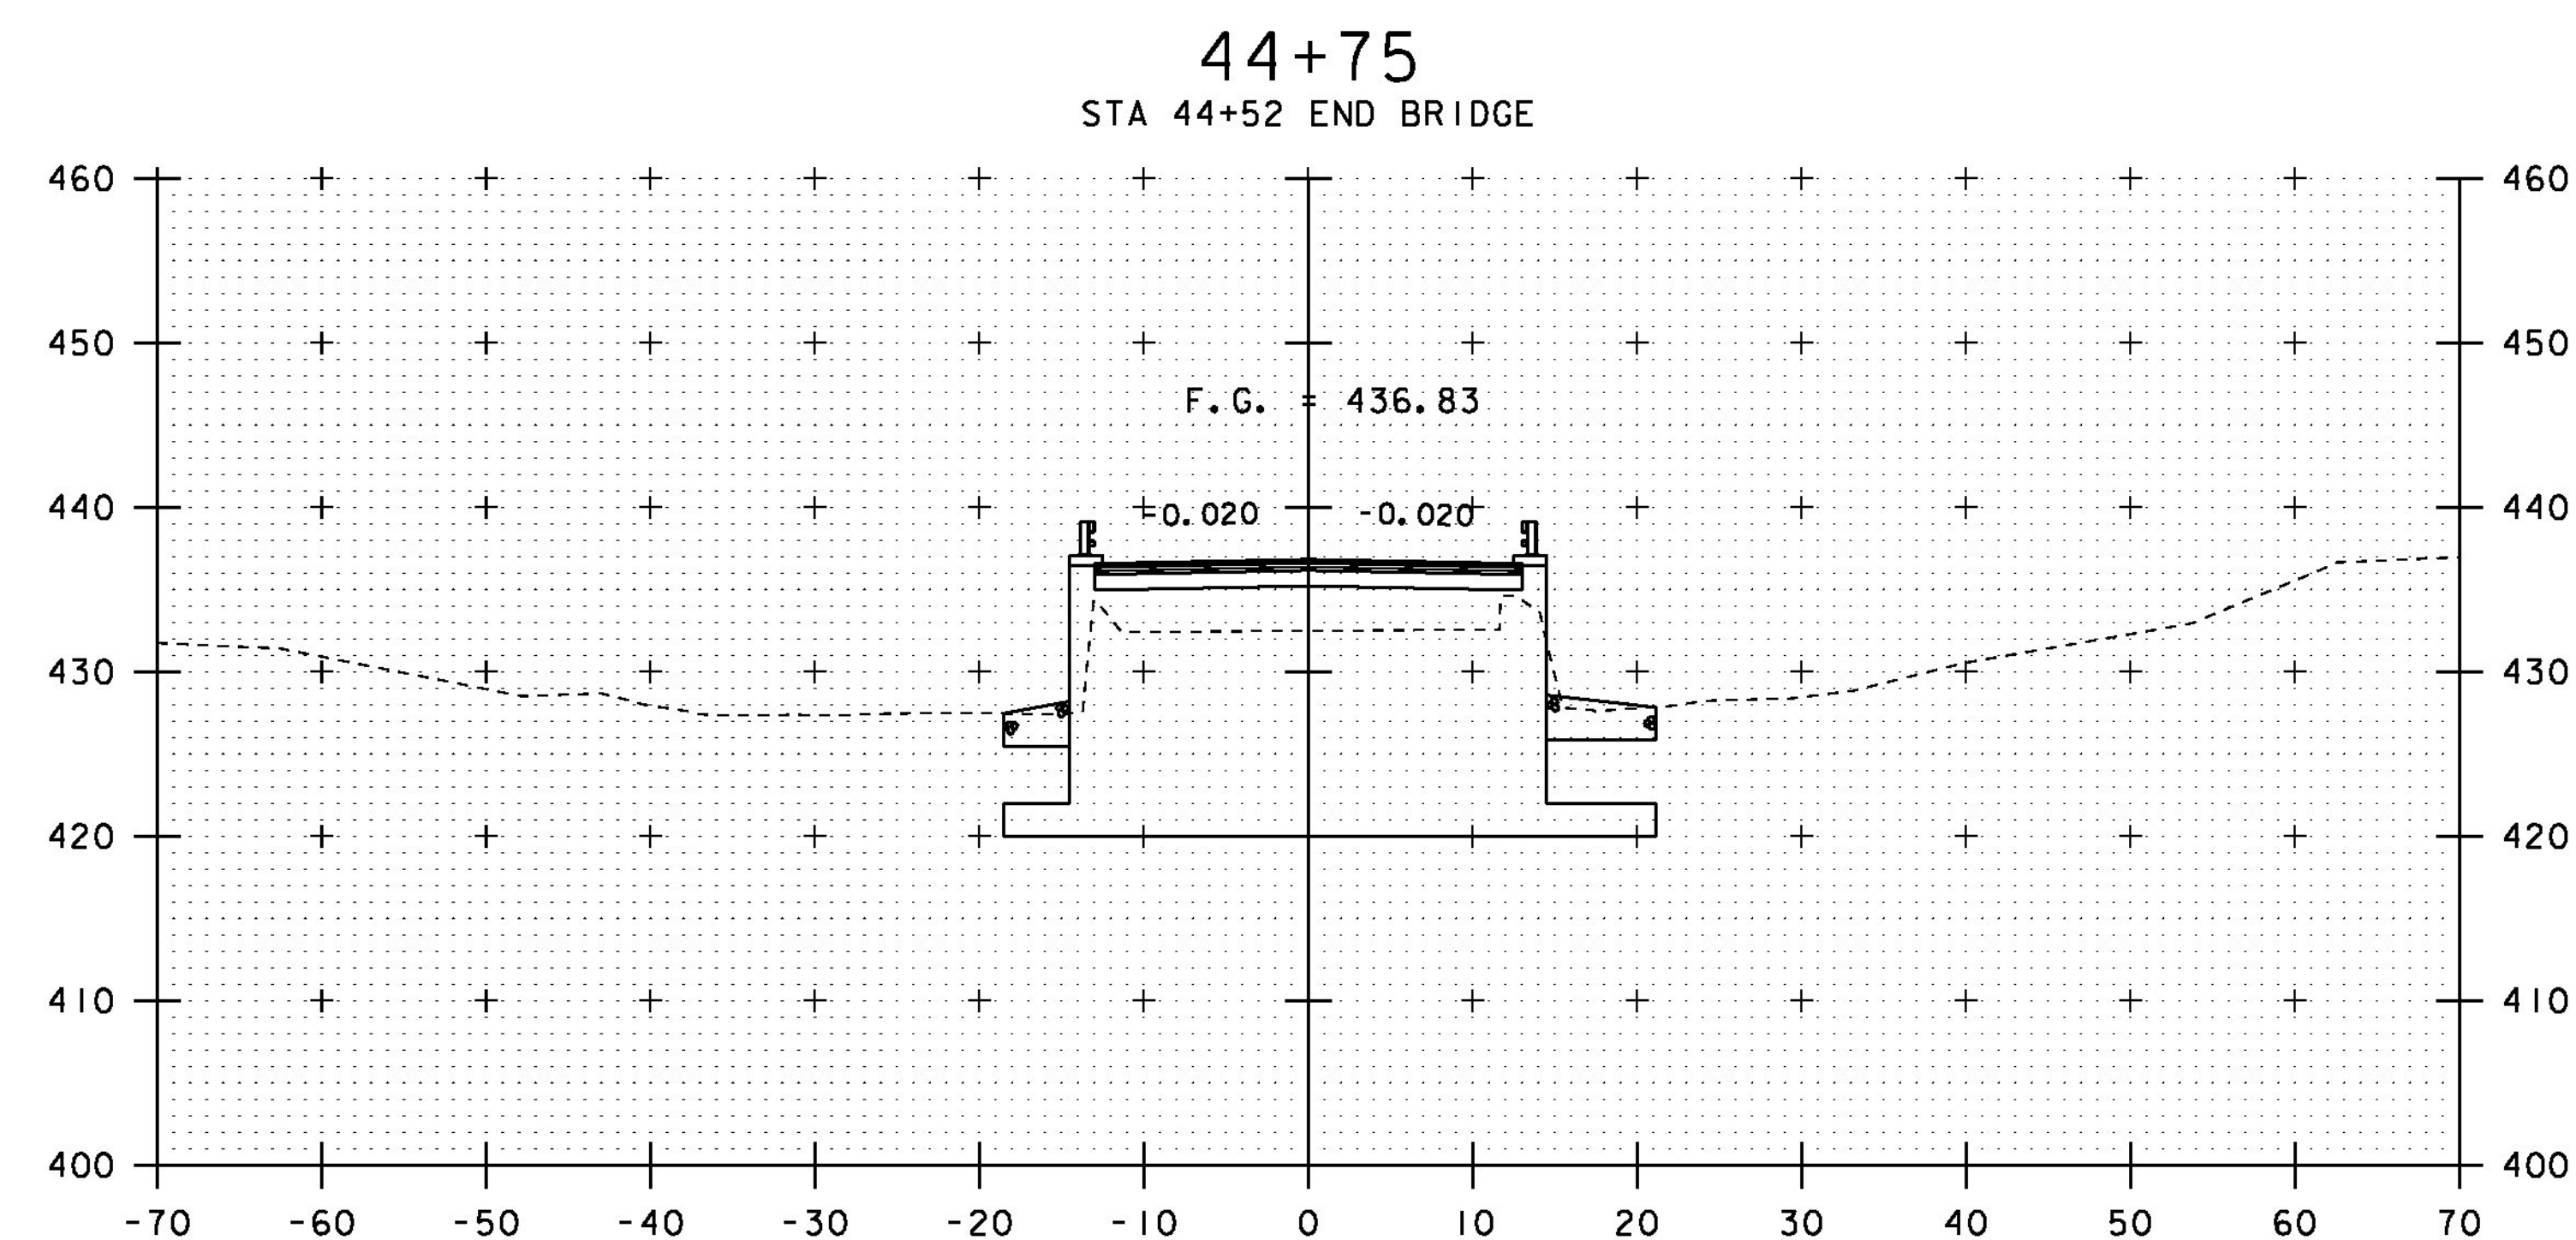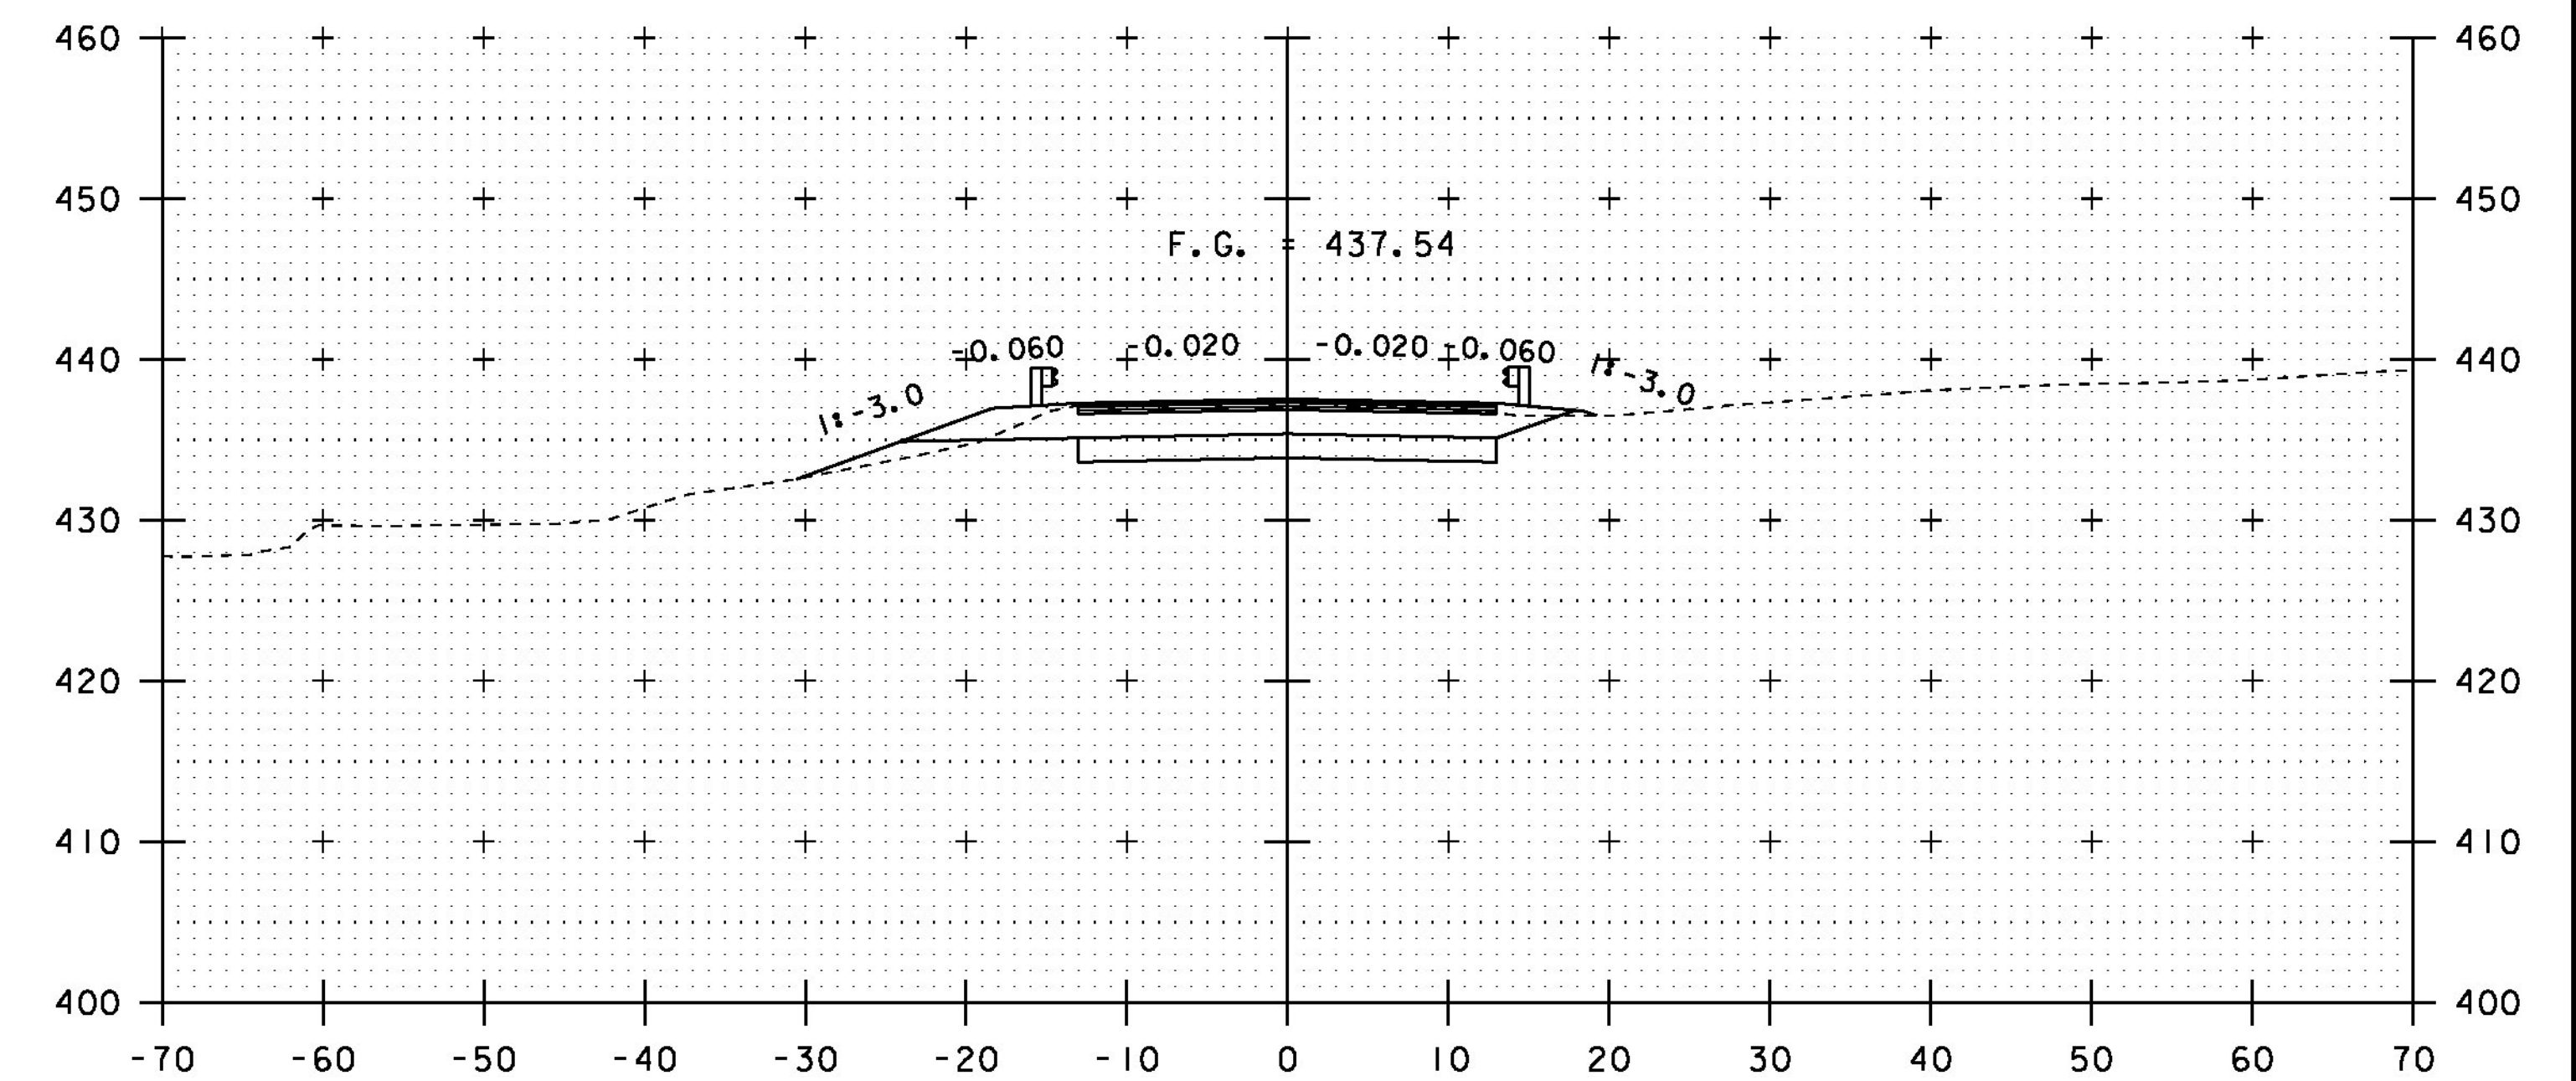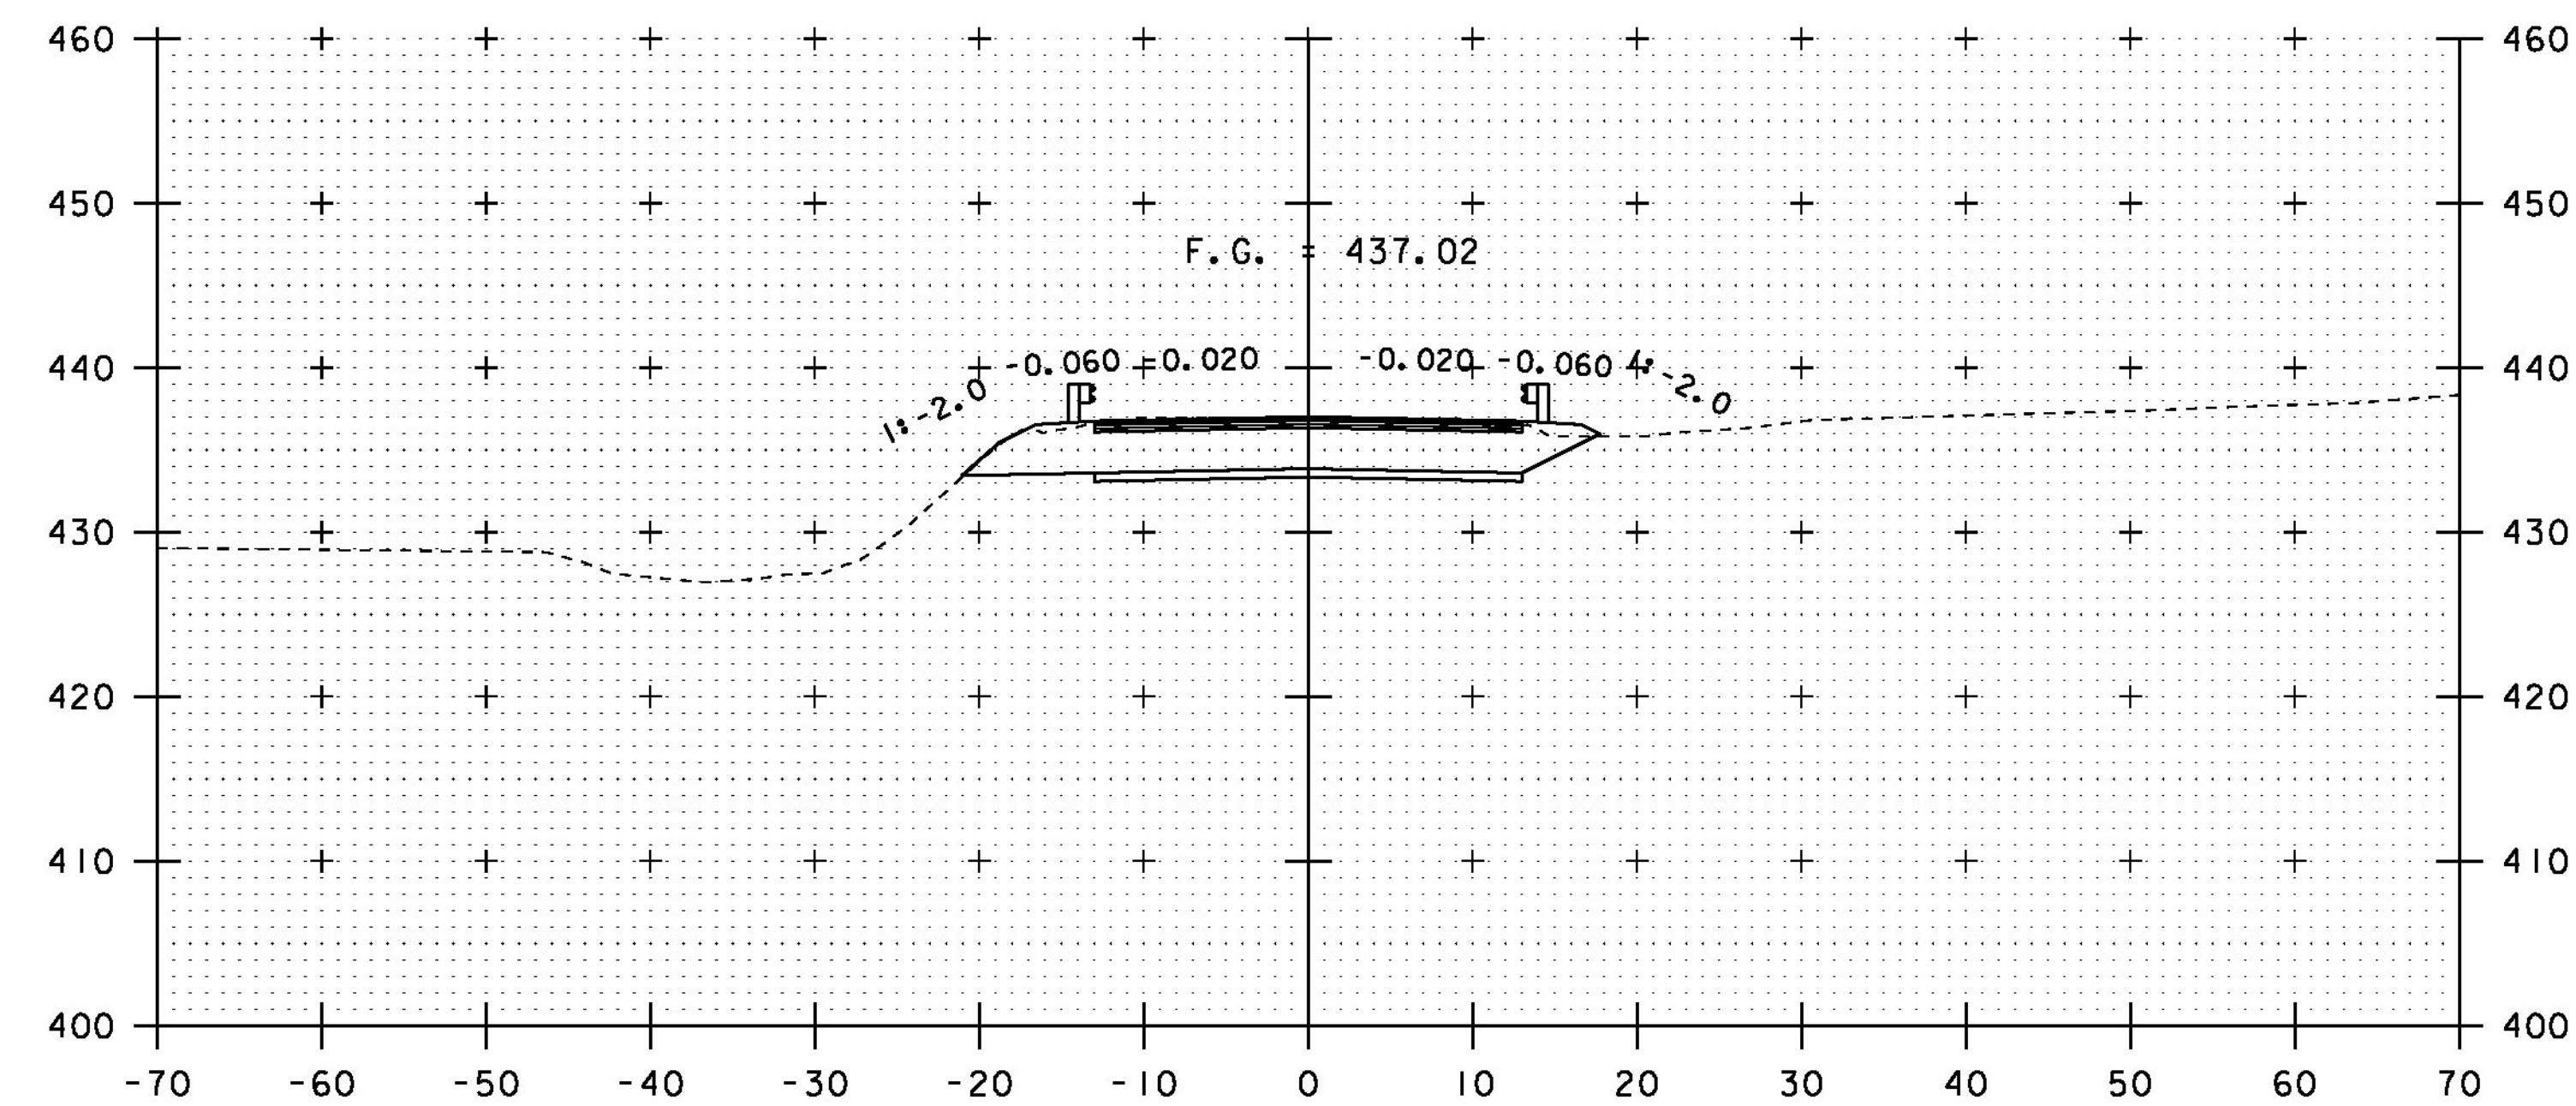


44+50

45+00

STA. 44+50 TO STA. 45+25

PROJECT NAME: RICHFORD	
PROJECT NUMBER: BRF 0302(29)	
FILE NAME: sl2j158xs.dgn	PLOT DATE: 11-DEC-2014
PROJECT LEADER: C. CARLSON	DRAWN BY: R. PELLETT
DESIGNED BY: H. SALLS	CHECKED BY: H. SALLS
MAINLINE CROSS SECTIONS 3	SHEET 27 OF 36



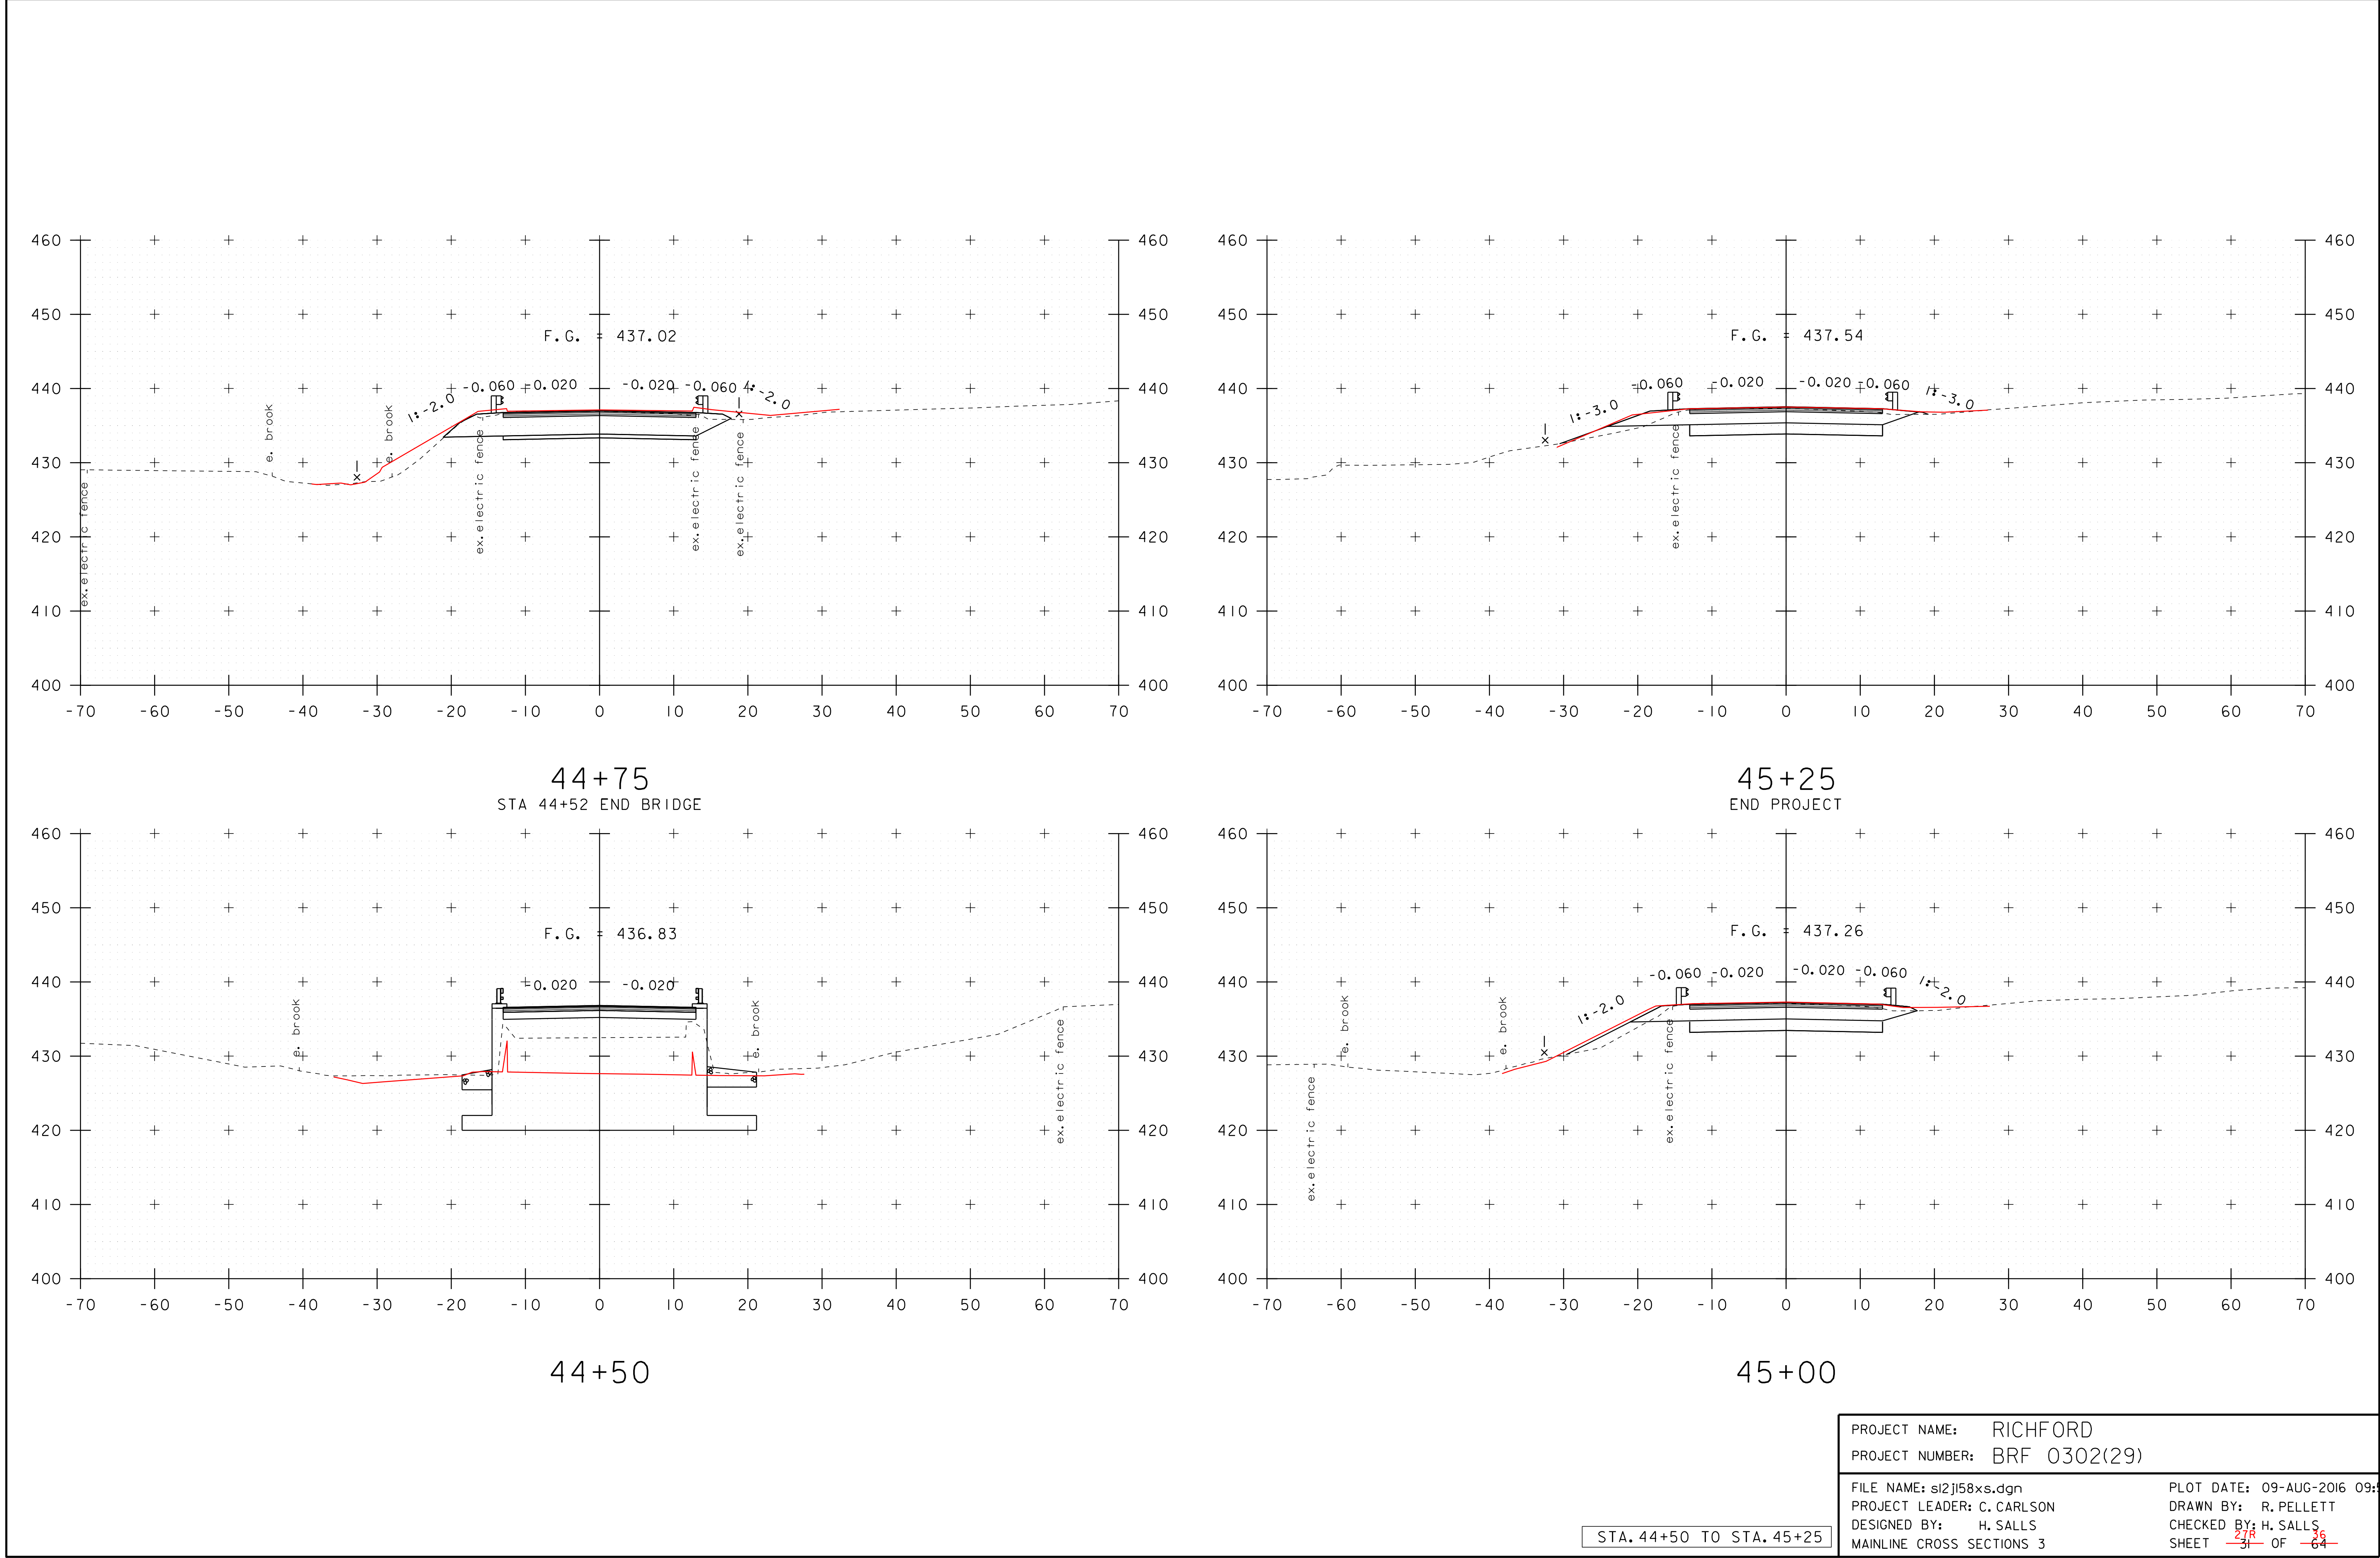





STA. 44+50 TO STA. 45+25

PROJECT NAME: RICHFORD  
PROJECT NUMBER: BRF 0302(29)

FILE NAME: sl2j58xs.dgn  
PROJECT LEADER: C. CARLSON  
DESIGNED BY: H. SALLS  
MAINLINE CROSS SECTIONS 3

PLOT DATE: 09-AUG-2016 09:57  
DRAWN BY: R. PELLETT  
CHECKED BY: H. SALLS  
SHEET 28 OF 24



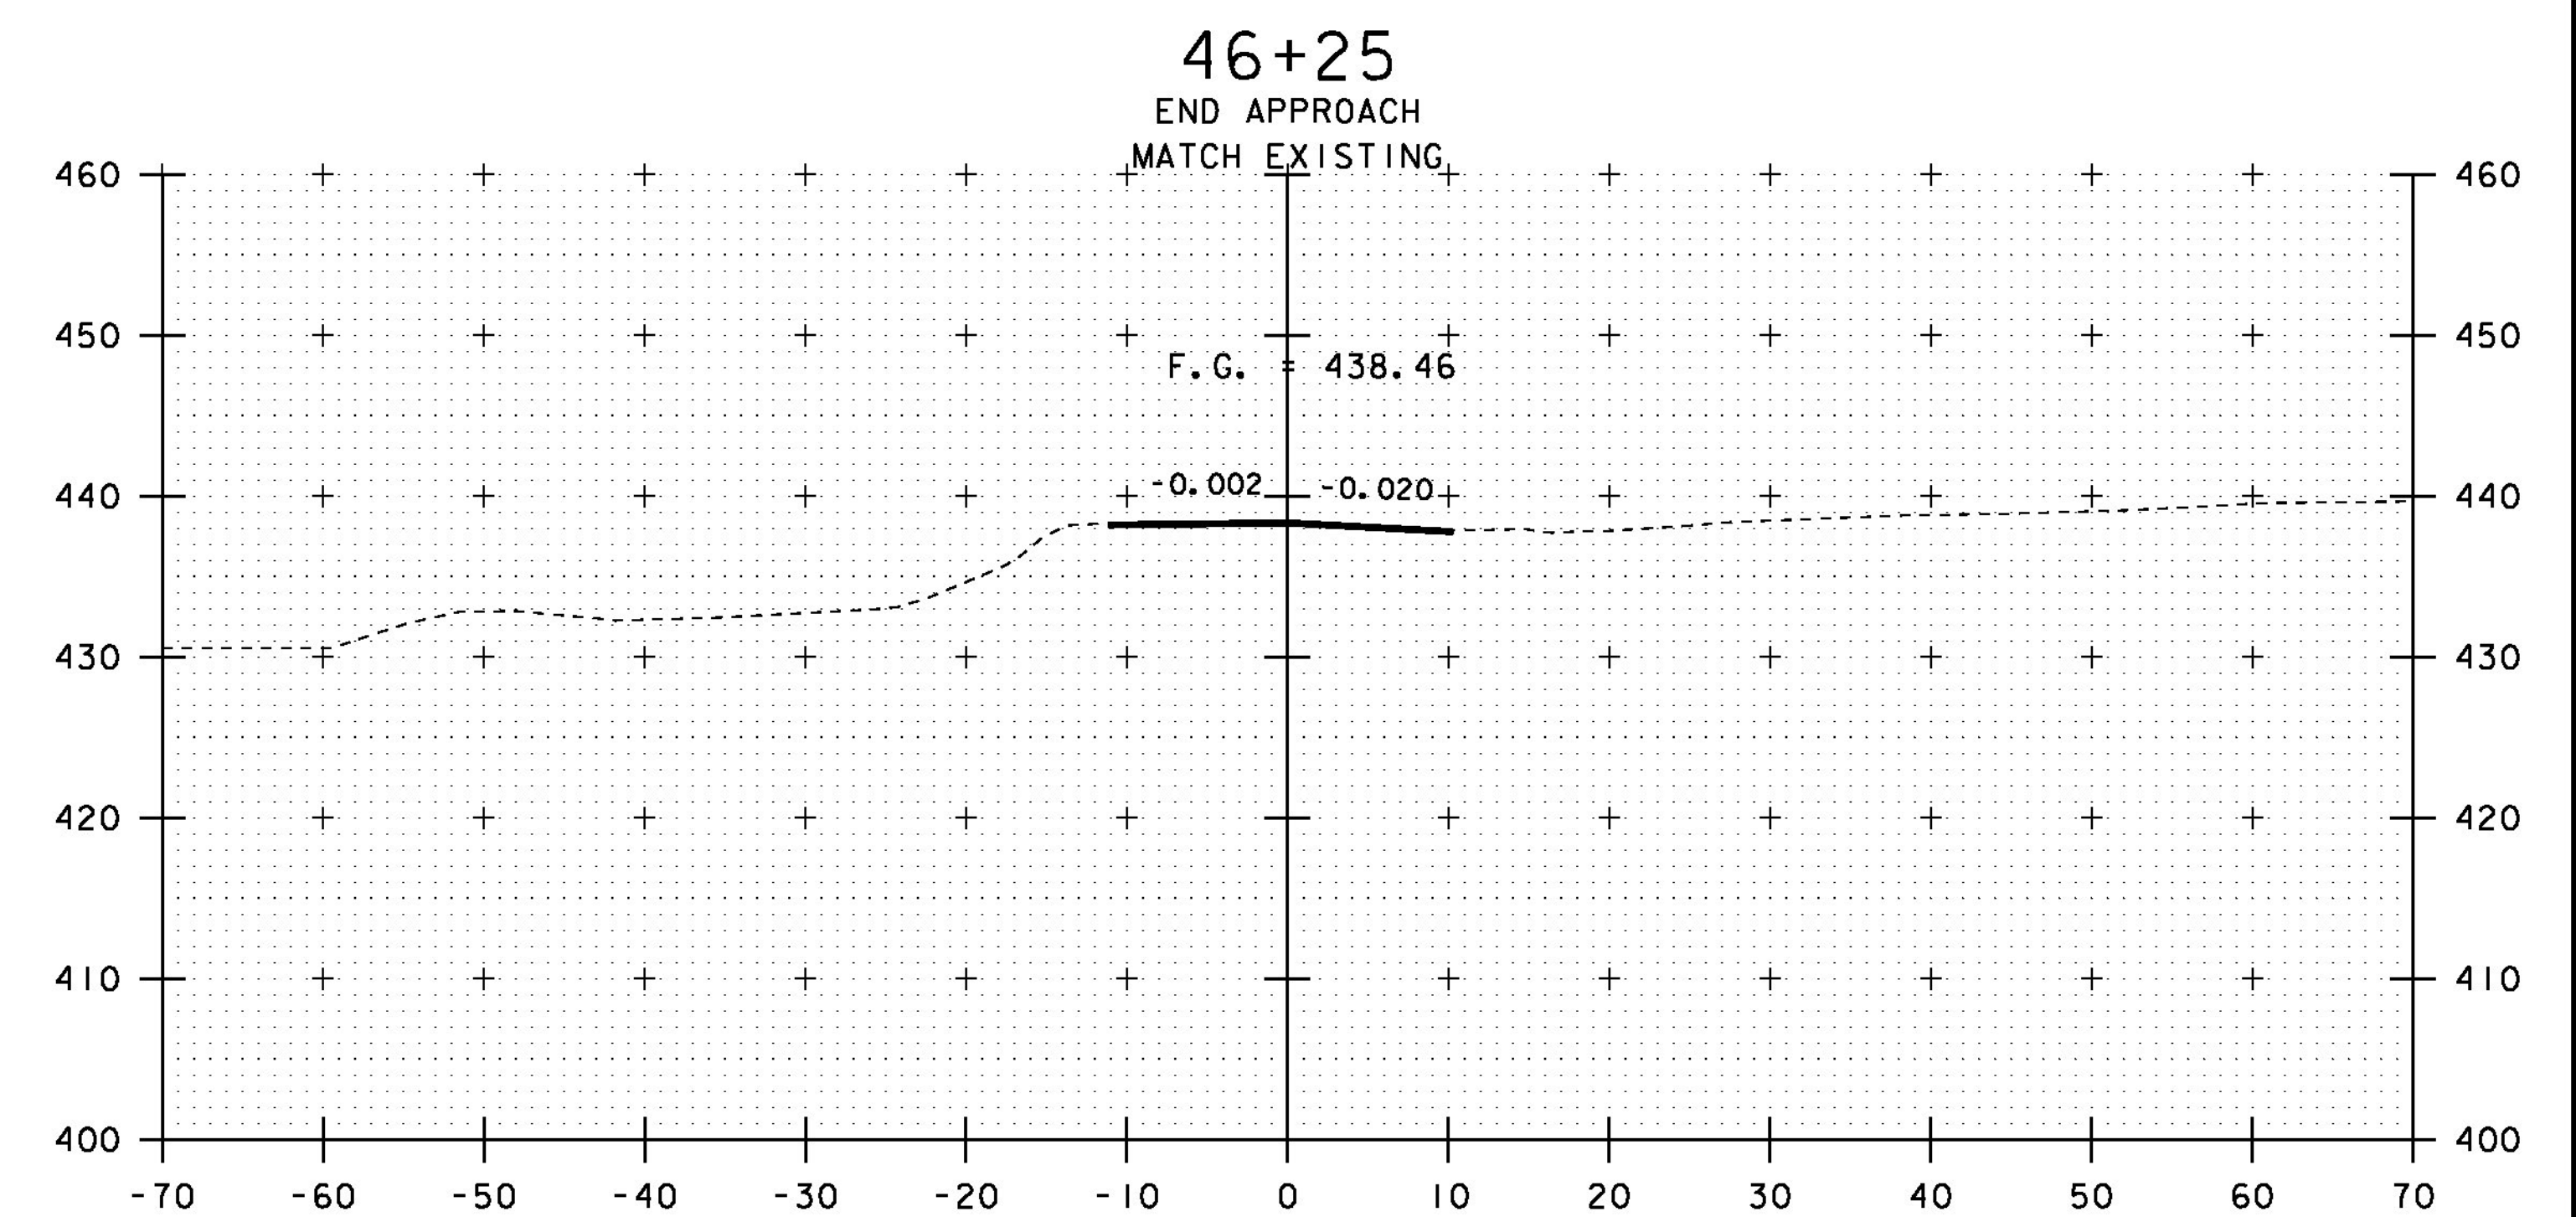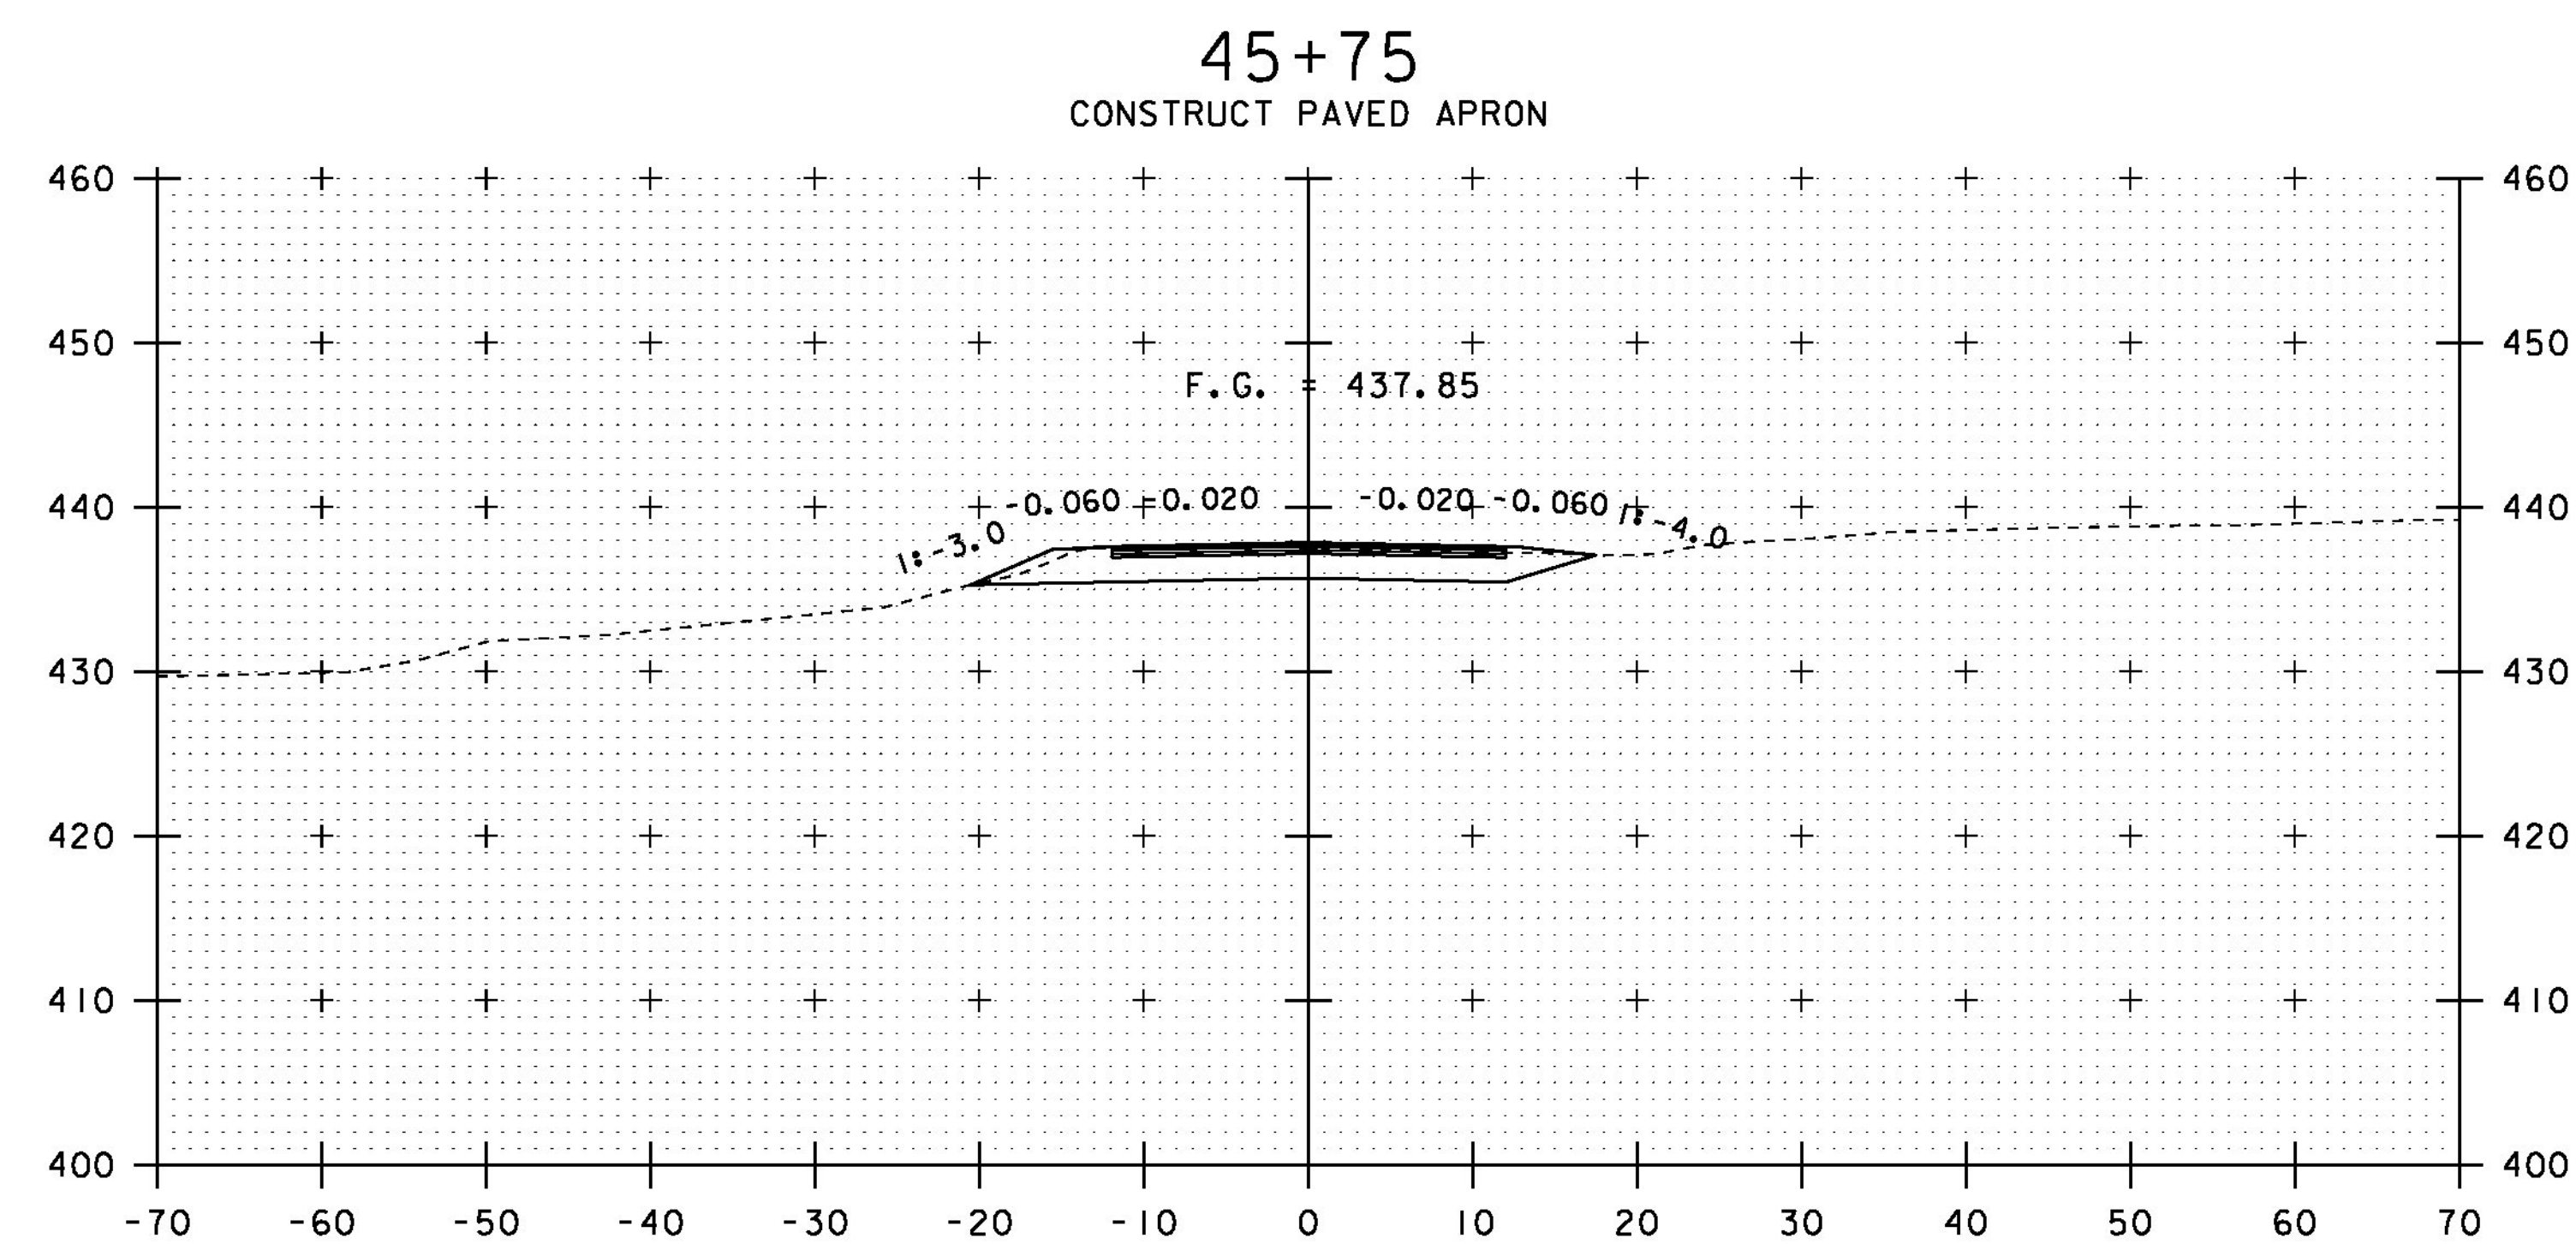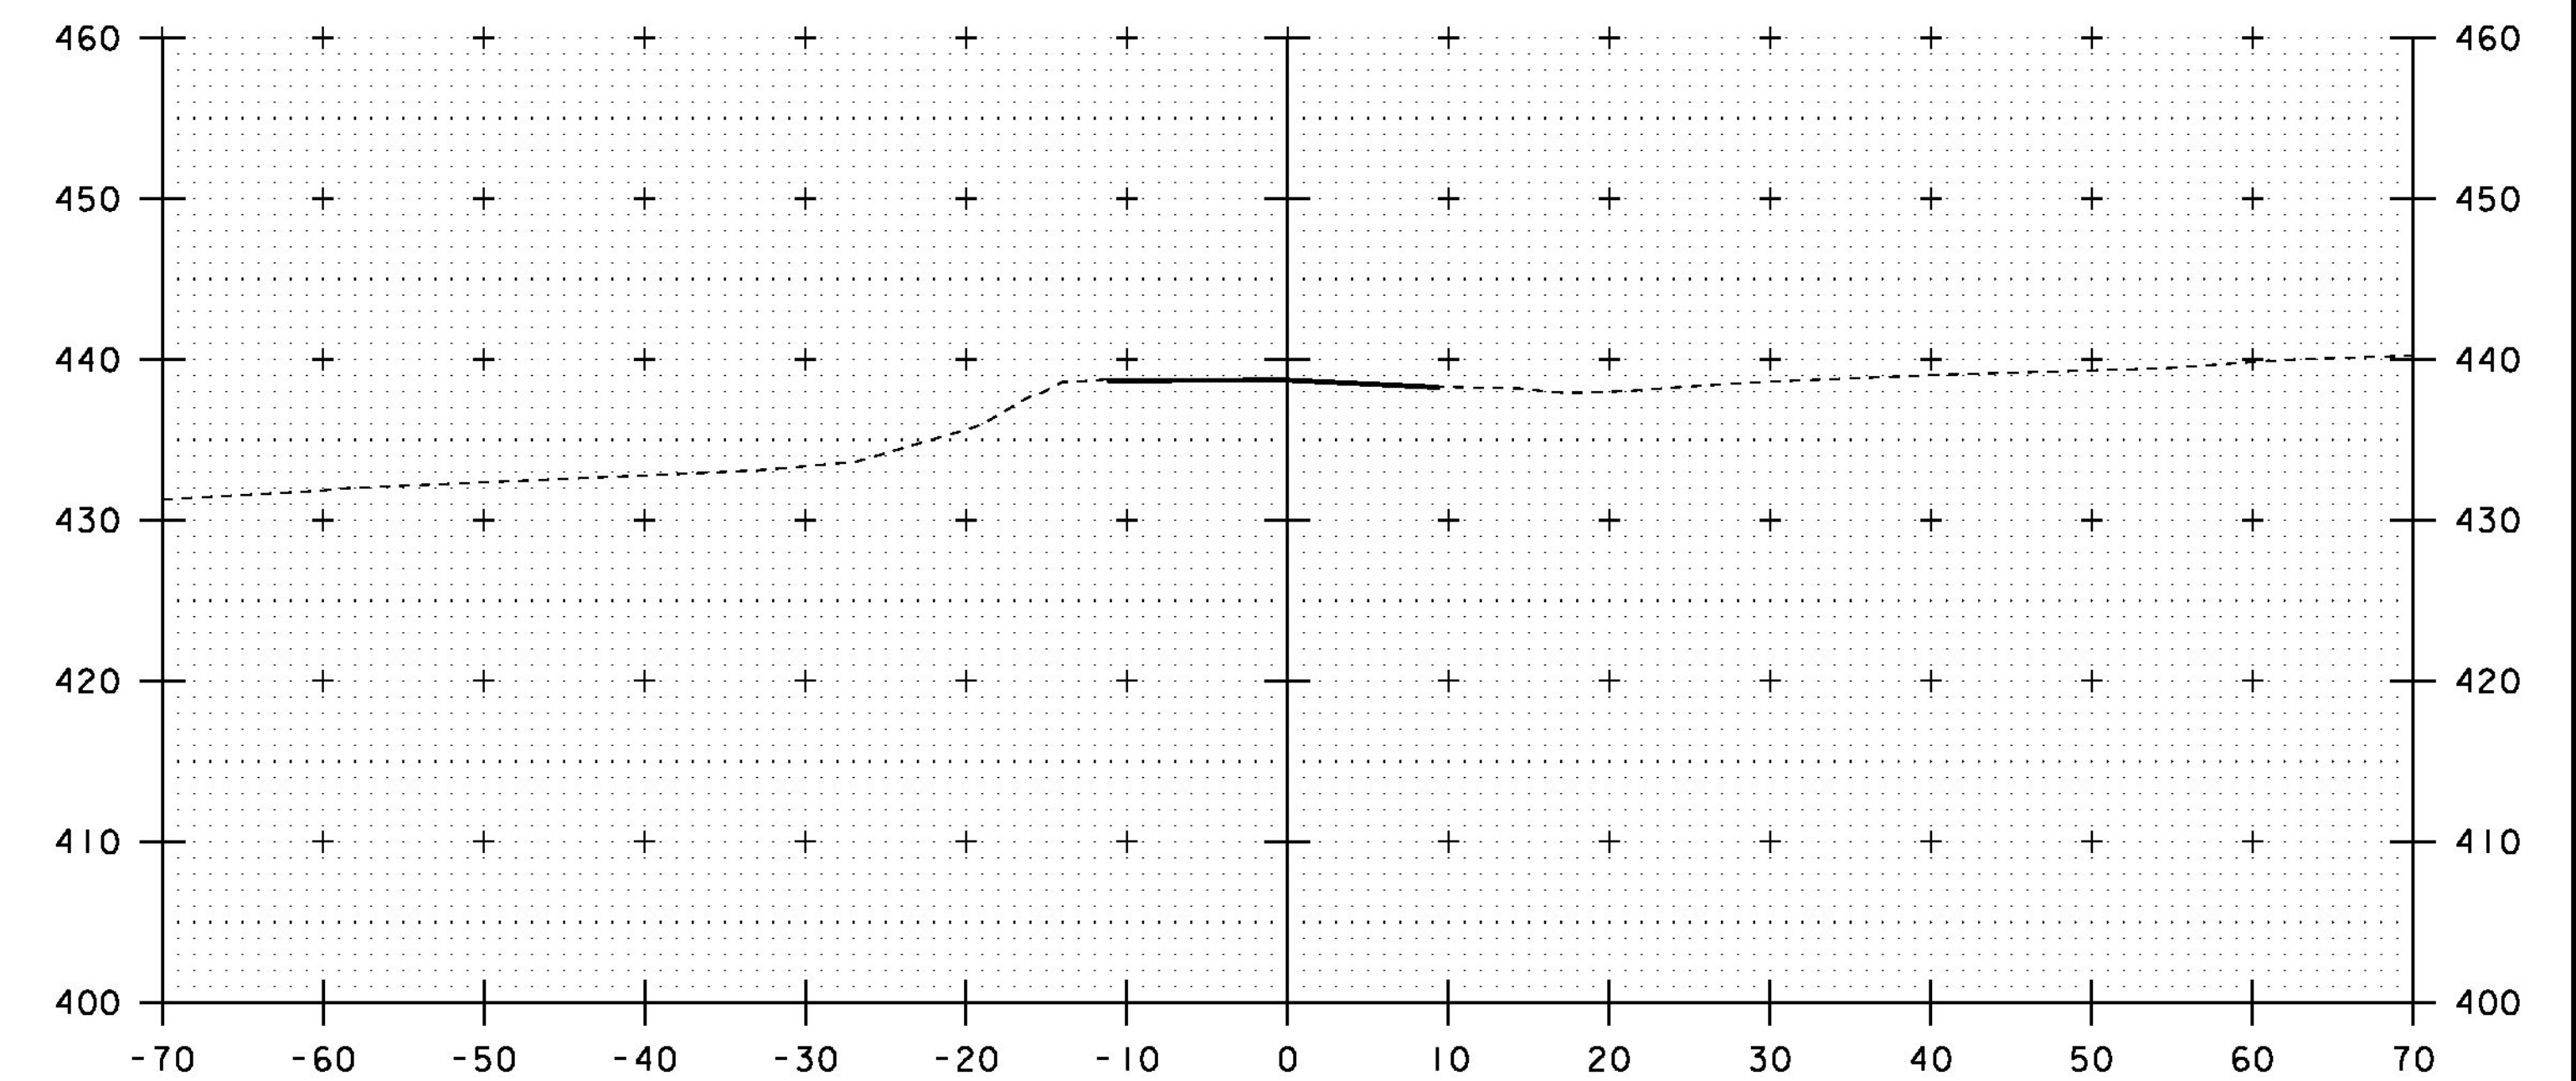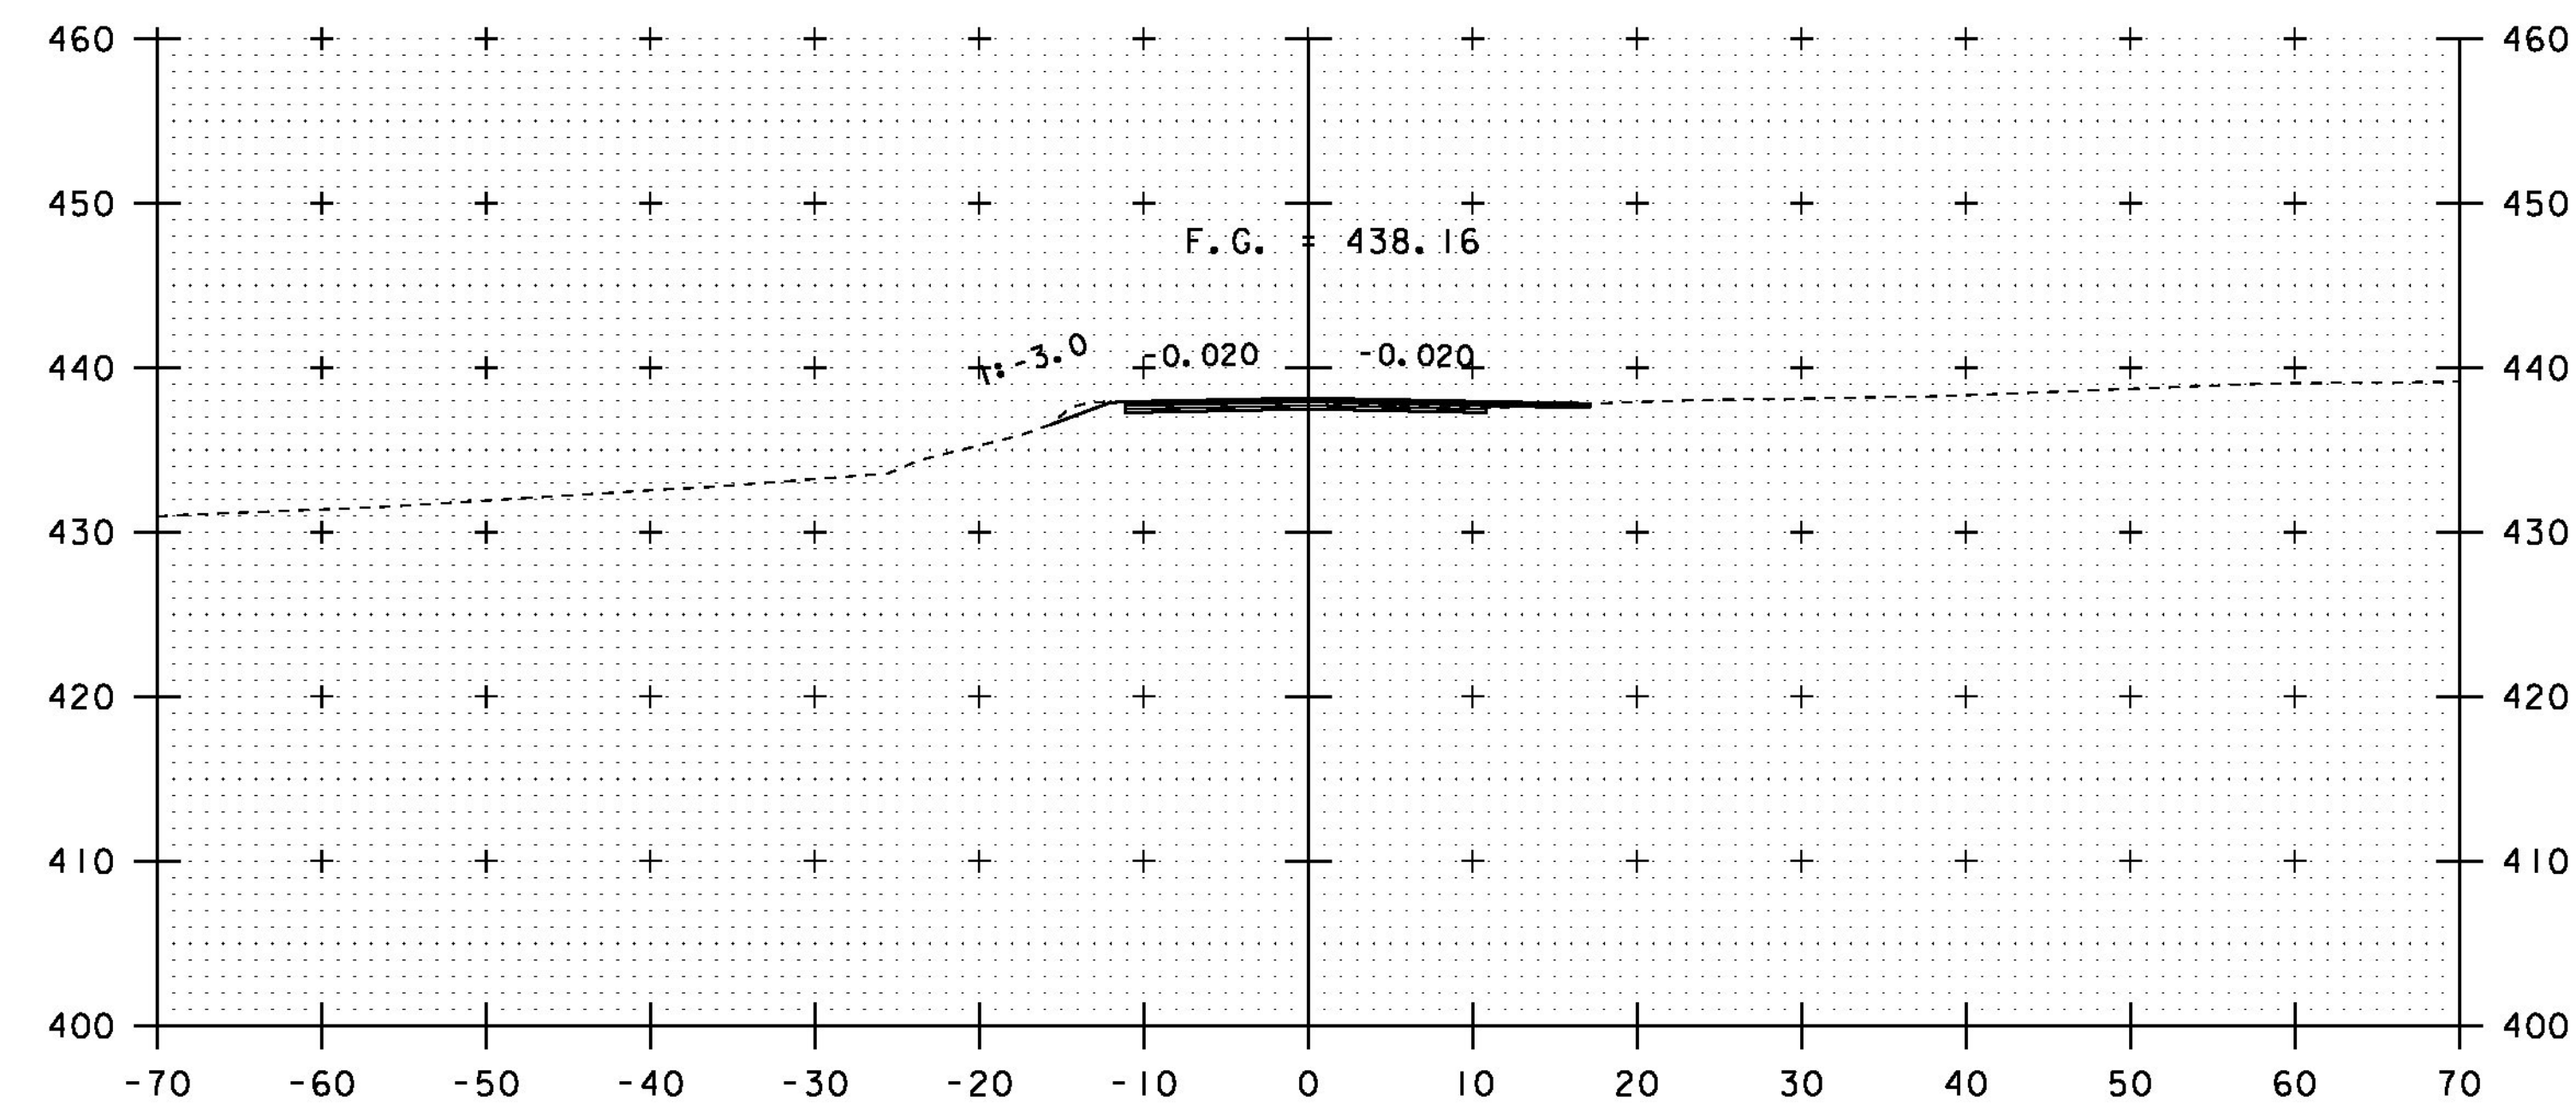


45+50

46+00


STA. 45+50 TO STA. 46+25

PROJECT NAME: RICHFORD	
PROJECT NUMBER: BRF 0302(29)	
FILE NAME: sl2j158xs.dgn	PLOT DATE: 11-DEC-2014
PROJECT LEADER: C. CARLSON	DRAWN BY: R. PELLETT
DESIGNED BY: H. SALLS	CHECKED BY: H. SALLS
MAINLINE CROSS SECTIONS 4	SHEET 28 OF 36



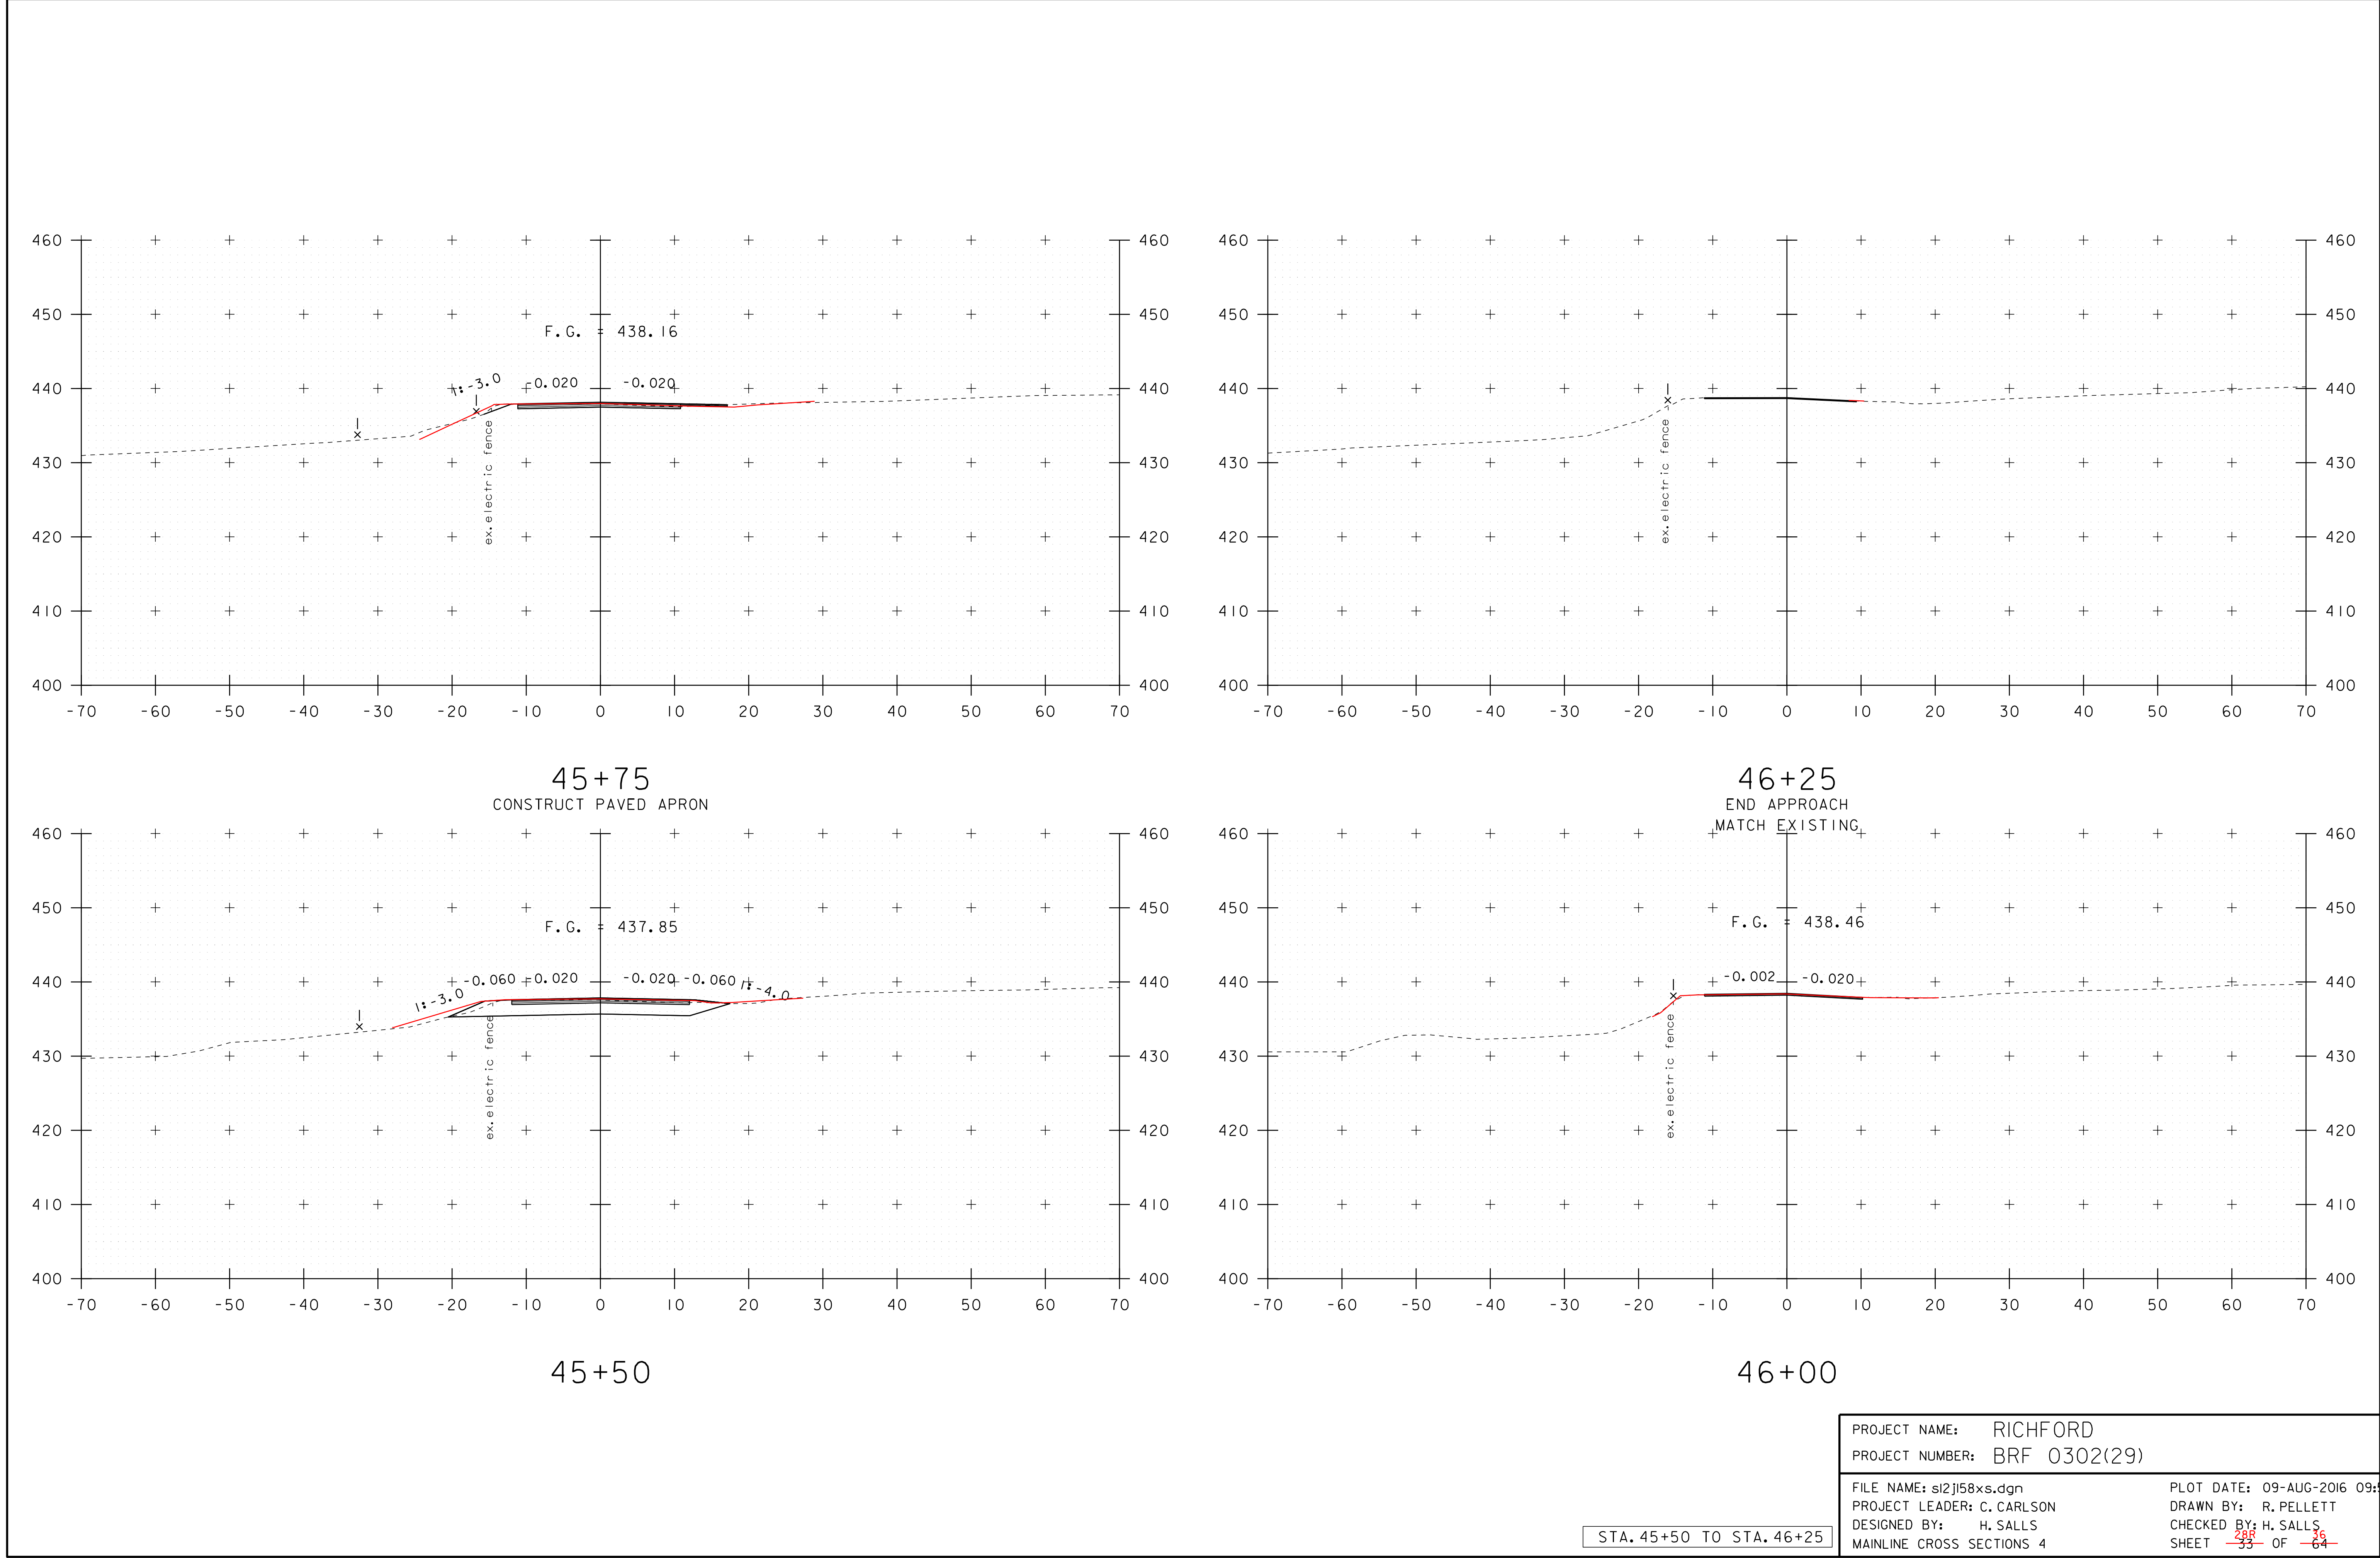




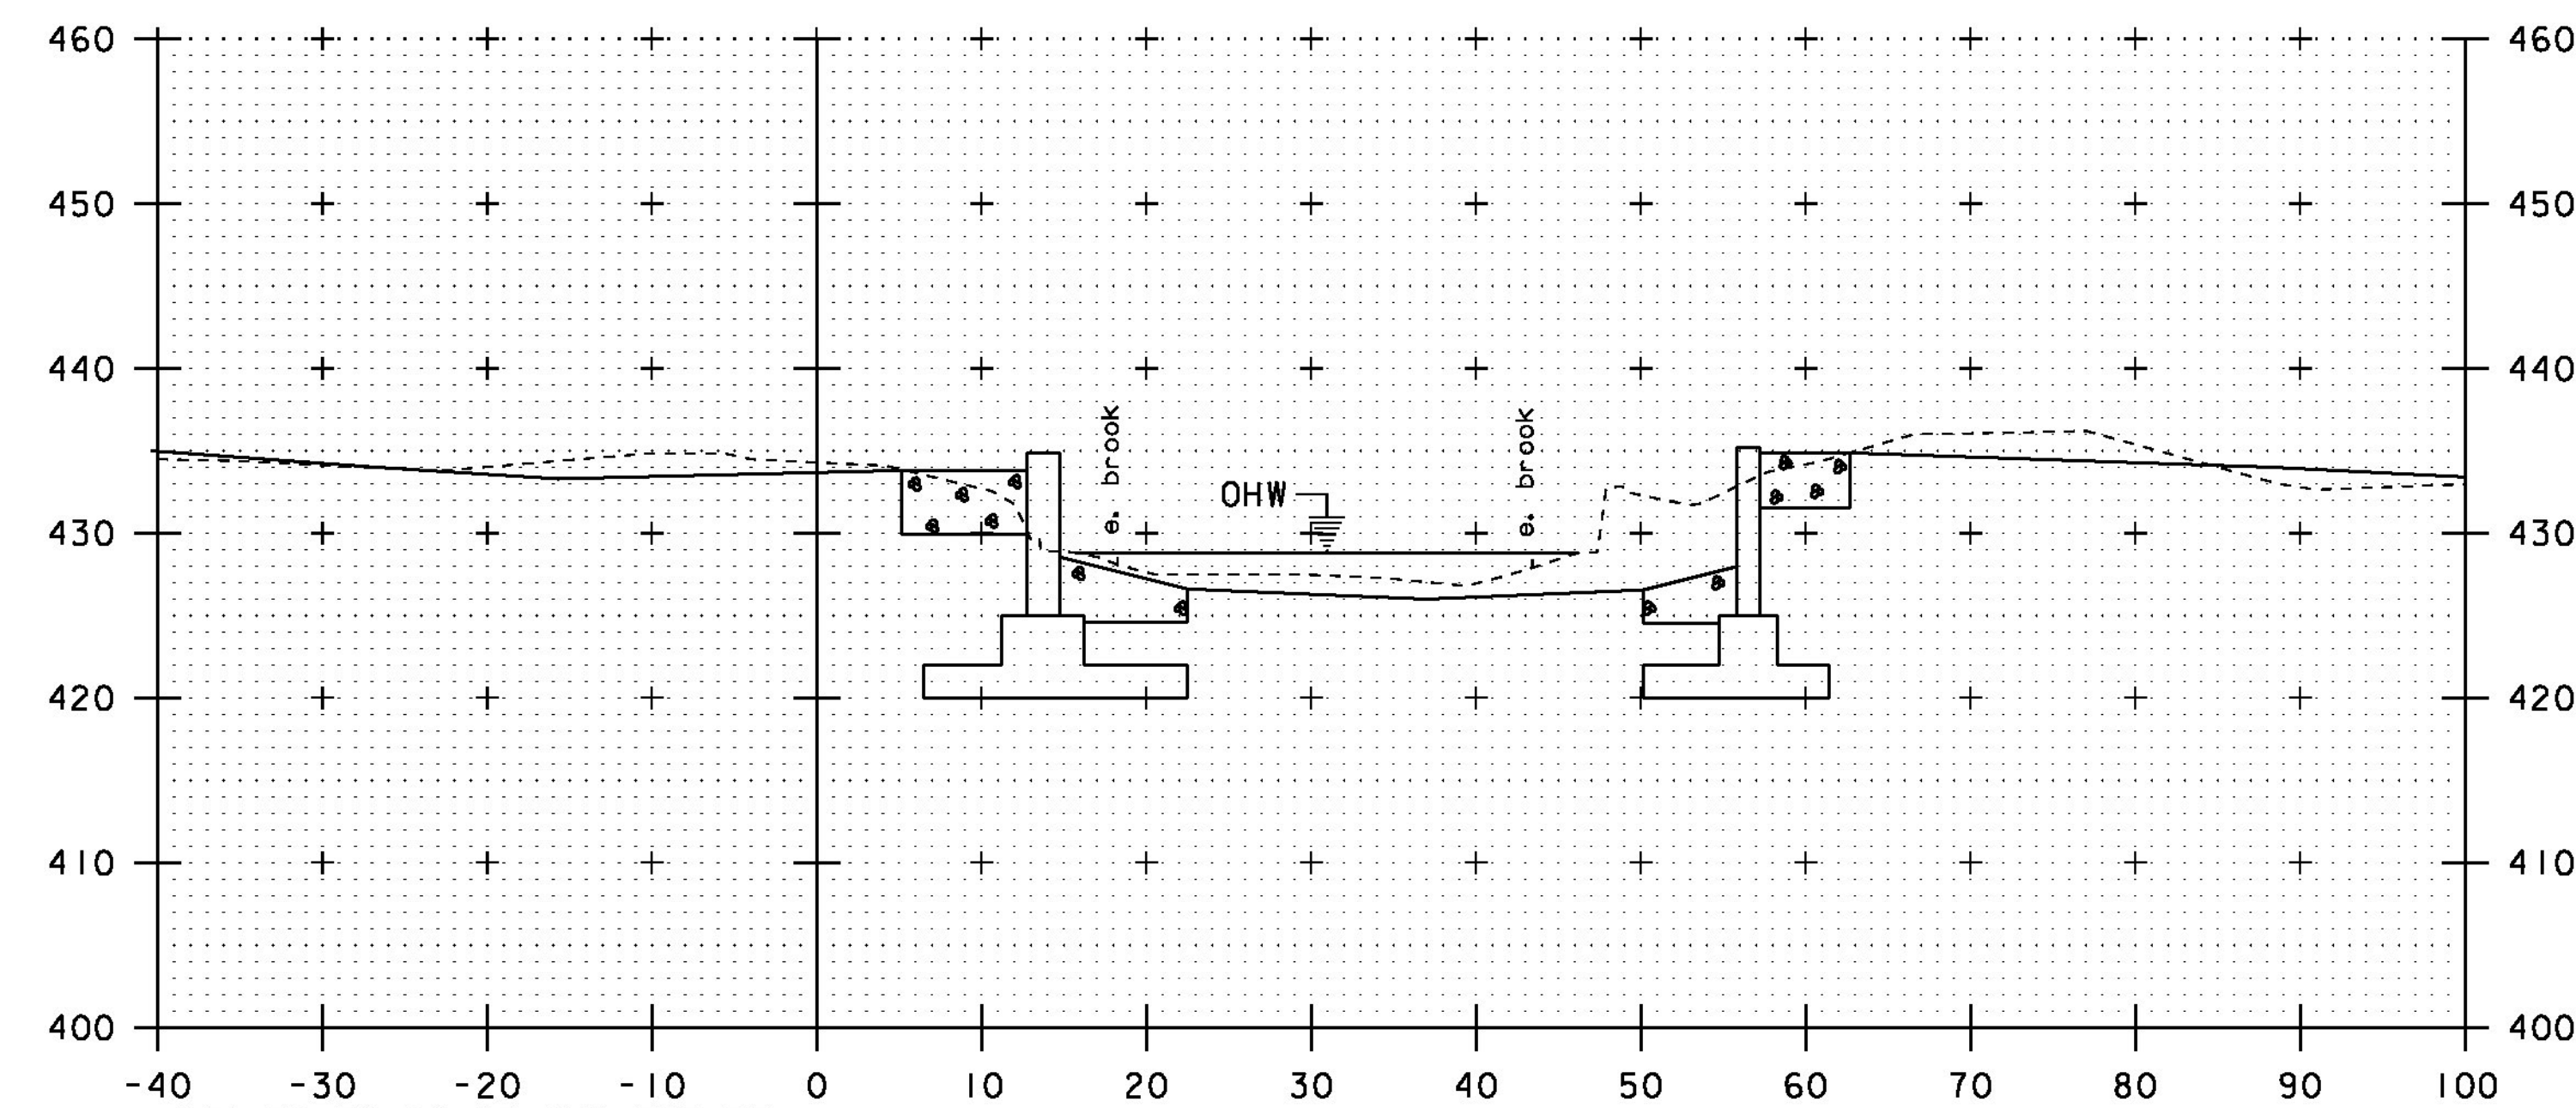


STA 50+72.00 RT AND FAR RT  
 BEGIN UNCLASSIFIED CHANNEL EXCAVATION  
 GEOTEXTILE UNDER STONE FILL  
 STONE FILL, TYPE II  
 GRUBBING MATERIAL


50+80

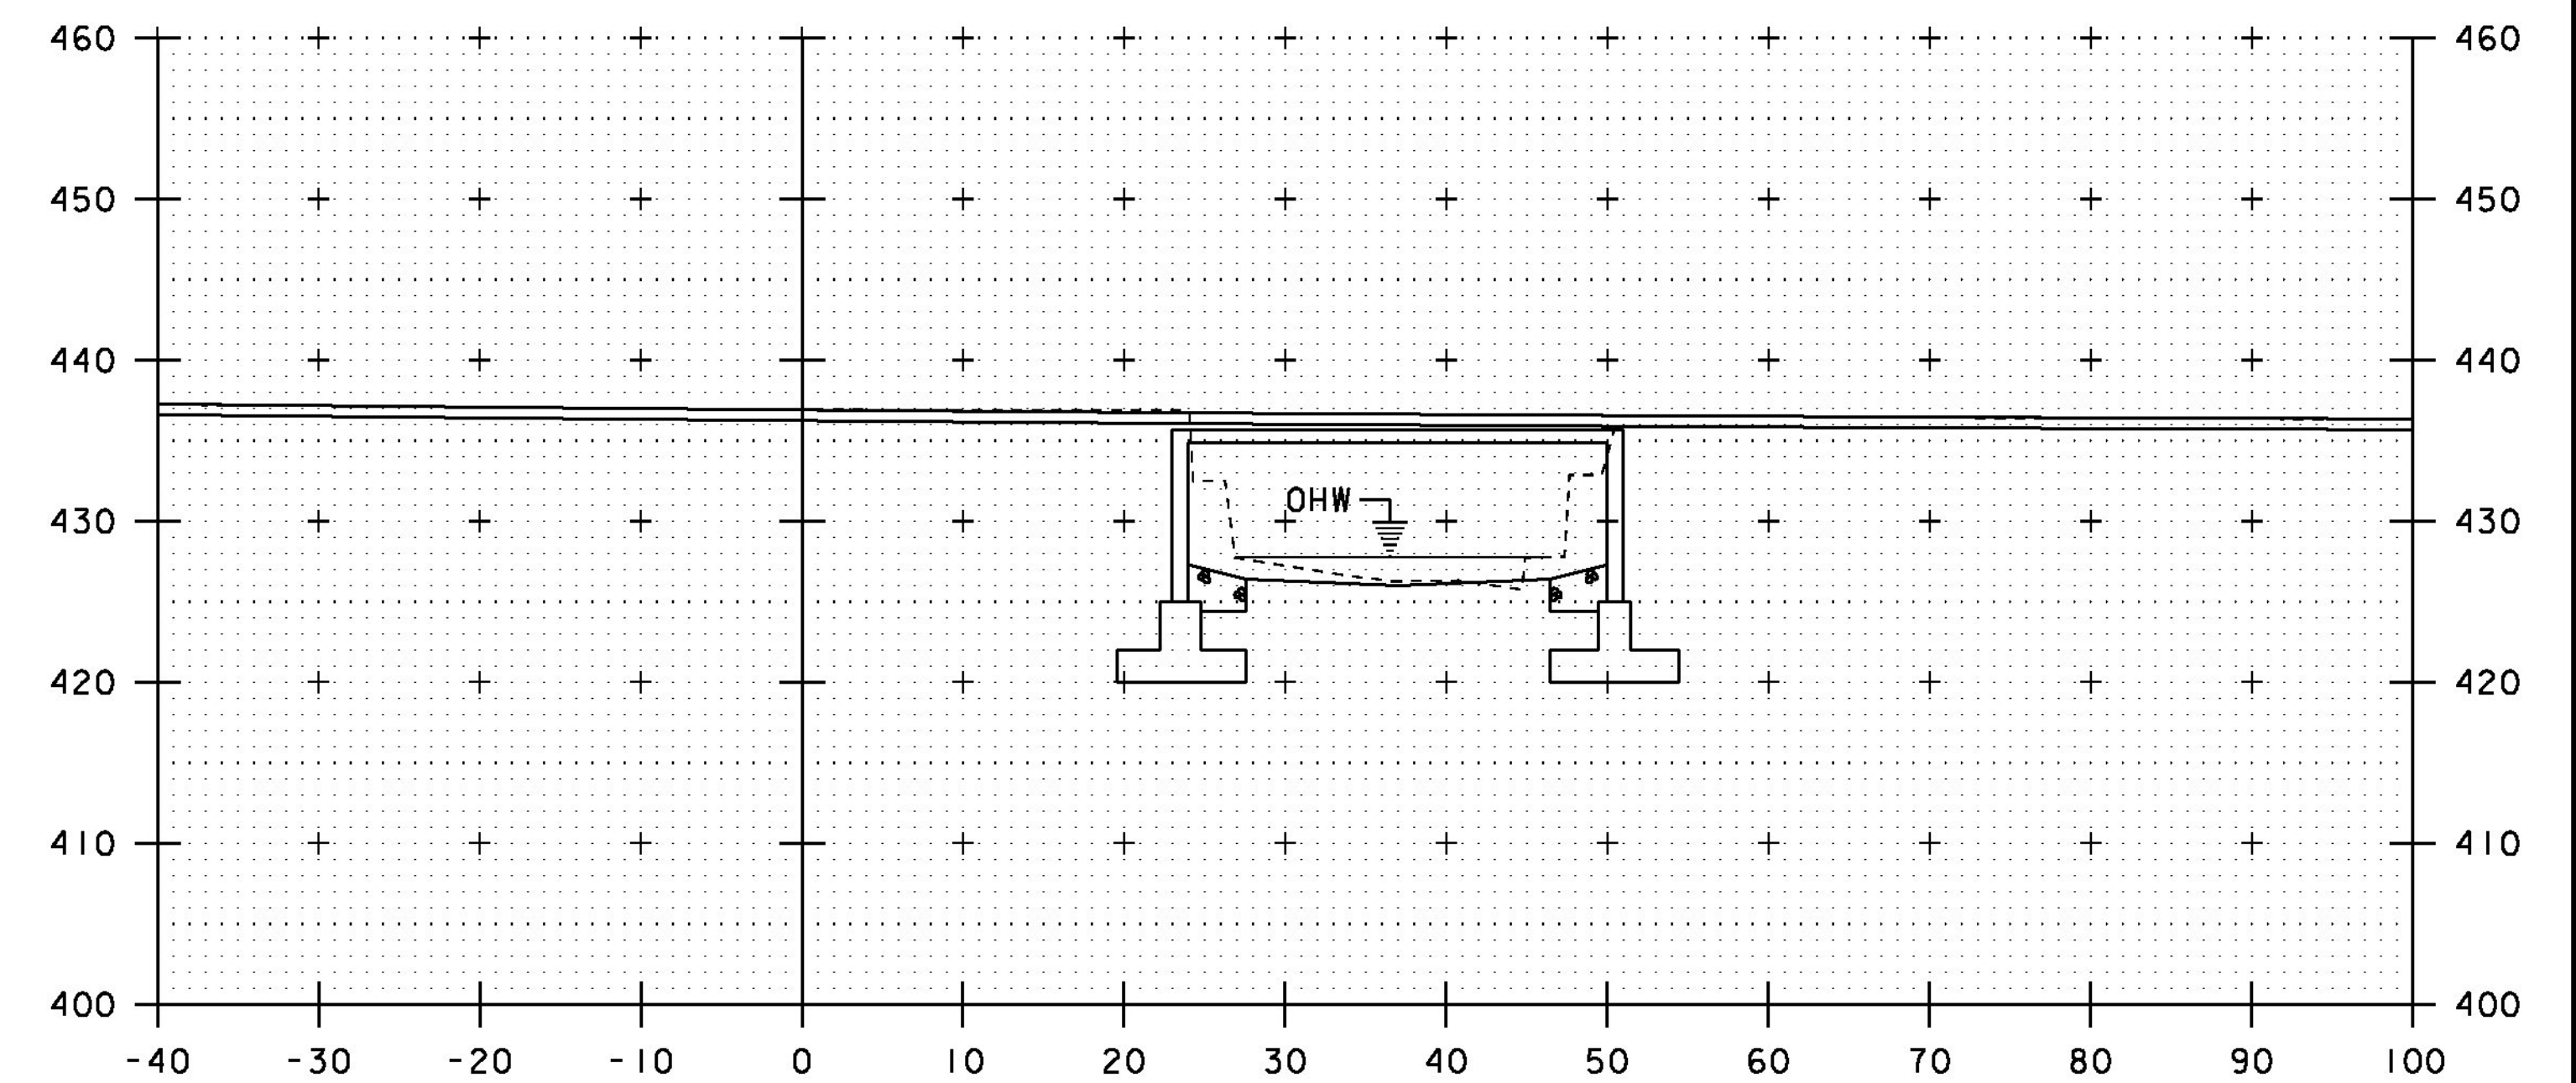

51+00

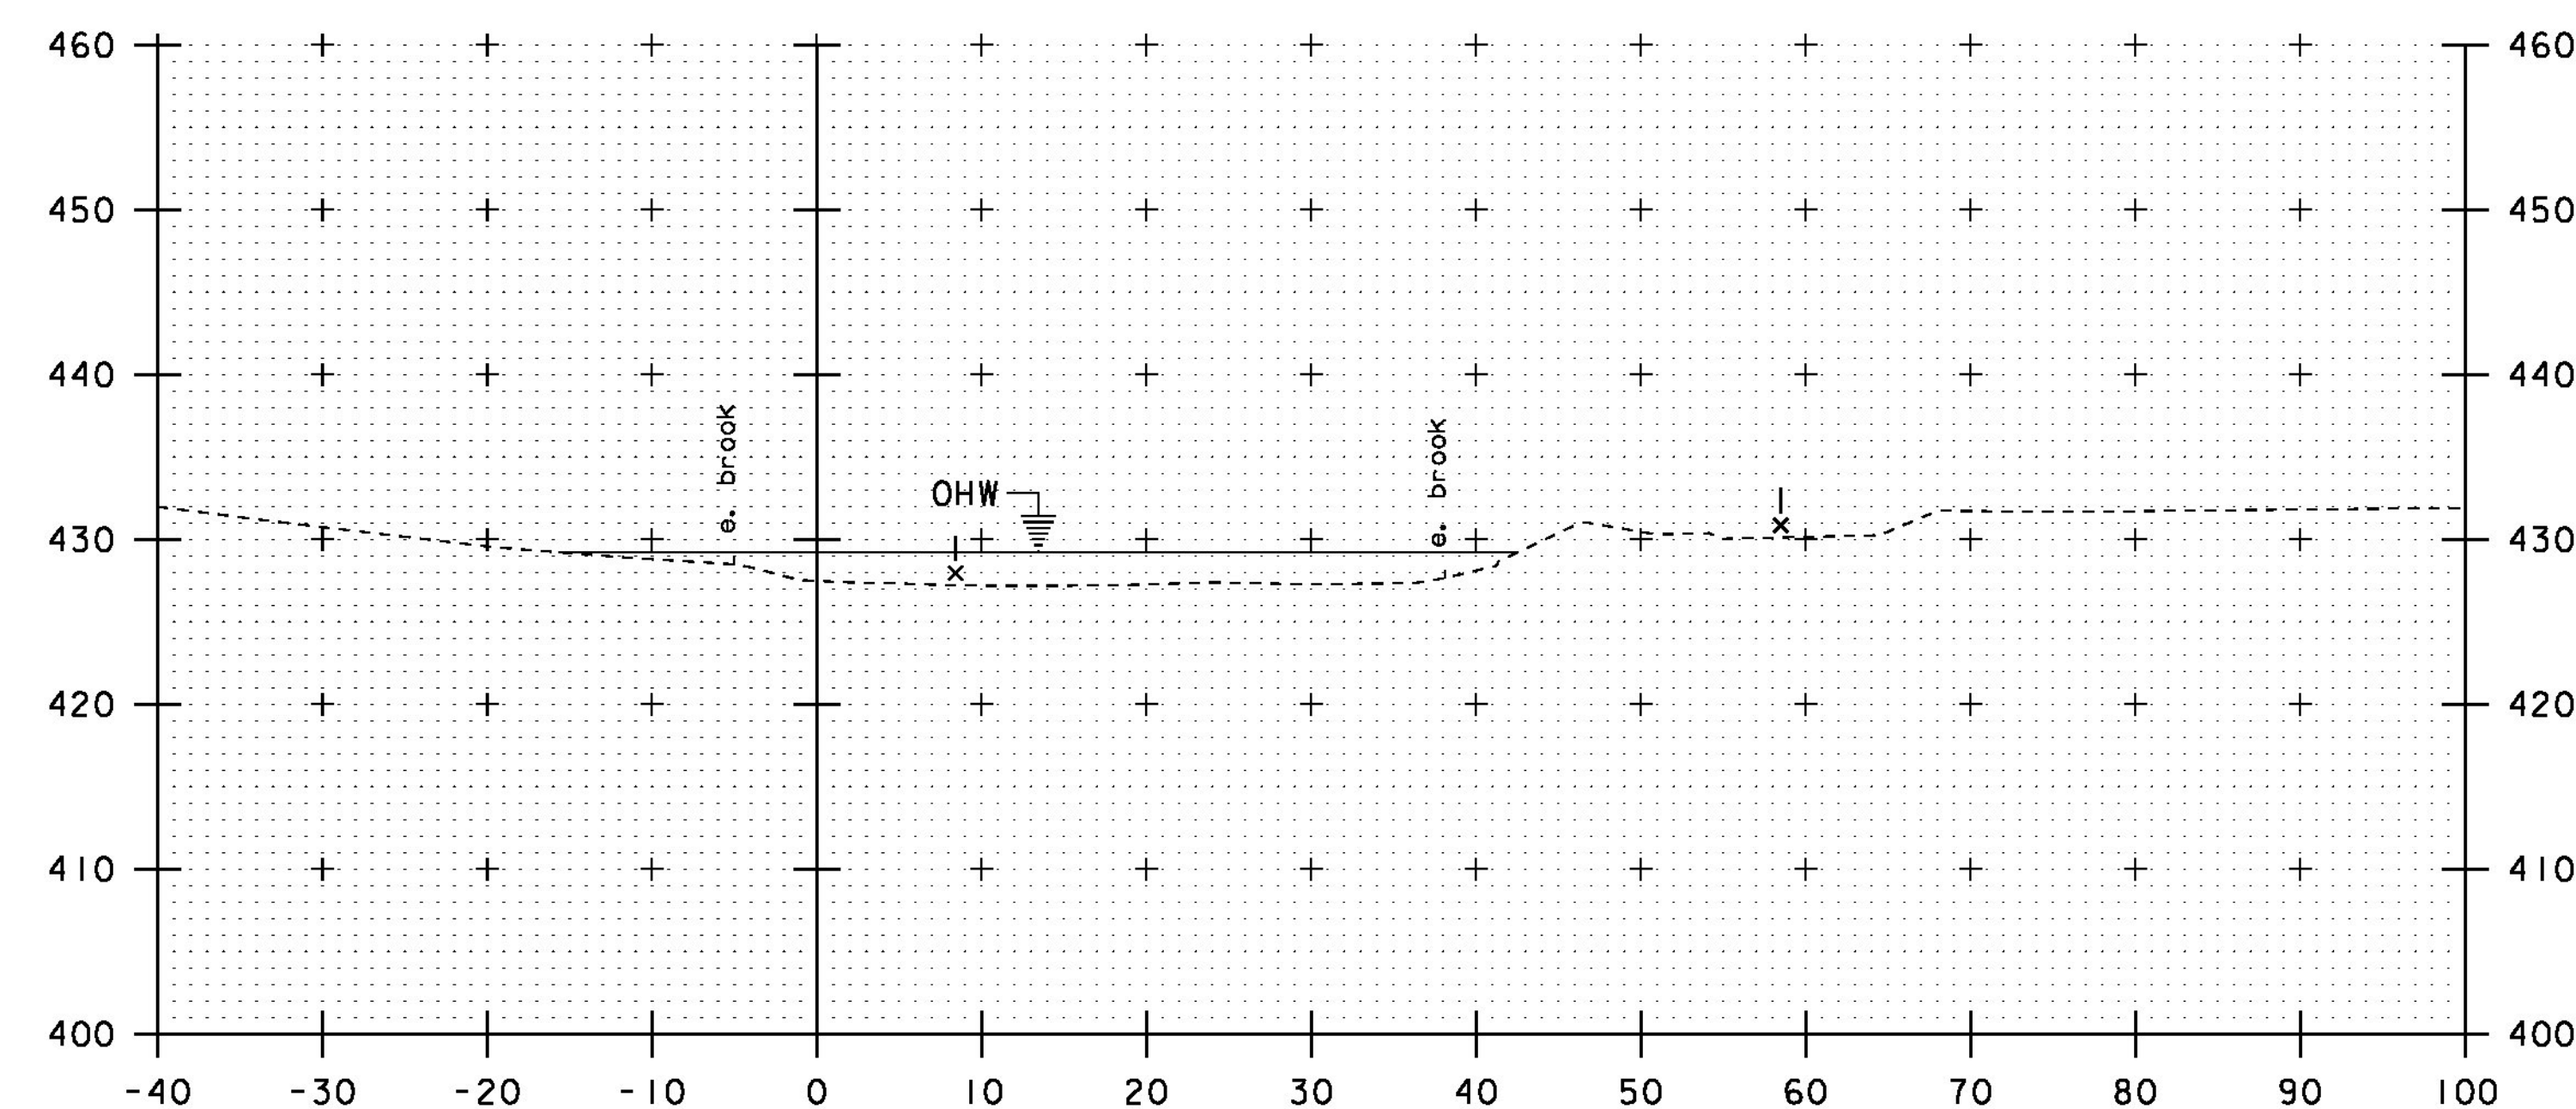

50+70

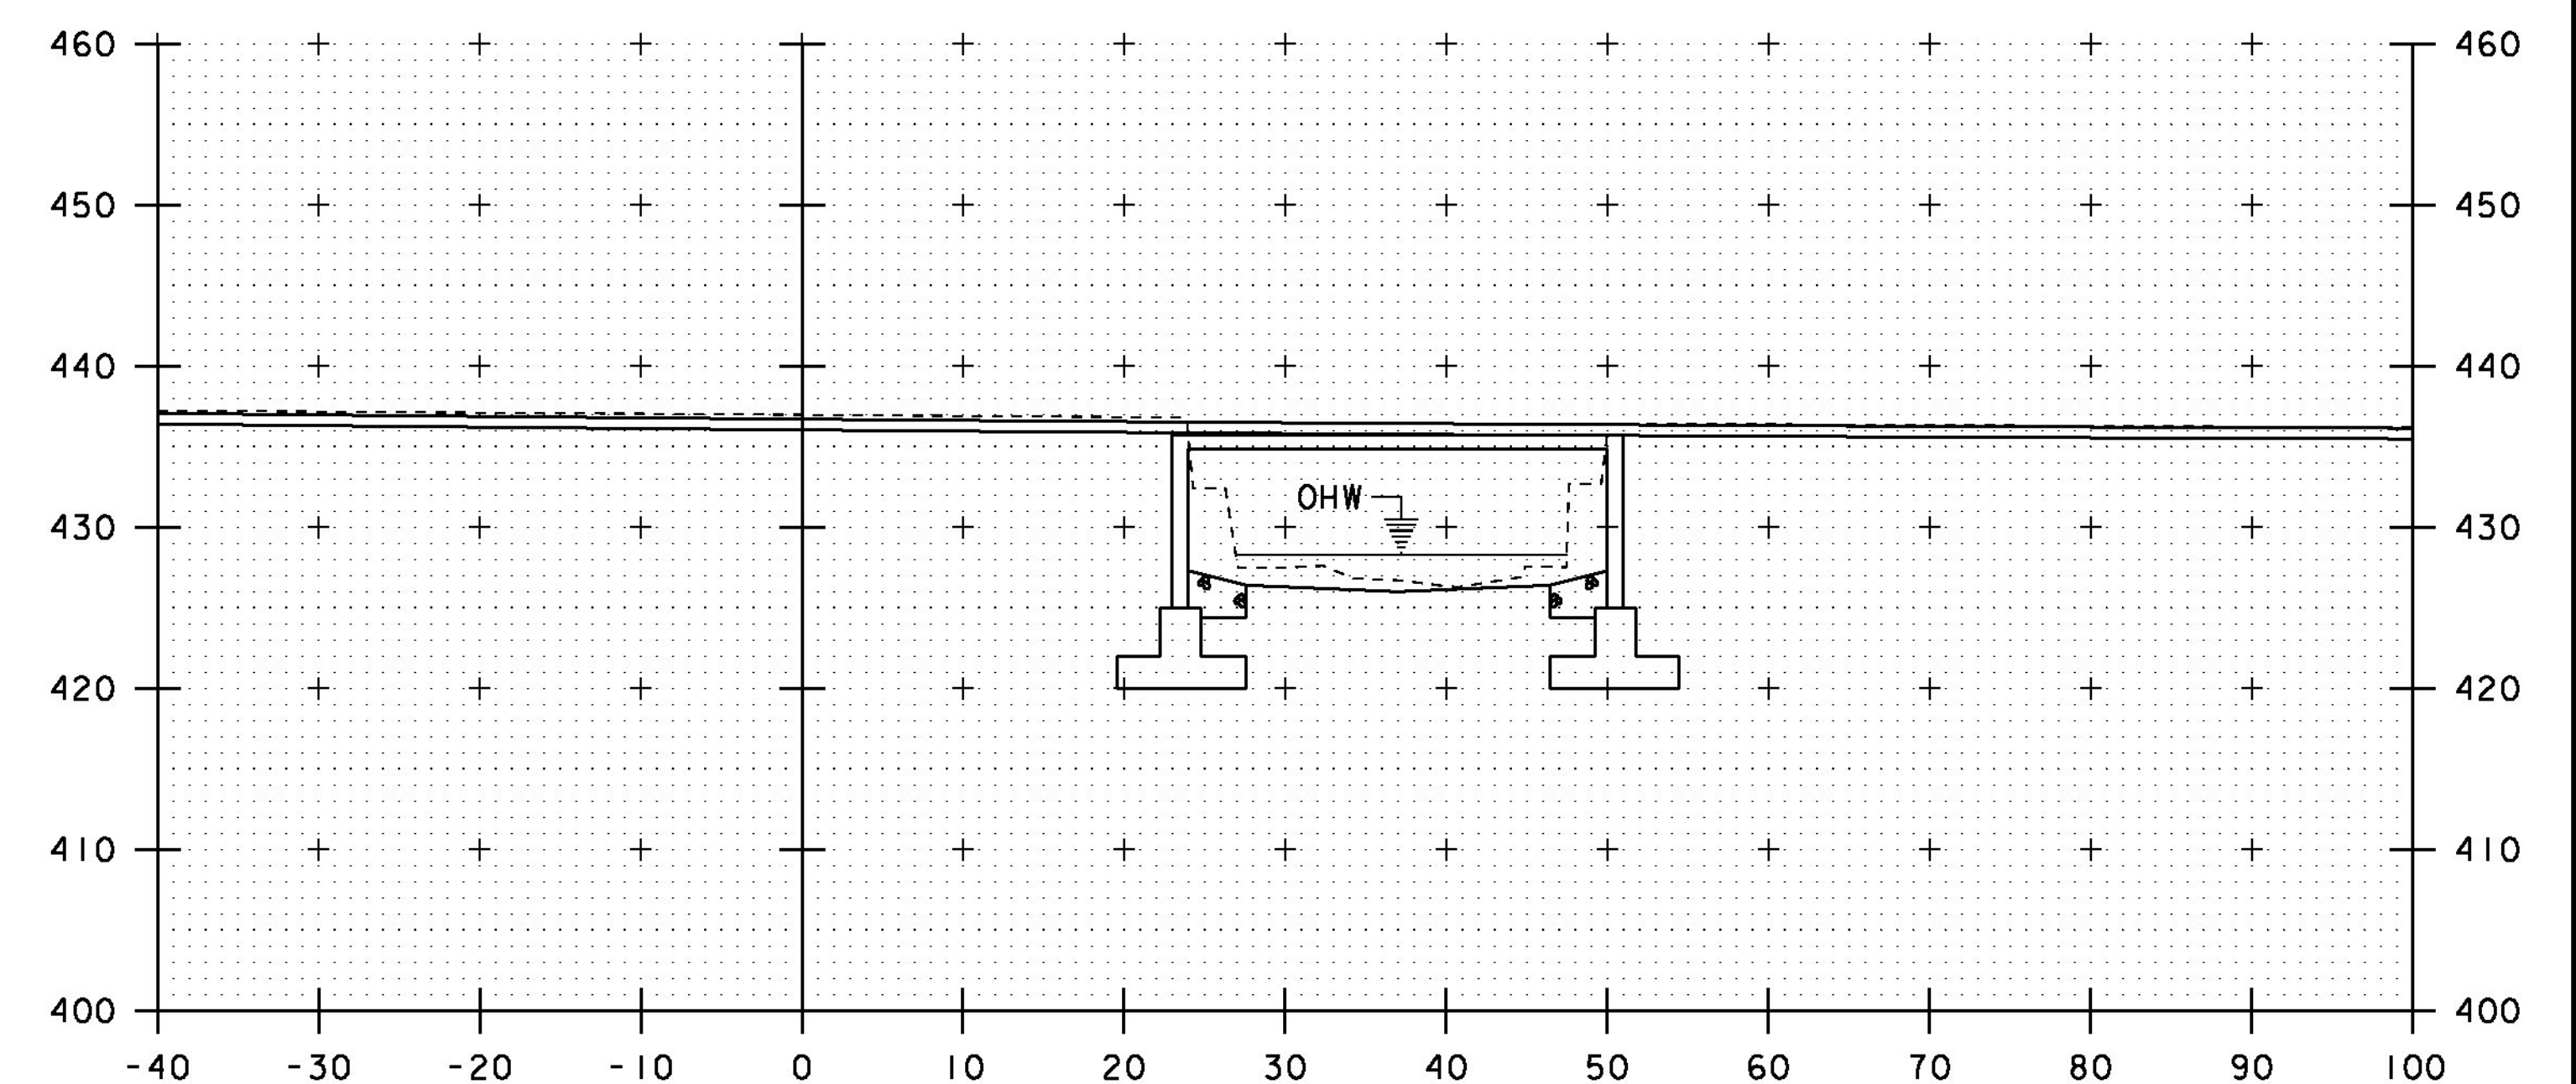





50+90

STA 50+85.50 RT AND FAR RT  
 STOP GRUBBING MATERIAL

STA. 50+70 TO STA. 51+00

PROJECT NAME:	RICHFORD	PLOT DATE:	11-DEC-2014
PROJECT NUMBER:	BRF 0302(29)	DRAWN BY:	R. PELLETT
FILE NAME:	sl2j158xs.dgn	CHECKED BY:	H. SALLS
PROJECT LEADER:	C. CARLSON	SHEET	29 OF 36
DESIGNED BY:	H. SALLS		
CHANNEL CROSS SECTIONS I			




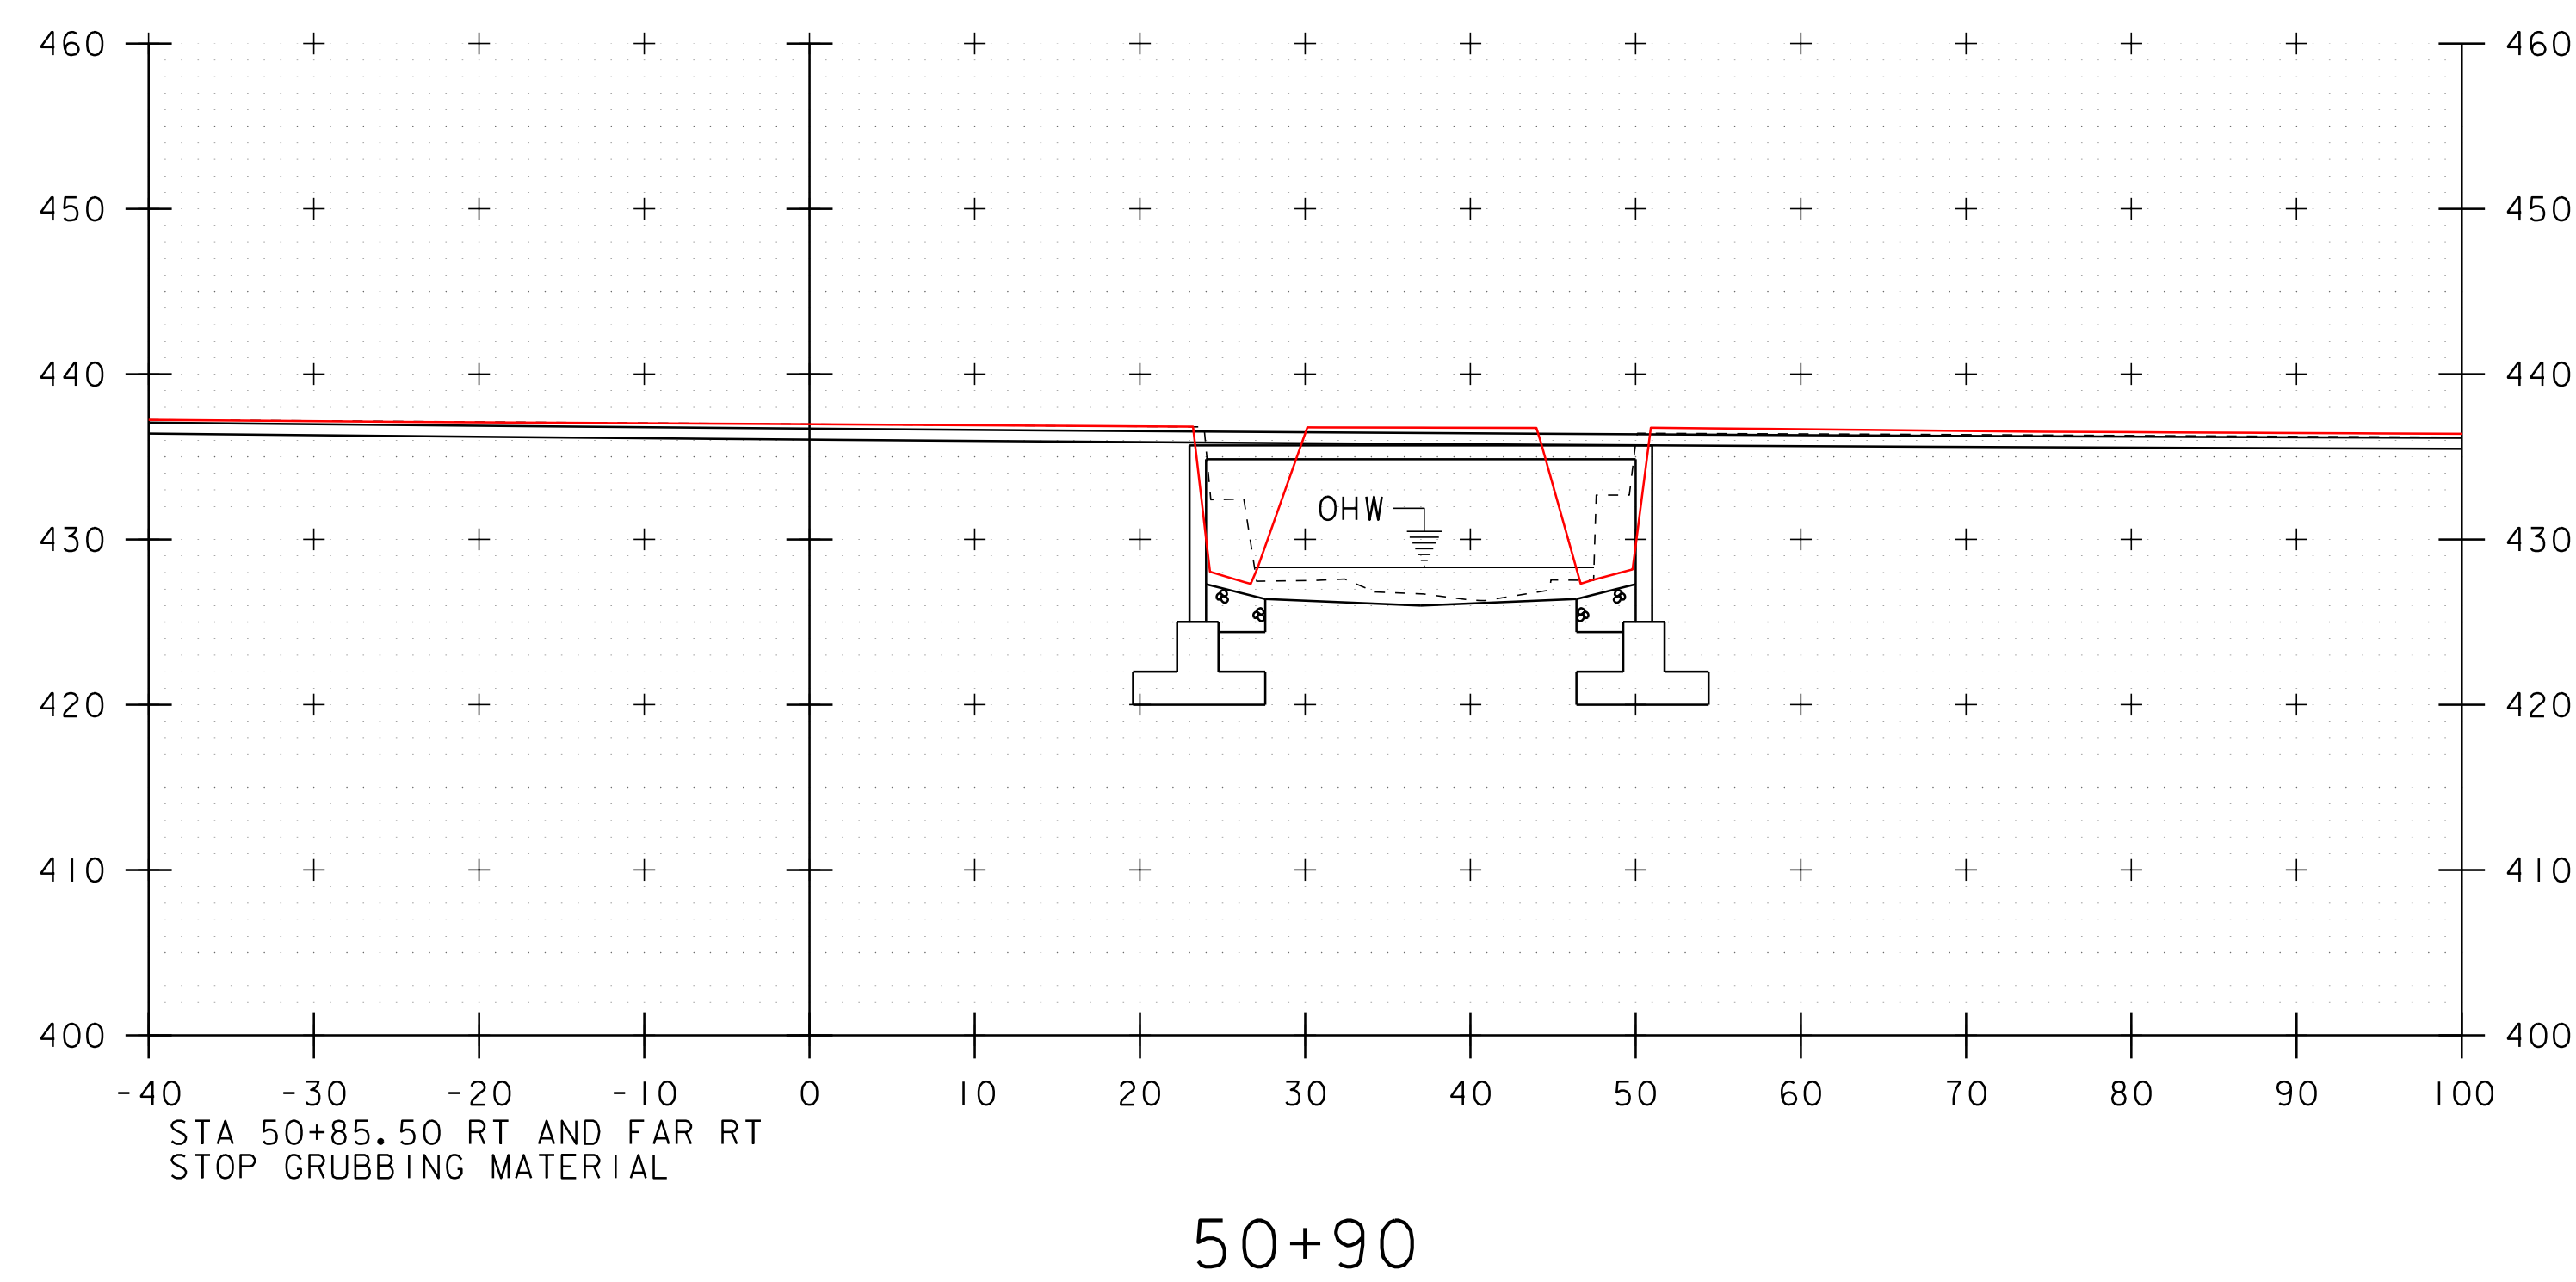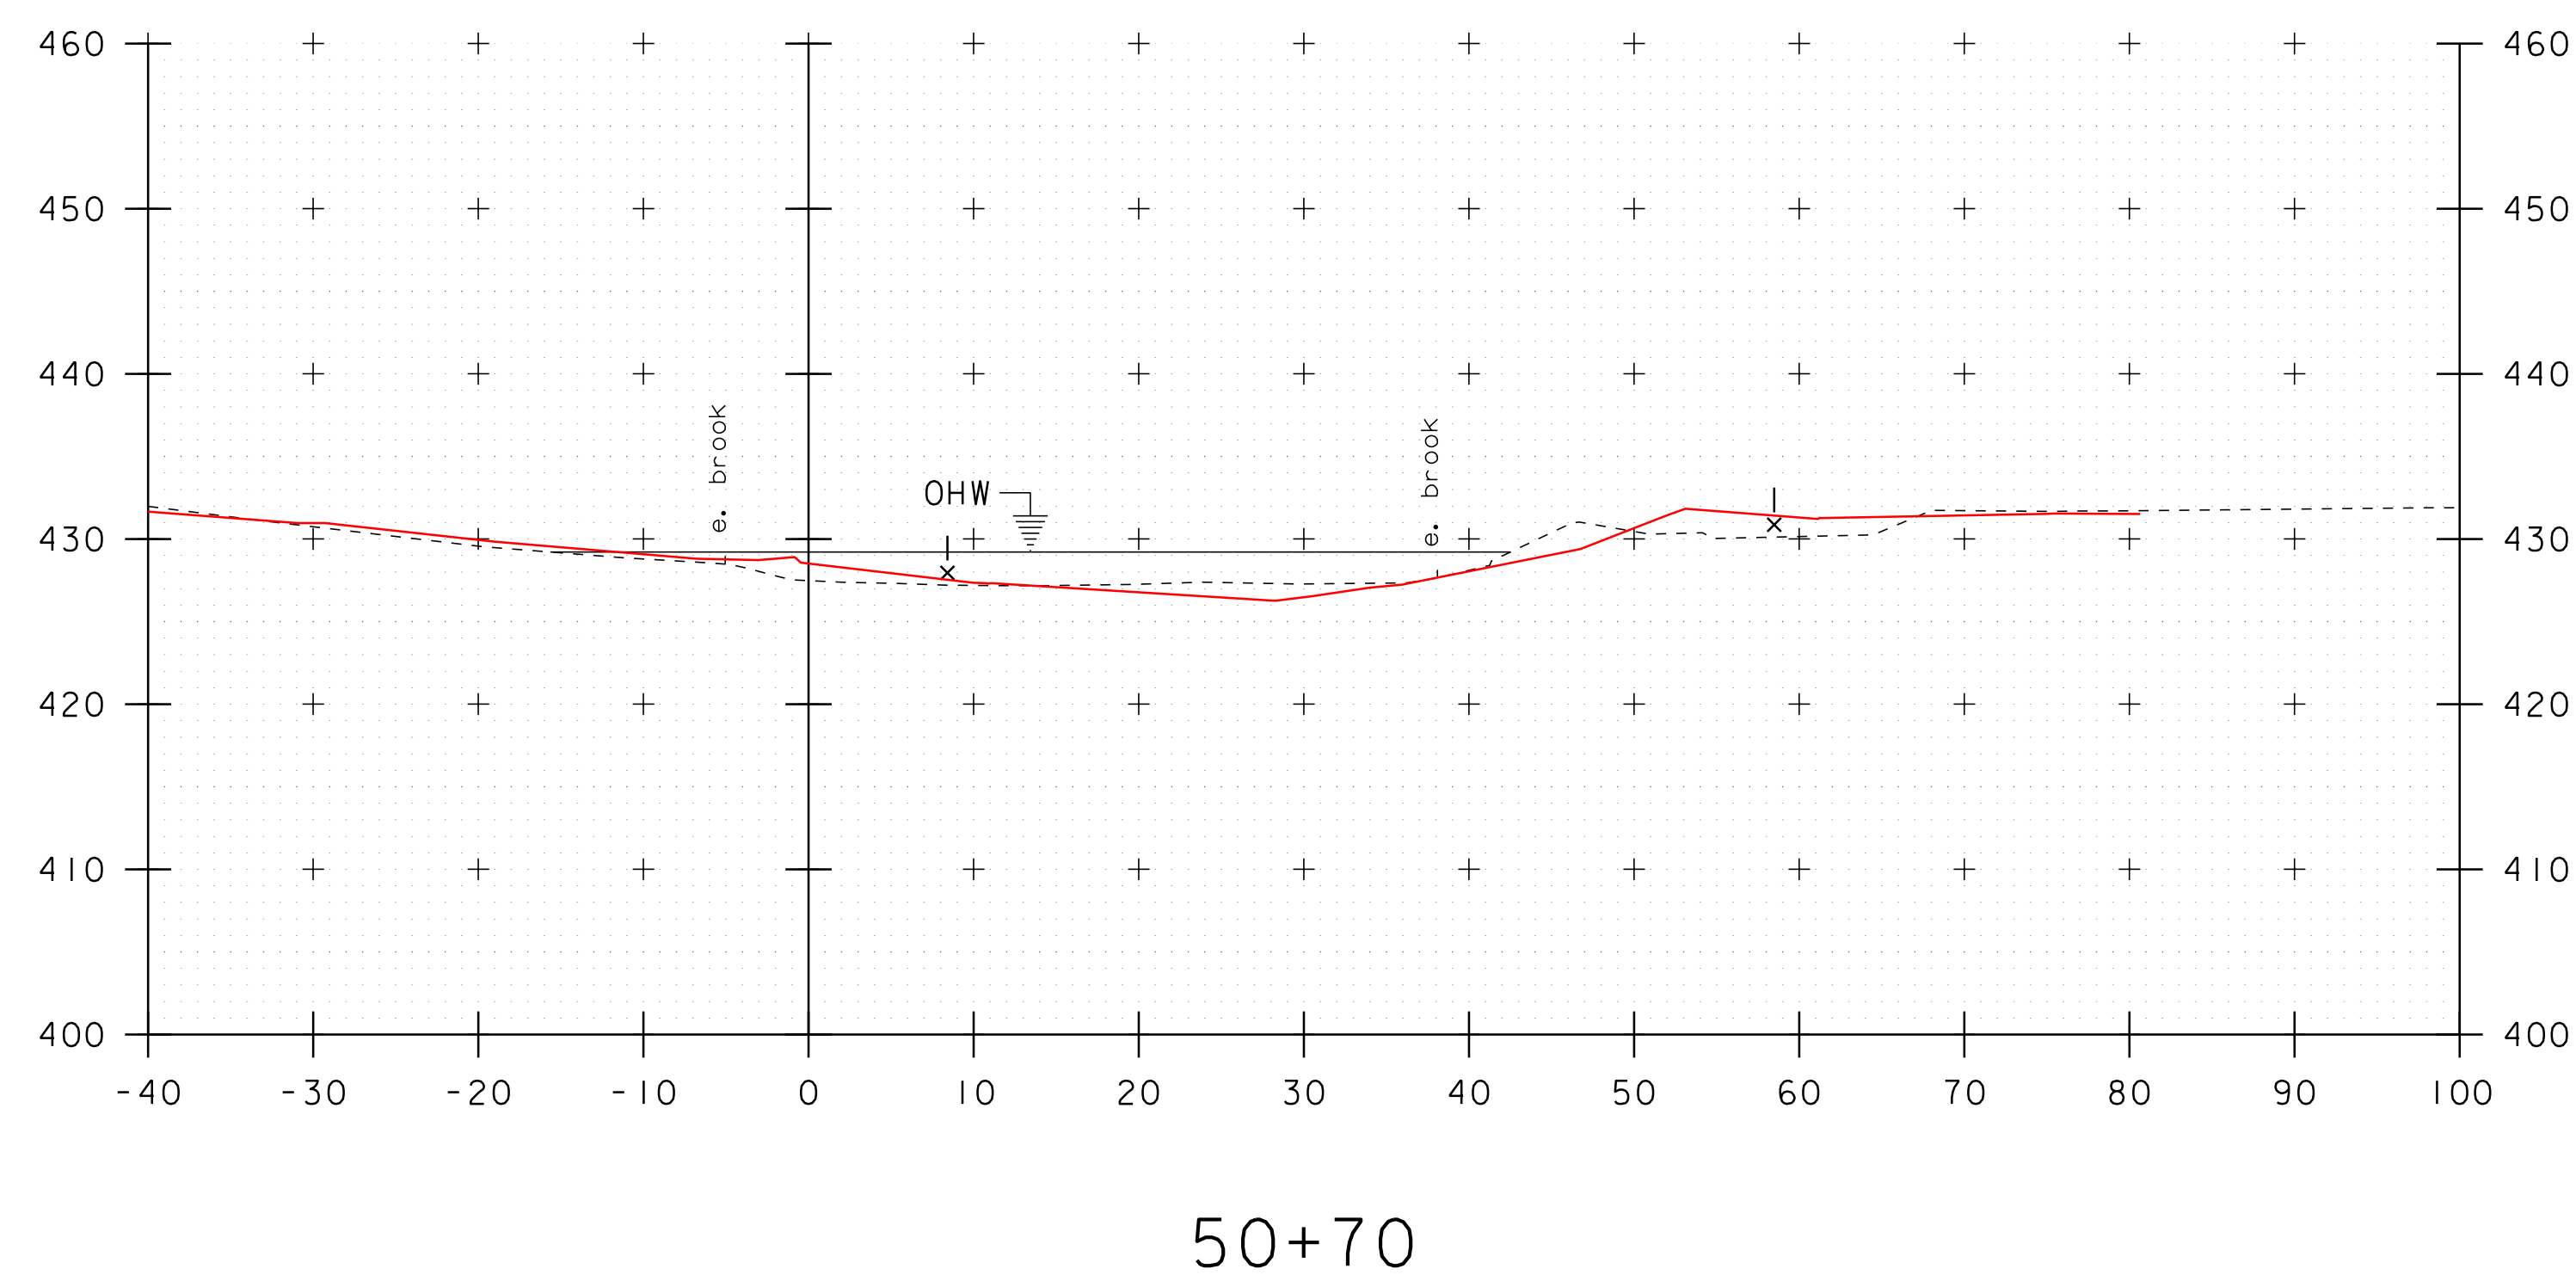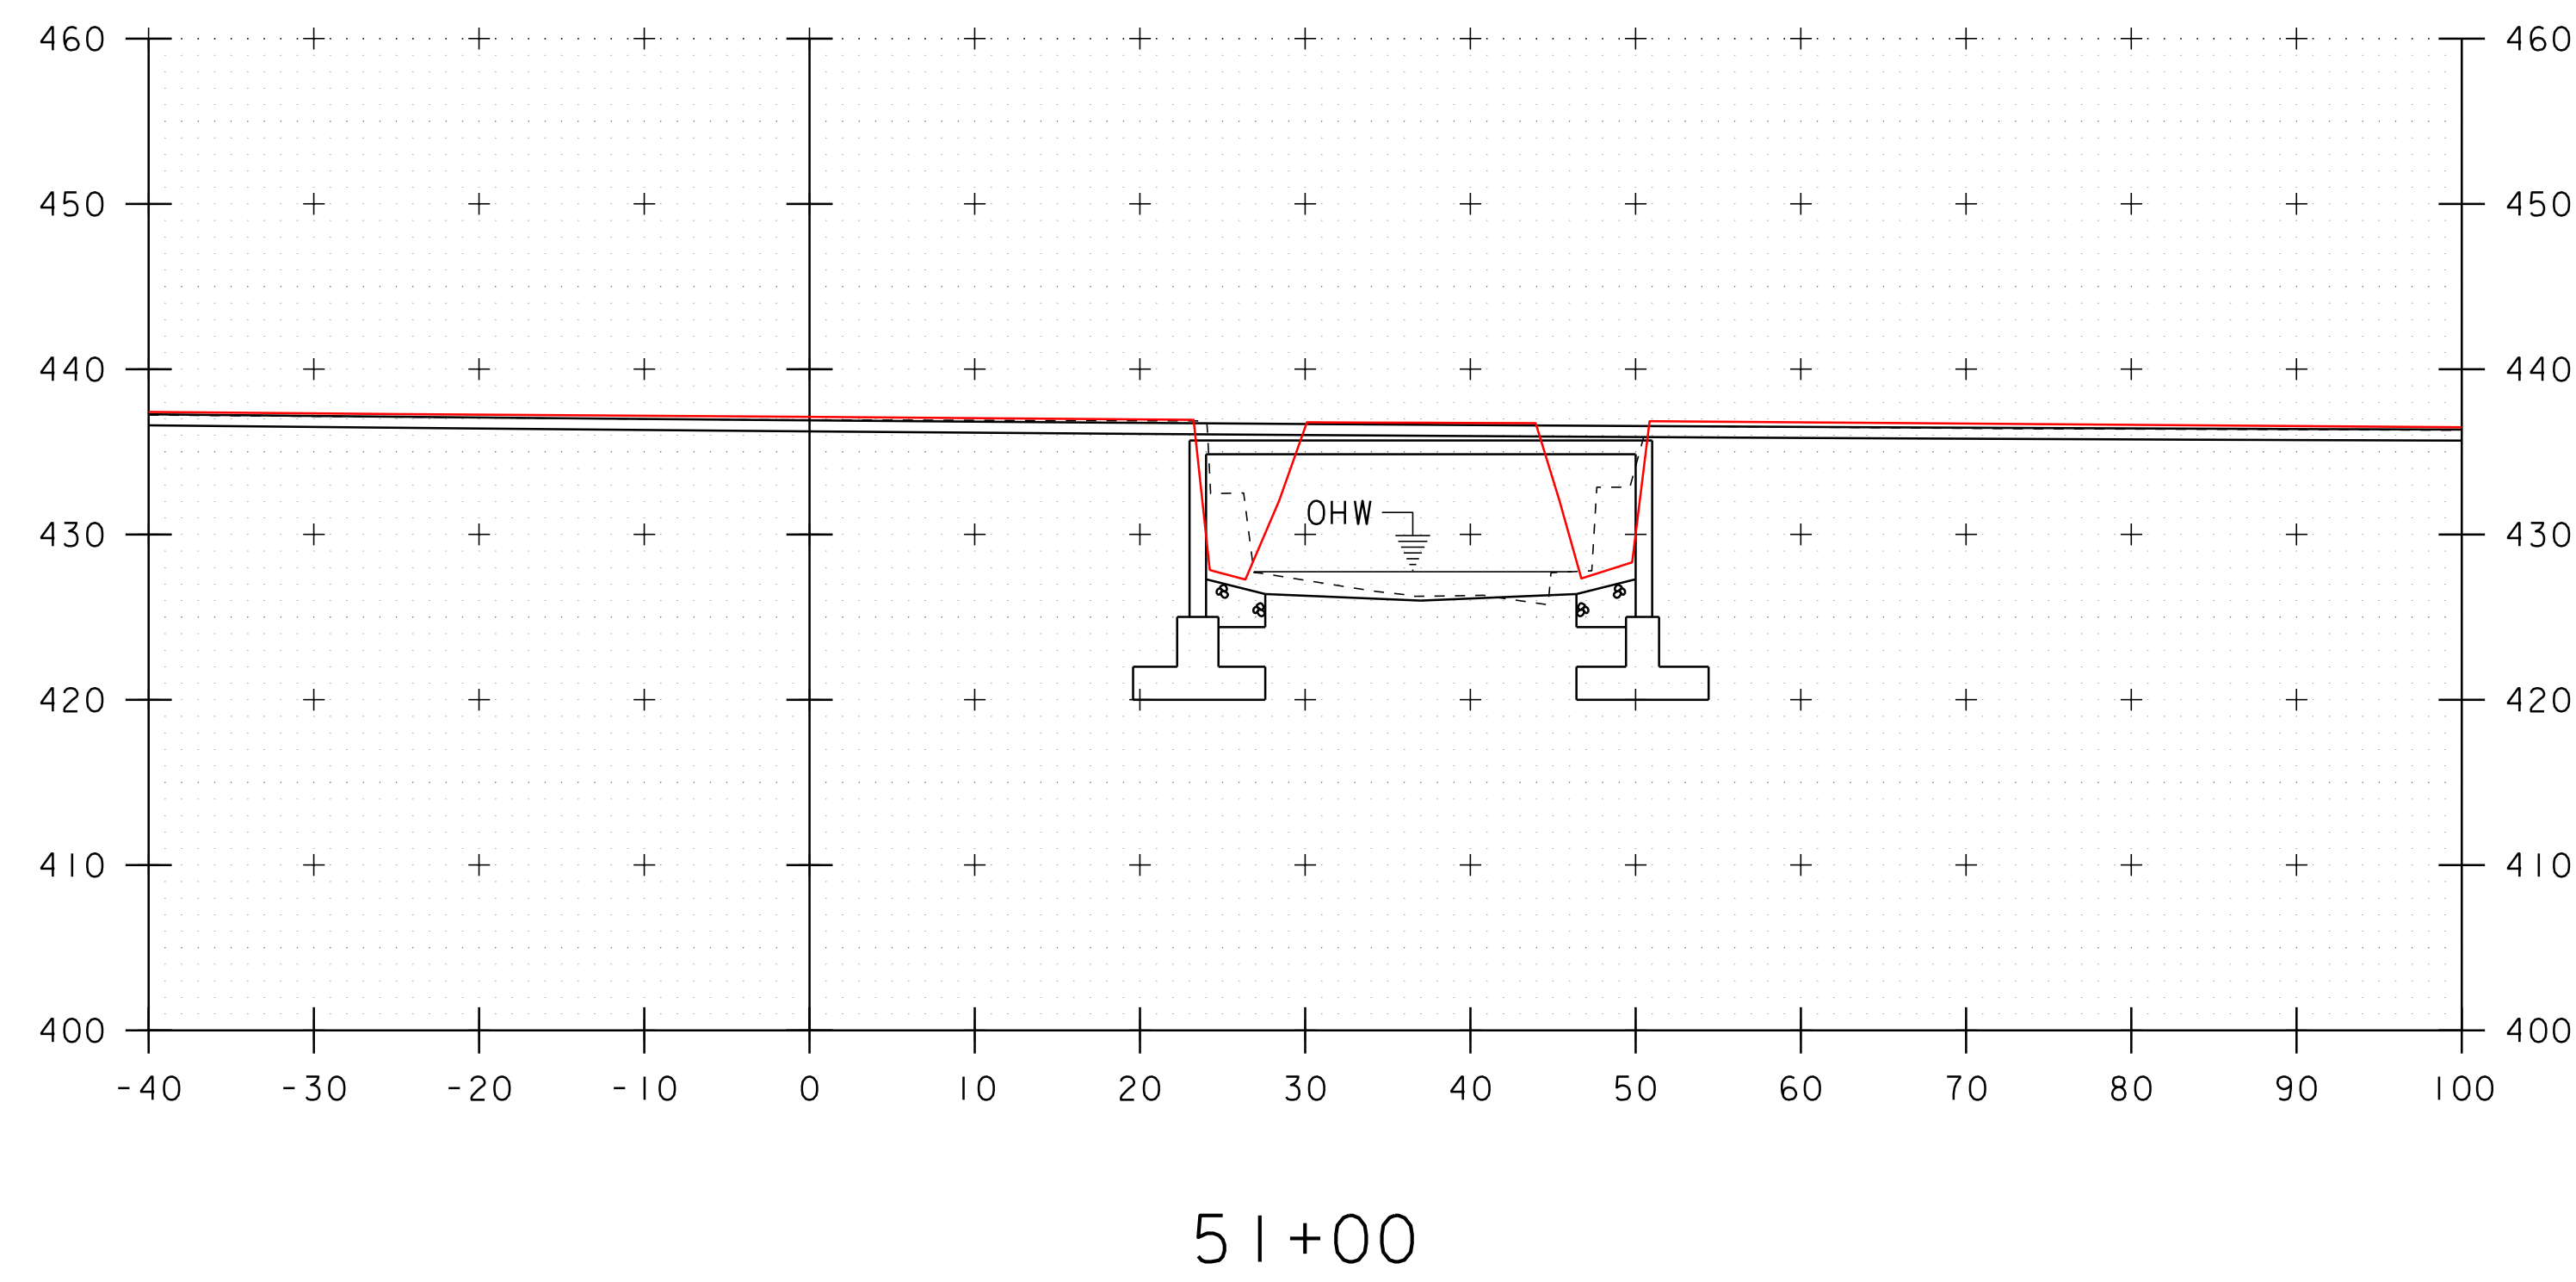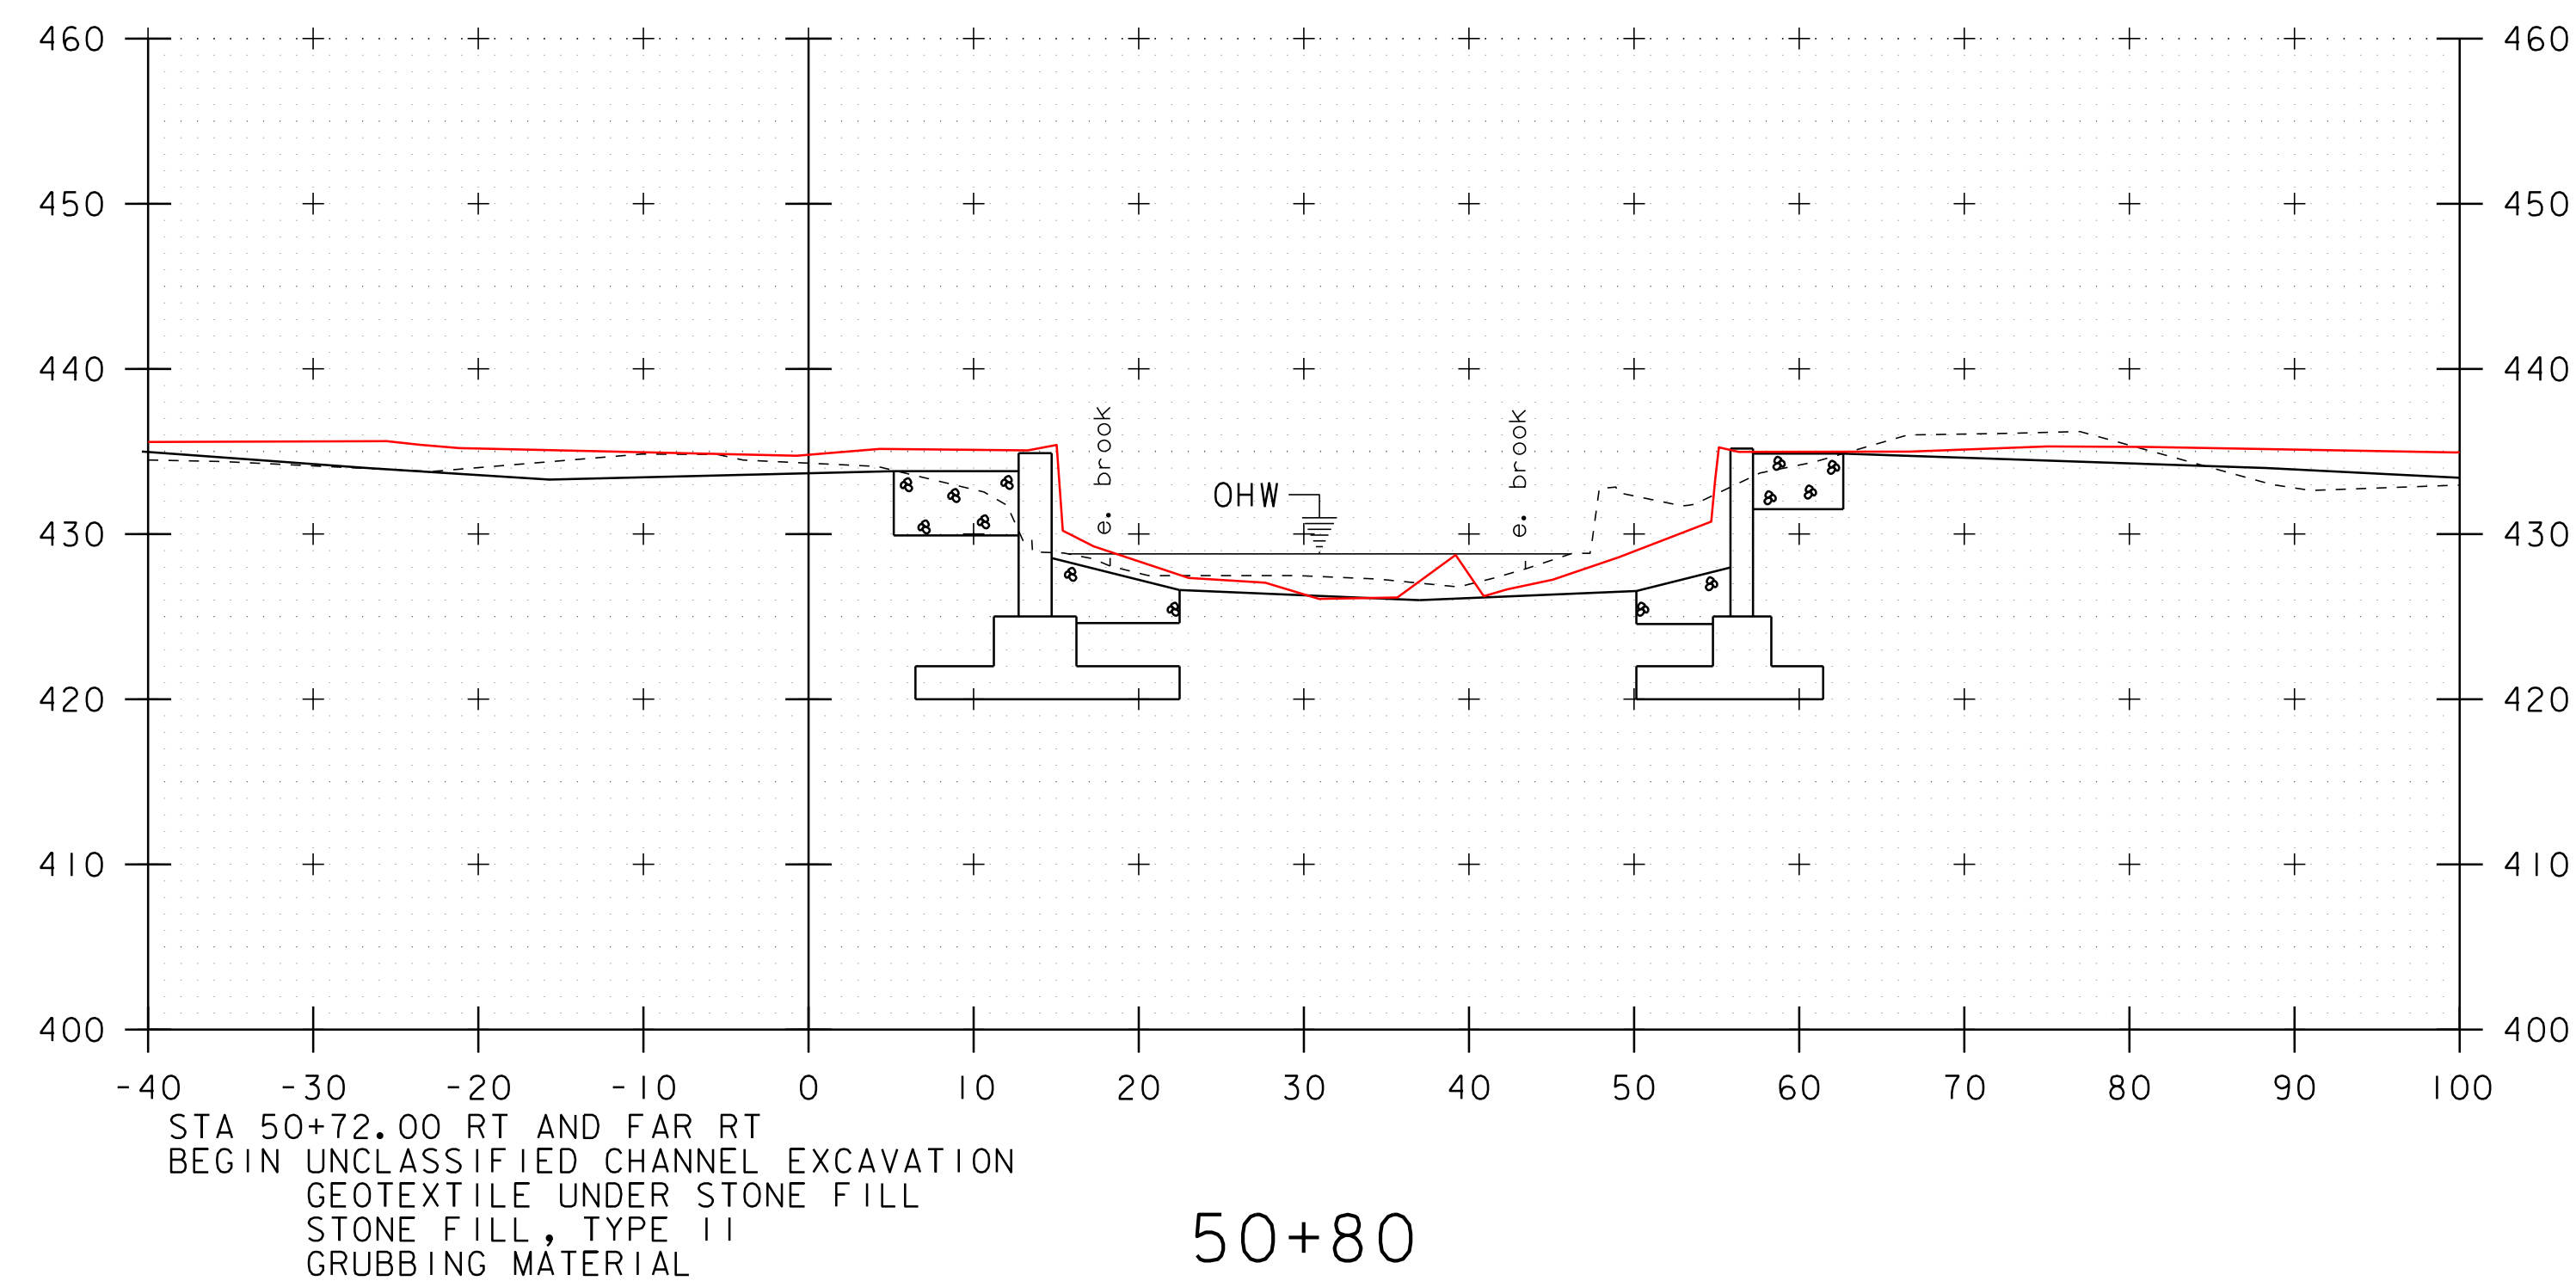

STA. 50+70 TO STA. 51+00

PROJECT NAME:	RICHFORD	PLOT DATE:	09-AUG-2016 09:57
PROJECT NUMBER:	BRF 0302(29)	DRAWN BY:	R. PELLETT
FILE NAME:	s12j158xs.dgn	CHECKED BY:	H. SALLS
PROJECT LEADER:	C. CARLSON	SHEET	29 OF 64
DESIGNED BY:	H. SALLS		
CHANNEL CROSS SECTIONS I			




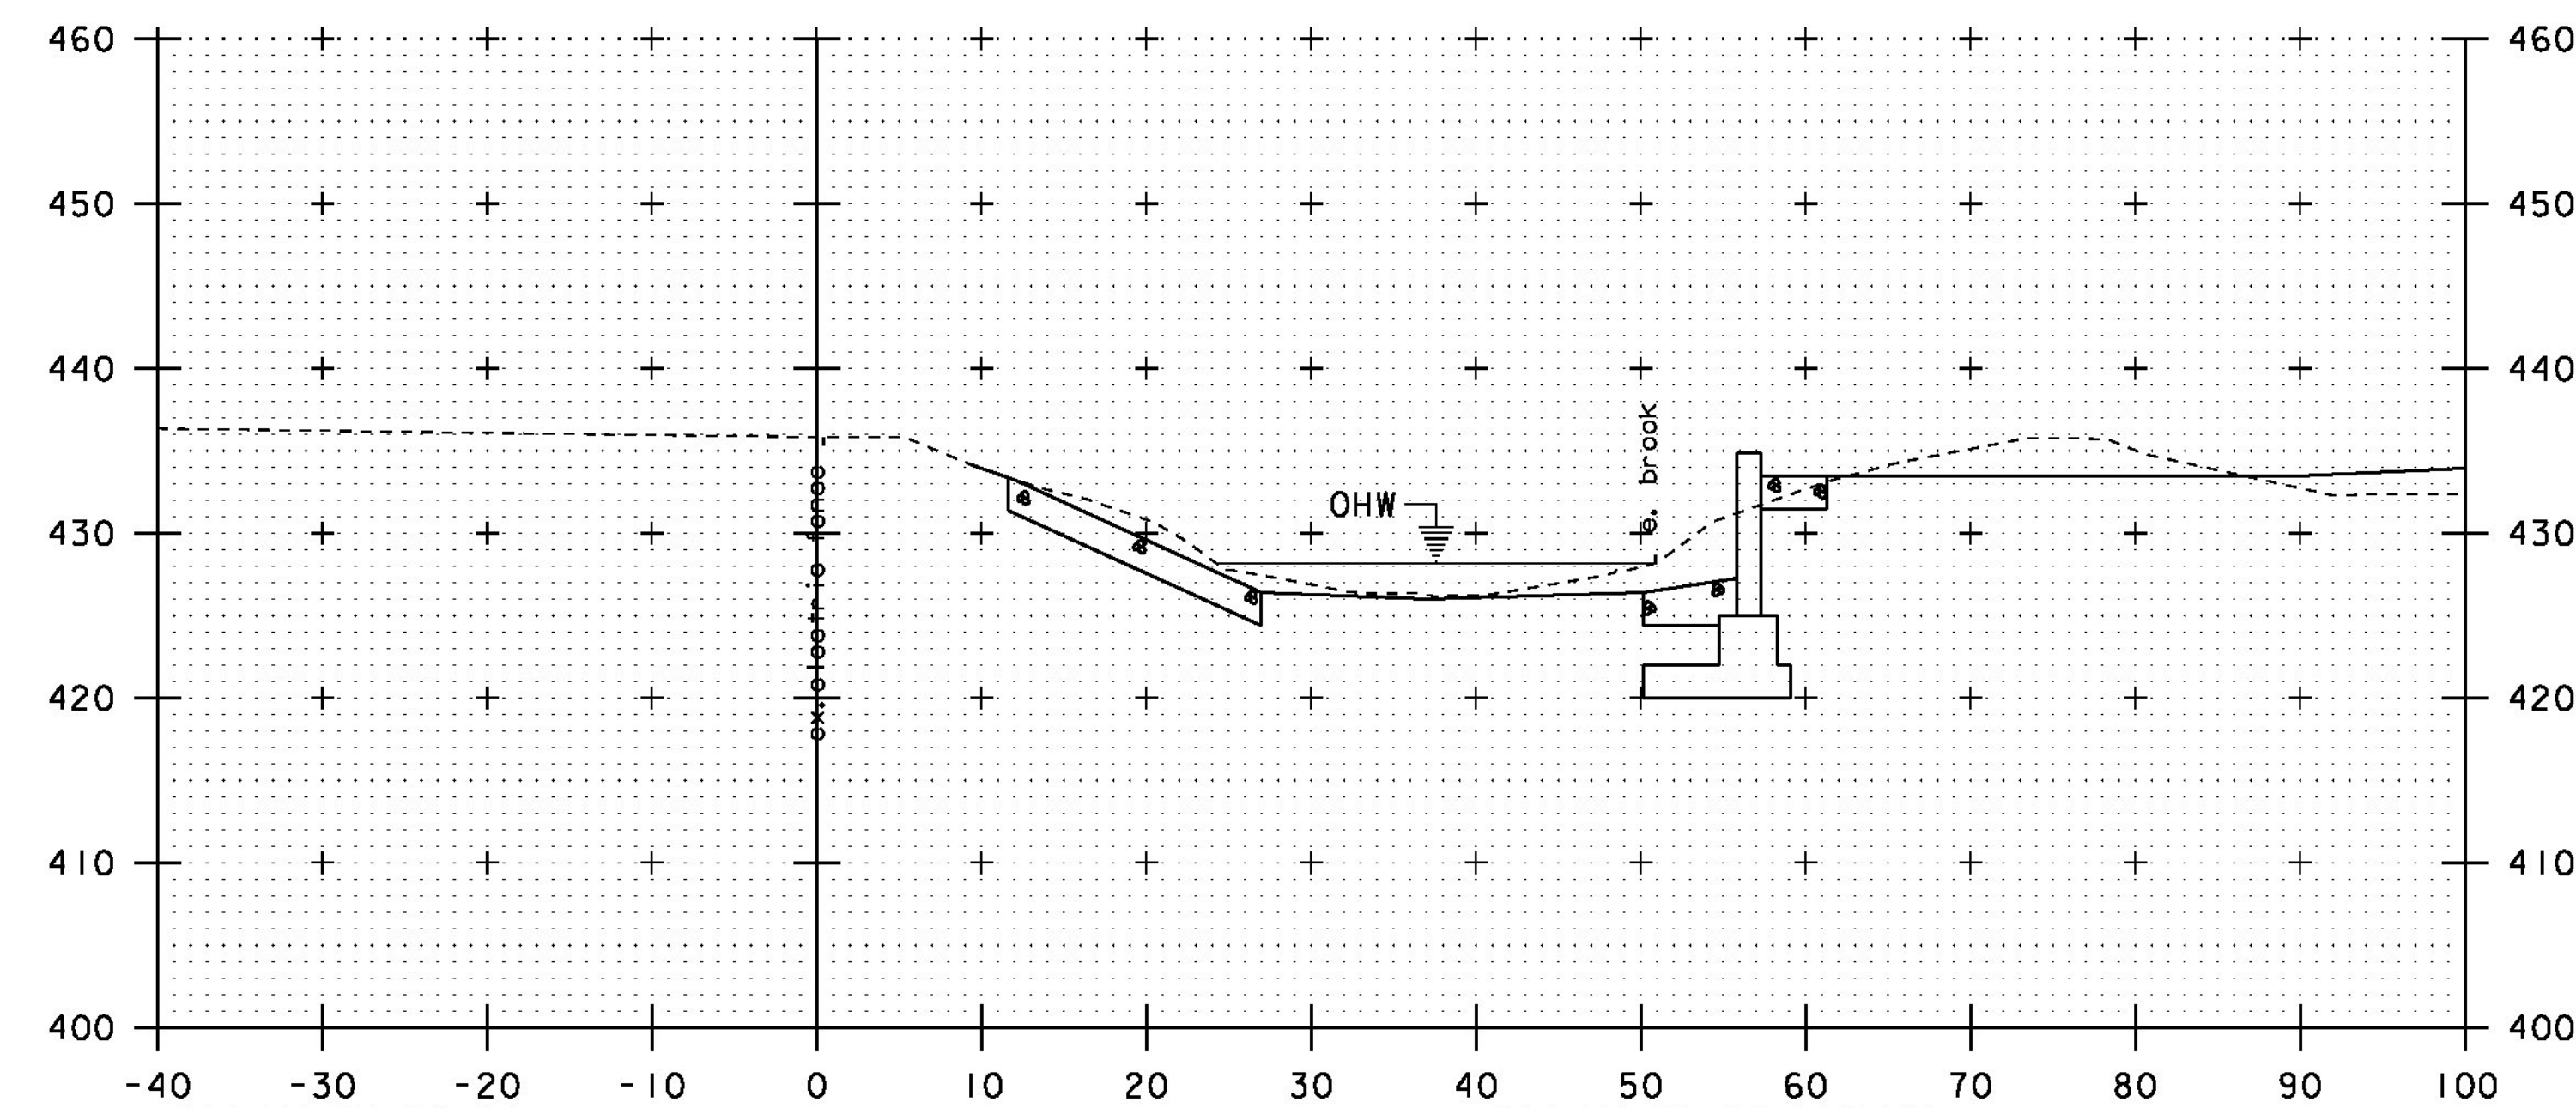


STA 51+21.00 RT  
END UNCLASSIFIED CHANNEL EXCAVATION  
GEOTEXTILE UNDER STONE FILL  
STONE FILL, TYPE II  
GRUBBING MATERIAL  
STA 51+14.50 RT  
RESUME GRUBBING MATERIAL

STA 51+27.00 FAR RT  
END UNCLASSIFIED CHANNEL EXCAVATION  
GEOTEXTILE UNDER STONE FILL  
STONE FILL, TYPE II  
GRUBBING MATERIAL  
STA 51+14.50 FAR RT  
RESUME GRUBBING MATERIAL


51+20

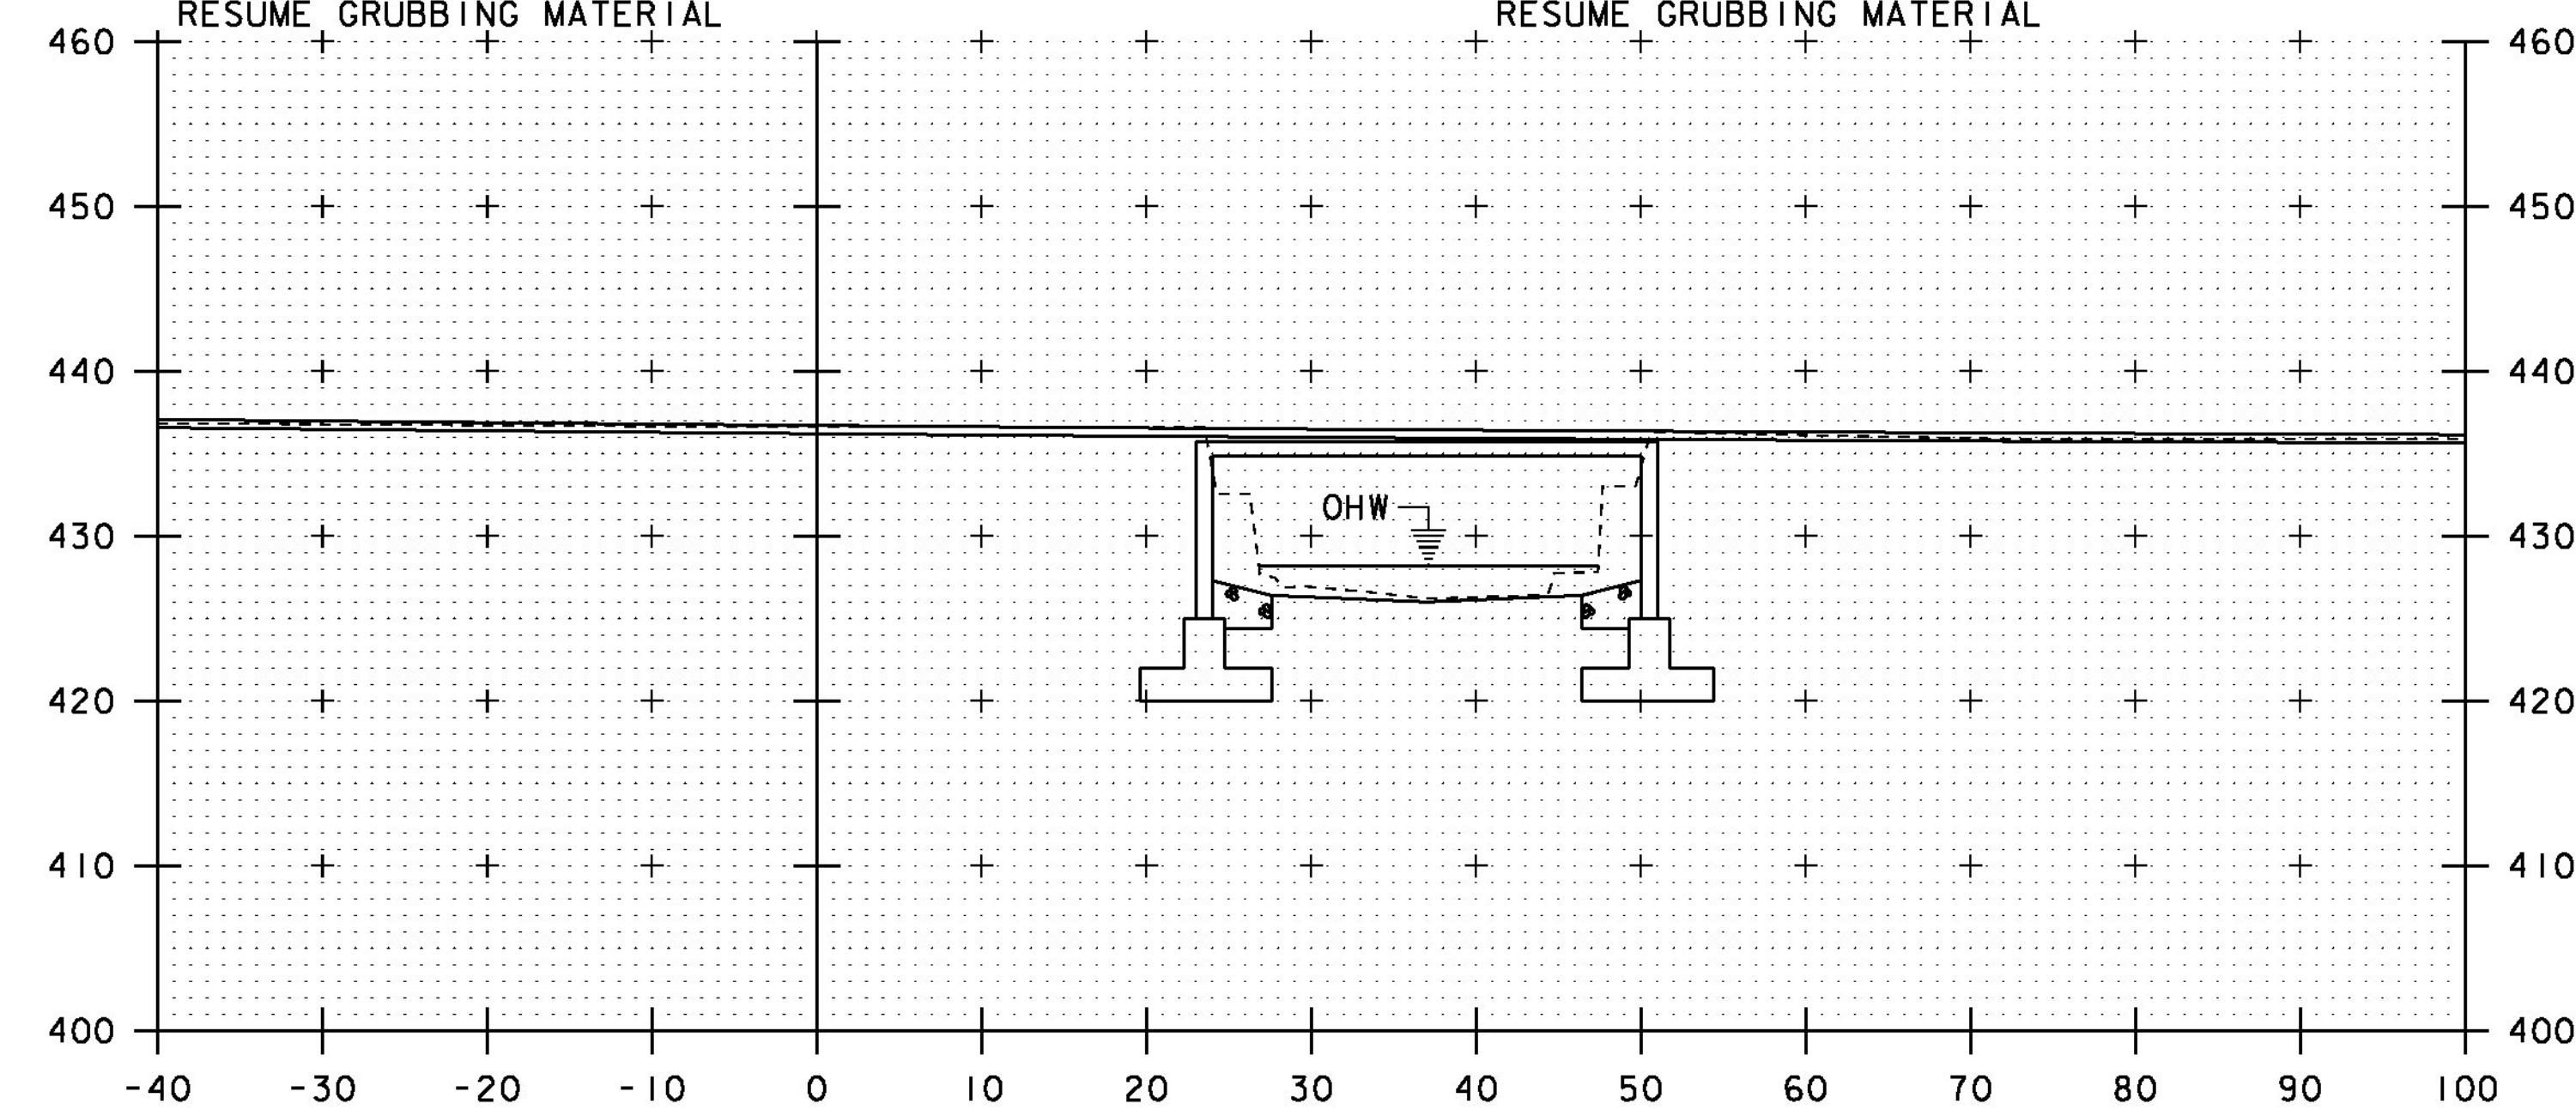

51+10

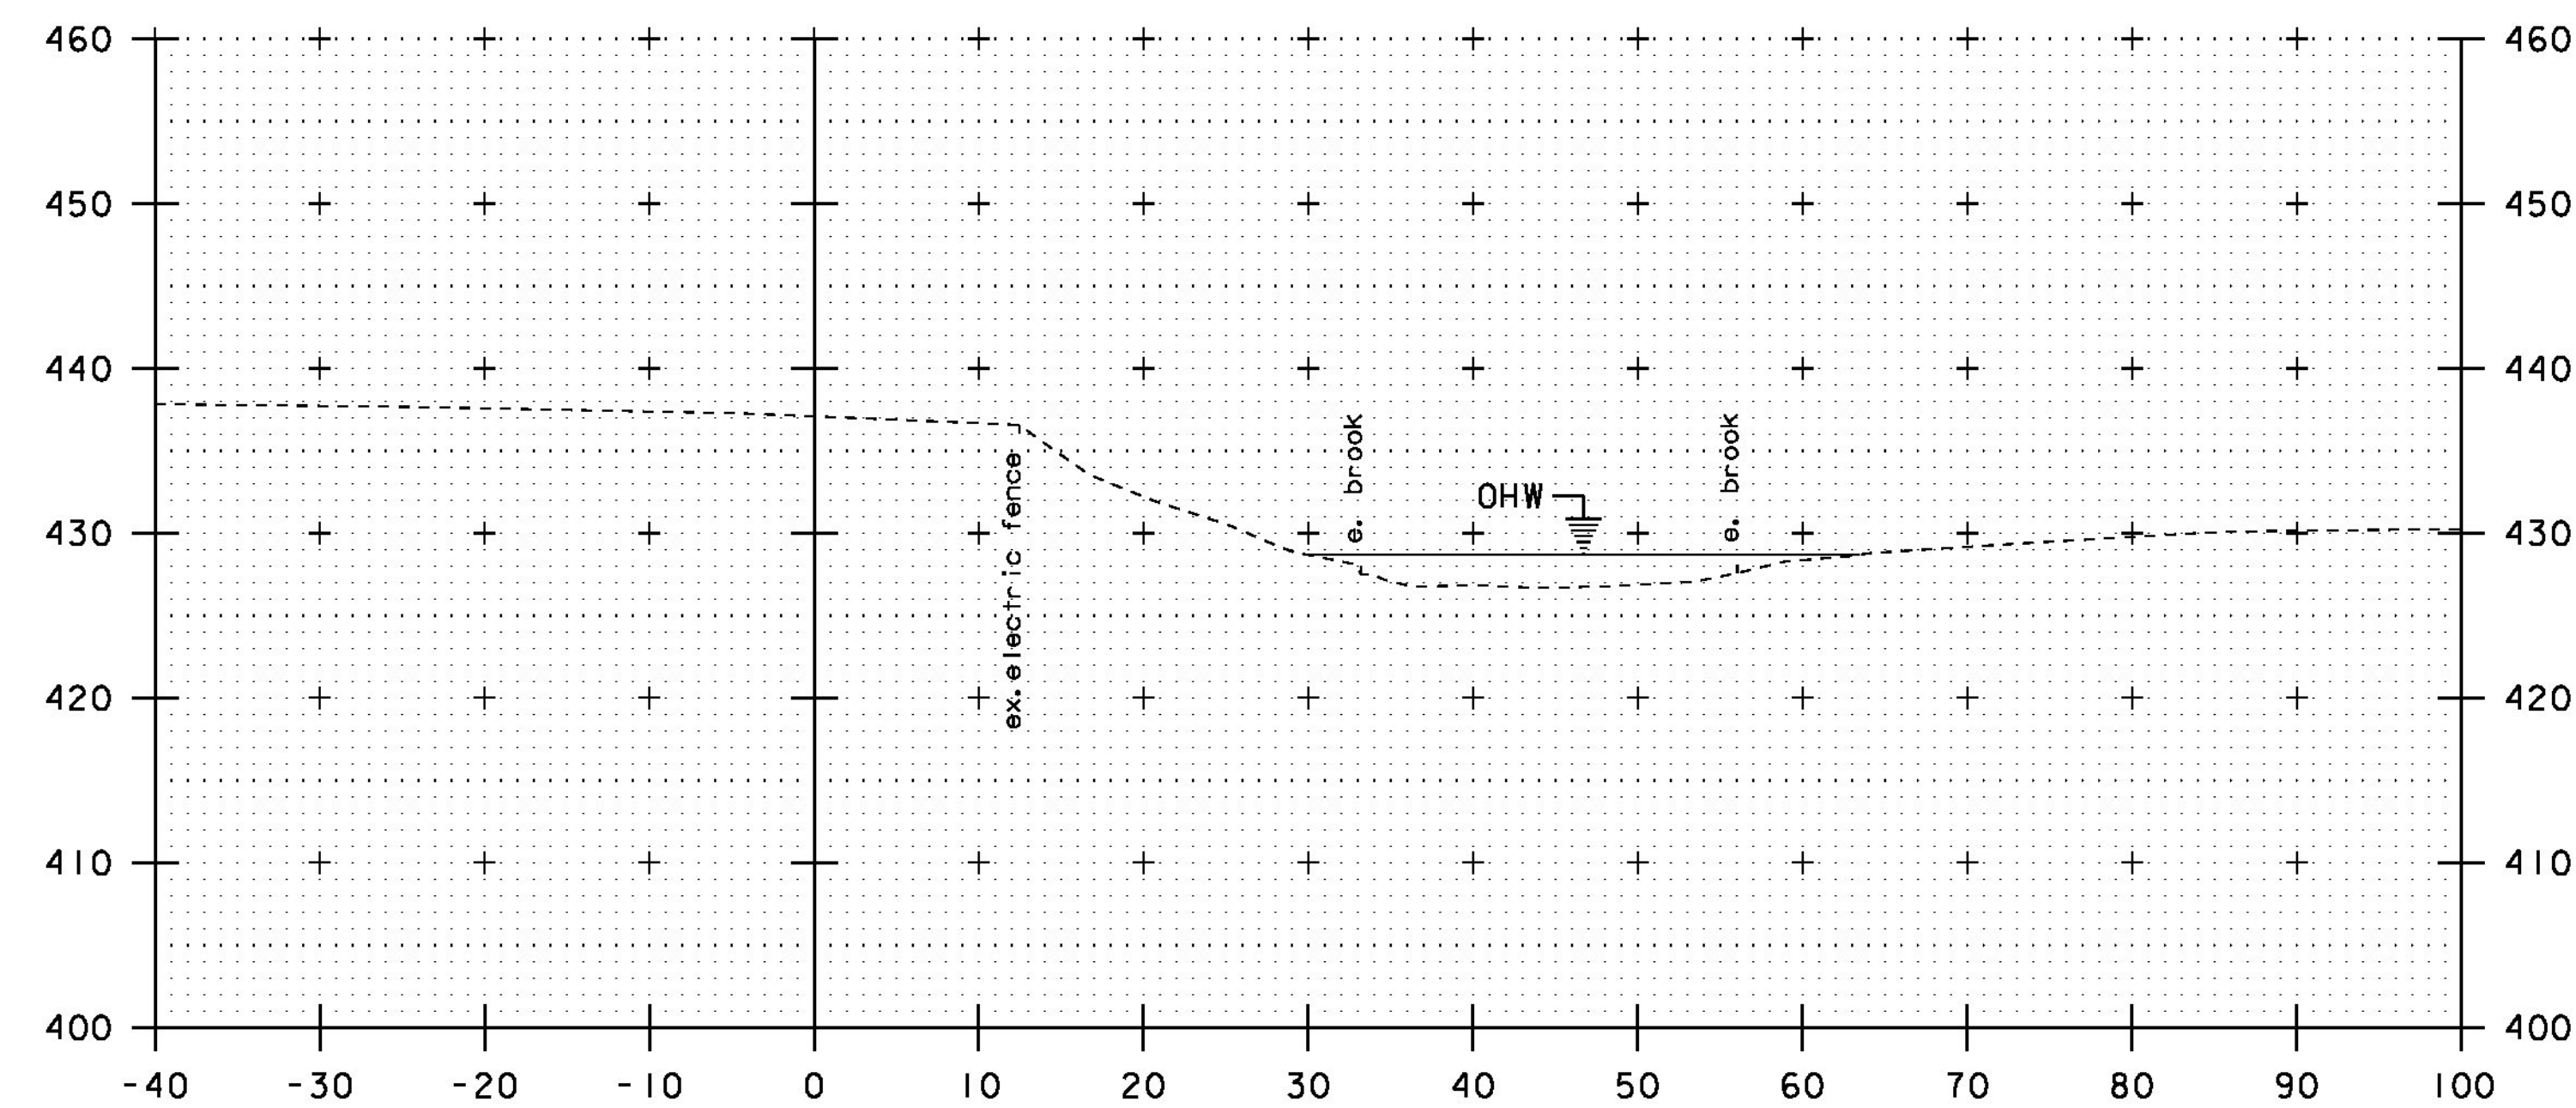

51+40

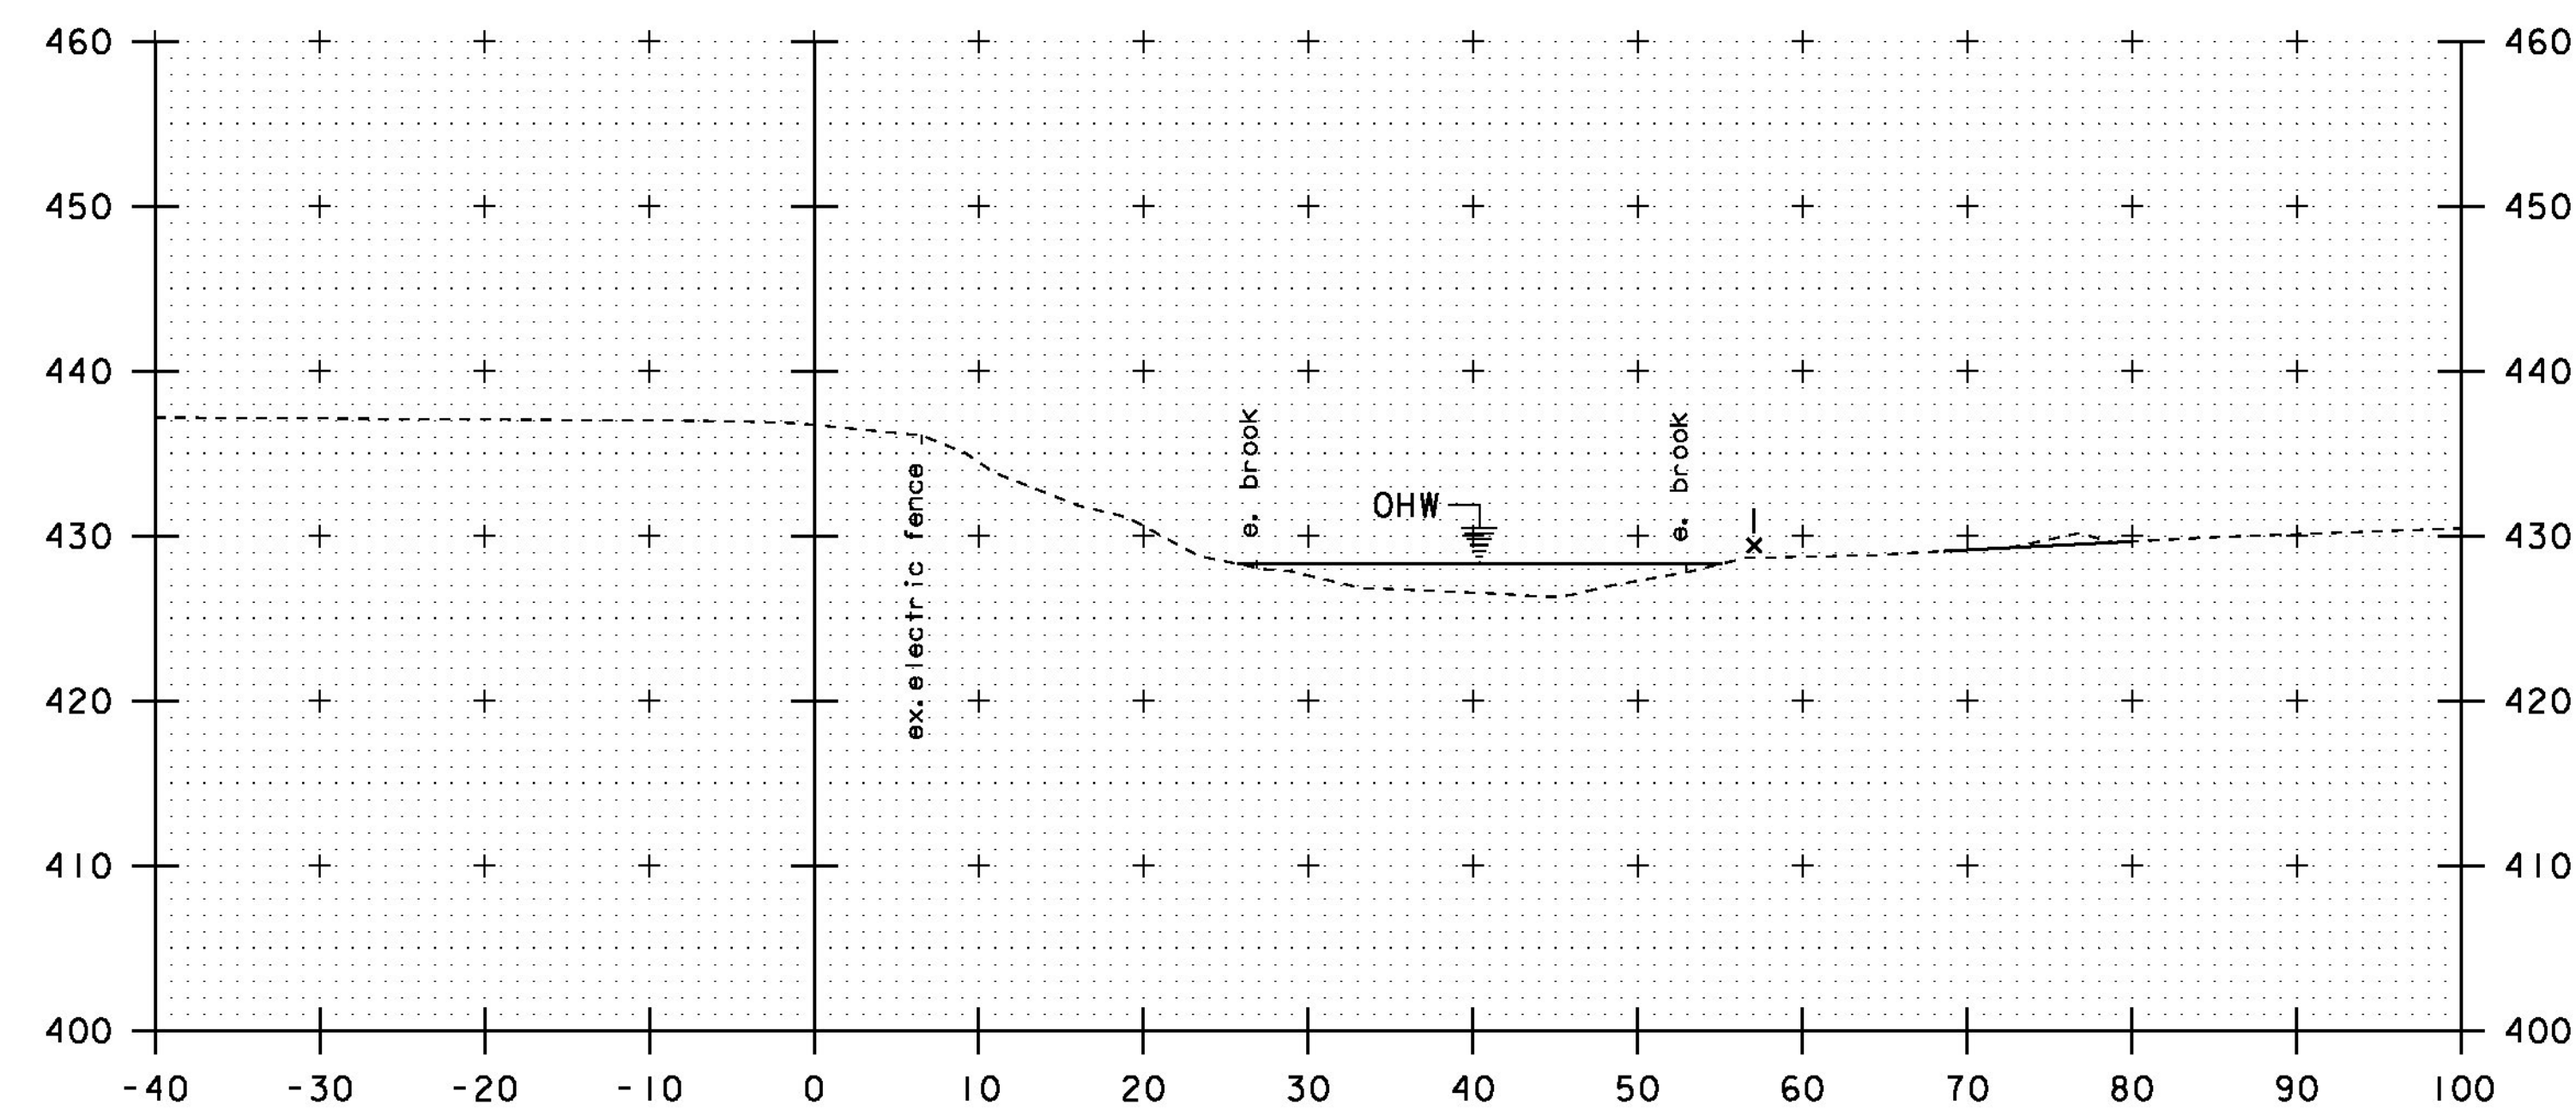


51+30




PROJECT NAME: RICHFORD	
PROJECT NUMBER: BRF 0302(29)	
FILE NAME: sl2j158xs.dgn	PLOT DATE: 11-DEC-2014
PROJECT LEADER: C. CARLSON	DRAWN BY: R. PELLETT
DESIGNED BY: H. SALLS	CHECKED BY: H. SALLS
CHANNEL CROSS SECTIONS 2	SHEET 30 OF 36

STA. 51+10 TO STA. 51+40



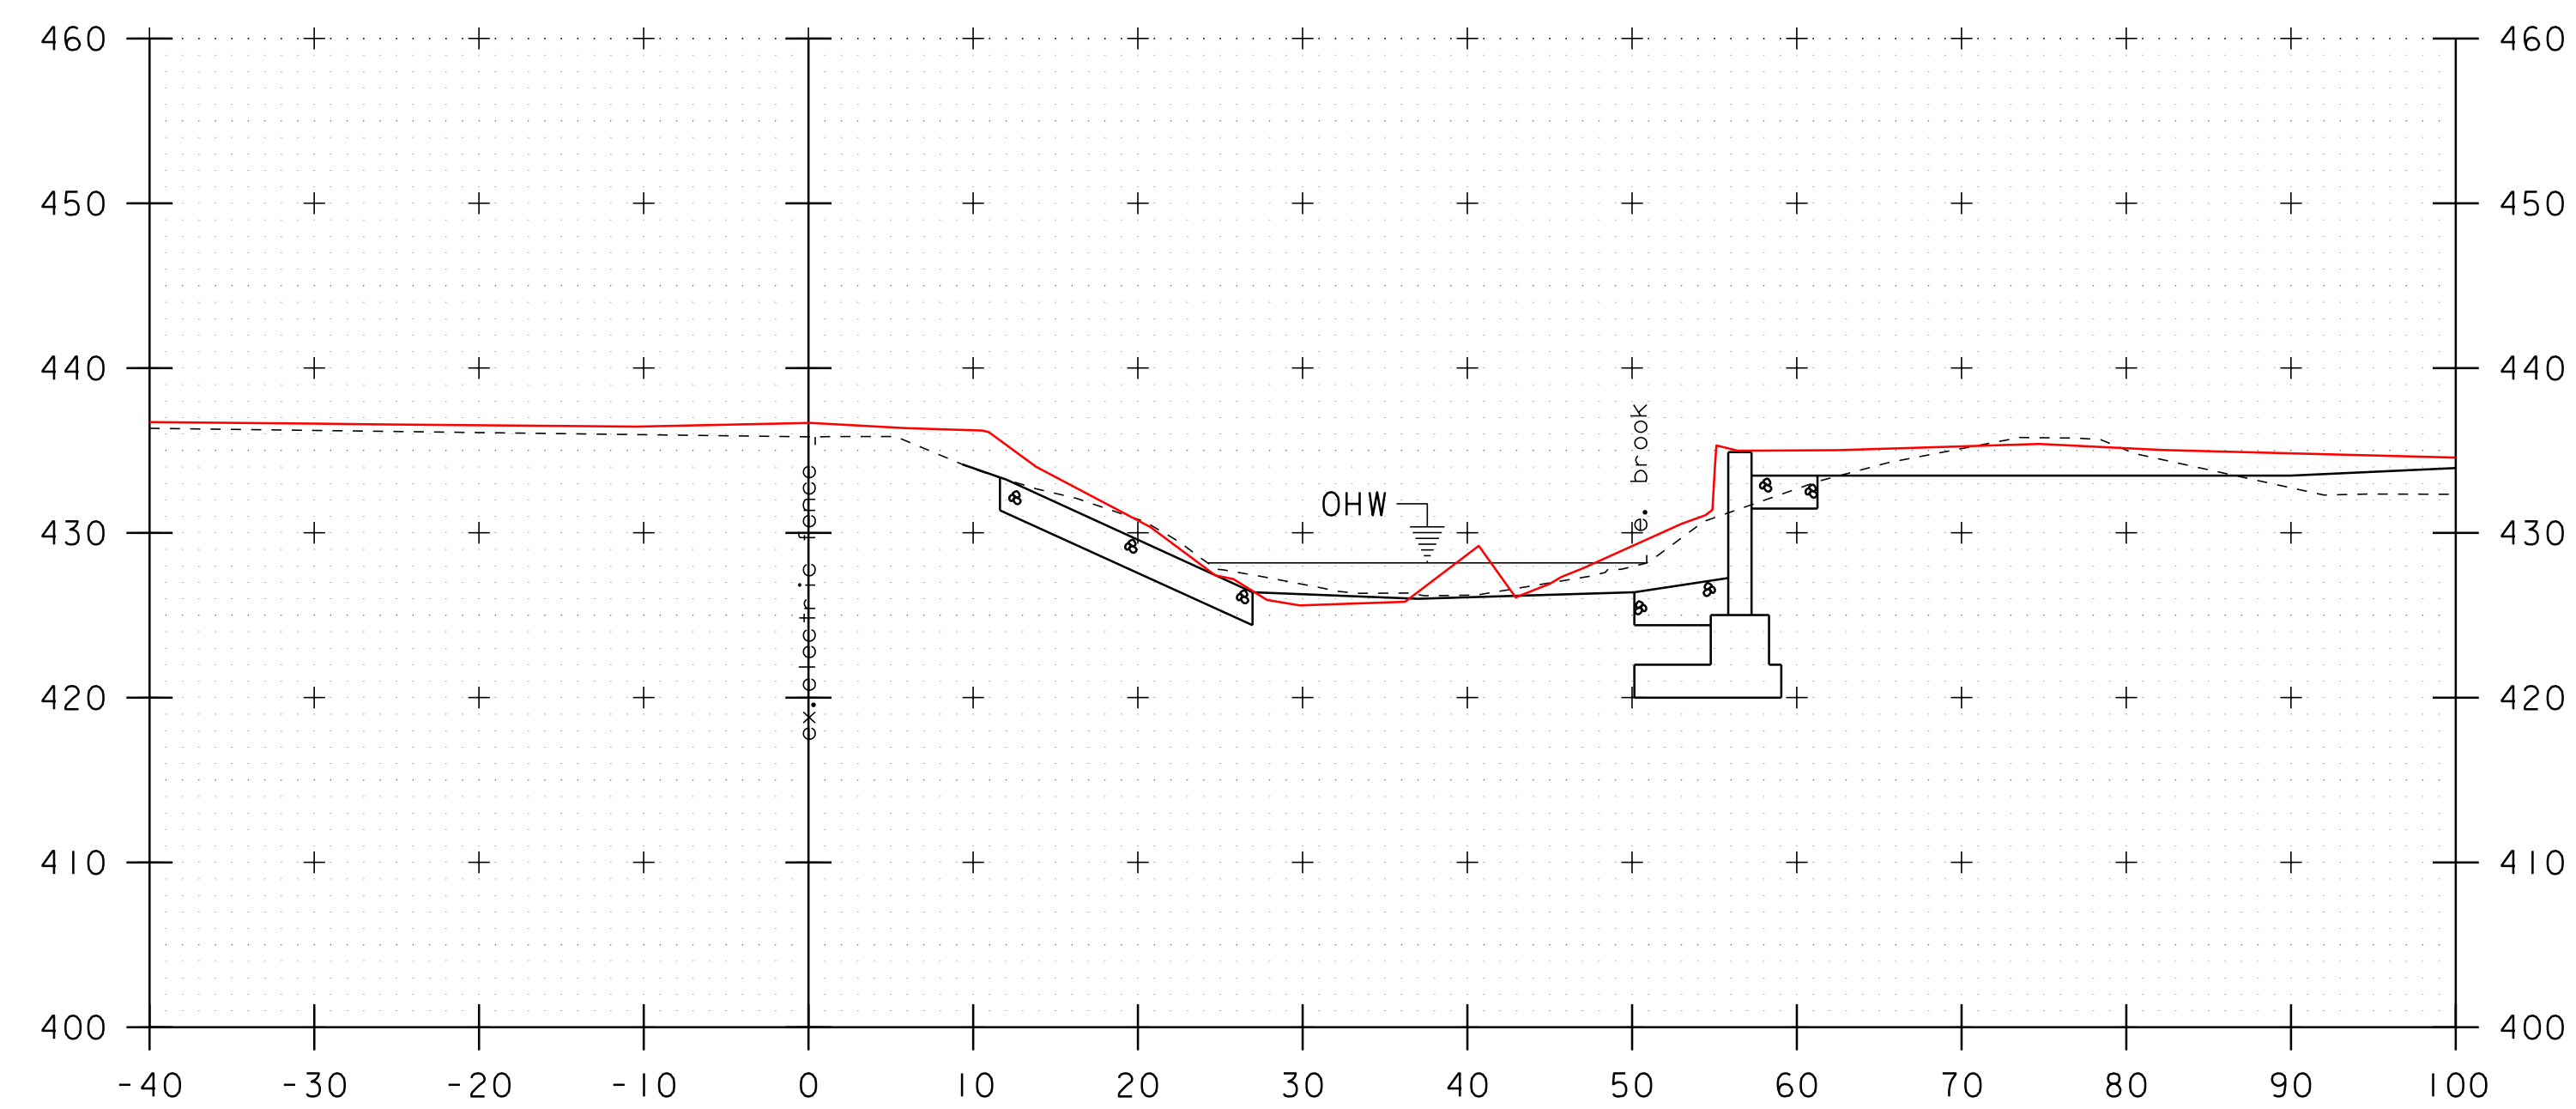

```
STA 51+21.00 RT
END UNCLASSIFIED CHANNEL EXCAVATION
GEOTEXTILE UNDER STONE FILL
STONE FILL, TYPE II
GRUBBING MATERIAL
STA 51+14.50 RT
RESUME GRUBBING MATERIAL
```

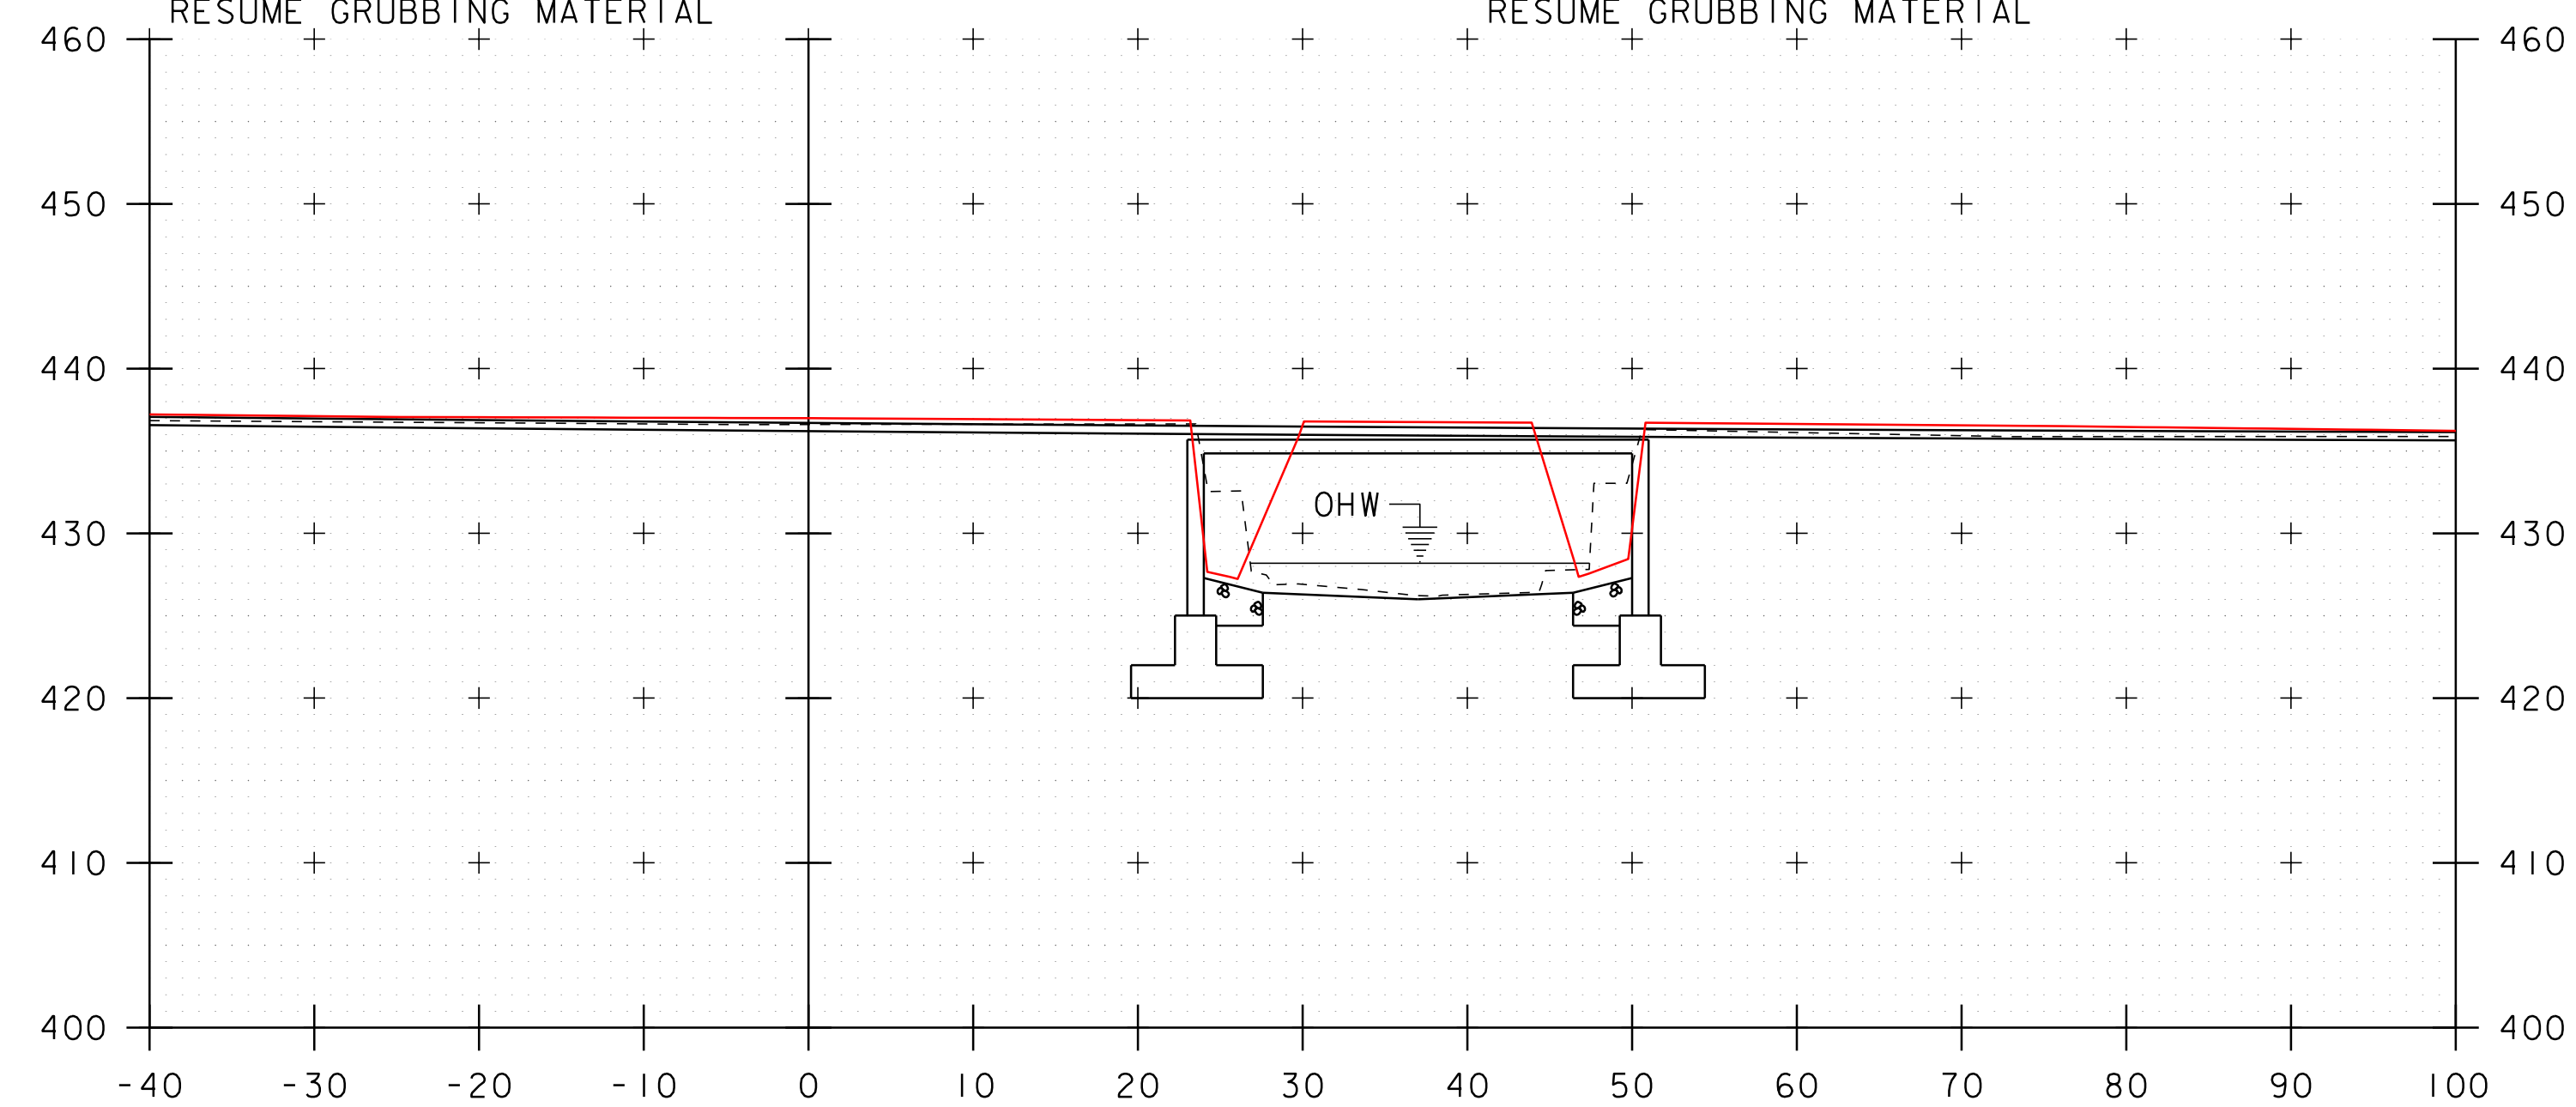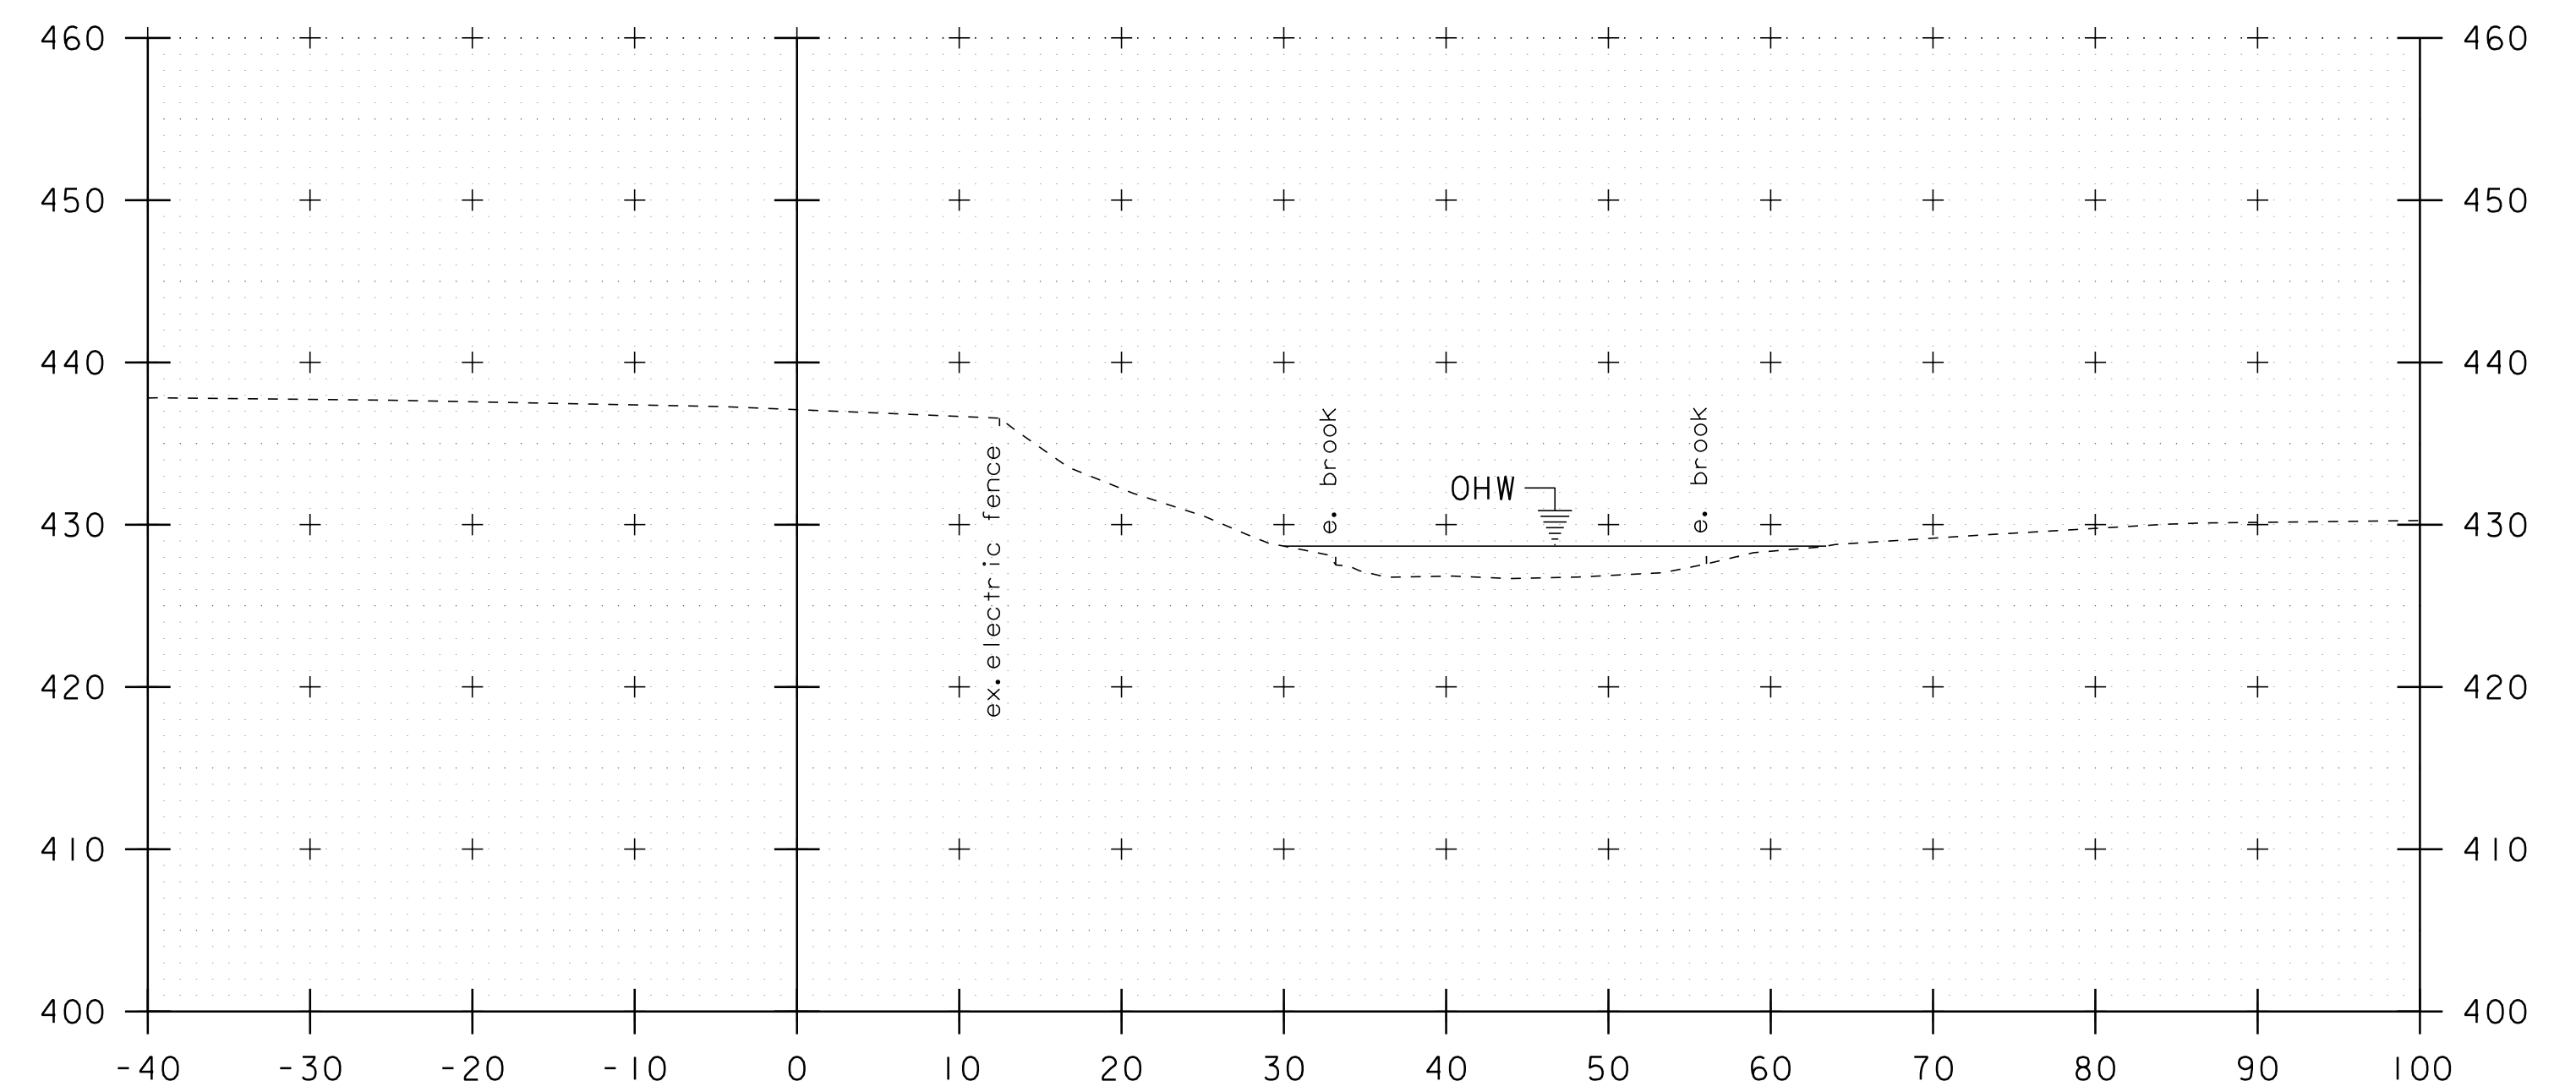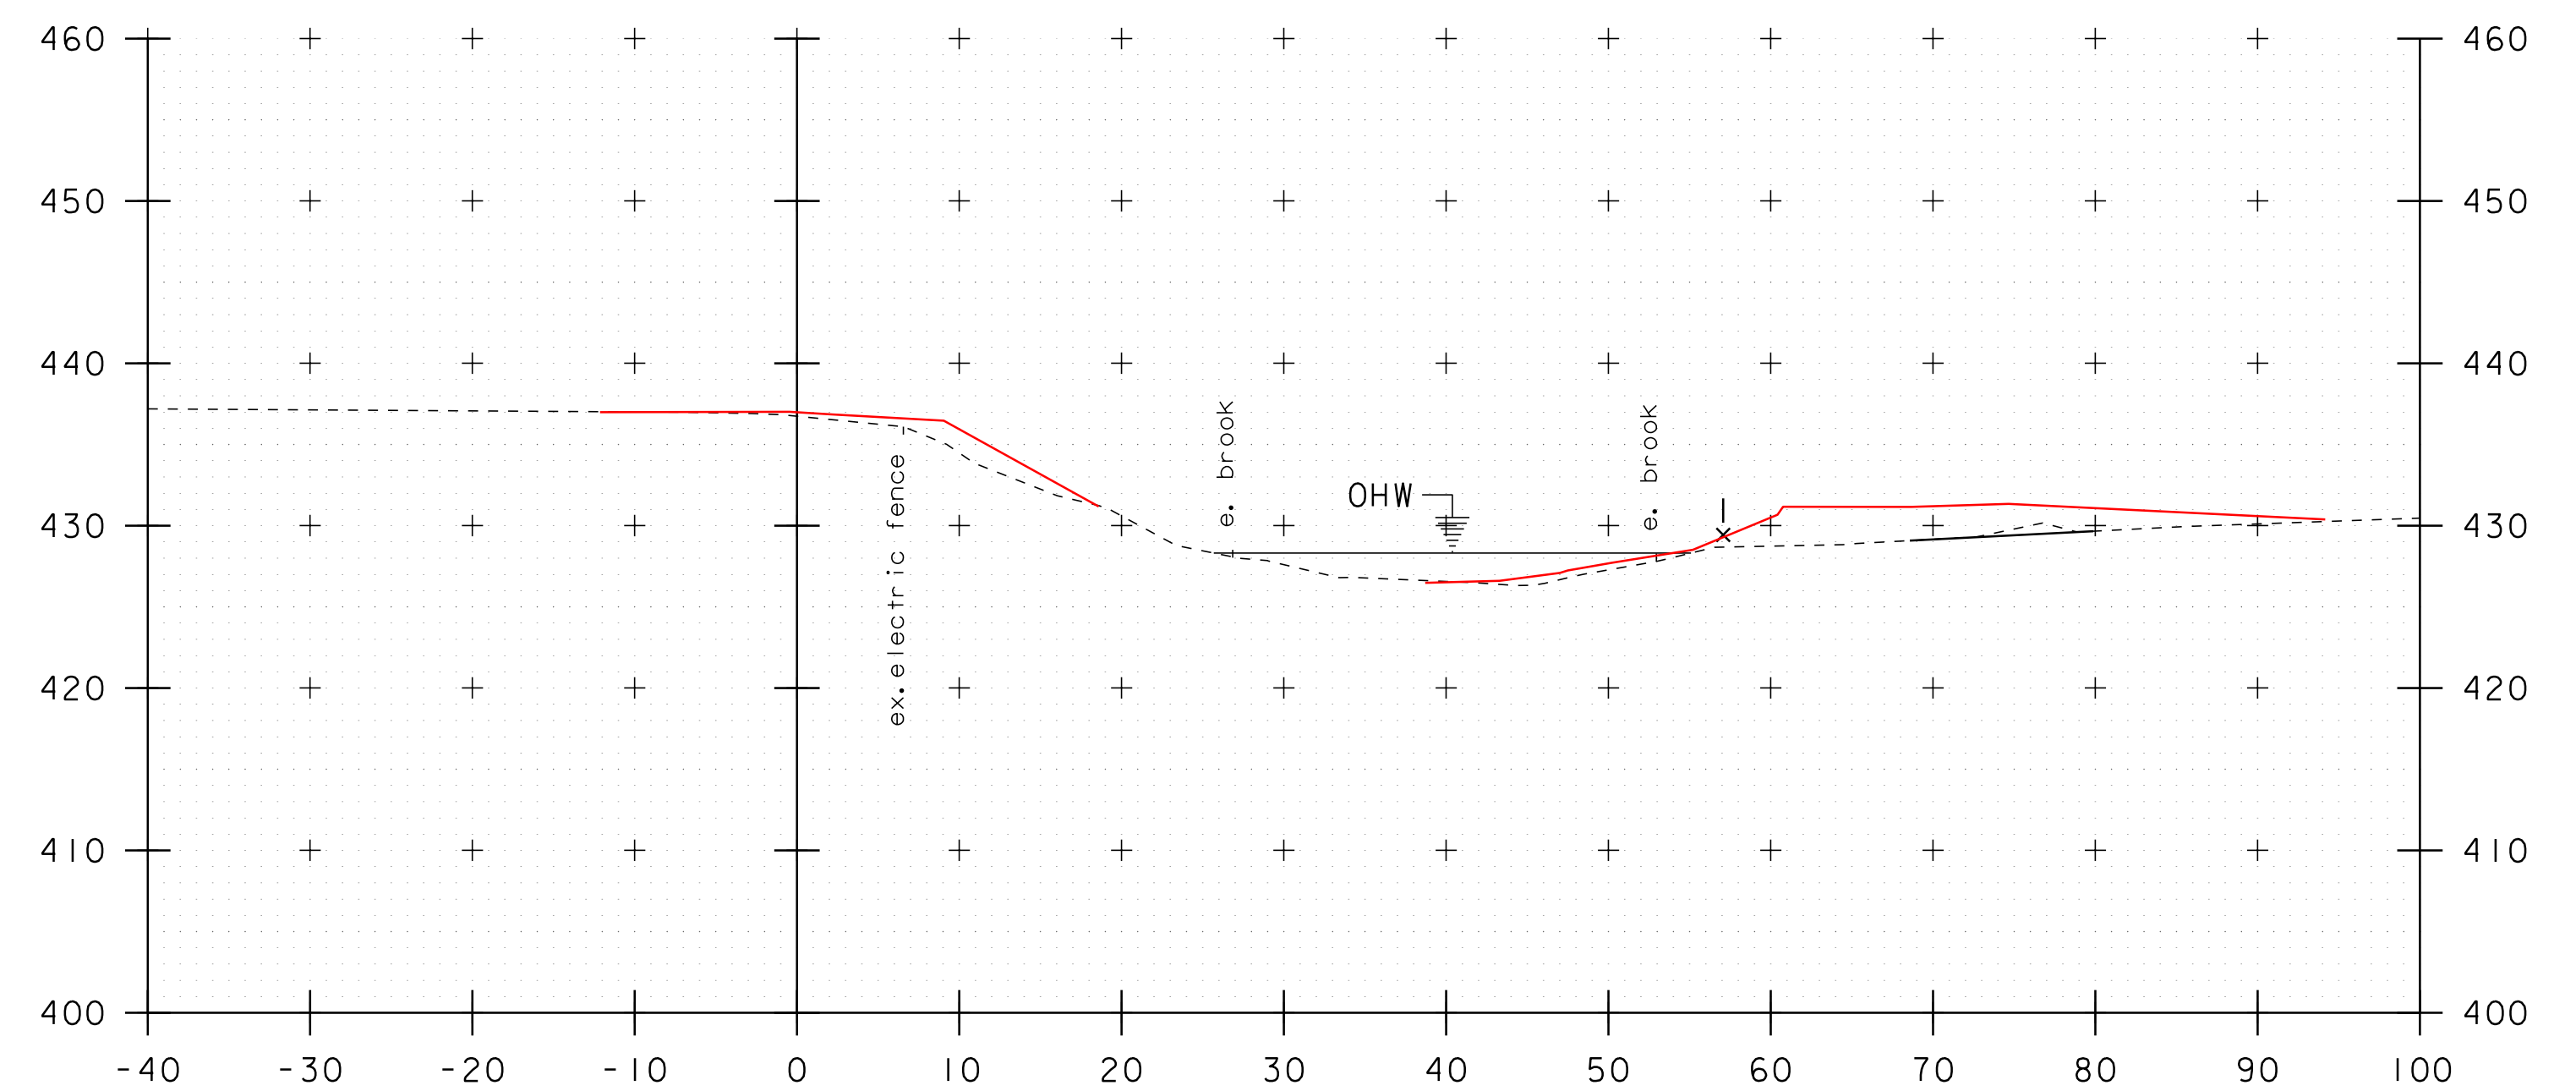 $51 + 20$  $51 + 10$  $51 + 40$  $51 + 30$ 

PROJECT NAME:	RICHFORD
PROJECT NUMBER:	BRF 0302(29)

FILE NAME: sl2j158xs.dgn  
PROJECT LEADER: C. CARLSON  
DESIGNED BY: H. SALLS  
CHANNEL CROSS SECTIONS 2

PLOT DATE: 09-AUG-2016 09:57  
DRAWN BY: R. PELLETT  
CHECKED BY: H. SALLS  
SHEET 30R OF 36  
37 64

STA. 51+10 TO STA. 51+40



EPSC PLAN NARRATIVE

1.1 PROJECT DESCRIPTION

THIS PROJECT INVOLVES THE REPLACEMENT OF BRIDGE 6 AND APPROACH ROADWAY AND CHANNEL WORK. EXISTING CONCRETE T-BEAM WILL BE REPLACED WITH A PRECAST CONCRETE 3-SIDED FRAME OR ARCH, SPANNING 28 FEET OVER BERRY BROOK. BRIDGE 6 IS LOCATED IN THE TOWN OF RICHFORD, ON TH 3 1.2 MILES WEST OF JUNCTION WITH TH 1.

NOTE: AREA OF DISTURBANCE INCLUDES LIMITS OF EARTH DISTURBANCE WITHIN THE PROJECT AREA, AS WELL AS WASTE, BORROW AND STAGING AREAS, AND OTHER EARTH DISTURBING ACTIVITIES WITHIN OR DIRECTLY ADJACENT TO THE PROJECT LIMITS AS SHOWN ON THE ATTACHED EPSC PLAN.

TOTAL AREA OF DISTURBANCE AS SHOWN ON THE ATTACHED EPSC PLAN IS APPROXIMATELY 0.35 ACRE.

IT IS ANTICIPATED THAT THIS PROJECT WILL LAST ONE CONSTRUCTION SEASON.

1.2 SITE INVENTORY

1.2.1 TOPOGRAPHY

THE TOPOGRAPHY OF THE AREA IS HILLY, WITH A MIXTURE OF OPEN AND FORESTED LAND COVER. TOWN HIGHWAY 3, FIELD DRIVE AND GRAVEL DRIVEWAY ARE WITHIN THE PROJECT LIMITS. THERE IS A RESIDENCE ON THE EAST SIDE OF THE PROJECT.

1.2.2 DRAINAGE, WATERWAYS, BODIES OF WATER, AND PROXIMITY TO NATURAL OR MAN-MADE WATER FEATURES

THE BERRY BROOK IS THE ONLY WATER SOURCE WITHIN THE PROJECT LIMITS. THE BROOK IS CLASSIFIED AS STEEP, SINUOUS, ALUVIAL WITH LOW BANKS TO FLOODPLAIN RELIEF. STREAM BED CONSISTS OF MOSTLY SAND, GRAVEL AND SILT WITH SOME COBBLES. DUE TO THE NATURE OF THE SURROUNDING TERRAIN THE PROJECT SITE COULD RECEIVE FLOOD WATER FROM THE MISSISQUOI RIVER AS IT MAY BACK UP THROUGH THE SITE.

1.2.3 VEGETATION

THE VEGETATION IN THE PROJECT AREA CONSISTS OF PASTURE LAND. THE IMPACT TO VEGETATION WILL BE LIMITED TO THAT WHICH IS DIRECTLY AFFECTED BY REPLACEMENT OF THE EXISTING BRIDGE. UPON PROJECT COMPLETION, THE CHANNEL WILL BE ARMORED WITH STONE FILL TYPE II AS SPECIFIED ON THE PLANS. DISTURBED VEGETATION WILL BE REESTABLISHED WITH STANDARD SEED AND MULCH PRACTICES.

1.2.4 SOILS

ALL SOIL DATA CAME FROM THE U.S. DEPARTMENT OF AGRICULTURE SOIL CONSERVATION SERVICE FOR THE COUNTY OF FRANKLIN, VERMONT. SOIL ON THE PROJECT SITE IS PEACHAM STONY SOILS, <1%, “K FACTOR” = 0.28. THE SOIL IS CONSIDERED MODERATELY ERODIBLE DUE TO SLOPES.

NOTE: K-VALUES GENERALLY INDICATE THE FOLLOWING:  
0.0-0.23 = LOW EROSION POTENTIAL  
0.24-0.36 = MODERATE EROSION POTENTIAL  
0.37 AND HIGHER = HIGH EROSION POTENTIAL

1.2.5 SENSITIVE RESOURCE AREAS

CRITICAL HABITATS: NO  
HISTORICAL OR ARCHEOLOGICAL AREAS: NO  
PRIME AGRICULTURAL LAND: NO  
THREATENED AND ENDANGERED SPECIES: NO  
WATER RESOURCE: BERRY BROOK  
WETLANDS: YES

1.3 RISK EVALUATION

THIS PROJECT DOES NOT FALL UNDER THE JURISDICTION OF GENERAL PERMIT 3-9020 FOR STORMWATER RUNOFF FROM CONSTRUCTION SITES. SHOULD CHANGES PRIOR TO OR DURING CONSTRUCTION RESULT IN ONE OR MORE ACRES OF EARTH DISTURBANCE OR SHOULD THE PROJECT BECOME PART OF A LARGER PLAN OF DEVELOPMENT, THE CONTRACTOR WILL BE RESPONSIBLE FOR ANY ADDITIONAL PERMITTING.

1.4 EROSION PREVENTION AND SEDIMENT CONTROL

THE EROSION CONTROL PLANS ARE MEANT AS A GUIDELINE FOR PREVENTING EROSION AND CONTROLLING SEDIMENT TRANSPORT. THE PRINCIPLES OUTLINED IN THIS NARRATIVE CONSIST OF APPLYING MEASURES THROUGHOUT CONSTRUCTION OF THE PROJECT IN ORDER TO MINIMIZE SEDIMENT TRANSPORT TO THE RECEIVING WATERS. THE MEASURES INCLUDE STABILIZATION AND STRUCTURAL PRACTICES, STORM WATER CONTROLS AND OTHER POLLUTION PREVENTION PRACTICES. THEY HAVE BEEN PROPOSED BY THE DESIGNER AS A BASIS FOR PROTECTING RESOURCES AND WILL NEED TO BE BUILT UPON BASED ON THE SPECIFIC MEANS AND METHODS OF THE CONTRACTOR. REFER TO THE LOW RISK SITE HANDBOOK AND APPROPRIATE DETAIL SHEETS FOR SPECIFIC GUIDANCE AND CONSTRUCTION DETAILING.

ALL MEASURES SHALL BE REGULARLY MAINTAINED AND SHALL BE CHECKED FOR SEDIMENT BUILD-UP. SEDIMENT SHALL BE DISPOSED OF AT AN APPROVED SITE WHERE IT WILL NOT BE SUBJECT TO EROSION.

1.4.1 MARK SITE BOUNDARIES

SITE BOUNDARIES AND AREAS CONSTRUCTION EQUIPMENT CAN ACCESS SHALL BE DELINEATED.

PROJECT DEMARCATION FENCING (PDF) AND BARRIER FENCE SHALL BE USED TO PHYSICALLY MARK SITE BOUNDARIES.

1.4.2 LIMIT DISTURBANCE AREA

PREVENTING INITIAL SOIL EROSION BY MINIMIZING THE EXPOSED AREA IS MUCH MORE EFFECTIVE THAN TREATING ERODED SEDIMENT. EARTH DISTURBANCE CAN BE MINIMIZED THROUGH CONSTRUCTION PHASING BY ONLY OPENING UP EARTH AS NECESSARY. THIS CAN LIMIT THE AREA THAT WILL BE DISTURBED AND EXPOSED TO EROSION. EMPLOY TEMPORARY CONSTRUCTION STABILIZATION PRACTICES IN INCREMENTAL STAGES AS PHASES CHANGE. FOR PROJECTS WHICH FALL UNDER THE CONSTRUCTION GENERAL PERMIT, ONLY THE ACREAGE LISTED ON THE PERMIT AUTHORIZATION MAY BE EXPOSED AT ANY GIVEN TIME.

MAINTAINING VEGETATED BUFFERS ALONG STREAM BANKS, WETLANDS OR OTHER SENSITIVE AREAS IS A CRUCIAL EROSION AND SEDIMENT CONTROL MEASURE THAT SHOULD BE ESTABLISHED WHEREVER POSSIBLE.

1.4.3 SITE ENTRANCE/EXIT STABILIZATION

TRACKING OF SEDIMENT ONTO PUBLIC HIGHWAYS SHALL BE MINIMIZED TO REDUCE THE POTENTIAL FOR RUNOFF ENTERING RECEIVING WATERS. INSTALLATION SHALL COINCIDE WITH THE CONTRACTOR’S PROGRESS SCHEDULE.

STABILIZED CONSTRUCTION ENTRANCES SHALL BE INSTALLED AS PROPOSED ON THE EPSC PLAN AND ANYWHERE EQUIPMENT WILL BE GOING FROM AREAS OF EXPOSED SOILS TO PAVED SURFACES.

1.4.4 INSTALL SEDIMENT BARRIERS

SEDIMENT BARRIERS SHALL BE UTILIZED TO INTERCEPT RUNOFF AND ALLOW SUSPENDED SEDIMENT TO SETTLE OUT. THEY SHALL BE INSTALLED PRIOR TO ANY UP SLOPE WORK.

SILT FENCE AND TURBIDITY CURTAIN WILL BE INSTALLED AS PROPOSED ON THE EPSC PLAN.

1.4.5 DIVERT UPLAND RUNOFF

DIVERSIONARY MEASURES SHALL BE USED TO INTERCEPT RUNOFF FROM ABOVE THE CONSTRUCTION AND DIRECT IT AROUND THE DISTURBED AREA SO THAT CLEAN WATER DOES NOT BECOME MUDDIED WHILE TRAVELING OVER EXPOSED SOILS ON THE CONSTRUCTION SITE.

THE PROJECT AREA IS RELATIVELY FLAT. THEREFORE IT IS NOT ANTICIPATED THAT DIVERSION MEASURES WILL BE NECESSARY.

1.4.6 SLOW DOWN CHANNELIZED RUNOFF

NONE ANTICIPATED

1.4.7 CONSTRUCT PERMANENT CONTROLS

NONE ANTICIPATED

1.4.8 STABILIZE EXPOSED SOILS DURING CONSTRUCTION

ALL AREAS OF DISTURBANCE MUST HAVE TEMPORARY STABILIZATION IN PLACE WITHIN 48 HOURS OF DISTURBANCE OR IN ACCORDANCE WITH THE CONSTRUCTION GENERAL PERMIT 3-9020 AUTHORIZATION.

THE FORECAST OF RAINFALL EVENTS SHALL TRIGGER IMMEDIATE PROTECTION OF EXPOSED SOILS.

1.4.9 WINTER STABILIZATION  
VARIOUS MEASURES SPECIFIC TO WINTER MAY BE NECESSARY SHOULD THE PROJECT EXTEND INTO WINTER (OCTOBER 15 THROUGH APRIL 15). REFER TO THE LOW RISK SITE HANDBOOK FOR GUIDANCE.

1.4.10 STABILIZE SOIL AT FINAL GRADE  
EXPOSED SOIL MUST BE STABILIZED WITHIN 48 HOURS OF REACHING FINAL GRADE.

1.4.11 DE-WATERING ACTIVITIES  
DISCHARGE FROM DEWATERING ACTIVITIES THAT FLOWS OFF OF THE CONSTRUCTION SITE MUST NOT CAUSE OR CONTRIBUTE TO A VIOLATION OF THE VERMONT WATER QUALITY STANDARDS.

1.4.12 INSPECT YOUR SITE  
INSPECT THE PROJECT SITE BASED ON SPECIAL PROVISION REQUIREMENTS OR CONSTRUCTION GENERAL PERMIT AUTHORIZATION STIPULATIONS.

1.5 SEQUENCE AND STAGING



THIS SECTION WILL BE DEVELOPED BY THE CONTRACTOR USING THE GUIDANCE OUTLINED IN THE VTRANS EPSC PLAN CONTRACTOR CHECKLIST.

1.5.2 OFF-SITE ACTIVITIES  
IN ADDITION TO THE CONTRACTOR CHECKLIST ANY ACTIVITIES OUTSIDE THE CONSTRUCTION LIMITS SHALL FOLLOW SUBSECTIONS 105.25- 105.29 OF THE STANDARD SPECIFICATIONS FOR CONSTRUCTION.

PROJECT NAME: RICHFORD	
PROJECT NUMBER: BRF 0302(29)	
FILE NAME: sl2j158epsc.narrative.dgn	PLOT DATE: 11-DEC-2014
PROJECT LEADER: C. CARLSON	DRAWN BY: R. PELLETT
DESIGNED BY: H. SALLS	CHECKED BY: H. SALLS
EPSC NARRATIVE	SHEET 31 OF 36



SOIL INFORMATION  
PEACHAM STONY SOILS  
<1% SLOPES  
MODERATE EROSION POTENTIAL  
K=0.28

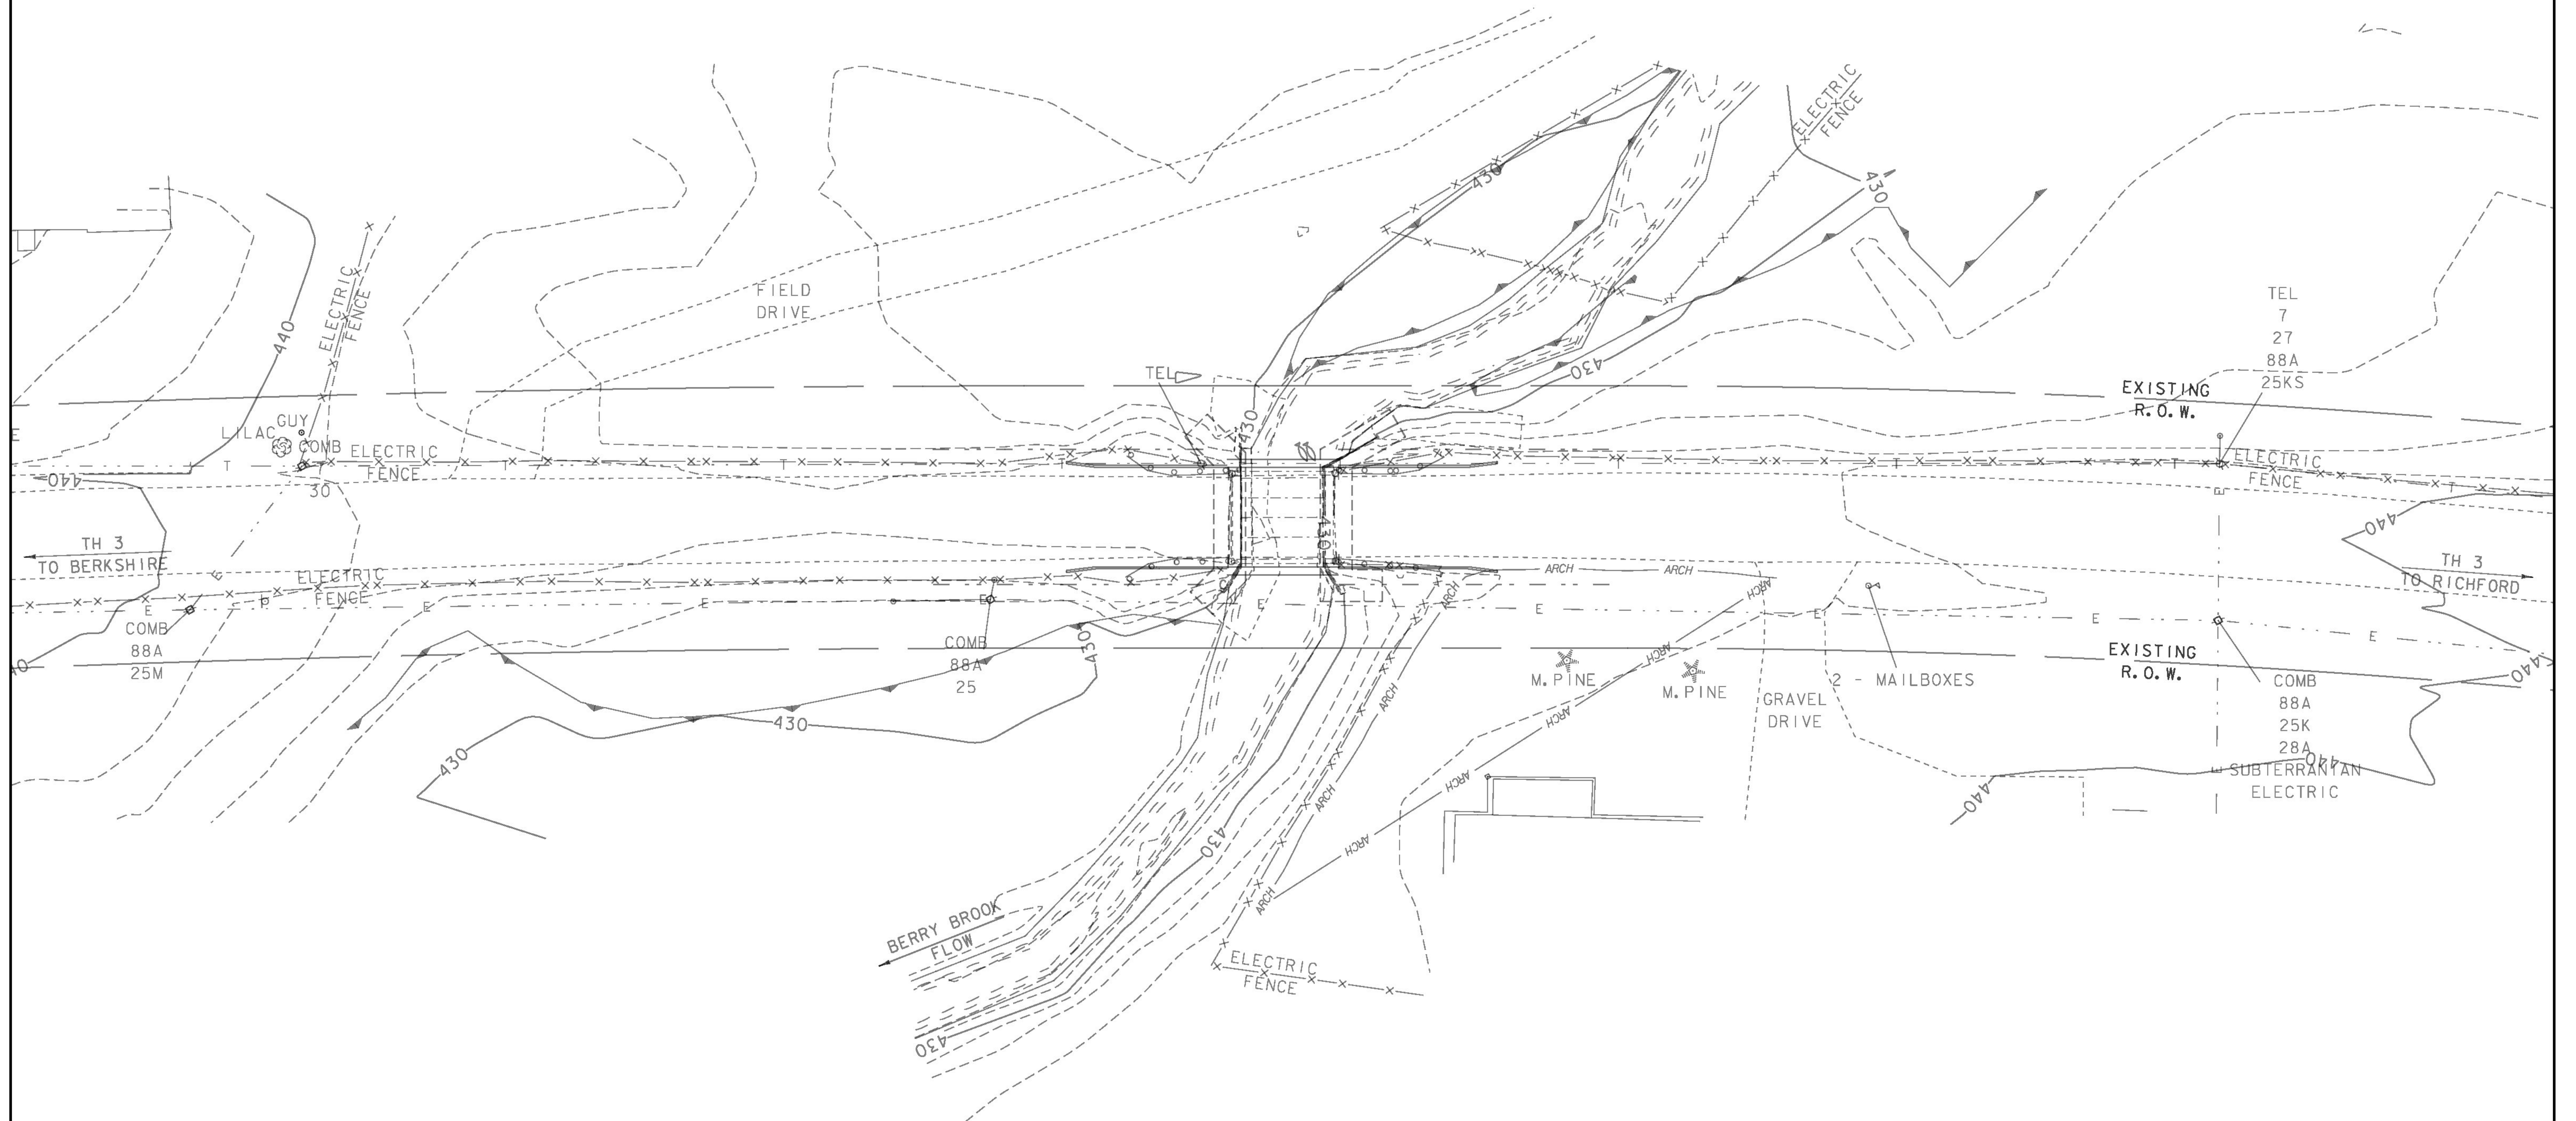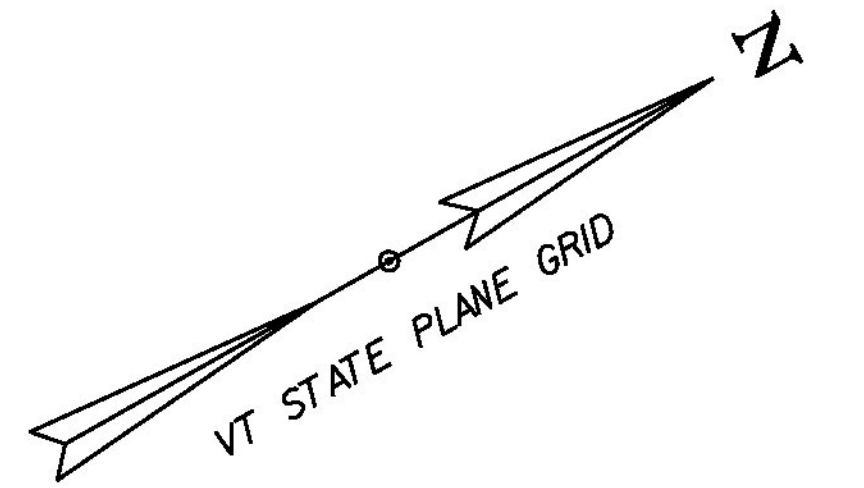

NOTE: SEE SHEET 8 FOR SYMBOLOGY LEGEND



PROJECT NAME: RICHFORD  
PROJECT NUMBER: BRF 0302(29)

FILE NAME: sl2j158bdrero.dgn  
PROJECT LEADER: C. CARLSON  
DESIGNED BY: H. SALLS  
EPSC EXISTING CONDITIONS

PLOT DATE: 11-DEC-2014  
DRAWN BY: R. PELLETT  
CHECKED BY: H. SALLS  
SHEET 32 OF 36

SCALE 1" = 20'-0"  
20 0 20



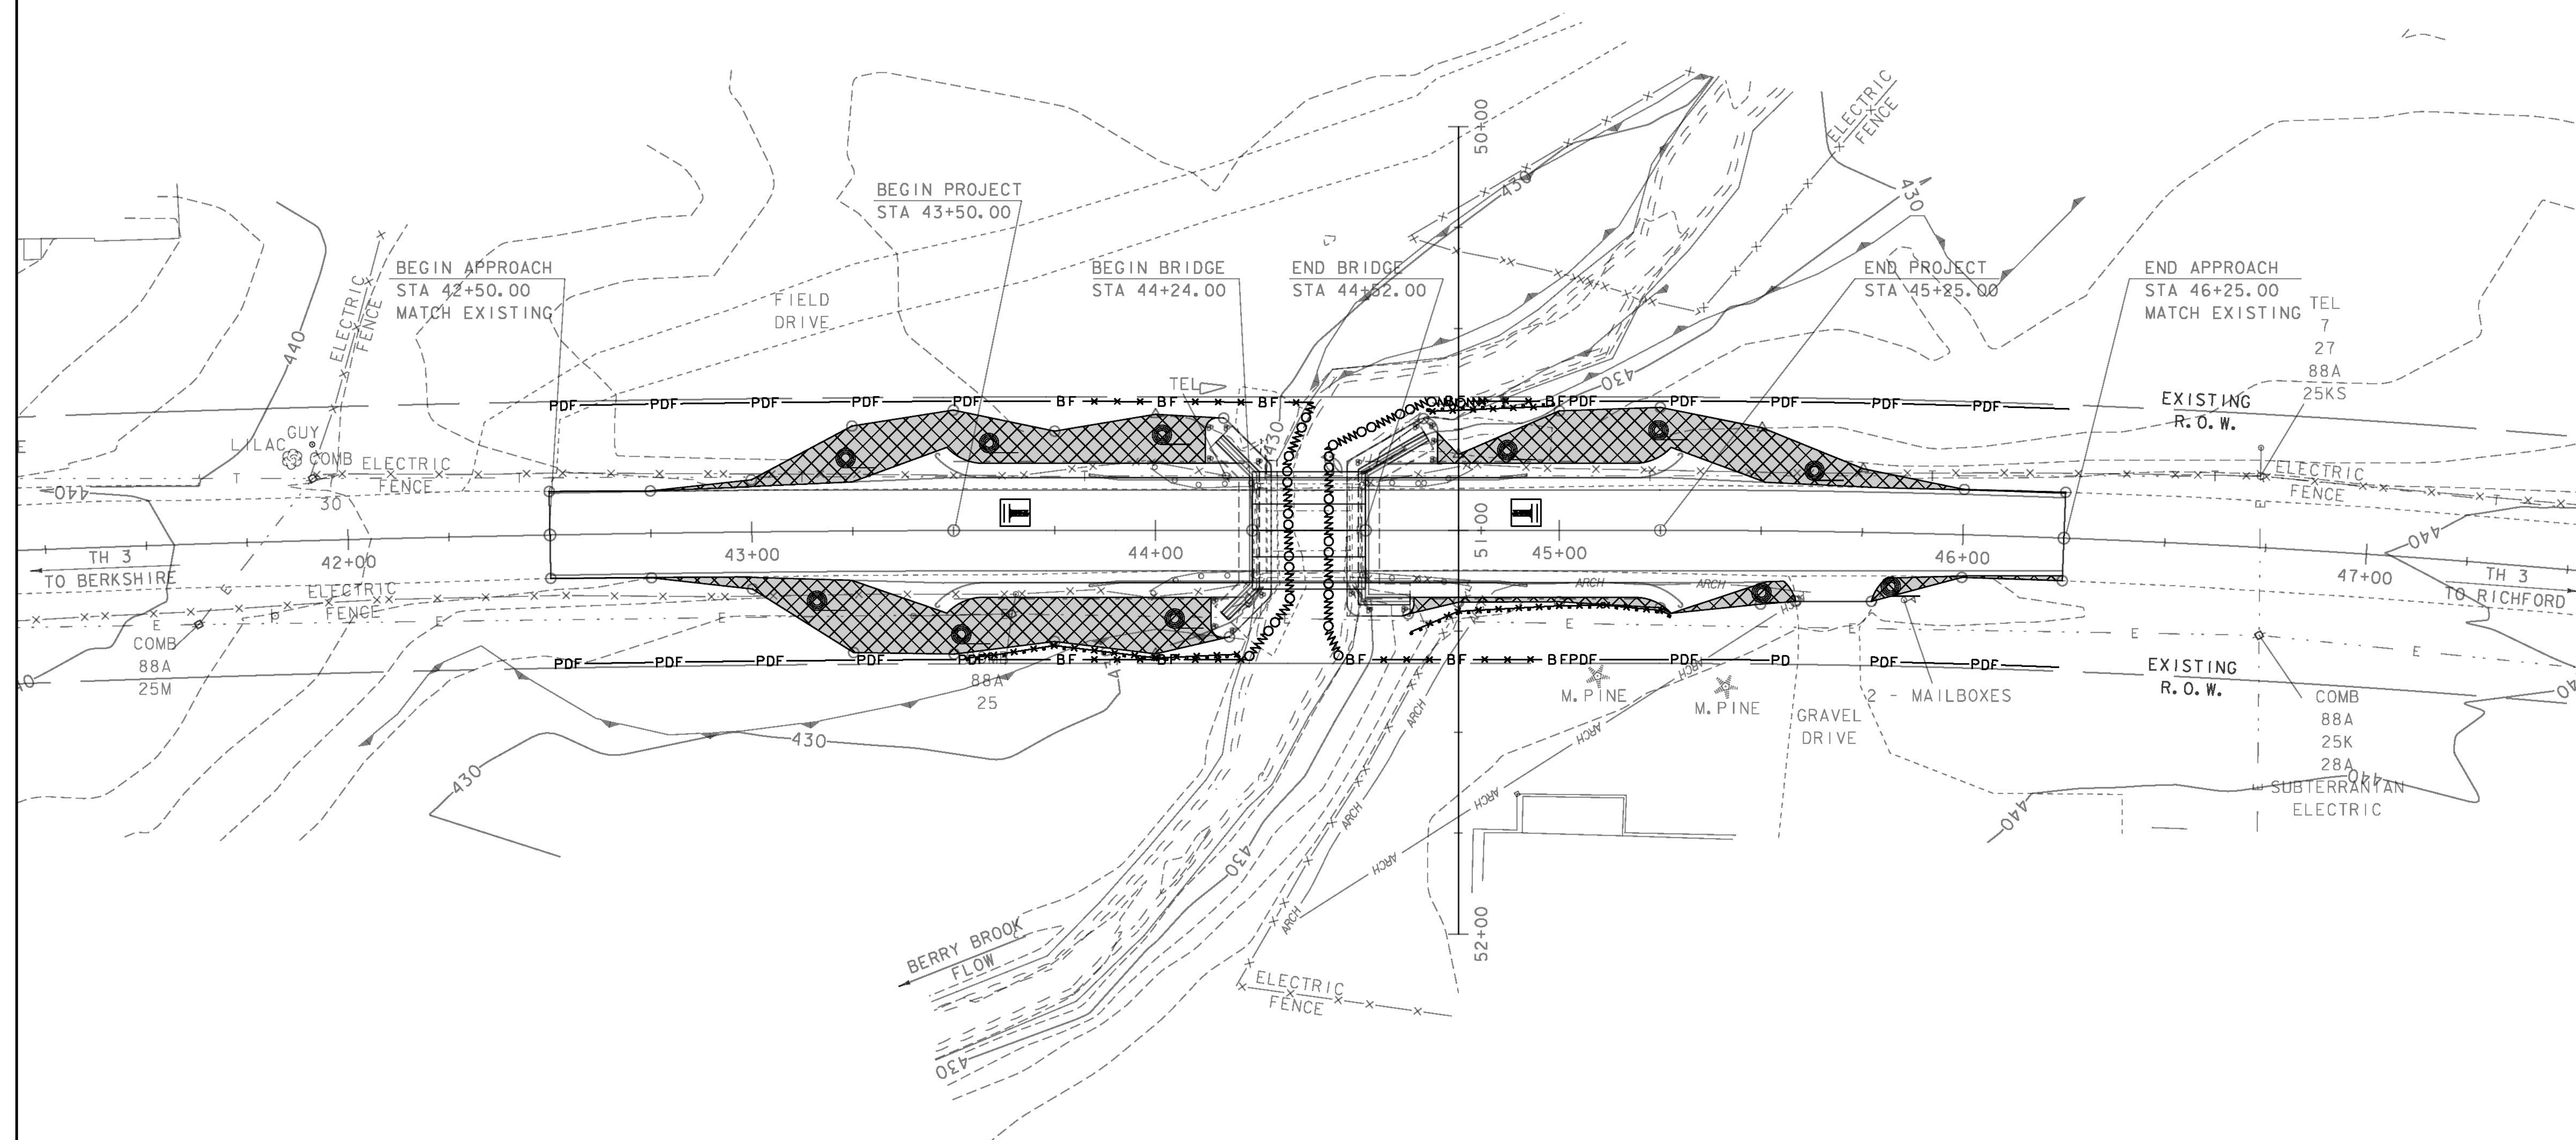
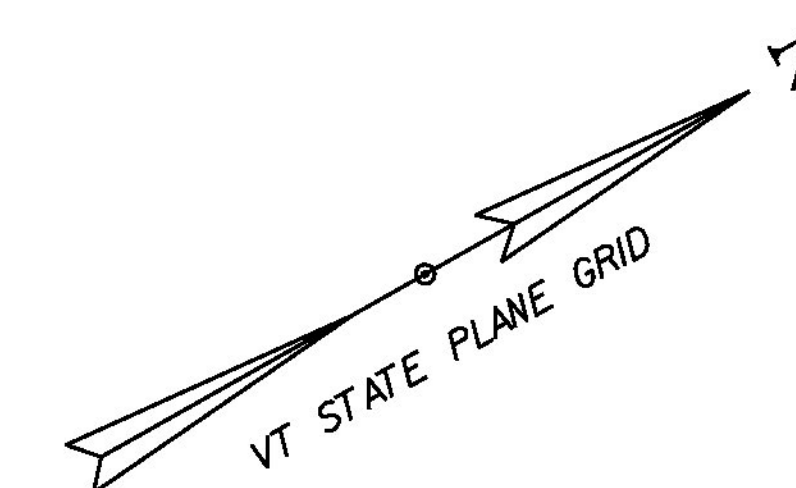


 = STABILIZED CONSTRUCTION ENTRANCE  
NOTE: SEE SHEET 8 FOR SYMBOLOGY LEGEND

SCALE 1" = 20'-0"  
20 0 20

PROJECT NAME: RICHFORD	
PROJECT NUMBER: BRF 0302(29)	
FILE NAME: sl2j158bdrero.dgn	PLOT DATE: 06-JAN-2015
PROJECT LEADER: C. CARLSON	DRAWN BY: R. PELLETT
DESIGNED BY: H. SALLS	CHECKED BY: H. SALLS
EPSC DURING CONSTRUCTION	SHEET 33 OF 36



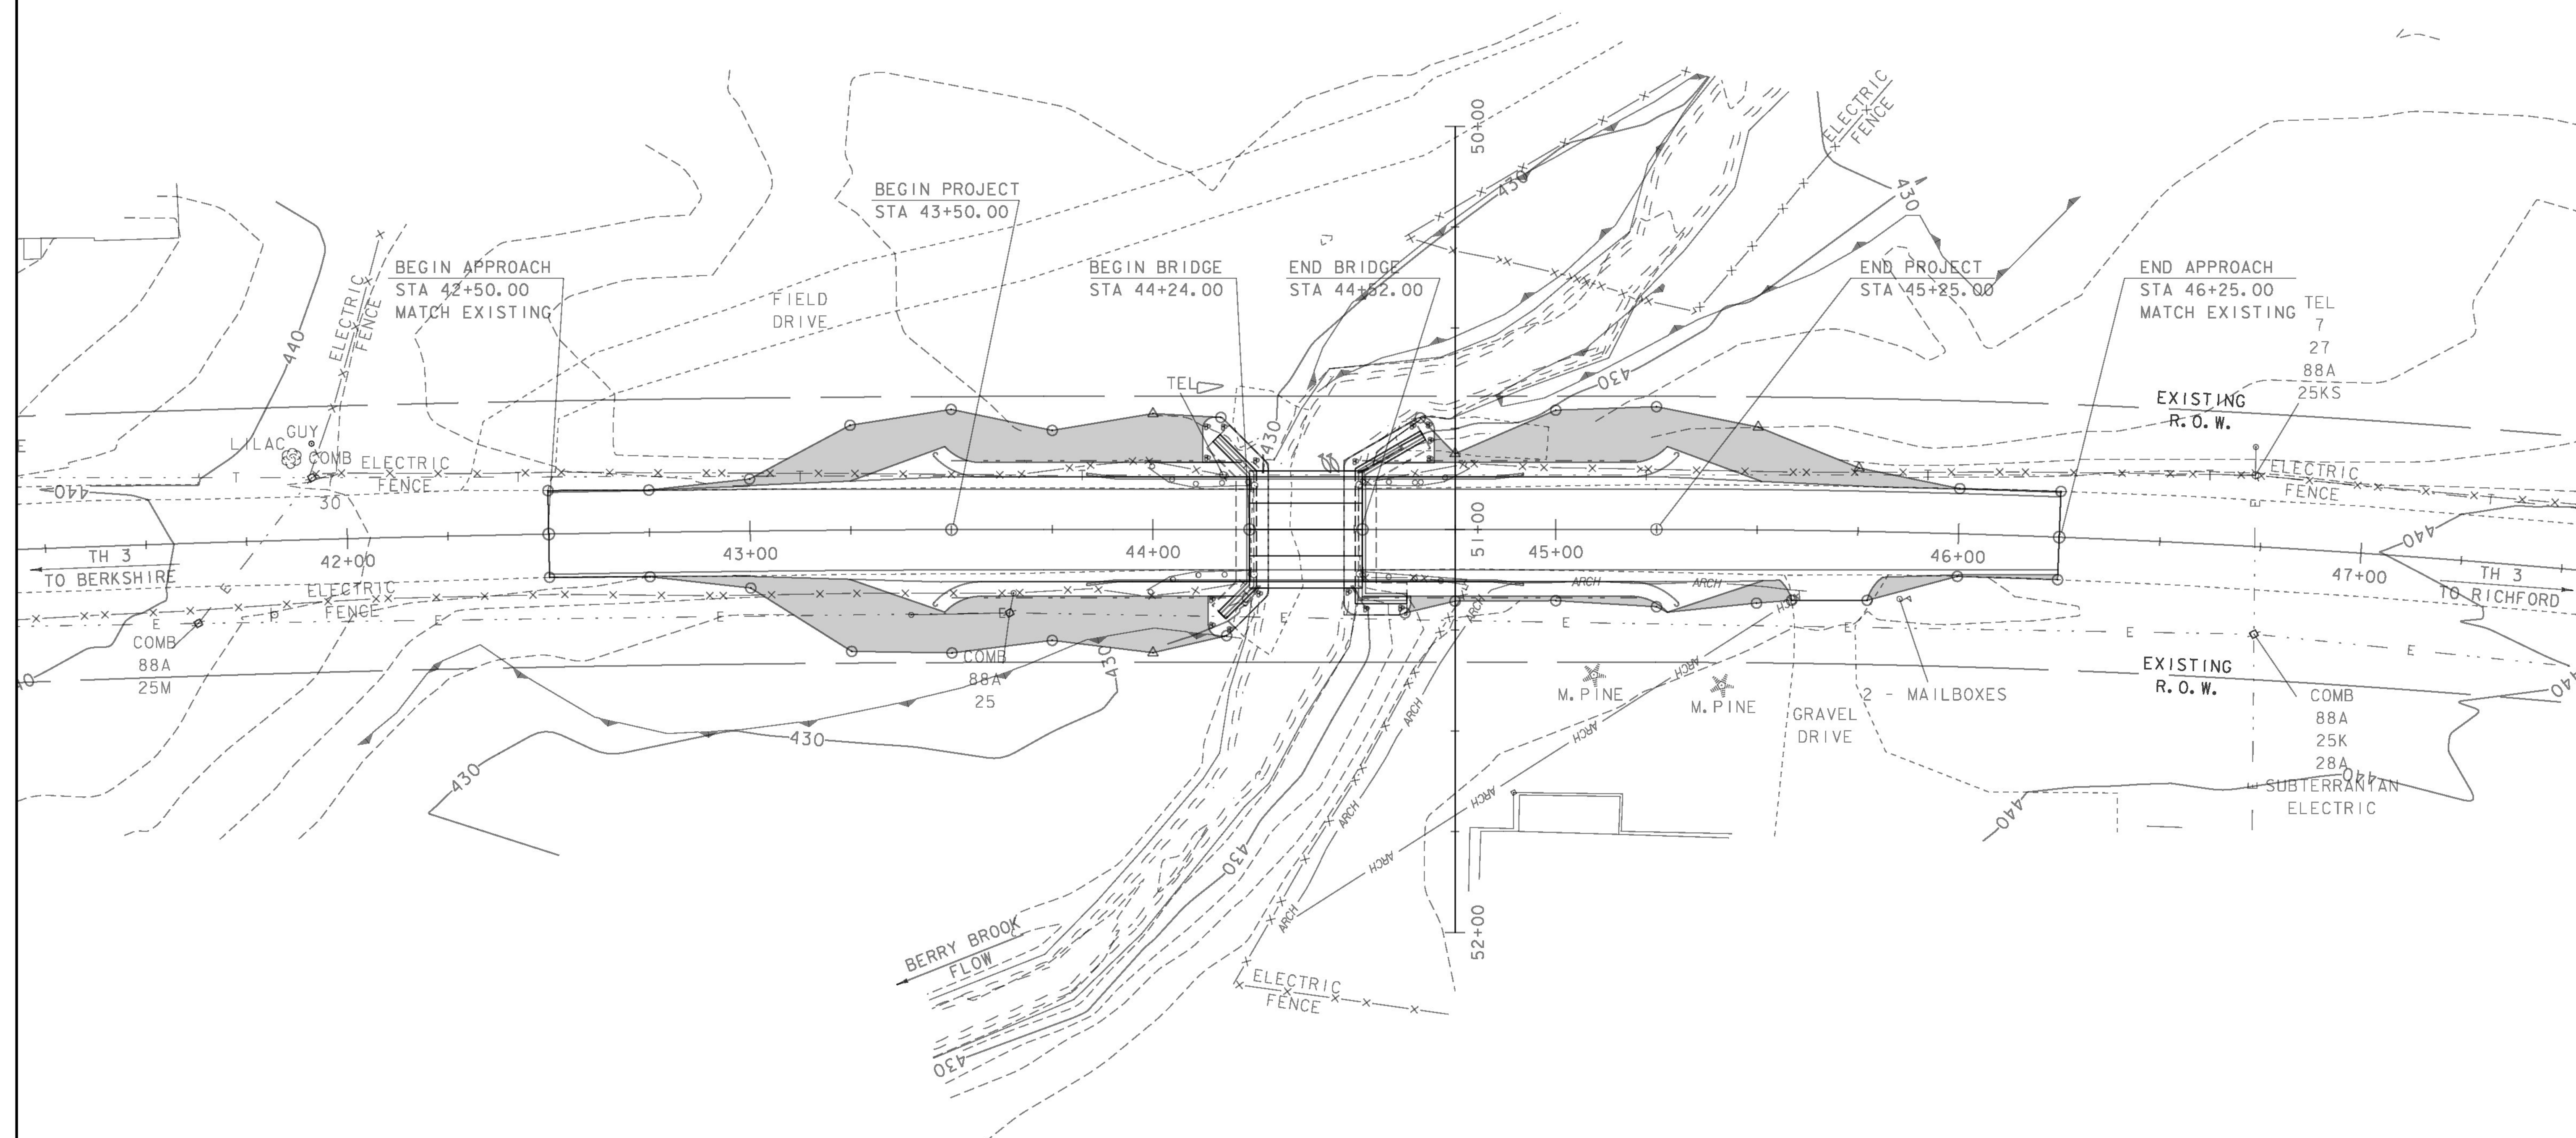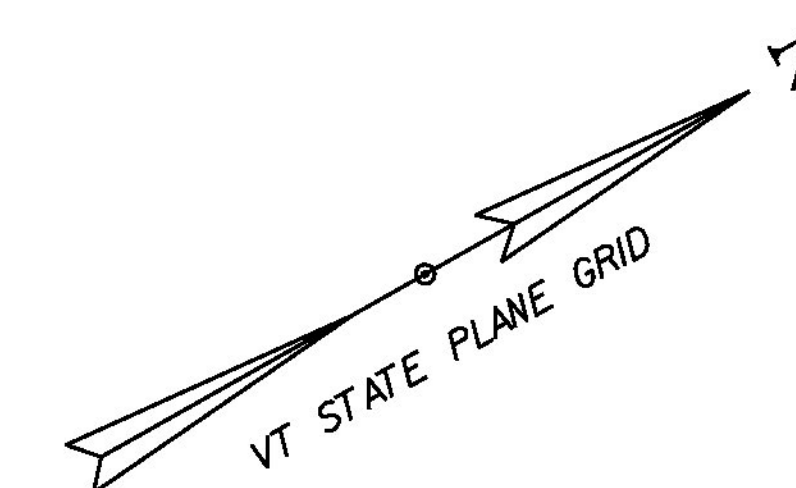


NOTE: SEE SHEET 8 FOR SYMBOLOGY LEGEND

PROJECT NAME: RICHFORD  
PROJECT NUMBER: BRF 0302(29)


FILE NAME: sl2j158bdrero.dgn	PLOT DATE: 11-DEC-2014
PROJECT LEADER: C. CARLSON	DRAWN BY: R. PELLETT
DESIGNED BY: H. SALLS	CHECKED BY: H. SALLS
EPSC FINAL CONDITIONS	SHEET 34 OF 36

SCALE 1" = 20'-0"  
20 0 20



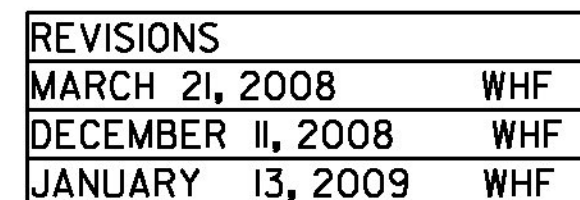



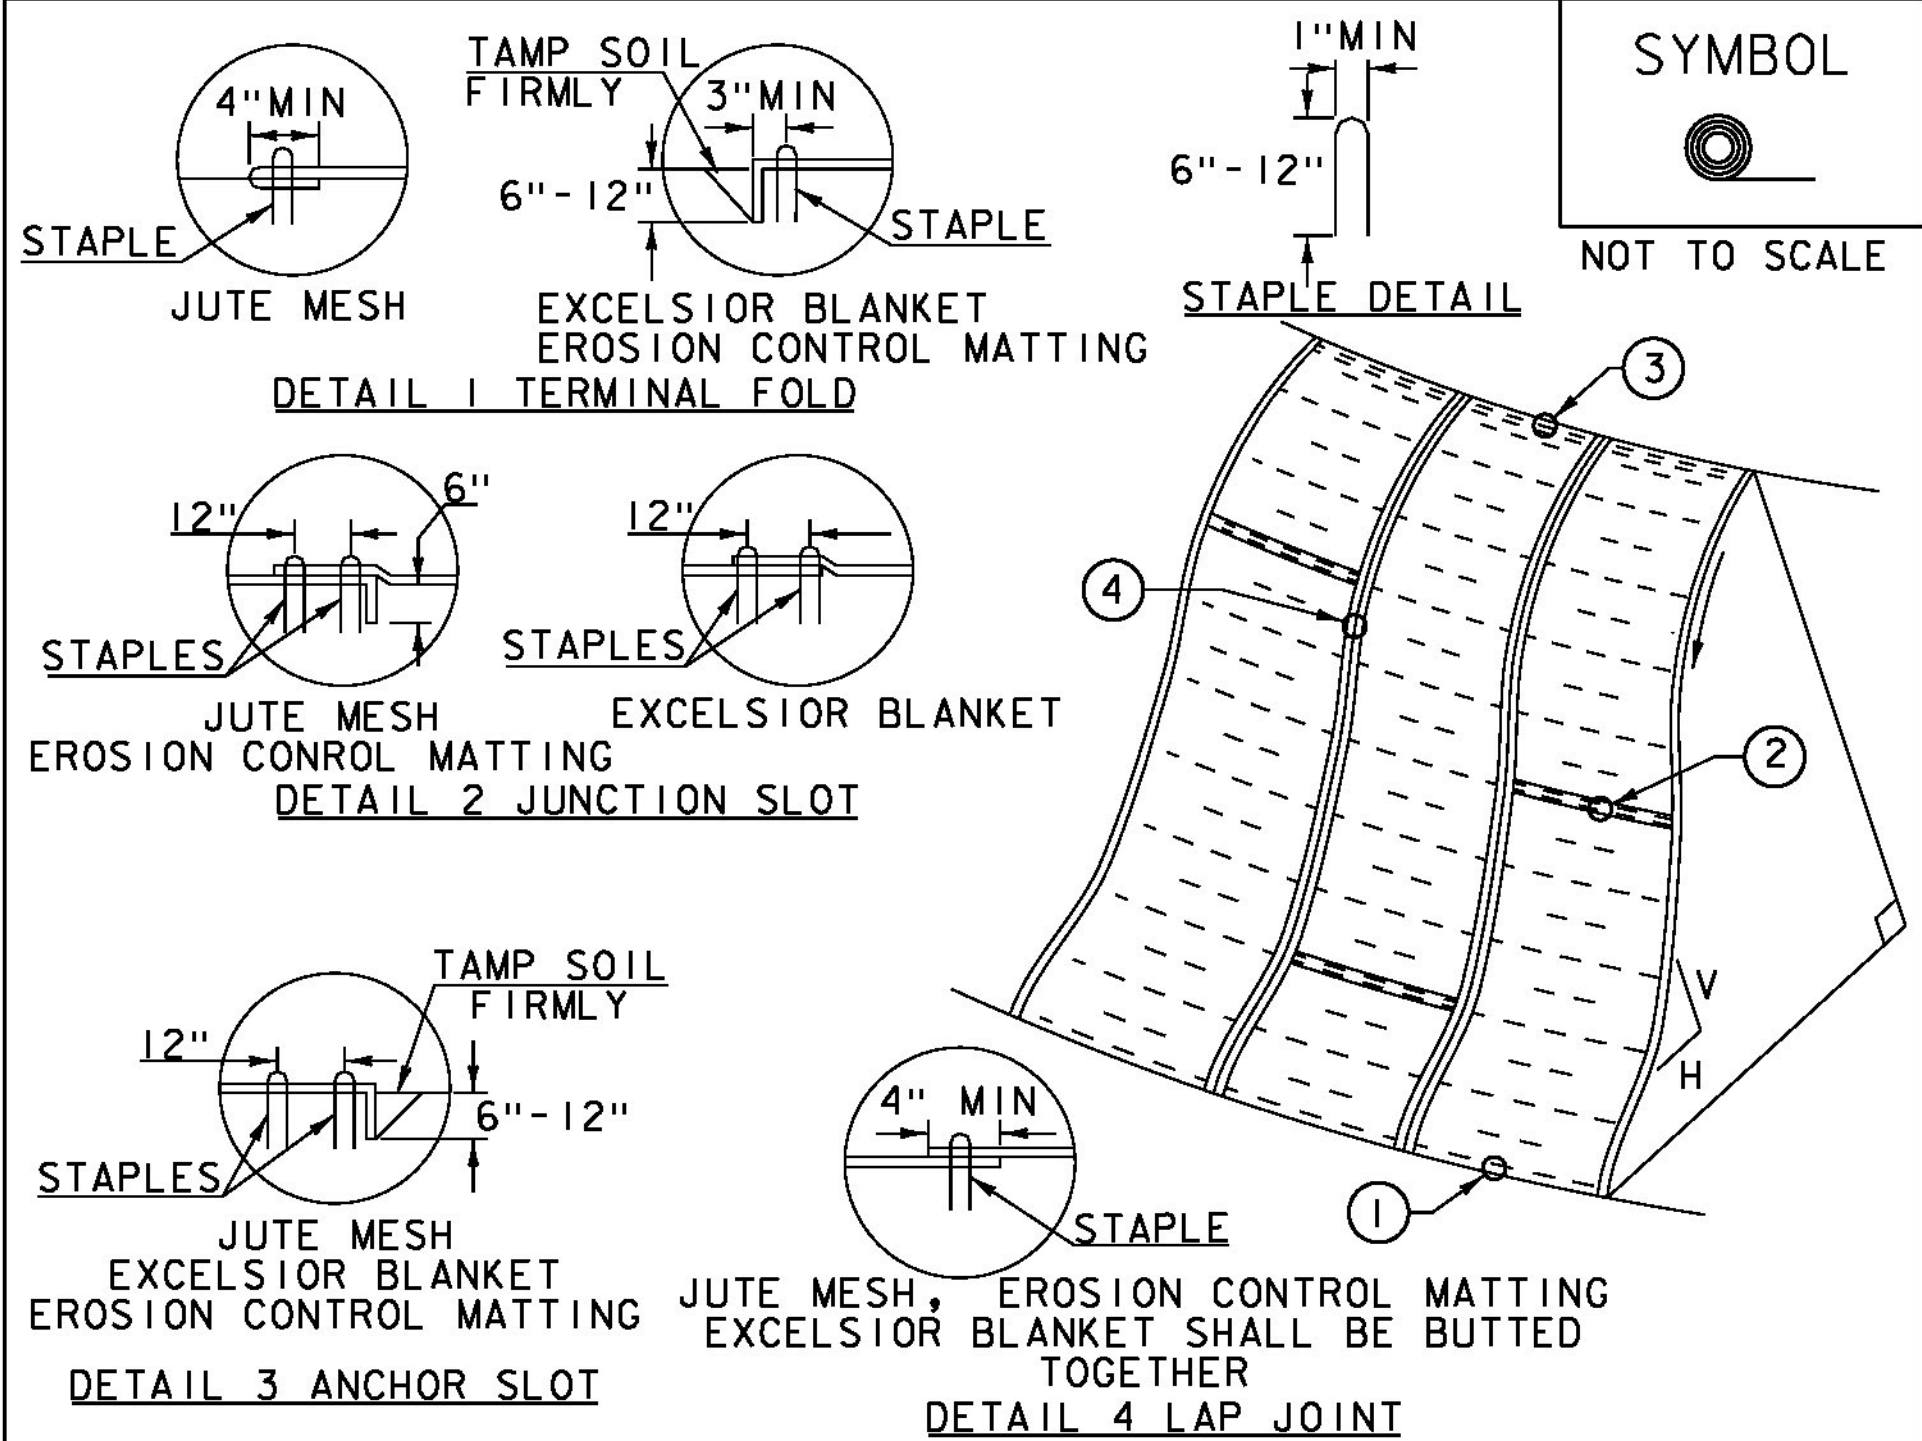


- CONSTRUCTION SPECIFICATIONS**
1. APPLY TO SLOPES GREATER THAN 3H: IV OR WHERE NECESSARY TO AID IN ESTABLISHING VEGETATION.
  2. APPLY FERTILIZER, LIME SEED PRIOR TO PLACING MATTING.
  3. STAPLES ARE TO BE PLACED ALTERNATELY, IN COLUMNS APPROXIMATELY 2' APART AND IN ROWS APPROXIMATELY 3' APART. APPROXIMATELY 175 STAPLES ARE REQUIRED PER 4'X225' ROLL OF MATERIAL AND 125 STAPLES ARE REQUIRED PER 4'X150' ROLL OF MATERIAL.
  4. DISTURBED AREAS SHALL BE SMOOTHLY GRADED. EROSION CONTROL MATERIAL SHALL BE PLACED LOOSELY OVER GROUND SURFACE. DO NOT STRETCH.
  5. ALL TERMINAL ENDS AND TRANSVERSE LAPS SHALL BE STAPLED AT APPROXIMATELY 12" INTERVALS.

ADAPTED FROM DETAILS PROVIDED BY: NEW YORK STATE DEC  
ORIGINALLY DEVELOPED BY USDA-NRCS  
VERMONT DEPARTMENT OF ENVIRONMENTAL CONSERVATION

ROLLED EROSION  
CONTROL PRODUCT  
(RECP) SIDE SLOPE

NOTES:  
REFER TO "THE VERMONT STANDARDS & SPECIFICATIONS FOR  
EROSION PREVENTION & SEDIMENT CONTROL -2006- "FROM  
THE VT AGENCY OF NATURAL RESOURCES FOR ADDITIONAL  
GUIDANCE.  
THIS WORK SHALL BE PERFORMED IN ACCORDANCE WITH SECTION  
653 AND AS SHOWN IN THE PLANS FOR TEMPORARY EROSION  
MATTING (PAY ITEM 653.20) OR PERMANENT EROSION MATTING  
(PAY ITEM 653.21).

REVISIONS  
APRIL 16, 2007 JMF  
JANUARY 13, 2009 WHF

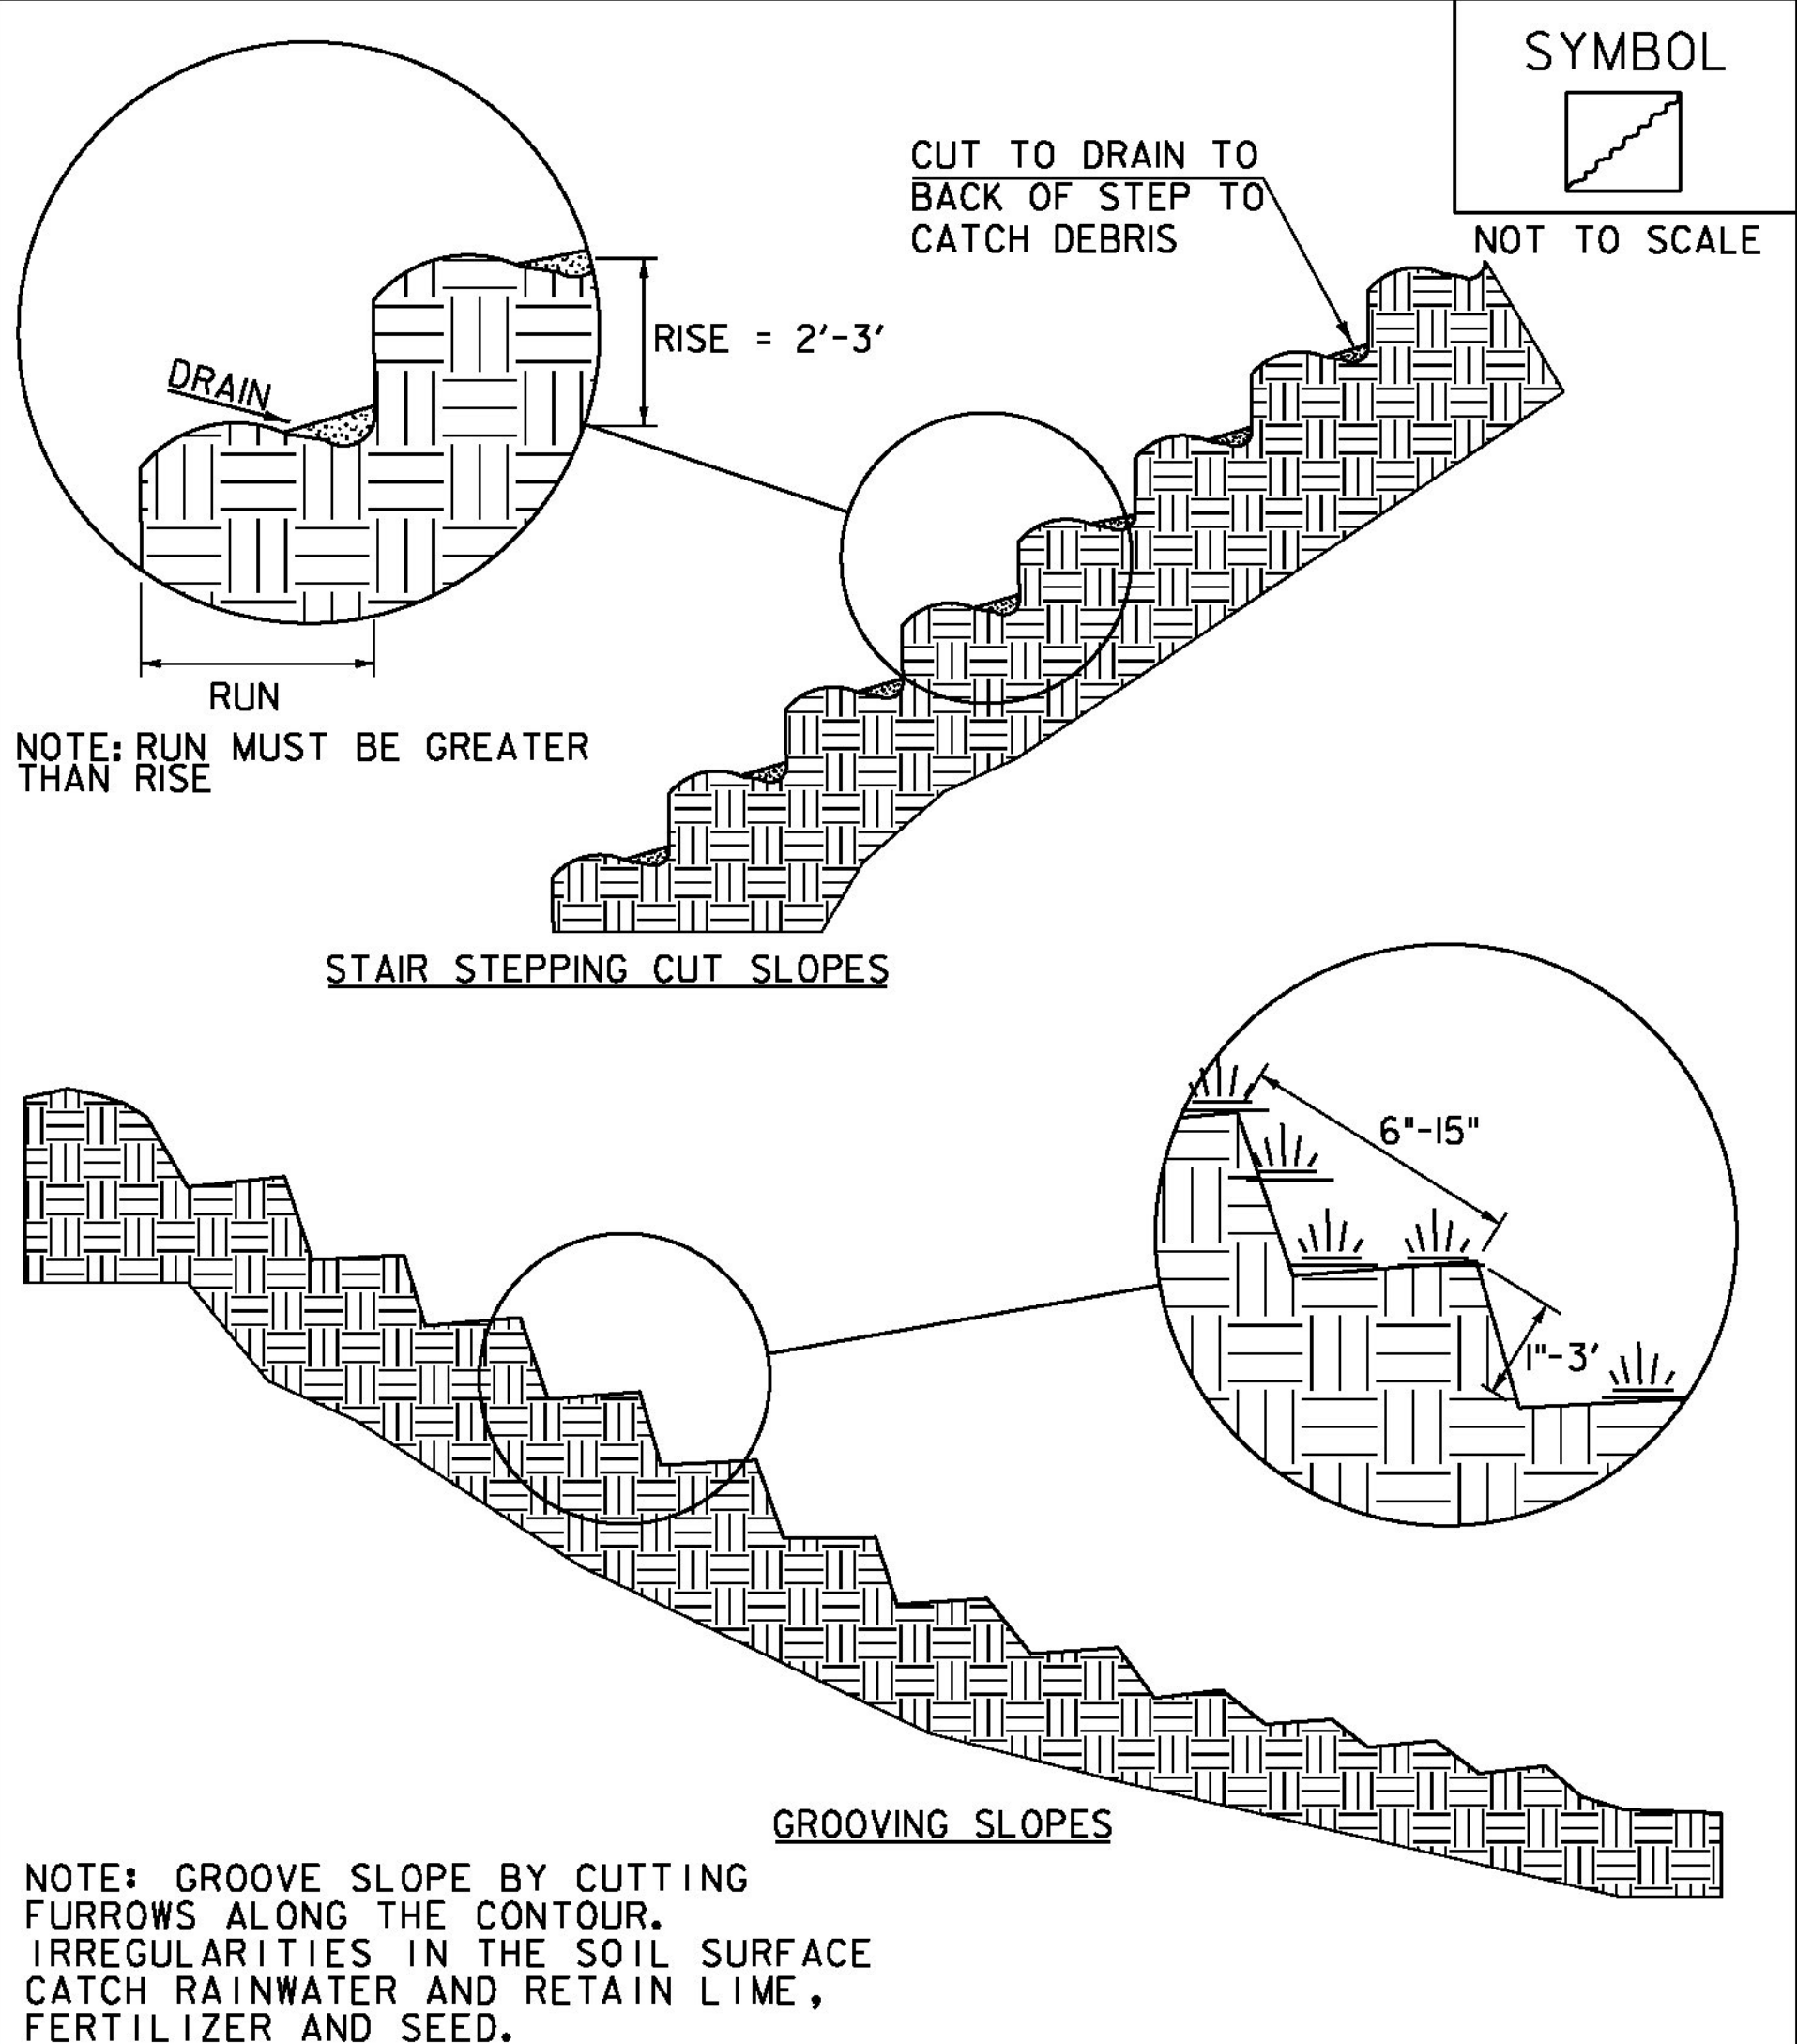

ADAPTED FROM DETAILS PROVIDED BY: NEW YORK STATE DEC  
ORIGINALLY DEVELOPED BY USDA-NRCS  
VERMONT DEPARTMENT OF ENVIRONMENTAL CONSERVATION

SURFACE ROUGHENING

NOTES:  
REFER TO "THE VERMONT STANDARDS & SPECIFICATIONS FOR  
EROSION PREVENTION & SEDIMENT CONTROL -2006- "FROM  
THE VT AGENCY OF NATURAL RESOURCES FOR ADDITIONAL  
GUIDANCE.  
THIS WORK SHALL BE CONSIDERED INCIDENTAL TO THE  
CONTRACT

REVISIONS  
APRIL 1, 2008 WHF  
JANUARY 13, 2009 WHF

VAOT RURAL AREA MIX					
		LBS/AC			
% WEIGHT	BROADCAST	HYDROSEED	NAME	GERM %	PURITY %
37.5%	22.5	45	CREeping RED FESCUE	85%	98%
37.5%	22.5	45	TALL FESCUE	90%	95%
5.0%	3	6	RED TOP	90%	95%
15.0%	9	18	BIRDSFOOT TREFOIL	85%	98%
5.0%	3	6	ANNUAL RYE GRASS	85%	95%
100%	60	120			

VAOT URBAN AREA MIX					
		LBS/AC			
% WEIGHT	BROADCAST	HYDROSEED	NAME	GERM %	PURITY %
42.5%	34	68	CREeping RED FESCUE	85%	98%
10.0%	8	16	PERENNIAL RYE GRASS	90%	95%
42.5%	34	68	KENTUCKY BLUE GRASS	85%	85%
5.0%	4	8	ANNUAL RYE GRASS	85%	95%
100%	80	160			

SOIL AMENDMENT GUIDANCE			
FERTILIZER		LIME	
BROADCAST	HYDROSEED	BROADCAST	HYDROSEED
10-20-10	FOLLOW	PELLETIZED	FOLLOW
500 LBS/AC	MANUFACTURER	2 TONS/AC	MANUFACTURER

- CONSTRUCTION GUIDANCE**
1. RURAL SEED MIX: USE AS INDICATED IN THE PLANS AND/OR FOR ALL ESTABLISHED UPLAND (NON WETLAND) AREAS DISTURBED BY THE CONTRACTOR.
  2. URBAN SEED MIX: USE AS INDICATED IN THE PLANS AND/OR FOR ALL ESTABLISHED LAWN AREAS DISTURBED BY THE CONTRACTOR.
  3. ALL SEED MIXTURES: SHALL NOT HAVE A WEED CONTENT EXCEEDING 0.40% BY WEIGHT AND SHALL BE FREE OF ALL NOXIOUS SEED.
  4. FERTILIZER AND LIMESTONE: SHALL FOLLOW RATES SHOWN ON PLAN OR AS DIRECTED BY THE ENGINEER
  5. HAY MULCH: TO BE PLACED ON EARTH SLOPES AT THE RATE OF 2 TONS/ACRE, ACHIEVE 90% GROUND COVER OR AS DIRECTED BY THE ENGINEER.
  6. TOPSOIL: TO BE USED WITH SEED AS INDICATED ON THE PLANS, OR AS DIRECTED BY THE ENGINEER.
  7. HYDROSEEDING: ALTHOUGH GUIDANCE IS GIVEN ABOVE THE SITE CONDITIONS AND THE TYPE OF HYDROSEED WILL ULTIMATELY DICTATE THE AMOUNTS AND TYPES OF SOIL AMENDMENTS TO BE APPLIED
  8. TURF ESTABLISHMENT: PLACING SEED, FERTILIZER, LIME AND MULCH PRIOR TO SEPTEMBER 15 AND AFTER APRIL 15 CAN BETTER ENSURE A VIGOROUS GROWTH OF GRASS.

ADAPTED FROM VTRANS TECHNICAL LANDSCAPE MANUAL FOR  
ROADWAYS AND TRANSPORTATION FACILITIES

TURF ESTABLISHMENT


THIS WORK SHALL BE PERFORMED IN ACCORDANCE  
WITH SECTION 651 FOR SEED (PAY ITEM 651.15)

REVISIONS  
JUNE 23, 2009 WHF  
JANUARY 15, 2010 WHF  
FEBRUARY 16, 2011 WHF




CONCRETE GENERAL NOTES

- 1. ALL EXPOSED EDGES OF CONCRETE SHALL BE CHAMFERED 1" x 1"
- 2. REINFORCING STEEL SIZE AND SPACING SHOWN IN THE PLANS IS BASED ON 60 KSI STEEL, UNLESS NOTED OTHERWISE. WITH THE ENGINEER'S PERMISSION, BAR SIZE AND SPACING MAY BE MODIFIED ACCORDING TO THE LATEST AASHTO LRFD BRIDGE DESIGN SPECIFICATION AND STRUCTURES DESIGN MANUAL WHEN USING HIGHER STRENGTH STEEL.

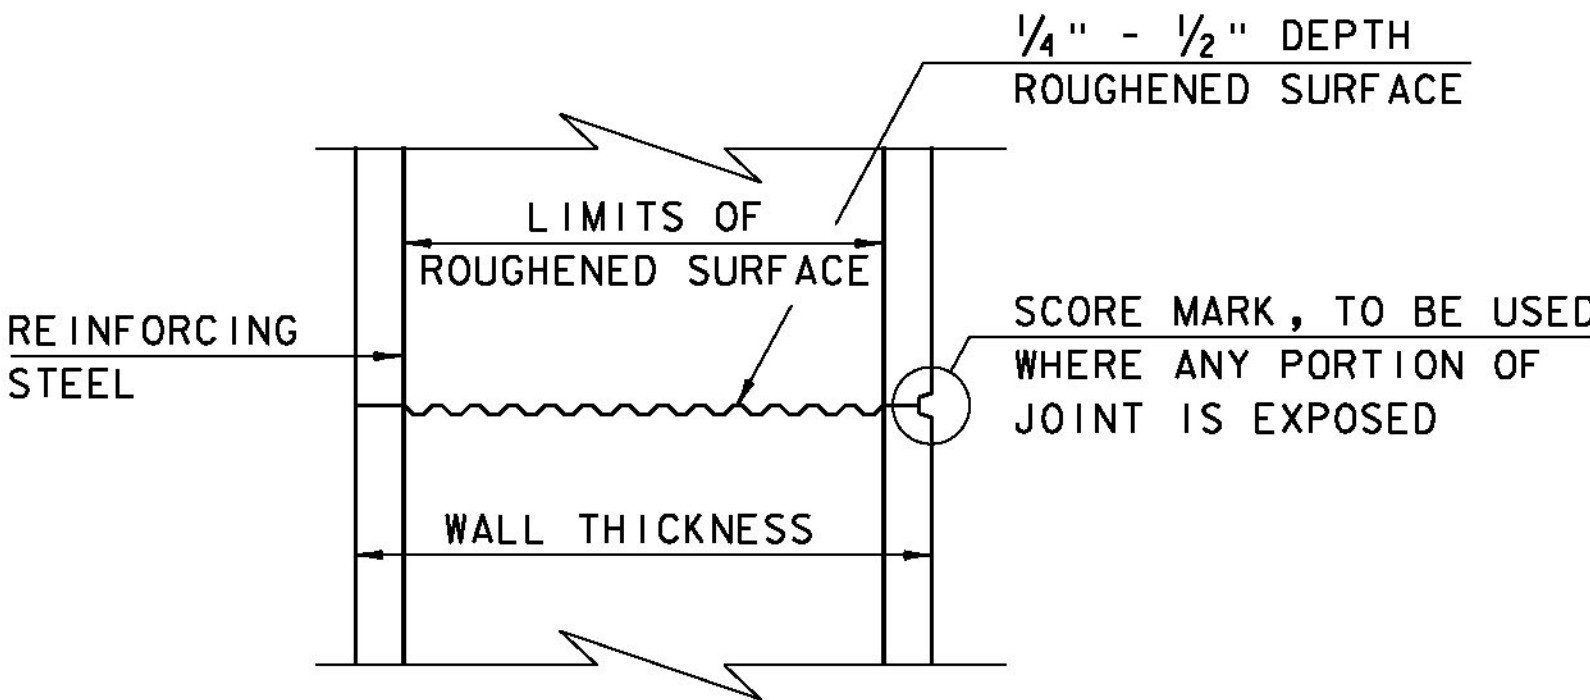


TYPICAL HORIZONTAL CONSTRUCTION JOINT  
(NOT TO SCALE)


- 1. THE SURFACE OF THE CONCRETE CONSTRUCTION JOINTS SHALL BE CLEANED AND FREE OF LAITANCE.
- 2. IMMEDIATELY BEFORE NEW CONCRETE IS PLACED, ALL CONSTRUCTION JOINTS SHALL BE WETTED AND STANDING WATER REMOVED.

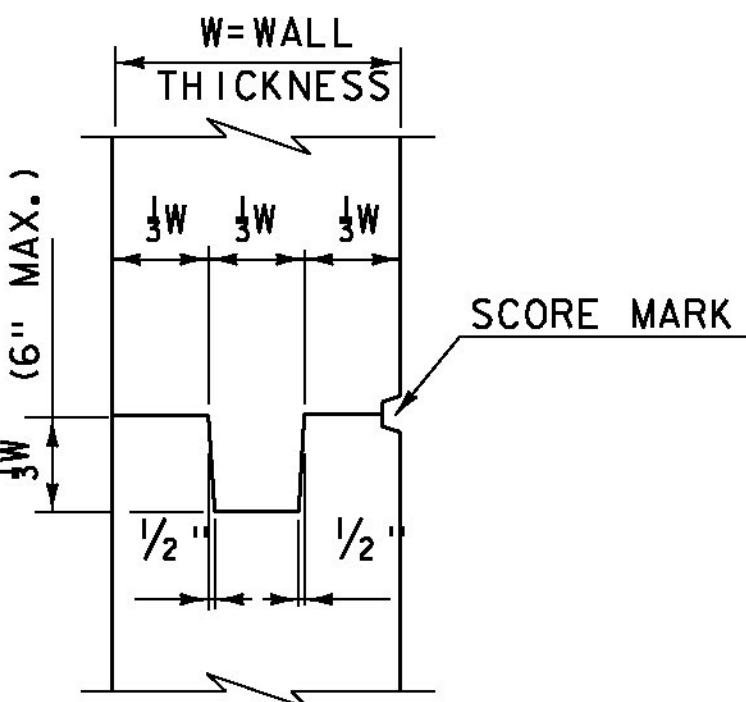


TYPICAL CONCRETE CONSTRUCTION JOINT  
(NOT TO SCALE)

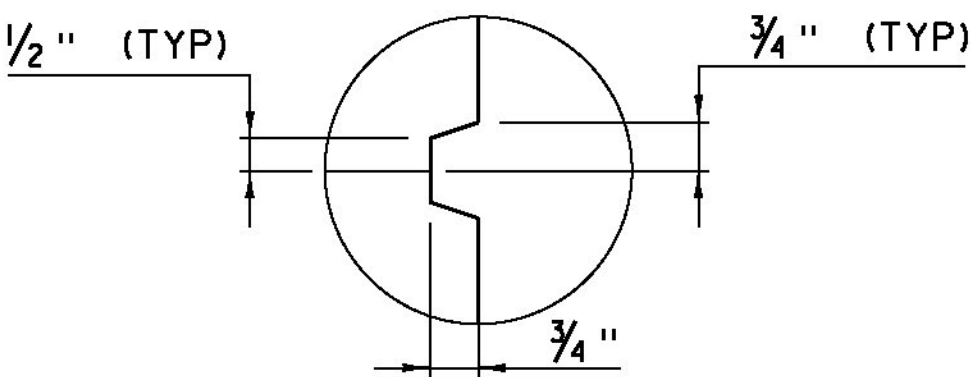


SCORE MARK DETAIL  
(NOT TO SCALE)

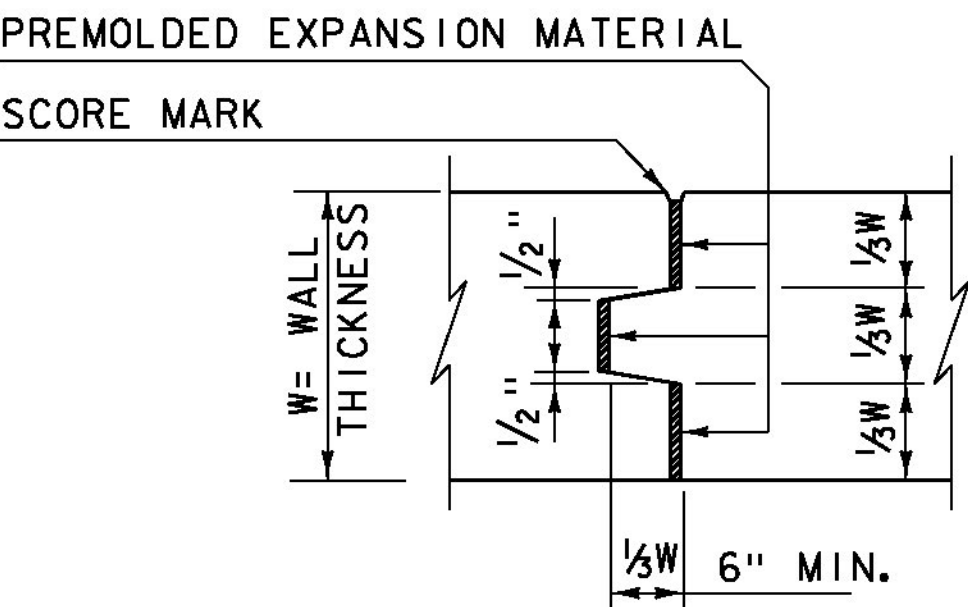

TYPICAL CONCRETE EXPANSION JOINT  
(NOT TO SCALE)

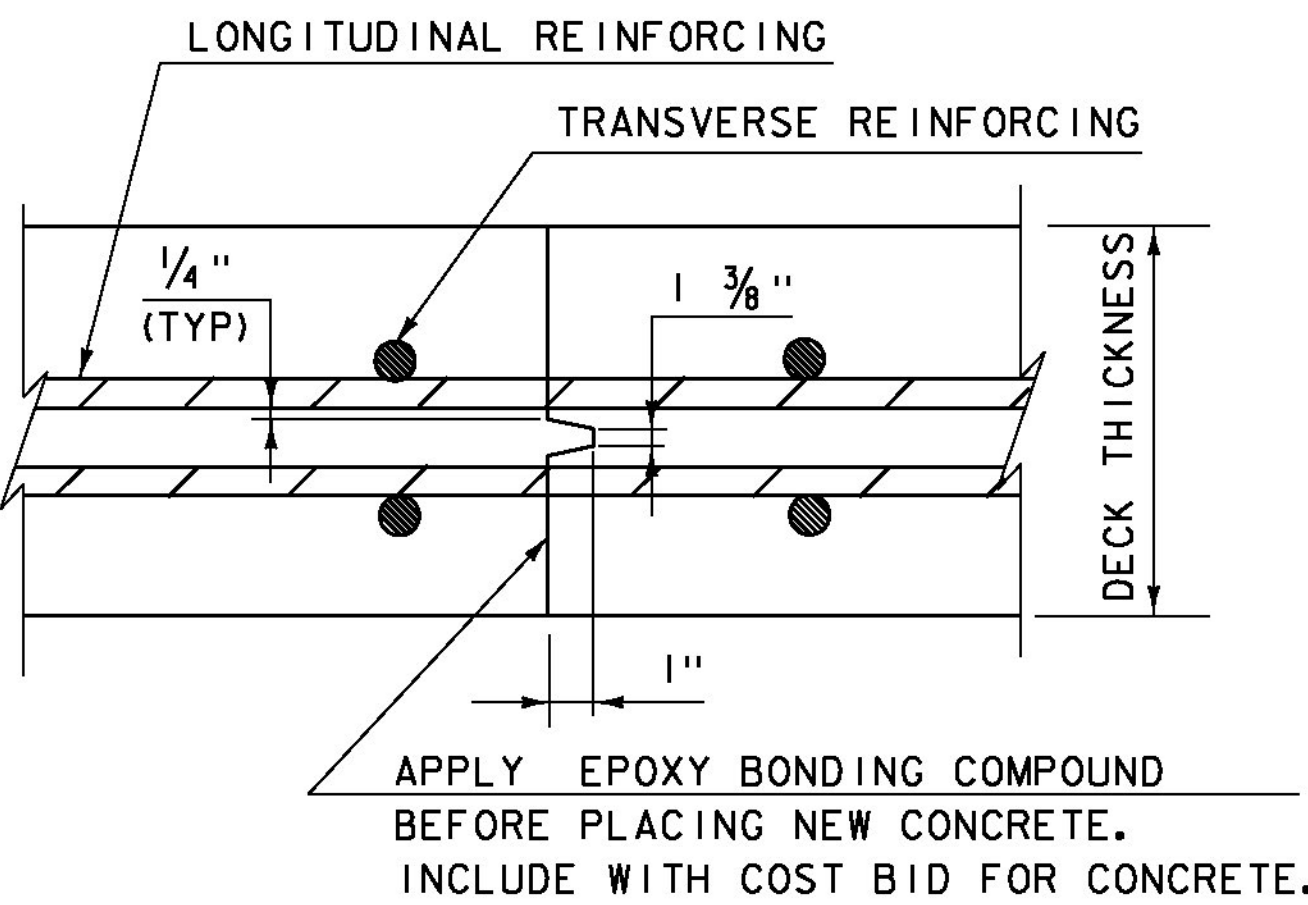


TRANSVERSE BRIDGE SLAB  
CONSTRUCTION JOINT DETAILS  
(NOT TO SCALE)

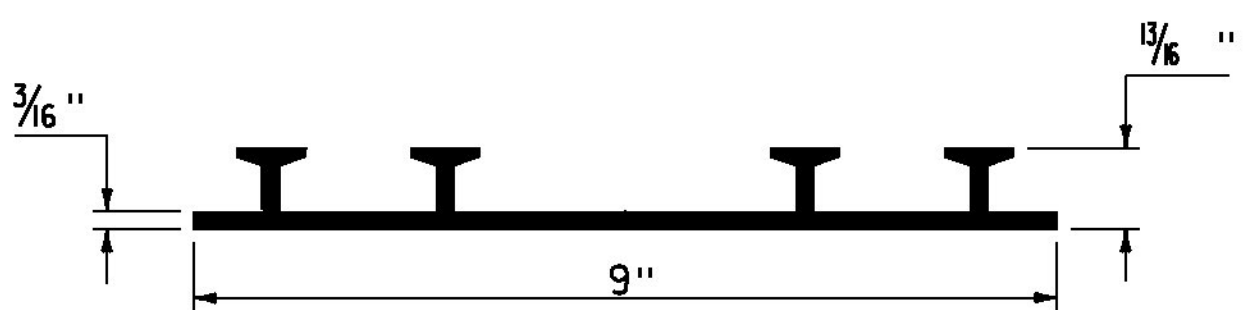

P.V.C. WATERSTOP FOR  
CONSTRUCTION JOINTS  
(NOT TO SCALE)

PAYMENT FOR THE P.V.C. WATERSTOP SHALL BE INCIDENTAL TO THE UNIT BID PRICE FOR THE ADJACENT CONCRETE.


OTHER CONFIGURATIONS OF WATERSTOP MAY BE USED UPON APPROVAL OF THE ENGINEER.

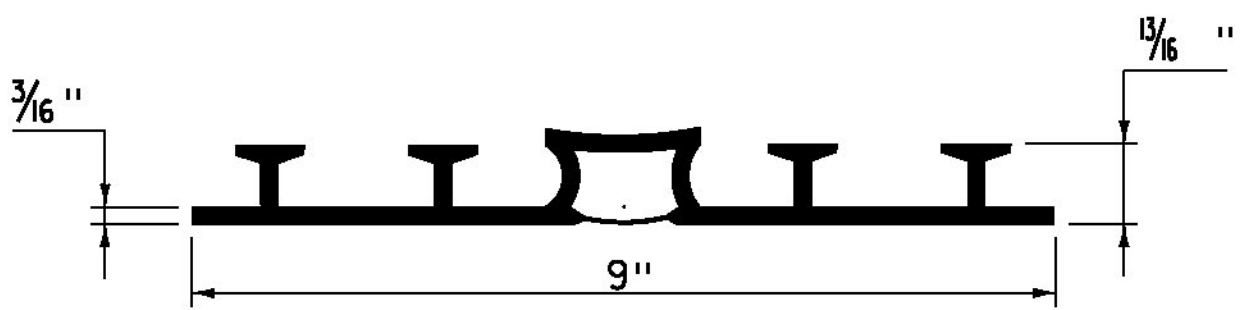

P.V.C. WATERSTOP FOR  
EXPANSION JOINTS  
(NOT TO SCALE)

PAYMENT FOR THE P.V.C. WATERSTOP SHALL BE INCIDENTAL TO THE UNIT BID PRICE FOR THE ADJACENT CONCRETE.


OTHER CONFIGURATIONS OF WATERSTOP MAY BE USED UPON APPROVAL OF THE ENGINEER.

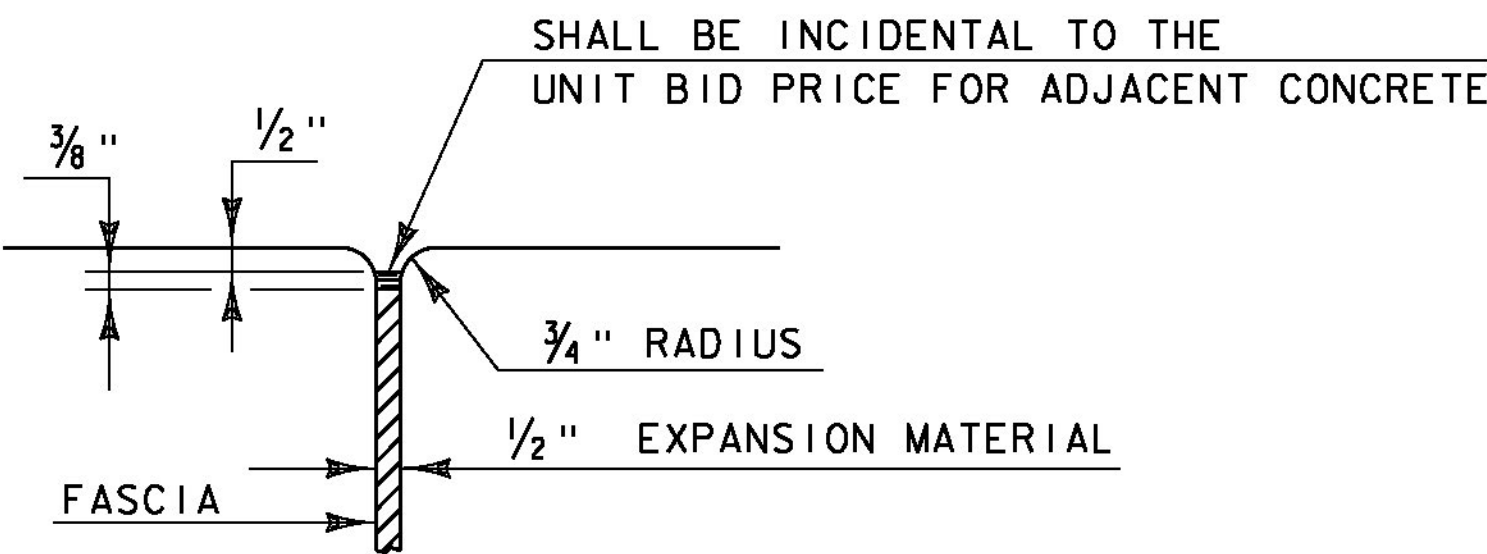

JOINT BETWEEN FASCIA  
AND WINGWALL  
(NOT TO SCALE)


REVISIONS	
MAY 7, 2010	APPROVED FOR USE BY VAO T STRUCTURES SECTION
FEBRUARY 9, 2012	REBAR SUBSTITUTION ALLOWANCE ADDED TO CONCRETE GENERAL NOTES.

CONCRETE  
DETAILS AND NOTES

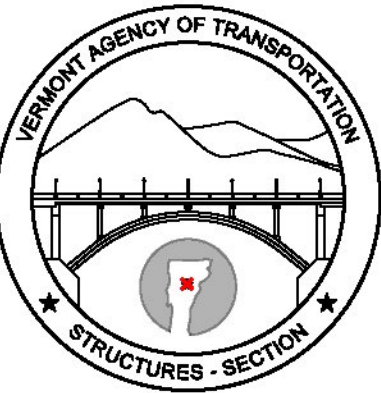


STRUCTURES  
DETAIL  
SD-501.00



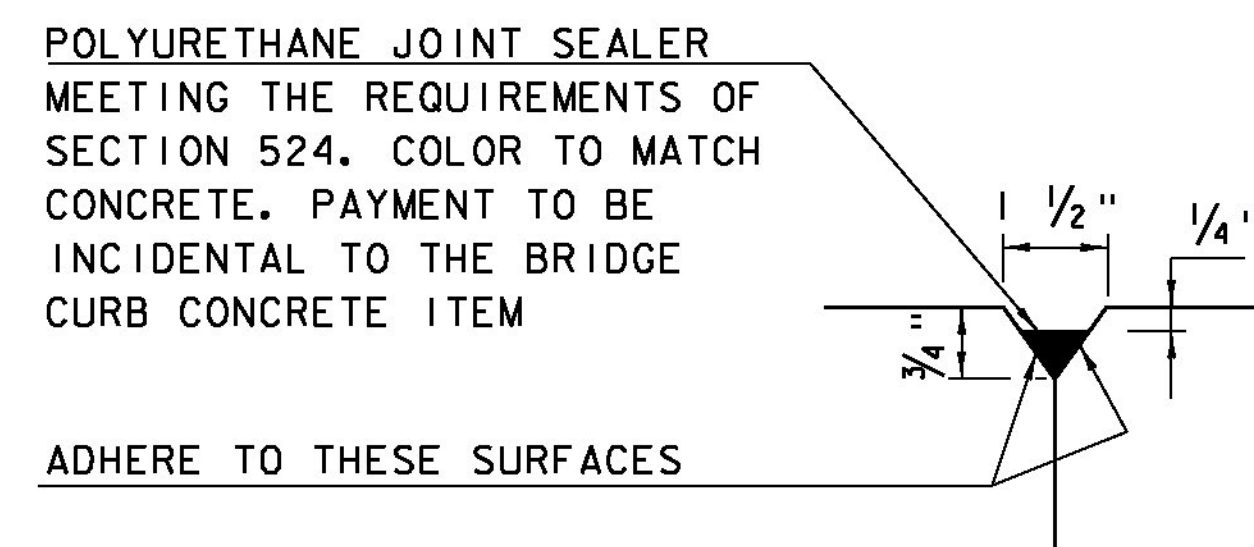

DETAIL "B"  
(NOT TO SCALE)

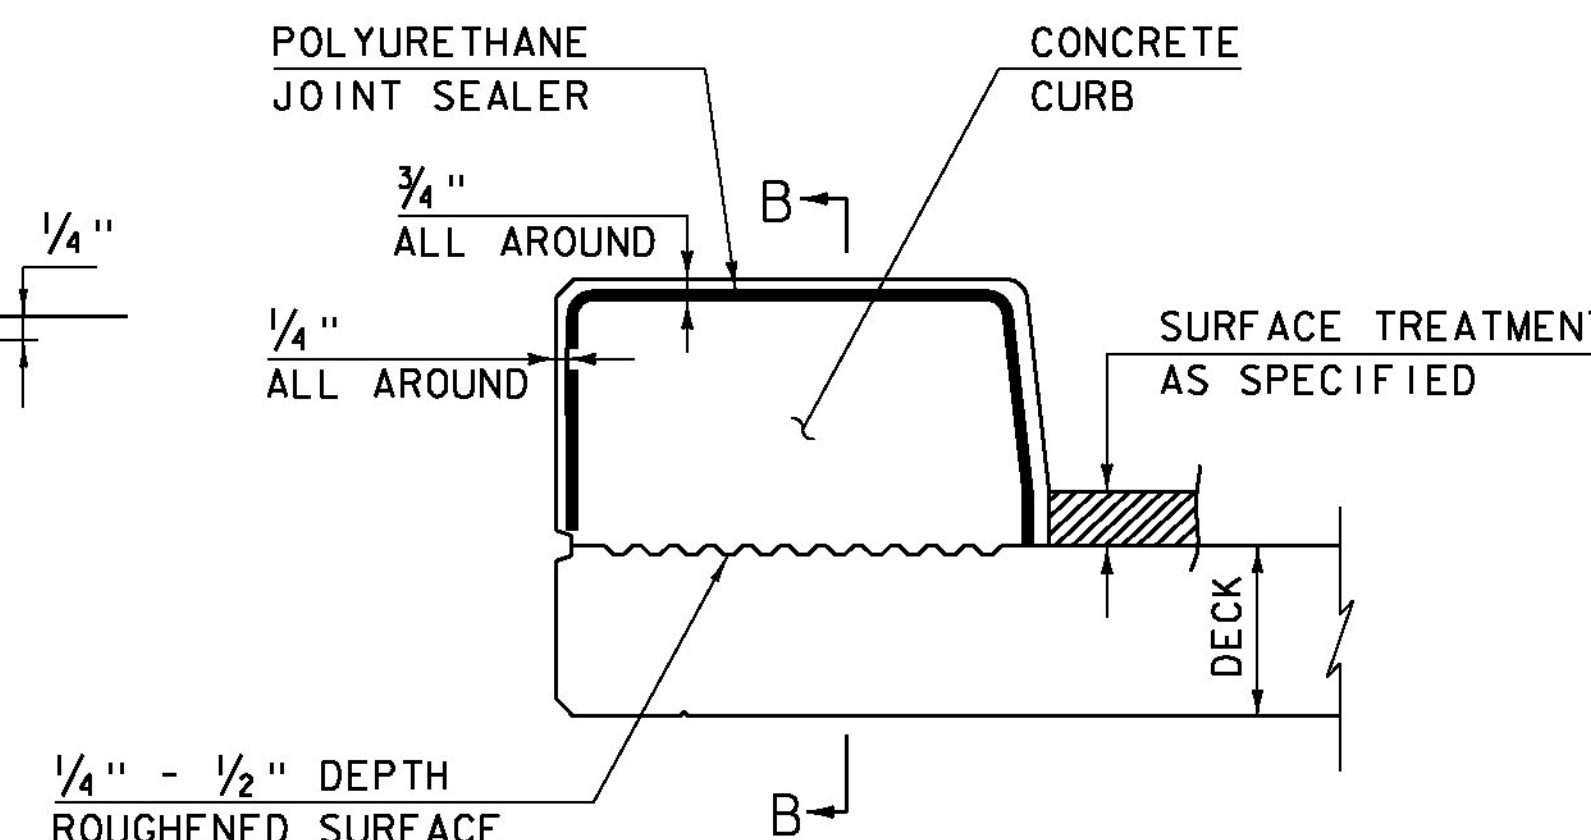


CONCRETE CURB JOINT SECTION  
(NOT TO SCALE)


1. SEE TYPICAL HORIZONTAL CONSTRUCTION JOINT DETAIL FOR ADDITIONAL INFORMATION

### CONCRETE CURB JOINT NOTES



1. CONCRETE CURBS MAY BE PLACED IN ONE CONTINUOUS OPERATION IF AN APPROVED SHRINKAGE REDUCING ADMIXTURE LISTED IN THE SPECIAL PROVISIONS IS USED WITH THE CONCRETE MIX DESIGN. PAYMENT FOR THE SHRINKAGE REDUCING ADMIXTURE WILL BE INCIDENTAL TO THE BRIDGE CURB CONCRETE ITEM.
2. IF THE CONTRACTOR CHOOSES NOT TO USE AN APPROVED SHRINKAGE REDUCING ADMIXTURE, THE CURBS SHALL BE CONSTRUCTED WITH CONSTRUCTION JOINTS SPACED AT A MAXIMUM OF 15'-0" CENTER TO CENTER AND 2'-0" MINIMUM FROM THE CENTER OF NEAREST BRIDGE RAILING POST.
3. ON MULTI-SPAN CONTINUOUS SUPERSTRUCTURES, REGARDLESS OF WHETHER APPROVED SHRINKAGE REDUCING ADMIXTURE IS USED, CURB JOINTS SHALL BE LOCATED OVER THE CENTERLINE OF PIERS AND 7'-0" EACH SIDE OF THE CENTERLINE OF EACH PIER.
4. WHEN CURB JOINTS ARE USED THE CURBS SHALL BE PLACED IN ALTERNATE SECTIONS WITH A MINIMUM OF 48 HOUR DELAY BETWEEN ADJACENT PLACEMENTS.
5. LONGITUDINAL REINFORCING SHALL BE CONTINUOUS THROUGH CURB CONSTRUCTION JOINTS. CURB STIRRUP BARS SHALL BE TURNED AS NECESSARY TO MAINTAIN COVER IN THE FLARED CURB ENDS.
6. THE JOINT SPACING AND DETAILS SHOWN SHALL APPLY TO SIDEWALKS WHEN SHOWN IN THE PLANS.

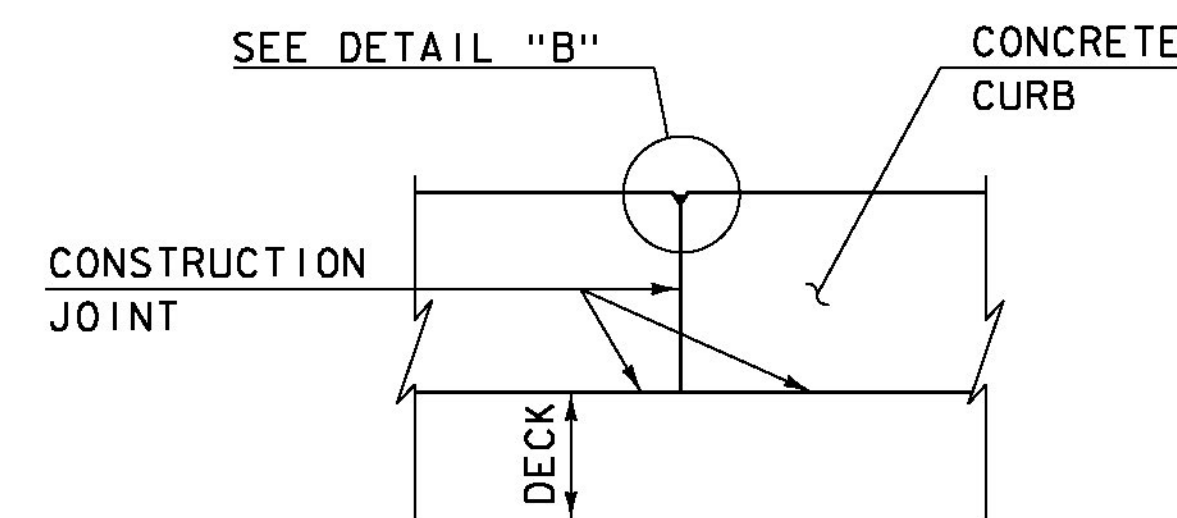

SECTION B - B  
(NOT TO SCALE)

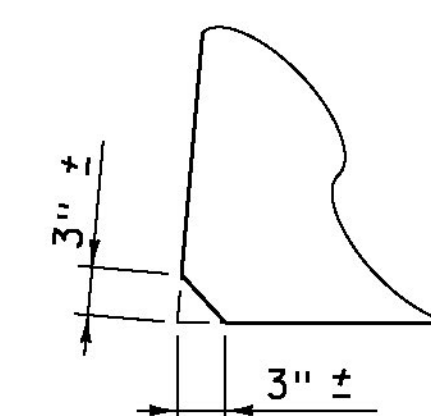


ACUTE ANGLE  
CLIP DETAIL  
(NOT TO SCALE)

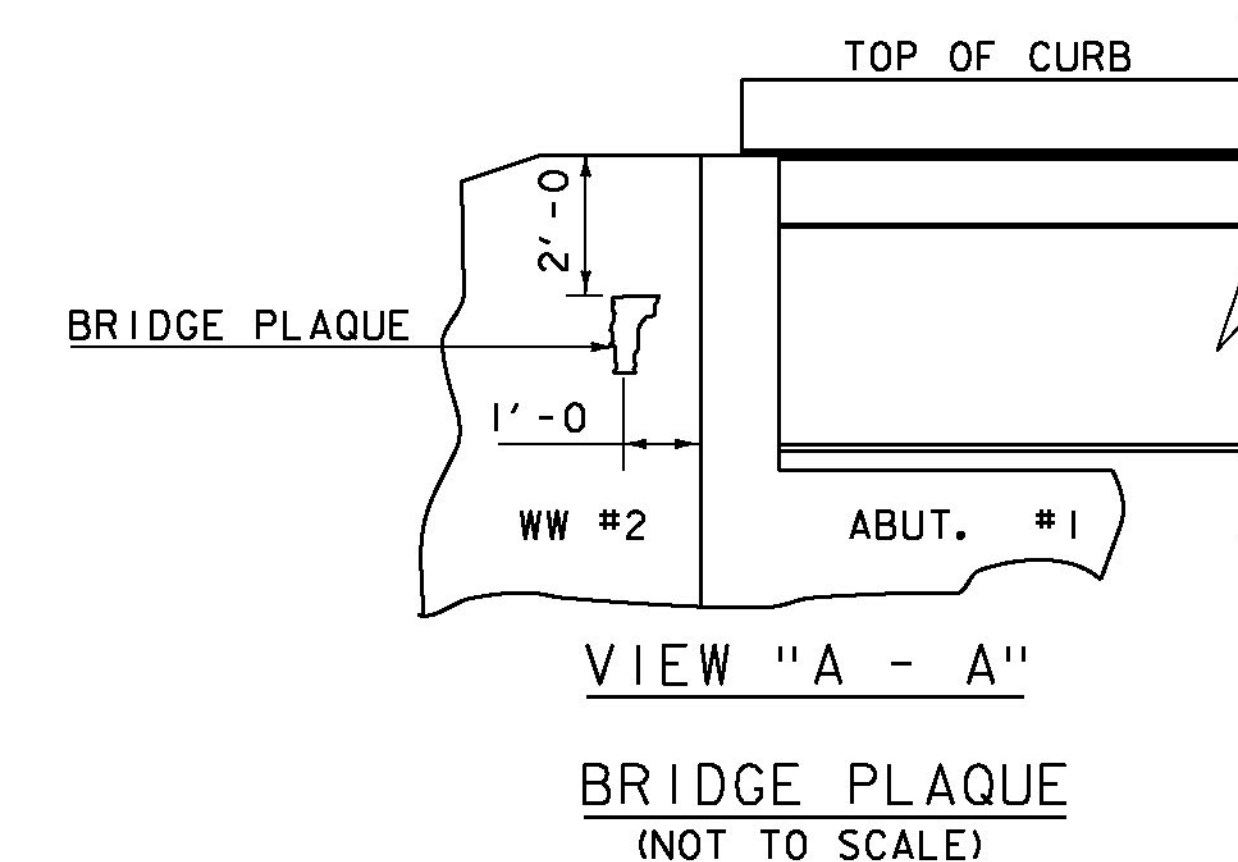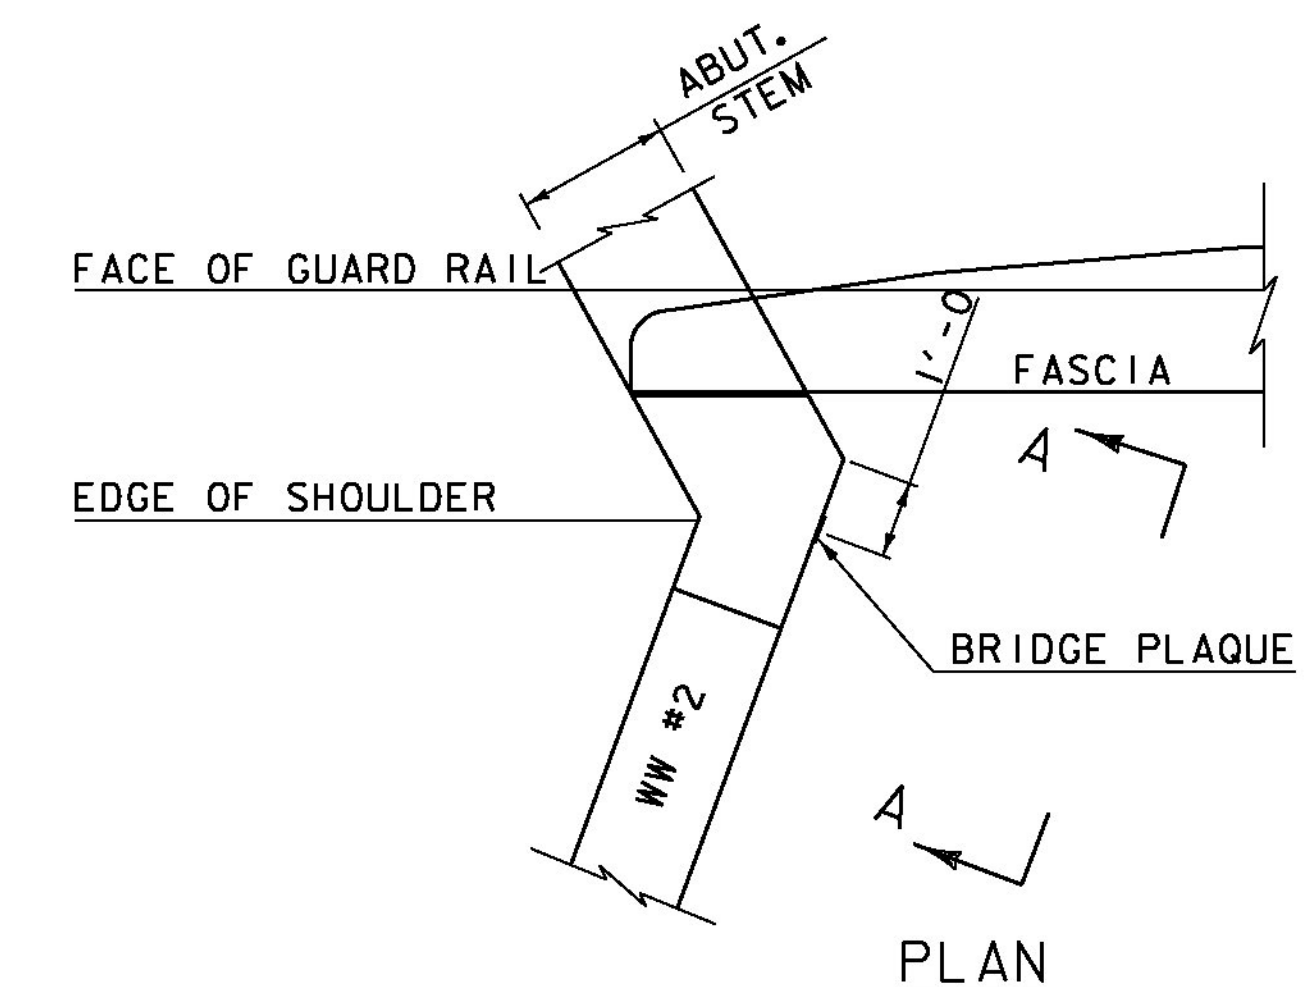


THE BRIDGE PLAQUE WILL BE SUPPLIED BY THE AGENCY OF TRANSPORTATION AND SHALL BE INSTALLED BY THE CONTRACTOR AT ABUTMENT #1 ON THE RIGHT SIDE AS SHOWN OR AS DIRECTED BY THE ENGINEER.

PAYMENT FOR INSTALLATION OF THE BRIDGE PLAQUE SHALL BE INCIDENTAL TO THE ADJACENT CONCRETE.

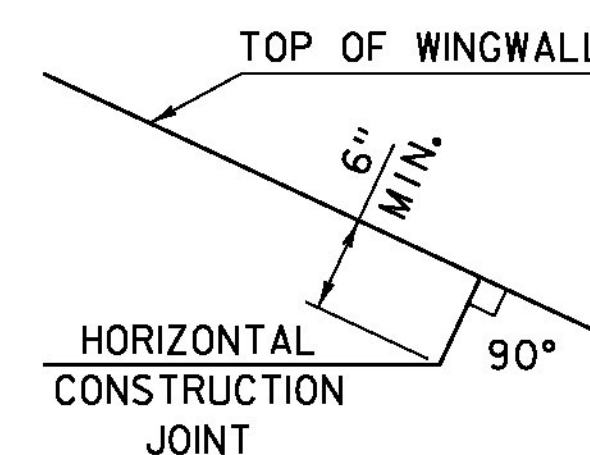


HORIZONTAL WINGWALL  
CONSTRUCTION JOINT  
(NOT TO SCALE)

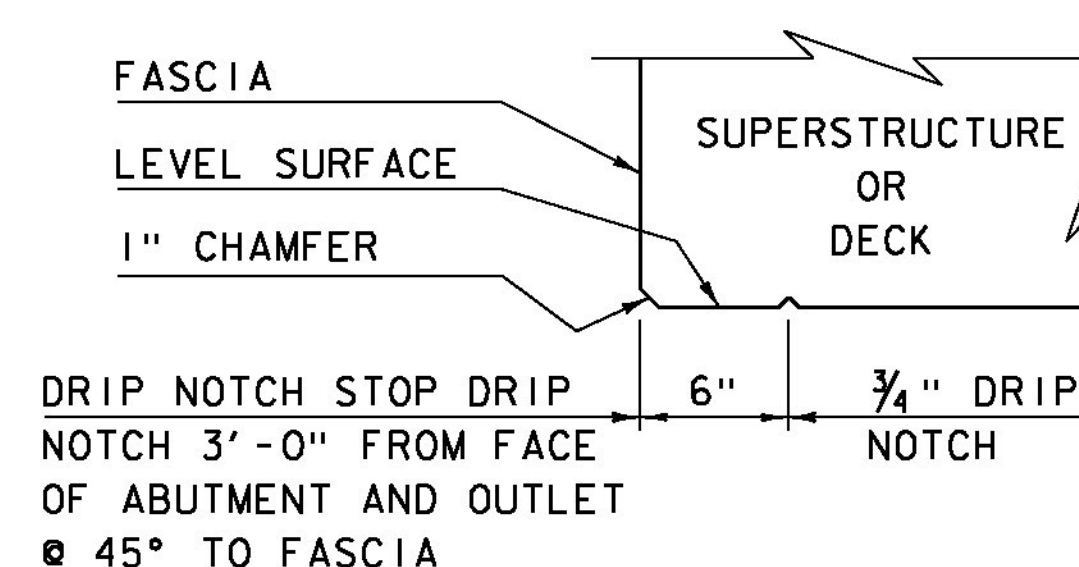

DRIP NOTCH DETAIL  
(NOT TO SCALE)

REVISIONS	
MAY 7, 2010	APPROVED FOR USE BY VAOT STRUCTURES SECTION
JUNE 4, 2010	MODIFIED AND ADDED TWO DETAILS
OCTOBER 10, 2012	MODIFIED HORZ. JOINT WINGWALL ADD 6" MIN. DIMENSION

## CONCRETE DETAILS AND NOTES

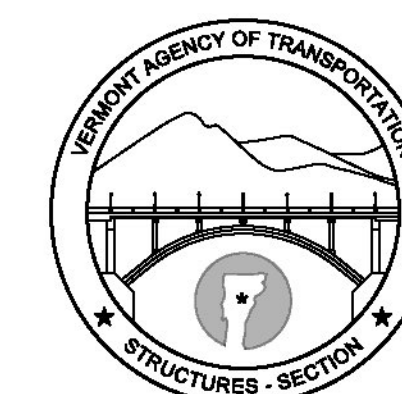

STRUCTURES  
DETAIL  
SD-502.00





C1 Culvert Rebar Schedule				
MK		QTY	LENGTH	
401	#4	16	10'	6"
402	#4	8	27'	0"
403	#4	104	6'	4"
501	#5	2	27'	4"
701	#7	32	18'	0"
702	#7	20	27'	0"

C1 HW Rebar Schedule			
MK		QTY	LENGTH
501	#5	3	27' - 4"
502	#5	43	3' - 2"

Scale: 1/4" = 1'-0"

ALL REINFORCING TO BE Z-BAR  
GR 60 (VTAOT LEVEL 2)  
ALL DOWEL BAR SPLICER & DOWEL-IN  
TO BE EPOXY COATED (A)  
(VTAOT LEVEL 1)

Guardrail Anchor  
Cast in by CSI  
Supplied by others  
(3) MK 501  
MK 502 @ 6" & 12" (A)  
See Headwall Reinforcing Detail  
Top of Culvert  
2"  
(2) MK 501  
#5 DBS/DI @ 6" (A)  
#5 DBS/DI @ 12" (A)  
See Headwall Reinforcing Detail  
Plan View  
2" cl.  
Typ.  
1'-4"  
Precast headwall  
7 5/8"  
2'-0"  
10"  
1'-1"  
3" bolt projection  
10" to 11 7/8"  
1'-0"  
A-A  
#5 DBS




**RECEIVED**  
Richford Precast Frame Complete Updated Submittal_Aprroved 7.23.15.pdf

July 22, 2015

**RESUBMIT** NO **Approved**  
**BY** C. CARLSON **DATE** 07/23/15

---
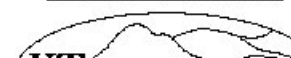
<u>STATE AGENCY</u>  	
Drawn By <b>R. YEAGER</b>   Reviewed By   Approved By <b>C VICK</b>	Date <b>16APR2015</b>   Date   Date <b>7/21/15</b>

C	SHOP DRAWING C1		REV
	Drawing No. C22312-C1		6
Quantity: 1	Project No: BRF030229	SHEET 1	OF 14

This drawing contains information proprietary to CONCRETE SYSTEMS, INC. This drawing is disclosed with the understanding that it will be retained in confidence and its use limited solely to the purpose for which it is disclosed. It is understood that no reproduction of this drawing is authorized without permission from CONCRETE SYSTEMS, INC. and that it will be returned to CONCRETE SYSTEMS, INC. upon request.

This drawing contains information proprietary to CONCRETE SYSTEMS, INC. This drawing is disclosed with the understanding that it will be retained in confidence and its use limited solely to the purpose for which it is disclosed. It is understood that no reproduction of this drawing is authorized without permission from CONCRETE SYSTEMS, INC. and that it will be returned to CONCRETE SYSTEMS, INC. upon request.





MK		QTY	LENGTH
401	#4	20	10' - 6"
402	#4	10	27' - 0"
403	#4	104	7' - 3"
701	#7	38	18' - 0"
702	#7	23	27' - 0"

 **REINFORCING DETAIL** Scale: N.T.S.



**RESUBMIT** NO **Approved**  
**BY** C. CARLSON **DATE** 07/23/15

This drawing contains information proprietary to CONCRETE SYSTEMS, INC. This drawing is disclosed with the understanding that it will be retained in confidence and its use limited solely to the purpose for which it is disclosed. It is understood that no reproduction of this drawing is authorized without permission from CONCRETE SYSTEMS, INC. and that it will be returned to CONCRETE SYSTEMS, INC. upon request.


C	SHOP DRAWING C2			REV
	Drawing No. C22312-C2			2
Quantity: 2	Project No: BRFO30229		SHEET 2	OF 14

3	
2	17JUN2015
1	14MAY2015
Rev.	Date



Contractor is to verify that all information shown on drawings has been thoroughly checked, complies with the contract documents and is adequate to construct the project. Should the Contractor find any discrepancy or deviation slightly from contract drawings to accommodate the manufacturing or design process. Approval of this drawing indicates that any deviation from the contract documents has been reviewed and found to be acceptable. Production will not commence until receipt of signed, approved shop drawings.	10			
	9			
	8			
	7			
	6	21JUL2015	SHORTENED DI & ADDED REBAR TO HW TO EASE MFG	RY
	5	08JUL2015	ALL DBS/DI WERE Z-BAR, NOW EPOXY COATED	RY
	4	17JUN2015	REVISED PER CUSTOMER REVIEW	BSS
	3	10JUN2015	ADJUSTED WATER REPELLENT	RY
	2	28MAY2015	10" DIM WAS 9 1/2", HDWALL BEND SCHED - 8" WAS 7 1/2"	RY
	1	14MAY2015	REVISED PER CUSTOMER REVIEW, REVISED GUARDRAIL ANCHOR SPACING, MOVED WINGWALL ANCHOR, ADDED NOTE	RY
Rev.		Date	DESCRIPTION	By
				REVISIONS



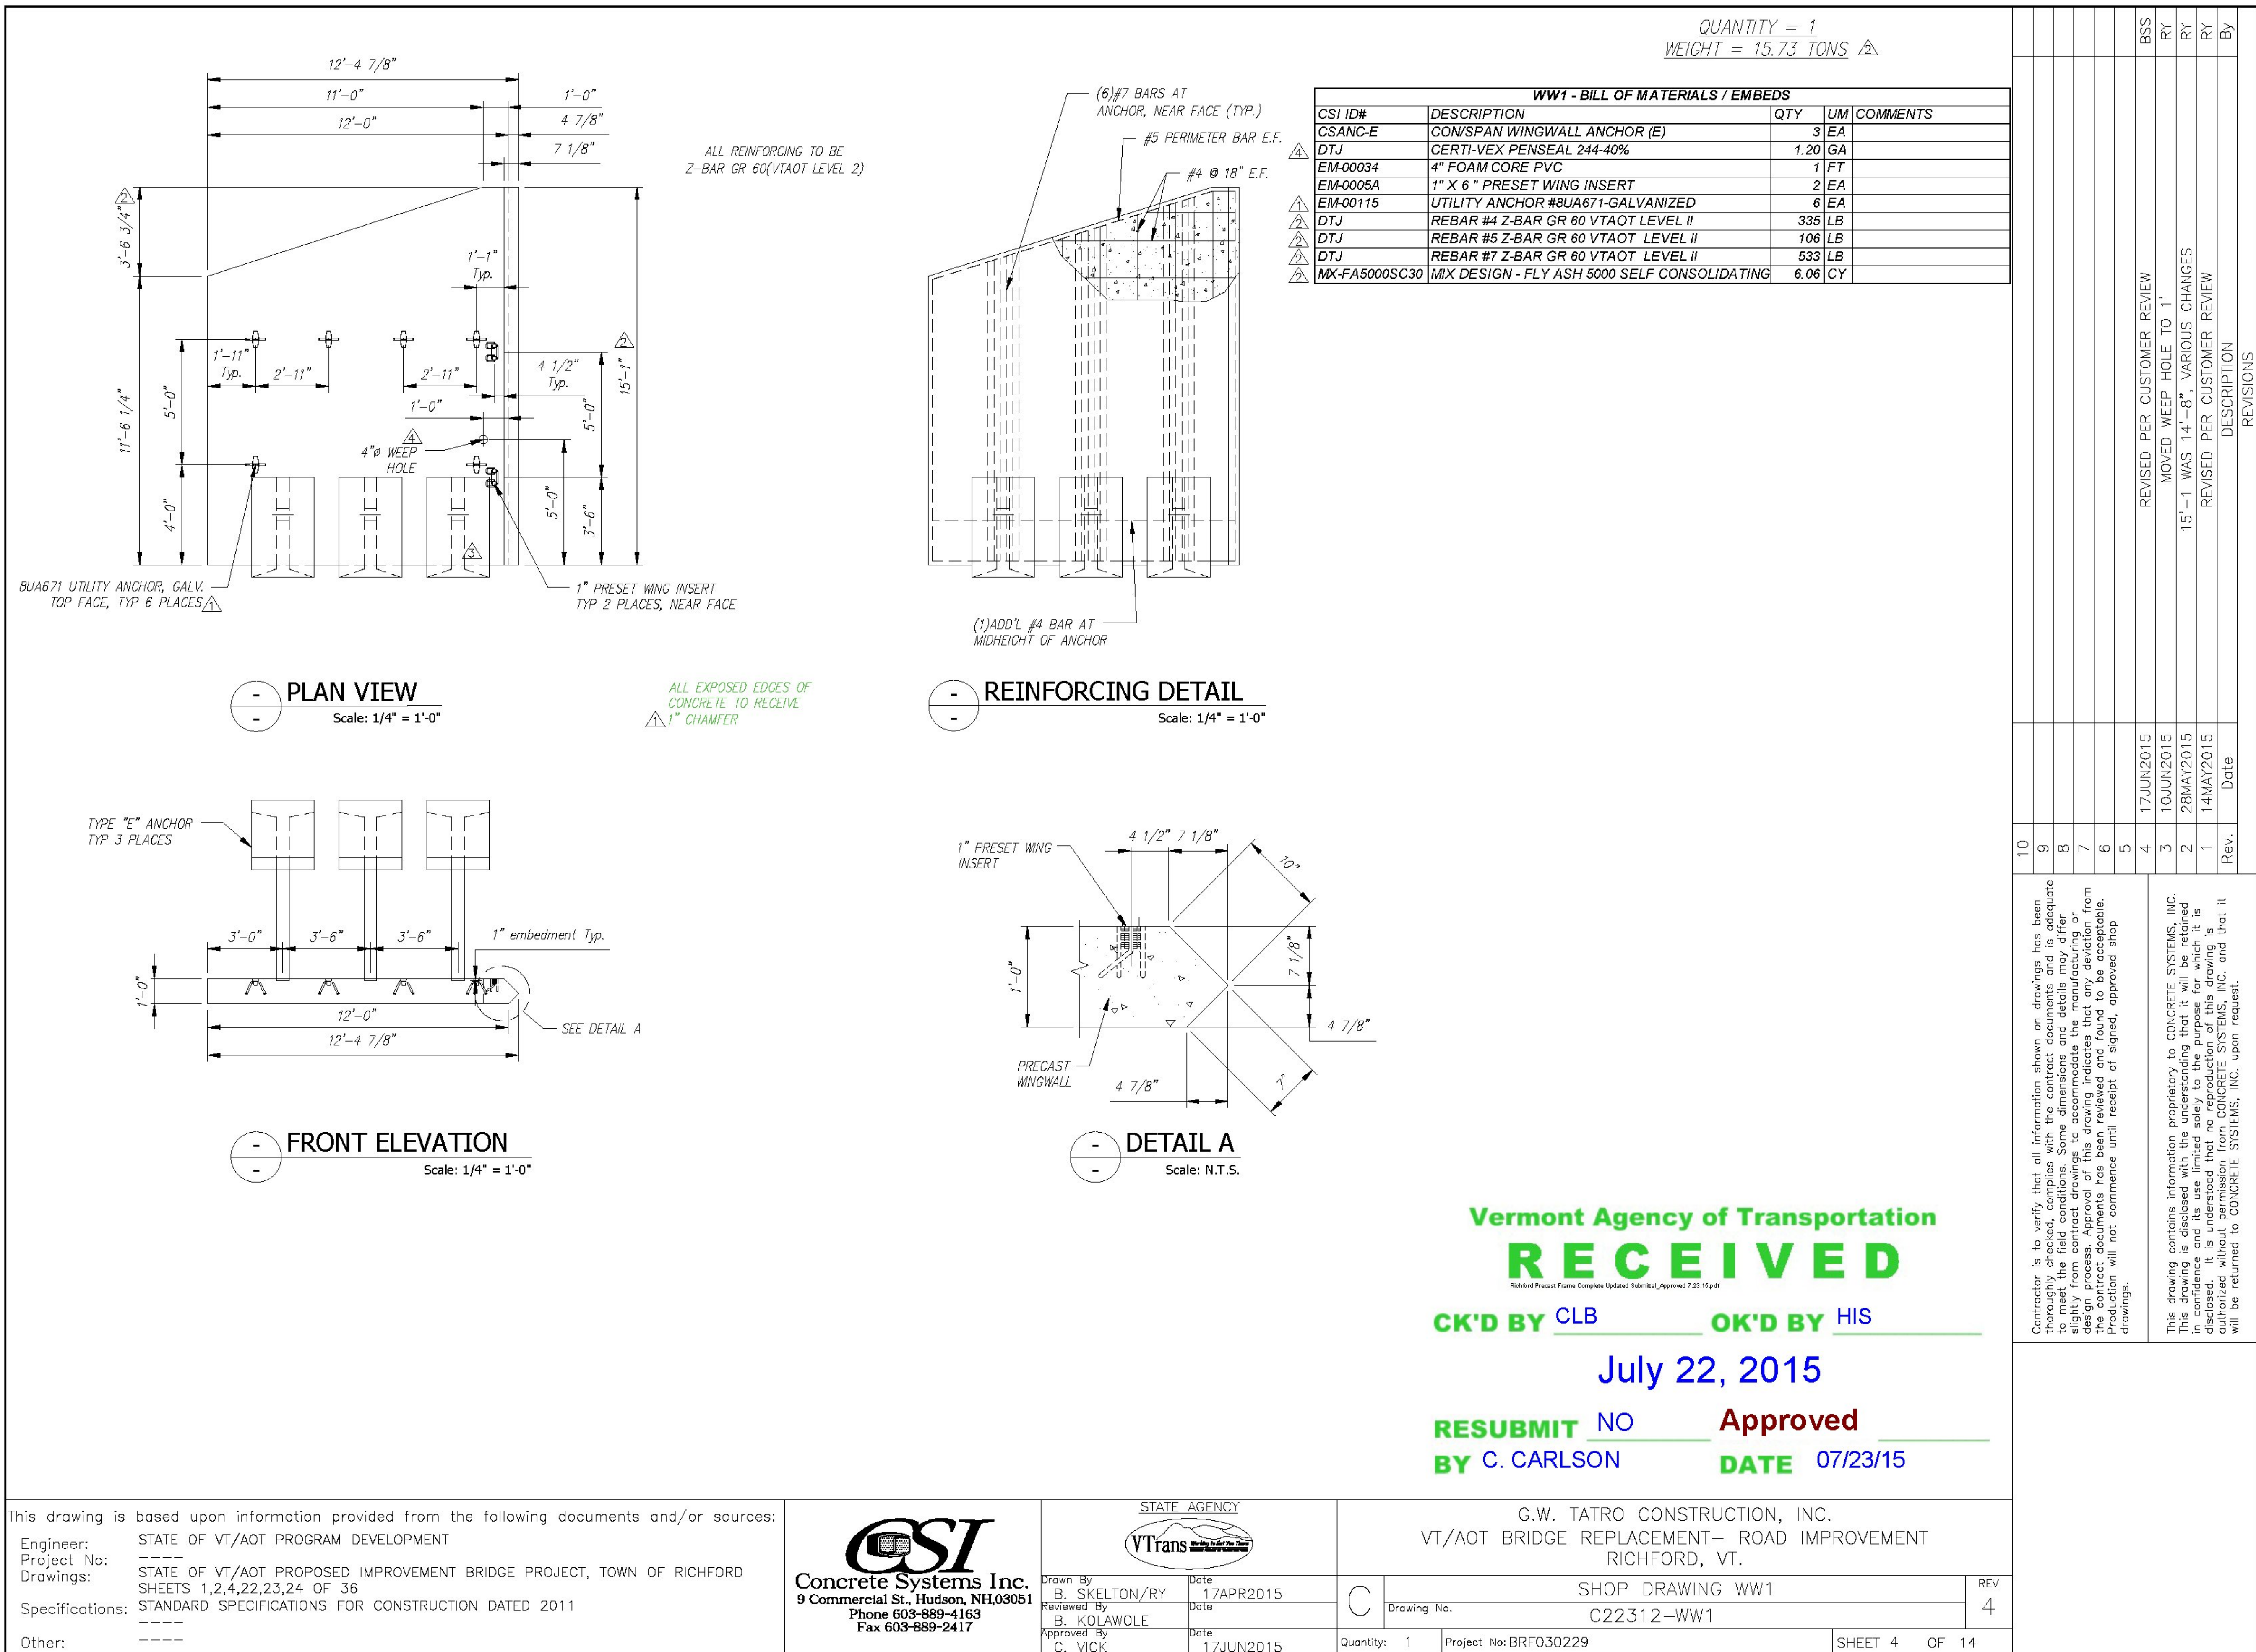




G.W. TATRO CONSTRUCTION, INC.  VT/AOT BRIDGE REPLACEMENT— ROAD IMPROVEMENT  RICHFORD, VT.			
C	SHOP DRAWING WW2		REV
	C22312—WW2		5
Quantity: 1	Project No: BRF030229	SHEET 5	OF 14




C	SHOP DRAWING WW3A			REV 4
	Drawing No. C22312-WW3A			
Quantity: 1	Project No: BRFO30229			SHEET 6 OF 14



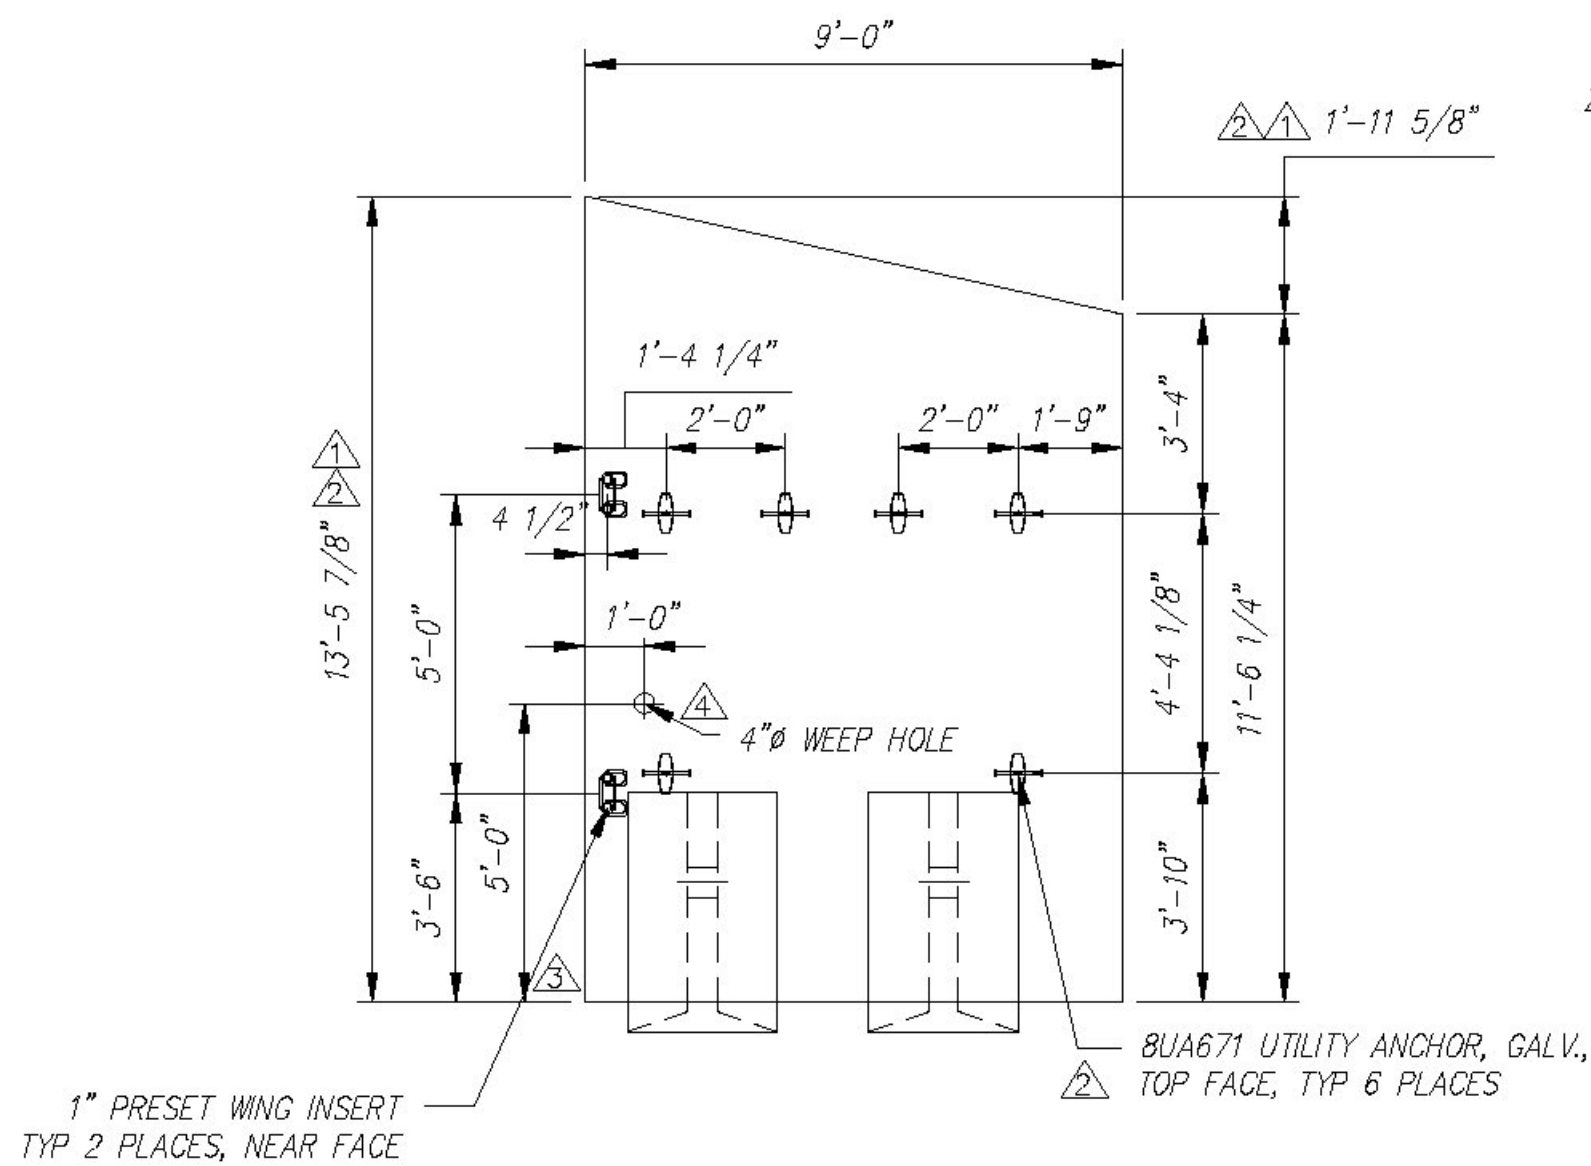


PLAN VIEW  
Scale: 1/4" = 1'-0"

ALL EXPOSED EDGES OF  
CONCRETE TO RECEIVE  
1" CHAMFER

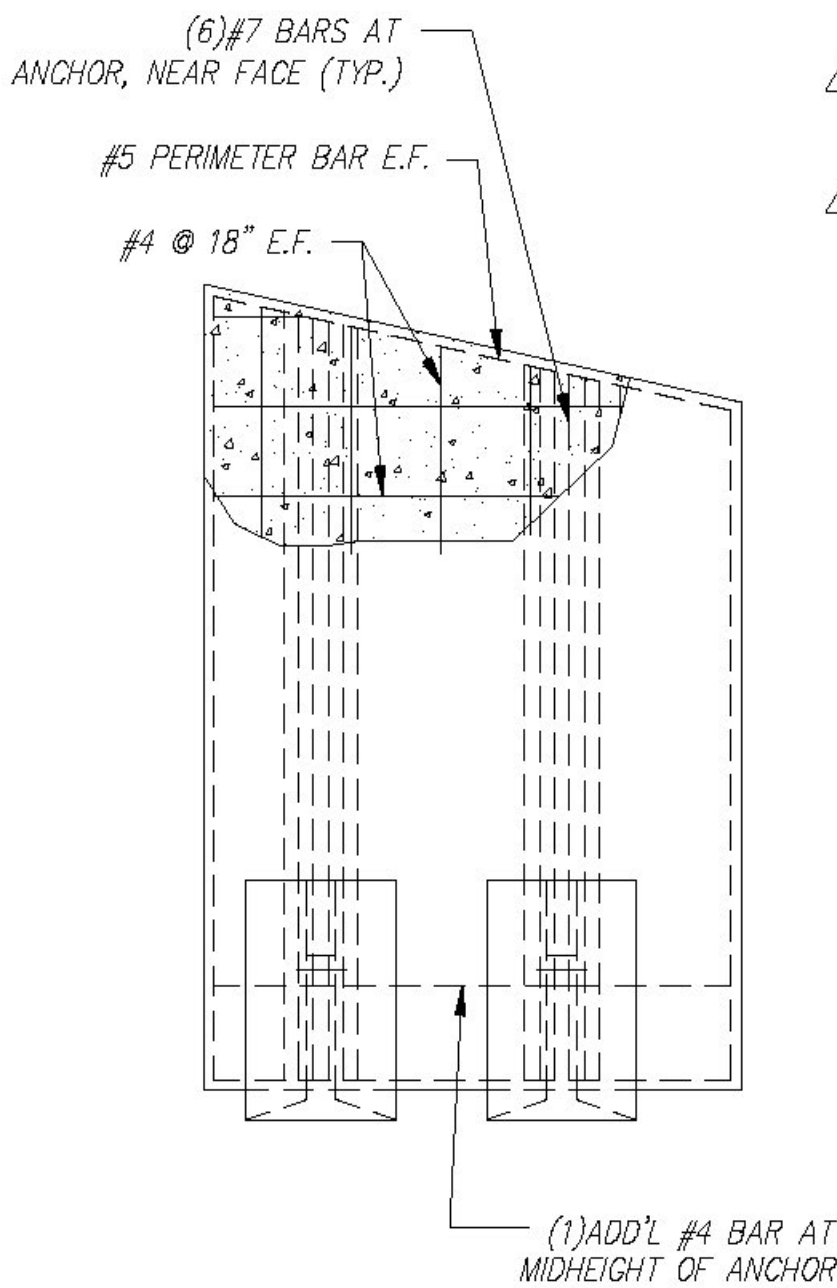

REINFORCING DETAIL  
Scale: 1/4" = 1'-0"

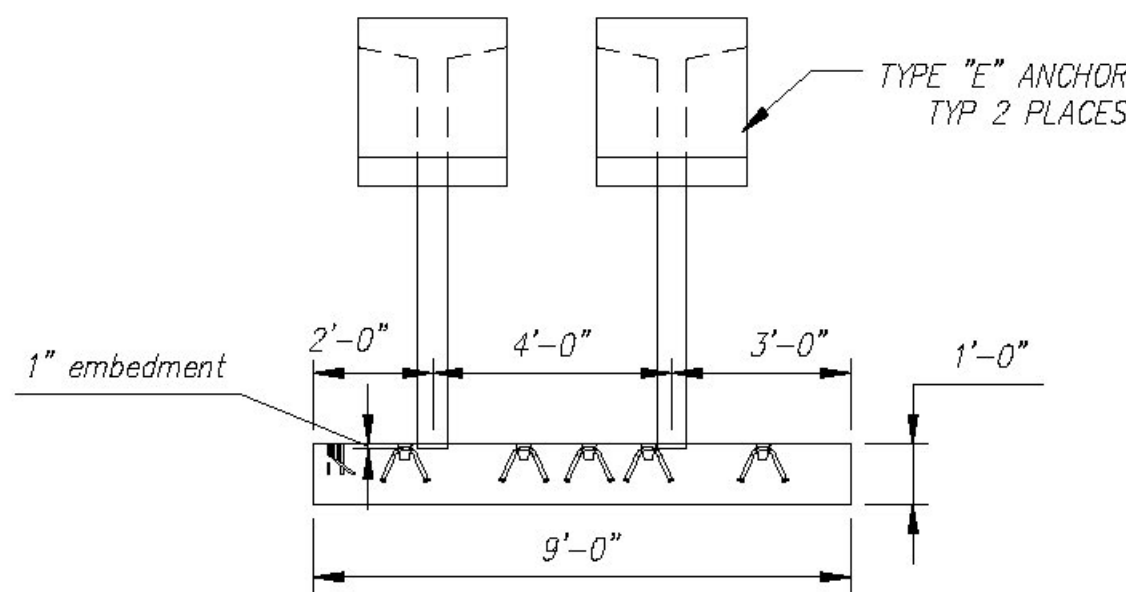

FRONT ELEVATION  
Scale: 1/4" = 1'-0"

QUANTITY = 1  
WEIGHT = 10.75 TONS

WW3B - BILL OF MATERIALS / EMBEDS			
CSI ID#	DESCRIPTION	QTY	UM COMMENTS
CSANC-E	CONSPAN WINGWALL ANCHOR (E)	2	EA
DTJ	CERTI-VEX PENSEAL 244-40%	1.00	GA
EM-00034	4" FOAM CORE PVC	1	FT
EM-0005A	1" X 6" PRESET WING INSERT	2	EA
EM-00115	UTILITY ANCHOR #8UA671-GALVANIZED	6	EA
DTJ	REBAR #4 Z-BAR GR 60 VTAOT LEVEL II	208	LB
DTJ	REBAR #5 Z-BAR GR 60 VTAOT LEVEL II	87	LB
DTJ	REBAR #7 Z-BAR GR 60 VTAOT LEVEL II	315	LB
MX-FA5000SC30	MX DESIGN - FLY ASH 5000 SELF CONSOLIDATING	4.17	CY

10	Contractor is to verify that all information shown on drawings has been thoroughly checked, complies with the contract documents and is adequate to meet the field conditions. Some dimensions and details may differ from those shown on drawings due to field conditions. The contractor is responsible for verifying the accuracy of the information shown on drawings. Approval of this drawing indicates that any deviation from the contract documents has been reviewed and found to be acceptable. Production will not commence until receipt of signed, approved shop drawings.	10	REVISED PER CUSTOMER REVIEW	BSS
9		9	ADDED WEEP HOLE	RY
8		8	REVISED PER CUSTOMER REVIEW	RY
7		7	REVISED PER CUSTOMER REVIEW	RY
6		6	DESCRIPTION	By
5		5	Date	
4		4	17JUN2015	
3		3	10JUN2015	
2		2	04JUN2015	
1		1	14MAY2015	
Rev.		Rev.		

Vermont Agency of Transportation

RECEIVED

Revised Precast Frame Complete Updated Submittal_Aproved 7.23.15.pdf

CK'D BY CLB OK'D BY HIS

July 22, 2015

RESUBMIT NO Approved  
BY C. CARLSON DATE 07/23/15

This drawing is based upon information provided from the following documents and/or sources:  
Engineer: STATE OF VT/AOT PROGRAM DEVELOPMENT  
Project No: STATE OF VT/AOT PROPOSED IMPROVEMENT BRIDGE PROJECT, TOWN OF RICHFORD  
Drawings: SHEETS 1,2,4,22,23,24 OF 36  
Specifications: STANDARD SPECIFICATIONS FOR CONSTRUCTION DATED 2011  
Other: -----


**CSI**  
Concrete Systems Inc.  
9 Commercial St., Hudson, NH, 03051  
Phone 603-889-4163  
Fax 603-889-2417

STATE AGENCY  
VTTrans  
Drawn By: B. SKELTON/RY  
Reviewed By: B. KOLAWOLE  
Approved By: C. VICK  
Date: 17APR2015  
Date: 17JUN2015


G.W. TATRO CONSTRUCTION, INC.  
VT/AOT BRIDGE REPLACEMENT- ROAD IMPROVEMENT  
RICHFORD, VT.

SHOP DRAWING WW3B  
C22312-WW3B  
Quantity: 1 Project No: BRFO30229 SHEET 7 OF 14  
REV 4



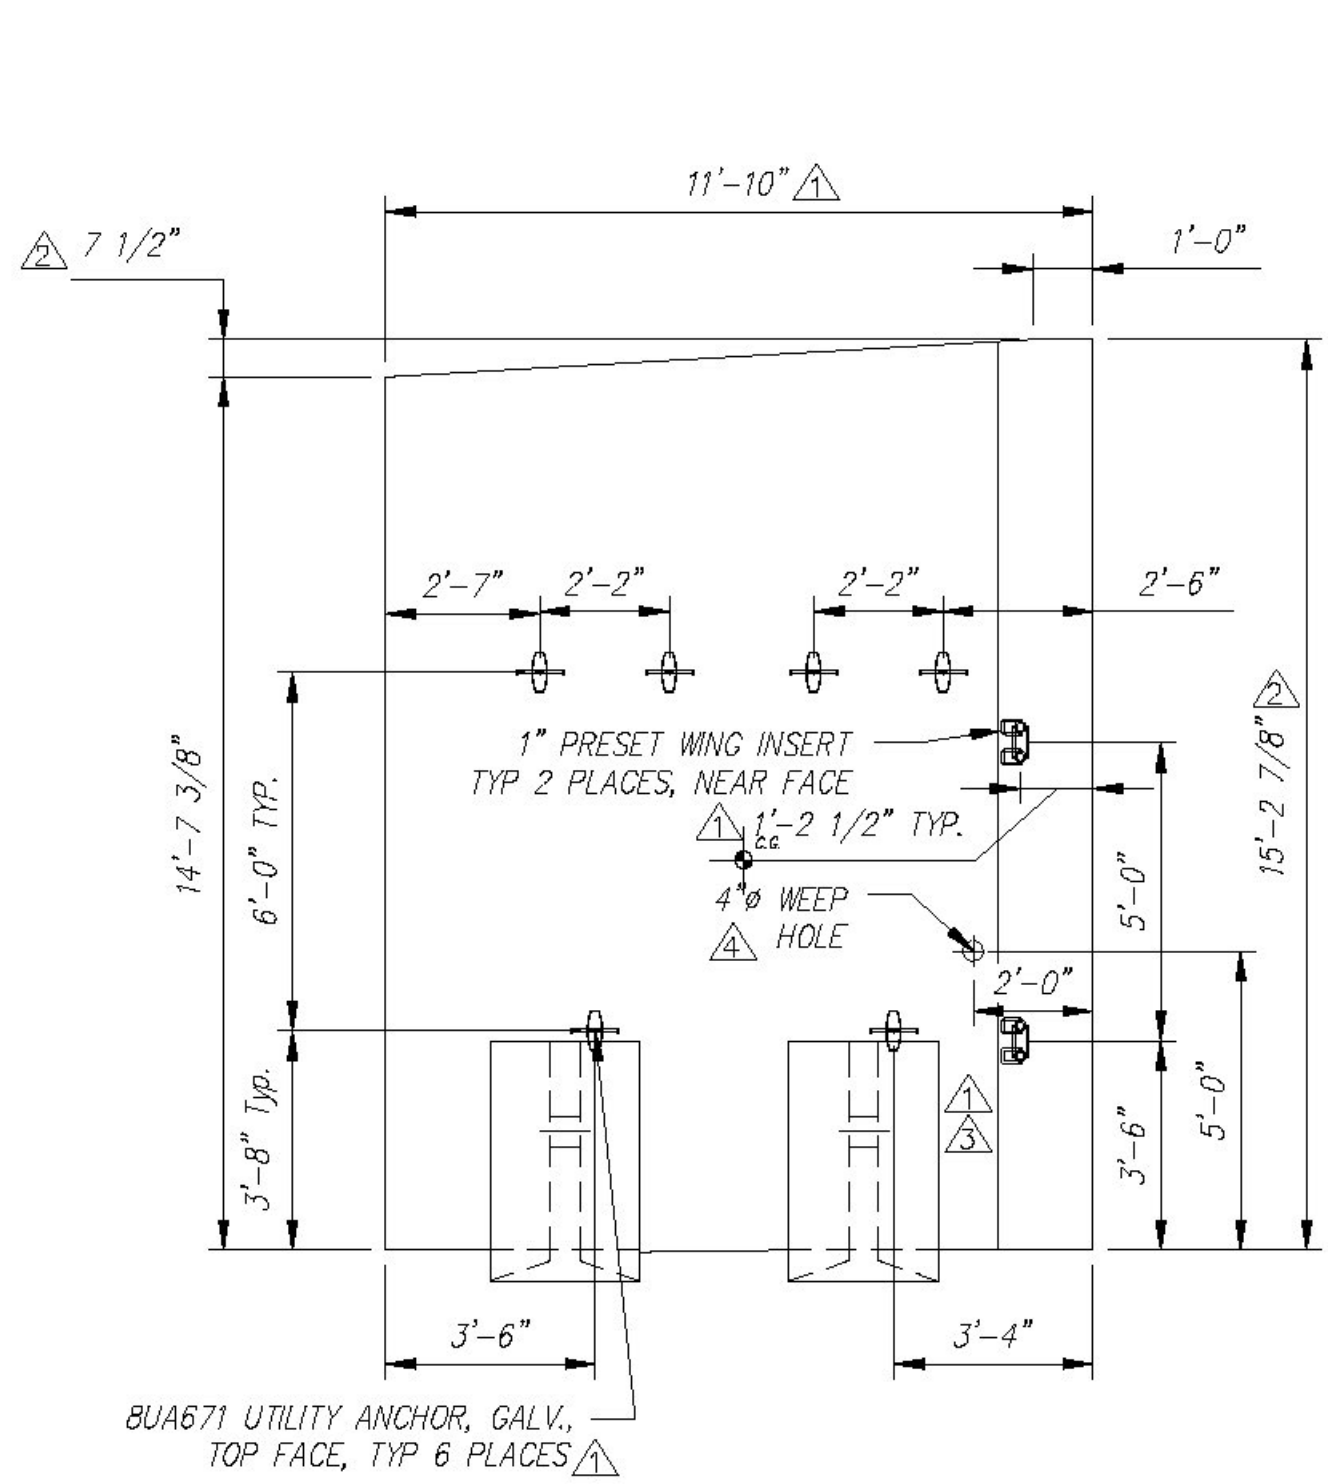


PLAN VIEW  
Scale: 1/4" = 1'-0"

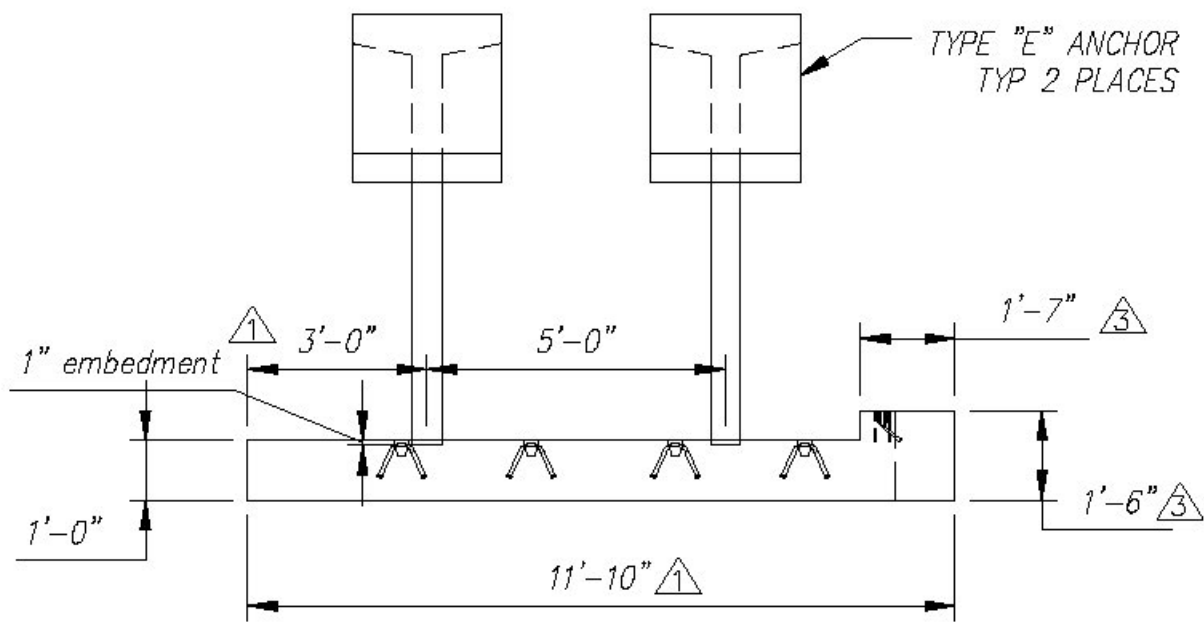

FRONT ELEVATION  
Scale: 1/4" = 1'-0"

ALL REINFORCING TO BE  
Z-BAR GR 60(VTAOT LEVEL 2)

ALL EXPOSED EDGES OF  
CONCRETE TO RECEIVE  
1" CHAMFER

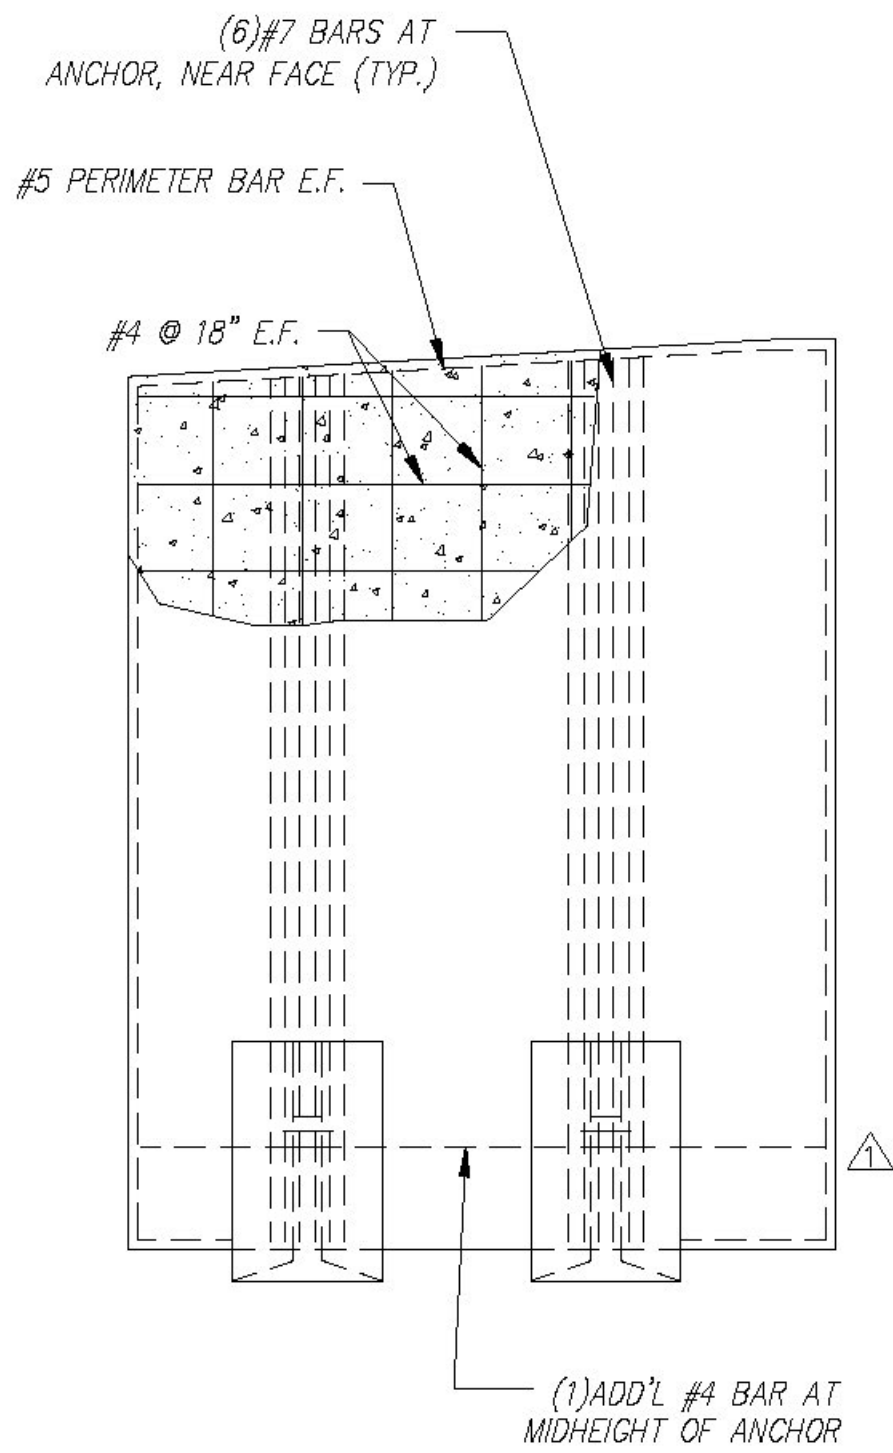

REINFORCING DETAIL  
Scale: 1/4" = 1'-0"

QUANTITY = 1  
WEIGHT = 16.47 TONS

WW4 - BILL OF MATERIALS / EMBEDS			
CSI ID#	DESCRIPTION	QTY	UM
CSANC-E	CONSPAN WINGWALL ANCHOR (E)	2	EA
DTJ	CERTI-VEX PENSEAL 244-40%	1.20	GA
EM-00034	4" FOAM CORE PVC	1	FT
EM-0005A	1" X 6" PRESET WING INSERT	2	EA
EM-00115	UTILITY ANCHOR #8UA671-GALVANIZED	6	EA
DTJ	REBAR #4 Z-BAR GR 60 VTAOT LEVEL II	305	LB
DTJ	REBAR #5 Z-BAR GR 60 VTAOT LEVEL II	108	LB
DTJ	REBAR #7 Z-BAR GR 60 VTAOT LEVEL II	356	LB
MX-FA5000SC30	MIX DESIGN - FLY ASH 5000 SELF CONSOLIDATING	6.99	CY

10	Contractor is to verify that all information shown on drawings has been thoroughly checked, complies with the contract documents and is adequate to meet the field conditions. Some dimensions and details may differ from those shown on drawings due to field conditions. The contractor is responsible for obtaining all necessary permits and approvals from the design process. Approval of this drawing indicates that any deviation from the contract documents has been reviewed and found to be acceptable. Production will not commence until receipt of signed, approved shop drawings.	10	REVISED PER CUSTOMER REVIEW
9		9	ADDED 6" STANDOFF
8		8	REVISED PER CUSTOMER REVIEW
7		7	REVISED PER CUSTOMER REVIEW
6		6	DESCRIPTION
5		5	By
4		4	Revisions
3		3	
2		2	
1		1	
Rev.		Date	

Vermont Agency of Transportation

RECEIVED

Richford Precast Frame Complete Updated Submittal, Approved 7/23/15.pdf

CK'D BY CLB OK'D BY HIS

July 22, 2015

RESUBMIT NO Approved  
BY C. CARLSON DATE 07/23/15

This drawing is based upon information provided from the following documents and/or sources:  
Engineer: STATE OF VT/AOT PROGRAM DEVELOPMENT  
Project No: STATE OF VT/AOT PROPOSED IMPROVEMENT BRIDGE PROJECT, TOWN OF RICHFORD  
Drawings: SHEETS 1,2,4,22,23,24 OF 36  
Specifications: STANDARD SPECIFICATIONS FOR CONSTRUCTION DATED 2011  
Other: -----


**CSI**  
Concrete Systems Inc.  
9 Commercial St., Hudson, NH, 03051  
Phone 603-889-4163  
Fax 603-889-2417

STATE AGENCY  
VTTrans  
Drawn By: B. SKELTON/RV  
Reviewed By: B. KOLAWOLE  
Approved By: C. VICK  
Date: 17APR2015  
Date: 17JUN2015


G.W. TATRO CONSTRUCTION, INC.  
VT/AOT BRIDGE REPLACEMENT- ROAD IMPROVEMENT  
RICHFORD, VT.

Quantity: 1 Project No: BRFO30229 SHEET 8 OF 14  
Drawing No. C22312-WW4  
REV 4




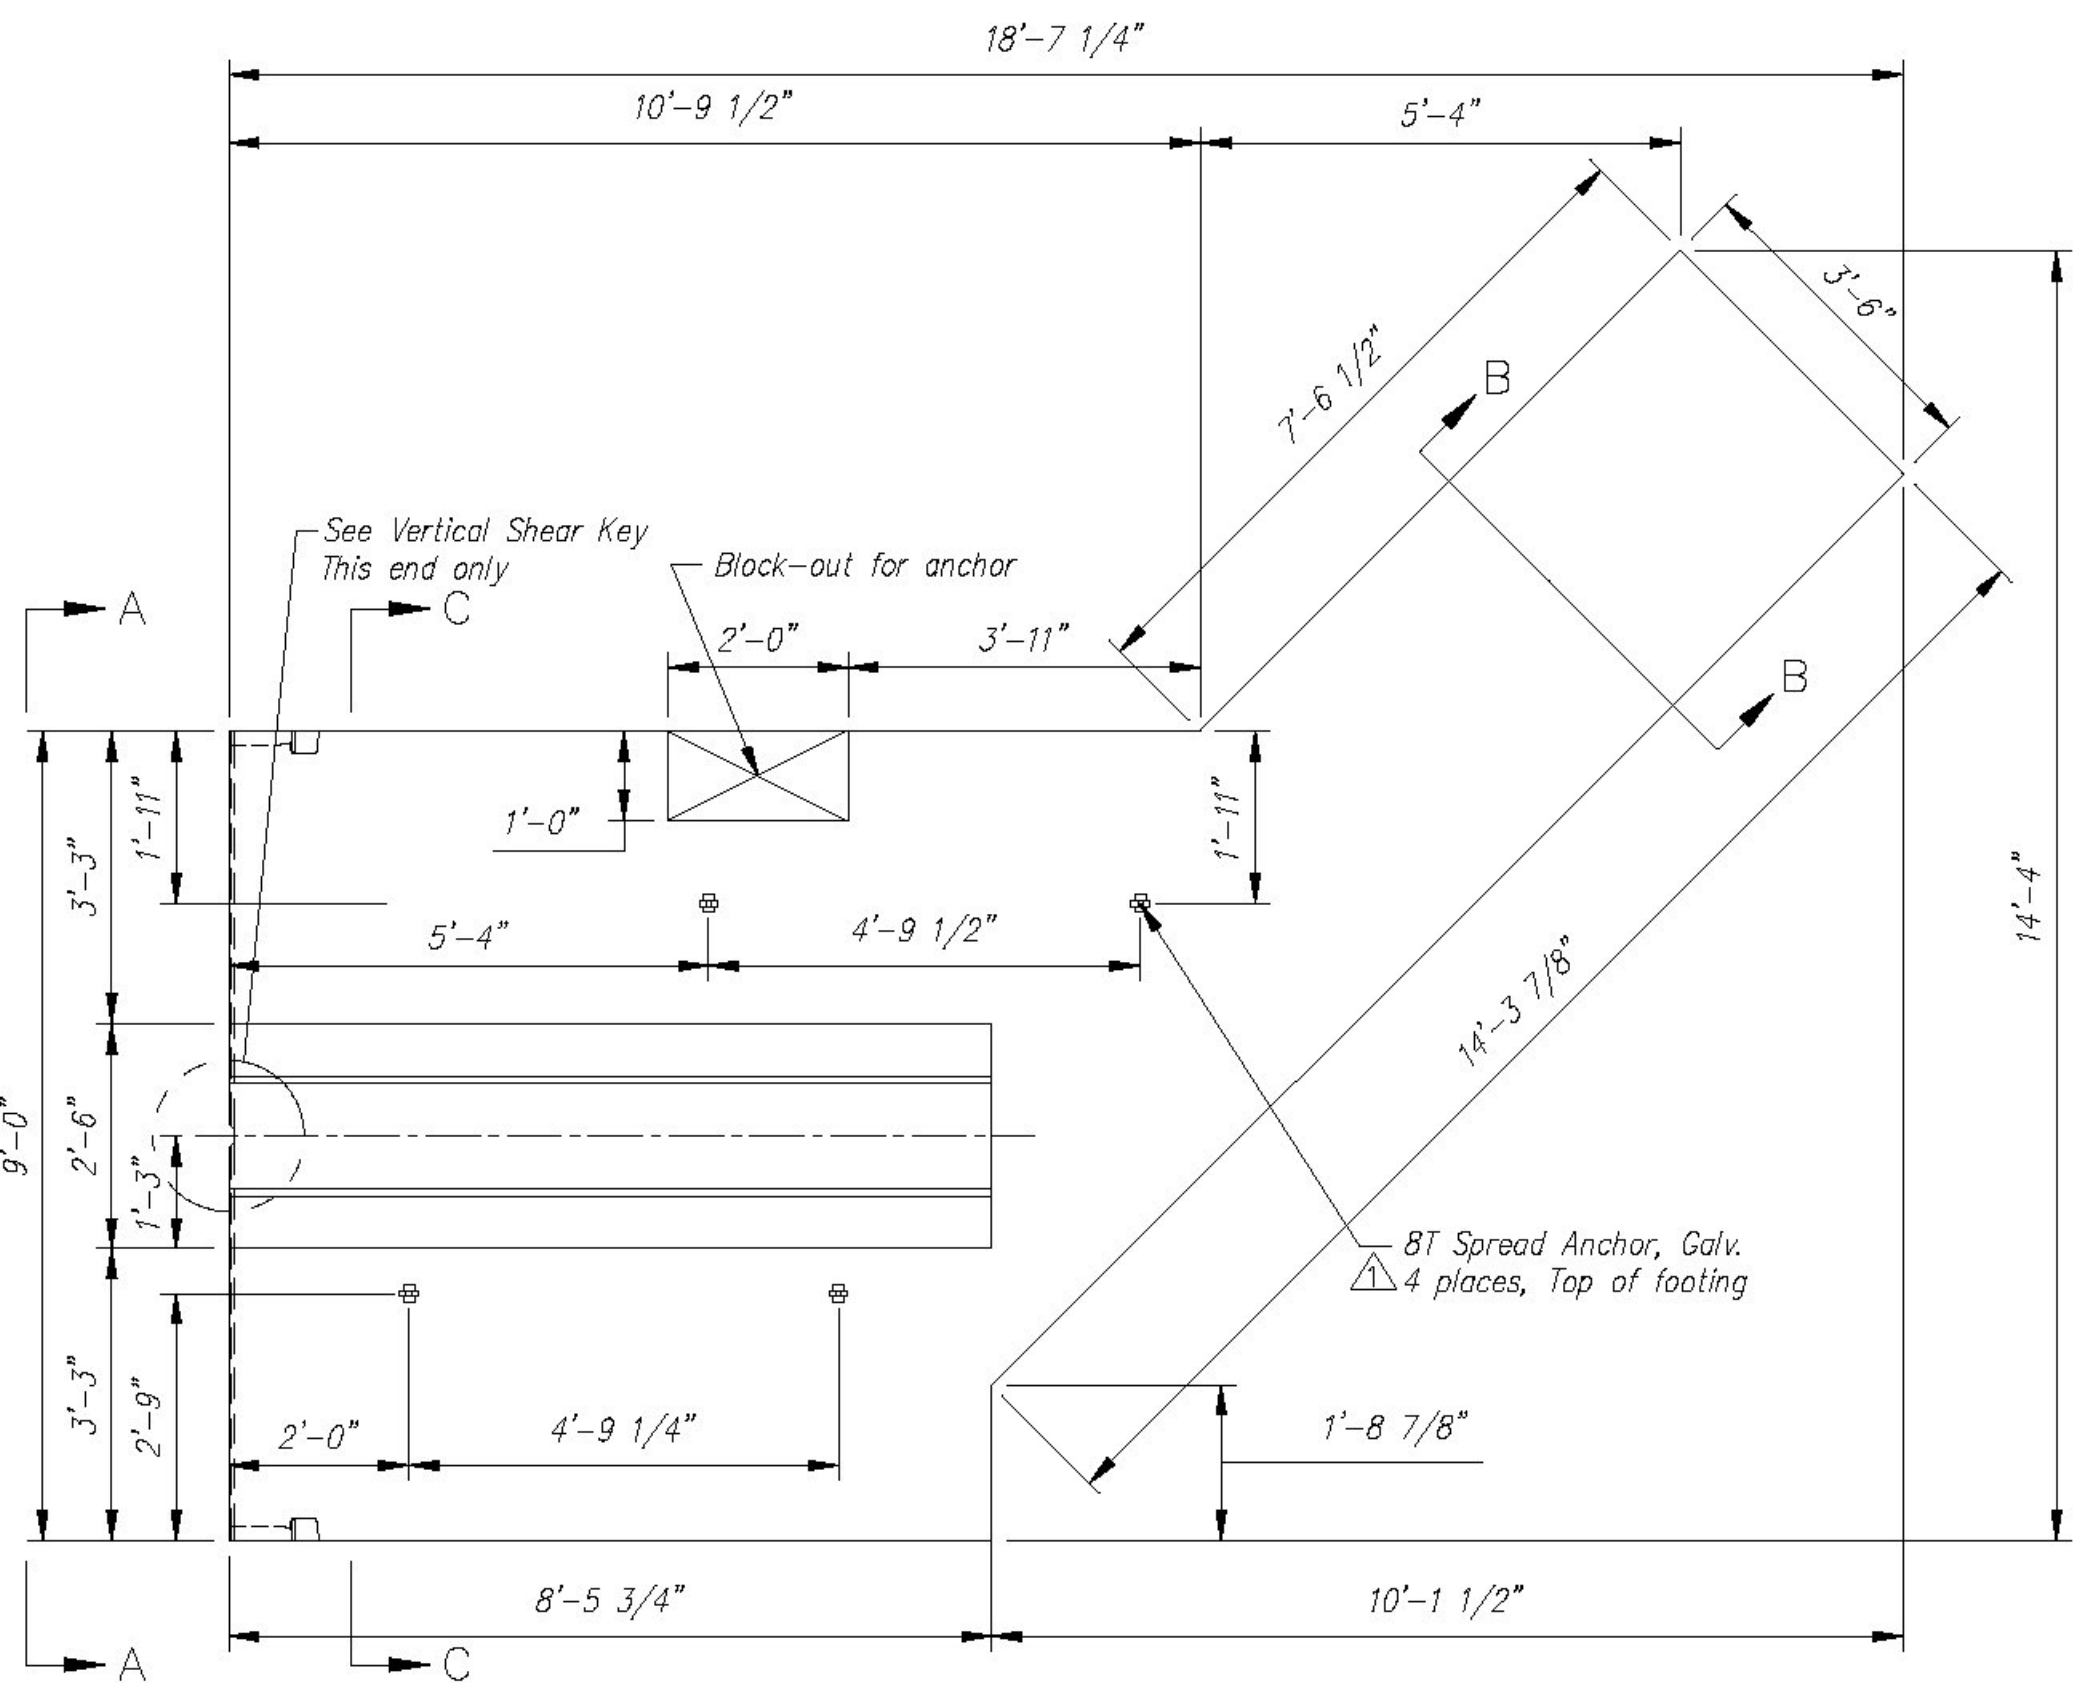


PLAN VIEW  
Scale: 3/8\" = 1'-0"

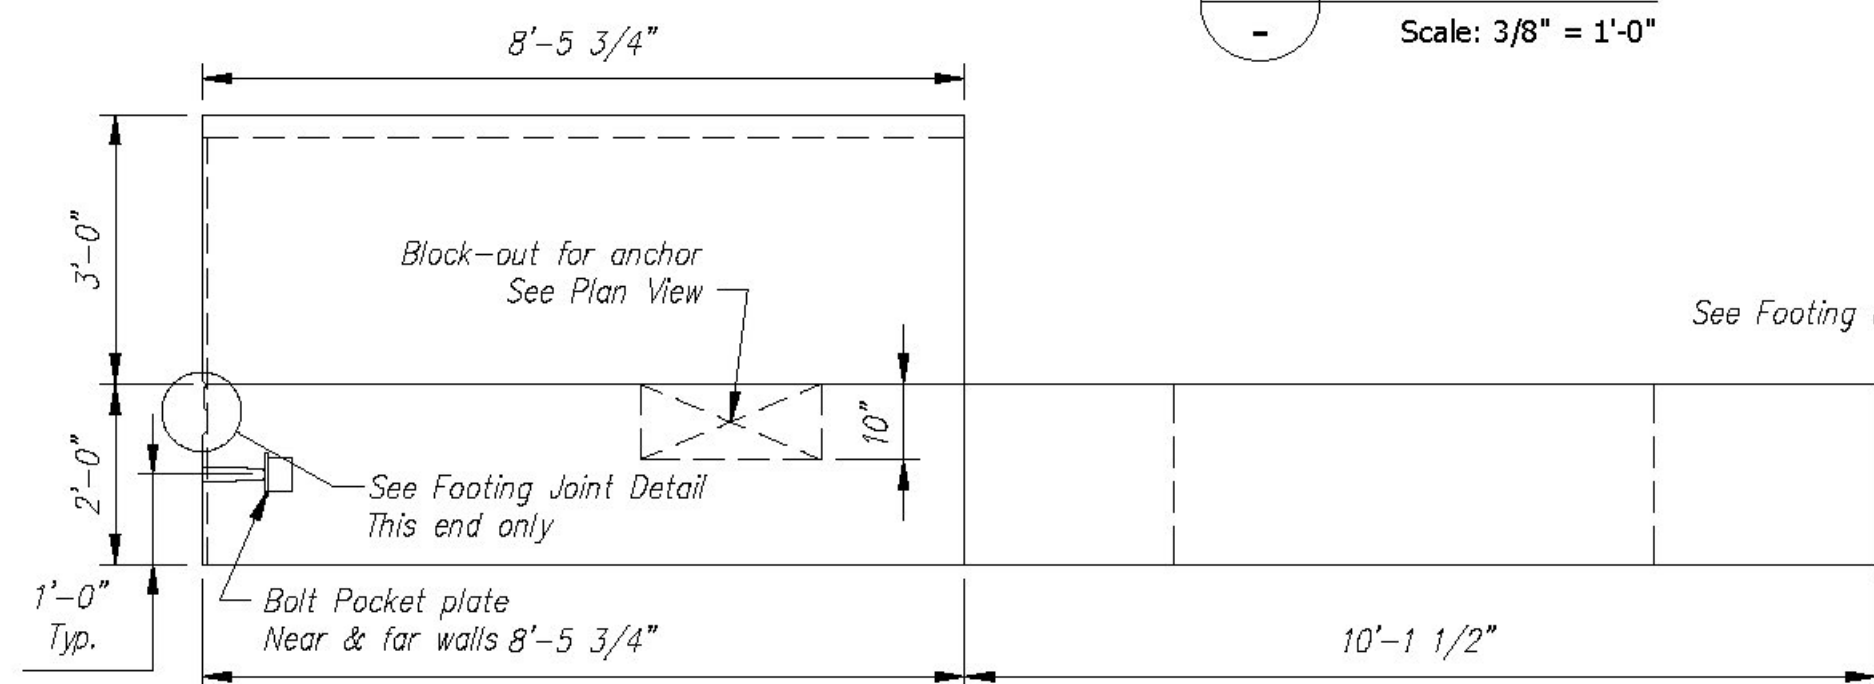


ELEVATION  
Scale: 3/8\" = 1'-0"

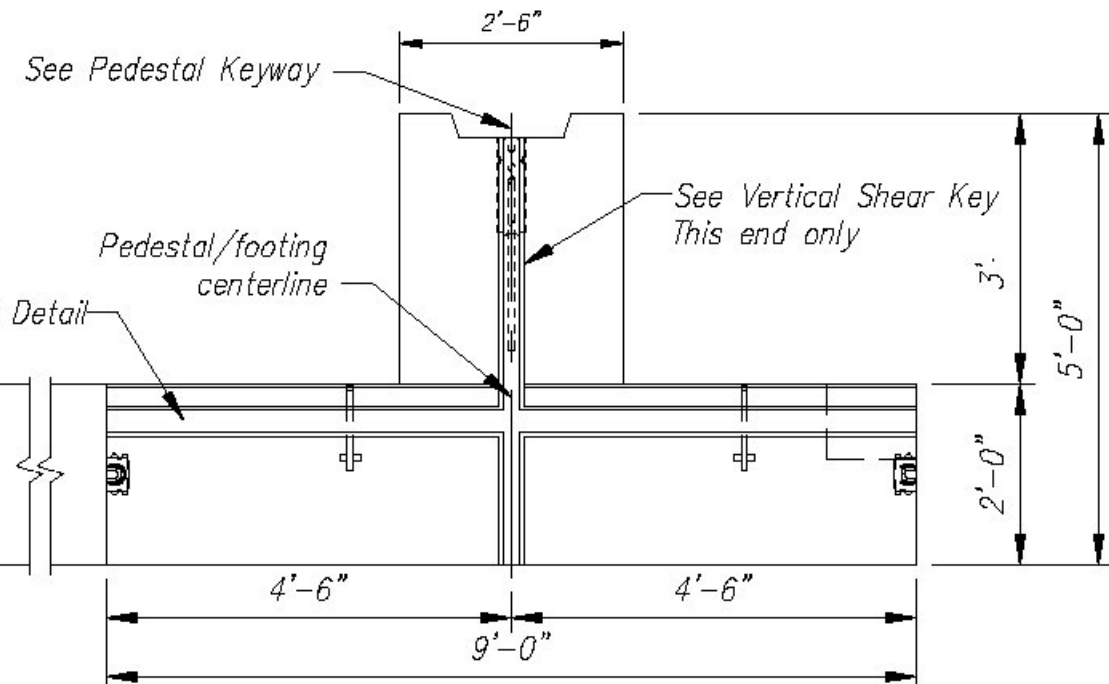


ELEVATION A-A  
Scale: 3/8\" = 1'-0"

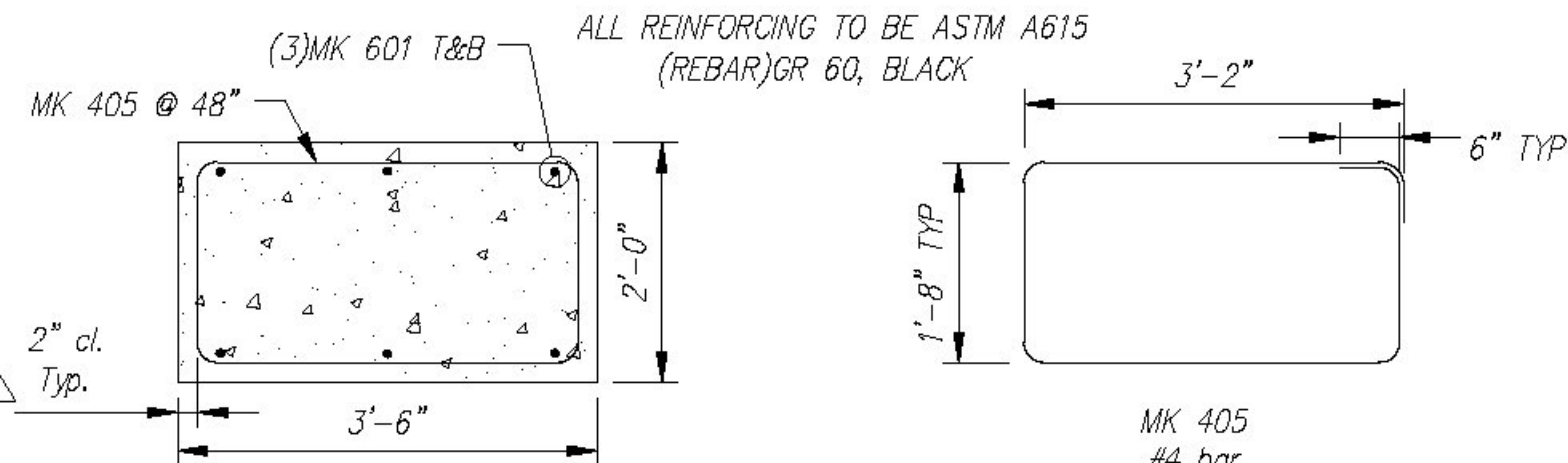


SECTION B-B  
REINFORCING DETAIL  
Scale: N.T.S.

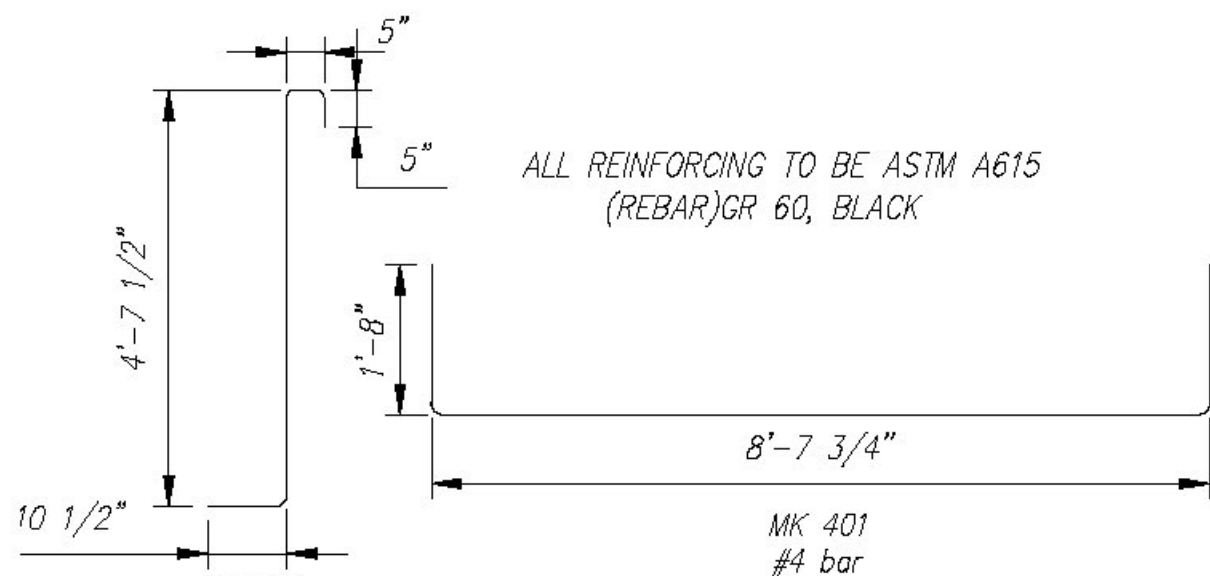


BENDING SCHEDULE  
Scale: N.T.S.

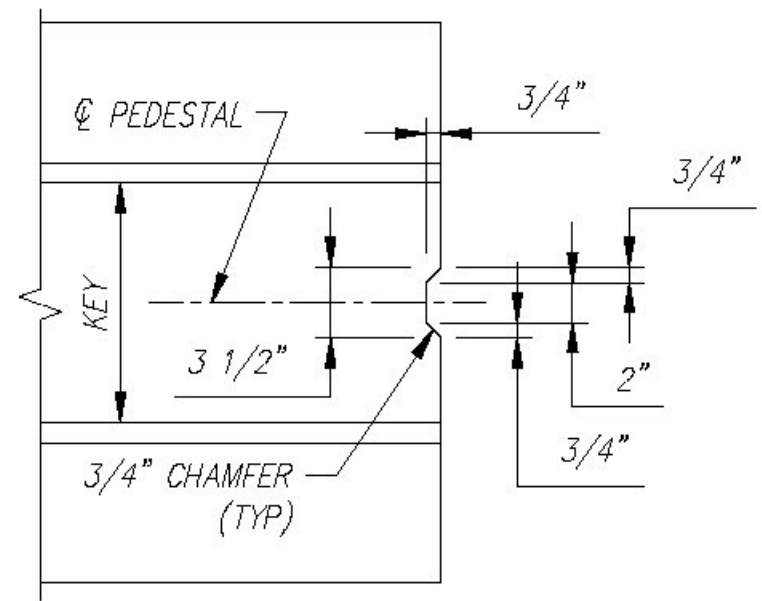


VERTICAL SHEAR KEY  
Scale: N.T.S.

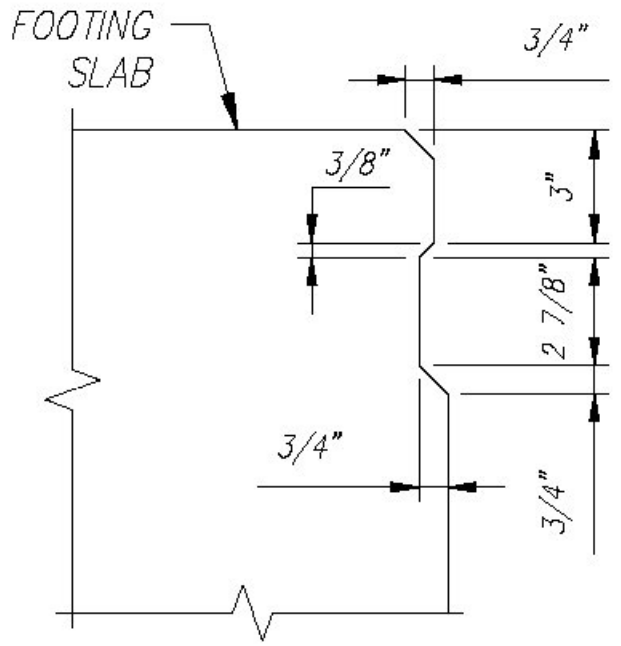

JOINT DETAIL  
Scale: N.T.S.

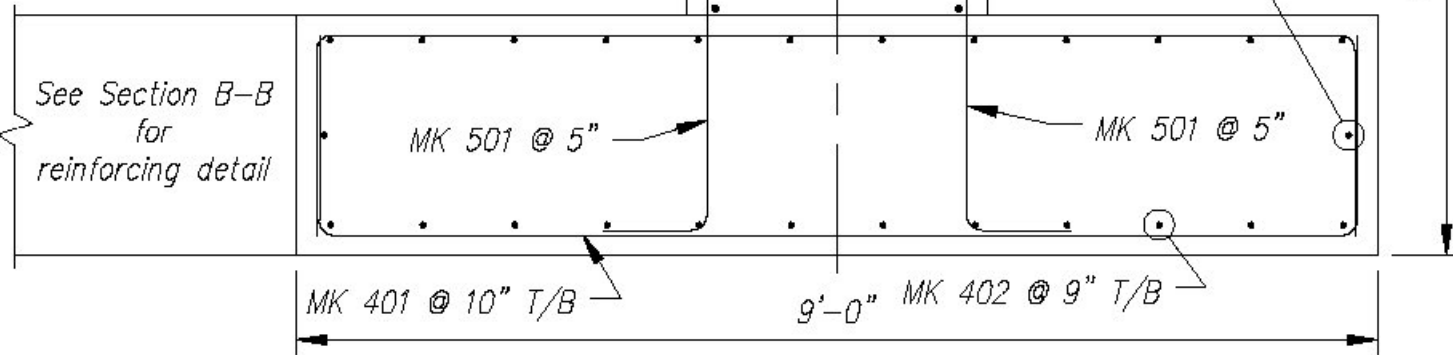

SECTION C-C  
REINFORCING DETAIL  
Scale: N.T.S.

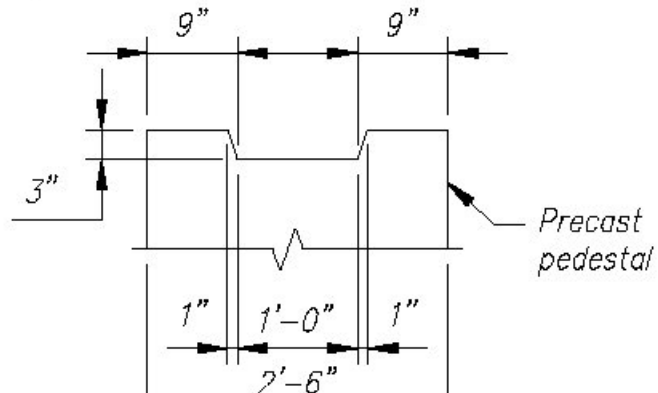

PEDESTAL KEYWAY  
Scale: N.T.S.

QUANTITY = 1 WEIGHT = 23.02 TONS			
FOOTING SLAB - F1 - BILL OF MATERIALS / EMBEDS			
CSI ID#	DESCRIPTION	QTY	UM COMMENTS
EM-00078	8T SPREAD ANCHOR #FL119/P94	4	EA
EM-00125	BOLT POCKET PLATE (GALVANIZED)	2	EA
RM-00013	REBAR #4 BLACK- GR 60	424	LB
RM-00015	REBAR #5 BLACK-GR 60 40'	264	LB
RM-00017	REBAR #6 BLACK-GR 60 40'	128	LB
MX-FA5000SC30	MIX DESIGN - FLY ASH 5000 SELF CONSOLIDATING	9.11	CY
FOOTING PEDESTAL - F1 - BILL OF MATERIALS / EMBEDS			
RM-00013	REBAR #4 BLACK- GR 60	104	LB
MX-FA5000SC30	MIX DESIGN - FLY ASH 5000 SELF CONSOLIDATING	2.26	CY

Fig. Slab - F1 Rebar Schedule			
MK	QTY	LENGTH	
401 #4	26	12	0"
402 #4	26	10	9"
405 #4	4	10	8"
MAX			
501 #5	40	6	4"
601 #6	6	14	3"
MAX			

Fig. Pedestal-F1 Rebar Schedule			
MK	QTY	LENGTH	
402 #4	17	8	3"
403 #4	9	1	8"

Vermont Agency of Transportation  
**RECEIVED**  
CK'D BY CLB OK'D BY HIS  
July 22, 2015  
RESUBMIT NO Approved  
BY C. CARLSON DATE 07/23/15

This drawing is based upon information provided from the following documents and/or sources:  
Engineer: STATE OF VT/AOT PROGRAM DEVELOPMENT  
Project No:  
Drawings: STATE OF VT/AOT PROPOSED IMPROVEMENT BRIDGE PROJECT, TOWN OF RICHFORD SHEETS 1,2,4,22,23,24 OF 36  
Specifications: STANDARD SPECIFICATIONS FOR CONSTRUCTION DATED 2011  
Other: -----

STATE AGENCY  
VTTrans

Concrete Systems Inc.  
9 Commercial St., Hudson, NH, 03051  
Phone 603-889-4163  
Fax 603-889-2417

Drawn By  
R. YEAGER  
Reviewed By  
B. KOLAWOLE  
Approved By  
C. VICK

Date  
16APR2015  
Date  
Date  
17JUN2015

G.W. TATRO CONSTRUCTION, INC.  
VT/AOT BRIDGE REPLACEMENT- ROAD IMPROVEMENT  
RICHFORD, VT.

C

SHOP DRAWING F1  
C22312-F1

REV  
1

Quantity: 1  
Project No: BRFO30229  
SHEET 9 OF 14

10	9	8	7	6	5	4	3	2	1	14MAY2015	Date
Rev.										Revised Per Customer Review, Revised Anchor Locations	
DESCRIPTION										By	
REVISIONS											

Contractor is to verify that all information shown on drawings has been thoroughly checked, complies with the contract documents and is adequate to meet the field conditions. Some dimensions and details may differ from those shown on drawings. The contractor shall be responsible for obtaining all necessary permits and approvals. Approval of this drawing indicates that any deviation from the contract documents has been reviewed and found to be acceptable. Production will not commence until receipt of signed, approved shop drawings.

This drawing contains information proprietary to CONCRETE SYSTEMS, INC. It is to be used only for the project and location specified. It is to be kept confidential and not be reproduced or distributed without the written permission of CONCRETE SYSTEMS, INC. and that it will be returned to CONCRETE SYSTEMS, INC. upon request.









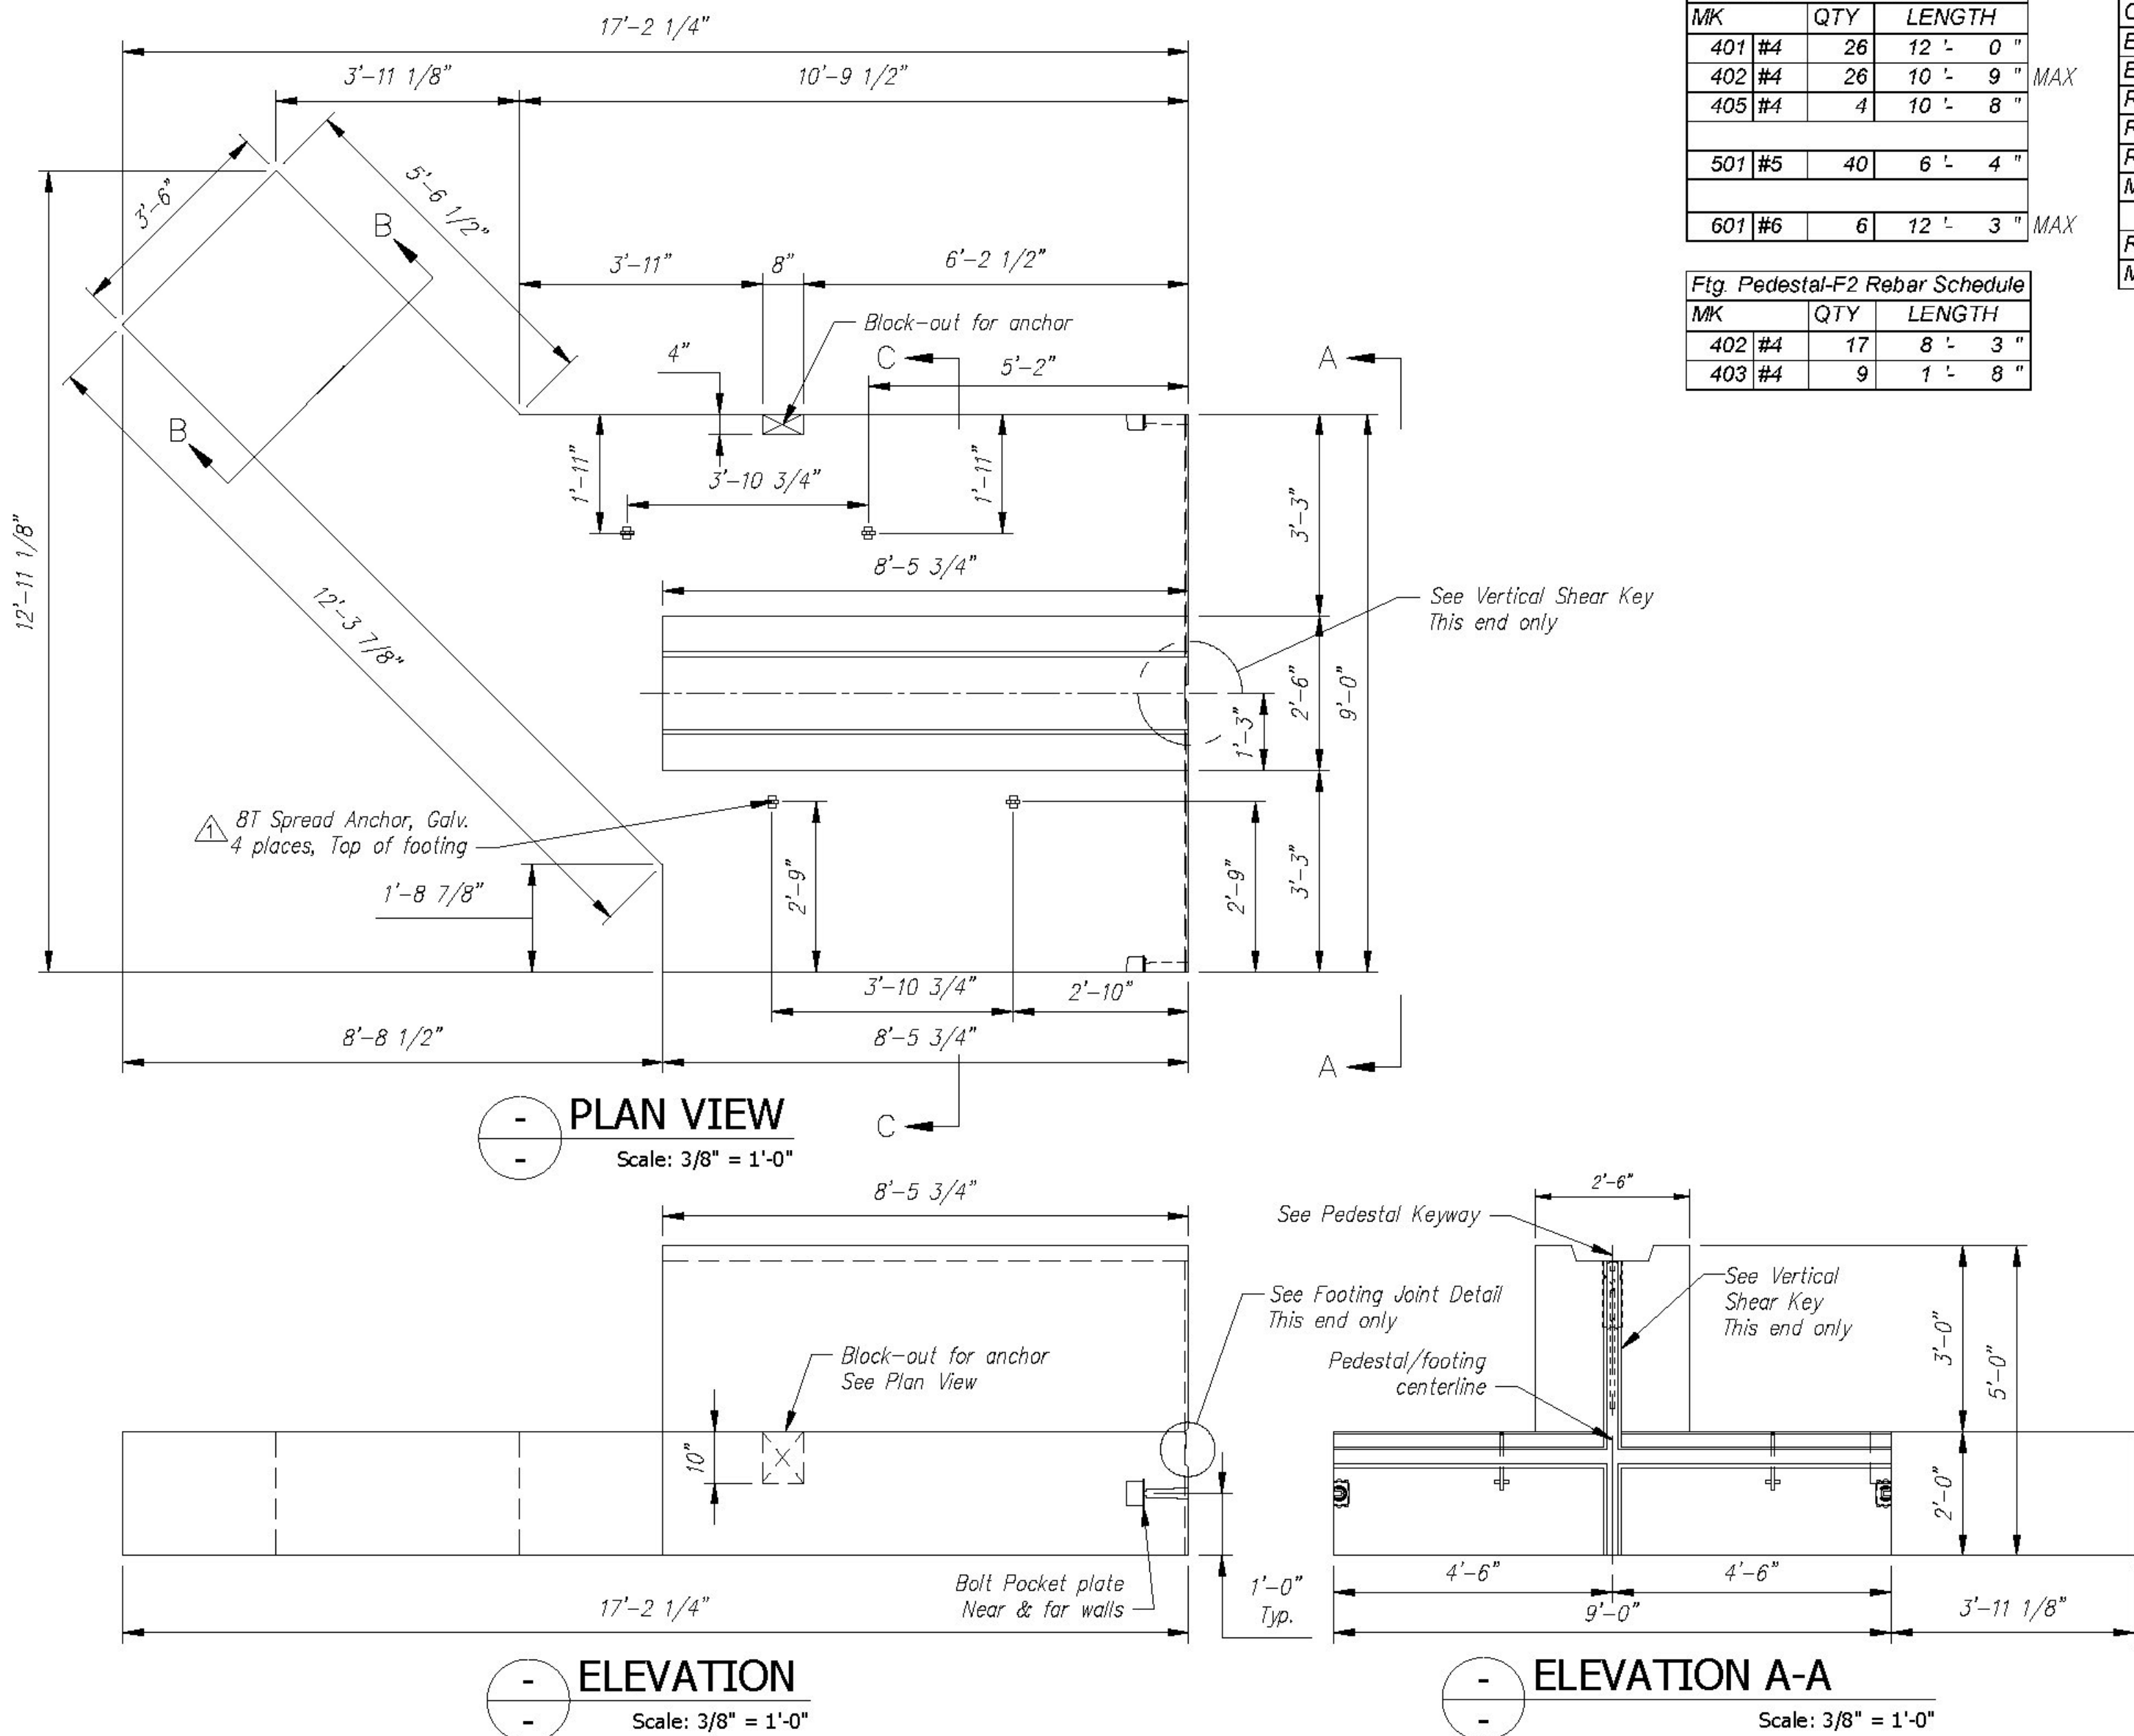


Fig. Slab - F2 Rebar Schedule			
MK	QTY	LENGTH	
401 #4	26	12'-0"	
402 #4	26	10'-9"	MAX
403 #4	4	10'-8"	
501 #5	40	6'-4"	
601 #6	6	12'-3"	MAX

Fig. Pedestal-F2 Rebar Schedule			
MK	QTY	LENGTH	
402 #4	17	8'-3"	
403 #4	9	1'-8"	

FOOTING SLAB - F2 - BILL OF MATERIALS / EMBEDS			
CSI ID#	DESCRIPTION	QTY	UM COMMENTS
EM-00078	8T SPREAD ANCHOR #FL119/P94	4	EA
EM-00125	BOLT POCKET PLATE (GALVANIZED)	2	EA
RM-00013	REBAR #4 BLACK-GR 60	424	LB
RM-00015	REBAR #5 BLACK-GR 60 40"	264	LB
RM-00017	REBAR #6 BLACK-GR 60 40"	110	LB
MX-FA5000SC30	MIX DESIGN - FLY ASH 5000 SELF CONSOLIDATING	8.59	CY
FOOTING PEDESTAL - F2 - BILL OF MATERIALS / EMBEDS			
RM-00013	REBAR #4 BLACK-GR 60	104	LB
MX-FA5000SC30	MIX DESIGN - FLY ASH 5000 SELF CONSOLIDATING	2.26	CY

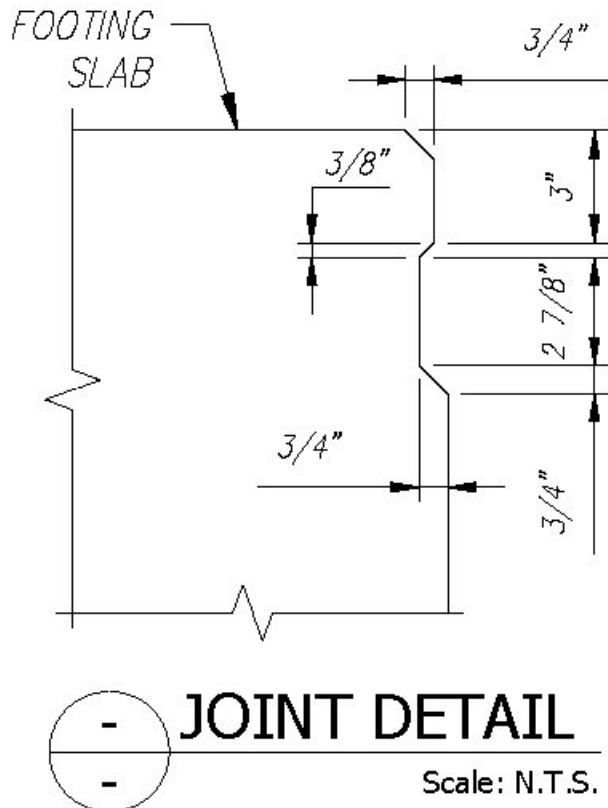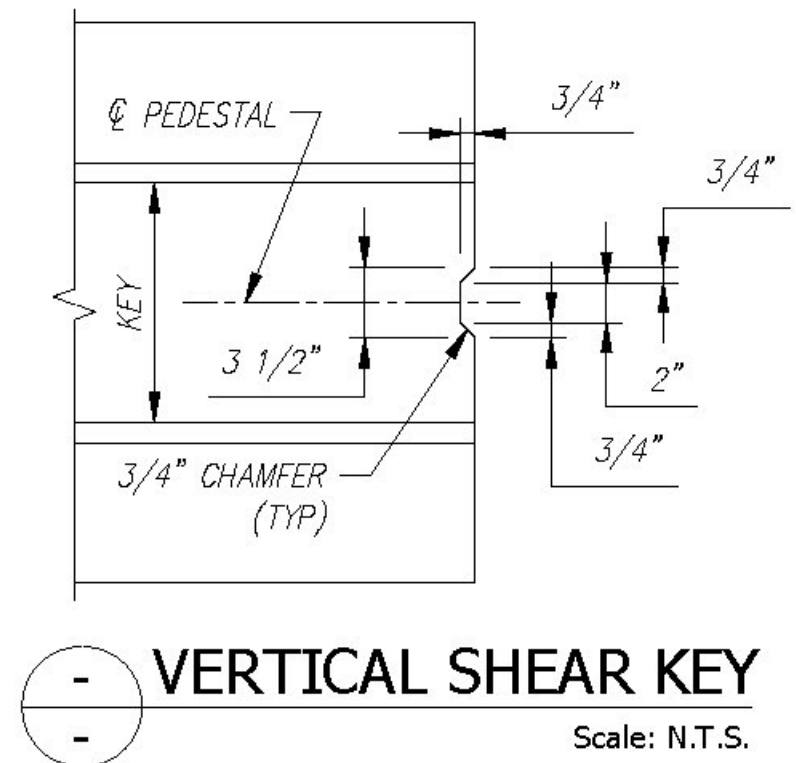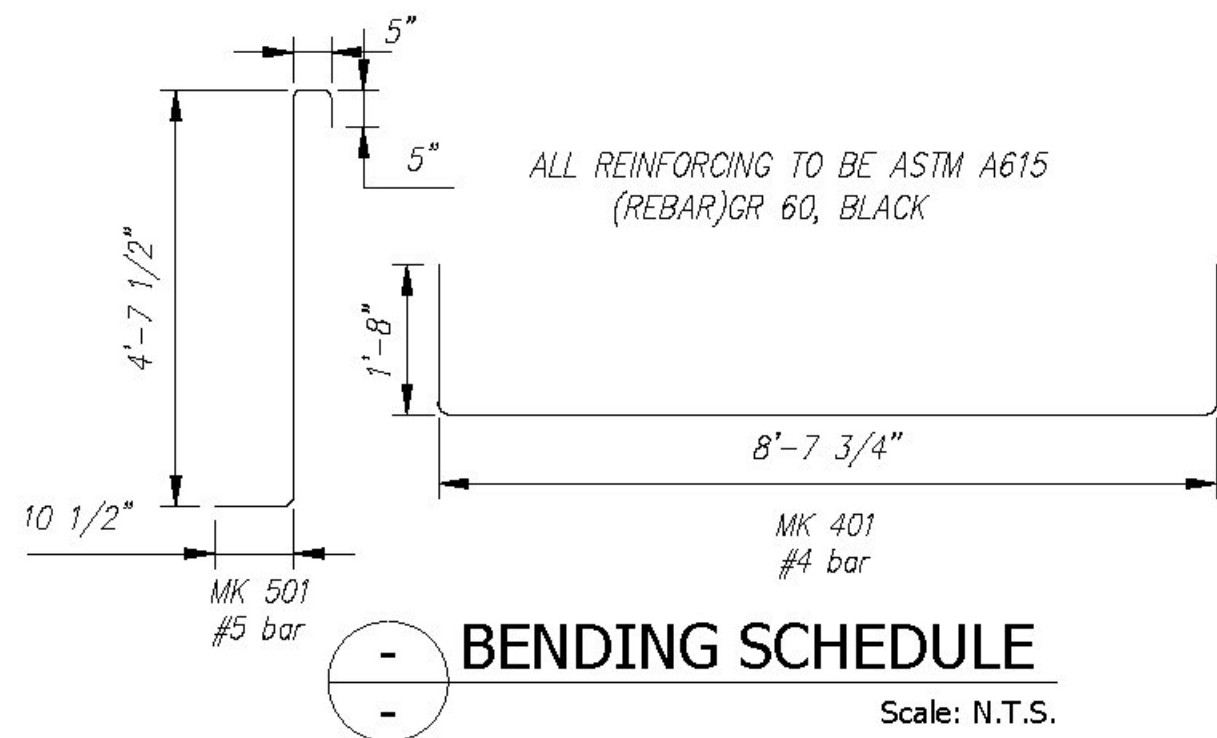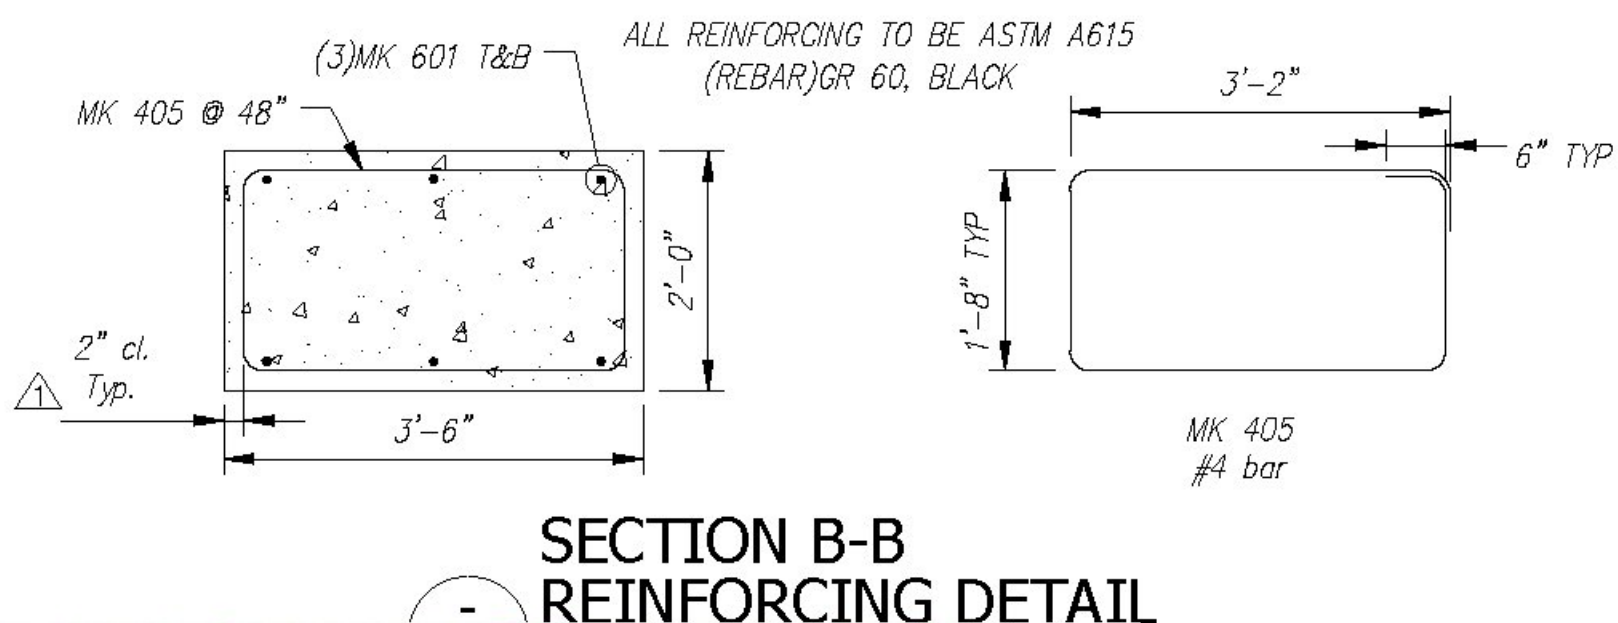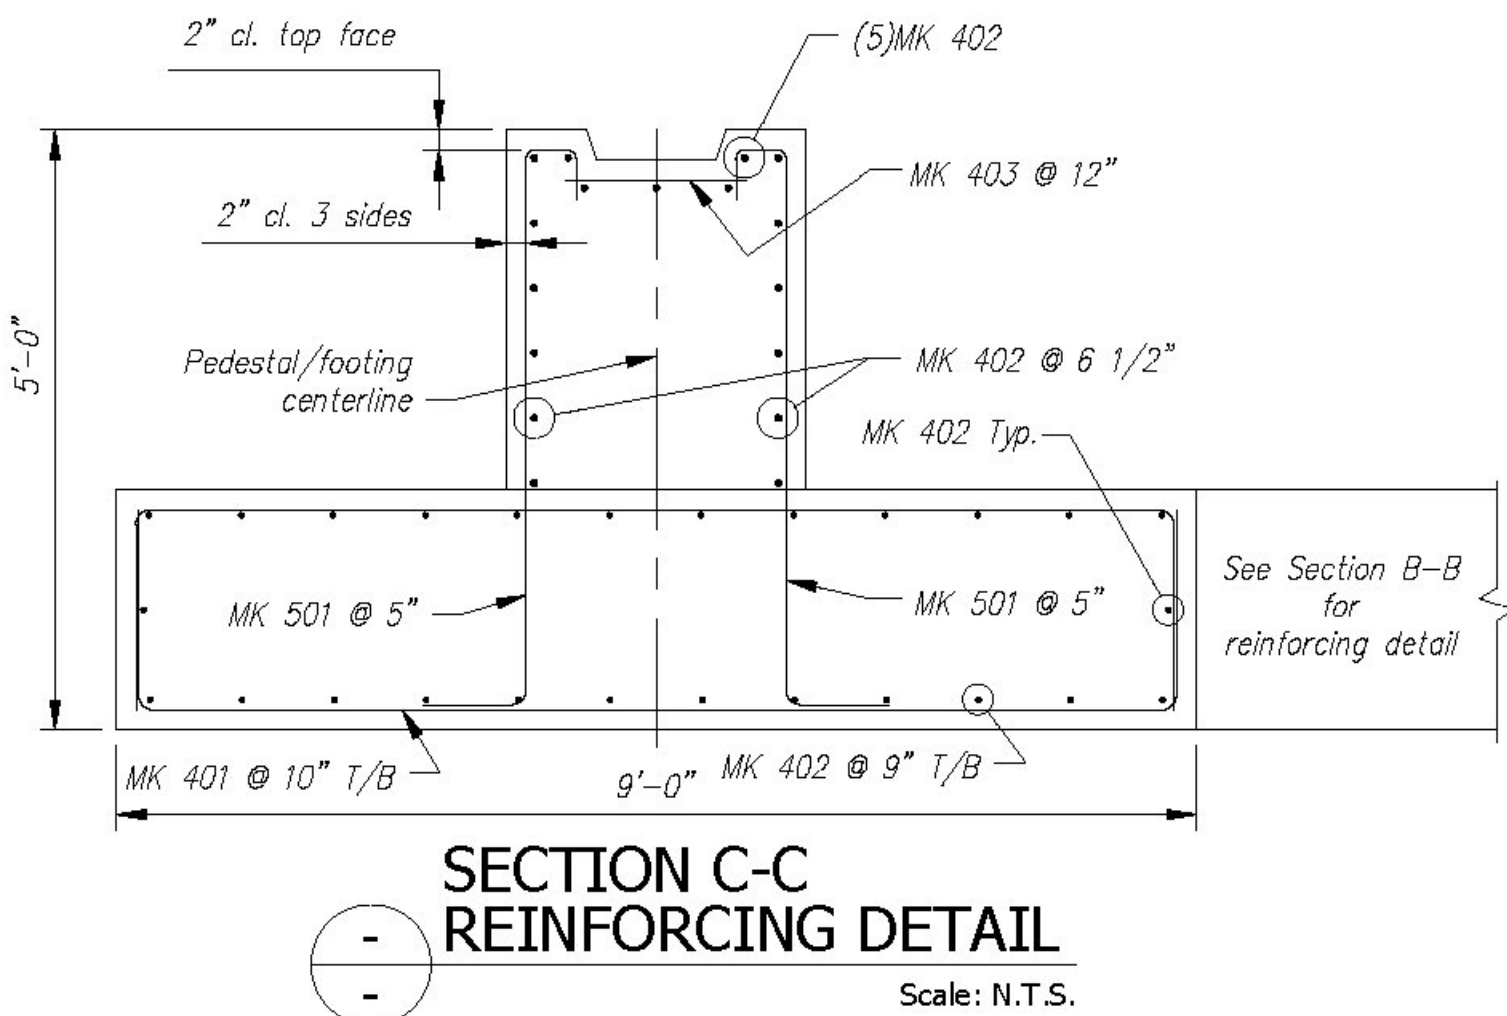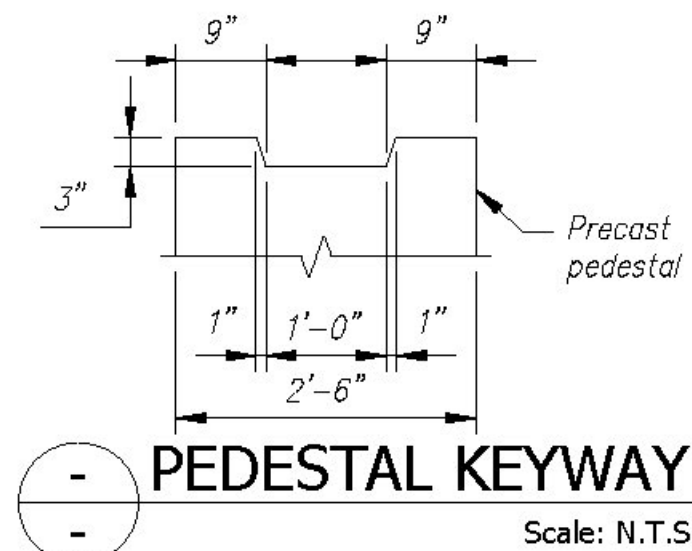

Contractor is to verify that all information shown on drawings has been thoroughly checked, complies with the contract documents and is adequate to meet the field conditions. Some dimensions and details may differ from those shown on drawings and shall be subject to change without notice. Approval of this drawing indicates that any deviation from the contract documents has been reviewed and found to be acceptable. Production will not commence until receipt of signed, approved shop drawings.

This drawing contains information proprietary to CONCRETE SYSTEMS, INC. It is disclosed with the understanding that it will be retained in confidence and not be reproduced or transmitted in any form or by any means electronic or mechanical, including photocopying, recording, or by any information storage and retrieval system, without the prior written permission of CONCRETE SYSTEMS, INC. and that it will be returned to CONCRETE SYSTEMS, INC. upon request.

Vermont Agency of Transportation

RECEIVED

CK'D BY CLB OK'D BY HIS

July 22, 2015

RESUBMIT NO Approved  
BY C. CARLSON DATE 07/23/15

Following documents and/or sources:

GE PROJECT, TOWN OF RICHFORD


DATED 2011

Concrete Systems Inc.  
9 Commercial St., Hudson, NH, 03051  
Phone 603-889-4163  
Fax 603-889-2417


STATE AGENCY  
VTTrans  
Drawn By: R. YEAGER  
Reviewed By: B. KOLAWOLE  
Approved By: C. VICK  
Date: 16APR2015  
Date: 17JUN2015

G.W. TATRO CONSTRUCTION, INC.  
VT/AOT BRIDGE REPLACEMENT- ROAD IMPROVEMENT  
RICHFORD, VT.  
SHOP DRAWING F2  
C22312-F2  
Quantity: 1 Project No: BRFO30229 SHEET 10 OF 14  
REV 1




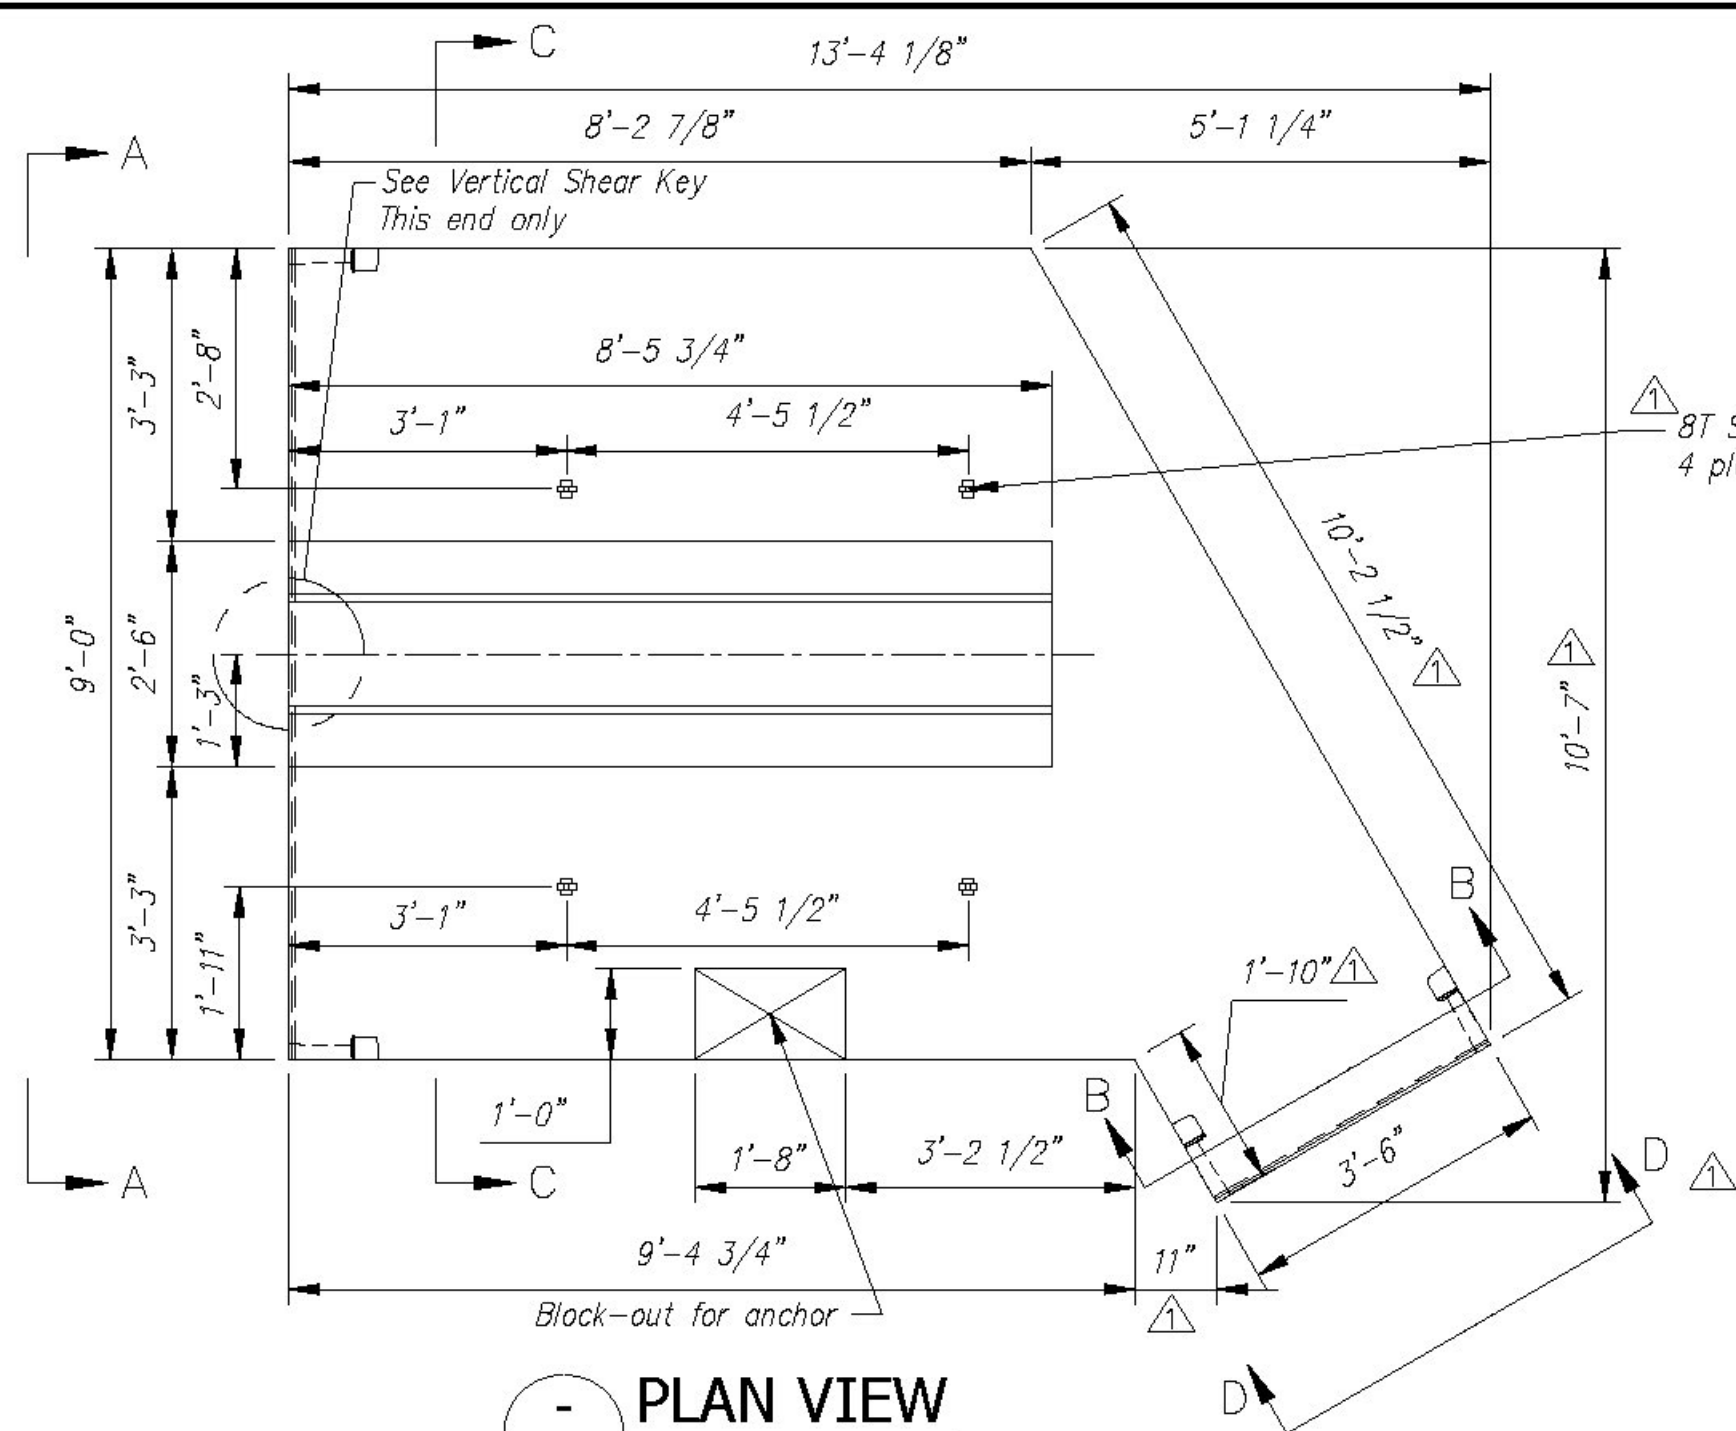

PLAN VIEW  
Scale: 3/8" = 1'-0"

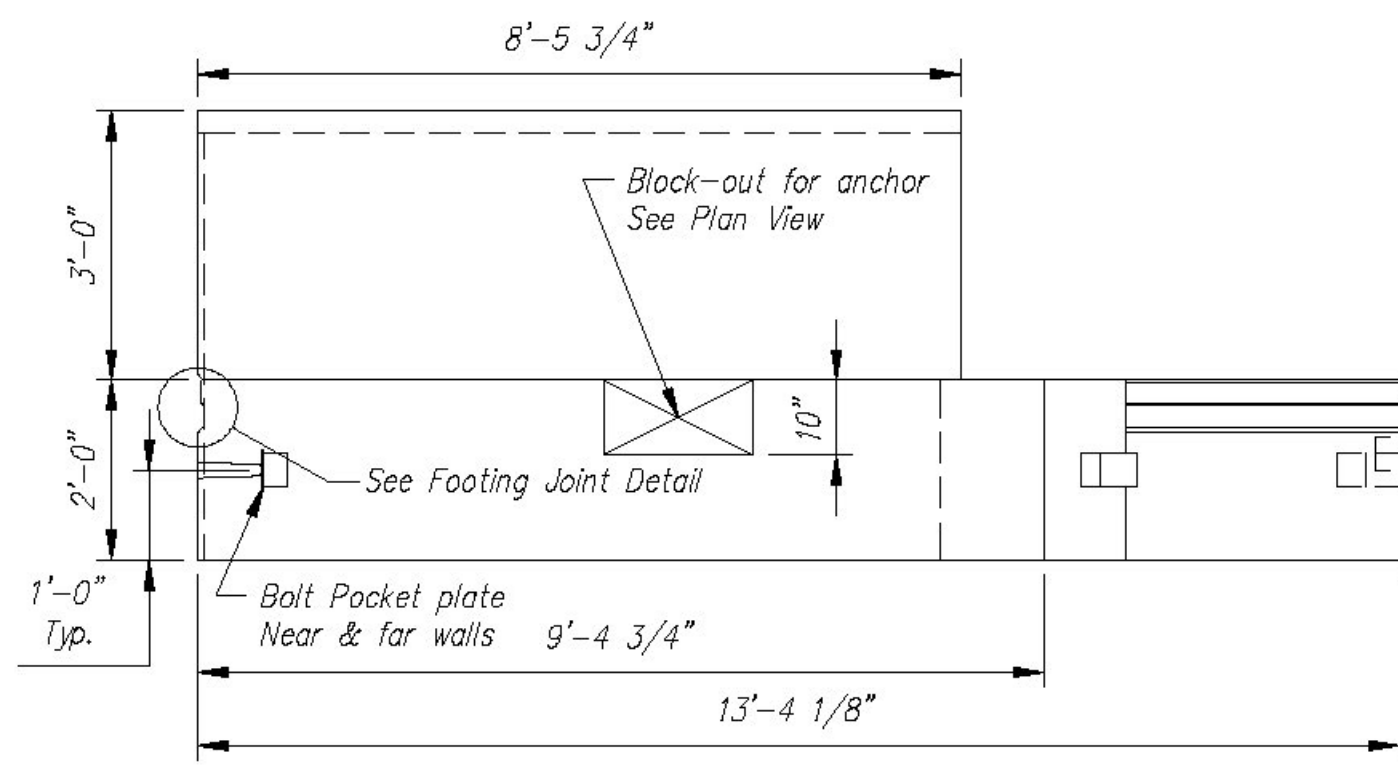


ELEVATION  
Scale: 3/8" = 1'-0"

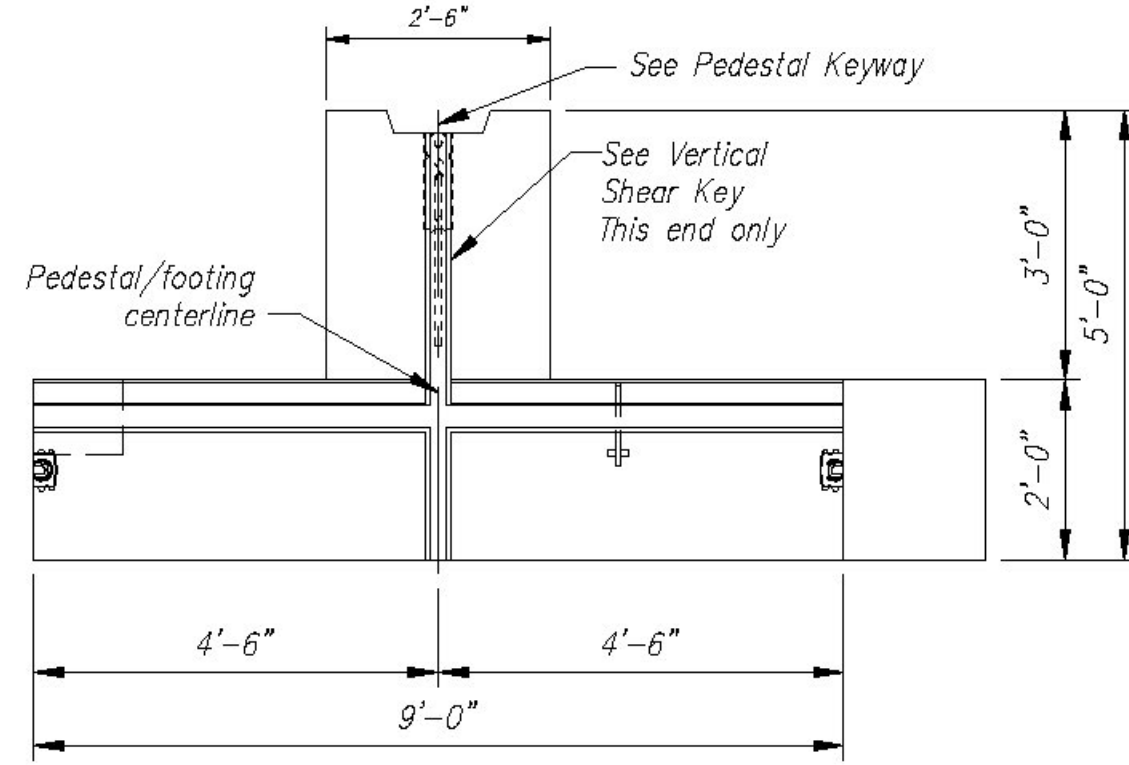


ELEVATION A-A  
Scale: 3/8" = 1'-0"

Fig. Slab - F3A Rebar Schedule			
MK	QTY	LENGTH	
401 #4	22	12'-0"	
402 #4	26	9'-4"	
405 #4	2	10'-8"	
501 #5	40	6'-4"	
601 #6	6	9'-10"	


Fig. Pedestal-F3A Rebar Schedule		
MK	QTY	LENGTH
402 #4	17	8'-3"
403 #4	9	1'-8"

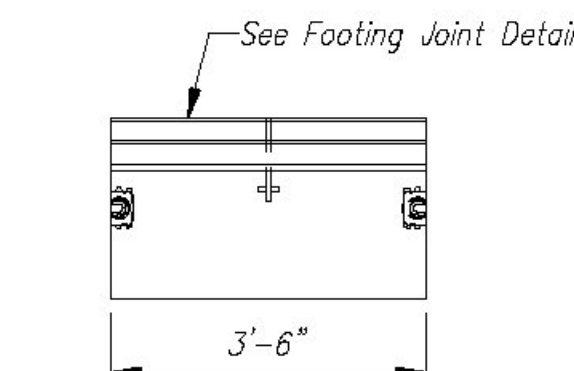


VIEW D-D  
Scale: N.T.S.

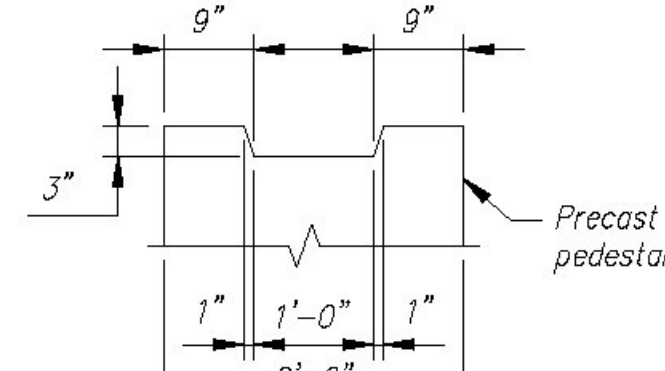


PEDESTAL KEYWAY  
Scale: N.T.S.

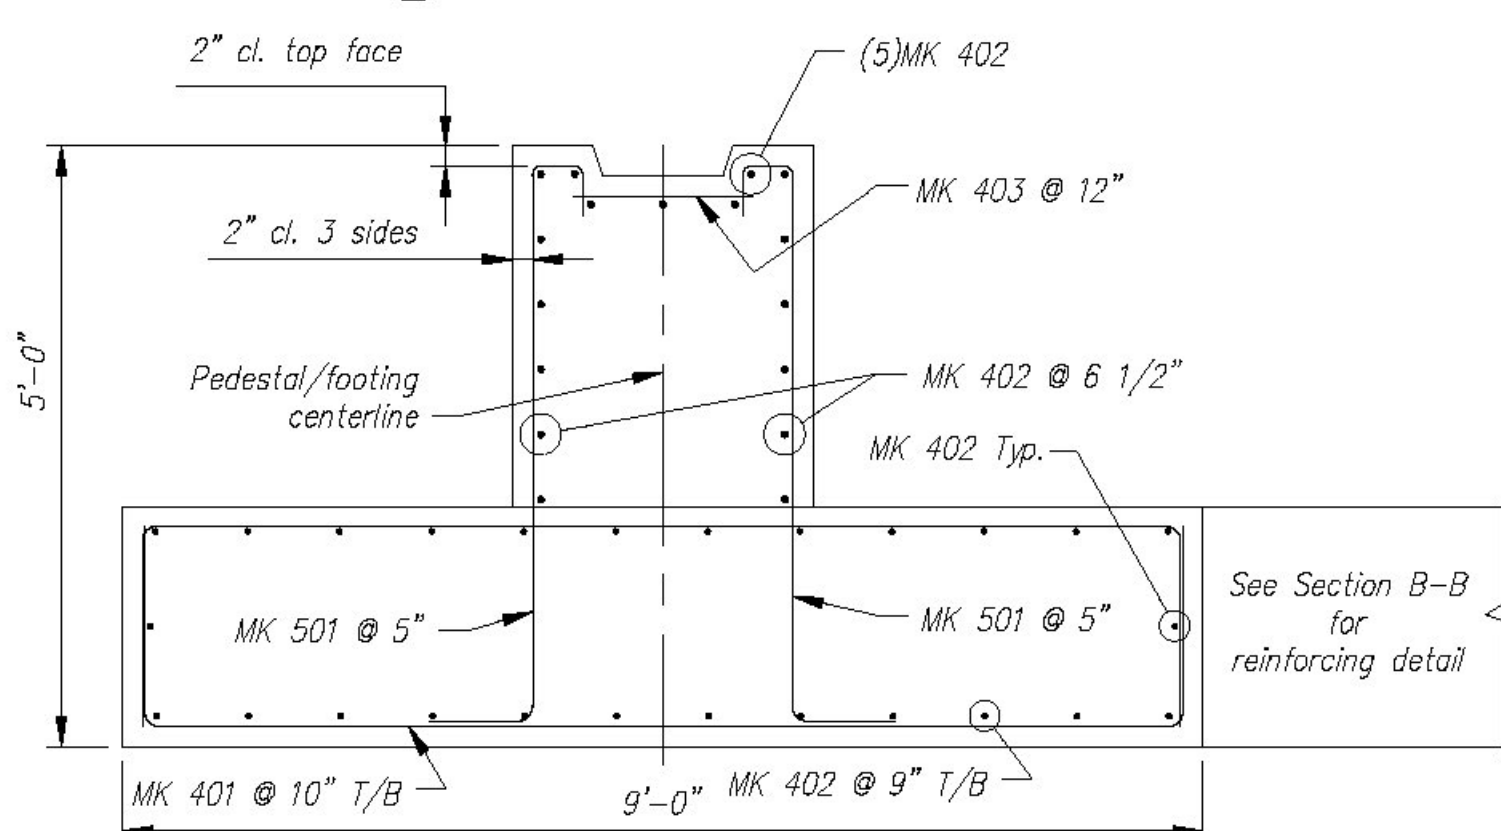


SECTION C-C  
REINFORCING DETAIL  
Scale: N.T.S.

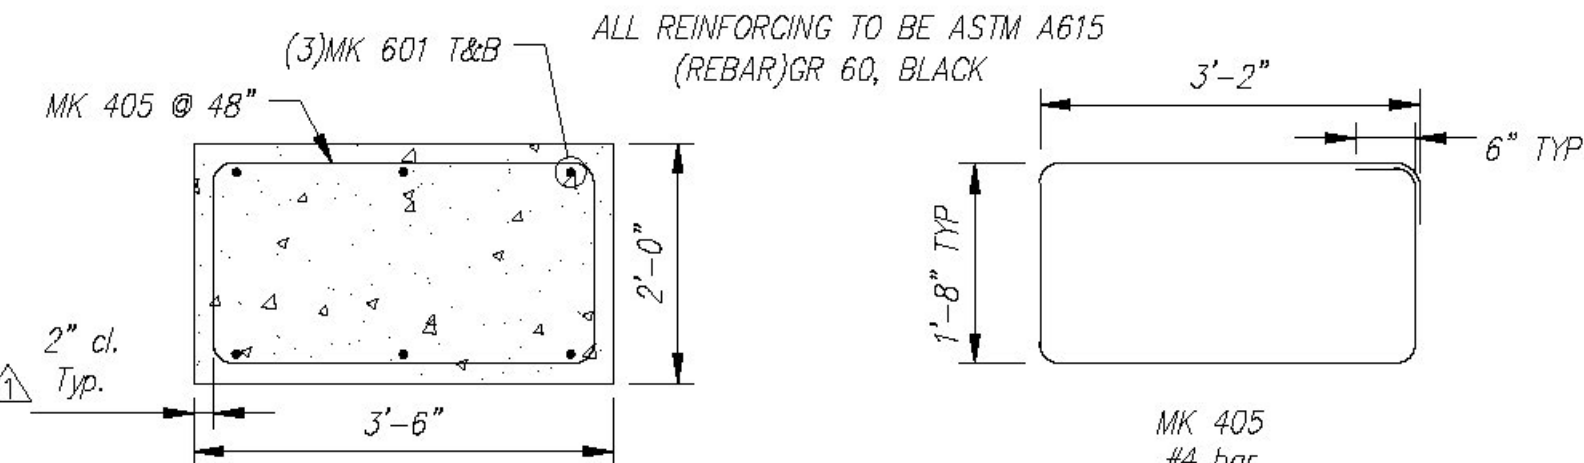


SECTION B-B  
REINFORCING DETAIL  
Scale: N.T.S.

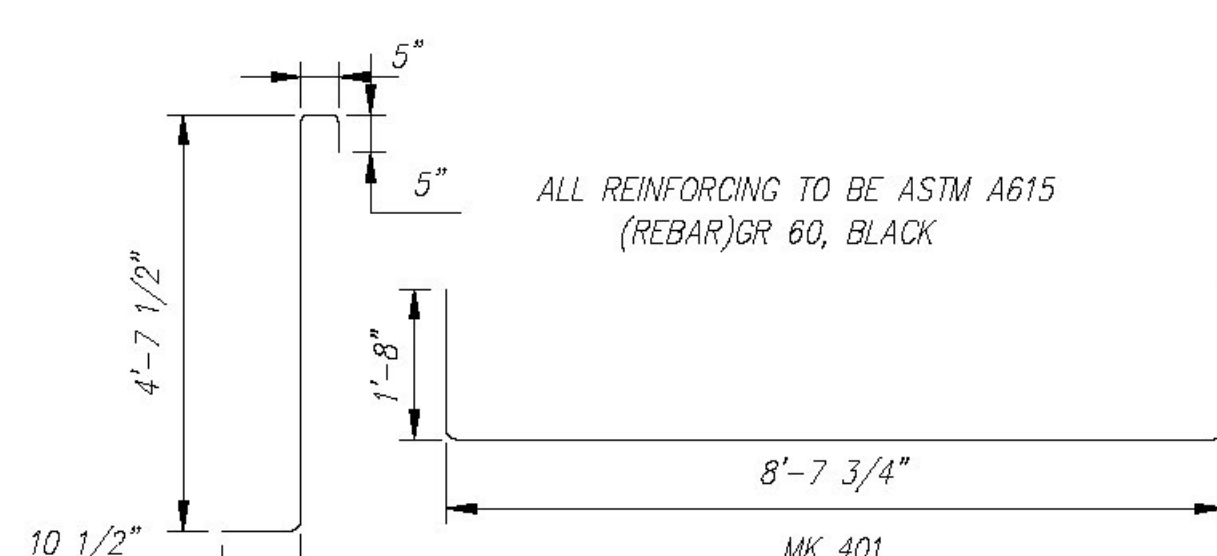

BENDING SCHEDULE  
Scale: N.T.S.

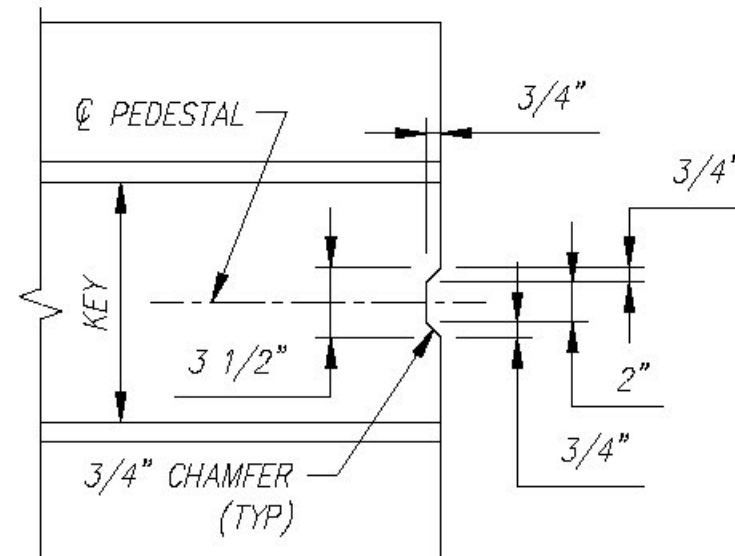

VERTICAL SHEAR KEY  
Scale: N.T.S.

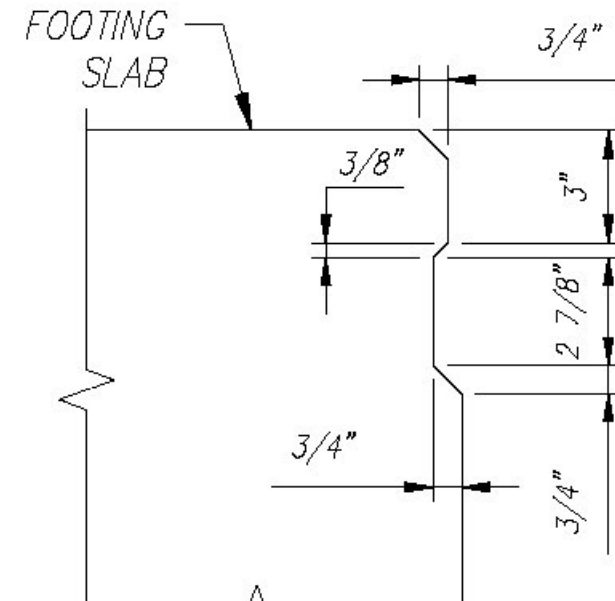

JOINT DETAIL  
Scale: N.T.S.

QUANTITY = 1  
WEIGHT = 19.85 TONS

FOOTING SLAB - F3A - BILL OF MATERIALS / EMBEDS				
CSI ID#	DESCRIPTION	QTY	UM	COMMENTS
EM-00078	8T SPREAD ANCHOR #FL119/P94	4	EA	
EM-00125	BOLT POCKET PLATE (GALVANIZED)	4	EA	
RM-00013	REBAR #4 BLACK-GR 60	353	LB	
RM-00015	REBAR #5 BLACK-GR 60 40'	264	LB	
RM-00017	REBAR #6 BLACK-GR 60 40'	89	LB	
MX-FA5000SC30	MIX DESIGN - FLY ASH 5000 SELF CONSOLIDATING	7.44	CY	
FOOTING PEDESTAL - F3A - BILL OF MATERIALS / EMBEDS				
RM-00013	REBAR #4 BLACK-GR 60	104	LB	
MX-FA5000SC30	MIX DESIGN - FLY ASH 5000 SELF CONSOLIDATING	2.26	CY	

Contractor is to verify that all information shown on drawings has been thoroughly checked, complies with the contract documents and is adequate to meet the field conditions. Some dimensions and details may differ from those shown on drawings. The contractor shall be responsible for the design process. Approval of this drawing indicates that the contractor has reviewed the contract documents and found them to be acceptable. Production will not commence until receipt of signed, approved shop drawings.

This drawing contains information proprietary to CONCRETE SYSTEMS, INC. It is to be used only for the project and site identified herein. It is to be disclosed only to those personnel who are authorized to use it. It is to be returned to CONCRETE SYSTEMS, INC. upon request.

Rev.	Date	Description	By
1	14MAY2015	REVISED PER CUSTOMER REVIEW, ADDED BOLT POCKETS, REVISED ANCHOR LOCATIONS	
2			
3			
4			
5			
6			
7			
8			
9			
10			

Following documents and/or sources:  
GE PROJECT, TOWN OF RICHFORD  
DATED 2011

**CSI**  
Concrete Systems Inc.  
9 Commercial St., Hudson, NH 03051  
Phone 603-889-4163  
Fax 603-889-2417

STATE AGENCY  
VTTrans  
Drawn By: R. YEAGER  
Reviewed By: B. KOLAWOLE  
Approved By: C. VICK  
Date: 16APR2015  
Date: 17JUN2015

G.W. TATRO CONSTRUCTION, INC.  
VT/AOT BRIDGE REPLACEMENT- ROAD IMPROVEMENT  
RICHFORD, VT.  
SHOP DRAWING F3A  
C22312-F3A  
Quantity: 1  
Project No: BRFO30229  
REV 1  
SHEET 11 OF 14








Vermont Agency of Transportation  
**RECEIVED**

CK'D BY CLB  
OK'D BY HIS  
July 22, 2015  
RESUBMIT NO  
BY C. CARLSON  
Approved  
DATE 07/23/15







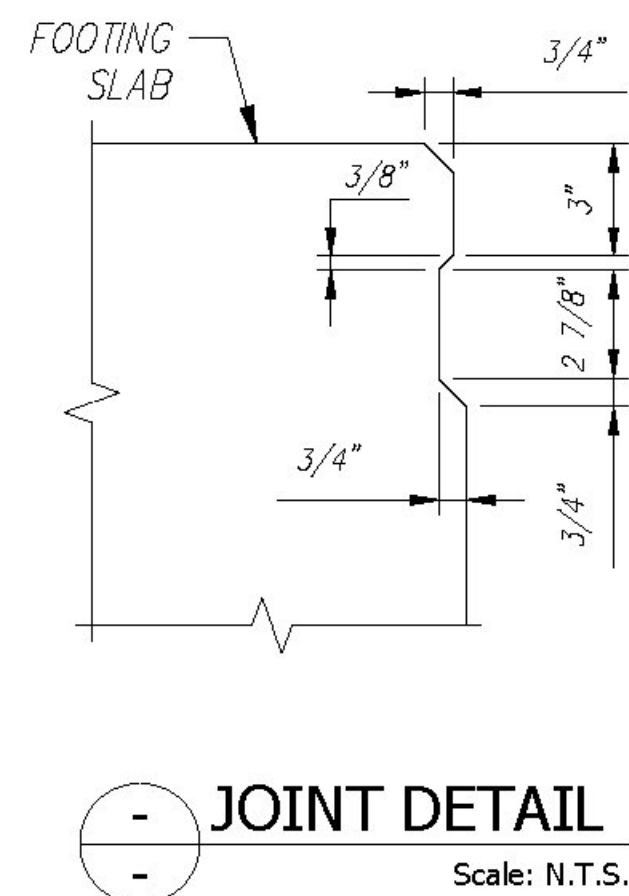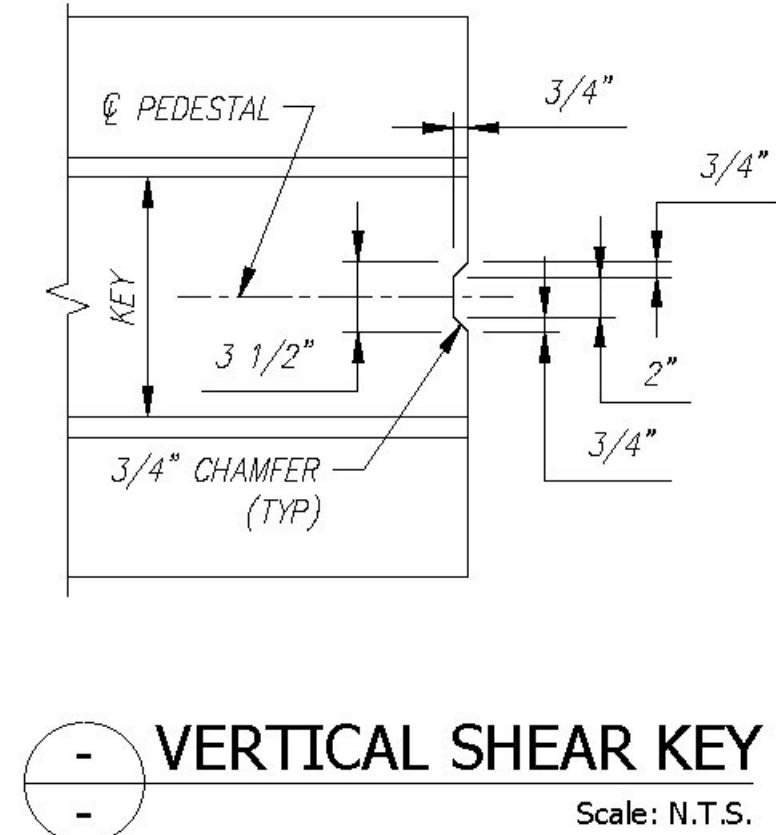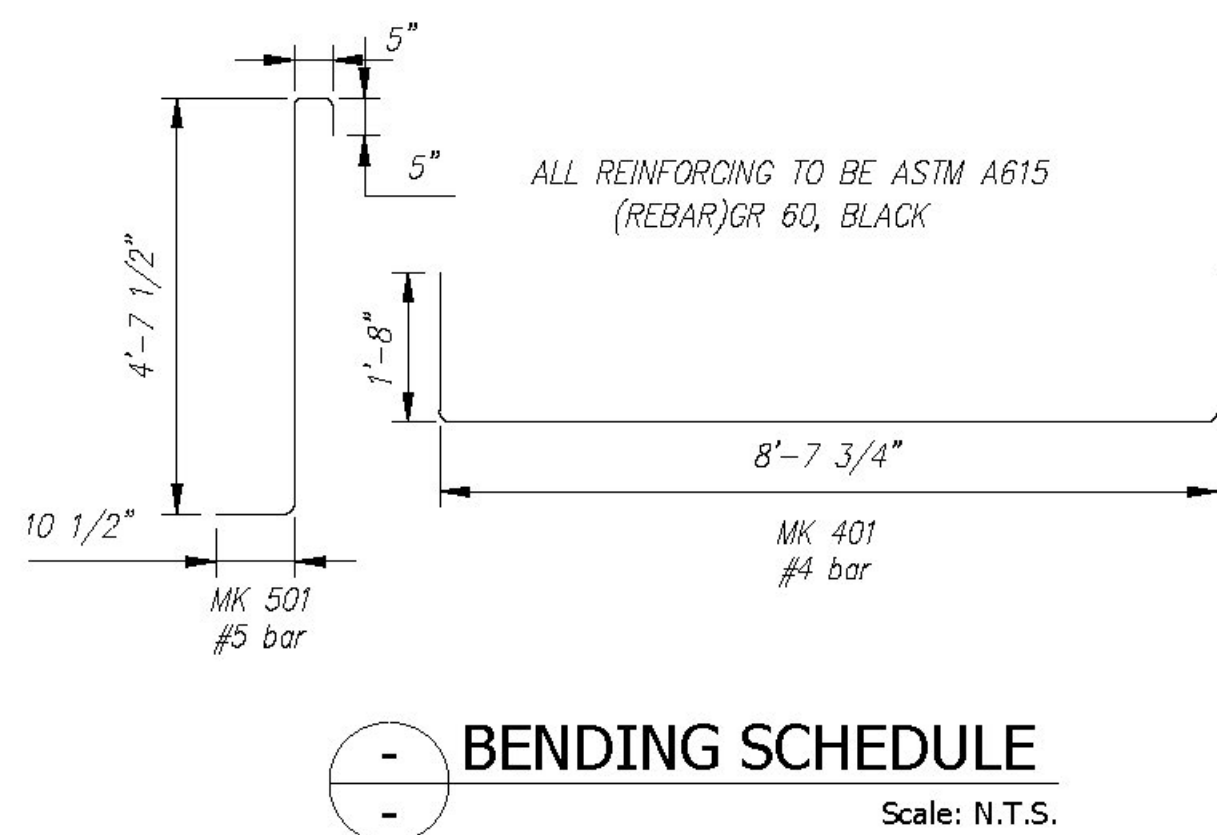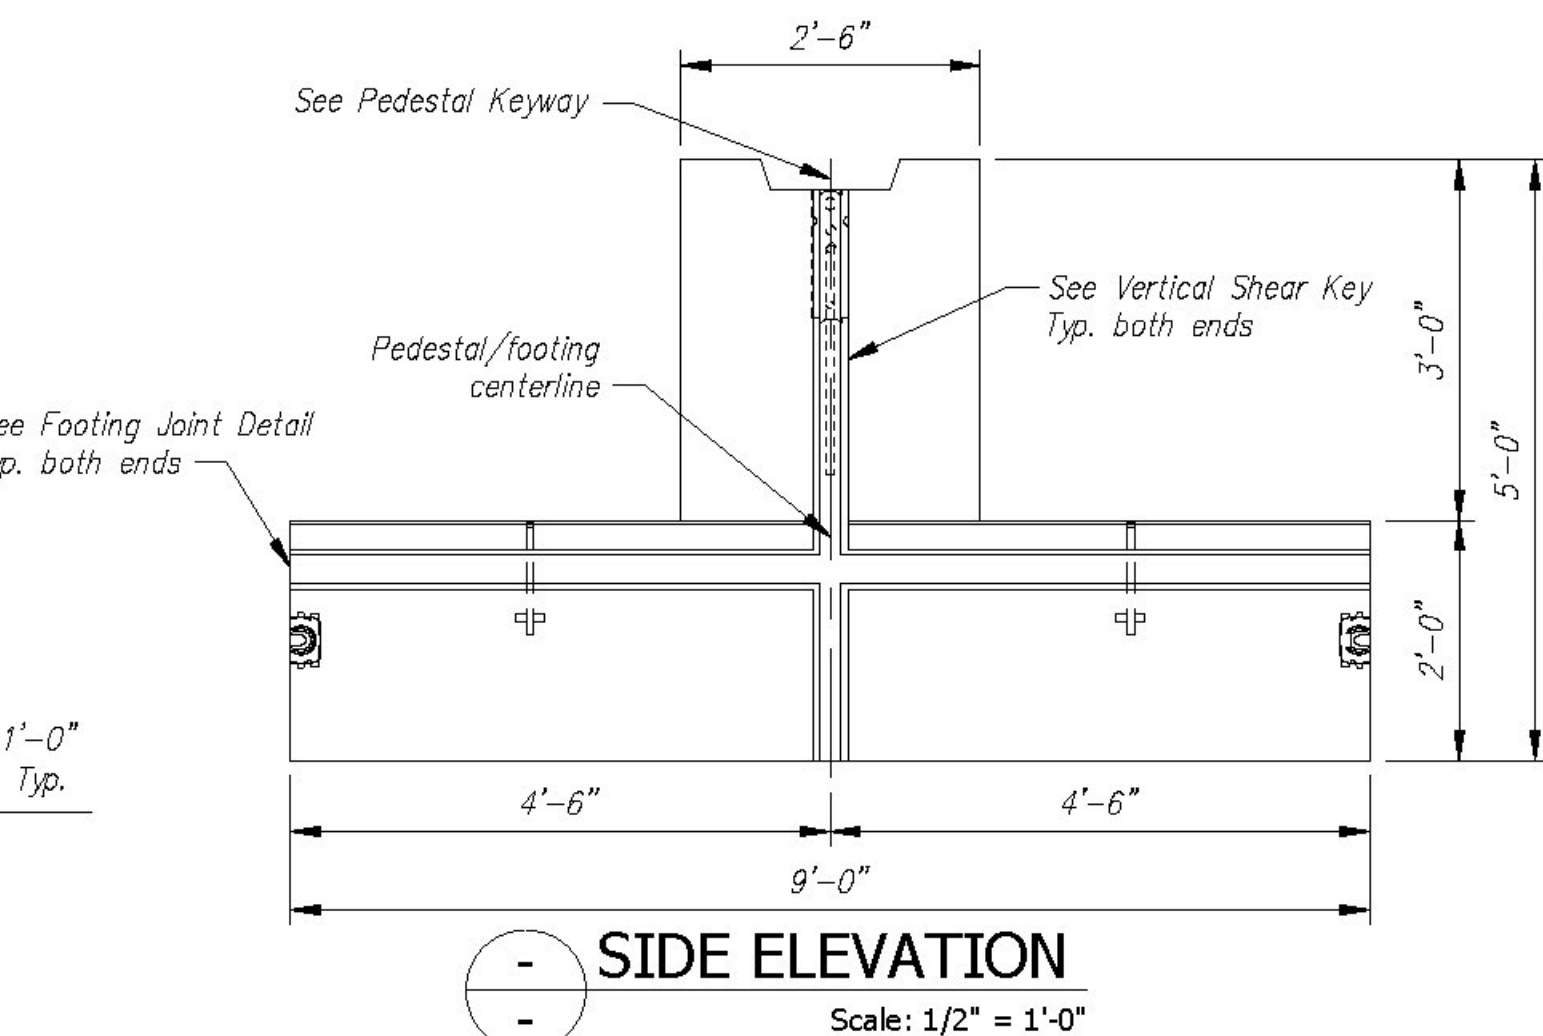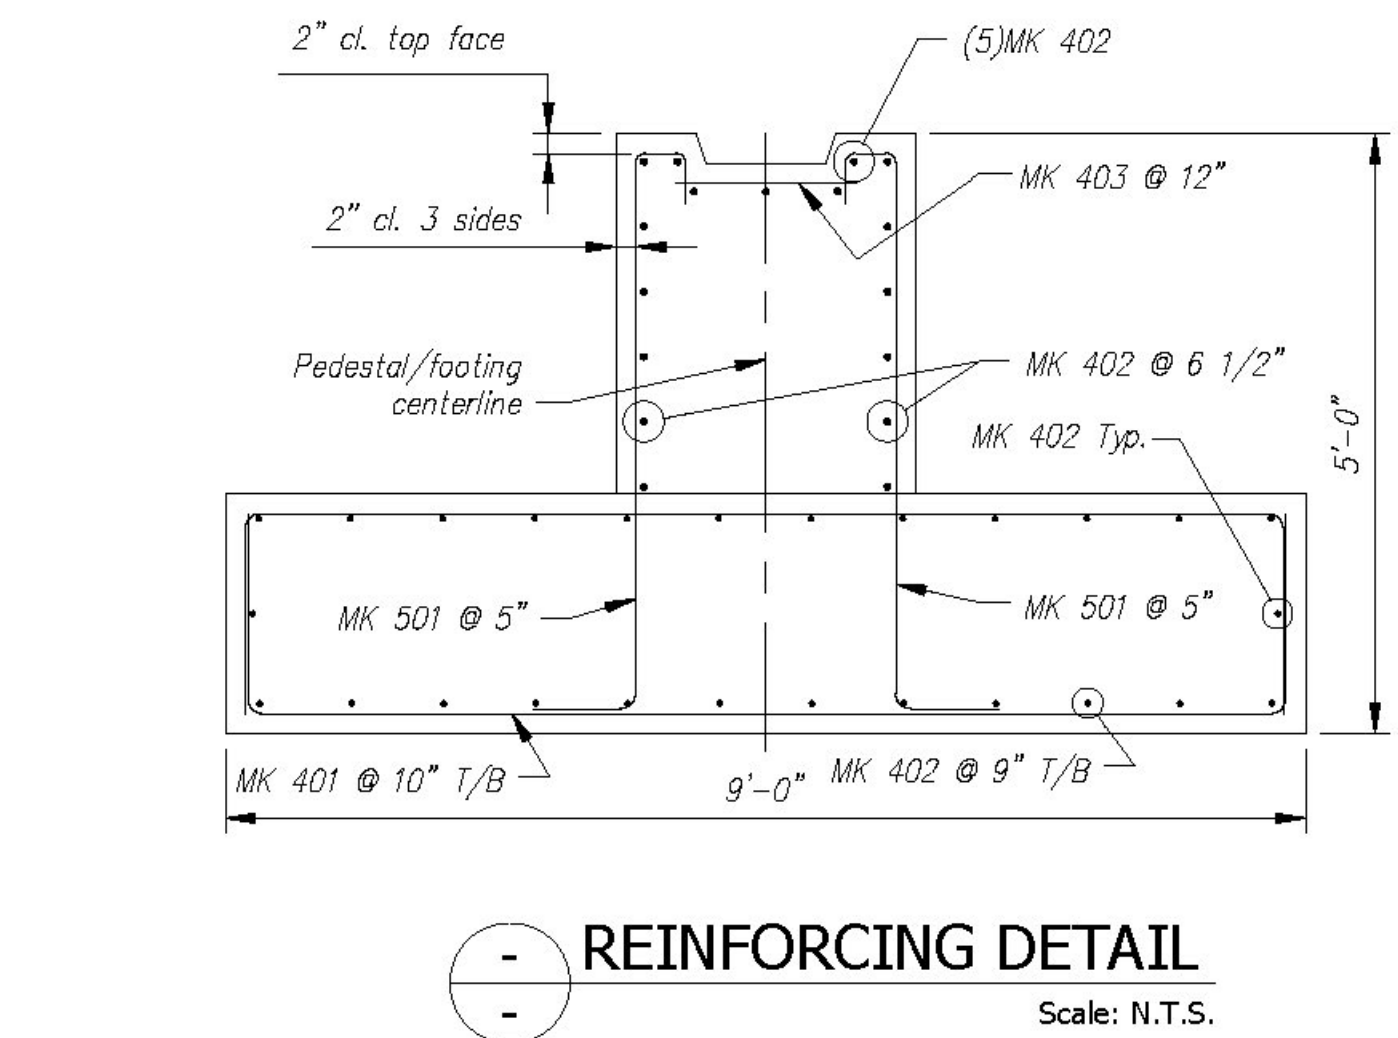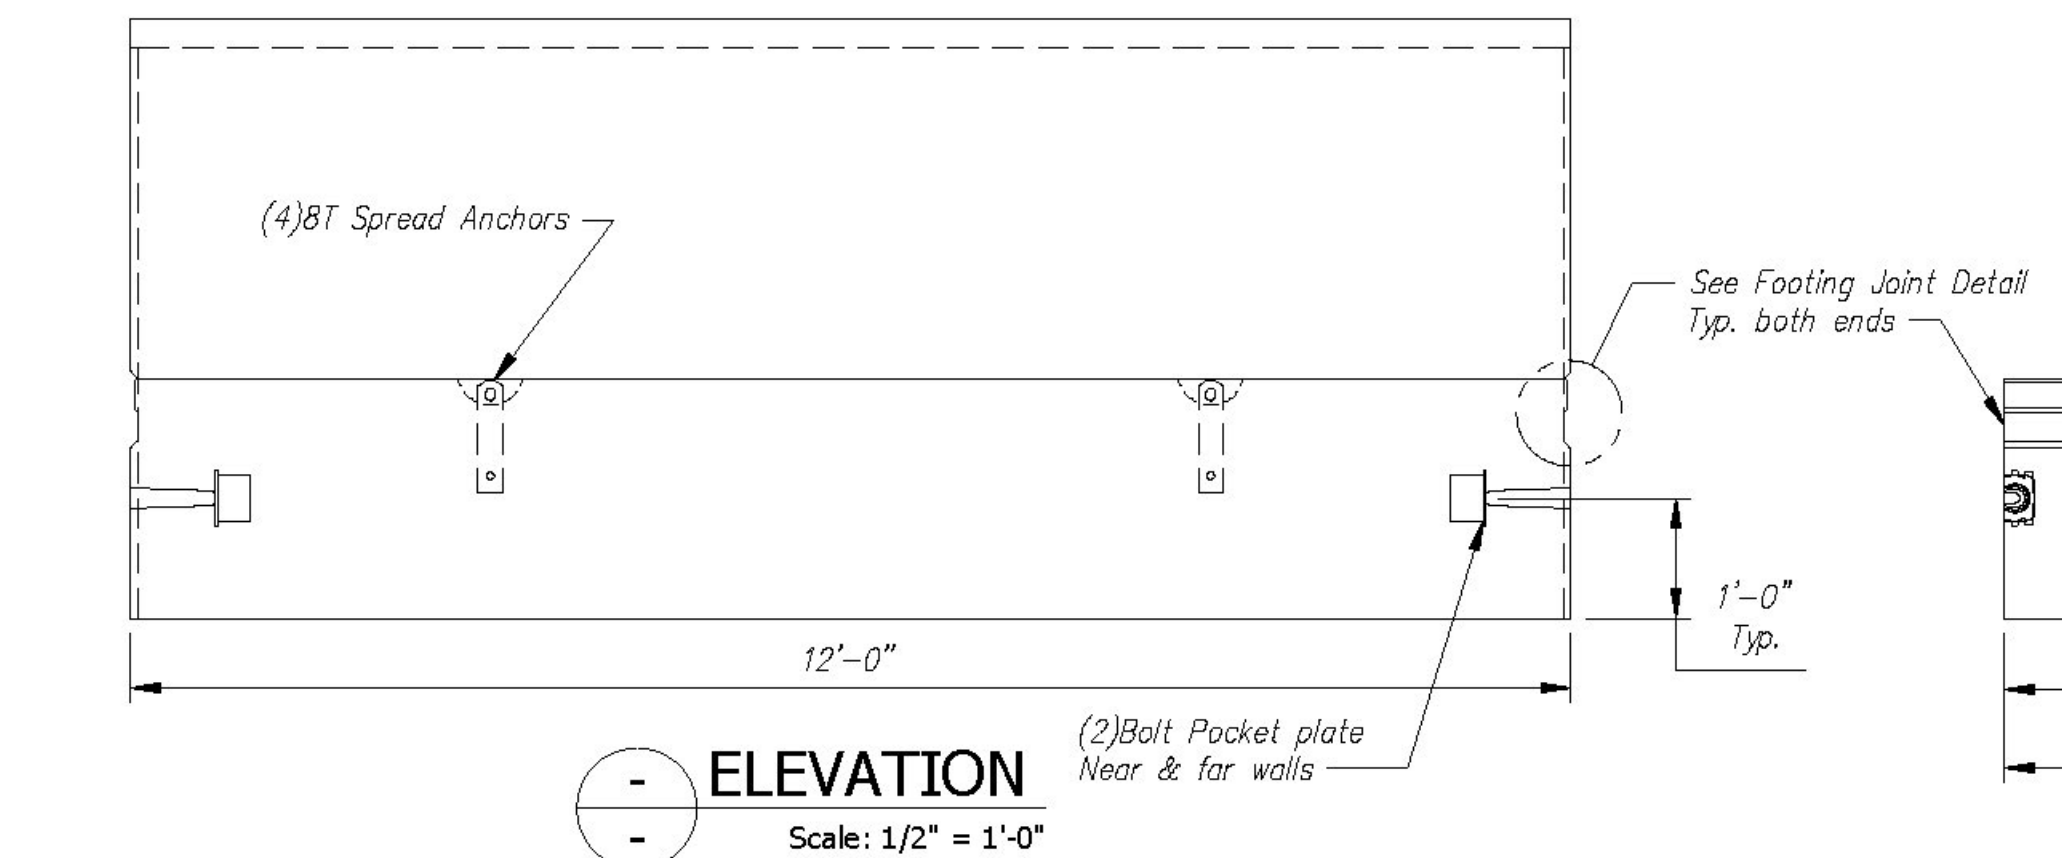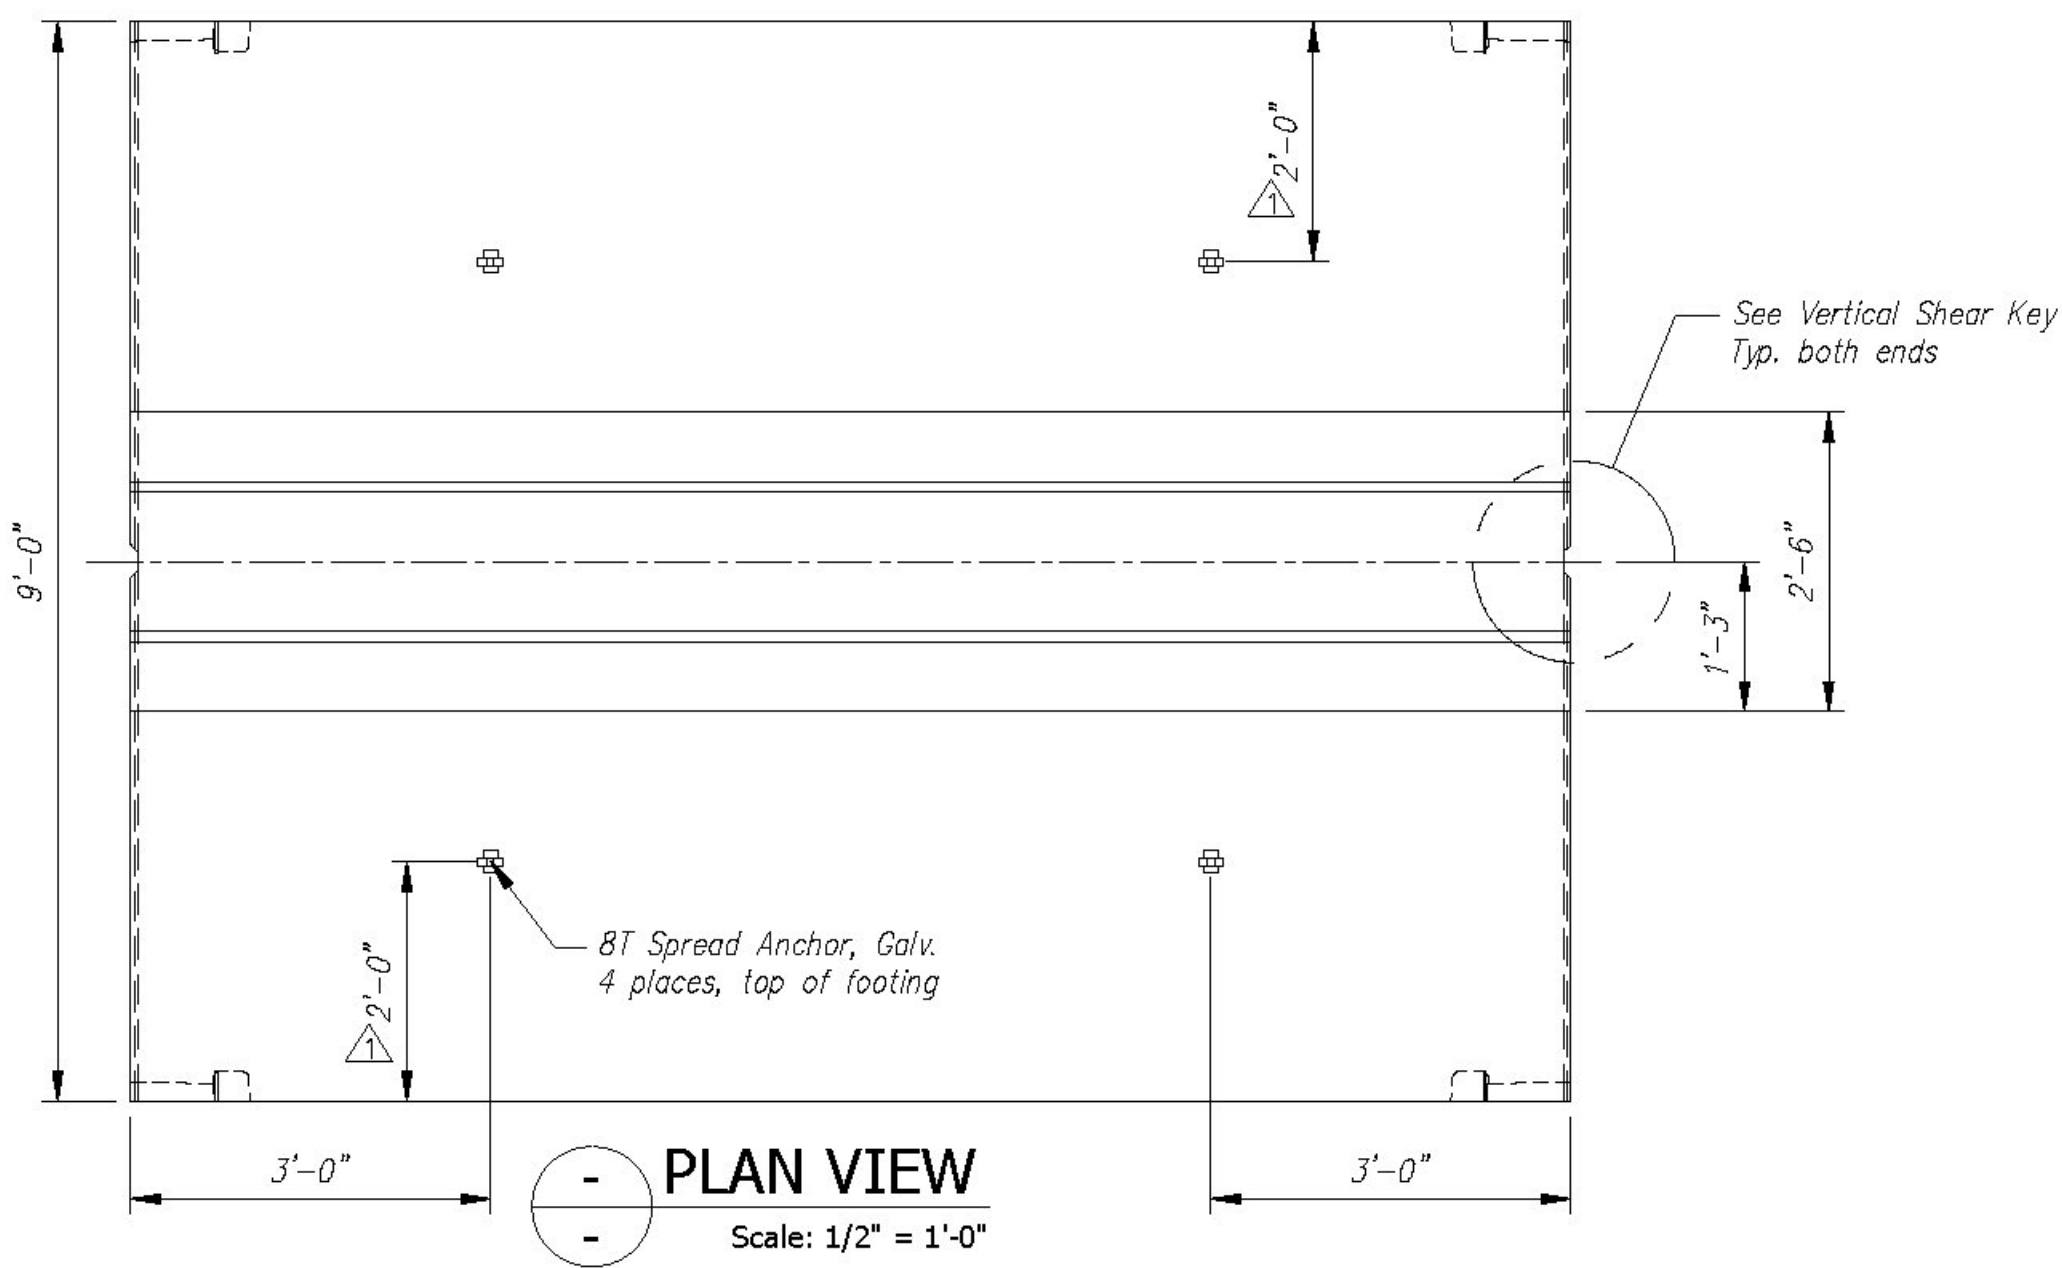

FOOTING SLAB - F5 - BILL OF MATERIALS / EMBEDS				
CSI ID#	DESCRIPTION	QTY	UM	COMMENTS
EM-00078	8T SPREAD ANCHOR #FL119/P94	4	EA	
EM-00125	BOLT POCKET PLATE (GALVANIZED)	4	EA	
RM-00013	REBAR #4 BLACK- GR 60	445	LB	
RM-00015	REBAR #5 BLACK-GR 60 40'	383	LB	
MX-FA5000SC30	MX DESIGN - FLY ASH 5000 SELF CONSOLIDATING	7.86	CY	
FOOTING PEDESTAL - F5 - BILL OF MATERIALS / EMBEDS				
RM-00013	REBAR #4 BLACK- GR 60	147	LB	
MX-FA5000SC30	MX DESIGN - FLY ASH 5000 SELF CONSOLIDATING	3.33	CY	

Fig. Slab - F5 Rebar Schedule			
MK	QTY	LENGTH	
401 #4	30	12	0 "
402 #4	26	11	9 "
501 #5	58	6	4 "


Fig. Pedestal-F5 Rebar Schedule			
MK	QTY	LENGTH	
402 #4	17	11	9 "
403 #4	12	1	8 "

QUANTITY = 1  
WEIGHT = 22.66 TONS

**Vermont Agency of Transportation**  
**RECEIVED**  
Richford Precast Frame Complete Updated Submittal_Aprroved 7.23.15.pdf

CK'D BY CLB OK'D BY HIS  
July 22, 2015

RESUBMIT NO Approved  
BY C. CARLSON DATE 07/23/15

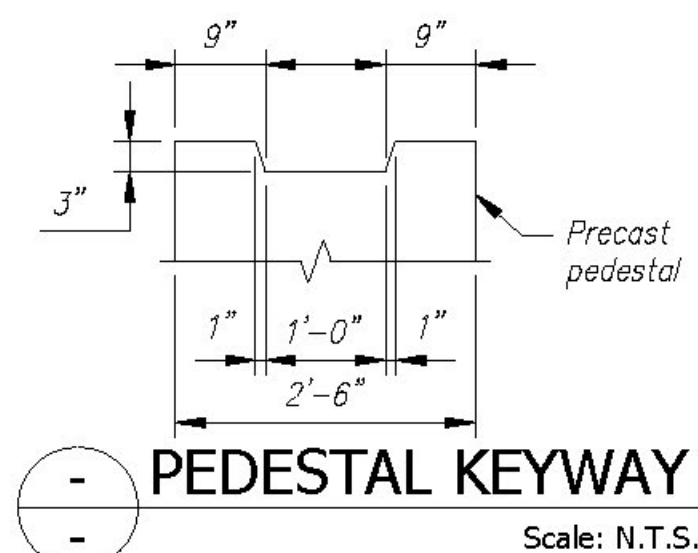

REVISIONS		DESCRIPTION	RY	By
10				
9				
8				
7				
6				
5				
4				
3				
2				
1	14MAY2015	REVISED PER CUSTOMER REVIEW, REVISED ANCHOR LOCATIONS		
Rev.	Date			

Contractor is to verify that all information shown on drawings has been thoroughly checked, complies with the contract documents and is adequate to meet the field conditions. Some dimensions and details may differ from those shown on drawings and shall be subject to the approval of the design engineer. Approval of this drawing indicates that the design engineer has reviewed the contract documents and found them to be acceptable. Production will not commence until receipt of signed, approved shop drawings.







This drawing contains information proprietary to CONCRETE SYSTEMS, INC. This drawing is disclosed with the understanding that it will be retained in confidence and not be reproduced or transmitted in any form or by any means, electronic or mechanical, including photocopying, recording, or by any information storage and retrieval system, without the prior written permission of CONCRETE SYSTEMS, INC. and that it will be returned to CONCRETE SYSTEMS, INC. upon request.

This drawing is based upon information provided from the following documents and/or sources:

Engineer: STATE OF VT/AOT PROGRAM DEVELOPMENT  
Project No:  
Drawings: STATE OF VT/AOT PROPOSED IMPROVEMENT BRIDGE PROJECT, TOWN OF RICHFORD SHEETS 1,2,4,22,23,24 OF 36  
Specifications: STANDARD SPECIFICATIONS FOR CONSTRUCTION DATED 2011  
Other: -----

<b>CSI</b> Concrete Systems Inc. 9 Commercial St., Hudson, NH 03051 Phone 603-889-4163 Fax 603-889-2417		STATE AGENCY <b>VTrans</b> Drawn By: R. YEAGER Reviewed By: B. KOLAWOLE Approved By: C. VICK Date: 16APR2015 Date: 17JUN2015	G.W. TATRO CONSTRUCTION, INC. VT/AOT BRIDGE REPLACEMENT- ROAD IMPROVEMENT RICHFORD, VT. Drawing No. C22312-F5 Quantity: 2 Project No: BRFO30229		REV 1 SHEET 13 OF 14
---------------------------------------------------------------------------------------------------------------------	--	------------------------------------------------------------------------------------------------------------------------------------------------	----------------------------------------------------------------------------------------------------------------------------------------------------------	--	-------------------------



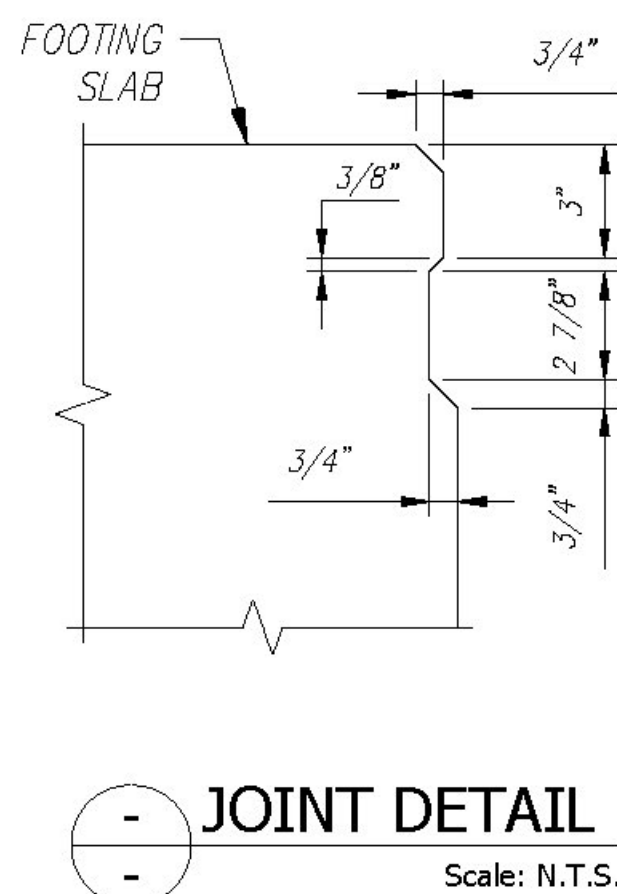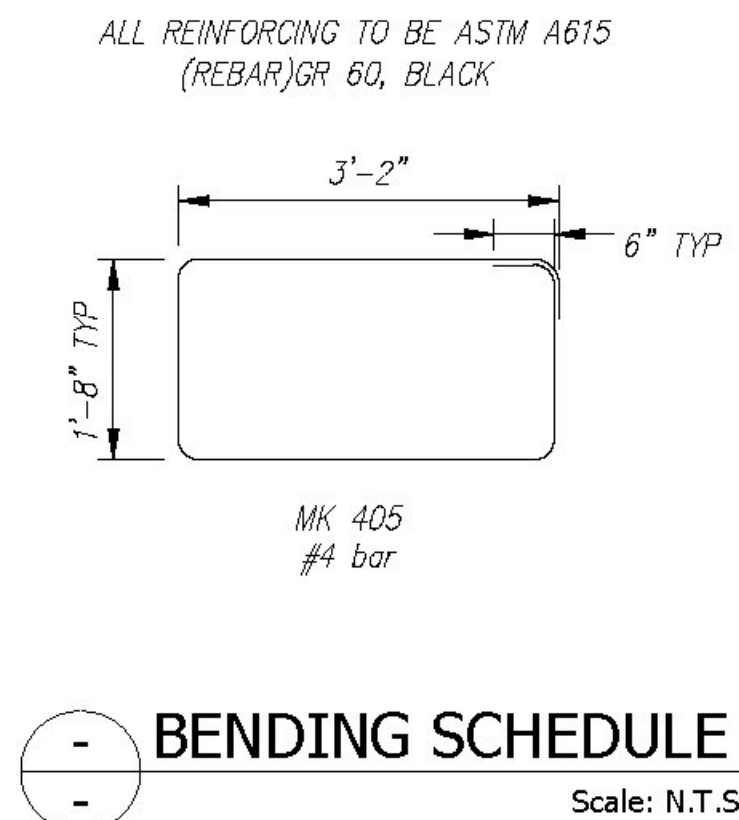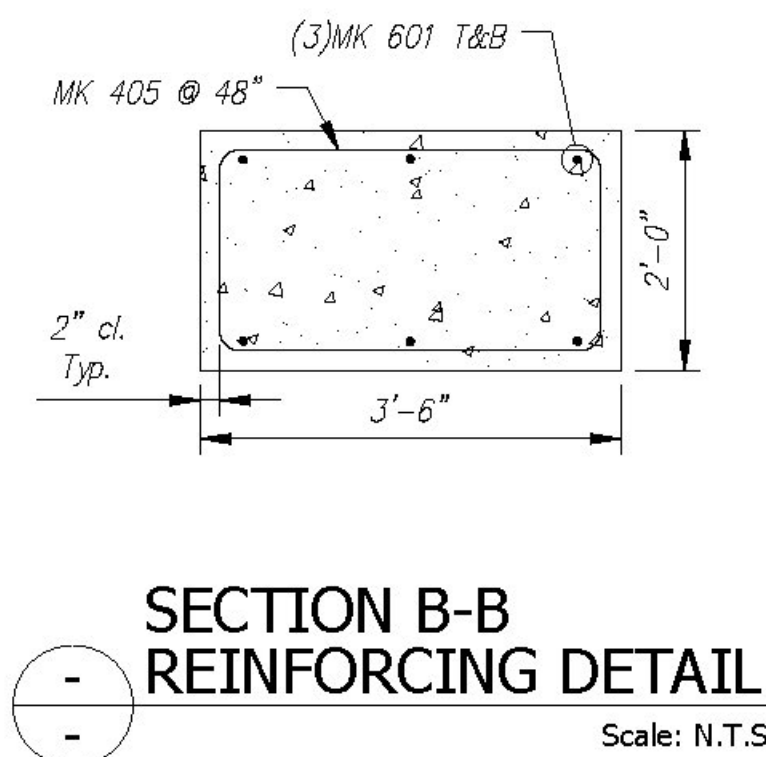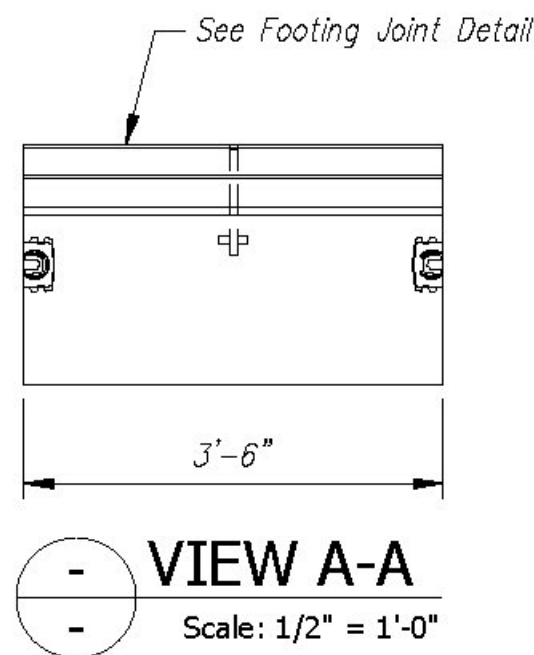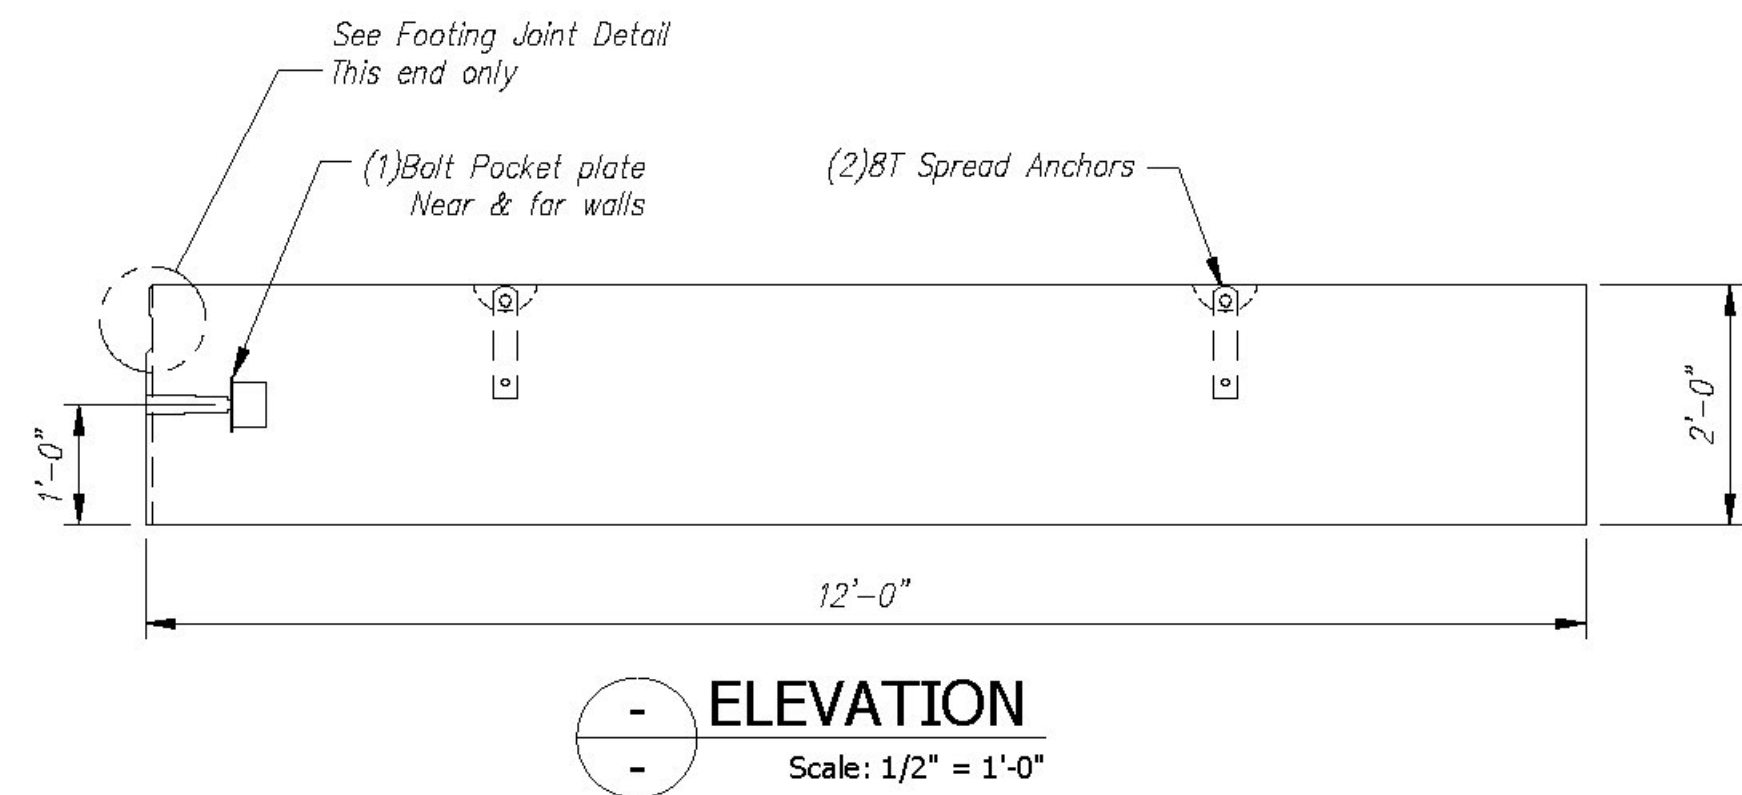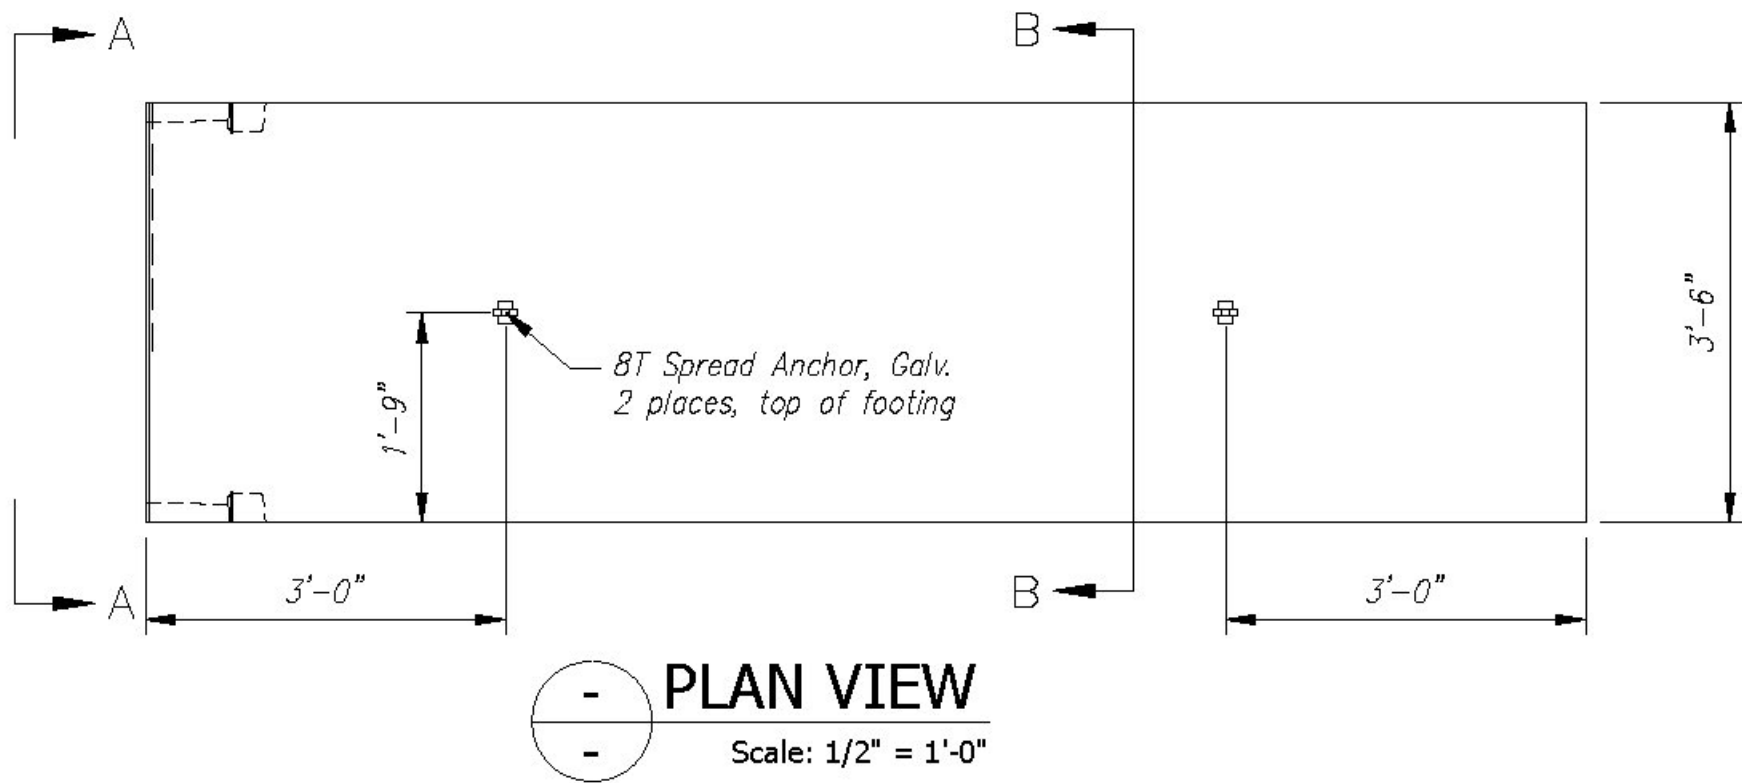

FOOTING SLAB - F3B - BILL OF MATERIALS / EMBEDS			
CSI ID#	DESCRIPTION	QTY	UM COMMENTS
EM-00078	8T SPREAD ANCHOR #FL119/P94	2	EA
EM-00125	BOLT POCKET PLATE (GALVANIZED)	2	EA
RM-00013	REBAR #4 BLACK- GR 60	29	LB
RM-00017	REBAR #6 BLACK-GR 60 40'	105	LB
MK-FA5000SC30	MIX DESIGN - FLY ASH 5000 SELF CONSOLIDATING	3.11	CY

Ftg. Slab - F3B Rebar Schedule		
MK	QTY	LENGTH
405 #4	4	10' - 8"
601 #6	6	11' - 8"

QUANTITY = 1  
WEIGHT = 6.30 TONS

Vermont Agency of Transportation  
**RECEIVED**

CK'D BY CLB OK'D BY HIS

July 22, 2015

RESUBMIT NO Approved  
BY C. CARLSON DATE 07/23/15

This drawing is based upon information provided from the following documents and/or sources:  
Engineer: STATE OF VT/AOT PROGRAM DEVELOPMENT  
Project No: ---  
Drawings: STATE OF VT/AOT PROPOSED IMPROVEMENT BRIDGE PROJECT, TOWN OF RICHFORD SHEETS 1,2,4,22,23,24 OF 36  
Specifications: STANDARD SPECIFICATIONS FOR CONSTRUCTION DATED 2011  
Other: ---

**CSI**  
Concrete Systems Inc.  
9 Commercial St., Hudson, NH, 03051  
Phone 603-889-4163  
Fax 603-889-2417

STATE AGENCY  
**VTrans**  
Drawn By: R. YEAGER  
Reviewed By: ---  
Approved By: C. VICK  
Date: 14MAY2015  
Date: 17JUN2015


G.W. TATRO CONSTRUCTION, INC.  
VT/AOT BRIDGE REPLACEMENT- ROAD IMPROVEMENT  
RICHFORD, VT.  
Drawing No. SHOP DRAWING F3B  
C22312-F3B  
Quantity: 1 Project No: BRFO30229 SHEET 14 OF 14

Contractor is to verify that all information shown on drawings has been thoroughly checked, complies with the contract documents and is adequate to meet the field conditions. Some dimensions and details may differ slightly from those shown on drawings due to field conditions. The design process approved of this drawing indicates that any deviation from the contract documents has been reviewed and found to be acceptable. Production will not commence until receipt of signed, approved shop drawings.

This drawing contains information proprietary to CONCRETE SYSTEMS, INC. It is to be used only for the project and site for which it was prepared. It is disclosed without permission from CONCRETE SYSTEMS, INC. and that it will be returned to CONCRETE SYSTEMS, INC. upon request.

Rev.	Date	DESCRIPTION
1	14MAY2015	REVISED PER CUSTOMER REVIEW, NEW FOOTING SECTION
2		
3		
4		
5		
6		
7		
8		
9		
10		



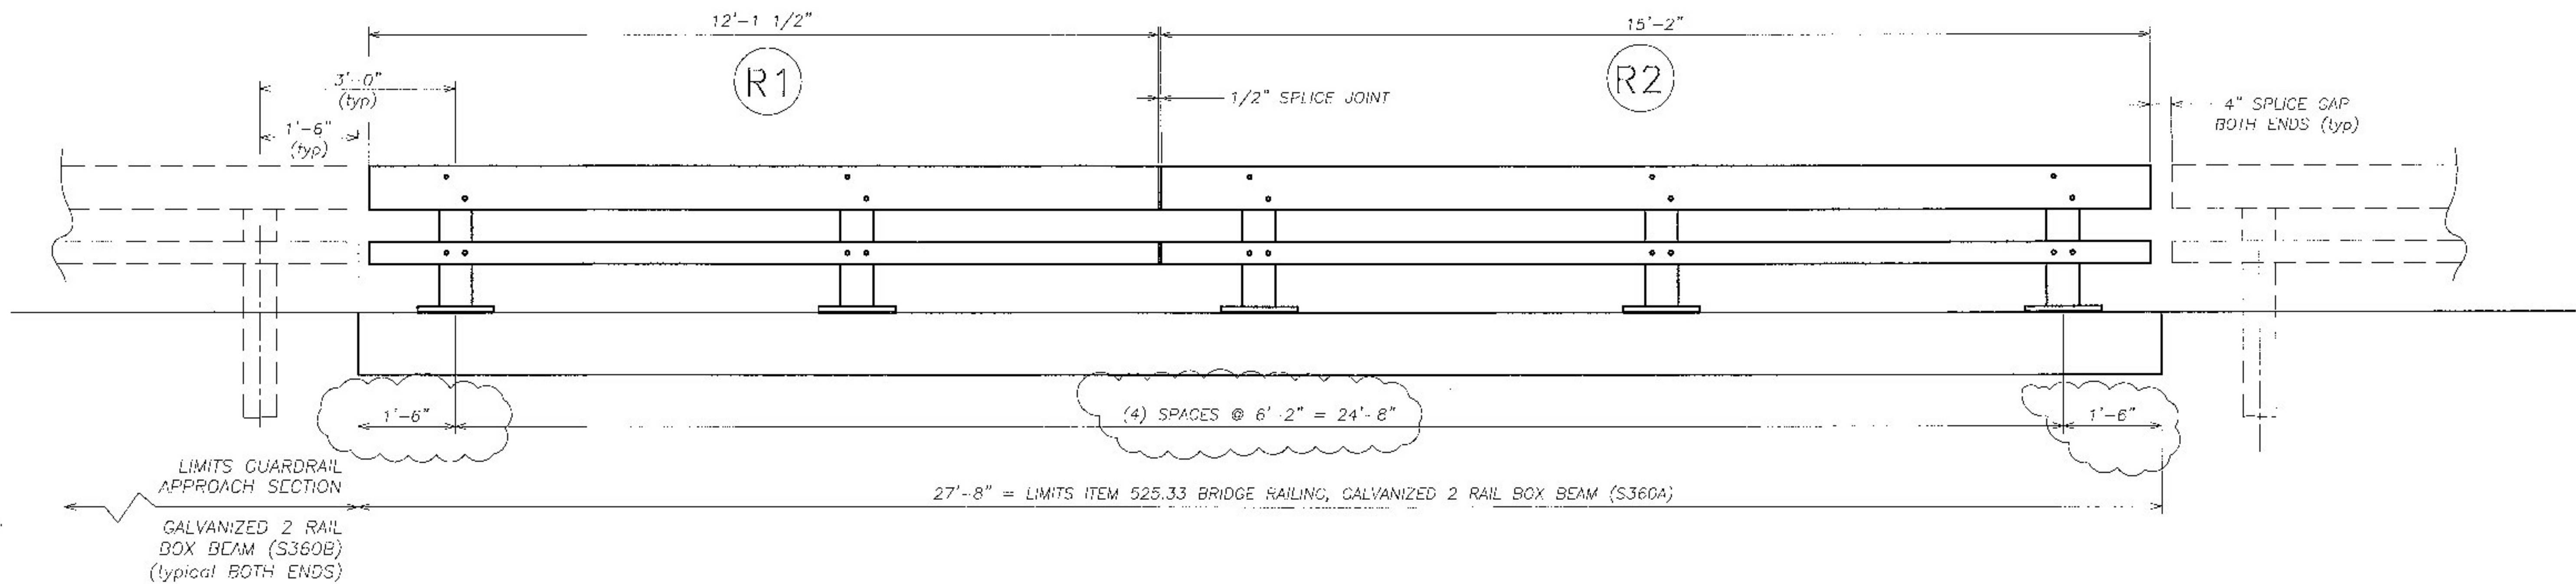

**TYPICAL RAILING ELEVATION**  
 LOOKING AT FACE OF RAILING FROM CENTERLINE OF ROAD  
 BOTH SIDES TYPICAL

### BILL OF MATERIAL





ITEM 525.33 BRIDGE RAILING, GALVANIZED 2 RAIL BOX BEAM = 56 LF

Qty	mk	Description	Spec.
10		BRIDGE RAILING POST W6 x 25 x 2'-2.375" OAH WITH 1 x 10 x 14 BASE PLATE (GLV)	A709 gr 50
2		SPLICE TUBE (FOR 8X4 RAIL) HSS 7 x 3 x 3/8 x 1'-8.000" OAL w/ TAPPED HOLES & 2 WELDED NUTS (GLV)	A500 gr B
2		SPLICE TUBE (FOR 4X4 RAIL) HSS 3 x 3 x 5/16 x 1'-8.000" OAL w/ TAPPED HOLES & 2 WELDED NUTS (GLV)	A500 gr B
2	R1	UPPER RAIL TUBE HSS 8 x 4 x 5/16 x 12'-1.500" LG (GLV) one end holes, one end slots	A500 gr B
2	R2	UPPER RAIL TUBE HSS 8 x 4 x 5/16 x 15'-2.000" LG (GLV) one end holes, one end slots	A500 gr B
2	R1	LOWER RAIL TUBE HSS 4 x 4 x 1/4 x 12'-1.500" LG (GLV) one end holes, one end slots	A500 gr B
2	R2	LOWER RAIL TUBE HSS 4 x 4 x 1/4 x 15'-2.000" LG (GLV) one end holes, one end slots	A500 gr B
10		ANCHOR SPACER PLATE PL 0.375 x 13.000 x 9.375	A709 gr 36
40		ANCHOR STUD DBL END PART THREAD - 1" DIA x 12.000 w/ 2.250" THD EACH END (GLV)	A449
80		HEAVY HEX NUT 1" (GLV)	A563 DH
40		ROUND WASHER (SAE) - 1" DIA SMALL (GLV)	F436
40		JAM NUT 1" (GALV)	A563 DH
40		ROUND HEAD POST BOLT slot or wrench head - no shoulder 3/4" DIA x 6" LG. FULL BODY (GLV)	A449 / A325
40		LOCK NUT 3/4" (GLV)	A563 DH
40		ROUND WASHER (SAE) 3/4" (GLV)	F436
16		HEX HEAD BOLT 5/8" DIA x 1.75" LG. (GLV)	A325
16		ROUND WASHER (SAE) 5/8" (GLV)	F436
10		BEARING PAD 0.125" THICK x 10.000 x 14.000 (NEOPRENE 80 duro +/-10)	aashto M251










No.	Remarks	Date
B	changes to match precast drawings	06-19-15
A	changes to match precast drawings	05-14-15
0	Initial submittal	04-28-15

<b>Vermont Agency of Transportation</b> <b>RECEIVED</b> CK'D BY FDB OK'D BY HIS <b>June 23, 2015</b> RESUBMIT No Approved BY Carolyn Carlson DATE 06/23/15		<b>HIGHWAY SAFETY CORP</b> GLASTONBURY, CT 860-633-9445 ITEM 525.33 BRIDGE RAILING, GALVANIZED 2 RAIL BOX BEAM (S-386A) BRP 0302 (28) TH 3 - BRIDGE NO. 6 TOWN OF RICHFORD, FRANKLIN COUNTY VT GENERAL CONTRACTOR LAFAYETTE JUN 23 2015 PAR <i>[Signature]</i> DATE 04-27-15 SEAL NONE SIZE D	
		CERTIFIED FABRICATOR SHEET NO. 2039 1 of 3	



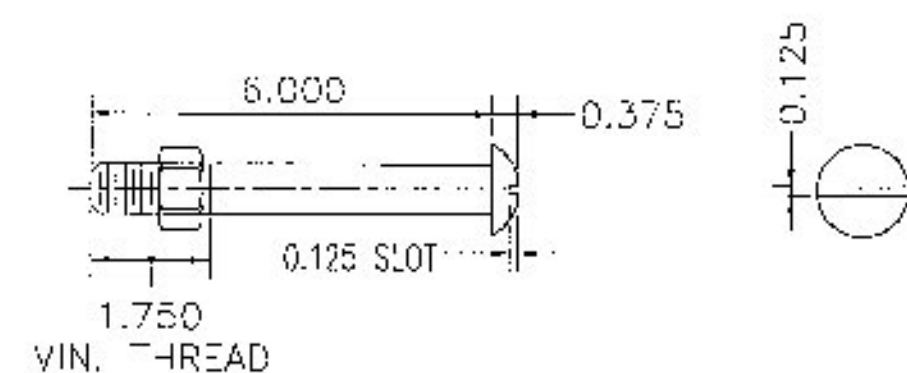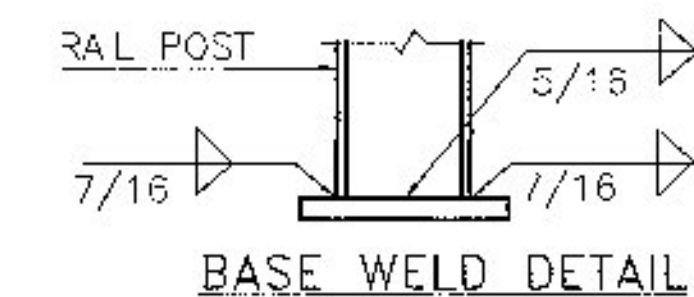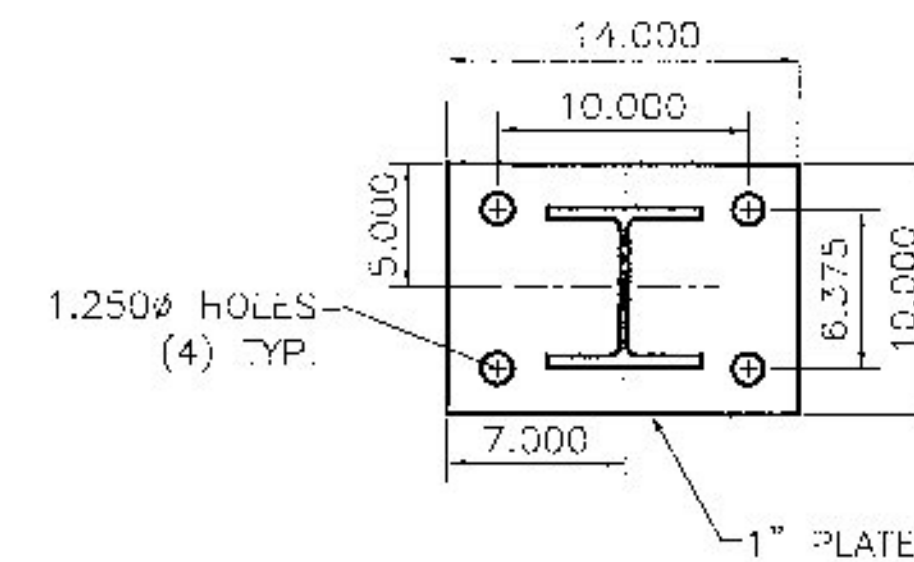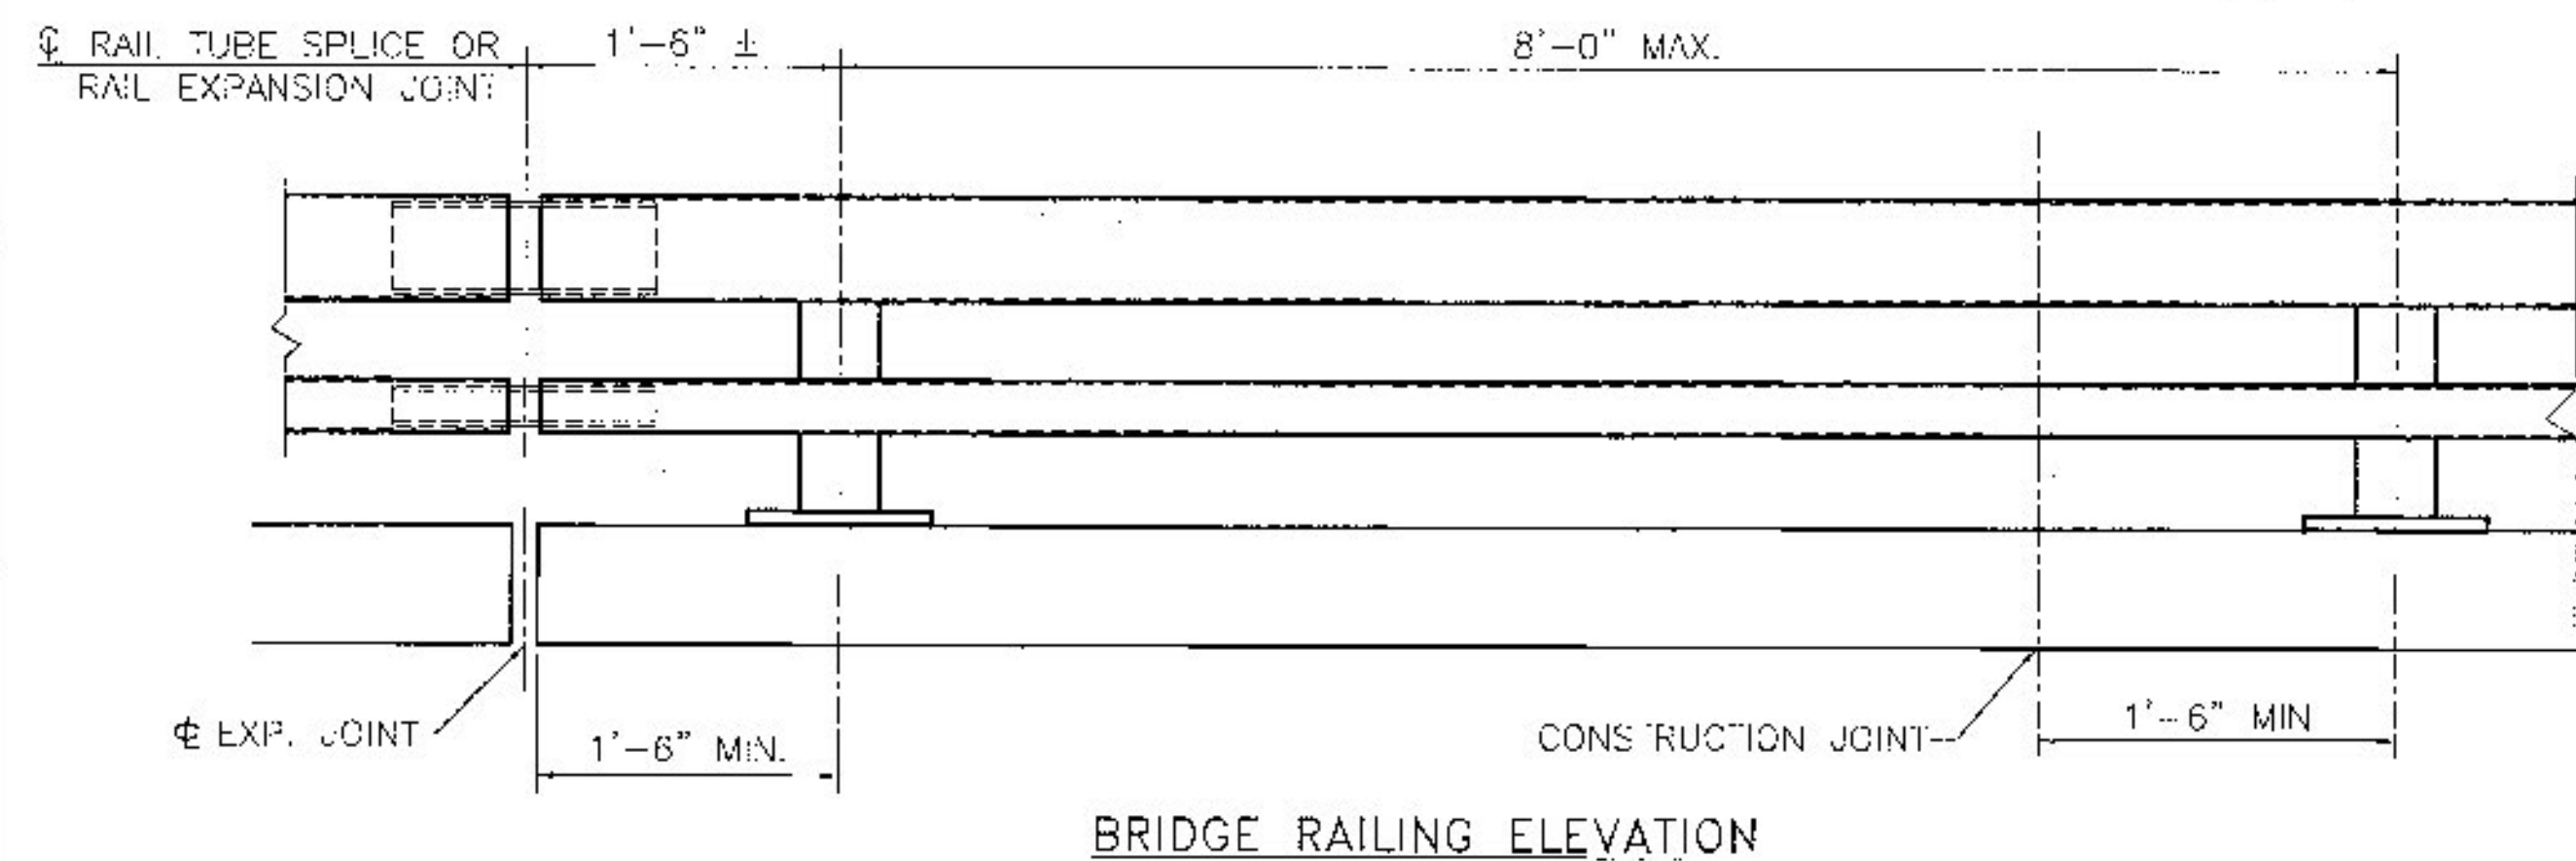

3/4" DIA. A449  
ROUND HEAD BOLT  
(WITH WASHER AND PREVAILING TORQUE TYPE LOCK NUT)  
(SEE NOTE #2)  
ONLY FULL DIAMETER BODY BOLTS WILL BE ALLOWED.

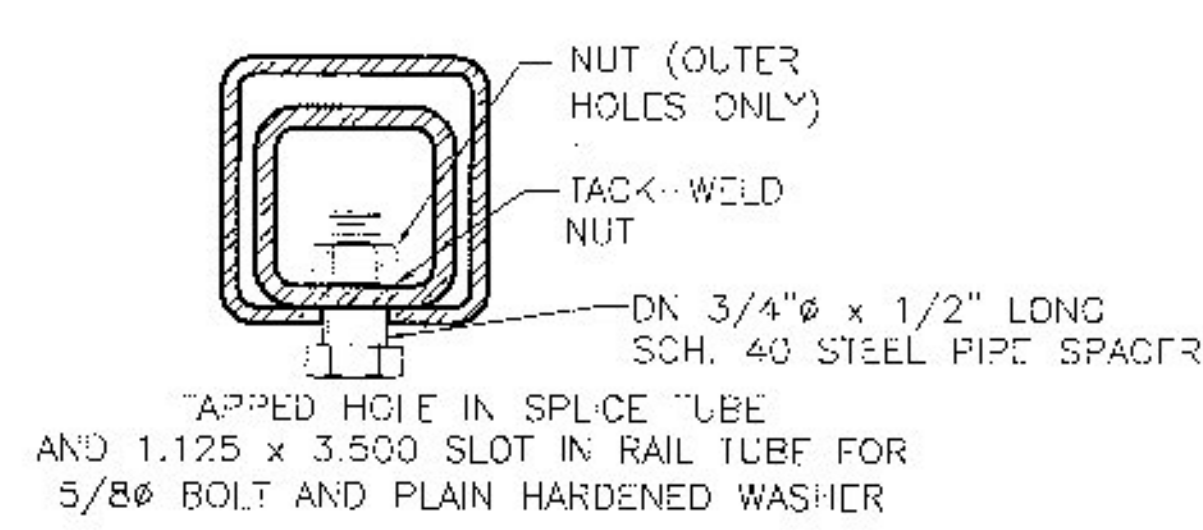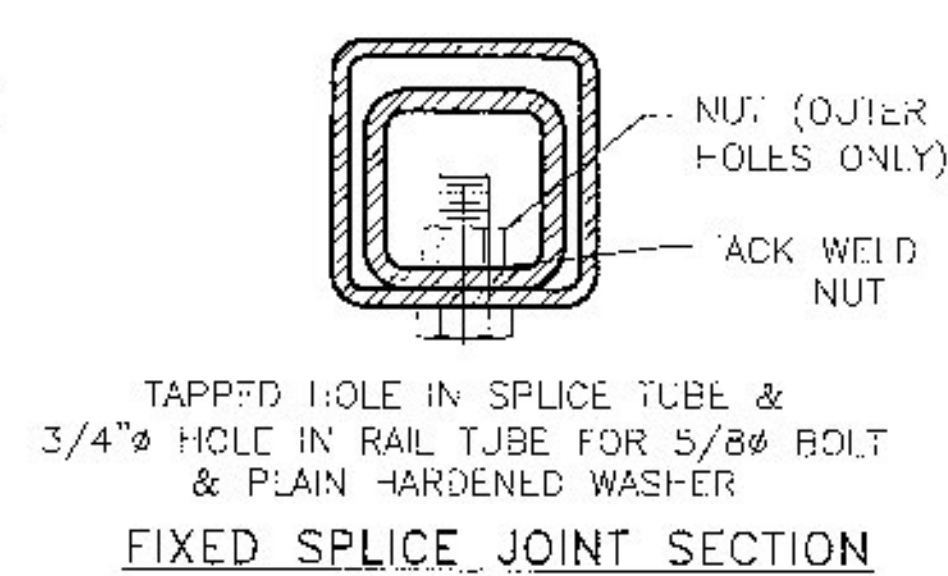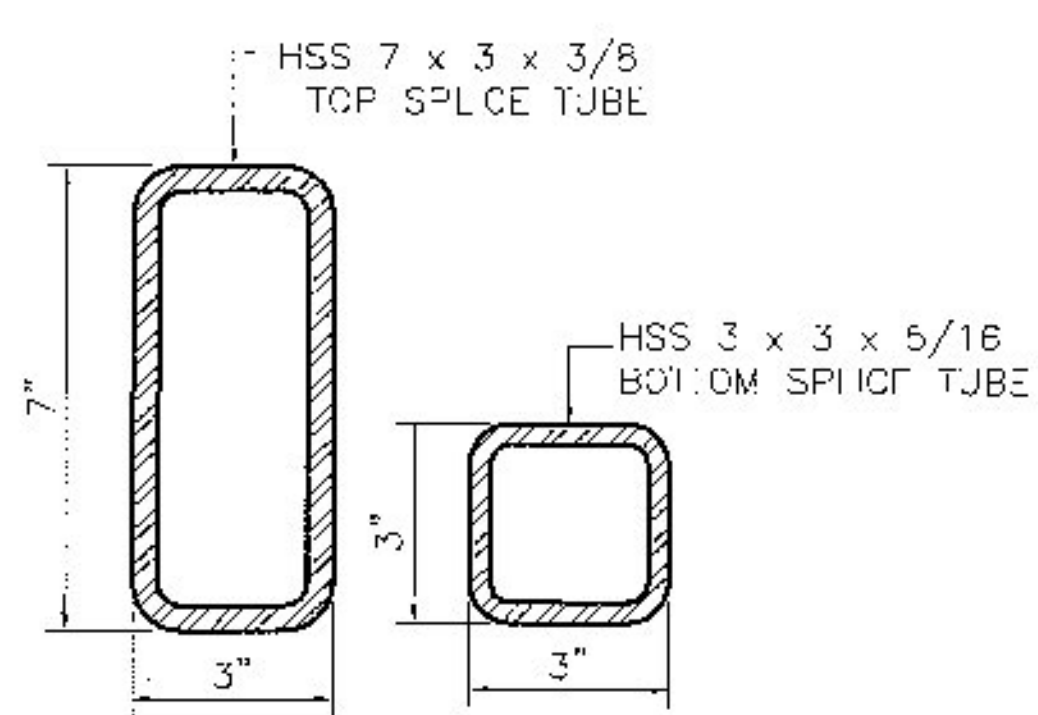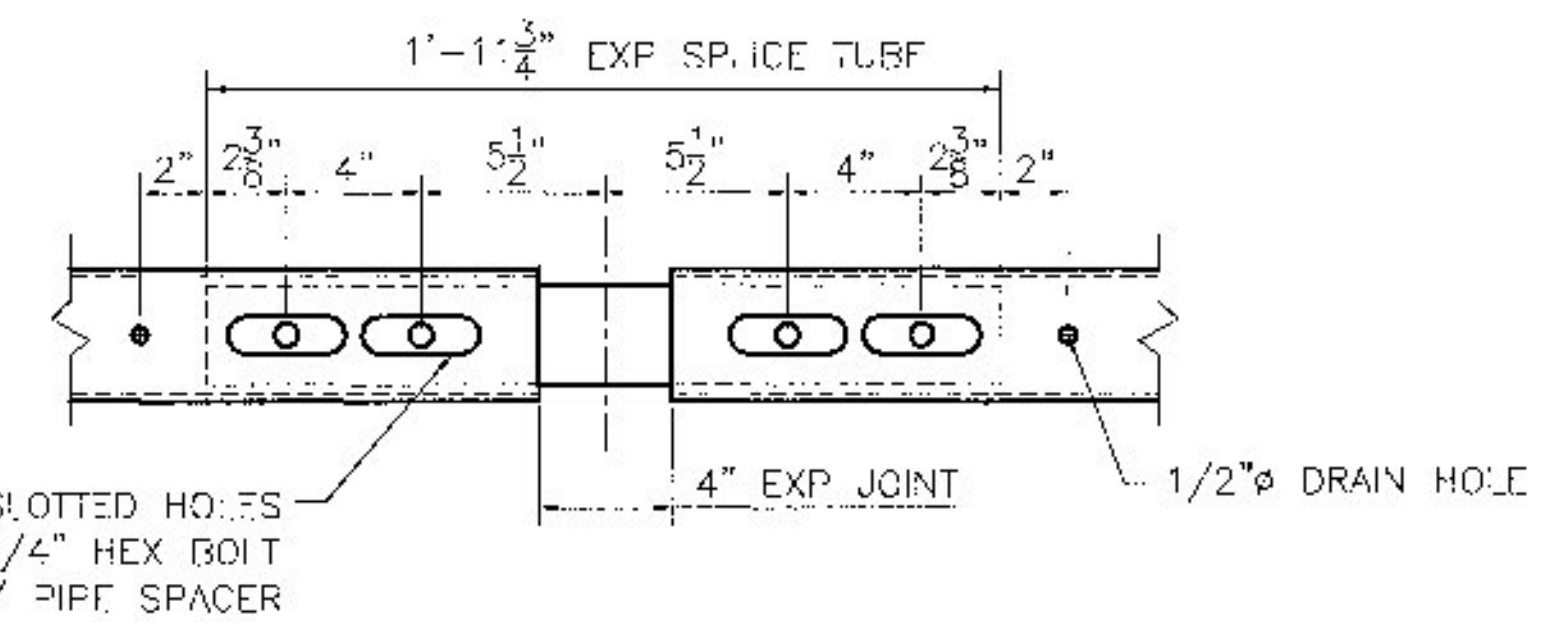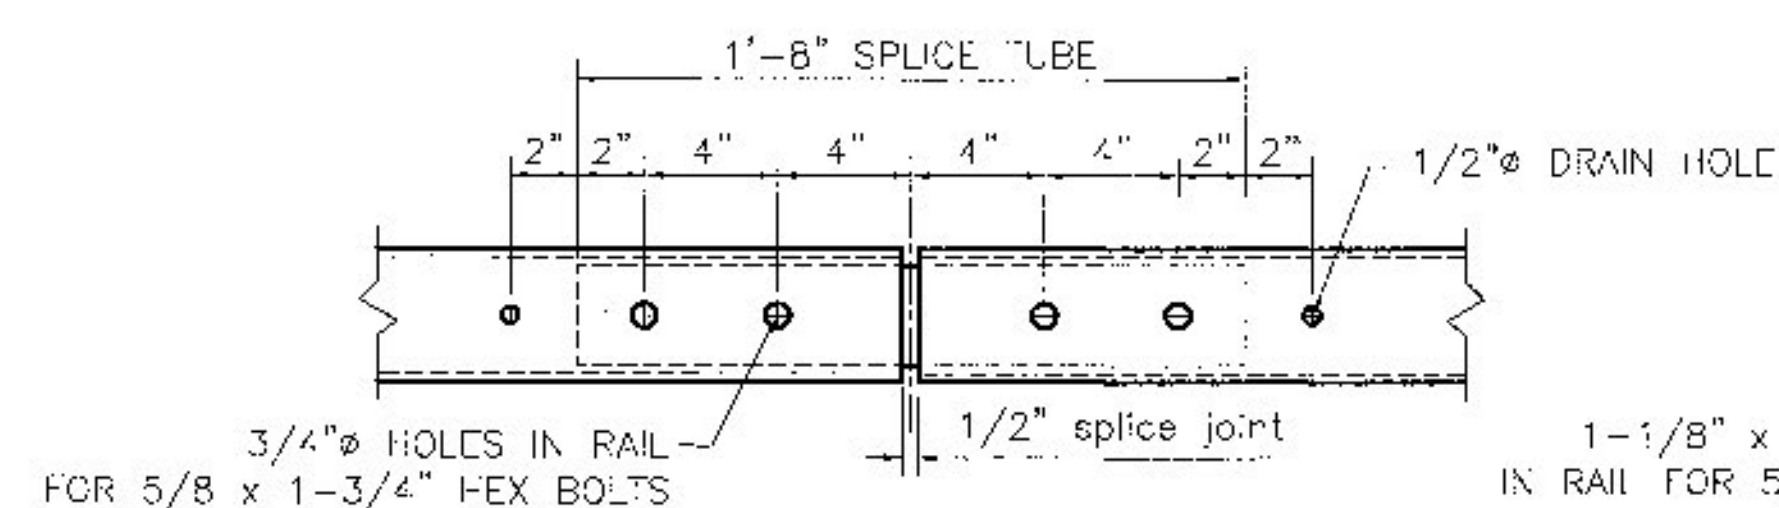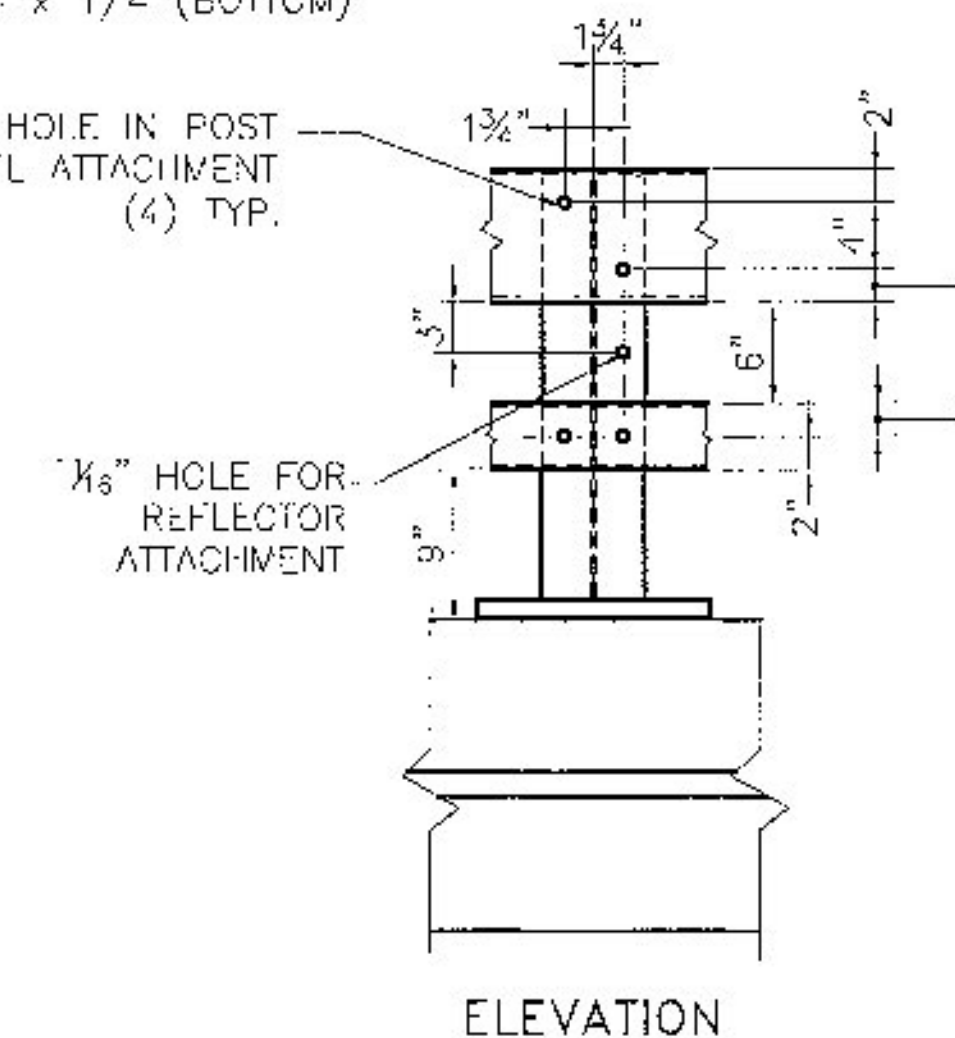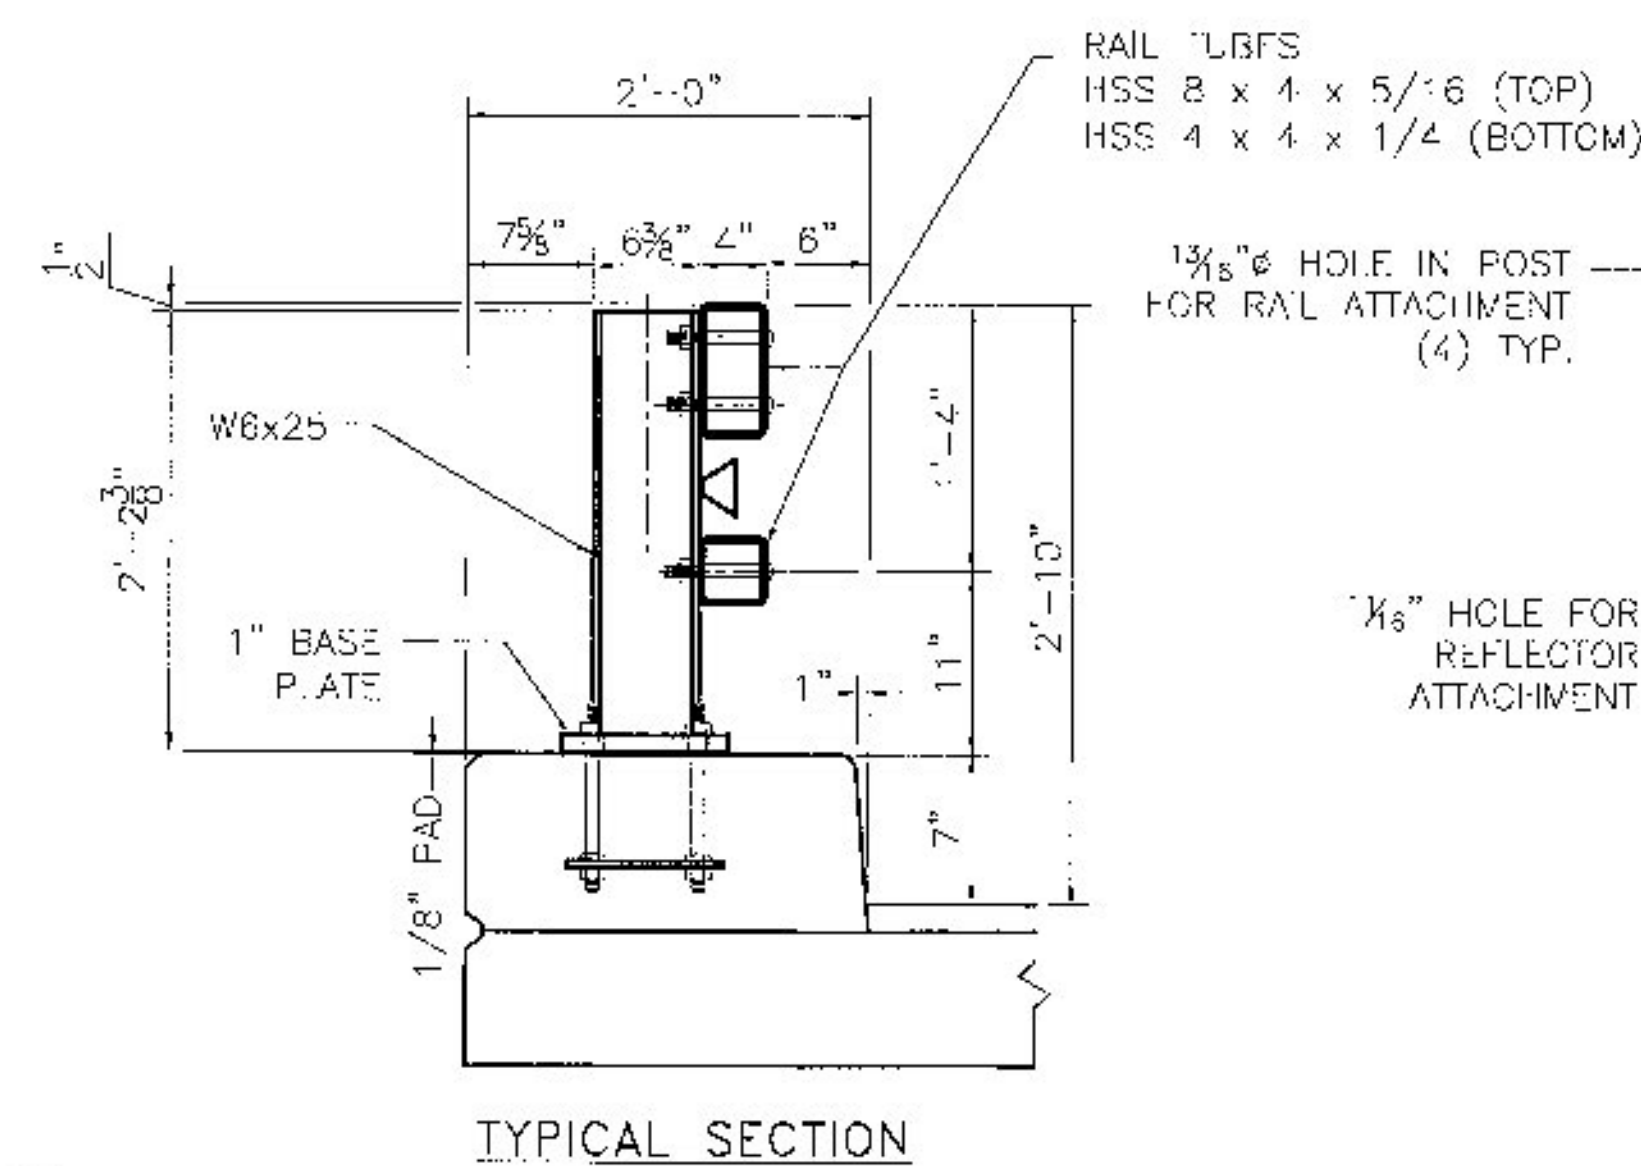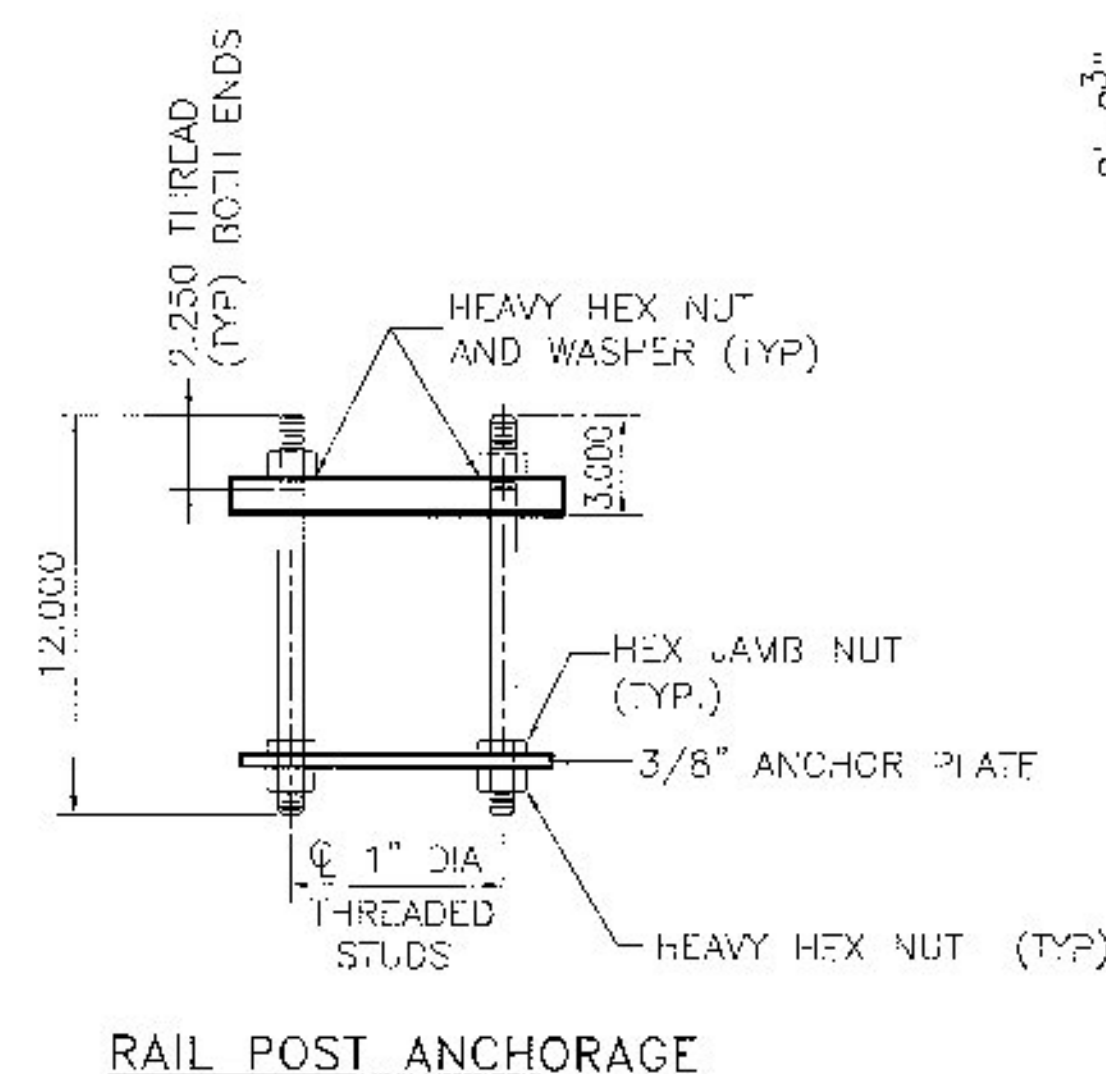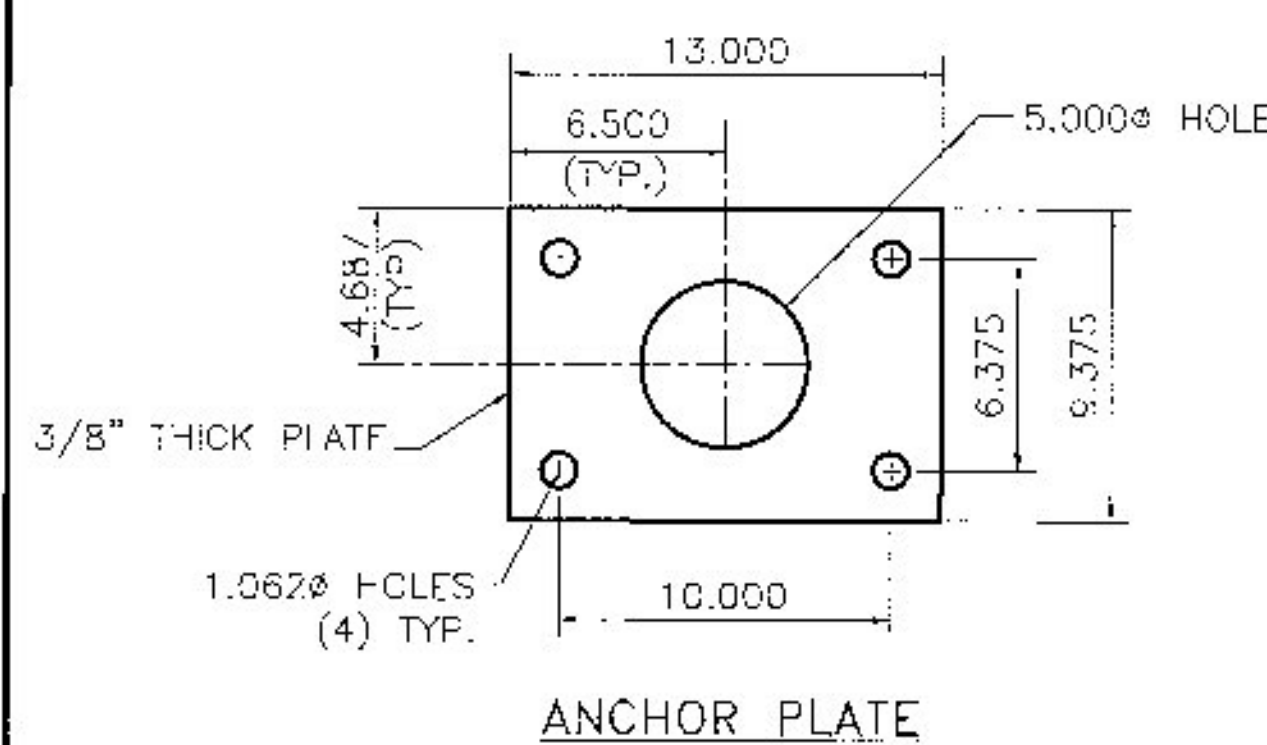

- NOTES:**
1. ALL WORK AND MATERIALS SHALL CONFORM TO SECTION 525.
  2. PRIOR TO GALVANIZING, ALL EXPOSED CUT OR SHEARED EDGES SHALL BE ROUNDED TO A 1/16" RADIUS AND BE FREE OF BURRS.
  3. ALL POSTS SHALL BE SET NORMAL TO GRADE.
  4. SECTIONS OF RAIL TUBE SHALL BE ATTACHED TO A MINIMUM OF TWO (2) RAIL POSTS AND PREFERABLY TO AT LEAST FOUR (4) POSTS.
  5. RAIL TUBE EXPANSION JOINT SHALL BE PROVIDED IN ANY RAIL BAY SPANNING THE END OF AN INTEGRAL ABUTMENT BRIDGE AND AT ALL SUPERSTRUCTURAL EXPANSION JOINTS. EXPANSION JOINT WIDTH SHALL BE 4" AT 45°F AND WILL BE ADJUSTED IN THE FIELD BY THE ENGINEER FOR OTHER TEMPERATURES.
  6. HOLES IN RAILS FOR RAIL TUBE ATTACHMENT SHALL BE FIELD-DRILLED. HOLES SHALL BE COATED WITH AN APPROVED ZINC-RICH PAINT PRIOR TO INSTALLATION.
  7. RAIL POST ANCHORING NUTS SHALL BE TIGHTENED TO A SNUG FIT AND GIVEN AN ADDITIONAL ONE-FOURTH TURN.
  8. RAIL TUBES SHALL BE ATTACHED USING 3/4" FULL DIAMETER BODY ASTM A449 ROUND HEAD BOLTS INSERTED THROUGH THE FACE OF THE TUBE. HOLES IN POSTS SHALL BE 1/16" LARGER THAN THE BOLT SIZE.
  9. ANY BENDING OR CURVING OF RAIL SHALL BE DONE IN A FABRICATION PLANT IN ACCORDANCE WITH SUBMITTED PROCEDURES.
  10. THE MINIMUM DISTANCE FROM A POST TO AN EXPANSION JOINT SHALL BE SUCH TO MAINTAIN MINIMUM EDGE DISTANCE OF 5" FROM ANY ANCHOR STUD TO THE END OF THE SLAB, OR TO THE EXPANSION JOINT RECESS POLAR, IF ONE IS USED.
  11. A DELINEATOR (SEE VDOT STANDARD DRAWING G-1 FOR DETAILS) SHALL BE INSTALLED AT NEAREST POST TO 30 FT SPACING. WHITE IS TO BE INSTALLED ON THE DRIVER'S RIGHT. FOR ONE WAY BRIDGES, YELLOW IS TO BE INSTALLED ON THE DRIVER'S LEFT. PAYMENT SHALL BE INCIDENTAL TO OTHER ITEMS.
  12. THIS PAVING MEETS THE REQUIREMENTS FOR A TL-4 SERVICE LEVEL.

WATERWAYS  
RAIL TUBES.....ASTM A500 GRADE B OR ASTM A501  
RAIL POSITS AND BASE PLATES.....ASTM A109/A709M, GRADE 50  
ALL OTHER SHAPES AND PLATES.....ASTM A709/A709M, GRADE 36  
ANCHOR STUDS.....ASTM A449  
ALL OTHER BOLTS (UNLESS NOTED).....AASHTO M164, TYPE 1

NUTS FOR AASHTO M164 BOLTS AND FOR ANCHOR STUDS SHALL COMPLY WITH  
AASHTO V291 (ASTM A563).

WASERS SHALL COMPLY WITH AASHTO M293 (ASTM F436) SPECIFICATIONS.

1/8" PAD SHALL COMPLY WITH STANDARD SPECIFICATION SUBSECTION 731.01 OR  
731.02.


RAIL POSITS AND BASE PLATES SHALL BE TESTED FOR IMPACT PROPERTIES IN  
ACCORDANCE WITH ASTM A501 CARP IMPACT TESTING USING TYPE A SPECIMEN.

<b>Vermont Agency of Transportation</b> <b>RECEIVED</b> RECEIVED 06/23/2015 09:00 AM by Mr. Bob Smith		 <b>HIGHWAY SAFETY CORP</b> GLASTONBURY, CT 860-633-9445																	
<b>CK'D BY</b> FDB	<b>OK'D BY</b> HIS	ITEM 525.33 BRIDGE RAILING, GALVANIZED 2 RAIL BOX BEAM (S-360A)  BR# 0302 (29) TH 3 - BRIDGE NO. 6 TOWN OF RICHFORD, FRANKLIN COUNTY VT																	
<b>June 23, 2015</b>		<table border="1"> <tr> <td colspan="2"> <b>CERTIFIED</b>  <b>FABRICATOR</b> </td> </tr> <tr> <td colspan="2">         WSC JOB NO:  <b>2039</b> </td> </tr> <tr> <td colspan="2">         SHEET NO:  <b>2 of 3</b> </td> </tr> </table>		<b>CERTIFIED</b> <b>FABRICATOR</b>		WSC JOB NO: <b>2039</b>		SHEET NO: <b>2 of 3</b>											
<b>CERTIFIED</b> <b>FABRICATOR</b>																			
WSC JOB NO: <b>2039</b>																			
SHEET NO: <b>2 of 3</b>																			
<b>RESUBMIT</b> No	<b>Approved</b>	<table border="1"> <tr> <td colspan="2">         GENERAL CONTRACTOR       </td> </tr> <tr> <td colspan="2">         RAIL ENGINEER       </td> </tr> <tr> <td colspan="2">         LAFAYETTE       </td> </tr> <tr> <td>         JOB#       </td> <td>         CHECKED       </td> </tr> <tr> <td>         PAR       </td> <td>         DATE       </td> </tr> <tr> <td>         NONE       </td> <td>         04-27-15       </td> </tr> <tr> <td>         SCALE       </td> <td>         SIZE       </td> </tr> <tr> <td>         NONE       </td> <td>         11x17       </td> </tr> </table>		GENERAL CONTRACTOR		RAIL ENGINEER		LAFAYETTE		JOB#	CHECKED	PAR	DATE	NONE	04-27-15	SCALE	SIZE	NONE	11x17
GENERAL CONTRACTOR																			
RAIL ENGINEER																			
LAFAYETTE																			
JOB#	CHECKED																		
PAR	DATE																		
NONE	04-27-15																		
SCALE	SIZE																		
NONE	11x17																		
<b>BY</b> Carolyn Carlson	<b>DATE</b> 06/23/15																		




















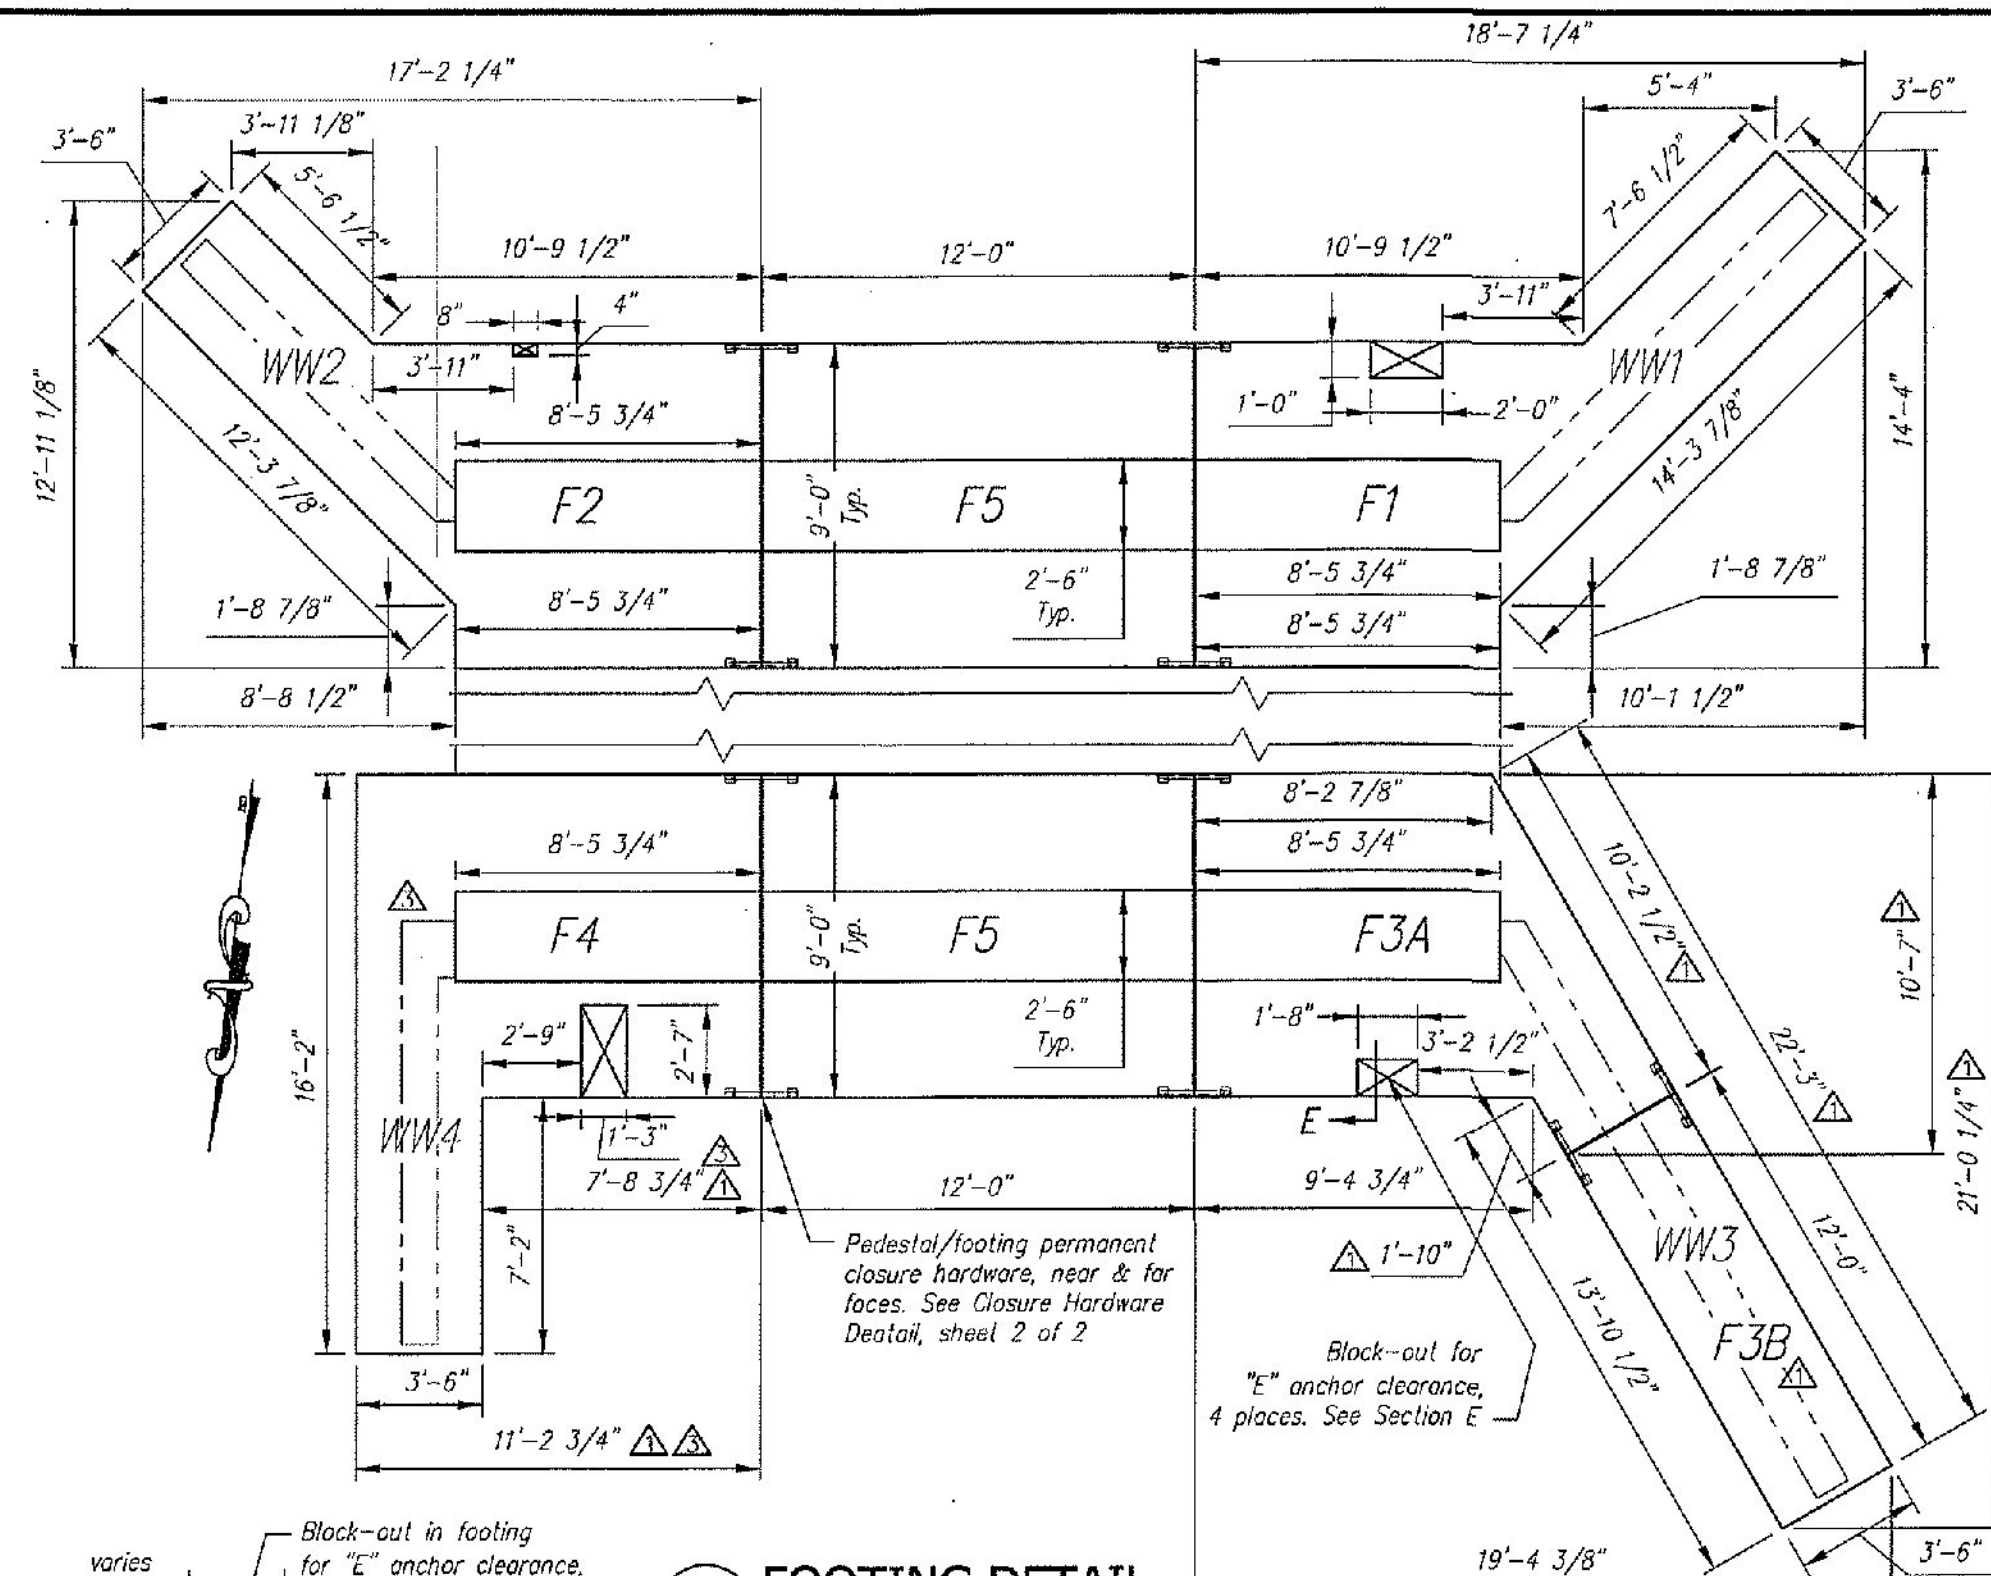

CULVERT PITYE SCHEDULE (MK-FA6000SC30)					
MARK	QTY	LENGTH	YDS	WEIGHT	
C1	1	6.54	15.40	31.19	TON
C2	2	7.50	15.20	30.78	TON
C3	1	7.38	16.50	35.41	TON
VWV1	1	12.00	7.77	13.73	TON
VWV2	1	10.00	6.35	12.86	TON
VWV3A	1	9.00	6.03	12.26	TON
VWV3B	1	9.00	5.31	10.75	TON
VWV4	1	11.83	8.13	16.46	TON
F1	1	18.58	11.37	23.02	TON
F2	1	17.17	10.85	21.97	TON
F3A	1	13.33	9.80	19.85	TON
F3B	1	12.00	3.11	6.30	TON
F4	1	16.17	11.70	23.69	TON
F5	2	12.00	11.19	22.86	TON

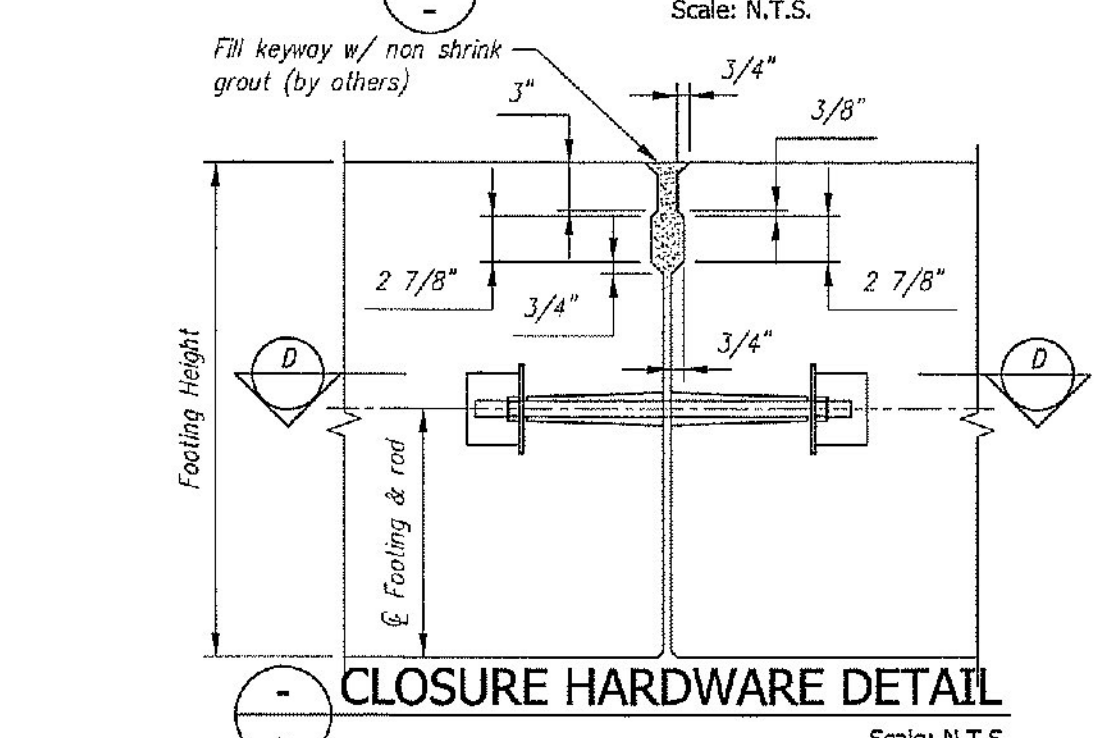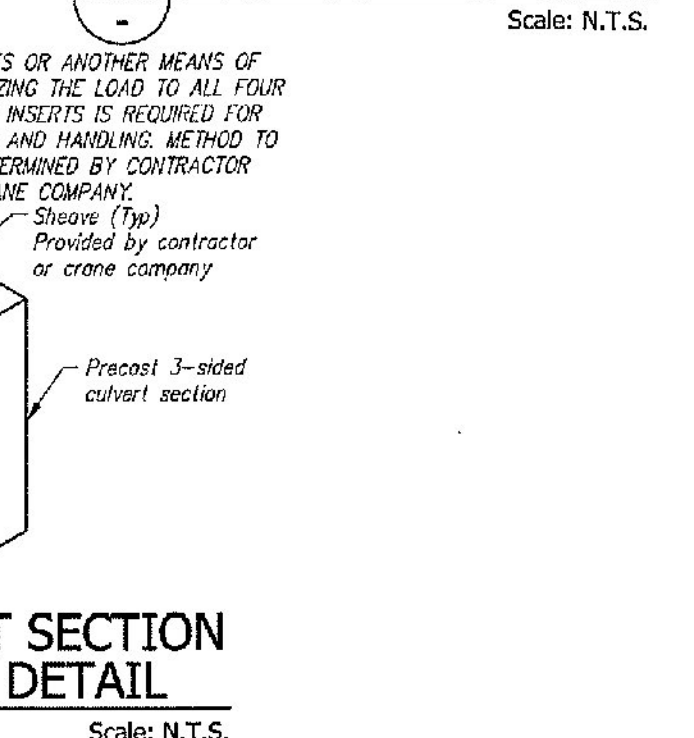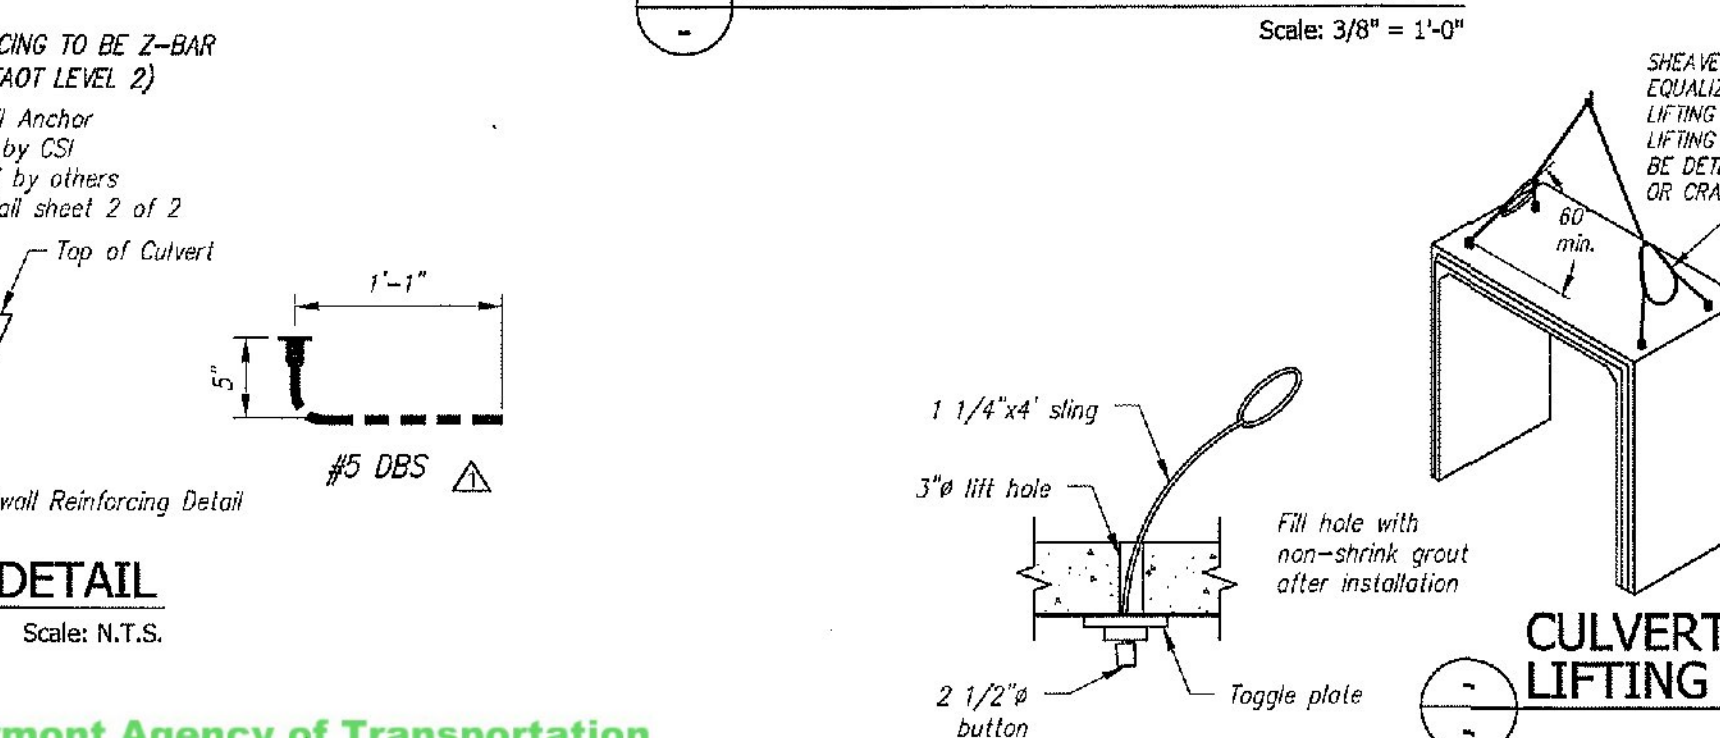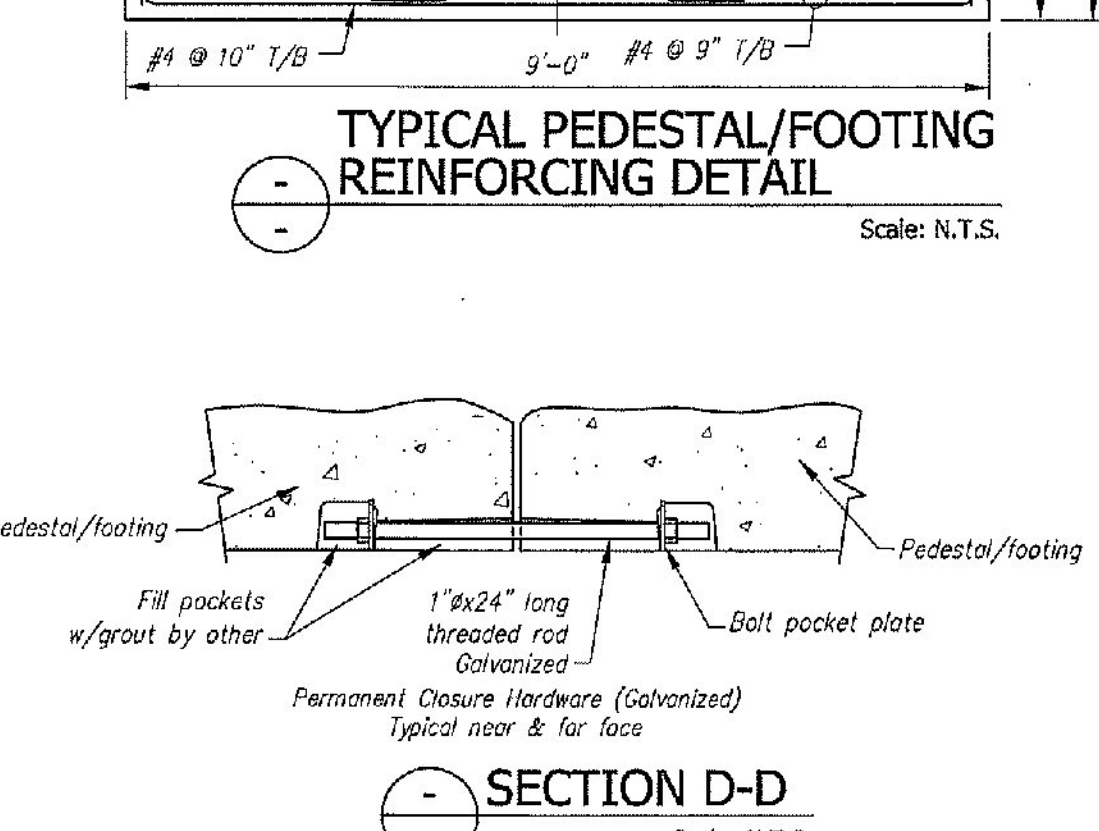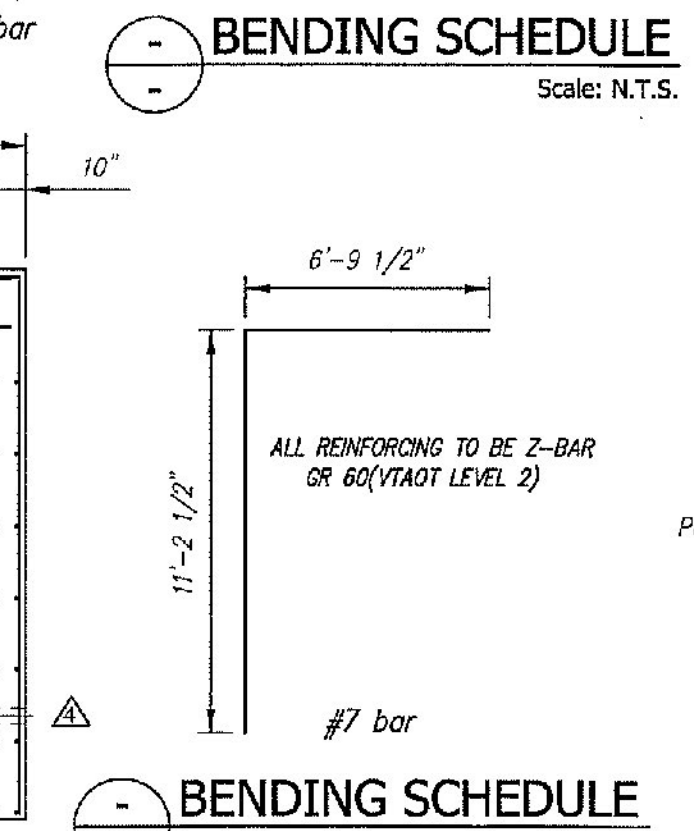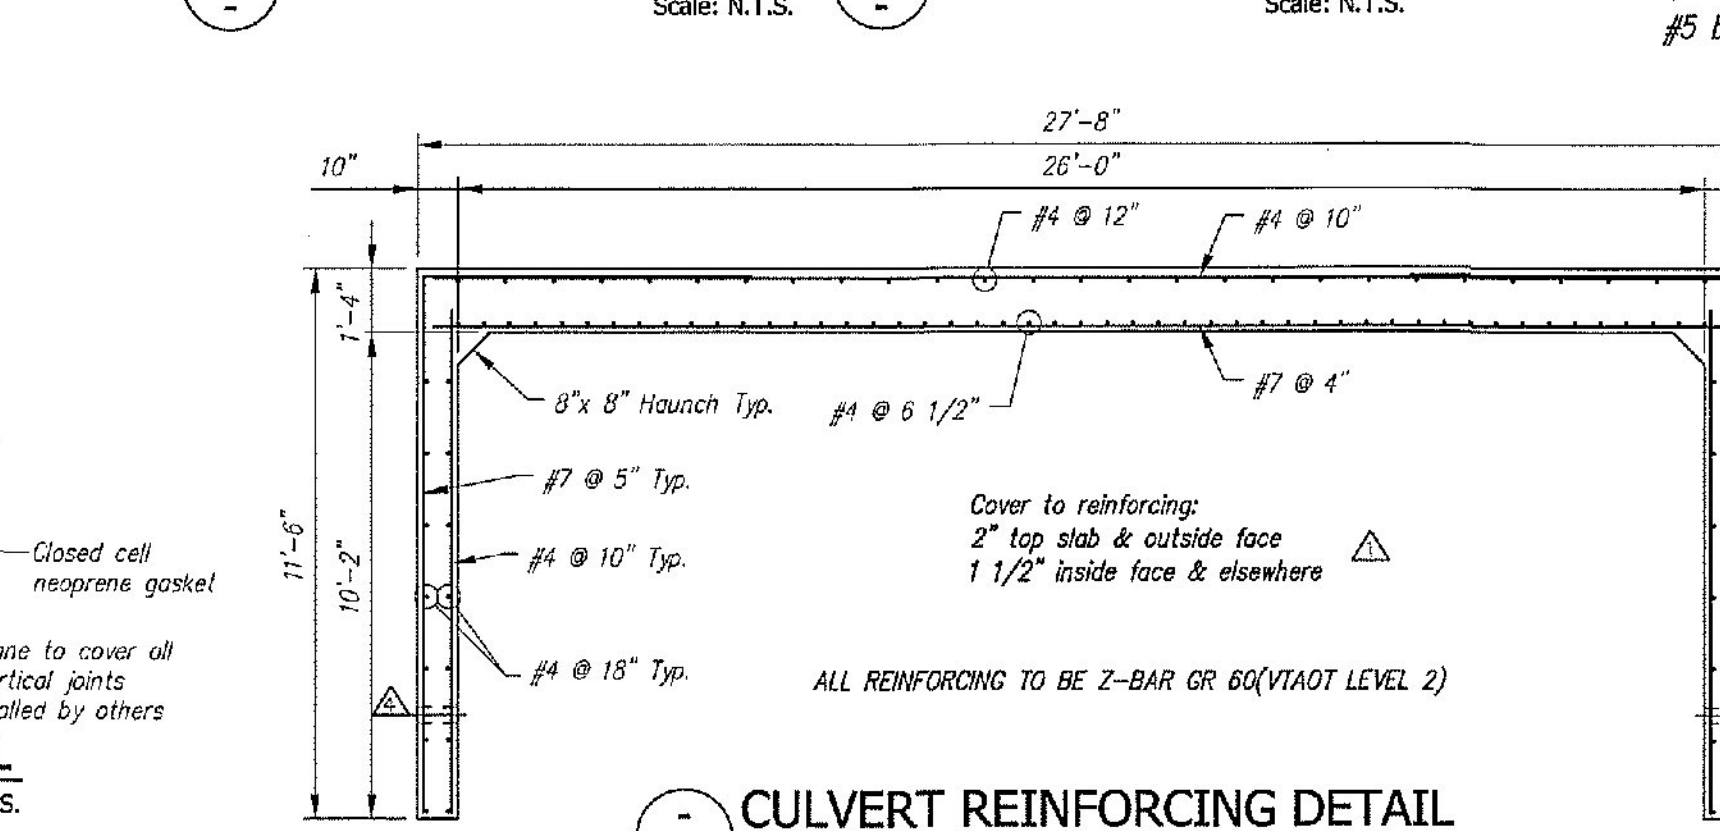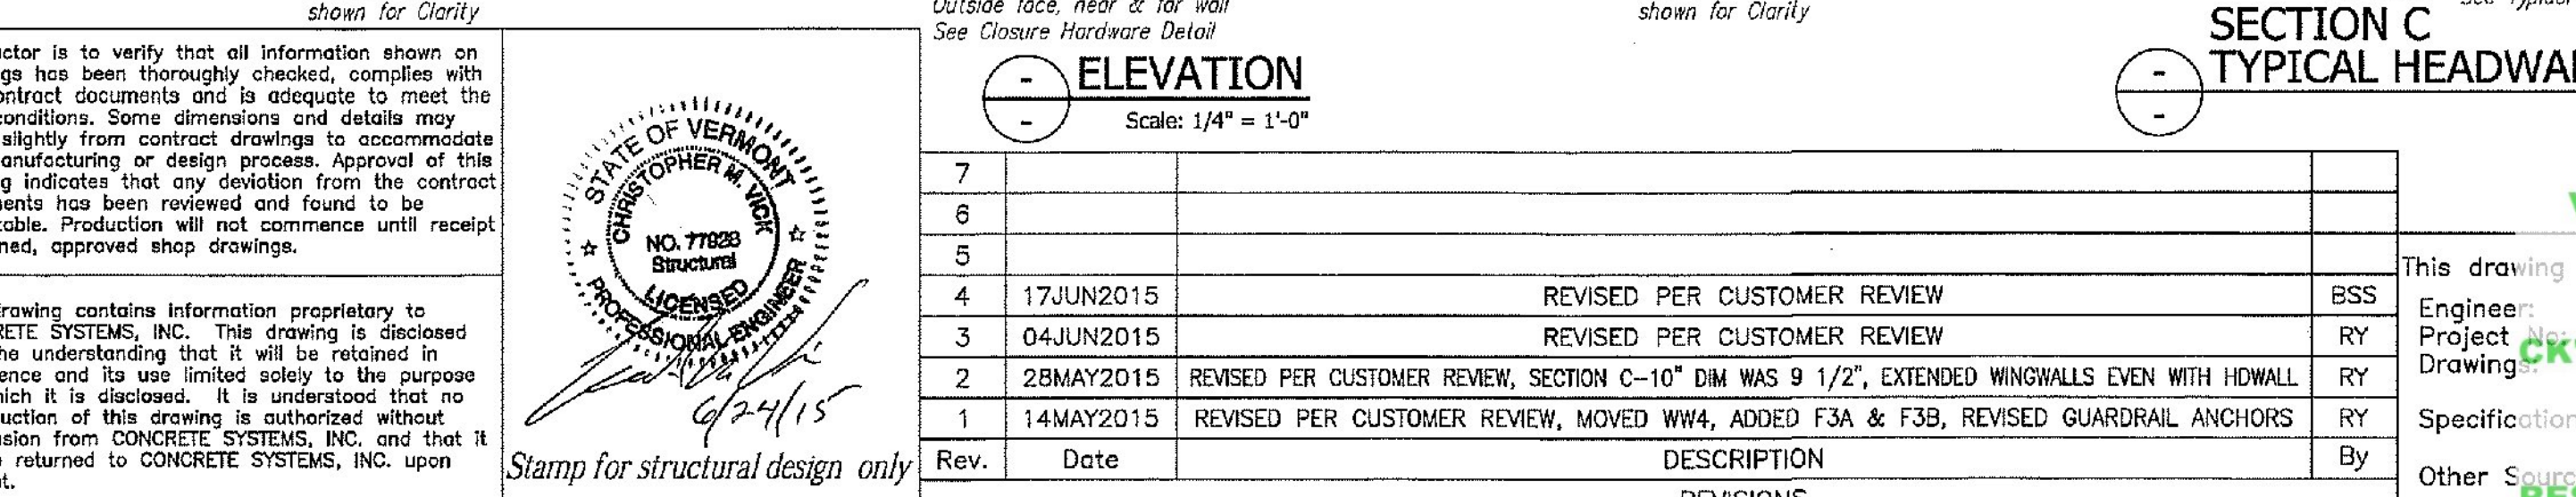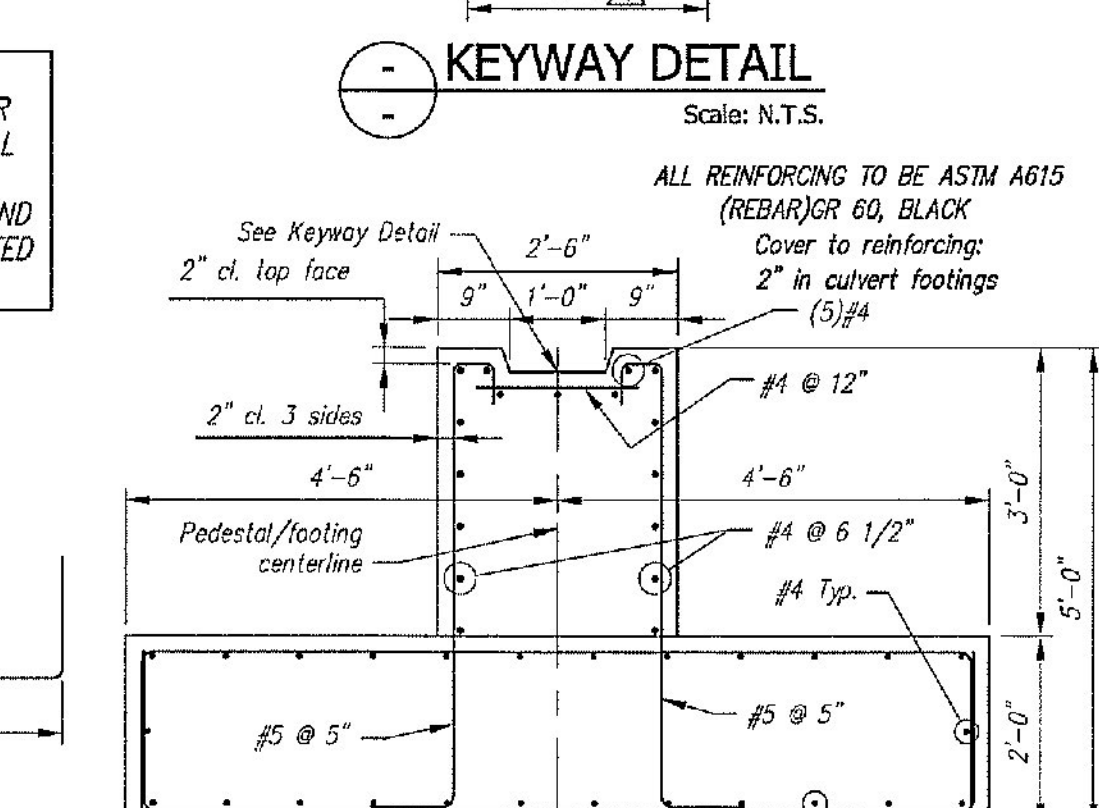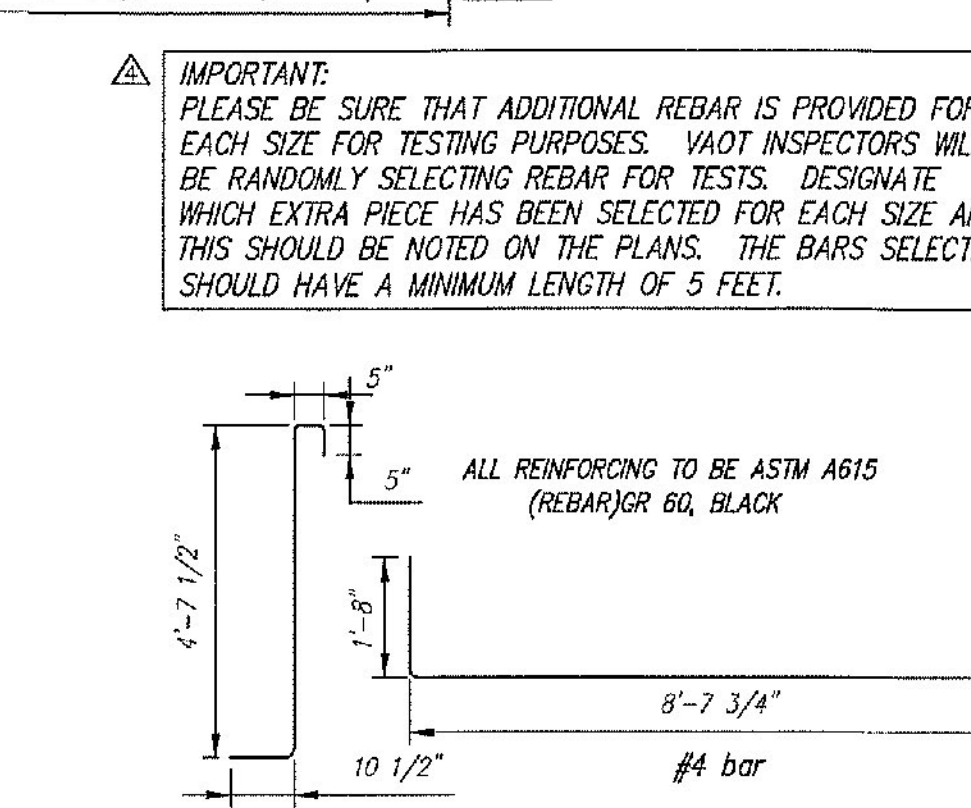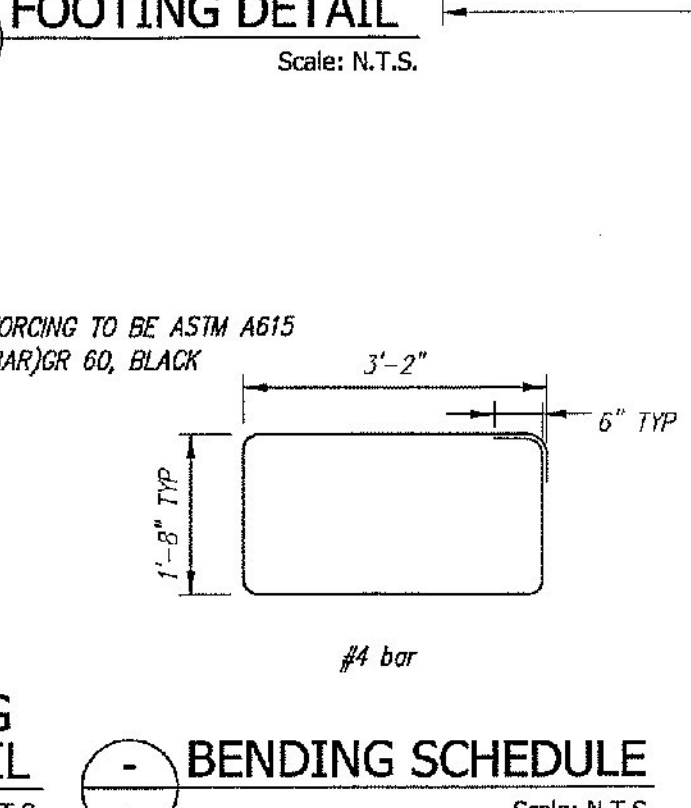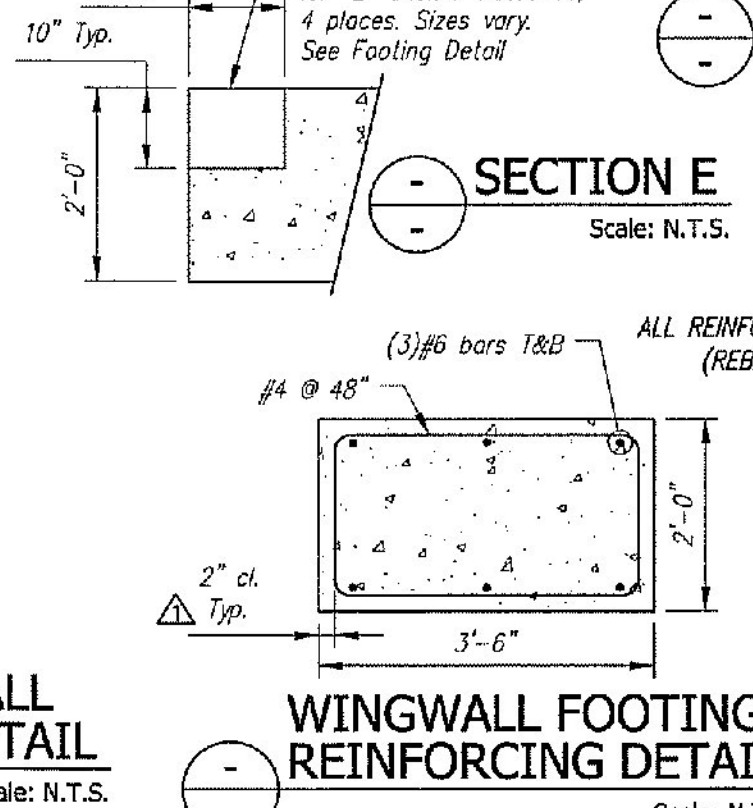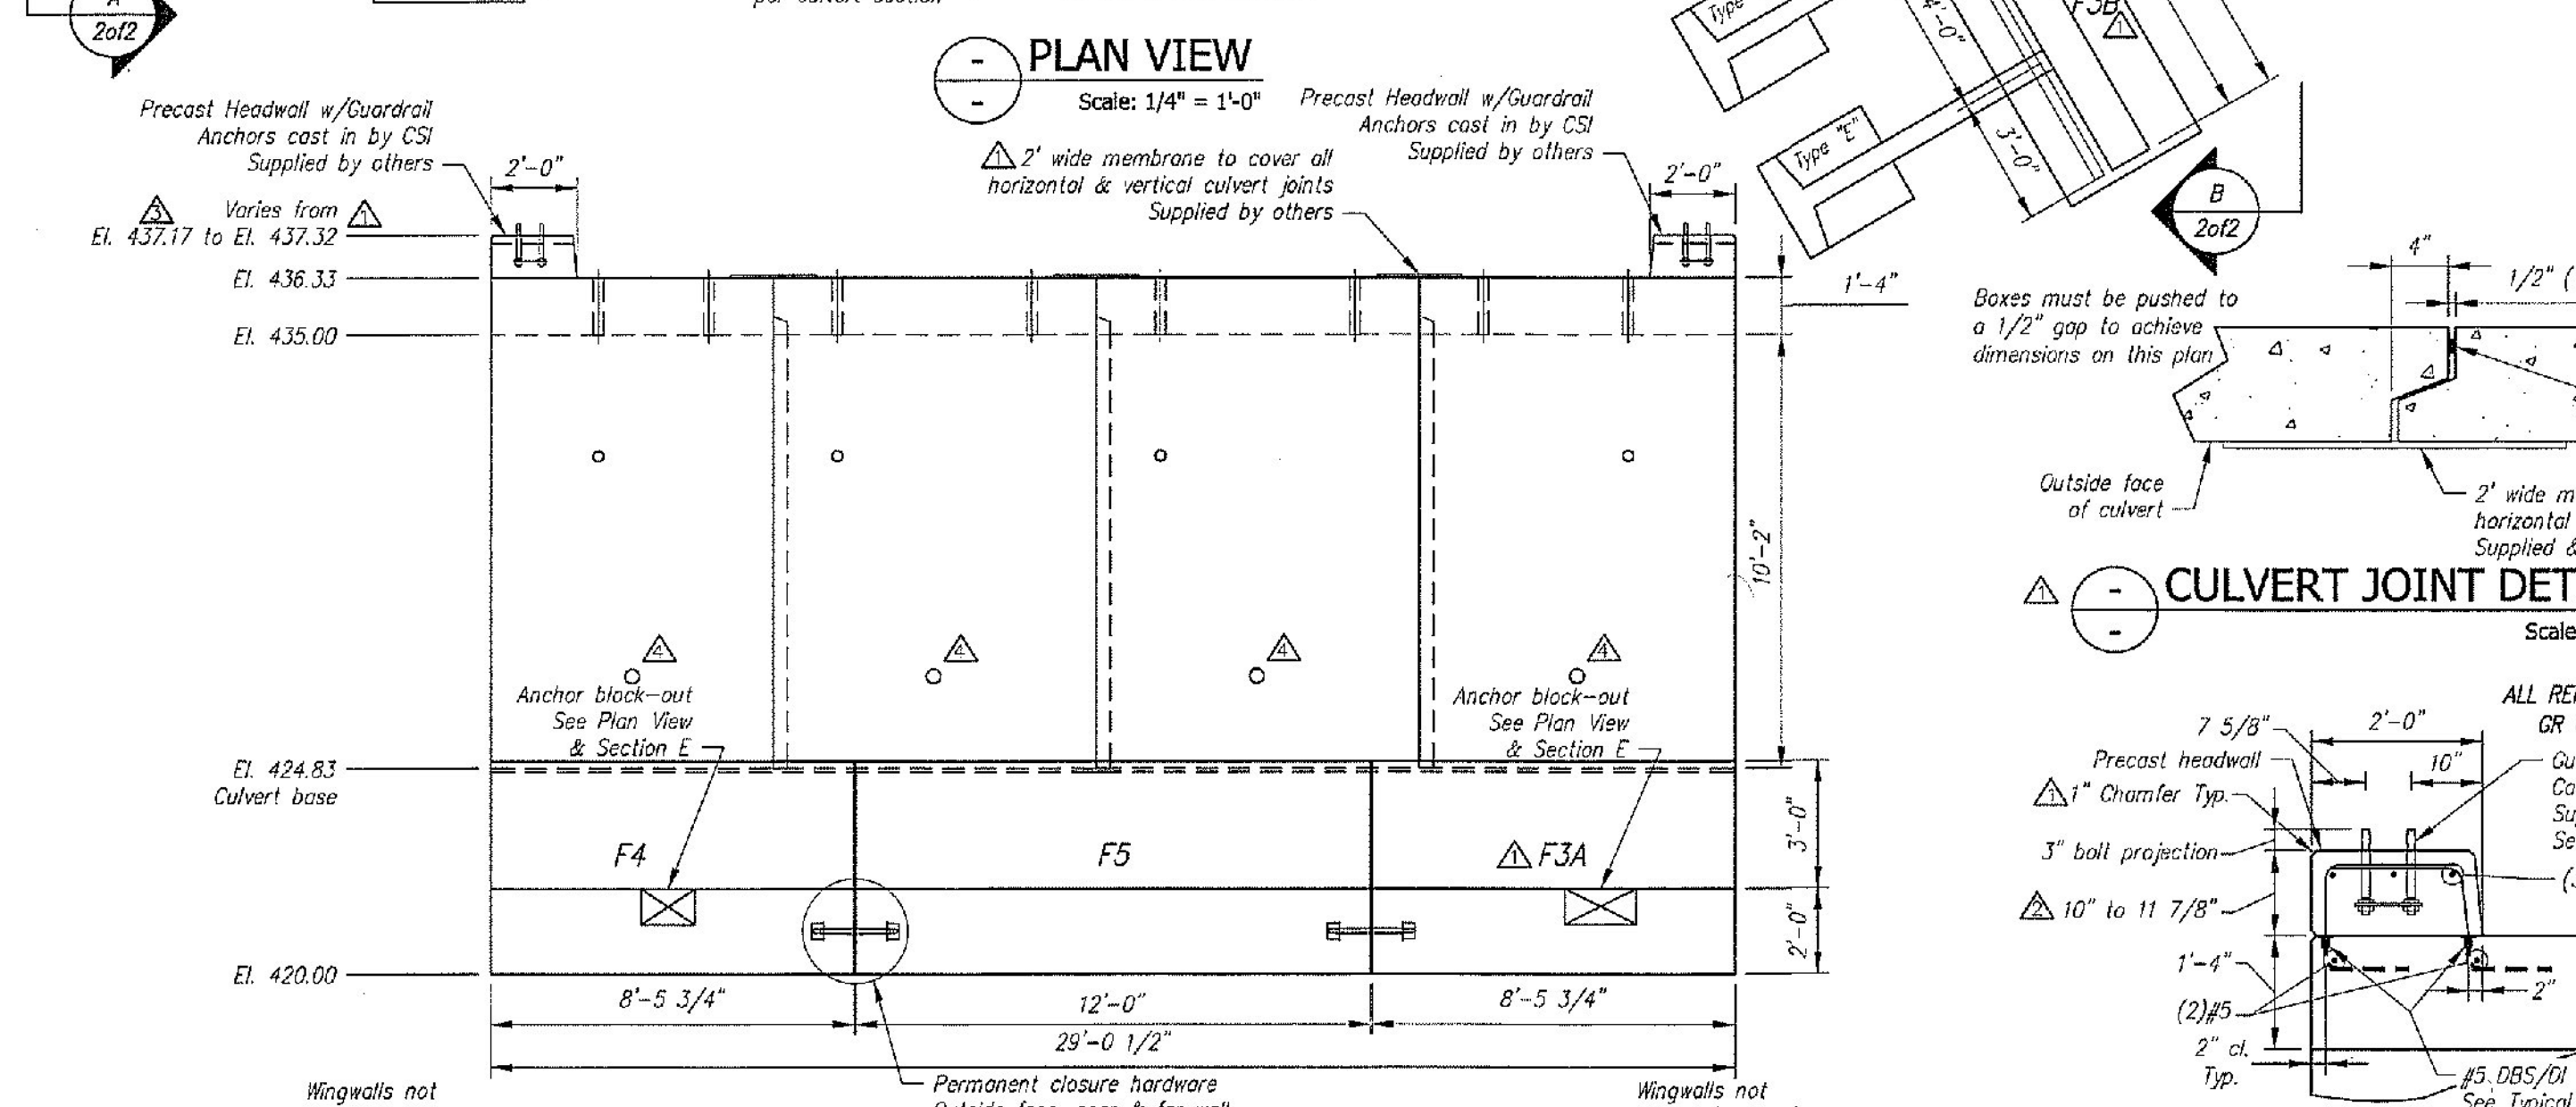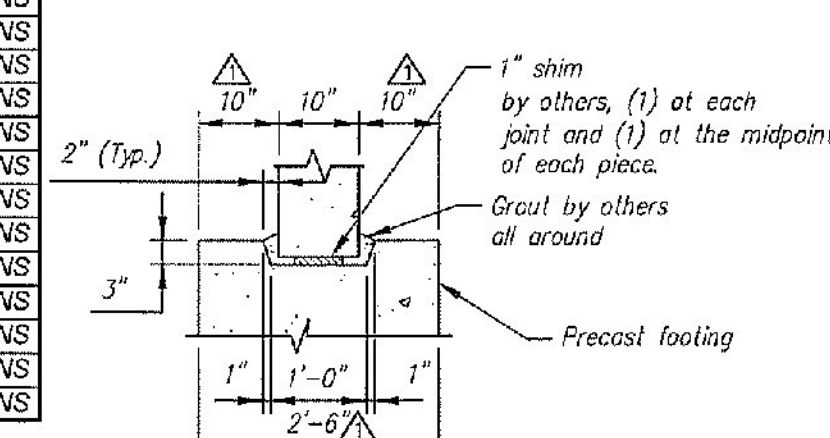

Contractor is to verify that all information shown on drawings has been thoroughly checked, comply with the contract documents and is adequate to meet the field conditions. Some dimensions and details may vary from contract documents to accommodate the manufacturing or design process. Approval of this drawing indicates that any deviation from the contract documents has been reviewed and found to be acceptable. Production will not commence until receipt of signed, approved shop drawings.

This drawing contains information proprietary to CONCRETE SYSTEMS, INC. This drawing is released with the understanding that it will be retained in confidence and its use is limited to the project for which it is disclosed. It is understood that no reproduction of this drawing is authorized without permission from CONCRETE SYSTEMS, INC. and that it will be returned to CONCRETE SYSTEMS, INC. upon request.

Stamp for structural design only

<b>Vermont Agency of Transportation</b>   <b>RECEIVED</b>	
This drawing is based upon information provided on the following documents:	
Engineer: STATE OF VT/AOT PROGRAM DEVELOPMENT	
Project: OK'D BY FDB OK'D BY HIS	
Drawing: SHEETS 1, 2, 4, 22, 23, 24, 02-316	
Specifications: STANDARD SPECIFICATIONS FOR CONSTRUCTION DATED 2011	
Other Sources: _____	
<b>RESUBMIT</b>   By Carolyn Carlson	<b>Approved</b>   <b>DATE</b> 06/29/15

**CSI**  
Concrete Systems Inc.  
9 Commercial St., Hudson, NH, 03051  
Phone 603-889-4163  
Fax 603-889-2417

<u>STATE AGENCY</u>	
Drawn By <b>R. YEAGER</b>	Date <b>31MAR2015</b>
Reviewed By <b>B. KOLAWOLE</b>	Date
Approved By	Date

G.W. TATRO CONSTRUCTION, INC. VT/AOT BRIDGE REPLACEMENT- ROAD IMPROVEMENT RICHFORD, VT.		
D	26' SPAN X 10' RISE 3-SIDED CULVERT Drawing No. C22312-L01A	REV 4



