


FINAL SURVEY
 DATE: _____
 BY: _____
 NO. _____
 AREA: _____

ORIGINAL SURVEY
 DATE: _____
 BY: _____
 NO. _____
 AREA: _____

ENOSBURG
 BRO 1448 (40)
 ROADWAY EARTHWORKS

Revised cross sections

ENOSBURG BRO 1448 (40)
 13111501
 Dense graded & PROFILE
 TRANSITION

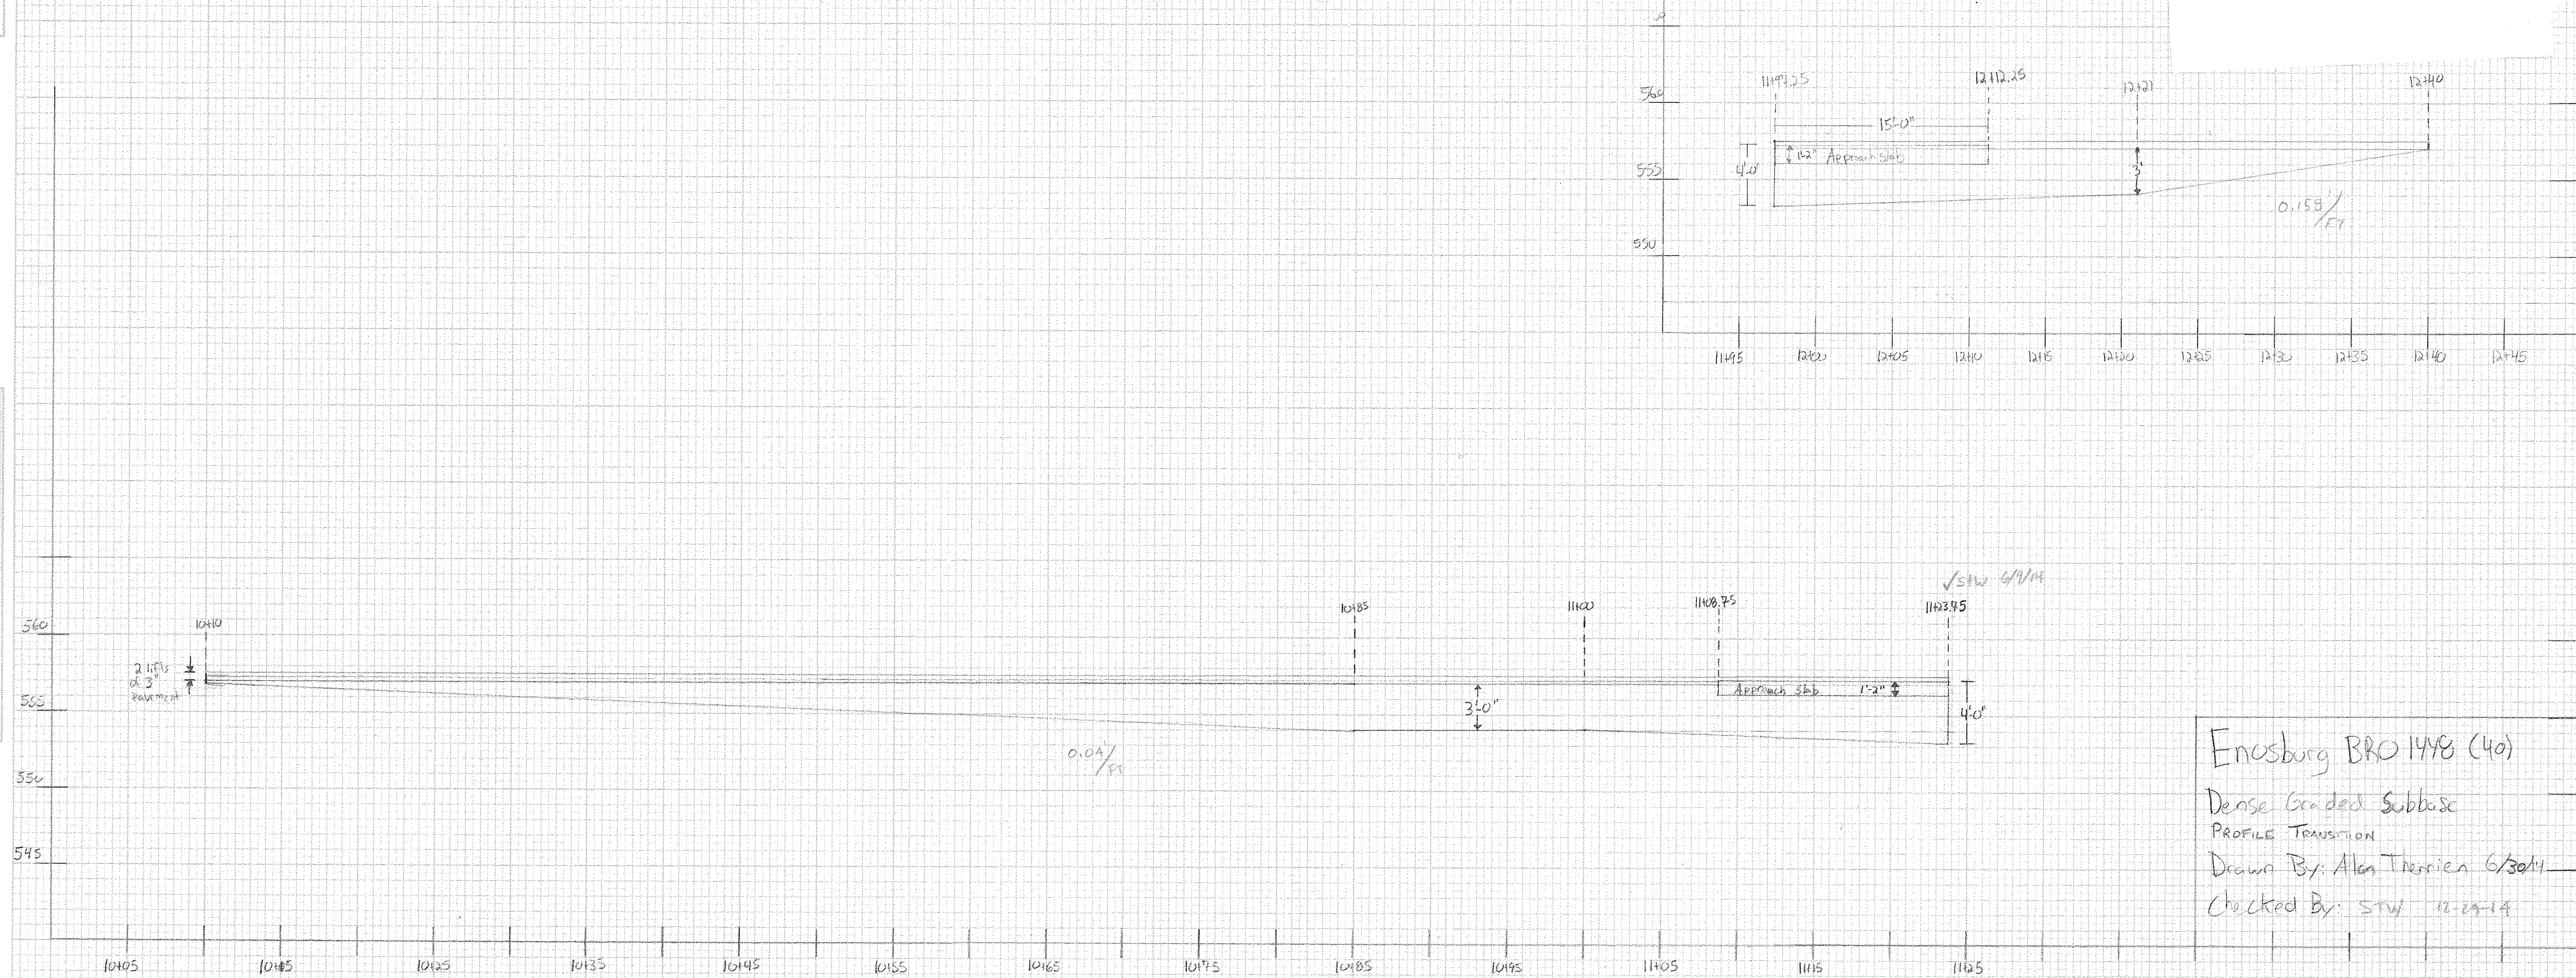

Enosburg BRO 1448 (40)
 Dense Graded Subbase
 PROFILE TRANSITION
 Drawn By: Allen Tremien 6/30/14
 Checked By: SWJ 12-29-14