
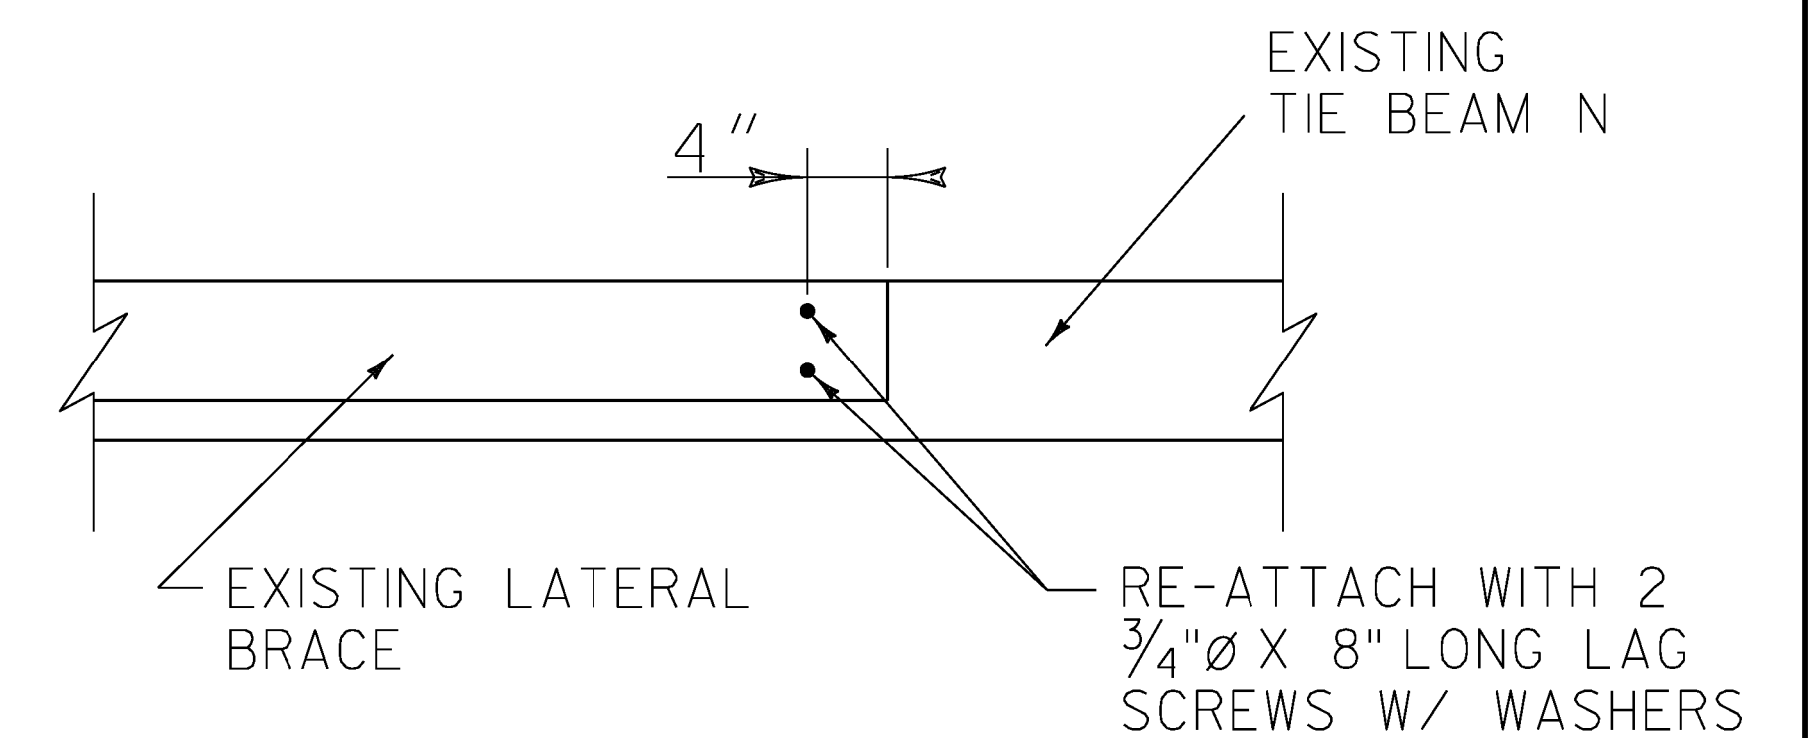
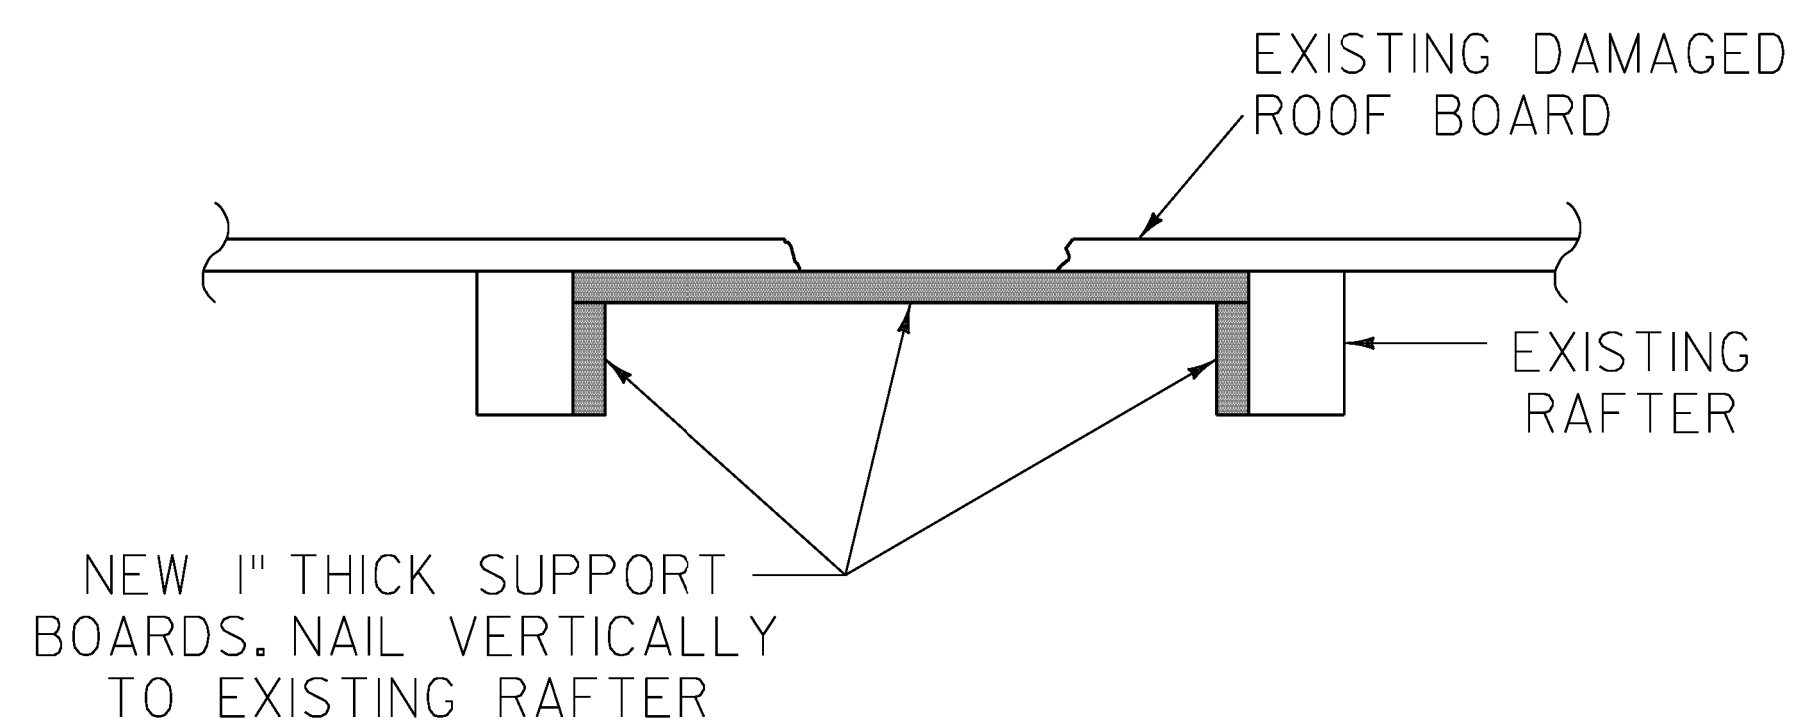
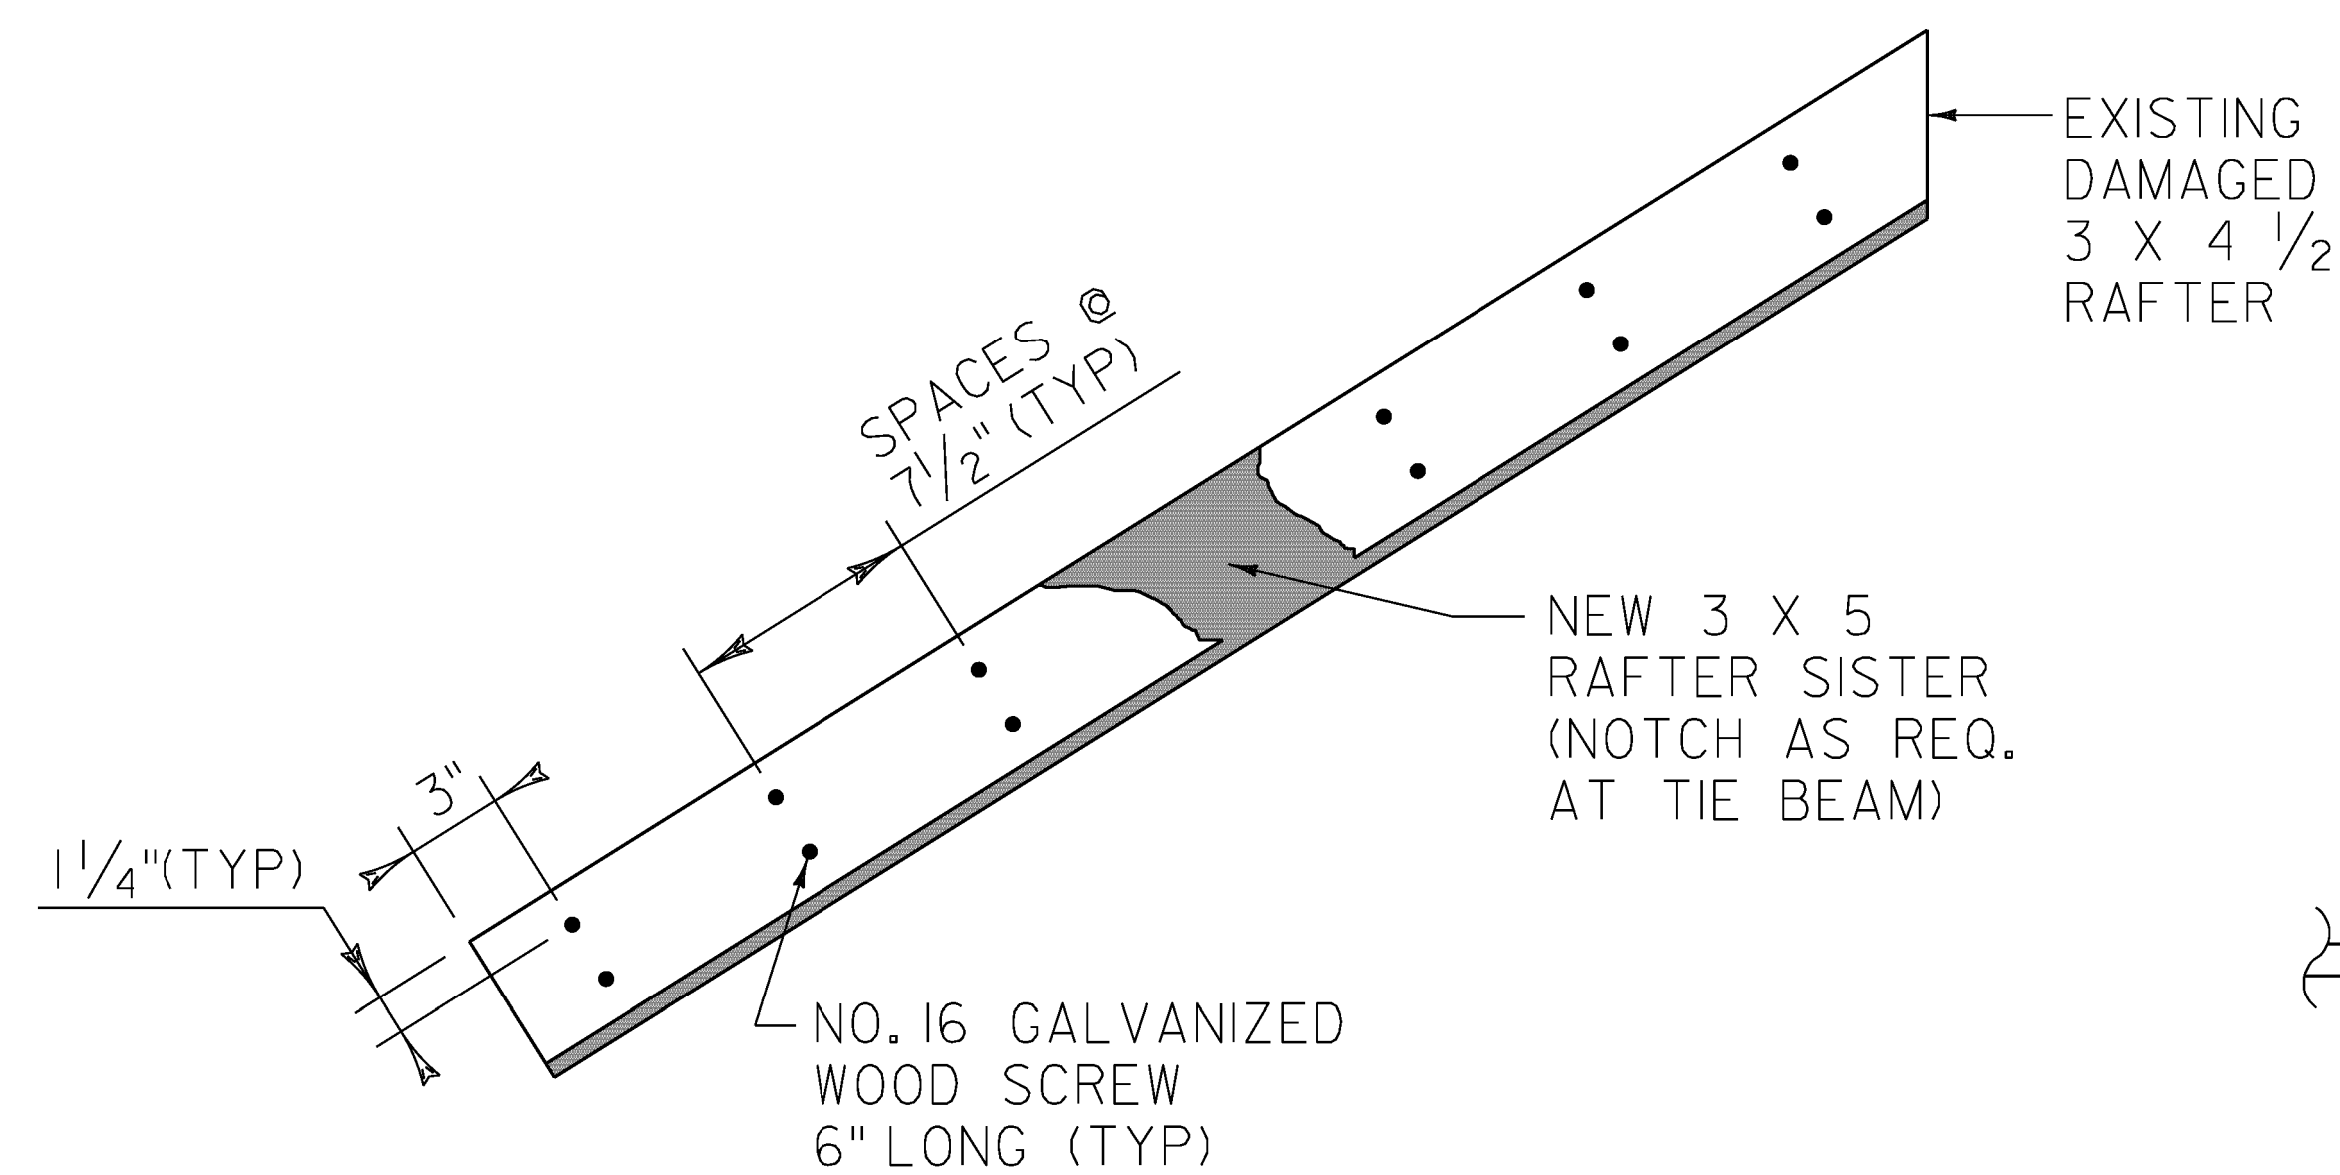


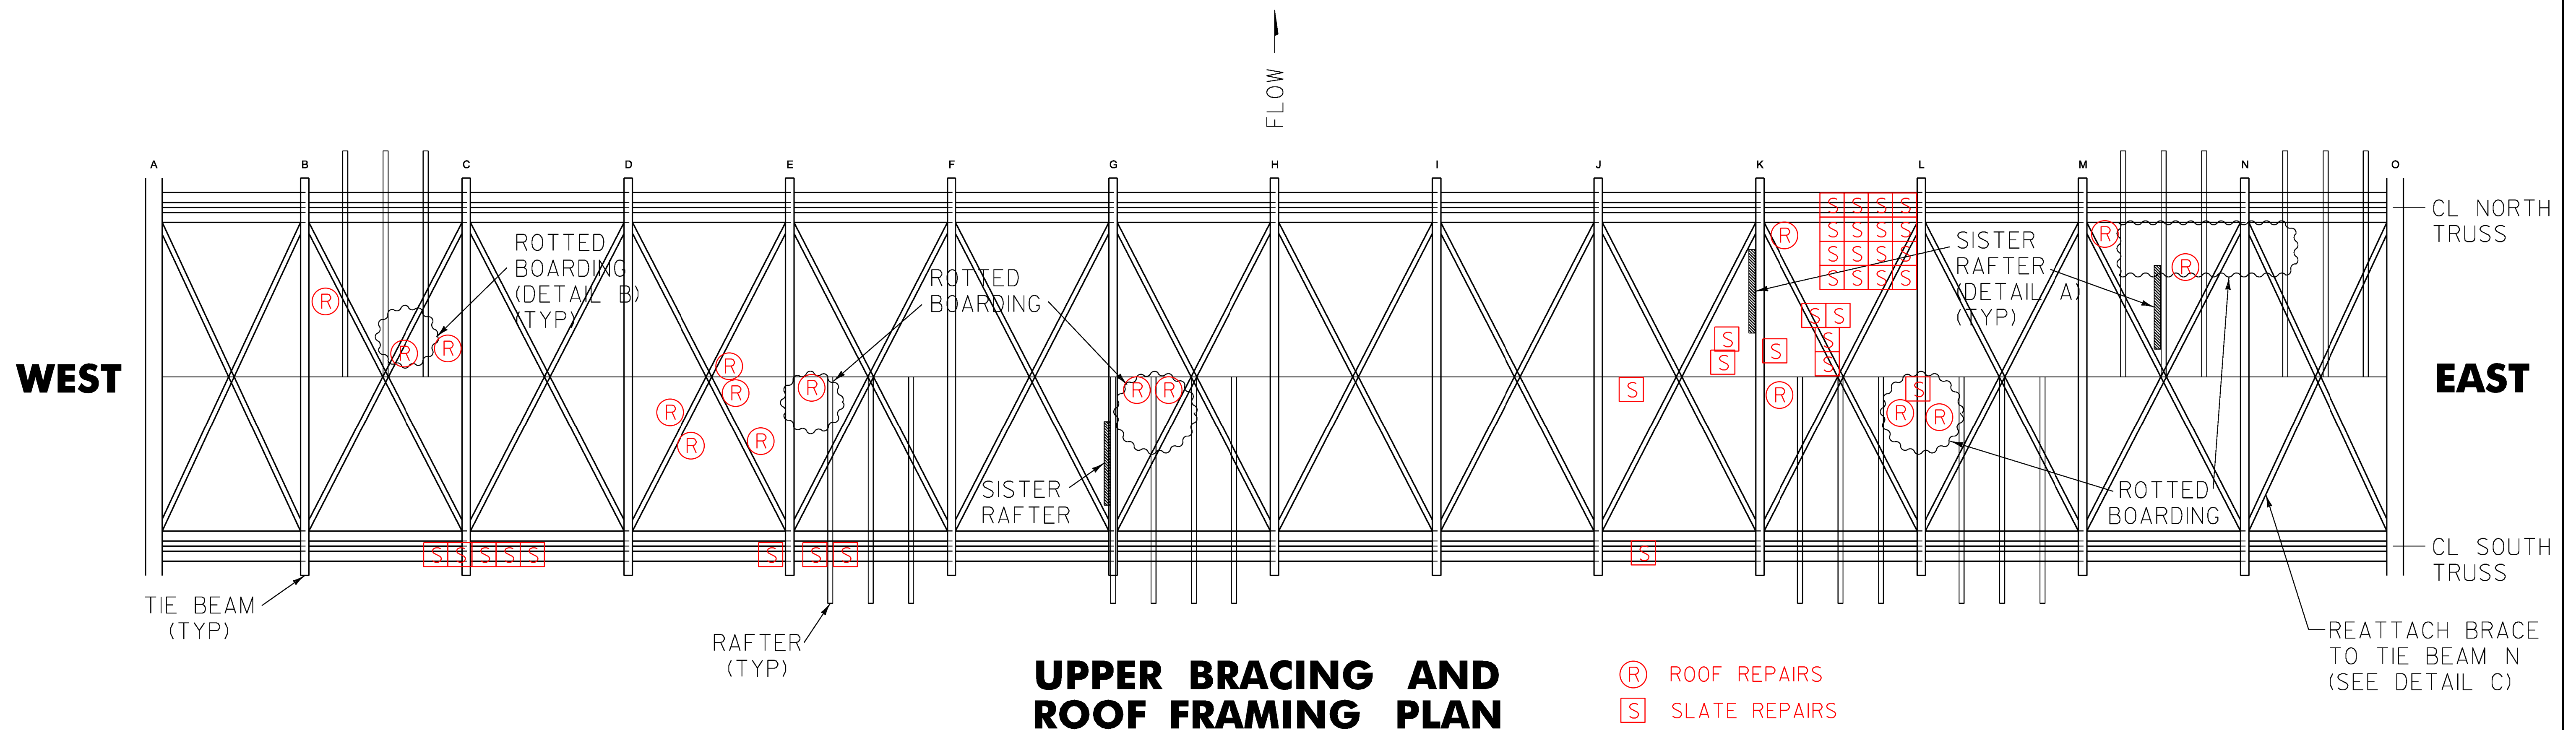

PROJECT NAME: SHREWSBURY	
PROJECT NUMBER: BHO 1443(29)	
FILE NAME: I2J350BridgeDetails	PLOT DATE: 18-NOV-2014
PROJECT LEADER: Mark Sargent	DRAWN BY: STRI
DESIGNED BY: John Weaver	CHECKED BY: John Weaver
ROOF REPAIR DETAILS	SHEET 10 OF 23