


ABUTMENT #1 ELEVATION


SCALE: $\frac{1}{8}'' = 1' - 0''$

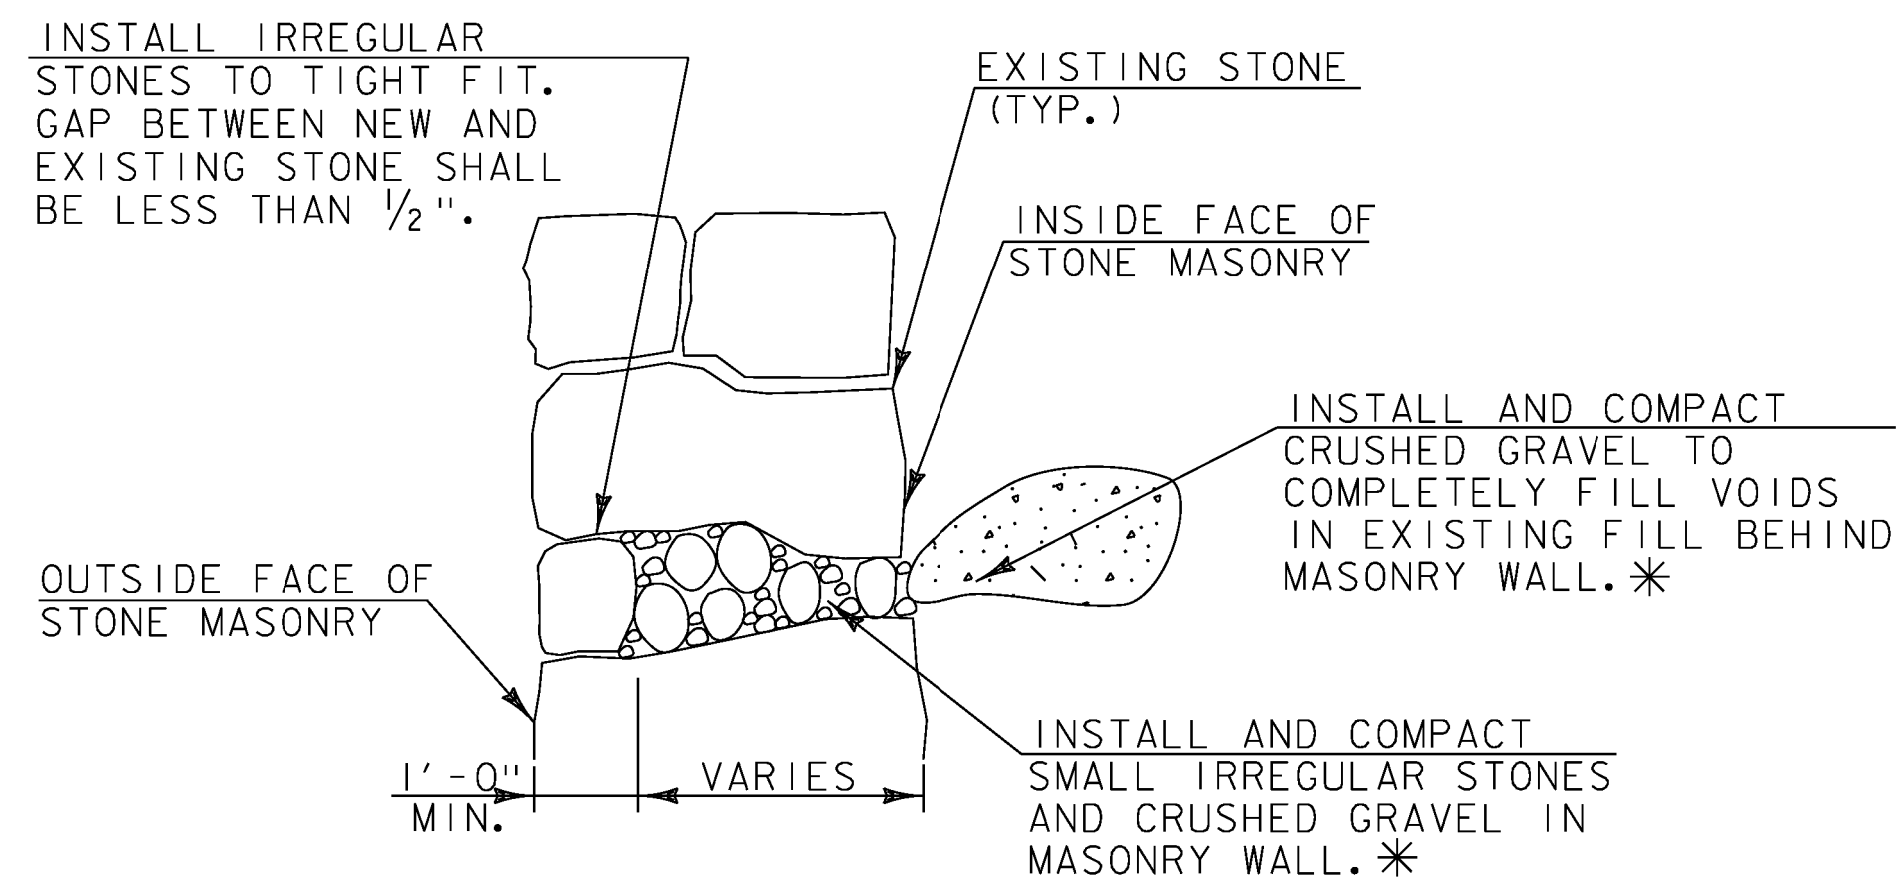

REPAIRING STONE MASONRY DETAIL


N. T. S.

*USE TAMPING RODS OR OTHER METHODS ACCEPTABLE TO THE ENGINEER.

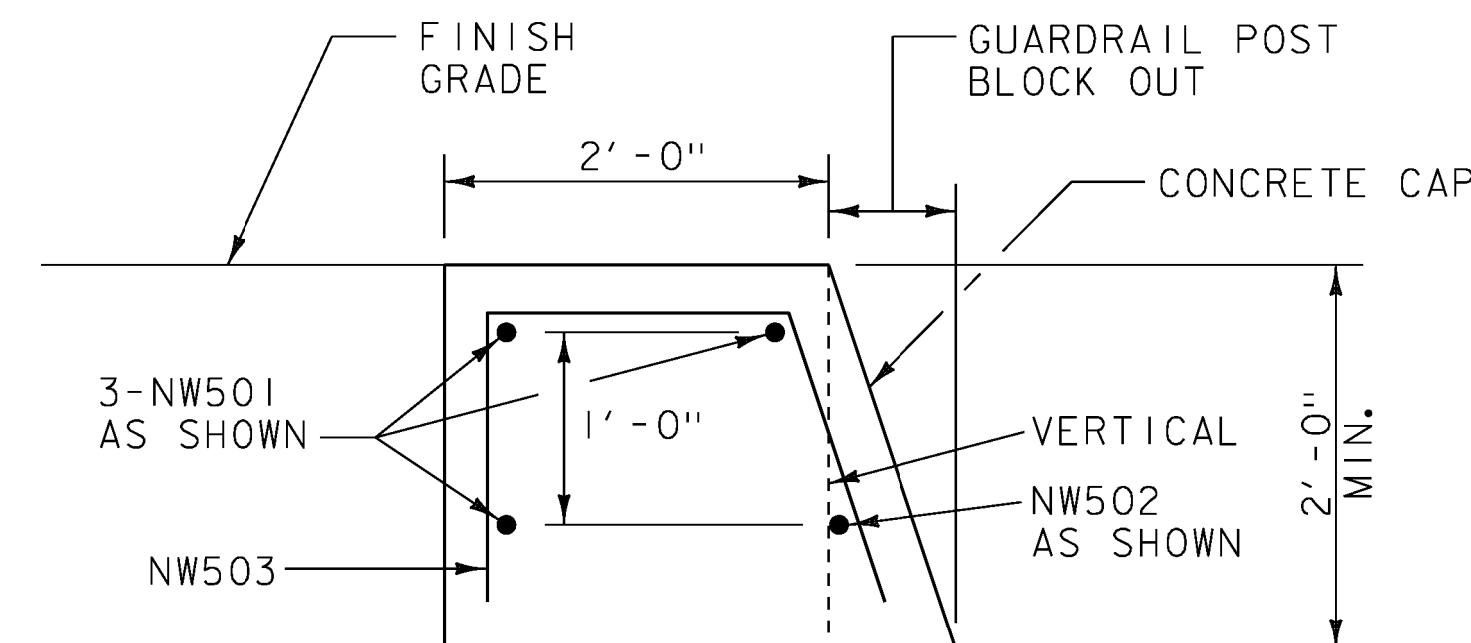


CONCRETE CAP DETAIL A

SCALE: $\frac{1}{2}'' = 1' - 0''$

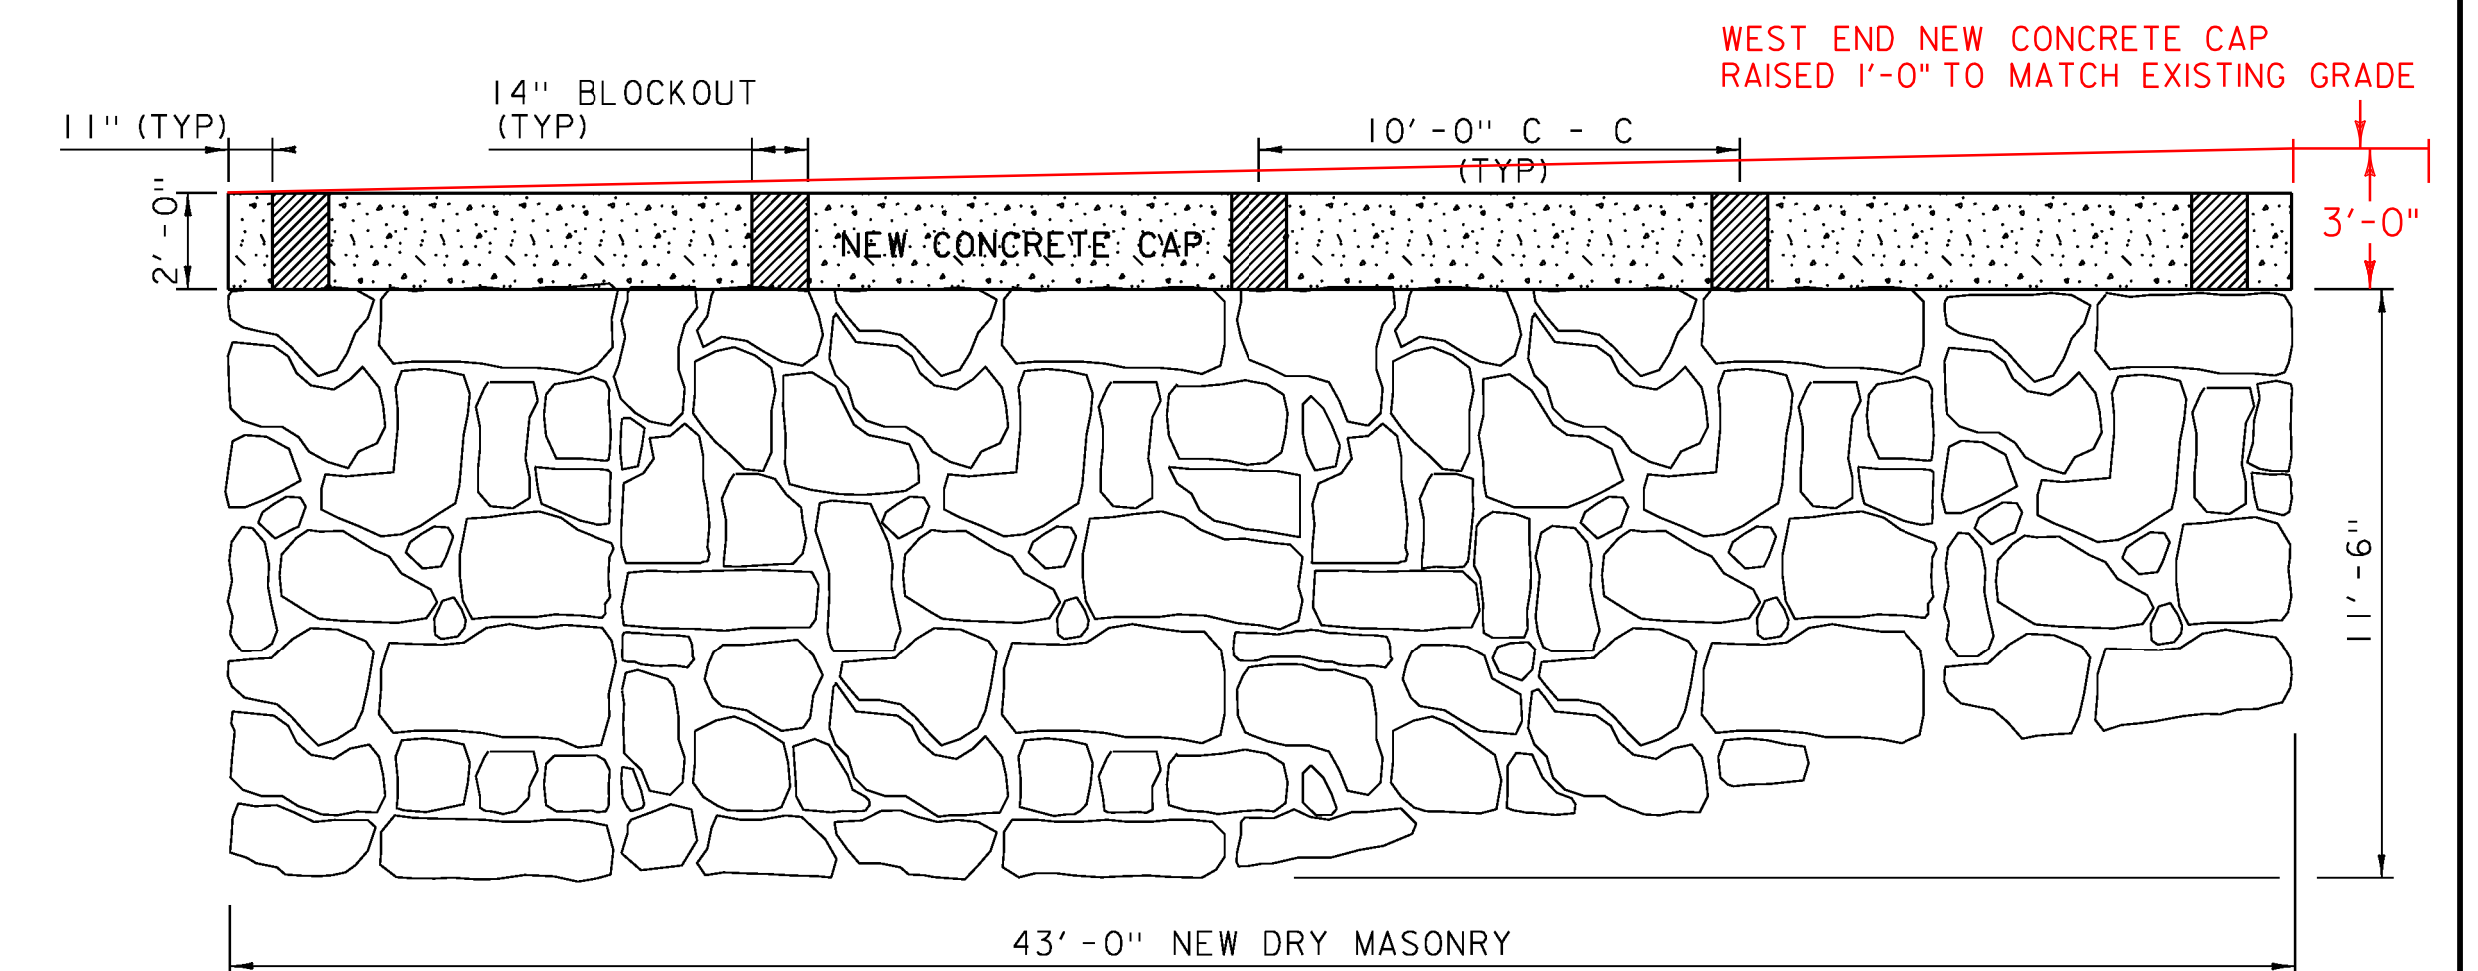


ABUTMENT #2 ELEVATION @ NW WING

SCALE: $\frac{1}{8}'' = 1' - 0''$

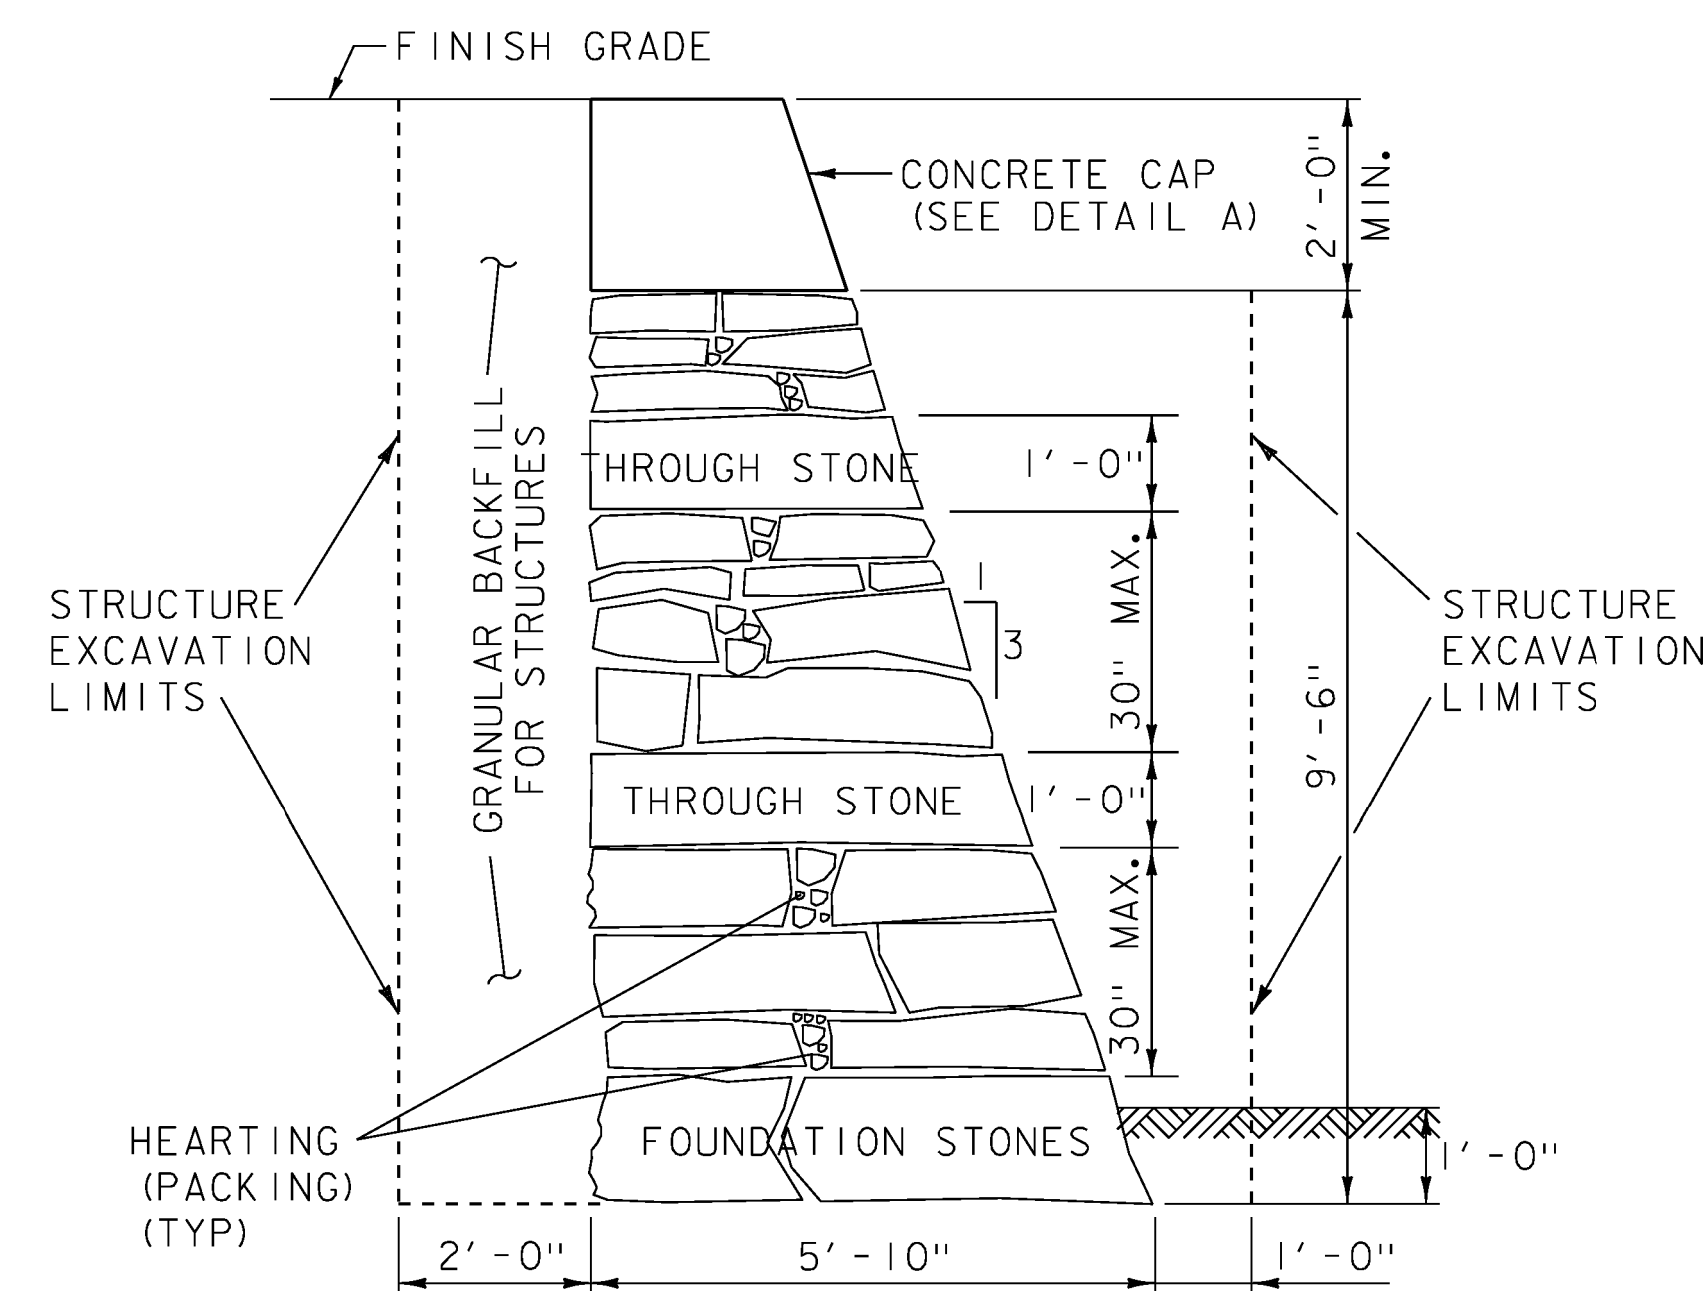

DRY STONE MASONRY TYPICAL SECTION


SCALE: $\frac{1}{4}'' = 1' - 0''$

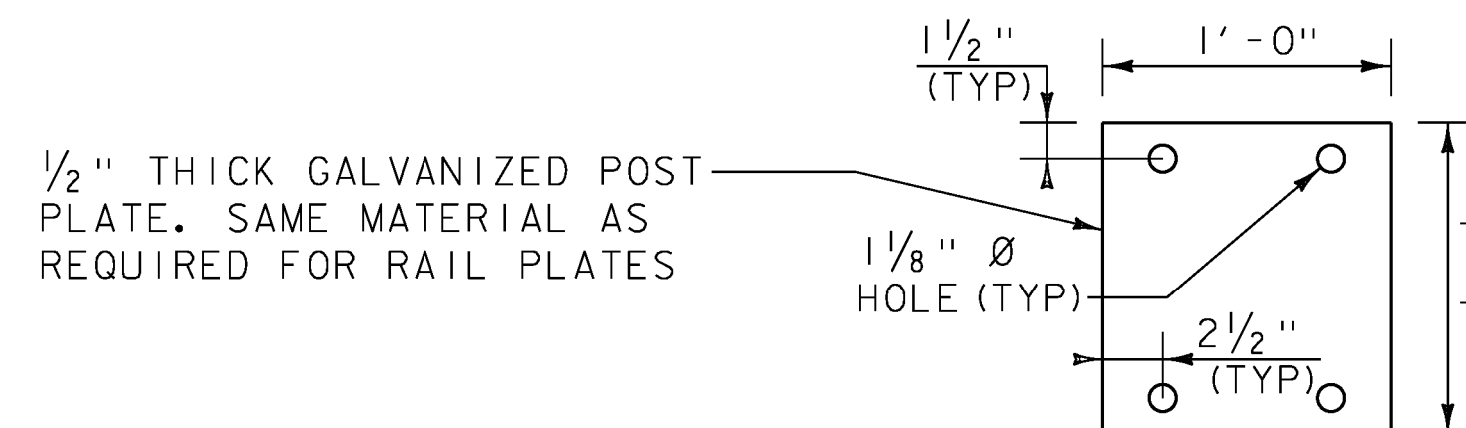

STEEL PLATE DETAIL B


SCALE: $\frac{3}{4}'' = 1' - 0''$

SPECIAL PROVISION (STEEL BACKED TIMBER GUARDRAIL, FASCIA MOUNTED)

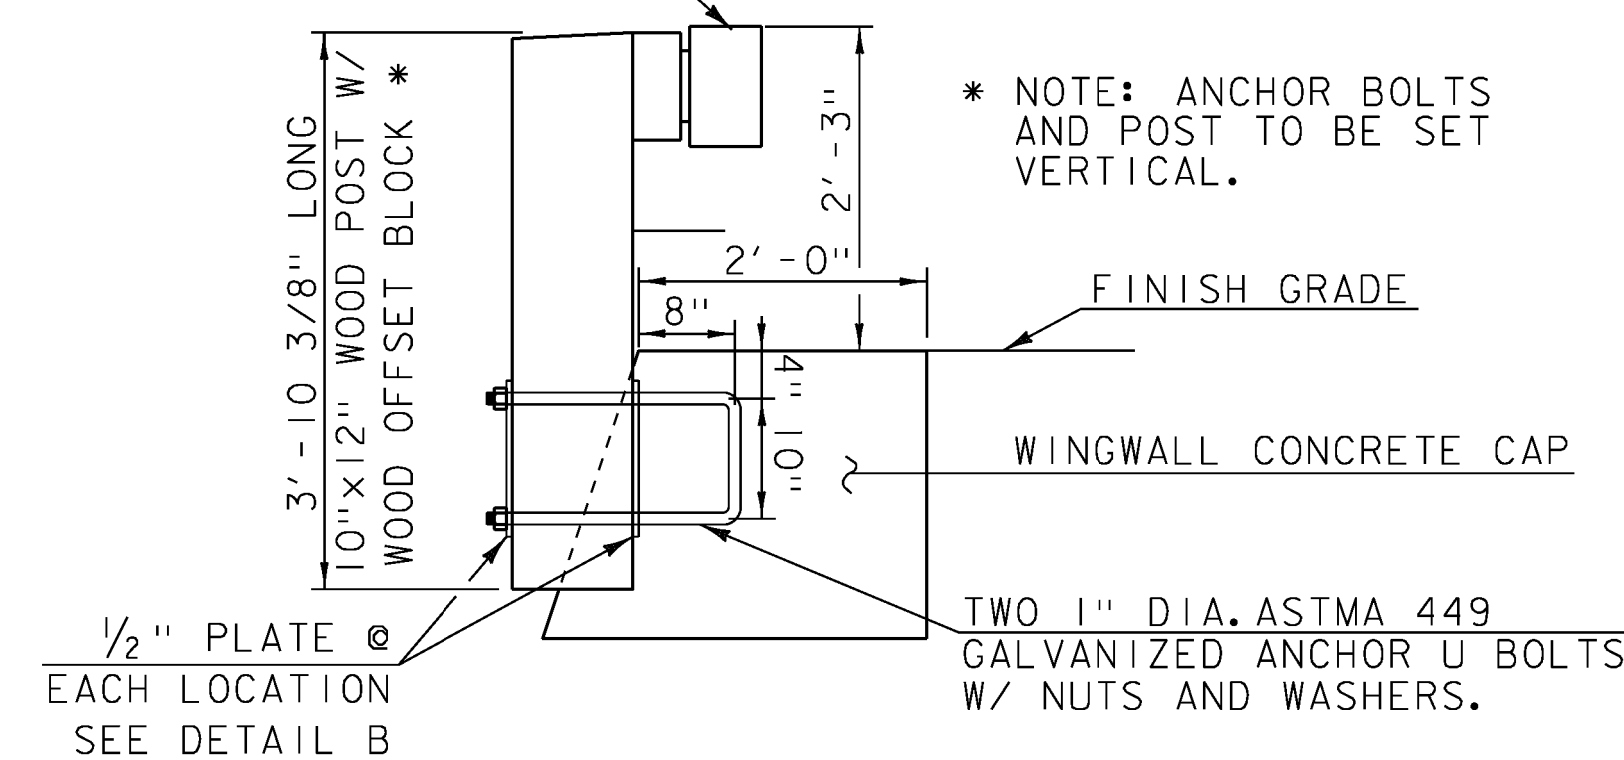


FASCIA MOUNTED, STEEL BACKED TIMBER GUARDRAIL DETAIL

SCALE: $\frac{3}{8}'' = 1' - 0''$

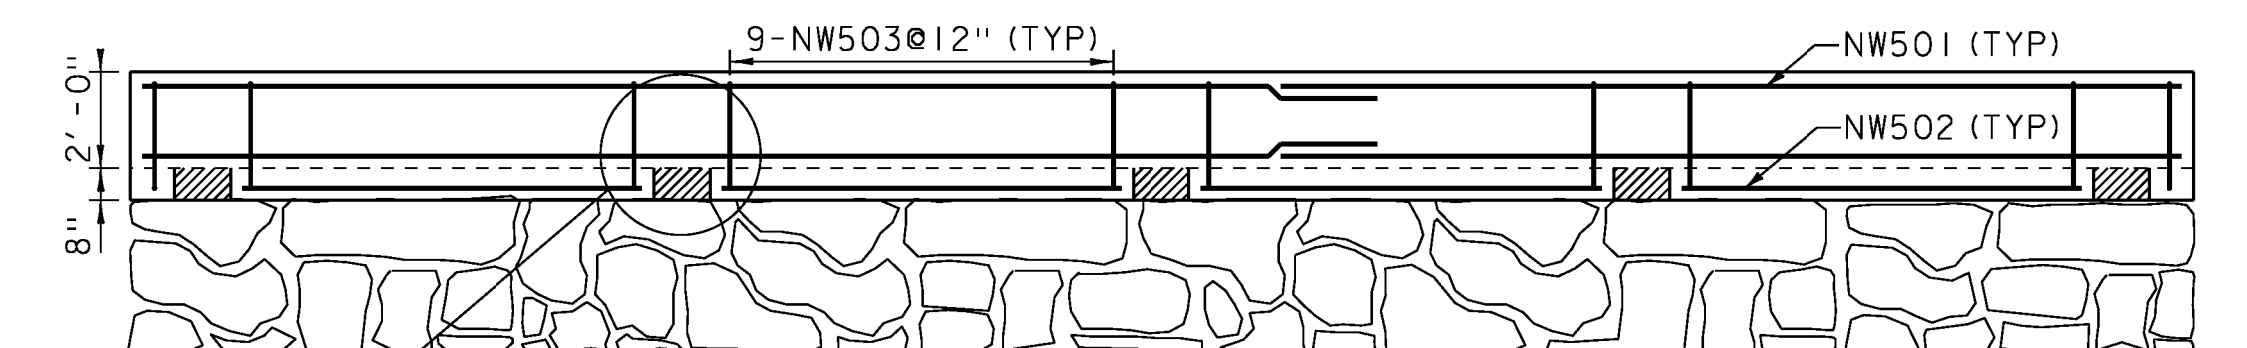

PLAN VIEW NW WINGWALL

SCALE: $\frac{1}{8}'' = 1' - 0''$

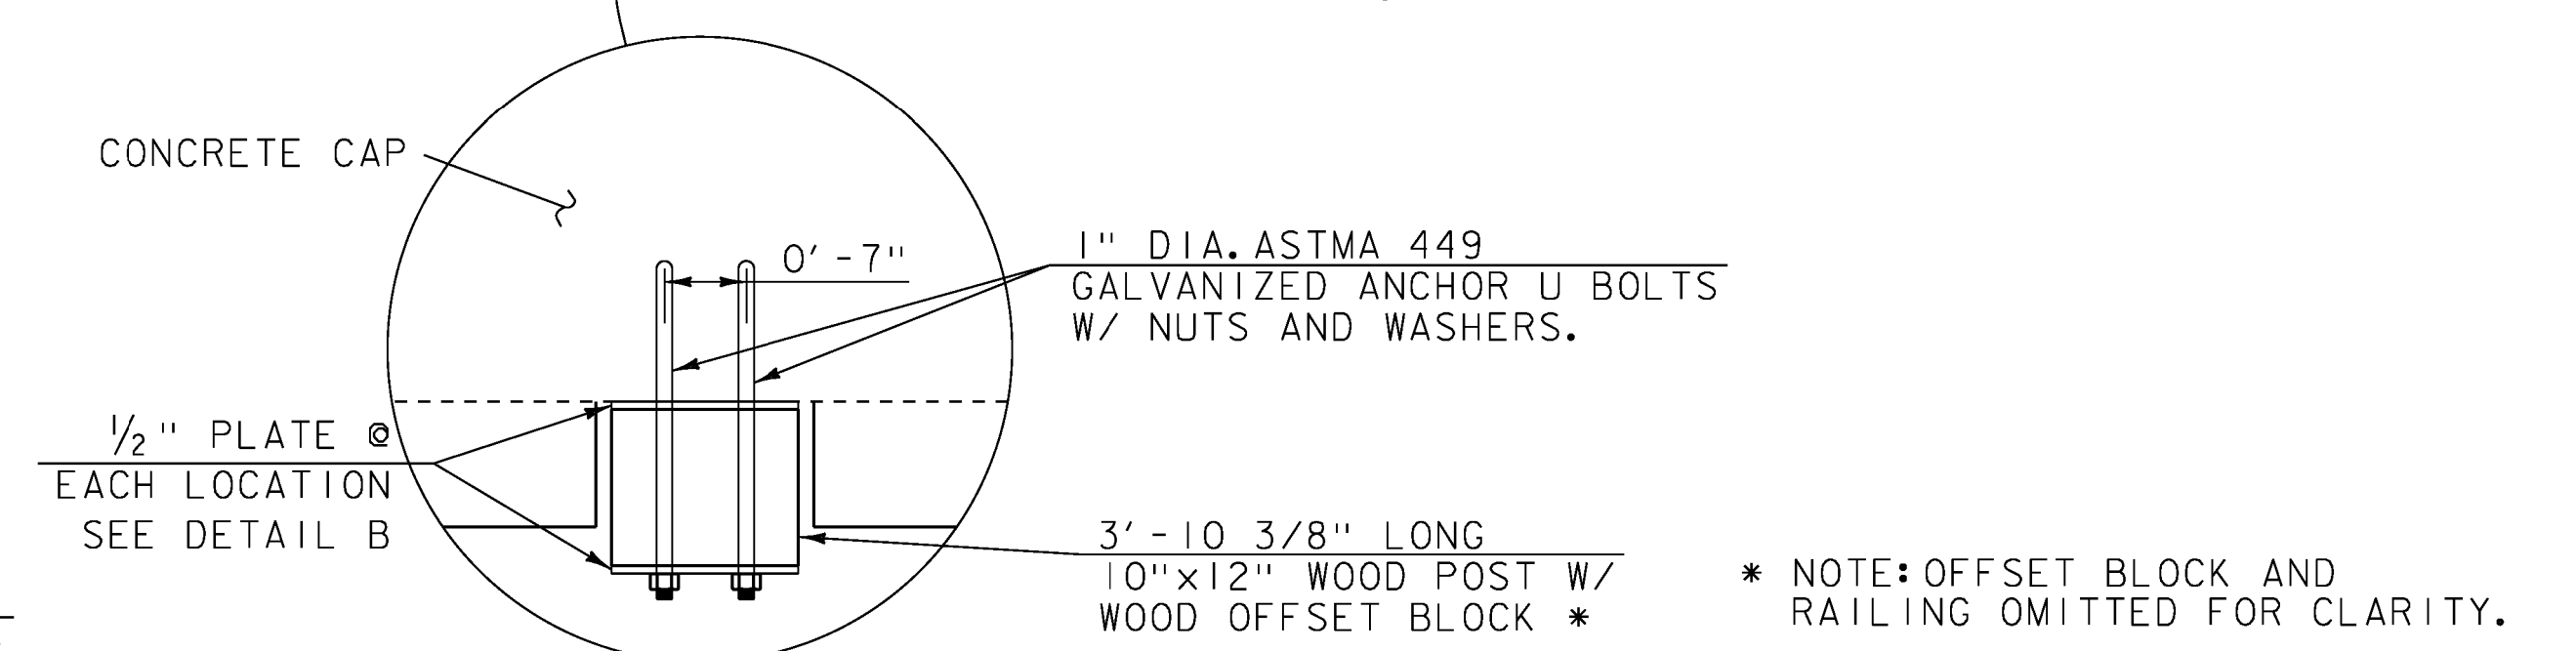

FASCIA MOUNTING DETAIL

SCALE: $\frac{1}{2}'' = 1' - 0''$

PROJECT NAME: SHREWSBURY
PROJECT NUMBER: BHO 1443(49)

FILE NAME: I2J350det.dgn
PROJECT LEADER: Sargent
DESIGNED BY: Weaver
Substructure Details

PLOT DATE: 11-DEC-2014
DRAWN BY: Weeber
CHECKED BY: Weaver
SHEET 14 OF 23