

INDEX OF SHEETS

1. TITLE SHEET
2. QUANTITY SHEET
3. MISCELLANEOUS DETAILS SHEET
4. TRAFFIC CONTROL SHEET
- 5-42 CLASS 2 TOWN HIGHWAY QUANTITY SHEETS 1-38
- 43-56 TOWN HIGHWAY COUNTY MAP SHEETS 1-14


STANDARDS LIST

T-1	8-6-12
T-24	8-6-12
T-28	8-6-12
T-29	8-6-12

STATE OF VERMONT
AGENCY OF TRANSPORTATION



PROPOSED IMPROVEMENT
STATEWIDE
CLASS 2 TOWN HIGHWAY

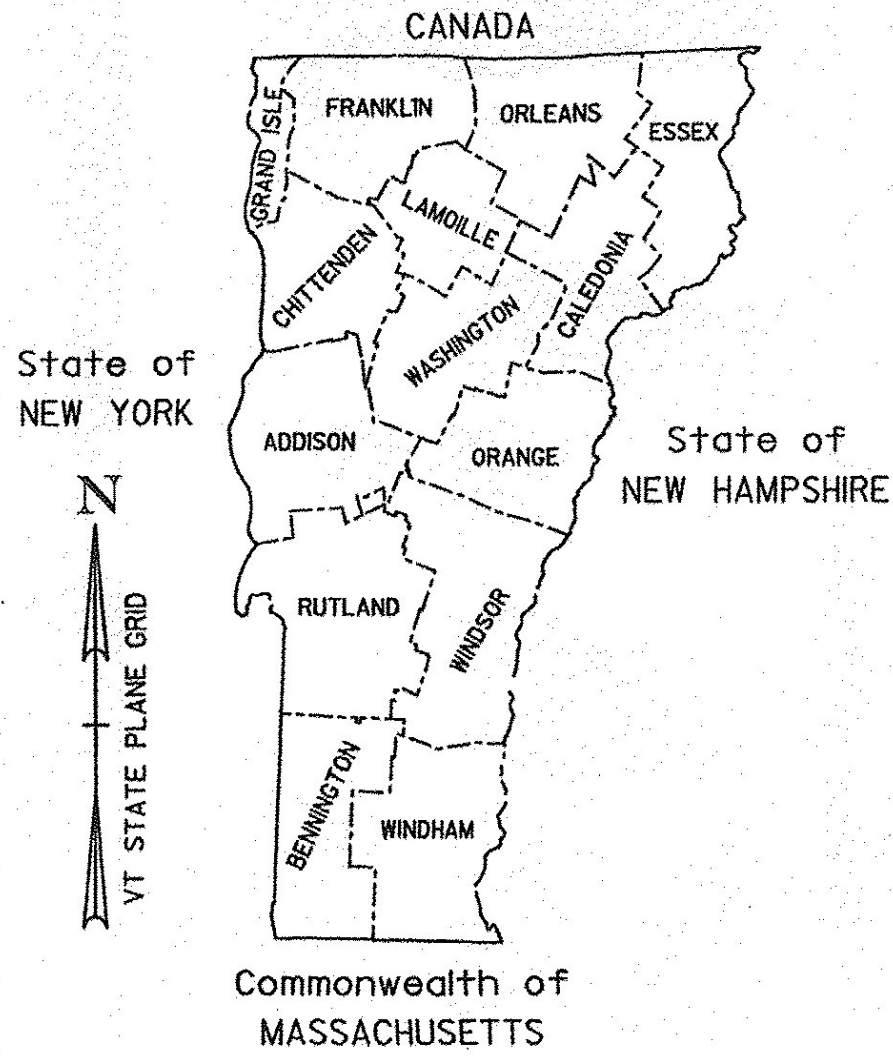

RECORD PLANS

CONTRACTOR: HI-WAY SAFETY SYSTEMS, INC. - ROCKLAND, MA

RESIDENT ENGINEER: JOSH HULETT

CONSTRUCTION BEGAN: JUNE 22, 2015

CONSTRUCTION COMPLETE: OCTOBER 10, 2016

RECORD PLANS BY: JOSH HULETT & JESSE IVES

I HEREBY CERTIFY THAT ALL THE CONSTRUCTION REQUIRED BY THIS SET OF DRAWINGS HAS BEEN ACCOMPLISHED AS INDICATED HEREIN.



BY Josh Hulett RESIDENT ENGINEER

DATE NOVEMBER 3, 2017

NOTE: Any further information concerning final quantities, amounts or other details relative to this project may be found at Central Files in the electronic archives.

WORK TO BE PERFORMED ON THIS PROJECT CONSISTS OF PAINTING 4" DOUBLE YELLOW CENTERLINE MARKINGS ON CLASS 2 TOWN HIGHWAYS.

LENGTH OF PROJECT = 11,488,947.00 FT = 2,175.937 MILES

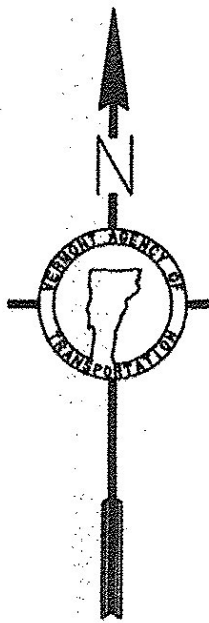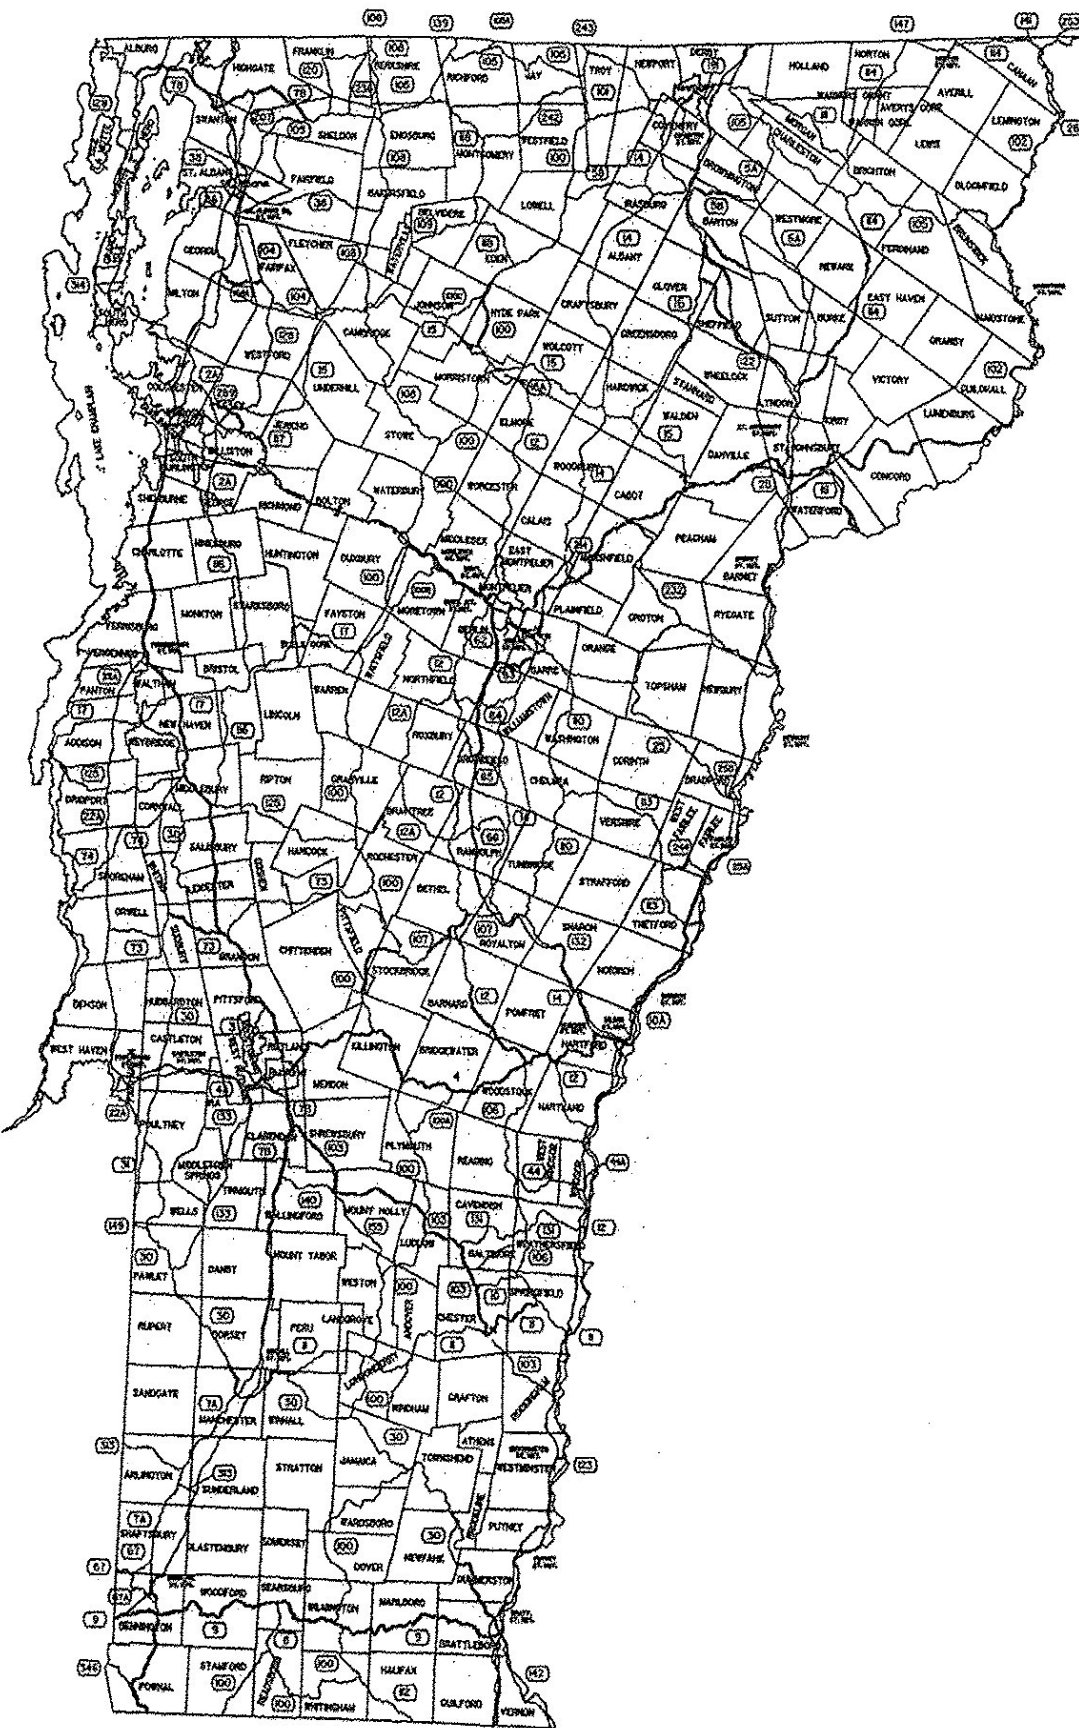

CONSTRUCTION IS TO BE CARRIED ON IN ACCORDANCE WITH THESE PLANS AND THE STANDARD SPECIFICATIONS FOR CONSTRUCTION DATED 2011, AS APPROVED BY THE FEDERAL HIGHWAY ADMINISTRATION ON JULY 20, 2011 FOR USE ON THIS PROJECT, INCLUDING ALL SUBSEQUENT REVISIONS AND SUCH REVISED SPECIFICATIONS AND SPECIAL PROVISIONS AS ARE INCORPORATED IN THESE PLANS.

QUALITY ASSURANCE PROGRAM : LEVEL 3

SURVEYED BY : N/A

SURVEYED DATE : N/A

DATUM

VERTICAL N/A

HORIZONTAL N/A

BUILT AS DESIGNED

DIRECTOR OF PROJECT DELIVERY

APPROVED [Signature] DATE 1/29/2015

PROJECT MANAGER : PATRICIA COBURN, P.E.

PROJECT NAME : STATEWIDE

PROJECT NUMBER : HES MARK (404)

SHEET 1 OF 56 SHEETS





STATE OF VERMONT
AGENCY OF TRANSPORTATION

QUANTITY SHEET

[illegible]

PROJECT NAME: STATEWIDE
PROJECT NUMBER: HES MARK(404)


FILE NAME: +14186.dgn PLOT DATE: 1/29/2015
PROJECT LEADER: P. COBURN DRAWN BY: K. RECORD
DESIGNED BY: K. SWEET CHECKED BY: L. DEGUTIS
QUANTITY SHEET SHEET 2 OF 56

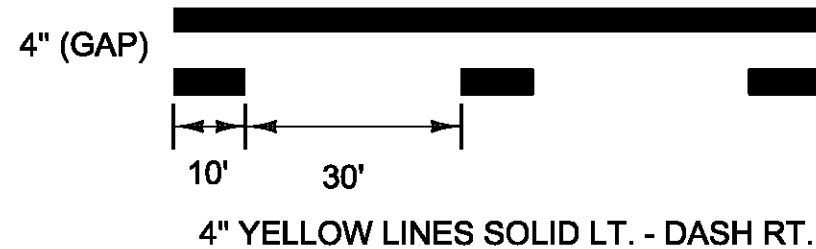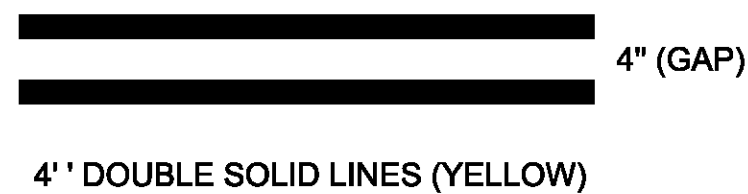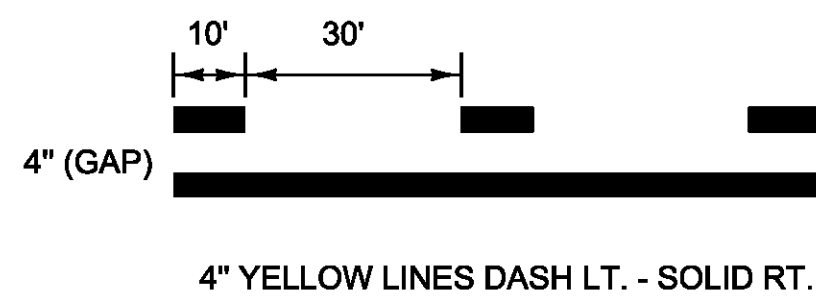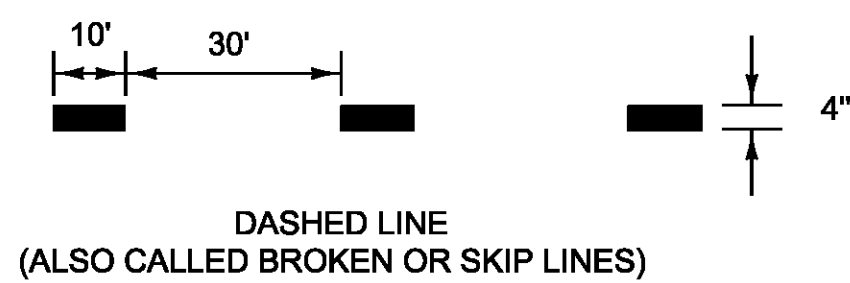

PAVEMENT MARKING LINE DETAILS

NOTE:

1. PAINT CENTERLINE MARKINGS TO MATCH EXISTING OR AS DIRECTED BY THE ENGINEER.

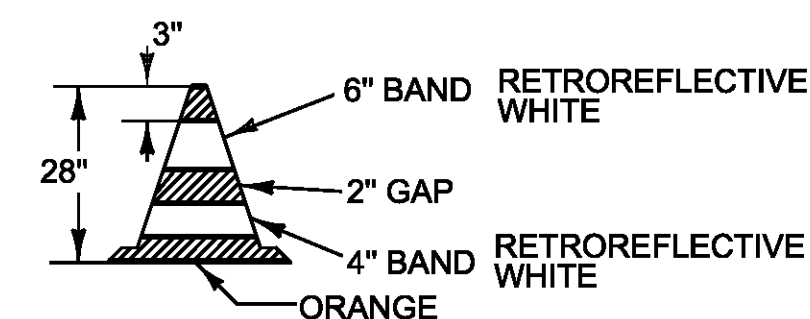


28" RETROREFLECTORIZED CONE

NOTES:

1. 28" RETROREFLECTORIZED CONES SHALL BE USED ON ALL ROADWAYS.
2. CONES MAY BE WEIGHTED TO PREVENT OVER-TURNING, HOWEVER THE WEIGHTS SHALL NOT PRESENT A HAZARD IF THE CONE IS STRUCK.

GENERAL NOTES:

1. THE CONTRACTOR SHALL WORK WITH VTRANS TO SCHEDULE MARKING ON CLASS 2 TOWN HIGHWAYS THAT ARE OTHERWISE SCHEDULED FOR REPAIRS OR REPAVING.
2. THE CONTRACTOR WILL BE RESPONSIBLE FOR INSTALLING CENTERLINE MARKINGS WITHIN 2 WEEKS OF NOTIFICATION FROM THE ENGINEER THAT REPAVED TOWN HIGHWAY IS READY FOR MARKING.
3. THIS PROJECT WILL BE A TWO YEAR CONTRACT. ALL WORK SPECIFIED IS TO BE COMPLETED TWICE, ONCE IN EACH YEAR, OR AS DIRECTED BY THE ENGINEER. QUANTITIES ARE FOR TWO APPLICATIONS. SEE THE SPECIAL PROVISIONS FOR CONTRACT WORK COMPLETION REQUIREMENTS.
4. TOWN HIGHWAY MAPS ARE AVAILABLE FOR REFERENCE IF NEEDED FROM THE VTRANS WEBSITE.

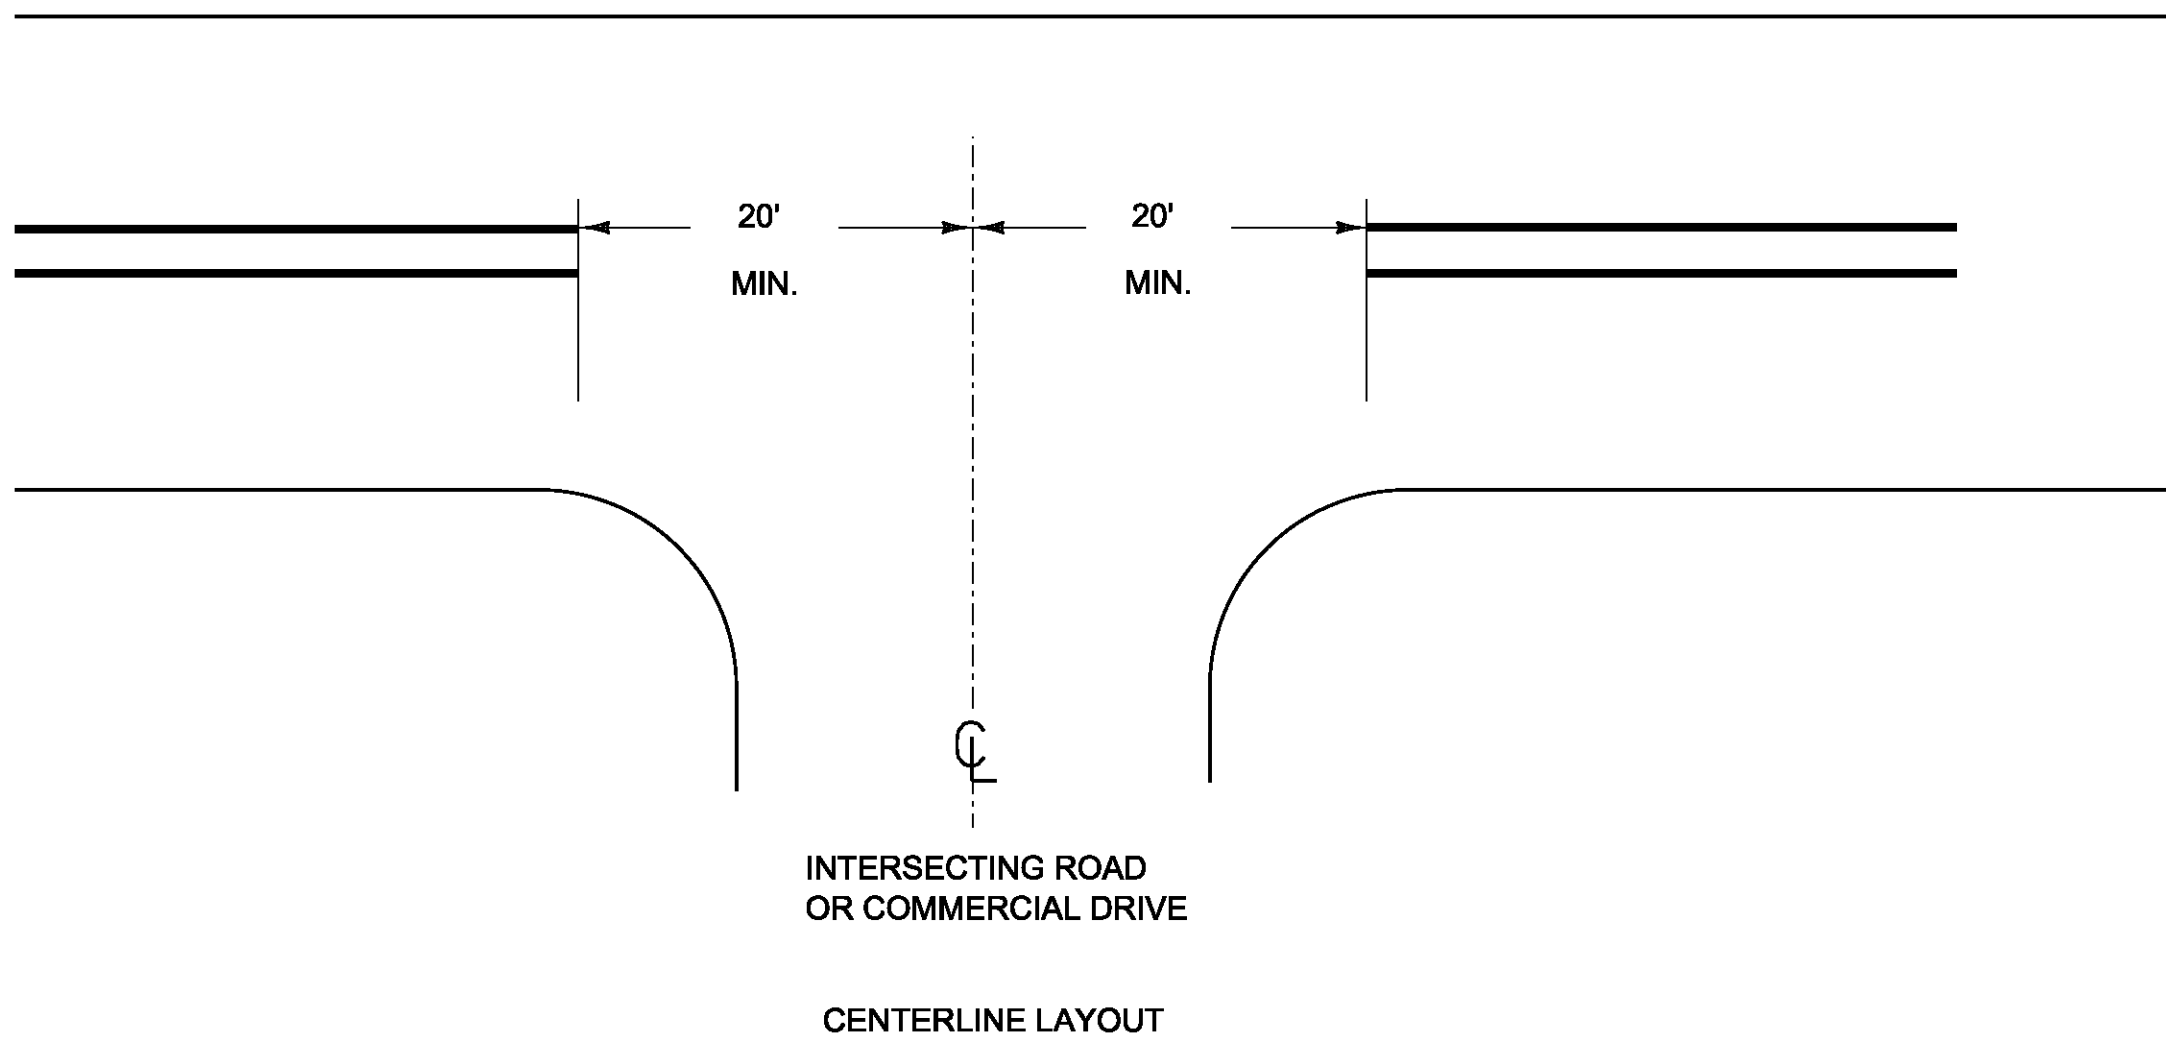

CENTERLINE BREAKS:


1. AT ALL STATE HIGHWAYS, TOWN HIGHWAYS THAT HAVE STOP OR YIELD SIGNS INSTALLED.
2. COMMERCIAL DRIVES:
 - A. WHERE A SEPARATE TURN LANE EXISTS ON THE MAIN LINE (LT. OR RT.).
 - B. WHERE SIGNIFICANT TRAFFIC VOLUMES EXIST.
3. ALL MARKING SHALL MATCH EXISTING.

NOT TO SCALE

PROJECT NAME: STATEWIDE
PROJECT NUMBER: HES MARK(404)


FILE NAME: t14t186.dgn
PROJECT LEADER: P. COBURN
DESIGNED BY: K. SWEET
MISCELLANEOUS DETAILS SHEET
PLOT DATE: 1/29/2015
DRAWN BY: K. SWEET
CHECKED BY: I. DEGUTIS
SHEET 3 OF 56

TRAFFIC CONTROL PLAN

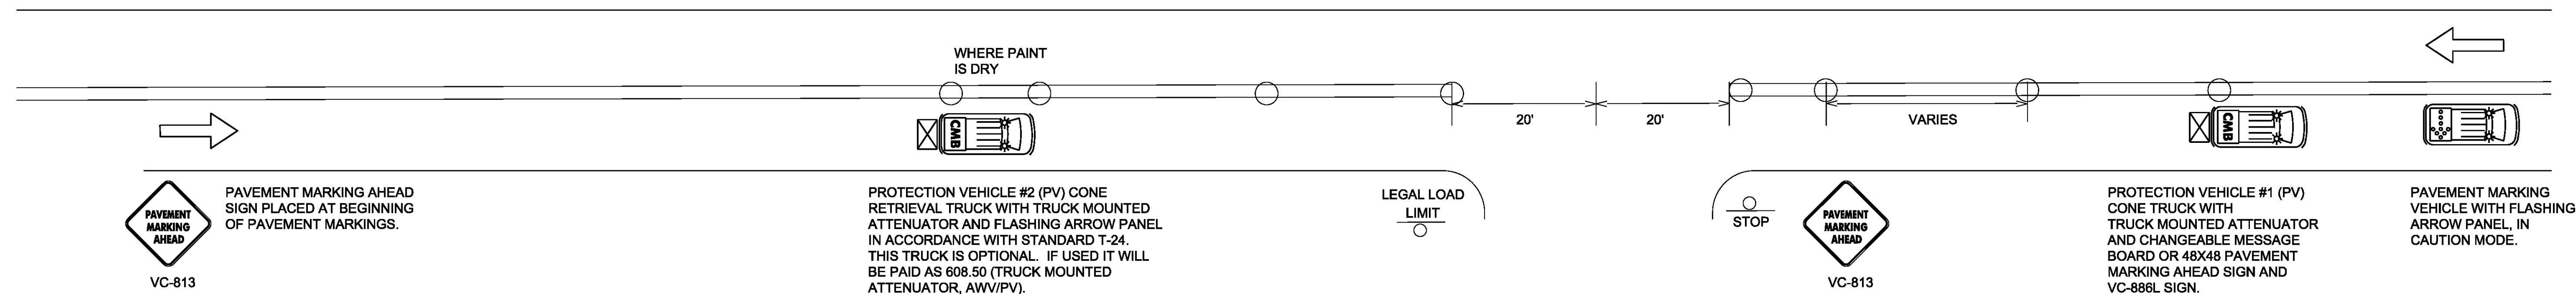


NOTES

- ALL WORK VEHICLES USED SHALL DISPLAY HIGH-INTENSITY ROTATING, FLASHING, OSCILLATING OR STROBE LIGHTS.
- ALL PROTECTION VEHICLES SHALL BE EQUIPPED WITH A TRUCK MOUNTED ATTENUATOR WITH A VC-886(L/R) SIGN ATTACHED AND A FLASHING ARROW PANEL IN ACCORDANCE WITH STANDARD T-24. PAYMENT WILL BE MADE UNDER ITEM 608.50 (TRUCK MOUNTED ATTENUATOR, AWV/PV).
- FLASHING ARROW PANELS MOUNTED TO VEHICLES WILL NOT BE PAID FOR DIRECTLY, BUT WILL BE CONSIDERED INCIDENTAL TO ITEM 641.10 (TRAFFIC CONTROL). FLASHING ARROW PANELS SHALL BE USED IN CAUTION MODE WHEN VEHICLE IS IN TRAVEL LANE.
- PROTECTION VEHICLE #1 SHALL TRAVEL AT A VARYING DISTANCE FROM PAVEMENT MARKING VEHICLE WHILE SETTING CONES ON THE WET PAINT TO ENSURE ADEQUATE SIGHT DISTANCE FOR TRAFFIC APPROACHING FROM THE REAR.
- UNIFORMED TRAFFIC OFFICER (UTO) REQUIRED FOR NIGHT WORK, AND AT OTHER TIMES AS DIRECTED BY THE ENGINEER.
- THE NUMBER OF CHANNELIZING DEVICES AND OTHER TRAFFIC CONTROL DEVICES SHOWN ON THIS SHEET ARE FOR ILLUSTRATIVE PURPOSES ONLY. THE ACTUAL NUMBER REQUIRED IS TO BE DETERMINED BASED ON FIELD CONDITIONS.
- CONE VEHICLES SHALL HAVE PROTECTIVE CAGES TO PROTECT THE PERSON PLACING AND RETRIEVING CONES.
- PAVEMENT MARKING AHEAD SIGNS SHALL BE PLACED AT THE BEGINNING OF PAVEMENT MARKING OPERATION AND AT A MINIMUM OF EVERY 3 MILES. THEY SHALL ALSO BE PLACED AFTER EVERY NUMBERED STATE HIGHWAY OR INTERSECTIONS INCLUDING COMMERCIAL DRIVES.
- WORK VEHICLES SHALL PULL OVER TO ALLOW VEHICLES TO PASS AT REASONABLE INTERVALS TO AVOID EXCESSIVE QUEUING AND DELAYS.
- CONE PICK-UP MAY BE ACCOMPLISHED USING DEDICATED VEHICLE (PV#2) OR BY PROTECTION VEHICLE #1 WHEN PAINT TRUCK IS NOT OPERATING AND PAINT IS DRY. QUANTITY OF 608.50 (TRUCK MOUNTED ATTENUATOR, AWV/PV) SHALL BE MEASURED AS THE NUMBER OF VEHICLE HOURS USED.
- CONES SHALL BE LEFT IN PLACE UNTIL PAINT IS DRY AND NOT TRACKING.
- CONE SPACING SHALL BE ADEQUATE SO THAT DRIVERS CAN ALWAYS SEE ONE CONE.

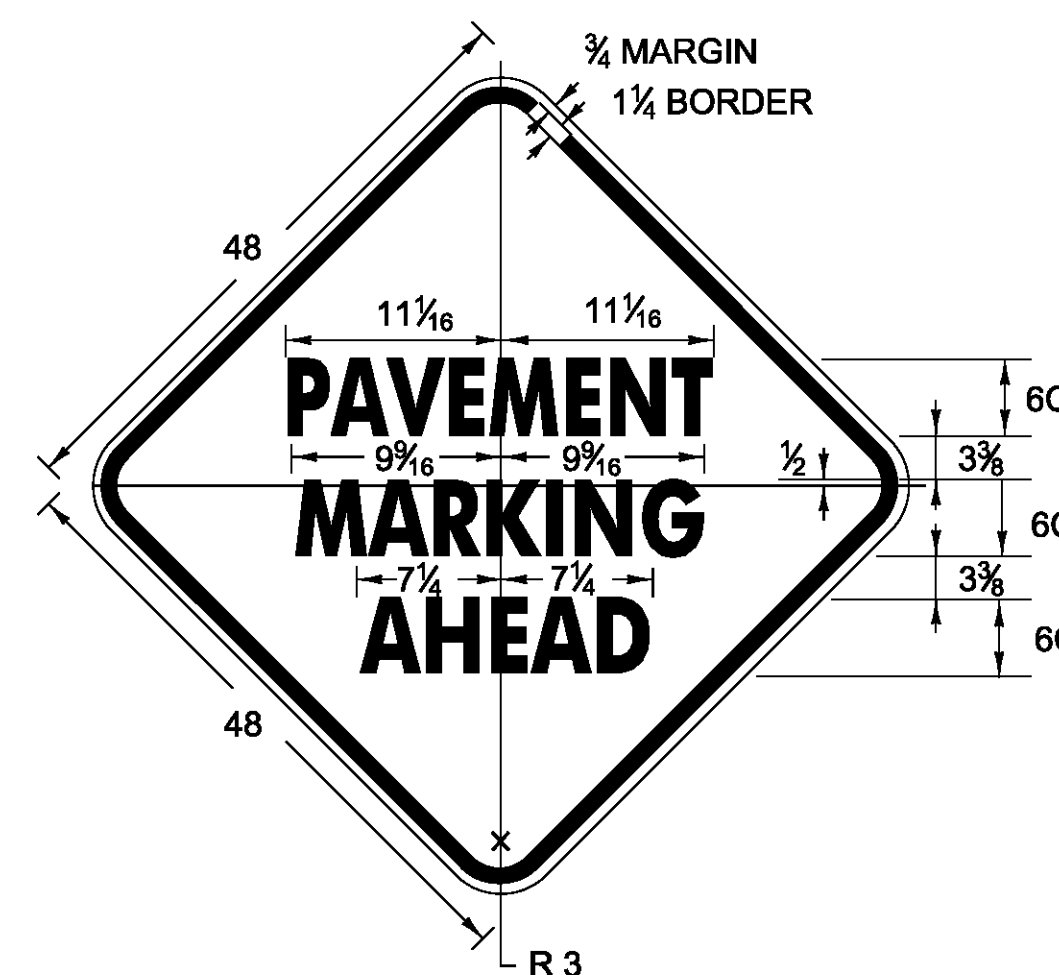

VC-813

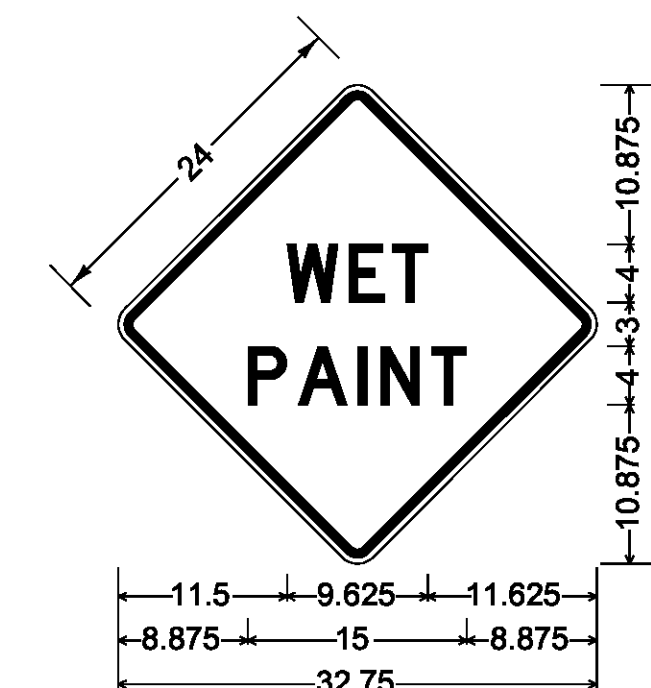

VC-885

LEGEND

- INDICATES TRAFFIC FLOW
- FLASHING ARROW PANEL
- TRUCK MOUNTED ATTENUATOR
- CHANGEABLE MESSAGE BOARD
- 28" RETROREFLECTORIZED CONE
- MARKING OPERATIONS VEHICLE

NOT TO SCALE

PROJECT NAME: STATEWIDE
PROJECT NUMBER: HES MARK(404)

FILE NAME: t14t186.dgn
PROJECT LEADER: P. COBURN
DESIGNED BY: K. SWEET
TRAFFIC CONTROL SHEET

PLOT DATE: 1/29/2015
DRAWN BY: K. SWEET
CHECKED BY: I. DEGUTIS
SHEET 4 OF 56

SUMMARY BY COUNTY OF CLASS 2 TOWN HIGHWAYS

COUNTY	TOWN	TH NUMBER	TH NAME	SURFACE	MILEAGE	LINEAR FT
ADDISON COUNTY	ADDISON	TH-1	LAKE ST.	PAVE	3.75	39,600
ADDISON COUNTY	ADDISON	TH-2	JERSEY ST SOUTH	PAVE	3.40	35,904
ADDISON COUNTY	ADDISON	TH-3	GOODRICH CORNER RD.	PAVE	2.52	26,611
ADDISON COUNTY	BRIDPORT	TH-1	CROWN PT RD	PAVE	5.45	57,552
ADDISON COUNTY	BRIDPORT	TH-2	BASIN HARBOR RD	PAVE	1.40	14,784
ADDISON COUNTY	BRIDPORT	TH-3	LAKE ST.	PAVE	5.88	62,093
ADDISON COUNTY	BRISTOL	TH-1	HARDSCRABBLE RD	PAVE	2.41	25,450
ADDISON COUNTY	BRISTOL	TH-2	RIVER RD	PAVE	0.43	4,541
ADDISON COUNTY	BRISTOL	TH-3	LINCOLN RD	PAVE	1.10	11,616
ADDISON COUNTY	BRISTOL	TH-4	MONKTON RD	PAVE	2.68	28,301
ADDISON COUNTY	BRISTOL	TH-4	NORTH ST	PAVE	1.00	10,560
ADDISON COUNTY	BRISTOL	TH-5	HEWITT RD	PAVE	1.00	10,560
ADDISON COUNTY	BRISTOL	TH-5	SOUTH ST	PAVE	0.59	6,230
ADDISON COUNTY	BRISTOL	TH-6	BURPEE RD	PAVE	1.88	19,853
ADDISON COUNTY	CORNWALL	TH-1	PARKHILL RD	PAVE	0.95	10,032
ADDISON COUNTY	CORNWALL	TH-1	SOUTH BINGHAM ST	PAVE	1.25	13,200
ADDISON COUNTY	CORNWALL	TH-2	CIDER MILL RD	PAVE	1.80	19,008
ADDISON COUNTY	CORNWALL	TH-2	JAMES RD	PAVE	0.69	7,286
ADDISON COUNTY	CORNWALL	TH-3	SWAMP RD	PAVE	1.90	20,064
ADDISON COUNTY	FERRISBURGH	TH-1	GREENBUSH RD	PAVE	0.04	422
ADDISON COUNTY	FERRISBURGH	TH-1	LONG POINT RD	PAVE	1.49	15,734
ADDISON COUNTY	FERRISBURGH	TH-1	OLD HOLLOW RD	PAVE	1.72	18,163
ADDISON COUNTY	FERRISBURGH	TH-1	STAGE RD	PAVE	1.02	10,771
ADDISON COUNTY	FERRISBURGH	TH-2	MONKTON RD	PAVE	3.46	36,538
ADDISON COUNTY	FERRISBURGH	TH-3	BASIN HARBOR RD	PAVE	4.68	49,421
ADDISON COUNTY	FERRISBURGH	TH-4	BUTTON BAY RD	PAVE	2.67	28,195
ADDISON COUNTY	FERRISBURGH	TH-5	LITTLE CHICAGO RD	PAVE	0.90	9,504
ADDISON COUNTY	FERRISBURGH	TH-6	GREENBUSH RD	PAVE	1.96	20,698
ADDISON COUNTY	FERRISBURGH	TH-7	MOUNT PHILO RD	PAVE	0.45	4,752
ADDISON COUNTY	GOSHEN	TH-1	CAPEN HILL RD	PAVE	0.83	8,765
ADDISON COUNTY	GOSHEN	TH-1	HATHAWAY RD	PAVE	0.31	3,274
ADDISON COUNTY	GOSHEN	TH-1	TOWN HILL RD	PAVE	0.65	6,864
ADDISON COUNTY	LEICESTER	TH-1	LEICESTER-WHITING RD	PAVE	3.16	33,370
ADDISON COUNTY	LEICESTER	TH-2	FERN LAKE RD	PAVE	2.35	24,816
ADDISON COUNTY	LEICESTER	TH-2	FERNVILLE RD	PAVE	0.20	2,112
ADDISON COUNTY	LEICESTER	TH-3	SWININGTON RD	PAVE	1.00	10,560
ADDISON COUNTY	LEICESTER	TH-4	LAKE DUNMORE RD	PAVE	3.83	40,445
ADDISON COUNTY	LEICESTER	TH-5	MAPLE ST	PAVE	0.76	8,026
ADDISON COUNTY	LINCOLN	TH-1	RIPTON RD	PAVE	0.03	317
ADDISON COUNTY	LINCOLN	TH-1	SOUTH LINCOLN RD	PAVE	1.07	11,299
ADDISON COUNTY	LINCOLN	TH-1	WEST RIVER RD	PAVE	2.29	24,182
ADDISON COUNTY	LINCOLN	TH-1	EAST RIVER RD	PAVE	1.09	11,510
ADDISON COUNTY	LINCOLN	TH-2	LINCOLN GAP RD	PAVE	2.35	24,816
ADDISON COUNTY SHEET 1 TOTAL					78.39	827,798

PROJECT NAME: STATEWIDE	
PROJECT NUMBER: HES MARK(404)	
FILE NAME: +14+186.dgn	PLOT DATE: 1/29/2015
PROJECT LEADER: P. COBURN	DRAWN BY: K. RECORD
DESIGNED BY: K. SWEET	CHECKED BY: I. DEGUTIS
CLASS 2 TOWN HIGHWAY QUANTITIES I	SHEET 5 OF 56

SUMMARY BY COUNTY OF CLASS 2 TOWN HIGHWAYS

COUNTY	TOWN	TH NUMBER	TH NAME	SURFACE	MILEAGE	LINEAR FT
ADDISON COUNTY	LINCOLN	TH-3	DOWNINGSVILLE RD	PAVE	1.45	15,312
ADDISON COUNTY	LINCOLN	TH-3	QUAKER ST	PAVE	0.90	9,504
ADDISON COUNTY	MIDDLEBURY	TH-4	WEYBRIDGE ST	PAVE	0.77	8,131
ADDISON COUNTY	MIDDLEBURY	TH-5	SEYMORE ST	PAVE	0.96	10,138
ADDISON COUNTY	MIDDLEBURY	TH-6	WASHINGTON ST EXT	PAVE	1.06	11,194
ADDISON COUNTY	MIDDLEBURY	TH-6	WASHINGTON ST EXT	PAVE	0.30	3,168
ADDISON COUNTY	MIDDLEBURY	TH-6	PAINTER RD	PAVE	1.64	17,318
ADDISON COUNTY	MIDDLEBURY	TH-6	MUNGER ST	PAVE	1.28	13,517
ADDISON COUNTY	MIDDLEBURY	TH-7	QUARRY RD	PAVE	2.16	22,810
ADDISON COUNTY	MIDDLEBURY	TH-7	SEMINARY ST	PAVE	0.35	3,696
ADDISON COUNTY	MIDDLEBURY	TH-7	SEMINARY ST EXT	PAVE	0.99	10,454
ADDISON COUNTY	MIDDLEBURY	TH-8	MERCHANTS ROW	PAVE	0.10	1,056
ADDISON COUNTY	MIDDLEBURY	TH-9	HALLADAY RD	PAVE	2.00	21,120
ADDISON COUNTY	MIDDLEBURY	TH-10	SHARD VILLA RD	PAVE	0.95	10,032
ADDISON COUNTY	MIDDLEBURY	TH-10	THREE MILE BRIDGE RD	PAVE	1.17	12,355
ADDISON COUNTY	MIDDLEBURY	TH-12	CADY RD	PAVE	1.26	13,306
ADDISON COUNTY	MIDDLEBURY	TH-13	PULP MILL RD	PAVE	0.03	317
ADDISON COUNTY	MONKTON	TH-1	SILVER ST	PAVE	1.66	17,530
ADDISON COUNTY	MONKTON	TH-1	MONKTON RD	PAVE	5.92	62,515
ADDISON COUNTY	MONKTON	TH-1	MONKTON RD G	PAVE	0.34	3,590
ADDISON COUNTY	MONKTON	TH-2	HAND RD	PAVE	0.05	528
ADDISON COUNTY	MONKTON	TH-2	HOLLOW RD	PAVE	2.93	30,941
ADDISON COUNTY	MONKTON	TH-3	BRISTOL RD	PAVE	5.09	53,750
ADDISON COUNTY	MONKTON	TH-4	STATE PRISON HOLLOW RD	PAVE	1.50	15,840
ADDISON COUNTY	MONKTON	TH-5	HARDSCRABBLE RD	PAVE	0.67	7,075
ADDISON COUNTY	MONKTON	TH-6	TYLER BRIDGE RD	PAVE	2.17	22,915
ADDISON COUNTY	MONKTON	TH-7	PARKS-HURLBURT RD	PAVE	0.61	6,442
ADDISON COUNTY	NEW HAVEN	TH-1	HALLOCK RD	PAVE	1.75	18,480
ADDISON COUNTY	NEW HAVEN	TH-1	QUAKER VILLAGE RD	PAVE	0.75	7,920
ADDISON COUNTY	NEW HAVEN	TH-2	RIVER RD	PAVE	4.72	49,843
ADDISON COUNTY	NEW HAVEN	TH-3	TOWN HILL RD	PAVE	1.81	19,114
ADDISON COUNTY	NEW HAVEN	TH-4	MUNGER ST	PAVE	3.06	32,314
ADDISON COUNTY	NEW HAVEN	TH-5	DOG TEAM RD	PAVE	1.86	19,642
ADDISON COUNTY	NEW HAVEN	TH-6	NORTH ST	PAVE	3.72	39,283
ADDISON COUNTY	ORWELL	TH-1	NORTH ORWELL RD	PAVE	3.55	37,488
ADDISON COUNTY	ORWELL	TH-2	ROUTE 73	PAVE	0.35	3,696
ADDISON COUNTY	ORWELL	TH-2	CHIPMANS POINT RD	PAVE	0.75	7,920
ADDISON COUNTY	ORWELL	TH-2	MT INDEPENCE RD	PAVE	3.00	31,680
ADDISON COUNTY	ORWELL	TH-3	ROUTE 73	PAVE	4.60	48,576
ADDISON COUNTY	ORWELL	TH-4	MT INDEPENCE RD	PAVE	1.54	16,262
ADDISON COUNTY	PANTON	TH-1	PEASE RD	PAVE	0.91	9,610
ADDISON COUNTY	PANTON	TH-1	PANTON RD	PAVE	3.71	39,178
ADDISON COUNTY	PANTON	TH-1	JERSEY ST	PAVE	0.59	6,230
ADDISON COUNTY SHEET 2 TOTAL					74.98	791,789

PROJECT NAME: STATEWIDE	
PROJECT NUMBER: HES MARK(404)	
FILE NAME: +14+186.dgn	PLOT DATE: 1/29/2015
PROJECT LEADER: P. COBURN	DRAWN BY: K. RECORD
DESIGNED BY: K. SWEET	CHECKED BY: I. DEGUTIS
CLASS 2 TOWN HIGHWAY QUANTITIES 2	SHEET 6 OF 56

SUMMARY BY COUNTY OF CLASS 2 TOWN HIGHWAYS

COUNTY	TOWN	TH NUMBER	TH NAME	SURFACE	MILEAGE	LINEAR FT
ADDISON COUNTY	PANTON	TH-1	LAKE RD	PAVE	2.25	23,760
ADDISON COUNTY	PANTON	TH-2	BUTTON BAY RD	PAVE	0.30	3,168
ADDISON COUNTY	PANTON	TH-2	JERSEY ST	PAVE	0.46	4,858
ADDISON COUNTY	PANTON	TH-3	BASIN HARBOR RD	PAVE	0.53	5,597
ADDISON COUNTY	PANTON	TH-4	JERSEY ST.	PAVE	2.03	21,437
ADDISON COUNTY	RIPTON	TH-1	LINCOLN RD	PAVE	1.89	19,958
ADDISON COUNTY	SALISBURY	TH-1	CREEK RD	PAVE	0.69	7,286
ADDISON COUNTY	SALISBURY	TH-1	MAPLE ST	PAVE	0.65	6,864
ADDISON COUNTY	SALISBURY	TH-1	WEST SALISBURY RD	PAVE	3.67	38,755
ADDISON COUNTY	SALISBURY	TH-2	SHARD VILLA RD	PAVE	2.25	23,760
ADDISON COUNTY	SALISBURY	TH-3	LAKE DUNMORE RD	PAVE	4.25	44,880
ADDISON COUNTY	SALISBURY	TH-4	WEST SHORE RD	PAVE	2.09	22,070
ADDISON COUNTY	SALISBURY	TH-5	UPPER PLAINS RD	PAVE	1.67	17,635
ADDISON COUNTY	SHOREHAM	TH-1	RICHVILLE RD	PAVE	4.80	50,688
ADDISON COUNTY	SHOREHAM	TH-2	ROUTE 73	PAVE	0.90	9,504
ADDISON COUNTY	SHOREHAM	TH-3	NORTH ORWELL RD	PAVE	1.65	17,424
ADDISON COUNTY	SHOREHAM	TH-4	LAPHAM BAY RD	PAVE	1.58	16,685
ADDISON COUNTY	STARKSBORO	TH-1	JERUSALEM RD	PAVE	0.10	1,056
ADDISON COUNTY	STARKSBORO	TH-1	TYLER BRIDGE RD	PAVE	0.30	3,136
ADDISON COUNTY	STARKSBORO	TH-2	HINESBURG HOLLOW RD	PAVE	0.86	9,082
ADDISON COUNTY	STARKSBORO	TH-3	STATE PRISON HOLLOW RD	PAVE	1.23	12,989
ADDISON COUNTY	STARKSBORO	TH-4	GORE RD	PAVE	0.91	9,610
ADDISON COUNTY	VERGENNES	TH-3	PANTON RD	PAVE	0.57	6,019
ADDISON COUNTY	VERGENNES	TH-4	MACDONOUGH RD	PAVE	0.95	10,032
ADDISON COUNTY	VERGENNES	TH-5	SOUTH MAPLE ST	PAVE	0.95	10,032
ADDISON COUNTY	VERGENNES	TH-6	GREEN ST	PAVE	0.90	9,504
ADDISON COUNTY	VERGENNES	TH-7	MONKTON RD	PAVE	0.37	3,907
ADDISON COUNTY	WALTHAM	TH-1	GREEN ST	PAVE	3.23	34,109
ADDISON COUNTY	WALTHAM	TH-2	MAPLE ST	PAVE	3.21	33,898
ADDISON COUNTY	WEYBRIDGE	TH-1	WEYBRIDGE RD	PAVE	6.60	69,696
ADDISON COUNTY	WEYBRIDGE	TH-2	JAMES RD	PAVE	1.55	16,368
ADDISON COUNTY	WEYBRIDGE	TH-2	QUAKER VILLAGE RD	PAVE	3.70	39,072
ADDISON COUNTY	WEYBRIDGE	TH-3	HAMILTON RD	PAVE	1.45	15,312
ADDISON COUNTY	WEYBRIDGE	TH-3	MORGAN HORSE FARM RD	PAVE	1.75	18,480
ADDISON COUNTY	WEYBRIDGE	TH-4	PULP MILL BRIDGE RD	PAVE	0.44	4,646
ADDISON COUNTY	WHITING	TH-1	LEICESTER-WHITING RD	PAVE	2.37	25,027
ADDISON COUNTY	WHITING	TH-1	SHOREHAM-WHITING RD	PAVE	1.27	13,411
ADDISON COUNTY	WHITING	TH-2	SAWYER-NEEDHAM RD	PAVE	1.55	16,368
ADDISON COUNTY SHEET 3 TOTAL					65.92	696,084
ADDISON COUNTY SHEET 1 TOTAL					78.39	827,798
ADDISON COUNTY SHEET 2 TOTAL					74.98	791,789
ADDISON COUNTY SHEET 3 TOTAL					65.92	696,084
ADDISON COUNTY TOTALS					219.29	2,315,671

PROJECT NAME: STATEWIDE	
PROJECT NUMBER: HES MARK(404)	
FILE NAME: +14+186.dgn	PLOT DATE: 1/29/2015
PROJECT LEADER: P. COBURN	DRAWN BY: K. RECORD
DESIGNED BY: K. SWEET	CHECKED BY: I. DEGUTIS
CLASS 2 TOWN HIGHWAY QUANTITIES 3	SHEET 7 OF 56

SUMMARY BY COUNTY OF CLASS 2 TOWN HIGHWAYS

COUNTY	TOWN	TH NUMBER	TH NAME	SURFACE	MILEAGE	LINEAR FT
BENNINGTON COUNTY	ARLINGTON	TH-1	EAST ARLINGTON RD	PAVE	1.54	16,262
BENNINGTON COUNTY	ARLINGTON	TH-3	SANDGATE RD	PAVE	1.25	13,200
BENNINGTON COUNTY	ARLINGTON	TH-4	WARM BROOK RD	PAVE	1.65	17,424
BENNINGTON COUNTY	ARLINGTON	TH-5	MAPLE HILL RD	PAVE	0.08	845
BENNINGTON COUNTY	ARLINGTON	TH-6	OLD MILL RD	PAVE	0.39	4,118
BENNINGTON COUNTY	BENNINGTON	TH-3	BANK ST	PAVE	0.08	845
BENNINGTON COUNTY	BENNINGTON	TH-3	BEACH ST	PAVE	0.69	7,286
BENNINGTON COUNTY	BENNINGTON	TH-3	SOUTH STREAM RD	PAVE	2.50	26,400
BENNINGTON COUNTY	BENNINGTON	TH-5	PARK ST	PAVE	0.66	6,970
BENNINGTON COUNTY	BENNINGTON	TH-5	EAST RD	PAVE	2.73	28,829
BENNINGTON COUNTY	BENNINGTON	TH-5	COUNTY ST	PAVE	0.20	2,112
BENNINGTON COUNTY	BENNINGTON	TH-6	BRANCH ST	PAVE	0.19	2,006
BENNINGTON COUNTY	BENNINGTON	TH-6	COUNTY ST	PAVE	0.59	6,230
BENNINGTON COUNTY	BENNINGTON	TH-6	GAGE ST	PAVE	0.34	3,590
BENNINGTON COUNTY	BENNINGTON	TH-7	BENMONT AVE	PAVE	0.79	8,342
BENNINGTON COUNTY	BENNINGTON	TH-7	NORTHSIDE DR	PAVE	0.21	2,218
BENNINGTON COUNTY	BENNINGTON	TH-8	MONUMENT AVE	PAVE	1.90	20,064
BENNINGTON COUNTY	BENNINGTON	TH-9	BERARD ST	PAVE	0.06	634
BENNINGTON COUNTY	DORSET	TH-1	DORSET WEST RD	PAVE	4.60	48,576
BENNINGTON COUNTY	DORSET	TH-2	CHURCH ST	PAVE	0.72	7,603
BENNINGTON COUNTY	DORSET	TH-3	MORSE HILL RD	PAVE	3.70	39,072
BENNINGTON COUNTY	DORSET	TH-4	BENEDICT RD	PAVE	0.46	4,858
BENNINGTON COUNTY	DORSET	TH-5	MAD TOM RD	PAVE	0.89	9,398
BENNINGTON COUNTY	LANDGROVE	TH-3	WINHALL HOLLOW RD	PAVE	0.10	1,056
BENNINGTON COUNTY	MANCHESTER	TH-2	WEST RD	PAVE	1.27	13,411
BENNINGTON COUNTY	MANCHESTER	TH-3	RIVER RD	PAVE	1.18	12,461
BENNINGTON COUNTY	MANCHESTER	TH-3	WEST RD	PAVE	2.17	22,915
BENNINGTON COUNTY	MANCHESTER	TH-4	RIVER RD	PAVE	1.98	20,909
BENNINGTON COUNTY	MANCHESTER	TH-4	UNION ST	PAVE	1.01	10,666
BENNINGTON COUNTY	MANCHESTER	TH-5	CENTER HILL	PAVE	0.40	4,224
BENNINGTON COUNTY	MANCHESTER	TH-6	RICHVILLE RD	PAVE	3.87	40,867
BENNINGTON COUNTY	MANCHESTER	TH-7	NORTH RD	PAVE	1.75	18,480
BENNINGTON COUNTY	MANCHESTER	TH-8	BARNUMVILLE RD	PAVE	1.15	12,144
BENNINGTON COUNTY	MANCHESTER	TH-8	BEECH ST	PAVE	0.15	1,584
BENNINGTON COUNTY	MANCHESTER	TH-8	HIGH MEADOW WAY	PAVE	0.80	8,448
BENNINGTON COUNTY	MANCHESTER	TH-10	BARNUMVILLE RD	PAVE	1.52	16,051
BENNINGTON COUNTY	MANCHESTER	TH-11	EAST MANCHESTER RD	PAVE	1.79	18,902
BENNINGTON COUNTY SHEET 1 TOTAL					45.36	479,002

PROJECT NAME: STATEWIDE	
PROJECT NUMBER: HES MARK(404)	
FILE NAME: +14+186.dgn	PLOT DATE: 1/29/2015
PROJECT LEADER: P. COBURN	DRAWN BY: K. RECORD
DESIGNED BY: K. SWEET	CHECKED BY: I. DEGUTIS
CLASS 2 TOWN HIGHWAY QUANTITIES 4	SHEET 8 OF 56

SUMMARY BY COUNTY OF CLASS 2 TOWN HIGHWAYS

COUNTY	TOWN	TH NUMBER	TH NAME	SURFACE	MILEAGE	LINEAR FT
BENNINGTON COUNTY	PERU	TH-1	HAPGOOD POND RD	PAVE	3.24	34,214
BENNINGTON COUNTY	PERU	TH-2	MAIN ST	PAVE	0.64	6,758
BENNINGTON COUNTY	PERU	TH-3	SOUTH RD	PAVE	0.96	10,138
BENNINGTON COUNTY	POWNAL	TH-1	CHURCH ST	PAVE	0.30	3,168
BENNINGTON COUNTY	POWNAL	TH-2	NORTH POWNAL RD	PAVE	2.89	30,518
BENNINGTON COUNTY	POWNAL	TH-3	BARBER POND RD	PAVE	2.01	21,226
BENNINGTON COUNTY	POWNAL	TH-3	SOUTH STREAM RD	PAVE	3.24	34,214
BENNINGTON COUNTY	POWNAL	TH-4	MAPLE GROVE RD	PAVE	2.20	23,232
BENNINGTON COUNTY	POWNAL	TH-4	JACKSON CROSS RD	PAVE	1.21	12,778
BENNINGTON COUNTY	READSBORO	TH-2	TUNNEL ST	PAVE	1.60	16,896
BENNINGTON COUNTY	READSBORO	TH-3	BRANCH HILL RD	PAVE	0.25	2,640
BENNINGTON COUNTY	READSBORO	TH-4	DEPOT ST	PAVE	0.12	1,267
BENNINGTON COUNTY	RUPERT	TH-1	ROUTE 153	PAVE	7.08	74,765
BENNINGTON COUNTY	RUPERT	TH-2	DORSET WEST RD	PAVE	0.29	3,062
BENNINGTON COUNTY	RUPERT	TH-2	ROUTE 315	PAVE	5.81	61,354
BENNINGTON COUNTY	SANDGATE	TH-1	SANDGATE RD	PAVE	1.85	19,536
BENNINGTON COUNTY	SANDGATE	TH-2	SANDGATE RD	PAVE	1.73	18,269
BENNINGTON COUNTY	SANDGATE	TH-2	WEST SANDGATE RD	PAVE	1.36	14,362
BENNINGTON COUNTY	SHAFTSBURY	TH-1	OLD DEPOT RD	PAVE	0.47	4,963
BENNINGTON COUNTY	SHAFTSBURY	TH-2	CHURCH ST	PAVE	0.27	2,851
BENNINGTON COUNTY	SHAFTSBURY	TH-3	BANK ST	PAVE	0.37	3,907
BENNINGTON COUNTY	SHAFTSBURY	TH-3	HAWKS AVE	PAVE	0.25	2,640
BENNINGTON COUNTY	SHAFTSBURY	TH-3	WHITE CREEK RD	PAVE	2.22	23,443
BENNINGTON COUNTY	SHAFTSBURY	TH-4	CLEVELAND AVE	PAVE	0.47	4,963
BENNINGTON COUNTY	SHAFTSBURY	TH-5	EAST RD	PAVE	3.49	36,854
BENNINGTON COUNTY	SHAFTSBURY	TH-6	BUCK HILL RD	PAVE	2.00	21,120
BENNINGTON COUNTY	SHAFTSBURY	TH-7	AIRPORT RD	PAVE	1.24	13,094
BENNINGTON COUNTY	STAMFORD	TH-1	CLOUGH RD	PAVE	0.23	2,429
BENNINGTON COUNTY	STAMFORD	TH-1	EAST RD	PAVE	1.80	19,008
BENNINGTON COUNTY	STAMFORD	TH-2	JEPSON RD	PAVE	0.20	2,112
BENNINGTON COUNTY	SUNDERLAND	TH-1	SUNDERLAND HILL RD	PAVE	1.75	18,480
BENNINGTON COUNTY	SUNDERLAND	TH-2	HILL FARM RD	PAVE	0.55	5,808
BENNINGTON COUNTY	SUNDERLAND	TH-2	SUNDERLAND HILL RD	PAVE	3.07	32,419
BENNINGTON COUNTY	SUNDERLAND	TH-3	KANSAS RD	PAVE	1.03	10,877
BENNINGTON COUNTY	SUNDERLAND	TH-3	KELLY STAND RD	PAVE	0.05	528
BENNINGTON COUNTY	WINHALL	TH-1	STRATTON MTN ACCESS	PAVE	3.56	37,594
BENNINGTON COUNTY	WINHALL	TH-2	WINHALL HOLLOW RD	PAVE	5.61	59,242
BENNINGTON COUNTY	WINHALL	TH-4	OLD TOWN RD	PAVE	1.37	14,467
BENNINGTON COUNTY SHEET 2 TOTAL					66.78	705,197
BENNINGTON COUNTY SHEET 1 TOTAL					45.36	479,002
BENNINGTON COUNTY SHEET 2 TOTAL					66.78	705,197
			BENNINGTON COUNTY TOTALS		112.14	1,184,198

PROJECT NAME: STATEWIDE	
PROJECT NUMBER: HES MARK(404)	
FILE NAME: +14+186.dgn	PLOT DATE: 1/29/2015
PROJECT LEADER: P. COBURN	DRAWN BY: K. RECORD
DESIGNED BY: K. SWEET	CHECKED BY: I. DEGUTIS
CLASS 2 TOWN HIGHWAY QUANTITIES 5	SHEET 9 OF 56

SUMMARY BY COUNTY OF CLASS 2 TOWN HIGHWAYS

COUNTY	TOWN	TH NUMBER	TH NAME	SURFACE	MILEAGE	LINEAR FT
CALEDONIA COUNTY	BARNET	TH-1	WEST BARNET RD	PAVE	4.02	42,451
CALEDONIA COUNTY	BARNET	TH-1	WEST MAIN ST	PAVE	1.02	10,771
CALEDONIA COUNTY	BARNET	TH-2	EAST PEACHAM RD	PAVE	0.03	317
CALEDONIA COUNTY	BARNET	TH-3	COMERFORD DAM RD	PAVE	1.82	19,219
CALEDONIA COUNTY	BARNET	TH-4	GROTON RD	PAVE	1.80	19,008
CALEDONIA COUNTY	BARNET	TH-5	JOES BROOK RD	PAVE	1.62	17,107
CALEDONIA COUNTY	BARNET	TH-6	NORTH MONROE RD	PAVE	0.12	1,267
CALEDONIA COUNTY	BARNET	TH-7	MONROE RD	PAVE	0.20	2,112
CALEDONIA COUNTY	BARNET	TH-8	CHURCH ST	PAVE	0.34	3,590
CALEDONIA COUNTY	BARNET	TH-9	BARNET CTR RD	PAVE	3.06	32,314
CALEDONIA COUNTY	BARNET	TH-10	ROY MOUNTAIN RD	PAVE	2.89	30,518
CALEDONIA COUNTY	BARNET	TH-10	HARVEY MOUNTAIN RD	PAVE	1.96	20,698
CALEDONIA COUNTY	BURKE	TH-1	NEWARK ST	PAVE	2.38	25,133
CALEDONIA COUNTY	BURKE	TH-2	BURKE HOLLOW RD	PAVE	4.88	51,533
CALEDONIA COUNTY	BURKE	TH-2	EAST DARLING HILL RD	PAVE	0.07	739
CALEDONIA COUNTY	BURKE	TH-3	CALENDER BROOK RD	PAVE	1.40	14,784
CALEDONIA COUNTY	BURKE	TH-4	BURKE HILL RD	PAVE	1.00	10,560
CALEDONIA COUNTY	BURKE	TH-4	DEPOT ST	PAVE	0.24	2,534
CALEDONIA COUNTY	BURKE	TH-5	VICTORYRD	PAVE	0.56	5,914
CALEDONIA COUNTY	BURKE	TH-6	EAST DARLING HILL RD	PAVE	0.70	7,392
CALEDONIA COUNTY	BURKE	TH-6	DARLING HILL RD	PAVE	0.40	4,224
CALEDONIA COUNTY	BURKE	TH-7	MOUNTAIN RD	PAVE	1.95	20,592
CALEDONIA COUNTY	BURKE	TH-8	KIRBY RD	PAVE	0.80	8,448
CALEDONIA COUNTY	DANVILLE	TH-1	BRAINERD ST	PAVE	0.83	8,765
CALEDONIA COUNTY	DANVILLE	TH-1	JOES BROOK RD	PAVE	2.83	29,885
CALEDONIA COUNTY	DANVILLE	TH-2	BRUCE BADGER MEM HWY	PAVE	4.44	46,886
CALEDONIA COUNTY	DANVILLE	TH-2	HILL ST	PAVE	0.59	6,230
CALEDONIA COUNTY	DANVILLE	TH-2	NORTH DANVILLE RD	PAVE	1.93	20,381
CALEDONIA COUNTY	DANVILLE	TH-3	PEACHAM RD	PAVE	3.26	34,426
CALEDONIA COUNTY	GROTON	TH-1	POWDER SPRING RD	PAVE	2.24	23,654
CALEDONIA COUNTY	GROTON	TH-2	MINARD HILL RD	PAVE	2.54	26,822
CALEDONIA COUNTY	GROTON	TH-3	BOULDER BEACH RD	PAVE	0.94	9,926
CALEDONIA COUNTY	HARDWICK	TH-1	BELFRY RD	PAVE	1.00	10,560
CALEDONIA COUNTY	HARDWICK	TH-2	CEDAR ST	PAVE	0.33	3,485
CALEDONIA COUNTY	HARDWICK	TH-2	EAST CHURCH ST	PAVE	0.38	4,013
CALEDONIA COUNTY	HARDWICK	TH-2	HARDWICK ST	PAVE	2.37	25,027
CALEDONIA COUNTY SHEET 1 TOTAL					56.94	601,286

PROJECT NAME: STATEWIDE	
PROJECT NUMBER: HES MARK(404)	
FILE NAME: +14+186.dgn	PLOT DATE: 1/29/2015
PROJECT LEADER: P. COBURN	DRAWN BY: K. RECORD
DESIGNED BY: K. SWEET	CHECKED BY: I. DEGUTIS
CLASS 2 TOWN HIGHWAY QUANTITIES 6	SHEET 10 OF 56

SUMMARY BY COUNTY OF CLASS 2 TOWN HIGHWAYS

COUNTY	TOWN	TH NUMBER	TH NAME	SURFACE	MILEAGE	LINEAR FT
CALEDONIA COUNTY	HARDWICK	TH-2	MAIN ST	PAVE	0.09	950
CALEDONIA COUNTY	HARDWICK	TH-3	CENTER RD	PAVE	4.43	46,781
CALEDONIA COUNTY	HARDWICK	TH-3	CHURCH ST	PAVE	0.14	1,478
CALEDONIA COUNTY	HARDWICK	TH-3	MAPLE ST	PAVE	0.11	1,162
CALEDONIA COUNTY	HARDWICK	TH-3	NORTH MAIN ST	PAVE	0.11	1,162
CALEDONIA COUNTY	HARDWICK	TH-3	SLAPP HILL	PAVE	0.41	4,330
CALEDONIA COUNTY	HARDWICK	TH-4	STANNARD MOUNTAIN RD	PAVE	0.10	1,056
CALEDONIA COUNTY	HARDWICK	TH-5	EAST MAIN ST	PAVE	0.33	3,485
CALEDONIA COUNTY	HARDWICK	TH-6	MAIN ST	PAVE	0.20	2,112
CALEDONIA COUNTY	HARDWICK	TH-7	SCHOOL ST	PAVE	0.34	3,590
CALEDONIA COUNTY	HARDWICK	TH-8	MACKVILLE RD	PAVE	0.95	10,032
CALEDONIA COUNTY	KIRBY	TH-1	RIDGE RD	PAVE	0.51	5,386
CALEDONIA COUNTY	LYNDON	TH-1	SOUTH WHEELOCK RD	PAVE	4.05	42,768
CALEDONIA COUNTY	LYNDON	TH-2	RED VILLAGE RD	PAVE	3.91	41,290
CALEDONIA COUNTY	LYNDON	TH-4	CALENDER BROOK RD	PAVE	0.60	6,336
CALEDONIA COUNTY	LYNDON	TH-5	DARLING HILL RD	PAVE	1.61	17,002
CALEDONIA COUNTY	LYNDON	TH-6	SEVERANCE HILL RD	PAVE	1.05	11,088
CALEDONIA COUNTY	LYNDON	TH-9	COLLEGE RD	PAVE	0.51	5,386
CALEDONIA COUNTY	LYNDON	TH-9	LOWER CAMPUS RD	PAVE	0.55	5,808
CALEDONIA COUNTY	LYNDON	TH-9	MCGOFF HILL	PAVE	1.00	10,560
CALEDONIA COUNTY	LYNDON	TH-10	BACK CENTER RD	PAVE	1.42	14,995
CALEDONIA COUNTY	LYNDON	TH-11	LILLY POND RD	PAVE	2.96	31,258
CALEDONIA COUNTY	NEWARK	TH-1	NEWARK ST	PAVE	3.36	35,482
CALEDONIA COUNTY	PEACHAM	TH-1	BAYLEY-HAZEN RD	PAVE	1.84	19,430
CALEDONIA COUNTY	PEACHAM	TH-1	PEACHAM-BARNET RD	PAVE	0.90	9,504
CALEDONIA COUNTY	PEACHAM	TH-1	PEACHAM-DANVILLE RD	PAVE	1.89	19,958
CALEDONIA COUNTY	PEACHAM	TH-1	SOUTH MAIN ST	PAVE	0.83	8,765
CALEDONIA COUNTY	PEACHAM	TH-2	EAST PEACHAM RD	PAVE	2.23	23,549
CALEDONIA COUNTY	PEACHAM	TH-3	PEACHAM-GROTON RD	PAVE	1.14	12,038
CALEDONIA COUNTY	RYEGATE	TH-1	BOLTONVILLE RD	PAVE	1.26	13,306
CALEDONIA COUNTY	RYEGATE	TH-1	BAYLEY-HAZEN RD	PAVE	1.50	15,840
CALEDONIA COUNTY	RYEGATE	TH-1	EAST RD	PAVE	2.15	22,704
CALEDONIA COUNTY	RYEGATE	TH-2	CHURCH ST	PAVE	0.35	3,696
CALEDONIA COUNTY	RYEGATE	TH-3	PAPERMILL RD	PAVE	0.18	1,901
CALEDONIA COUNTY	RYEGATE	TH-4	PEACHAM RD	PAVE	2.32	24,499
CALEDONIA COUNTY	RYEGATE	TH-5	CREAMERY RD	PAVE	1.73	18,269
CALEDONIA COUNTY	RYEGATE	TH-6	WITHERSPOON RD	PAVE	4.47	47,203
CALEDONIA COUNTY SHEET 2 TOTAL					51.53	544,157

PROJECT NAME: STATEWIDE	
PROJECT NUMBER: HES MARK(404)	
FILE NAME: +14+186.dgn	PLOT DATE: 1/29/2015
PROJECT LEADER: P. COBURN	DRAWN BY: K. RECORD
DESIGNED BY: K. SWEET	CHECKED BY: I. DEGUTIS
CLASS 2 TOWN HIGHWAY QUANTITIES 7	SHEET II OF 56

SUMMARY BY COUNTY OF CLASS 2 TOWN HIGHWAYS

COUNTY	TOWN	TH NUMBER	TH NAME	SURFACE	MILEAGE	LINEAR FT
CALEDONIA COUNTY	ST JOHNSBURY	TH-4	CONCORD AVE	PAVE	1.78	18,797
CALEDONIA COUNTY	ST JOHNSBURY	TH-5	MAPLE ST	PAVE	0.21	2,218
CALEDONIA COUNTY	ST JOHNSBURY	TH-6	BREEZEY HILL RD	PAVE	1.97	20,803
CALEDONIA COUNTY	ST JOHNSBURY	TH-6	PLEASANT ST	PAVE	0.73	7,709
CALEDONIA COUNTY	ST JOHNSBURY	TH-7	NORTH DANVILLE RD	PAVE	1.40	14,784
CALEDONIA COUNTY	ST JOHNSBURY	TH-8	SEVERANCE HILL RD	PAVE	3.53	37,277
CALEDONIA COUNTY	ST JOHNSBURY	TH-9	HOSPITAL DR	PAVE	0.13	1,373
CALEDONIA COUNTY	ST JOHNSBURY	TH-9	OLD CENTER RD	PAVE	0.95	10,032
CALEDONIA COUNTY	ST JOHNSBURY	TH-10	HOSPITAL DR	PAVE	0.50	5,280
CALEDONIA COUNTY	SUTTON	TH-1	CALENDER BROOK RD	PAVE	2.56	27,034
CALEDONIA COUNTY	SUTTON	TH-1	UNDER PASS RD	PAVE	5.28	55,757
CALEDONIA COUNTY	SUTTON	TH-2	BURKE RD	PAVE	1.88	19,853
CALEDONIA COUNTY	SUTTON	TH-3	CENTER ST	PAVE	0.14	1,478
CALEDONIA COUNTY	SUTTON	TH-3	SHEFFIELD RD	PAVE	0.13	1,373
CALEDONIA COUNTY	WALDEN	TH-1	CABOT RD	PAVE	1.59	16,790
CALEDONIA COUNTY	WALDEN	TH-3	ROUTE 215	PAVE	0.95	10,032
CALEDONIA COUNTY	WATERFORD	TH-1	CROSS RD	PAVE	0.27	2,851
CALEDONIA COUNTY	WATERFORD	TH-2	LOWER WATERFORD RD	PAVE	2.63	27,773
CALEDONIA COUNTY	WATERFORD	TH-3	DUCK POND RD	PAVE	3.04	32,102
CALEDONIA COUNTY	WATERFORD	TH-4	DANIELS FARM RD	PAVE	1.36	14,362
CALEDONIA COUNTY	WHEELOCK	TH-1	SOUTH WHEELOCK RD	PAVE	0.45	4,752
CALEDONIA COUNTY SHEET 3 TOTAL					31.48	332,429
CALEDONIA COUNTY SHEET 1 TOTAL					56.94	601,286
CALEDONIA COUNTY SHEET 2 TOTAL					51.53	544,157
CALEDONIA COUNTY SHEET 3 TOTAL					31.48	332,429
			CALEDONIA COUNTY TOTALS		139.95	1,477,872

PROJECT NAME: STATEWIDE	
PROJECT NUMBER: HES MARK(404)	
FILE NAME: +14+186.dgn	PLOT DATE: 1/29/2015
PROJECT LEADER: P. COBURN	DRAWN BY: K. RECORD
DESIGNED BY: K. SWEET	CHECKED BY: I. DEGUTIS
CLASS 2 TOWN HIGHWAY QUANTITIES 8	SHEET 12 OF 56

SUMMARY BY COUNTY OF CLASS 2 TOWN HIGHWAYS

COUNTY	TOWN	TH NUMBER	TH NAME	SURFACE	MILEAGE	LINEAR FT
CHITTENDEN COUNTY	BOLTON	TH-1	DUXBURY RD	PAVE	3.81	40,234
CHITTENDEN COUNTY	BOLTON	TH-2	NASHVILLE RD	PAVE	0.40	4,224
CHITTENDEN COUNTY	BOLTON	TH-3	BOLTON VALLET ACCESS RD	PAVE	4.37	46,147
CHITTENDEN COUNTY	BUELS GORE	TH-1	GORE RD	PAVE	0.45	4,752
CHITTENDEN COUNTY	BURLINGTON	TH-1	MAIN ST	PAVE	0.76	8,026
CHITTENDEN COUNTY	BURLINGTON	TH-3	COLCHESTER AVE	PAVE	1.13	11,933
CHITTENDEN COUNTY	BURLINGTON	TH-3	ENT/EXT RAMP TOWN HWY	PAVE	0.25	2,640
CHITTENDEN COUNTY	BURLINGTON	TH-3	NORTH AVE	PAVE	3.11	32,842
CHITTENDEN COUNTY	BURLINGTON	TH-3	PARK ST	PAVE	0.10	1,056
CHITTENDEN COUNTY	BURLINGTON	TH-3	PEARL ST	PAVE	0.93	9,821
CHITTENDEN COUNTY	BURLINGTON	TH-3	PLATTSBURG AVE	PAVE	0.61	6,442
CHITTENDEN COUNTY	BURLINGTON	TH-5	GROVE ST	PAVE	0.56	5,914
CHITTENDEN COUNTY	BURLINGTON	TH-5	CHASE ST	PAVE	0.03	317
CHITTENDEN COUNTY	BURLINGTON	TH-5	BARRETT ST	PAVE	0.14	1,478
CHITTENDEN COUNTY	BURLINGTON	TH-6	EAST AVE	PAVE	0.77	8,131
CHITTENDEN COUNTY	BURLINGTON	TH-7	QUEEN CITY PARKWAY	PAVE	0.30	3,168
CHITTENDEN COUNTY	BURLINGTON	TH-8	PINE ST	PAVE	2.06	21,754
CHITTENDEN COUNTY	BURLINGTON	TH-9	ENT/EXT RAMP TOWN HWY	PAVE	1.27	13,411
CHITTENDEN COUNTY	BURLINGTON	TH-9	PARK ST	PAVE	0.38	4,013
CHITTENDEN COUNTY	BURLINGTON	TH-9	ROUTE 127	PAVE	3.43	36,221
CHITTENDEN COUNTY	BURLINGTON	TH-10	MANHATTEN DR	PAVE	0.38	4,013
CHITTENDEN COUNTY	BURLINGTON	TH-10	OAK ST	PAVE	0.22	2,323
CHITTENDEN COUNTY	BURLINGTON	TH-10	RIVERSIDE AVE	PAVE	0.20	2,112
CHITTENDEN COUNTY	BURLINGTON	TH-11	ENT/EXT RAMP TOWN HWY	PAVE	0.56	5,914
CHITTENDEN COUNTY	BURLINGTON	TH-12	MANSFIELD AVE	PAVE	0.31	3,274
CHITTENDEN COUNTY	BURLINGTON	TH-12	NORTH ST	PAVE	0.98	10,349
CHITTENDEN COUNTY	BURLINGTON	TH-13	NORTH PROSPECT ST	PAVE	0.58	6,125
CHITTENDEN COUNTY	BURLINGTON	TH-13	SOUTH PROSPECT ST	PAVE	1.26	13,306
CHITTENDEN COUNTY	BURLINGTON	TH-13	LEDGE RD	PAVE	0.36	3,802
CHITTENDEN COUNTY	BURLINGTON	TH-14	BATTERY ST	PAVE	0.48	5,069
CHITTENDEN COUNTY	BURLINGTON	TH-15	ST PAUL ST	PAVE	0.60	6,336
CHITTENDEN COUNTY	CHARLOTTE	TH-1	SPEAR ST	PAVE	6.07	64,099
CHITTENDEN COUNTY	CHARLOTTE	TH-2	CHURCH HILL RD	PAVE	0.70	7,392
CHITTENDEN COUNTY	CHARLOTTE	TH-2	HINESBURG RD	PAVE	3.94	41,606
CHITTENDEN COUNTY	CHARLOTTE	TH-3	FERRY RD	PAVE	2.89	30,518
CHITTENDEN COUNTY	CHARLOTTE	TH-4	GREENBUSH RD	PAVE	4.86	51,322
CHITTENDEN COUNTY	CHARLOTTE	TH-4	THOMPSONS POINT RD	PAVE	2.49	26,294
CHITTENDEN COUNTY	CHARLOTTE	TH-5	STATE PARK RD	PAVE	0.55	5,808
CHITTENDEN COUNTY	CHARLOTTE	TH-5	MT PHILO RD	PAVE	0.95	10,032
CHITTENDEN COUNTY	CHARLOTTE	TH-6	SPEAR ST	PAVE	2.15	22,704
CHITTENDEN COUNTY	CHARLOTTE	TH-7	CHURCH HILL RD	PAVE	1.07	11,299
CHITTENDEN COUNTY	CHARLOTTE	TH-8	MT PHILO RD	PAVE	2.81	29,674
CHITTENDEN COUNTY SHEET 1 TOTAL					59.27	625,891

PROJECT NAME: STATEWIDE	
PROJECT NUMBER: HES MARK(404)	
FILE NAME: +14+186.dgn	PLOT DATE: 1/29/2015
PROJECT LEADER: P. COBURN	DRAWN BY: K. RECORD
DESIGNED BY: K. SWEET	CHECKED BY: I. DEGUTIS
CLASS 2 TOWN HIGHWAY QUANTITIES 9	SHEET 13 OF 56

SUMMARY BY COUNTY OF CLASS 2 TOWN HIGHWAYS

COUNTY	TOWN	TH NUMBER	TH NAME	SURFACE	MILEAGE	LINEAR FT
CHITTENDEN COUNTY	CHARLOTTE	TH-9	DORSET ST	PAVE	1.42	14,995
CHITTENDEN COUNTY	COLCHESTER	TH-1	BAY RD	PAVE	1.40	14,784
CHITTENDEN COUNTY	COLCHESTER	TH-1	CHURCH RD	PAVE	0.91	9,610
CHITTENDEN COUNTY	COLCHESTER	TH-1	EAST LAKESHORE DR	PAVE	1.47	15,523
CHITTENDEN COUNTY	COLCHESTER	TH-1	HEINEBERG DR	PAVE	0.90	9,504
CHITTENDEN COUNTY	COLCHESTER	TH-1	PORTERS POINT RD	PAVE	0.15	1,584
CHITTENDEN COUNTY	COLCHESTER	TH-1	WEST LAKESHORE DR	PAVE	1.85	19,536
CHITTENDEN COUNTY	COLCHESTER	TH-2	EAST RD	PAVE	2.96	31,258
CHITTENDEN COUNTY	COLCHESTER	TH-3	BLAKELY RD	PAVE	0.53	5,597
CHITTENDEN COUNTY	COLCHESTER	TH-3	MALLETTS BAY AVE	PAVE	2.91	30,730
CHITTENDEN COUNTY	COLCHESTER	TH-4	LIME KILN RD	PAVE	0.21	2,218
CHITTENDEN COUNTY	COLCHESTER	TH-5	FARNSWORTH RD	PAVE	0.75	7,920
CHITTENDEN COUNTY	COLCHESTER	TH-6	COLCHESTER POND RD	PAVE	0.15	1,584
CHITTENDEN COUNTY	COLCHESTER	TH-6	DEPOT ST	PAVE	0.60	6,336
CHITTENDEN COUNTY	COLCHESTER	TH-7	SEVERANCE RD	PAVE	2.03	21,437
CHITTENDEN COUNTY	COLCHESTER	TH-8	JASPER MINE RD	PAVE	0.34	3,590
CHITTENDEN COUNTY	COLCHESTER	TH-8	MAYO RD	PAVE	0.45	4,752
CHITTENDEN COUNTY	COLCHESTER	TH-9	BLAKELY RD	PAVE	2.20	23,232
CHITTENDEN COUNTY	COLCHESTER	TH-10	PRIM RD	PAVE	1.30	13,728
CHITTENDEN COUNTY	COLCHESTER	TH-11	BARNES AVE	PAVE	0.14	1,478
CHITTENDEN COUNTY	COLCHESTER	TH-12	WINCHESTER PL	PAVE	0.35	3,696
CHITTENDEN COUNTY	COLCHESTER	TH-13	VERMONT NATIONAL GUARD RD	PAVE	0.09	950
CHITTENDEN COUNTY	COLCHESTER	TH-14	JOHNSON AVE	PAVE	0.17	1,795
CHITTENDEN COUNTY	ESSEX	TH-1	NORTH WILLISTON RD	PAVE	0.34	3,590
CHITTENDEN COUNTY	ESSEX	TH-2	OLD STAGE RD	PAVE	4.00	42,240
CHITTENDEN COUNTY	ESSEX	TH-3	SUSIE WILSON BY-PASS	PAVE	0.80	8,448
CHITTENDEN COUNTY	ESSEX	TH-3	SUSIEWILSON RD	PAVE	0.49	5,174
CHITTENDEN COUNTY	ESSEX	TH-4	SAND HILL RD	PAVE	2.29	24,182
CHITTENDEN COUNTY	ESSEX	TH-5	KELLOGG RD	PAVE	0.55	5,808
CHITTENDEN COUNTY	ESSEX	TH-5	SOUTH ST	PAVE	0.33	3,485
CHITTENDEN COUNTY	ESSEX	TH-5	WEST ST	PAVE	1.12	11,827
CHITTENDEN COUNTY	ESSEX	TH-6	PINECREST DR	PAVE	1.00	10,560
CHITTENDEN COUNTY	ESSEX	TH-6	SOUTH SUMMIT ST	PAVE	0.43	4,541
CHITTENDEN COUNTY	ESSEX	TH-7	ESSEX WAY	PAVE	0.46	4,858
CHITTENDEN COUNTY	ESSEX	TH-8	ALLEN MARTIN DR	PAVE	0.93	9,821
CHITTENDEN COUNTY	HINESBURG	TH-1	SHELBURNE FALLS RD	PAVE	2.96	31,258
CHITTENDEN COUNTY	HINESBURG	TH-2	MECHANICSVILLE RD	PAVE	0.91	9,610
CHITTENDEN COUNTY	HINESBURG	TH-2	RICHMOND RD	PAVE	3.42	36,115
CHITTENDEN COUNTY	HINESBURG	TH-3	CHARLOTTE RD	PAVE	2.61	27,562
CHITTENDEN COUNTY	HINESBURG	TH-4	SILVER ST	PAVE	3.39	35,798
CHITTENDEN COUNTY	HINESBURG	TH-5	HOLLOW RD	PAVE	2.80	29,568
CHITTENDEN COUNTY	HINESBURG	TH-6	POND RD	PAVE	2.10	22,176
CHITTENDEN COUNTY SHEET 2 TOTAL					54.21	572,458

PROJECT NAME: STATEWIDE	
PROJECT NUMBER: HES MARK(404)	
FILE NAME: +14+186.dgn	PLOT DATE: 1/29/2015
PROJECT LEADER: P. COBURN	DRAWN BY: K. RECORD
DESIGNED BY: K. SWEET	CHECKED BY: I. DEGUTIS
CLASS 2 TOWN HIGHWAY QUANTITIES 10	SHEET 14 OF 56

SUMMARY BY COUNTY OF CLASS 2 TOWN HIGHWAYS

COUNTY	TOWN	TH NUMBER	TH NAME	SURFACE	MILEAGE	LINEAR FT
CHITTENDEN COUNTY	HINESBURG	TH-7	CVU RD	PAVE	0.55	5,808
CHITTENDEN COUNTY	HINESBURG	TH-9	NORTH RD	PAVE	2.30	24,288
CHITTENDEN COUNTY	HUNTINGTON	TH-1	MAIN RD	PAVE	9.70	102,432
CHITTENDEN COUNTY	HUNTINGTON	TH-2	HINESBURG HOLLOW RD	PAVE	1.48	15,629
CHITTENDEN COUNTY	JERICO	TH-1	BARBER FARM RD	PAVE	2.56	27,034
CHITTENDEN COUNTY	JERICO	TH-1	BROWNS TRACE	PAVE	3.55	37,488
CHITTENDEN COUNTY	JERICO	TH-2	EATHEN ALLEN RD	PAVE	0.81	8,554
CHITTENDEN COUNTY	JERICO	TH-2	LEE RIVER RD	PAVE	2.30	24,288
CHITTENDEN COUNTY	JERICO	TH-3	BROWNS TRACE	PAVE	0.89	9,398
CHITTENDEN COUNTY	JERICO	TH-4	BROWNS TRACE	PAVE	1.75	18,480
CHITTENDEN COUNTY	JERICO	TH-5	RIVER RD	PAVE	0.43	4,541
CHITTENDEN COUNTY	JERICO	TH-6	PLAINS RD	PAVE	0.57	6,019
CHITTENDEN COUNTY	JERICO	TH-6	SKUNK HOLLOW RD	PAVE	1.69	17,846
CHITTENDEN COUNTY	JERICO	TH-7	GOVERNOR PECK RD	PAVE	1.49	15,734
CHITTENDEN COUNTY	MILTON	TH-1	ENT/EXT RAMP TOWN HWY	PAVE	0.13	1,373
CHITTENDEN COUNTY	MILTON	TH-1	MIDDLE RD	PAVE	2.99	31,574
CHITTENDEN COUNTY	MILTON	TH-1	RAILROAD ST	PAVE	1.35	14,256
CHITTENDEN COUNTY	MILTON	TH-2	MAIN ST	PAVE	0.63	6,653
CHITTENDEN COUNTY	MILTON	TH-2	WESTFORD RD	PAVE	3.04	32,102
CHITTENDEN COUNTY	MILTON	TH-3	LAKE RD	PAVE	8.19	86,486
CHITTENDEN COUNTY	MILTON	TH-4	EVEREST RD	PAVE	3.20	33,792
CHITTENDEN COUNTY	MILTON	TH-5	EAST RD	PAVE	4.55	48,048
CHITTENDEN COUNTY	MILTON	TH-5	NORTH RD	PAVE	2.35	24,816
CHITTENDEN COUNTY	MILTON	TH-6	WEST MILTON RD	PAVE	4.26	44,986
CHITTENDEN COUNTY	MILTON	TH-7	BEAR TRAP RD	PAVE	2.88	30,413
CHITTENDEN COUNTY	RICHMOND	TH-1	BRIDGE ST	PAVE	0.57	6,019
CHITTENDEN COUNTY	RICHMOND	TH-1	HUNTINGTON RD	PAVE	4.15	43,824
CHITTENDEN COUNTY	RICHMOND	TH-2	HINESBURG RD	PAVE	3.90	41,184
CHITTENDEN COUNTY	RICHMOND	TH-3	COCHRAN RD	PAVE	3.68	38,861
CHITTENDEN COUNTY	RICHMOND	TH-4	JERICO RD	PAVE	2.33	24,605
CHITTENDEN COUNTY	RICHMOND	TH-5	DUXBURY RD	PAVE	0.20	2,112
CHITTENDEN COUNTY	RICHMOND	TH-6	GOVERNOR PECK RD	PAVE	0.80	8,448
CHITTENDEN COUNTY	ST GEORGE	TH-1	OAK HILL RD	PAVE	0.30	3,168
CHITTENDEN COUNTY	ST GEORGE	TH-2	SOUTH BROWNELL RD	PAVE	0.07	739
CHITTENDEN COUNTY	SHELBURNE	TH-1	HARBOR RD	PAVE	1.67	17,635
CHITTENDEN COUNTY	SHELBURNE	TH-1	BAY RD	PAVE	1.84	19,430
CHITTENDEN COUNTY	SHELBURNE	TH-2	DORSET ST	PAVE	0.48	5,069
CHITTENDEN COUNTY	SHELBURNE	TH-2	FALLS RD	PAVE	1.19	12,566
CHITTENDEN COUNTY	SHELBURNE	TH-2	IRISH HILLS RD	PAVE	1.79	18,902
CHITTENDEN COUNTY	SHELBURNE	TH-2	SHELBURNE-HINESBURG RD	PAVE	0.91	9,610
CHITTENDEN COUNTY	SHELBURNE	TH-3	BOSTWICK RD	PAVE	2.28	24,077
CHITTENDEN COUNTY	SHELBURNE	TH-4	SPEAR ST	PAVE	0.39	4,118
CHITTENDEN COUNTY SHEET 3 TOTAL					90.19	952,406

PROJECT NAME: STATEWIDE	
PROJECT NUMBER: HES MARK(404)	
FILE NAME: +14+186.dgn	PLOT DATE: 1/29/2015
PROJECT LEADER: P. COBURN	DRAWN BY: K. RECORD
DESIGNED BY: K. SWEET	CHECKED BY: I. DEGUTIS
CLASS 2 TOWN HIGHWAY QUANTITIES II	SHEET 15 OF 56

SUMMARY BY COUNTY OF CLASS 2 TOWN HIGHWAYS

COUNTY	TOWN	TH NUMBER	TH NAME	SURFACE	MILEAGE	LINEAR FT
CHITTENDEN COUNTY	SHELBURNE	TH-4	THOMAS RD	PAVE	1.09	11,510
CHITTENDEN COUNTY	SHELBURNE	TH-5	DORSET ST	PAVE	2.86	30,202
CHITTENDEN COUNTY	SHELBURNE	TH-6	SPEAR ST	PAVE	3.03	31,997
CHITTENDEN COUNTY	SHELBURNE	TH-7	HARBOR RD	PAVE	2.88	30,413
CHITTENDEN COUNTY	SHELBURNE	TH-8	CHEESE FACTORY RD	PAVE	0.55	5,808
CHITTENDEN COUNTY	SHELBURNE	TH-8	BARSTOW RD	PAVE	1.00	10,560
CHITTENDEN COUNTY	SHELBURNE	TH-9	MT PHILO RD	PAVE	1.10	11,616
CHITTENDEN COUNTY	SHELBURNE	TH-10	DORSET ST	PAVE	0.30	3,168
CHITTENDEN COUNTY	SHELBURNE	TH-11	MARSETT RD	PAVE	0.35	3,696
CHITTENDEN COUNTY	SHELBURNE	TH-12	WEBSTER RD	PAVE	1.10	11,616
CHITTENDEN COUNTY	SHELBURNE	TH-13	WEBSTER RD	PAVE	0.35	3,696
CHITTENDEN COUNTY	SOUTH BURLINGTON	TH-2	PATCHEN RD	PAVE	1.12	11,827
CHITTENDEN COUNTY	SOUTH BURLINGTON	TH-3	AIRPORT DR	PAVE	0.68	7,181
CHITTENDEN COUNTY	SOUTH BURLINGTON	TH-3	AIRPORT PARKWAY	PAVE	1.42	14,995
CHITTENDEN COUNTY	SOUTH BURLINGTON	TH-3	LIME KILN RD	PAVE	0.30	3,168
CHITTENDEN COUNTY	SOUTH BURLINGTON	TH-3	WHITE ST	PAVE	0.26	2,746
CHITTENDEN COUNTY	SOUTH BURLINGTON	TH-4	WHITE ST	PAVE	0.59	6,230
CHITTENDEN COUNTY	SOUTH BURLINGTON	TH-5	SWIFT ST	PAVE	1.64	17,318
CHITTENDEN COUNTY	SOUTH BURLINGTON	TH-5	DORSET ST	PAVE	1.81	19,114
CHITTENDEN COUNTY	SOUTH BURLINGTON	TH-6	DORSET ST	PAVE	2.30	24,288
CHITTENDEN COUNTY	SOUTH BURLINGTON	TH-7	EAST TERRACE	PAVE	0.07	739
CHITTENDEN COUNTY	SOUTH BURLINGTON	TH-7	SPEAR ST	PAVE	3.97	41,923
CHITTENDEN COUNTY	SOUTH BURLINGTON	TH-8	KENNEDY DR	PAVE	1.51	15,946
CHITTENDEN COUNTY	SOUTH BURLINGTON	TH-9	OLD FARM RD	PAVE	0.74	7,814
CHITTENDEN COUNTY	SOUTH BURLINGTON	TH-10	CHEESE FACTORY RD	PAVE	0.79	8,342
CHITTENDEN COUNTY	SOUTH BURLINGTON	TH-11	CENTRAL AVE	PAVE	0.51	5,386
CHITTENDEN COUNTY	SOUTH BURLINGTON	TH-11	QUEEN CITY PARKWAY	PAVE	0.35	3,696
CHITTENDEN COUNTY	SOUTH BURLINGTON	TH-12	KIMBALL AVE	PAVE	1.05	11,088
CHITTENDEN COUNTY	UNDERHILL	TH-1	PLEASANT VALLEY RD	PAVE	6.04	63,782
CHITTENDEN COUNTY	UNDERHILL	TH-1	RIVER RD	PAVE	2.31	24,394
CHITTENDEN COUNTY	UNDERHILL	TH-1	PARK ST	PAVE	0.40	4,224
CHITTENDEN COUNTY	WESTFORD	TH-1	OLD STAGE RD	PAVE	0.65	6,864
CHITTENDEN COUNTY	WESTFORD	TH-2	WESTFORD-MILTON RD	PAVE	1.83	19,325
CHITTENDEN COUNTY	WESTFORD	TH-3	CAMBRIDGE RD	PAVE	1.00	10,560
CHITTENDEN COUNTY	WILLISTON	TH-1	NORTH WILLISTON RD	PAVE	2.85	30,096
CHITTENDEN COUNTY	WILLISTON	TH-1	OAK HILL RD	PAVE	4.85	51,216
CHITTENDEN COUNTY	WILLISTON	TH-2	INDUSTRIAL AVE	PAVE	1.05	11,088
CHITTENDEN COUNTY	WILLISTON	TH-3	OLD CREAMERY RD	PAVE	2.10	22,176
CHITTENDEN COUNTY	WILLISTON	TH-4	MOUNTAIN VIEW RD	PAVE	2.95	31,152
CHITTENDEN COUNTY	WILLISTON	TH-5	SOUTH BROWNELL RD	PAVE	3.88	40,973
CHITTENDEN COUNTY SHEET 4 TOTAL					63.63	671,933

PROJECT NAME: STATEWIDE	
PROJECT NUMBER: HES MARK(404)	
FILE NAME: +14+186.dgn	PLOT DATE: 1/29/2015
PROJECT LEADER: P. COBURN	DRAWN BY: K. RECORD
DESIGNED BY: K. SWEET	CHECKED BY: I. DEGUTIS
CLASS 2 TOWN HIGHWAY QUANTITIES 12	SHEET 16 OF 56

SUMMARY BY COUNTY OF CLASS 2 TOWN HIGHWAYS

COUNTY	TOWN	TH NUMBER	TH NAME	SURFACE	MILEAGE	LINEAR FT
CHITTENDEN COUNTY	WILLISTON	TH-6	MARSHALL RD	PAVE	1.60	16,896
CHITTENDEN COUNTY	WINOOSKI	TH-3	MALLETTS BAY AVE	PAVE	0.70	7,392
CHITTENDEN COUNTY	WINOOSKI	TH-3	WEST ALLEN ST	PAVE	0.13	1,373
CHITTENDEN COUNTY	WINOOSKI	TH-4	EAST SPRING ST	PAVE	0.41	4,330
CHITTENDEN COUNTY	WINOOSKI	TH-4	WEST SPRING ST	PAVE	0.33	3,485
CHITTENDEN COUNTY	WINOOSKI	TH-5	LAFOUNTAIN ST	PAVE	0.51	5,386
CHITTENDEN COUNTY	WINOOSKI	TH-5	DION ST	PAVE	0.15	1,584
CHITTENDEN COUNTY	WINOOSKI	TH-6	WINOOSKI FALLS WAY	PAVE	0.22	2,323
CHITTENDEN COUNTY	WINOOSKI	TH-7	CASCADE WAY	PAVE	0.08	845
CHITTENDEN COUNTY	WINOOSKI	TH-8	ABENAKI WAY	PAVE	0.10	1,056
CHITTENDEN COUNTY	WINOOSKI	TH-9	CENTER ST	PAVE	0.18	1,901
CHITTENDEN COUNTY SHEET 5 TOTAL					4.41	46,570
CHITTENDEN COUNTY SHEET 1 TOTAL					59.27	625,891
CHITTENDEN COUNTY SHEET 2 TOTAL					54.21	572,458
CHITTENDEN COUNTY SHEET 3 TOTAL					90.19	952,406
CHITTENDEN COUNTY SHEET 4 TOTAL					63.63	671,933
CHITTENDEN COUNTY SHEET 5 TOTAL					4.41	46,570
			CHITTENDEN COUNTY TOTALS		271.71	2,869,258

PROJECT NAME: STATEWIDE	
PROJECT NUMBER: HES MARK(404)	
FILE NAME: t14t186.dgn	PLOT DATE: 1/29/2015
PROJECT LEADER: P. COBURN	DRAWN BY: K. RECORD
DESIGNED BY: K. SWEET	CHECKED BY: I. DEGUTIS
CLASS 2 TOWN HIGHWAY QUANTITIES 13	SHEET 17 OF 56

SUMMARY BY COUNTY OF CLASS 2 TOWN HIGHWAYS

COUNTY	TOWN	TH NUMBER	TH NAME	SURFACE	MILEAGE	LINEAR FT
ESSEX COUNTY	BRIGHTON	TH-3	NEWARK RD	PAVE	0.83	8,765
ESSEX COUNTY	BRIGHTON	TH-4	SOUTH ST	PAVE	0.18	1,901
ESSEX COUNTY	BRIGHTON	TH-4	MIDDLE ST	PAVE	0.57	6,019
ESSEX COUNTY	BRIGHTON	TH-5	LAKESHORE DR	PAVE	1.60	16,896
ESSEX COUNTY	BRIGHTON	TH-5	PLEASANT ST	PAVE	1.55	16,368
ESSEX COUNTY	CANAAN	TH-1	RIVER RD	PAVE	2.37	25,027
ESSEX COUNTY	CONCORD	TH-1	VICTORY RD	PAVE	2.62	27,667
ESSEX COUNTY	CONCORD	TH-2	BEACH DR	PAVE	0.86	9,082
ESSEX COUNTY	CONCORD	TH-3	SHADOW LAKE RD	PAVE	0.09	950
ESSEX COUNTY	CONCORD	TH-4	OREGON RD	PAVE	3.56	37,594
ESSEX COUNTY	EAST HAVEN	TH-1	SCHOOL ST	PAVE	0.67	7,075
ESSEX COUNTY	GUILDHALL	TH-1	GRANBY RD	PAVE	0.89	9,398
ESSEX COUNTY	GUILDHALL	TH-2	BRIDGE ST	PAVE	0.10	1,056
ESSEX COUNTY	LUNENBURG	TH-1	BEECH ST	PAVE	0.13	1,373
ESSEX COUNTY	LUNENBURG	TH-1	COMMERCIAL AVE	PAVE	0.18	1,901
ESSEX COUNTY	LUNENBURG	TH-1	EAST CONCORD RD	PAVE	1.03	10,877
ESSEX COUNTY	LUNENBURG	TH-1	RIVER RD	PAVE	5.28	55,757
ESSEX COUNTY	LUNENBURG	TH-1	RIVERSIDE AVE	PAVE	0.63	6,653
ESSEX COUNTY	LUNENBURG	TH-2	POND HILL RD	PAVE	0.76	8,026
ESSEX COUNTY	LUNENBURG	TH-2	BOBBIN MILL RD	PAVE	0.45	4,752
ESSEX COUNTY	LUNENBURG	TH-2	SOUTH LUNENBURG RD	PAVE	1.90	20,064
ESSEX COUNTY	LUNENBURG	TH-4	TOWN HIGHWAY 4	PAVE	0.04	422
ESSEX COUNTY	NORTON	TH-1	NELSON RD	PAVE	0.40	4,224
ESSEX COUNTY	VICTORY	TH-1	GRANBY RD	PAVE		-
ESSEX COUNTY	VICTORY	TH-2	VICTORY RD	PAVE		-
ESSEX COUNTY TOTALS					26.69	281,846

PROJECT NAME: STATEWIDE	
PROJECT NUMBER: HES MARK(404)	
FILE NAME: t14t186.dgn	PLOT DATE: 1/29/2015
PROJECT LEADER: P. COBURN	DRAWN BY: K. RECORD
DESIGNED BY: K. SWEET	CHECKED BY: I. DEGUTIS
CLASS 2 TOWN HIGHWAY QUANTITIES 14	SHEET 18 OF 56

SUMMARY BY COUNTY OF CLASS 2 TOWN HIGHWAYS

COUNTY	TOWN	TH NUMBER	TH NAME	SURFACE	MILEAGE	LINEAR FT
FRANKLIN COUNTY	BAKERSFIELD	TH-1	BOSTON POST RD	PAVE	2.54	26,822
FRANKLIN COUNTY	BAKERSFIELD	TH-2	EAST BAKERSFIELD RD	PAVE	0.81	8,554
FRANKLIN COUNTY	BERKSHIRE	TH-1	STANLEY HILL RD	PAVE	0.30	3,168
FRANKLIN COUNTY	BERKSHIRE	TH-3	BERKSHIRE CTR RD	PAVE	2.63	27,773
FRANKLIN COUNTY	BERKSHIRE	TH-3	RICHFORD RD	PAVE	3.75	39,600
FRANKLIN COUNTY	BERKSHIRE	TH-4	WATER TOWER RD	PAVE	4.12	43,507
FRANKLIN COUNTY	BERKSHIRE	TH-5	BERKSHIRE CTR RD	PAVE	4.10	43,296
FRANKLIN COUNTY	BERKSHIRE	TH-6	PERLEY RD	PAVE	0.20	2,112
FRANKLIN COUNTY	BERKSHIRE	TH-7	NOBLE RD	PAVE	0.55	5,808
FRANKLIN COUNTY	ENOSBURG	TH-1	TYLER BRANCH RD	PAVE	4.85	51,216
FRANKLIN COUNTY	ENOSBURG	TH-1	PERLEY RD	PAVE	0.85	8,976
FRANKLIN COUNTY	ENOSBURG	TH-2	BOSTON POST RD	PAVE	5.85	61,776
FRANKLIN COUNTY	ENOSBURG	TH-3	DUFFY HILL RD	PAVE	0.72	7,603
FRANKLIN COUNTY	ENOSBURG	TH-3	EAST SHELDON RD	PAVE	0.30	3,168
FRANKLIN COUNTY	ENOSBURG	TH-4	WATER TOWER RD	PAVE	0.85	8,976
FRANKLIN COUNTY	ENOSBURG	TH-5	DUFFY HILL RD	PAVE	0.73	7,709
FRANKLIN COUNTY	ENOSBURG	TH-6	DEPOT ST	PAVE	0.23	2,429
FRANKLIN COUNTY	ENOSBURG	TH-6	PLEASANT ST	PAVE	0.28	2,957
FRANKLIN COUNTY	ENOSBURG	TH-7	ST ALBANS ST	PAVE	0.45	4,752
FRANKLIN COUNTY	ENOSBURG	TH-8	ORCHARD ST	PAVE	0.75	7,920
FRANKLIN COUNTY	FAIRFAX	TH-1	BUCK HOLLOW RD	PAVE	5.20	54,912
FRANKLIN COUNTY	FAIRFAX	TH-2	FLETCHER RD	PAVE	3.62	38,227
FRANKLIN COUNTY	FAIRFAX	TH-3	OAKLAND STATION RD	PAVE	0.03	317
FRANKLIN COUNTY	FAIRFAX	TH-4	TOOF RD	PAVE	0.20	2,112
FRANKLIN COUNTY	FAIRFAX	TH-5	CARROLL HILL RD	PAVE	0.30	3,168
FRANKLIN COUNTY	FAIRFAX	TH-5	CADIEUX RD	PAVE	0.55	5,808
FRANKLIN COUNTY	FAIRFAX	TH-5	BRICK CHURCH RD	PAVE	1.05	11,088
FRANKLIN COUNTY	FAIRFIELD	TH-1	NORTH RD	PAVE	5.20	54,912
FRANKLIN COUNTY	FAIRFIELD	TH-1	SOUTH RD	PAVE	3.52	37,171
FRANKLIN COUNTY	FAIRFIELD	TH-2	CHESTER A ARTHUR RD	PAVE	4.65	49,104
FRANKLIN COUNTY	FAIRFIELD	TH-3	BUCK HOLLOW RD	PAVE	1.10	11,616
FRANKLIN COUNTY	FAIRFIELD	TH-4	POND RD	PAVE	4.33	45,725
FRANKLIN COUNTY	FAIRFIELD	TH-5	SHELDON WOODS RD	PAVE	1.10	11,616
FRANKLIN COUNTY	FAIRFIELD	TH-6	SWAMP RD	PAVE	1.90	20,064
FRANKLIN COUNTY	FLETCHER	TH-1	CAMBRIDGE RD	PAVE	3.25	34,320
FRANKLIN COUNTY	FLETCHER	TH-1	FAIRFAX RD	PAVE	1.67	17,635
FRANKLIN COUNTY	FLETCHER	TH-2	FAIRFIELD RD	PAVE	6.23	65,789
FRANKLIN COUNTY	FLETCHER	TH-3	BUCK HOLLOW RD	PAVE	1.10	11,616
FRANKLIN COUNTY	FRANKLIN	TH-1	MIDDLE RD	PAVE	0.04	422
FRANKLIN COUNTY	FRANKLIN	TH-1	MORSES LINE RD	PAVE	4.64	48,998
FRANKLIN COUNTY	FRANKLIN	TH-2	GORE RD	PAVE	0.58	6,125
FRANKLIN COUNTY SHEET 1 TOTAL					85.12	898,867

PROJECT NAME: STATEWIDE	
PROJECT NUMBER: HES MARK(404)	
FILE NAME: +14+186.dgn	PLOT DATE: 1/29/2015
PROJECT LEADER: P. COBURN	DRAWN BY: K. RECORD
DESIGNED BY: K. SWEET	CHECKED BY: I. DEGUTIS
CLASS 2 TOWN HIGHWAY QUANTITIES 15	SHEET 19 OF 56

SUMMARY BY COUNTY OF CLASS 2 TOWN HIGHWAYS

COUNTY	TOWN	TH NUMBER	TH NAME	SURFACE	MILEAGE	LINEAR FT
FRANKLIN COUNTY	FRANKLIN	TH-3	BROWNS CORNER RD	PAVE	3.05	32,208
FRANKLIN COUNTY	FRANKLIN	TH-3	HANNA RD	PAVE	0.57	6,019
FRANKLIN COUNTY	FRANKLIN	TH-4	DEWING RD	PAVE	0.90	9,504
FRANKLIN COUNTY	FRANKLIN	TH-5	SWAMP RD	PAVE	1.90	20,064
FRANKLIN COUNTY	FRANKLIN	TH-6	STANLEY RD	PAVE	2.15	22,704
FRANKLIN COUNTY	GEORGIA	TH-1	ARROW HEAD LAKE RD	PAVE	0.80	8,448
FRANKLIN COUNTY	GEORGIA	TH-2	PLAINS RD	PAVE	2.60	27,456
FRANKLIN COUNTY	GEORGIA	TH-3	POLLY HUBBARD RD	PAVE	1.15	12,144
FRANKLIN COUNTY	GEORGIA	TH-3	GEORGIA SHORE RD	PAVE	2.70	28,512
FRANKLIN COUNTY	GEORGIA	TH-3	GEORGIA MIDDLE RD	PAVE	2.25	23,760
FRANKLIN COUNTY	GEORGIA	TH-4	OAKLAND STATION RD	PAVE	3.83	40,445
FRANKLIN COUNTY	GEORGIA	TH-5	GEORGIA SHORE RD	PAVE	3.38	35,693
FRANKLIN COUNTY	GEORGIA	TH-6	MILL RIVER RD	PAVE	1.90	20,064
FRANKLIN COUNTY	HIGHGATE	TH-1	CARTER HILL RD	PAVE	3.58	37,805
FRANKLIN COUNTY	HIGHGATE	TH-2	GORE RD	PAVE	5.78	61,037
FRANKLIN COUNTY	HIGHGATE	TH-3	FRANKLIN RD	PAVE	2.15	22,704
FRANKLIN COUNTY	HIGHGATE	TH-4	MACHIA RD	PAVE	1.75	18,480
FRANKLIN COUNTY	HIGHGATE	TH-5	FRONTAGE RD	PAVE	2.61	27,562
FRANKLIN COUNTY	HIGHGATE	TH-6	ST ARMAND RD	PAVE	5.10	53,856
FRANKLIN COUNTY	MONTGOMERY	TH-1	FULLER BRIDGE RD	PAVE	1.88	19,853
FRANKLIN COUNTY	MONTGOMERY	TH-2	HAZENS NOTCH RD	PAVE	0.61	6,442
FRANKLIN COUNTY	RICHFORD	TH-1	PINNACLE RD	PAVE	1.43	15,101
FRANKLIN COUNTY	RICHFORD	TH-1	RIVER ST	PAVE	0.47	4,963
FRANKLIN COUNTY	RICHFORD	TH-2	SOUTH RICHFORD ST	PAVE	5.33	56,285
FRANKLIN COUNTY	RICHFORD	TH-3	NORTH BRANCH RD	PAVE	1.15	12,144
FRANKLIN COUNTY	ST ALBANS CITY	TH-6	NORTH ELM ST	PAVE		-
FRANKLIN COUNTY	ST ALBANS CITY	TH-7	HIGH ST	PAVE		-
FRANKLIN COUNTY	ST ALBANS CITY	TH-8	FEDERAL ST	PAVE		-
FRANKLIN COUNTY	ST ALBANS CITY	TH-9	CONGRESS ST	PAVE		-
FRANKLIN COUNTY	ST ALBANS CITY	TH-10	UPPER WELDON ST	PAVE		-
FRANKLIN COUNTY	ST ALBANS CITY	TH-11	FAIRFAX ST	PAVE		-
FRANKLIN COUNTY	ST ALBANS TOWN	TH-1	GEORGIA SHORE RD	PAVE	1.30	13,728
FRANKLIN COUNTY	ST ALBANS TOWN	TH-2	MAQUAM SHORE RD	PAVE	5.52	58,291
FRANKLIN COUNTY	ST ALBANS TOWN	TH-3	HATHAWAY POINT RD	PAVE	2.70	28,512
FRANKLIN COUNTY	ST ALBANS TOWN	TH-4	COUNTY RD	PAVE	0.69	7,286
FRANKLIN COUNTY	ST ALBANS TOWN	TH-5	CHURCH RD	PAVE	0.72	7,603
FRANKLIN COUNTY	ST ALBANS TOWN	TH-6	LOWER NEWTON RD	PAVE	2.36	24,922
FRANKLIN COUNTY	ST ALBANS TOWN	TH-7	HIGH ST	PAVE	0.24	2,534
FRANKLIN COUNTY	ST ALBANS TOWN	TH-8	CONGRESS ST	PAVE	0.25	2,640
FRANKLIN COUNTY SHEET 2 TOTAL					72.80	768,768

PROJECT NAME: STATEWIDE	
PROJECT NUMBER: HES MARK(404)	
FILE NAME: +14+186.dgn	PLOT DATE: 1/29/2015
PROJECT LEADER: P. COBURN	DRAWN BY: K. RECORD
DESIGNED BY: K. SWEET	CHECKED BY: I. DEGUTIS
CLASS 2 TOWN HIGHWAY QUANTITIES 16	SHEET 20 OF 56

SUMMARY BY COUNTY OF CLASS 2 TOWN HIGHWAYS

COUNTY	TOWN	TH NUMBER	TH NAME	SURFACE	MILEAGE	LINEAR FT
FRANKLIN COUNTY	ST ALBANS TOWN	TH-9	UPPER WELDON ST	PAVE	0.13	1,373
FRANKLIN COUNTY	ST ALBANS TOWN	TH-10	FAIRFAX ST	PAVE	0.91	9,610
FRANKLIN COUNTY	ST ALBANS TOWN	TH-11	BRIGHAM RD	PAVE	1.90	20,064
FRANKLIN COUNTY	ST ALBANS TOWN	TH-12	KELLOGG RD	PAVE	0.45	4,752
FRANKLIN COUNTY	ST ALBANS TOWN	TH-13	JEWETT AVE	PAVE	0.85	8,976
FRANKLIN COUNTY	ST ALBANS TOWN	TH-14	KELLOGG RD	PAVE	2.55	26,928
FRANKLIN COUNTY	SHELDON	TH-1	MILL ST	PAVE	0.29	3,062
FRANKLIN COUNTY	SHELDON	TH-1	SHAWVILLE RD	PAVE	1.29	13,622
FRANKLIN COUNTY	SHELDON	TH-2	EAST SHELDON RD	PAVE	5.70	60,192
FRANKLIN COUNTY	SHELDON	TH-2	PLEASANT ST	PAVE	0.70	7,392
FRANKLIN COUNTY	SHELDON	TH-2	BRIDGE ST	PAVE	0.28	2,957
FRANKLIN COUNTY	SHELDON	TH-3	KANE RD	PAVE	1.07	11,299
FRANKLIN COUNTY	SHELDON	TH-4	MAIN ST	PAVE	2.16	22,810
FRANKLIN COUNTY	SHELDON	TH-5	WOODS HILL RD	PAVE	1.65	17,424
FRANKLIN COUNTY	SHELDON	TH-6	MACHIA RD	PAVE	1.65	17,424
FRANKLIN COUNTY	SHELDON	TH-7	SHELDON WOODS RD	PAVE	1.20	12,672
FRANKLIN COUNTY	SWANTON	TH-2	BEEBE RD	PAVE	1.80	19,008
FRANKLIN COUNTY	SWANTON	TH-2	SOUTH RIVER ST	PAVE	1.08	11,405
FRANKLIN COUNTY	SWANTON	TH-3	WOODS HILL RD	PAVE	2.85	30,096
FRANKLIN COUNTY	SWANTON	TH-4	MAQUAM SHORE RD	PAVE	3.09	32,630
FRANKLIN COUNTY	SWANTON	TH-4	LAKE ST	PAVE	1.52	16,051
FRANKLIN COUNTY	SWANTON	TH-5	SOUTH RIVER ST	PAVE	0.22	2,323
FRANKLIN COUNTY	SWANTON	TH-5	POND RD	PAVE	1.19	12,566
FRANKLIN COUNTY	SWANTON	TH-6	BUSHEY RD	PAVE	3.55	37,488
FRANKLIN COUNTY	SWANTON	TH-6	LINDA AVE	PAVE	0.39	4,118
FRANKLIN COUNTY	SWANTON	TH-7	COUNTY RD	PAVE	3.03	31,997
FRANKLIN COUNTY	SWANTON	TH-8	BROWN AVE	PAVE	0.13	1,373
FRANKLIN COUNTY	SWANTON	TH-8	ELM ST	PAVE	0.13	1,373
FRANKLIN COUNTY	SWANTON	TH-9	ELM ST	PAVE	0.12	1,267
FRANKLIN COUNTY	SWANTON	TH-9	FRONTAGE RD	PAVE	0.60	6,336
FRANKLIN COUNTY	SWANTON	TH-10	FOURTH ST	PAVE	0.35	3,696
FRANKLIN COUNTY SHEET 3 TOTAL					42.83	452,285
FRANKLIN COUNTY SHEET 1 TOTAL					85.12	898,867
FRANKLIN COUNTY SHEET 2 TOTAL					72.80	768,768
FRANKLIN COUNTY SHEET 3 TOTAL					42.83	452,285
			FRANKLIN COUNTY TOTALS		200.75	2,119,920

PROJECT NAME:	STATEWIDE
PROJECT NUMBER:	HES MARK(404)
FILE NAME: +14+186.dgn	PLOT DATE: 1/29/2015
PROJECT LEADER: P. COBURN	DRAWN BY: K. RECORD
DESIGNED BY: K. SWEET	CHECKED BY: I. DEGUTIS
CLASS 2 TOWN HIGHWAY QUANTITIES 17	SHEET 21 OF 56

SUMMARY BY COUNTY OF CLASS 2 TOWN HIGHWAYS

COUNTY	TOWN	TH NUMBER	TH NAME	SURFACE	MILEAGE	LINEAR FT
GRAND ISLE COUNTY	ALBURGH	TH-1	BORDER RD	PAVE	1.59	16,790
GRAND ISLE COUNTY	ALBURGH	TH-2	ALBURGH SPRINGS RD	PAVE	2.84	29,990
GRAND ISLE COUNTY	ALBURGH	TH-3	WEST SHORE RD	PAVE	4.45	46,992
GRAND ISLE COUNTY	ALBURGH	TH-4	TRUCK ROUTE	PAVE	1.83	19,325
GRAND ISLE COUNTY	GRAND ISLE	TH-1	GRISWOLD RD	PAVE	1.12	11,827
GRAND ISLE COUNTY	GRAND ISLE	TH-1	MOCCASIN AVE	PAVE	1.38	14,573
GRAND ISLE COUNTY	GRAND ISLE	TH-1	WEST SHORE RD	PAVE	2.21	23,338
GRAND ISLE COUNTY	GRAND ISLE	TH-2	HYDE RD	PAVE	0.85	8,976
GRAND ISLE COUNTY	GRAND ISLE	TH-3	EAST SHORE RD	PAVE	2.11	22,282
GRAND ISLE COUNTY	GRAND ISLE	TH-3	TOWN LINE RD	PAVE	0.98	10,349
GRAND ISLE COUNTY	GRAND ISLE	TH-4	DONALDSON RD	PAVE	0.70	7,392
GRAND ISLE COUNTY	ISLE LOMOTTE	TH-1	MAIN ST	PAVE	4.69	49,526
GRAND ISLE COUNTY	ISLE LOMOTTE	TH-2	WEST SHORE RD	PAVE	1.15	12,144
GRAND ISLE COUNTY	ISLE LOMOTTE	TH-2	SHRINE RD	PAVE	1.10	11,616
GRAND ISLE COUNTY	ISLE LOMOTTE	TH-2	SCHOOL ST	PAVE	0.95	10,032
GRAND ISLE COUNTY	NORTH HERO	TH-1	LAKE VIEW DR	PAVE	2.21	23,338
GRAND ISLE COUNTY	NORTH HERO	TH-1	BRIDGE ST	PAVE	1.79	18,902
GRAND ISLE COUNTY	NORTH HERO	TH-2	SOUTH END RD	PAVE	0.91	9,610
GRAND ISLE COUNTY	NORTH HERO	TH-2	STATION RD	PAVE	1.14	12,038
GRAND ISLE COUNTY	NORTH HERO	TH-2	WEST SHORE RD	PAVE	1.41	14,890
GRAND ISLE COUNTY	NORTH HERO	TH-3	LAKEVIEW DR	PAVE	1.74	18,374
GRAND ISLE COUNTY	SOUTH HERO	TH-1	STATION RD	PAVE	1.53	16,157
GRAND ISLE COUNTY	SOUTH HERO	TH-1	TRACY RD	PAVE	0.31	3,274
GRAND ISLE COUNTY	SOUTH HERO	TH-2	SOUTH ST	PAVE	3.30	34,848
GRAND ISLE COUNTY	SOUTH HERO	TH-4	TRACY RD	PAVE	0.31	3,274
GRAND ISLE COUNTY	SOUTH HERO	TH-5	LANDON RD	PAVE	1.70	17,952
GRAND ISLE COUNTY TOTALS					44.30	467,808

PROJECT NAME: STATEWIDE	
PROJECT NUMBER: HES MARK(404)	
FILE NAME: t14t186.dgn	PLOT DATE: 1/29/2015
PROJECT LEADER: P. COBURN	DRAWN BY: K. RECORD
DESIGNED BY: K. SWEET	CHECKED BY: I. DEGUTIS
CLASS 2 TOWN HIGHWAY QUANTITIES 18	SHEET 22 OF 56

SUMMARY BY COUNTY OF CLASS 2 TOWN HIGHWAYS

COUNTY	TOWN	TH NUMBER	TH NAME	SURFACE	MILEAGE	LINEAR FT
LAMOILLE COUNTY	CAMBRIDGE	TH-1	LOWER PLEASANT VALLEY RD	PAVE	3.85	40,656
LAMOILLE COUNTY	CAMBRIDGE	TH-1	MANSFIELD AVE	PAVE	0.18	1,901
LAMOILLE COUNTY	CAMBRIDGE	TH-1	PLEASANT VALLEY RD	PAVE	0.55	5,808
LAMOILLE COUNTY	CAMBRIDGE	TH-2	PUMPKIN HARBOR RD	PAVE	1.26	13,306
LAMOILLE COUNTY	CAMBRIDGE	TH-3	PLOT RD	PAVE	0.75	7,920
LAMOILLE COUNTY	CAMBRIDGE	TH-4	HOGBACK RD	PAVE	2.20	23,232
LAMOILLE COUNTY	CAMBRIDGE	TH-5	UPPER PLEASANT VALLEY RD	PAVE	4.23	44,669
LAMOILLE COUNTY	EDEN	TH-1	NORTH RD	PAVE	3.40	35,904
LAMOILLE COUNTY	EDEN	TH-2	EAST HILL RD	PAVE	0.59	6,230
LAMOILLE COUNTY	ELMORE	TH-2	ELMORE POND RD	PAVE	0.40	4,224
LAMOILLE COUNTY	HYDE PARK	TH-1	CENTER RD	PAVE	3.40	35,904
LAMOILLE COUNTY	HYDE PARK	TH-1	CENTERVILLE RD	PAVE	3.00	31,680
LAMOILLE COUNTY	HYDE PARK	TH-2	DEPOT ST	PAVE	0.28	2,957
LAMOILLE COUNTY	HYDE PARK	TH-3	FERRY ST	PAVE	0.56	5,914
LAMOILLE COUNTY	HYDE PARK	TH-3	NORTH HYDE PARK RD	PAVE	3.97	41,923
LAMOILLE COUNTY	HYDE PARK	TH-4	JOHNSON ST EXT	PAVE	0.27	2,851
LAMOILLE COUNTY	HYDE PARK	TH-4	MAIN ST	PAVE	0.28	2,957
LAMOILLE COUNTY	HYDE PARK	TH-4	EAST MAIN ST	PAVE	0.65	6,864
LAMOILLE COUNTY	HYDE PARK	TH-5	CHURCH ST	PAVE	0.30	3,168
LAMOILLE COUNTY	JOHNSON	TH-1	CLAY HILL RD	PAVE	0.91	9,610
LAMOILLE COUNTY	JOHNSON	TH-1	PEARL ST	PAVE	0.12	1,267
LAMOILLE COUNTY	JOHNSON	TH-1	PLOT RD	PAVE	0.40	4,224
LAMOILLE COUNTY	JOHNSON	TH-2	RAILROAD ST	PAVE	0.50	5,280
LAMOILLE COUNTY	JOHNSON	TH-3	SCHOOL ST	PAVE	0.40	4,224
LAMOILLE COUNTY	JOHNSON	TH-4	HOGBACK RD	PAVE	2.43	25,661
LAMOILLE COUNTY	JOHNSON	TH-6	WILSON RD	PAVE	0.36	3,802
LAMOILLE COUNTY	JOHNSON	TH-7	FOOTE BROOK RD	PAVE	0.24	2,534
LAMOILLE COUNTY	MORRISTOWN	TH-2	CADYS FALLS RD	PAVE	2.37	25,027
LAMOILLE COUNTY	MORRISTOWN	TH-2	MORRISTOWN CORNERS RD	PAVE	0.10	1,056
LAMOILLE COUNTY	MORRISTOWN	TH-3	BRIDGE ST	PAVE	0.45	4,752
LAMOILLE COUNTY	MORRISTOWN	TH-4	RANDOLPH RD	PAVE	1.14	12,038
LAMOILLE COUNTY	MORRISTOWN	TH-5	BRIDGE ST	PAVE	0.28	2,957
LAMOILLE COUNTY	MORRISTOWN	TH-5	STAGECOACH RD	PAVE	5.60	59,136
LAMOILLE COUNTY	MORRISTOWN	TH-6	RANDOLPH RD	PAVE	5.02	53,011
LAMOILLE COUNTY	MORRISTOWN	TH-7	CENTER RD	PAVE	0.45	4,752
LAMOILLE COUNTY	STOWE	TH-1	MOSCOW RD	PAVE	2.09	22,070
LAMOILLE COUNTY	STOWE	TH-2	RANDOLPH RD	PAVE	0.65	6,864
LAMOILLE COUNTY	STOWE	TH-3	SCHOOL ST	PAVE	0.31	3,274
LAMOILLE COUNTY	STOWE	TH-3	STOWE HOLLOW RD	PAVE	2.70	28,512
LAMOILLE COUNTY SHEET 1 TOTAL					56.64	598,118

PROJECT NAME: STATEWIDE	
PROJECT NUMBER: HES MARK(404)	
FILE NAME: +14+186.dgn	PLOT DATE: 1/29/2015
PROJECT LEADER: P. COBURN	DRAWN BY: K. RECORD
DESIGNED BY: K. SWEET	CHECKED BY: I. DEGUTIS
CLASS 2 TOWN HIGHWAY QUANTITIES 19	SHEET 23 OF 56

SUMMARY BY COUNTY OF CLASS 2 TOWN HIGHWAYS

COUNTY	TOWN	TH NUMBER	TH NAME	SURFACE	MILEAGE	LINEAR FT
LAMOILLE COUNTY	STOWE	TH-4	STAGECOACH RD	PAVE	1.56	16,474
LAMOILLE COUNTY	STOWE	TH-5	BARROWS RD	PAVE	1.80	19,008
LAMOILLE COUNTY	STOWE	TH-5	LUCE HILL RD	PAVE	0.55	5,808
LAMOILLE COUNTY	STOWE	TH-6	MAYO FARM RD	PAVE	0.45	4,752
LAMOILLE COUNTY	STOWE	TH-6	WEST HILL RD	PAVE	0.67	7,075
LAMOILLE COUNTY	STOWE	TH-6	WEEKS HILL RD	PAVE	0.29	3,062
LAMOILLE COUNTY	STOWE	TH-7	GOLD BROOK RD	PAVE	1.33	14,045
LAMOILLE COUNTY	WATERVILLE	TH-1	PLOT RD	PAVE	1.06	11,194
LAMOILLE COUNTY	WATERVILLE	TH-2	HOGBACK RD	PAVE	0.04	422
LAMOILLE COUNTY	WOLCOTT	TH-1	NORTH WOLCOTT RD	PAVE	5.25	55,440
LAMOILLE COUNTY	WOLCOTT	TH-2	FORT HILL RD	PAVE	0.32	3,379
LAMOILLE COUNTY	WOLCOTT	TH-3	SCHOOL ST	PAVE	0.24	2,534
LAMOILLE COUNTY	WOLCOTT	TH-4	ELMORE POND RD	PAVE	0.54	5,702
LAMOILLE COUNTY SHEET 2 TOTAL					14.10	148,896
LAMOILLE COUNTY SHEET 1 TOTAL					56.64	598,118
LAMOILLE COUNTY SHEET 2 TOTAL					14.10	148,896
			LAMOILLE COUNTY TOTALS		70.74	747,014

SUMMARY BY COUNTY OF CLASS 2 TOWN HIGHWAYS

COUNTY	TOWN	TH NUMBER	TH NAME	SURFACE	MILEAGE	LINEAR FT
ORANGE COUNTY	BRADFORD	TH-1	CHELSEA RD	PAVE	1.82	19,219
ORANGE COUNTY	BRADFORD	TH-2	ROWELL BROOK RD	PAVE	2.29	24,182
ORANGE COUNTY	BRADFORD	TH-3	FAIRGROUND RD	PAVE	2.99	31,574
ORANGE COUNTY	BRADFORD	TH-4	SOUTH RD	PAVE	3.61	38,122
ORANGE COUNTY	BRAINTREE	TH-2	THRESHER RD	PAVE	0.53	5,597
ORANGE COUNTY	BRAINTREE	TH-2	BRAINTREE HILL RD	PAVE	1.12	11,827
ORANGE COUNTY	BROOKFIELD	TH-1	NORTHFIELD RD	PAVE	1.15	12,144
ORANGE COUNTY	BROOKFIELD	TH-1	STONE RD	PAVE	0.18	1,901
ORANGE COUNTY	BROOKFIELD	TH-2	RIDGE RD	PAVE	3.26	34,426
ORANGE COUNTY	BROOKFIELD	TH-5	EAST RANDOLPH RD	PAVE	0.48	5,069
ORANGE COUNTY	CHELSEA	TH-1	EAST RANDOLPH RD	PAVE	2.89	30,518
ORANGE COUNTY	CHELSEA	TH-2	UPPER VILLAGE RD	PAVE	1.60	16,896
ORANGE COUNTY	CORINTH	TH-1	VILLAGE RD	PAVE	1.10	11,616
ORANGE COUNTY	CORINTH	TH-2	COOKVILLE RD	PAVE	2.89	30,518
ORANGE COUNTY	CORINTH	TH-2	BROOK RD	PAVE	0.38	4,013
ORANGE COUNTY	CORINTH	TH-2	GOOSE GREEN RD	PAVE	2.81	29,674
ORANGE COUNTY	CORINTH	TH-3	CHELSEA RD	PAVE	5.71	60,298
ORANGE COUNTY	CORINTH	TH-4	BROOK RD	PAVE	3.97	41,923
ORANGE COUNTY	CORINTH	TH-6	EAGLE HOLLOW RD	PAVE	0.74	7,814
ORANGE COUNTY	CORINTH	TH-7	SOUTH RD	PAVE	0.04	422
ORANGE COUNTY	FAIRLEE	TH-1	LAKE MOREY RD	PAVE	5.56	58,714
ORANGE COUNTY	NEWBURY	TH-1	SNAKE RD	PAVE	3.15	33,264
ORANGE COUNTY	NEWBURY	TH-1	TYLER FARM RD	PAVE	1.60	16,896
ORANGE COUNTY	NEWBURY	TH-2	SWAMP RD	PAVE	1.22	12,883
ORANGE COUNTY	NEWBURY	TH-3	BOLTONVILLE RD	PAVE	0.29	3,062
ORANGE COUNTY	NEWBURY	TH-4	CHAPEL ST	PAVE	0.23	2,429
ORANGE COUNTY	NEWBURY	TH-4	SCOTCH HOLLOW RD	PAVE	6.62	69,907
ORANGE COUNTY	ORANGE	TH-1	RESERVOIR RD	PAVE	4.95	52,272
ORANGE COUNTY	ORANGE	TH-2	TUCKER RD	PAVE	1.91	20,170
ORANGE COUNTY	RANDOLPH	TH-1	RIDGE RD	PAVE	3.31	34,954
ORANGE COUNTY	RANDOLPH	TH-2	EAST BETHEL RD	PAVE	2.23	23,549
ORANGE COUNTY	RANDOLPH	TH-3	CHELSEA MOUNTAIN RD	PAVE	3.56	37,594
ORANGE COUNTY	RANDOLPH	TH-6	WINDOVER RD	PAVE	0.47	4,963
ORANGE COUNTY	RANDOLPH	TH-8	BEANVILLE RD	PAVE	1.23	12,989
ORANGE COUNTY	RANDOLPH	TH-8	PLEASANT ST	PAVE	0.20	2,112
ORANGE COUNTY	RANDOLPH	TH-8	SOUTH PLEASANT ST	PAVE	0.42	4,435
ORANGE COUNTY	STRAFFORD	TH-1	ROUTE 132	PAVE	4.63	48,893
ORANGE COUNTY	STRAFFORD	TH-2	JUSTIN SMITH MEMORIAL HWY	PAVE	5.79	61,142
ORANGE COUNTY	STRAFFORD	TH-3	MILLER POND RD	PAVE	2.70	28,512
ORANGE COUNTY SHEET 1 TOTAL					89.63	946,493

PROJECT NAME: STATEWIDE	
PROJECT NUMBER: HES MARK(404)	
FILE NAME: +14+186.dgn	PLOT DATE: 1/29/2015
PROJECT LEADER: P. COBURN	DRAWN BY: K. RECORD
DESIGNED BY: K. SWEET	CHECKED BY: I. DEGUTIS
CLASS 2 TOWN HIGHWAY QUANTITIES 21	SHEET 25 OF 56

SUMMARY BY COUNTY OF CLASS 2 TOWN HIGHWAYS

COUNTY	TOWN	TH NUMBER	TH NAME	SURFACE	MILEAGE	LINEAR FT
ORANGE COUNTY	THETFORD	TH-1	ROUTE 132	PAVE	5.17	54,595
ORANGE COUNTY	THETFORD	TH-2	WEST FAIRLEE RD	PAVE	0.59	6,230
ORANGE COUNTY	THETFORD	TH-3	MAIN ST	PAVE	0.20	2,112
ORANGE COUNTY	THETFORD	TH-3	ACADEMY RD	PAVE	2.80	29,568
ORANGE COUNTY	THETFORD	TH-4	MILLER POND RD	PAVE	0.77	8,131
ORANGE COUNTY	THETFORD	TH-5	LATHAM RD	PAVE	2.39	25,238
ORANGE COUNTY	THETFORD	TH-6	TUCKER HILL RD	PAVE	2.27	23,971
ORANGE COUNTY	TOPSHAM	TH-1	POWDER SPRING RD	PAVE	5.33	56,285
ORANGE COUNTY	TOPSHAM	TH-1	TOPSHAM-CORINTH RD	PAVE	3.78	39,917
ORANGE COUNTY	TOPSHAM	TH-2	SWAMP RD	PAVE	2.09	22,070
ORANGE COUNTY	TOPSHAM	TH-3	EAST ORANGE RD	PAVE	0.98	10,349
ORANGE COUNTY	TUNBRIDGE	TH-1	STAFFORD RD	PAVE	4.84	51,110
ORANGE COUNTY	VERSHIRE	TH-1	GOOSE GREEN RD	PAVE	1.48	15,629
ORANGE COUNTY	VERSHIRE	TH-2	MILLER POND RD	PAVE	0.29	3,062
ORANGE COUNTY	VERSHIRE	TH-2	SOUTH VERSHIRE RD	PAVE	0.17	1,795
ORANGE COUNTY	VERSHIRE	TH-3	EAGLE HOLLOW RD	PAVE	2.38	25,133
ORANGE COUNTY	WEST FAIRLEE	TH-1	CROSSROAD	PAVE	0.44	4,646
ORANGE COUNTY	WEST FAIRLEE	TH-1	WEST FAIRLEE RD	PAVE	0.28	2,957
ORANGE COUNTY	WEST FAIRLEE	TH-2	MIDDLEBROOK RD	PAVE	4.40	46,464
ORANGE COUNTY	WEST FAIRLEE	TH-2	WILD HILL RD	PAVE	1.35	14,256
ORANGE COUNTY	WEST FAIRLEE	TH-3	BEANVILLE RD	PAVE	0.90	9,504
ORANGE COUNTY	WILLIAMSTOWN	TH-1	COGSWELL ST	PAVE	0.48	5,069
ORANGE COUNTY	WILLIAMSTOWN	TH-1	GRANITEVILLE RD	PAVE	3.18	33,581
ORANGE COUNTY	WILLIAMSTOWN	TH-1	MEADOW ST	PAVE	0.30	3,168
ORANGE COUNTY	WILLIAMSTOWN	TH-3	CHELSEA RD	PAVE	3.93	41,501
ORANGE COUNTY	WILLIAMSTOWN	TH-4	ROOD POND RD	PAVE	0.02	211
ORANGE COUNTY	WILLIAMSTOWN	TH-6	ROBAR RD	PAVE	0.53	5,597
ORANGE COUNTY	WILLIAMSTOWN	TH-7	PIRIE RD	PAVE	0.85	8,976
ORANGE COUNTY SHEET 2 TOTAL					52.19	551,126
ORANGE COUNTY SHEET 1 TOTAL					89.63	946,493
ORANGE COUNTY SHEET 2 TOTAL					52.19	551,126
			ORANGE COUNTY TOTALS		141.82	1,497,619

PROJECT NAME: STATEWIDE	
PROJECT NUMBER: HES MARK(404)	
FILE NAME: +14+186.dgn	PLOT DATE: 1/29/2015
PROJECT LEADER: P. COBURN	DRAWN BY: K. RECORD
DESIGNED BY: K SWEET	CHECKED BY: I. DEGUTIS
CLASS 2 TOWN HIGHWAY QUANTITIES 22	SHEET 26 OF 56

SUMMARY BY COUNTY OF CLASS 2 TOWN HIGHWAYS

COUNTY	TOWN	TH NUMBER	TH NAME	SURFACE	MILEAGE	LINEAR FT
ORLEANS COUNTY	ALBANY	TH-1	CREEK RD	PAVE	2.71	28,618
ORLEANS COUNTY	ALBANY	TH-3	WATER ST	PAVE	0.48	5,069
ORLEANS COUNTY	BARTON	TH-1	WILLOUGHBY LAKE RD	PAVE	5.57	58,819
ORLEANS COUNTY	BARTON	TH-2	MAPLE ST	PAVE	0.51	5,386
ORLEANS COUNTY	BARTON	TH-2	ROARING BROOK RD	PAVE	1.90	20,064
ORLEANS COUNTY	BARTON	TH-3	EAST ST	PAVE	0.38	4,013
ORLEANS COUNTY	BARTON	TH-3	EASTERN AVE	PAVE	0.74	7,814
ORLEANS COUNTY	BARTON	TH-3	MAPLE ST	PAVE	0.35	3,696
ORLEANS COUNTY	BARTON	TH-4	TARBOX HILL RD	PAVE	0.52	5,491
ORLEANS COUNTY	BARTON	TH-4	ROARING BROOK RD	PAVE	0.56	5,914
ORLEANS COUNTY	BARTON	TH-5	ELM ST	PAVE	0.64	6,758
ORLEANS COUNTY	BARTON	TH-5	CENTER RD	PAVE	0.50	5,280
ORLEANS COUNTY	BARTON	TH-6	LAKE REGION RD	PAVE	0.92	9,715
ORLEANS COUNTY	BARTON	TH-7	BURTON HILL RD	PAVE	0.95	10,032
ORLEANS COUNTY	BARTON	TH-8	MAPLE HILL RD	PAVE	3.53	37,277
ORLEANS COUNTY	BROWNINGTON	TH-1	CENTER RD	PAVE	1.40	14,784
ORLEANS COUNTY	BROWNINGTON	TH-2	SCHOOLHOUSE RD	PAVE	0.17	1,795
ORLEANS COUNTY	BROWNINGTON	TH-2	OLD STONEHOUSE RD	PAVE	0.25	2,640
ORLEANS COUNTY	BROWNINGTON	TH-2	HINMAN SETTLER RD	PAVE	0.45	4,752
ORLEANS COUNTY	BROWNINGTON	TH-2	FROG POND RD	PAVE	1.19	12,566
ORLEANS COUNTY	BROWNINGTON	TH-2	HUNT HILL RD	PAVE	0.39	4,118
ORLEANS COUNTY	CHARLESTON	TH-1	HUDSON RD	PAVE	2.98	31,469
ORLEANS COUNTY	CHARLESTON	TH-2	DURGIN RD	PAVE	0.80	8,448
ORLEANS COUNTY	CHARLESTON	TH-3	CHURCH HILL RD	PAVE	0.45	4,752
ORLEANS COUNTY	COVENTRY	TH-2	AIRPORT RD	PAVE	1.36	14,362
ORLEANS COUNTY	COVENTRY	TH-4	ALDERBROOK RD	PAVE	1.95	20,592
ORLEANS COUNTY	CRAFTSBURY	TH-1	NORTH CRAFTSBURY RD	PAVE	3.67	38,755
ORLEANS COUNTY	CRAFTSBURY	TH-1	SOUTH CRAFTSBURY RD	PAVE	1.79	18,902
ORLEANS COUNTY	CRAFTSBURY	TH-2	EAST CRAFTSBURY RD	PAVE	2.18	23,021
ORLEANS COUNTY	CRAFTSBURY	TH-3	WILD BRANCH RD	PAVE	3.32	35,059
ORLEANS COUNTY	DERBY	TH-1	HOLLAND RD	PAVE	2.16	22,810
ORLEANS COUNTY	DERBY	TH-1	CASWELL AVE	PAVE	0.08	845
ORLEANS COUNTY	DERBY	TH-2	ELM ST	PAVE	1.89	19,958
ORLEANS COUNTY	DERBY	TH-3	BEEBE RD	PAVE	3.16	33,370
ORLEANS COUNTY	DERBY	TH-3	BAXTER AVE	PAVE	0.50	5,280
ORLEANS COUNTY	DERBY	TH-4	DARLING HILL RD	PAVE	4.78	50,477
ORLEANS COUNTY	DERBY	TH-5	HINMAN SETTLER RD	PAVE	1.72	18,163
ORLEANS COUNTY	DERBY	TH-6	NORTH DERBY RD	PAVE	4.32	45,619
ORLEANS COUNTY	DERBY	TH-7	SHATTUCK HILL RD	PAVE	1.30	13,728
ORLEANS COUNTY	GLOVER	TH-1	COUNTY RD	PAVE	2.09	22,070
ORLEANS COUNTY	GLOVER	TH-3	ROARING BROOK RD	PAVE	0.28	2,957
ORLEANS COUNTY	GLOVER	TH-3	BEAN HILL RD	PAVE	2.60	27,456
ORLEANS COUNTY SHEET 1 TOTAL					67.49	712,694

PROJECT NAME: STATEWIDE	
PROJECT NUMBER: HES MARK(404)	
FILE NAME: +14+186.dgn	PLOT DATE: 1/29/2015
PROJECT LEADER: P. COBURN	DRAWN BY: K. RECORD
DESIGNED BY: K. SWEET	CHECKED BY: I. DEGUTIS
CLASS 2 TOWN HIGHWAY QUANTITIES 23	SHEET 27 OF 56

SUMMARY BY COUNTY OF CLASS 2 TOWN HIGHWAYS

COUNTY	TOWN	TH NUMBER	TH NAME	SURFACE	MILEAGE	LINEAR FT
ORLEANS COUNTY	GREENSBORO	TH-1	CRAFTSBURY RD	PAVE	4.94	52,166
ORLEANS COUNTY	GREENSBORO	TH-1	BEND RD	PAVE	2.65	27,984
ORLEANS COUNTY	GREENSBORO	TH-1	WILSON ST	PAVE	0.16	1,690
ORLEANS COUNTY	GREENSBORO	TH-2	BREEZY AVE	PAVE	0.84	8,870
ORLEANS COUNTY	GREENSBORO	TH-2	HARDWICK ST	PAVE	0.70	7,392
ORLEANS COUNTY	GREENSBORO	TH-3	CENTER RD	PAVE	0.52	5,491
ORLEANS COUNTY	GREENSBORO	TH-4	MAIN ST	PAVE	1.37	14,467
ORLEANS COUNTY	HOLLAND	TH-1	VALLEY RD	PAVE	6.35	67,056
ORLEANS COUNTY	IRASBURG	TH-1	PARK AVE	PAVE	0.16	1,690
ORLEANS COUNTY	IRASBURG	TH-1	CREEK RD	PAVE	2.50	26,400
ORLEANS COUNTY	IRASBURG	TH-3	RIVER RD	PAVE	0.51	5,386
ORLEANS COUNTY	IRASBURG	TH-4	BURTON HILL RD	PAVE	0.73	7,709
ORLEANS COUNTY	IRASBURG	TH-5	LAKE REGION RD	PAVE	1.13	11,933
ORLEANS COUNTY	JAY	TH-1	CROSS RD	PAVE	3.31	34,954
ORLEANS COUNTY	JAY	TH-2	JAY PEAK RD	PAVE	0.79	8,342
ORLEANS COUNTY	JAY	TH-3	STONEY PATH RD	PAVE	0.56	5,914
ORLEANS COUNTY	LOWELL	TH-1	HAZEN NOTCH RD	PAVE	1.89	19,958
ORLEANS COUNTY	LOWELL	TH-2	LOWER VILLAGE RD	PAVE	0.50	5,280
ORLEANS COUNTY	LOWELL	TH-3	MINES RD	PAVE	5.20	54,912
ORLEANS COUNTY	MORGAN	TH-1	VALLEY RD	PAVE	1.60	16,896
ORLEANS COUNTY	MORGAN	TH-2	GORE RD SOUTH	PAVE	1.40	14,784
ORLEANS COUNTY	MORGAN	TH-3	MORGAN-CHARLESTON RD	PAVE	0.36	3,802
ORLEANS COUNTY	NEWPORT CITY	TH-3	LAKE RD	PAVE	2.23	23,549
ORLEANS COUNTY	NEWPORT CITY	TH-3	MAIN ST	PAVE	0.28	2,957
ORLEANS COUNTY	NEWPORT CITY	TH-4	GLEN RD	PAVE	1.21	12,778
ORLEANS COUNTY	NEWPORT CITY	TH-4	WESTERN AVE	PAVE	0.39	4,118
ORLEANS COUNTY	NEWPORT CITY	TH-6	SIAS AVE	PAVE	0.52	5,491
ORLEANS COUNTY	NEWPORT CITY	TH-8	WESTERN AVE	PAVE	0.30	3,168
ORLEANS COUNTY	NEWPORT CITY	TH-9	ALDERBROOK RD	PAVE	0.24	2,534
ORLEANS COUNTY	NEWPORT CITY	TH-10	BLUFF RD	PAVE	0.95	10,032
ORLEANS COUNTY	NEWPORT CITY	TH-10	UNION ST	PAVE	0.35	3,696
ORLEANS COUNTY	NEWPORT CITY	TH-11	RAILROAD SQUARE	PAVE	0.18	1,901
ORLEANS COUNTY	NEWPORT TOWN	TH-1	CROSS RD	PAVE	2.75	29,040
ORLEANS COUNTY	NEWPORT TOWN	TH-2	LAKE RD	PAVE	3.14	33,158
ORLEANS COUNTY	NEWPORT TOWN	TH-3	VANCE HILL RD	PAVE	3.40	35,904
ORLEANS COUNTY	NEWPORT TOWN	TH-4	CITY FARM RD	PAVE	1.45	15,312
ORLEANS COUNTY	TROY	TH-1	SOUTH PLEASANT ST	PAVE	0.32	3,379
ORLEANS COUNTY	TROY	TH-2	EAST HILL	PAVE	5.70	60,192
ORLEANS COUNTY	TROY	TH-3	ELM ST	PAVE	0.20	2,112
ORLEANS COUNTY	TROY	TH-3	HIGHLAND AVE	PAVE	0.09	950
ORLEANS COUNTY SHEET 2 TOTAL					61.87	653,347

PROJECT NAME: STATEWIDE	
PROJECT NUMBER: HES MARK(404)	
FILE NAME: +14+186.dgn	PLOT DATE: 1/29/2015
PROJECT LEADER: P. COBURN	DRAWN BY: K. RECORD
DESIGNED BY: K. SWEET	CHECKED BY: I. DEGUTIS
CLASS 2 TOWN HIGHWAY QUANTITIES 24	SHEET 28 OF 56

SUMMARY BY COUNTY OF CLASS 2 TOWN HIGHWAYS

COUNTY	TOWN	TH NUMBER	TH NAME	SURFACE	MILEAGE	LINEAR FT
ORLEANS COUNTY	WESTFIELD	TH-1	NORTH HILL RD	PAVE	2.70	28,512
ORLEANS COUNTY	WESTFIELD	TH-3	KENNISON RD	PAVE	2.35	24,816
ORLEANS COUNTY	WESTMORE	TH-1	WILLOUGHBY LAKE RD	PAVE	0.46	4,858
ORLEANS COUNTY	WESTMORE	TH-1	NORTH BEACH RD	PAVE	0.29	3,062
ORLEANS COUNTY SHEET 3 TOTAL					5.80	61,248
ORLEANS COUNTY SHEET 1 TOTAL					67.49	712,694
ORLEANS COUNTY SHEET 2 TOTAL					61.87	653,347
ORLEANS COUNTY SHEET 3 TOTAL					5.80	61,248
			ORLEANS COUNTY TOTALS		135.16	1,427,290

PROJECT NAME: STATEWIDE	
PROJECT NUMBER: HES MARK(404)	
FILE NAME: +14+186.dgn	PLOT DATE: 1/29/2015
PROJECT LEADER: P. COBURN	DRAWN BY: K. RECORD
DESIGNED BY: K. SWEET	CHECKED BY: I. DEGUTIS
CLASS 2 TOWN HIGHWAY QUANTITIES 25	SHEET 29 OF 56

SUMMARY BY COUNTY OF CLASS 2 TOWN HIGHWAYS

COUNTY	TOWN	TH NUMBER	TH NAME	SURFACE	MILEAGE	LINEAR FT
RUTLAND COUNTY	BENSON	TH-1	HULETT HILL RD	PAVE	0.70	7,392
RUTLAND COUNTY	BENSON	TH-1	STAGE RD	PAVE	2.57	27,139
RUTLAND COUNTY	BENSON	TH-2	ROUTE 144	PAVE	4.24	44,774
RUTLAND COUNTY	BENSON	TH-3	LAKE RD	PAVE	3.84	40,550
RUTLAND COUNTY	BENSON	TH-4	SUNSET LAKE RD	PAVE	0.63	6,653
RUTLAND COUNTY	BRANDON	TH-4	PEARL ST	PAVE	1.73	18,269
RUTLAND COUNTY	BRANDON	TH-5	CARVER ST	PAVE	0.04	422
RUTLAND COUNTY	BRANDON	TH-5	FLORENCE RD	PAVE	0.69	7,286
RUTLAND COUNTY	BRANDON	TH-5	UNION ST	PAVE	2.89	30,518
RUTLAND COUNTY	BRANDON	TH-6	NORTH ST	PAVE	1.33	14,045
RUTLAND COUNTY	BRANDON	TH-7	ARNOLD DISTRICT RD	PAVE	2.47	26,083
RUTLAND COUNTY	BRANDON	TH-8	MCCONNELL RD	PAVE	3.30	34,848
RUTLAND COUNTY	BRANDON	TH-9	HIGH POND RD	PAVE	2.42	25,555
RUTLAND COUNTY	CASTLETON	TH-2	CREEK RD	PAVE	2.48	26,189
RUTLAND COUNTY	CASTLETON	TH-2	WEST CASTLETON RD	PAVE	2.34	24,710
RUTLAND COUNTY	CASTLETON	TH-3	EAST HUBBARDTON RD	PAVE	4.97	52,483
RUTLAND COUNTY	CASTLETON	TH-4	SOUTH ST	PAVE	2.65	27,984
RUTLAND COUNTY	CASTLETON	TH-5	NORTH RD	PAVE	4.12	43,507
RUTLAND COUNTY	CASTLETON	TH-6	BLISSVILLE RD	PAVE	1.30	13,728
RUTLAND COUNTY	CHITTENDEN	TH-1	CHITTENDEN RD	PAVE	2.23	23,549
RUTLAND COUNTY	CHITTENDEN	TH-1	DAM RD	PAVE	2.16	22,810
RUTLAND COUNTY	CHITTENDEN	TH-2	POWERHOUSE RD	PAVE	1.43	15,101
RUTLAND COUNTY	CHITTENDEN	TH-2	FURNACE BROOK RD	PAVE	0.74	7,814
RUTLAND COUNTY	CHITTENDEN	TH-2	HOLDEN RD	PAVE	2.38	25,133
RUTLAND COUNTY	CHITTENDEN	TH-3	MEADOW LAKE DR	PAVE	0.04	422
RUTLAND COUNTY	CHITTENDEN	TH-4	MOUNTAIN TOP RD	PAVE	1.80	19,008
RUTLAND COUNTY	CLARENDON	TH-1	MIDDLE RD	PAVE	4.11	43,402
RUTLAND COUNTY	CLARENDON	TH-2	CREEK RD	PAVE	4.67	49,315
RUTLAND COUNTY	CLARENDON	TH-3	WALKER MTN RD	PAVE	6.21	65,578
RUTLAND COUNTY	CLARENDON	TH-4	COLD RIVER RD	PAVE	0.95	10,032
RUTLAND COUNTY	CLARENDON	TH-4	NORTH SHREWSBURY RD	PAVE	0.99	10,454
RUTLAND COUNTY	CLARENDON	TH-6	COLD RIVER RD	PAVE	0.54	5,702
RUTLAND COUNTY	CLARENDON	TH-7	AIRPORT RD	PAVE	1.76	18,586
RUTLAND COUNTY	CLARENDON	TH-8	EAST CLARENDON RD	PAVE	3.26	34,426
RUTLAND COUNTY	DANBY	TH-1	BROOK RD	PAVE	4.14	43,718
RUTLAND COUNTY	DANBY	TH-1	SOUTH MAIN ST	PAVE	0.02	211
RUTLAND COUNTY	DANBY	TH-1	DANBY-PAWLET RD	PAVE	4.23	44,669
RUTLAND COUNTY	DANBY	TH-1	MT TABOR AVE	PAVE	0.10	1,056
RUTLAND COUNTY	DANBY	TH-2	TINMOUTH RD	PAVE	3.23	34,109
RUTLAND COUNTY	DANBY	TH-3	SCOTTSVILLE RD	PAVE	0.75	7,920
RUTLAND COUNTY	FAIR HAVEN	TH-4	AIRPORT RD	PAVE	0.02	211
RUTLAND COUNTY	FAIR HAVEN	TH-4	FOURTH ST	PAVE	0.62	6,547
RUTLAND COUNTY	FAIR HAVEN	TH-5	SCOTCH HILL RD	PAVE	3.41	36,010
RUTLAND COUNTY	FAIR HAVEN	TH-6	WEST ST	PAVE	1.27	13,411
RUTLAND COUNTY SHEET 1 TOTAL					95.77	1,011,331

PROJECT NAME: STATEWIDE	
PROJECT NUMBER: HES MARK(404)	
FILE NAME: +14+186.dgn	PLOT DATE: 1/29/2015
PROJECT LEADER: P. COBURN	DRAWN BY: K. RECORD
DESIGNED BY: K. SWEET	CHECKED BY: I. DEGUTIS
CLASS 2 TOWN HIGHWAY QUANTITIES 26	SHEET 30 OF 56

SUMMARY BY COUNTY OF CLASS 2 TOWN HIGHWAYS

COUNTY	TOWN	TH NUMBER	TH NAME	SURFACE	MILEAGE	LINEAR FT
RUTLAND COUNTY	FAIR HAVEN	TH-7	BOLGER RD	PAVE	1.27	13,411
RUTLAND COUNTY	FAIR HAVEN	TH-9	SWAMP RD	PAVE	0.15	1,584
RUTLAND COUNTY	HUBBARDTON	TH-1	HORTONIA RD	PAVE	4.00	42,240
RUTLAND COUNTY	HUBBARDTON	TH-1	ROUTE 144	PAVE	0.40	4,224
RUTLAND COUNTY	HUBBARDTON	TH-2	MONUMENT HILL RD	PAVE	6.90	72,864
RUTLAND COUNTY	HUBBARDTON	TH-3	ROUTE 144	PAVE	0.52	5,491
RUTLAND COUNTY	HUBBARDTON	TH-4	HIGH POND RD	PAVE	0.20	2,112
RUTLAND COUNTY	MENDON	TH-1	MEADOW LAKE DR	PAVE	1.13	11,933
RUTLAND COUNTY	MENDON	TH-2	TOWN LINE RD	PAVE	0.88	9,293
RUTLAND COUNTY	MENDON	TH-2	NOTCH RD	PAVE	1.51	15,946
RUTLAND COUNTY	MENDON	TH-3	PARK LANE	PAVE	0.47	4,963
RUTLAND COUNTY	MIDDLETOWN SPRINGS	TH-1	WEST ST	PAVE	3.20	33,792
RUTLAND COUNTY	MOUNT HOLLY	TH-1	BELMONT RD	PAVE	2.41	25,450
RUTLAND COUNTY	MOUNT HOLLY	TH-1	HORTONVILLE RD	PAVE	3.28	34,637
RUTLAND COUNTY	MOUNT HOLLY	TH-1	TARBELLVILLE RD	PAVE	1.09	11,510
RUTLAND COUNTY	MOUNT HOLLY	TH-2	CHURCH ST	PAVE	0.17	1,795
RUTLAND COUNTY	MOUNT HOLLY	TH-2	HEALDVILLE RD	PAVE	3.66	38,650
RUTLAND COUNTY	MOUNT TABOR	TH-1	BROOKLYN RD	PAVE	0.79	8,342
RUTLAND COUNTY	MOUNT TABOR	TH-1	MT TABOR AVE	PAVE	0.06	634
RUTLAND COUNTY	MOUNT TABOR	TH-2	SOUTH END RD	PAVE	1.17	12,355
RUTLAND COUNTY	PAWLET	TH-1	ROUTE 153	PAVE	6.06	63,994
RUTLAND COUNTY	PAWLET	TH-2	BUTTONS FALLS RD	PAVE	1.72	18,163
RUTLAND COUNTY	PAWLET	TH-3	RIVER RD	PAVE	1.61	17,002
RUTLAND COUNTY	PAWLET	TH-4	DANBY-PAWLET RD	PAVE	1.66	17,530
RUTLAND COUNTY	PAWLET	TH-5	NORTH PAWLET RD	PAVE	1.76	18,586
RUTLAND COUNTY	PITTSFORD	TH-1	WEST CREEK RD	PAVE	5.49	57,974
RUTLAND COUNTY	PITTSFORD	TH-2	KENDALL HILL RD	PAVE	0.98	10,349
RUTLAND COUNTY	PITTSFORD	TH-3	FURNACE RD	PAVE	2.80	29,568
RUTLAND COUNTY	PITTSFORD	TH-4	CHITTENDEN RD	PAVE	0.60	6,336
RUTLAND COUNTY	PITTSFORD	TH-5	ARCH ST	PAVE	0.90	9,504
RUTLAND COUNTY	PITTSFORD	TH-6	CORN HILL RD	PAVE	2.10	22,176
RUTLAND COUNTY	PITTSFORD	TH-7	MEADOW LAKE DR	PAVE	0.18	1,901
RUTLAND COUNTY	PITTSFORD	TH-8	WHIPPLE HOLLOW RD	PAVE	4.02	42,451
RUTLAND COUNTY	POULTNEY	TH-2	EAST MAIN ST	PAVE	1.14	12,038
RUTLAND COUNTY	POULTNEY	TH-2	ROUTE 140	PAVE	3.38	35,693
RUTLAND COUNTY	POULTNEY	TH-3	COLLEGE ST NORTH	PAVE	0.41	4,330
RUTLAND COUNTY	POULTNEY	TH3	EAST MAIN ST	PAVE	0.45	4,752
RUTLAND COUNTY	POULTNEY	TH-3	MAIN ST	PAVE	0.35	3,696
RUTLAND COUNTY	POULTNEY	TH-3	YORK ST	PAVE	0.36	3,802
RUTLAND COUNTY	POULTNEY	TH-4	BENTLEY AVE	PAVE	0.04	422
RUTLAND COUNTY	POULTNEY	TH-4	COLLEGE ST SOUTH	PAVE	0.12	1,267
RUTLAND COUNTY	POULTNEY	TH-4	GRANVILLE ST	PAVE	0.67	7,075
RUTLAND COUNTY	POULTNEY	TH-5	YORK ST	PAVE	0.37	3,907
RUTLAND COUNTY	POULTNEY	TH-5	YORK ST EXT.	PAVE	3.16	33,370
RUTLAND COUNTY SHEET 2 TOTAL					73.59	777,110

PROJECT NAME: STATEWIDE	
PROJECT NUMBER: HES MARK(404)	
FILE NAME: +14+186.dgn	PLOT DATE: 1/29/2015
PROJECT LEADER: P. COBURN	DRAWN BY: K. RECORD
DESIGNED BY: K. SWEET	CHECKED BY: I. DEGUTIS
CLASS 2 TOWN HIGHWAY QUANTITIES 27	SHEET 31 OF 56

SUMMARY BY COUNTY OF CLASS 2 TOWN HIGHWAYS

COUNTY	TOWN	TH NUMBER	TH NAME	SURFACE	MILEAGE	LINEAR FT
RUTLAND COUNTY	POULTNEY	TH-6	THRALL RD	PAVE	1.38	14,573
RUTLAND COUNTY	POULTNEY	TH-6	DEPOT ST	PAVE	0.11	1,162
RUTLAND COUNTY	POULTNEY	TH-6	ON THE GREEN	PAVE	0.19	2,006
RUTLAND COUNTY	POULTNEY	TH-7	BENTLEY AVE	PAVE	0.39	4,118
RUTLAND COUNTY	POULTNEY	TH-7	SALTIS RD	PAVE	0.91	9,610
RUTLAND COUNTY	POULTNEY	TH-8	BLISSVILLE RD	PAVE	1.75	18,480
RUTLAND COUNTY	POULTNEY	TH-8	CHURCH ST	PAVE	0.35	3,696
RUTLAND COUNTY	PROCTOR	TH-2	CROSS ST	PAVE	0.14	1,478
RUTLAND COUNTY	PROCTOR	TH-2	FLORENCE RD	PAVE	2.52	26,611
RUTLAND COUNTY	PROCTOR	TH-2	NORTH ST	PAVE	0.30	3,168
RUTLAND COUNTY	PROCTOR	TH-2	SCHOOL ST	PAVE	0.14	1,478
RUTLAND COUNTY	PROCTOR	TH-2	WEST ST	PAVE	3.50	36,960
RUTLAND COUNTY	PROCTOR	TH-3	MAIN ST	PAVE	0.47	4,963
RUTLAND COUNTY	RUTLAND CITY	TH-3	STRONGS AVE	PAVE	0.61	6,442
RUTLAND COUNTY	RUTLAND CITY	TH-3	MERCHANTS ROW	PAVE	0.17	1,795
RUTLAND COUNTY	RUTLAND CITY	TH-4	WEST ST	PAVE	0.76	8,026
RUTLAND COUNTY	RUTLAND CITY	TH-5	FIELD AVE	PAVE	0.53	5,597
RUTLAND COUNTY	RUTLAND CITY	TH-6	GROVE ST	PAVE	1.47	15,523
RUTLAND COUNTY	RUTLAND CITY	TH-7	PIERPOINT AVE	PAVE	0.25	2,640
RUTLAND COUNTY	RUTLAND CITY	TH-7	CRESCENT AVE	PAVE	0.91	9,610
RUTLAND COUNTY	RUTLAND CITY	TH-7	FAIRVIEW AVE	PAVE	0.15	1,584
RUTLAND COUNTY	RUTLAND CITY	TH-8	MADISON ST	PAVE	0.23	2,429
RUTLAND COUNTY	RUTLAND CITY	TH-8	RIVER ST	PAVE	0.86	9,082
RUTLAND COUNTY	RUTLAND CITY	TH-9	ALLEN ST	PAVE	0.77	8,131
RUTLAND COUNTY	RUTLAND CITY	TH-9	STRATTON RD	PAVE	1.33	14,045
RUTLAND COUNTY	RUTLAND CITY	TH-10	DORR DR	PAVE	1.54	16,262
RUTLAND COUNTY	RUTLAND CITY	TH-10	RIPLEY RD	PAVE	0.20	2,112
RUTLAND COUNTY	RUTLAND CITY	TH-11	KILLINGTON AVE	PAVE	1.37	14,467
RUTLAND COUNTY	RUTLAND CITY	TH-12	PARK ST	PAVE	0.75	7,920
RUTLAND COUNTY	RUTLAND CITY	TH-13	PINE ST	PAVE	0.14	1,478
RUTLAND COUNTY	RUTLAND CITY	TH-13	FOREST ST	PAVE	0.93	9,821
RUTLAND COUNTY	RUTLAND CITY	TH-14	EAST ST	PAVE	0.61	6,442
RUTLAND COUNTY	RUTLAND CITY	TH-14	JACKSON AVE	PAVE	0.20	2,112
RUTLAND COUNTY	RUTLAND TOWN	TH-1	EAST PITTSFORD RD	PAVE	3.23	34,109
RUTLAND COUNTY	RUTLAND TOWN	TH-2	CREEK RD	PAVE	1.04	10,982
RUTLAND COUNTY	RUTLAND TOWN	TH-3	MIDDLE RD	PAVE	0.32	3,379
RUTLAND COUNTY	RUTLAND TOWN	TH-4	NORTH GROVE ST	PAVE	2.75	29,040
RUTLAND COUNTY	RUTLAND TOWN	TH-5	COLD RIVER RD	PAVE	1.78	18,797
RUTLAND COUNTY	RUTLAND TOWN	TH-6	WEST PROCTOR RD	PAVE	0.88	9,293
RUTLAND COUNTY	RUTLAND TOWN	TH-7	MEADOW LAKE DR	PAVE	0.43	4,541
RUTLAND COUNTY	RUTLAND TOWN	TH-8	TOWN LINE RD	PAVE	0.92	9,715
RUTLAND COUNTY	RUTLAND TOWN	TH-9	POST RD	PAVE	1.38	14,573
RUTLAND COUNTY	RUTLAND TOWN	TH-9	POST RD EXT	PAVE	0.30	3,168
RUTLAND COUNTY	RUTLAND TOWN	TH-9	PARK LANE	PAVE	0.48	5,069
RUTLAND COUNTY SHEET 3 TOTAL					39.44	416,486

PROJECT NAME: STATEWIDE	
PROJECT NUMBER: HES MARK(404)	
FILE NAME: +14+186.dgn	PLOT DATE: 1/29/2015
PROJECT LEADER: P. COBURN	DRAWN BY: K. RECORD
DESIGNED BY: K. SWEET	CHECKED BY: I. DEGUTIS
CLASS 2 TOWN HIGHWAY QUANTITIES 28	SHEET 32 OF 56

SUMMARY BY COUNTY OF CLASS 2 TOWN HIGHWAYS

COUNTY	TOWN	TH NUMBER	TH NAME	SURFACE	MILEAGE	LINEAR FT
RUTLAND COUNTY	RUTLAND TOWN	TH-10	KILLINGTON AVE	PAVE	0.47	4,963
RUTLAND COUNTY	RUTLAND TOWN	TH-11	MCKINLEY AVE	PAVE	1.10	11,616
RUTLAND COUNTY	KILLINGTON	TH-1	RIVER RD	PAVE	1.32	13,939
RUTLAND COUNTY	KILLINGTON	TH-1	RIVER RD FORK	PAVE	0.04	422
RUTLAND COUNTY	KILLINGTON	TH-2	KILLINGTON RD	PAVE	2.97	31,363
RUTLAND COUNTY	KILLINGTON	TH-3	WEST HILL RD	PAVE	0.72	7,603
RUTLAND COUNTY	SHREWSBURY	TH-1	COLD RIVER RD	PAVE	6.69	70,646
RUTLAND COUNTY	SHREWSBURY	TH-2	LINCOLN HILL RD	PAVE	0.34	3,590
RUTLAND COUNTY	SHREWSBURY	TH-2	TOWN HILL RD	PAVE	1.74	18,374
RUTLAND COUNTY	SHREWSBURY	TH-2	NORTHAM RD	PAVE	2.64	27,878
RUTLAND COUNTY	SHREWSBURY	TH-3	EASTHAM RD	PAVE	1.29	13,622
RUTLAND COUNTY	SHREWSBURY	TH-3	MOUNT HOLLEY RD	PAVE	0.80	8,448
RUTLAND COUNTY	SHREWSBURY	TH-4	LINCOLN HILL RD	PAVE	2.23	23,549
RUTLAND COUNTY	SUDBURY	TH-1	BURR POND RD	PAVE	3.46	36,538
RUTLAND COUNTY	SUDBURY	TH-2	LAKE HORTONIA RD	PAVE	1.75	18,480
RUTLAND COUNTY	SUDBURY	TH-4	SAWYER-NEEDHAM RD	PAVE	1.30	13,728
RUTLAND COUNTY	TINMOUTH	TH-1	MOUNTAIN VIEW RD	PAVE	3.55	37,488
RUTLAND COUNTY	TINMOUTH	TH-1	ROUTE 140	PAVE	5.91	62,410
RUTLAND COUNTY	TINMOUTH	TH-2	EAST RD	PAVE	3.46	36,538
RUTLAND COUNTY	TINMOUTH	TH-5	EAST WELLS RD	PAVE	0.06	634
RUTLAND COUNTY	WALLINGFORD	TH-1	DEPOT ST	PAVE	0.16	1,690
RUTLAND COUNTY	WALLINGFORD	TH-1	ROUTE 140	PAVE	2.26	23,866
RUTLAND COUNTY	WALLINGFORD	TH-2	CREEK RD	PAVE	1.34	14,150
RUTLAND COUNTY	WALLINGFORD	TH-2	MAPLE ST	PAVE	0.13	1,373
RUTLAND COUNTY	WELLS	TH-1	EAST WELLS RD	PAVE	4.59	48,470
RUTLAND COUNTY	WELLS	TH-2	NORTH ST	PAVE	1.94	20,486
RUTLAND COUNTY	WELLS	TH-2	WEST LAKE RD	PAVE	1.38	14,573
RUTLAND COUNTY	WELLS	TH-2	SOUTH ST	PAVE	0.75	7,920
RUTLAND COUNTY	WELLS	TH-2	BULL FROG HOLLOW RD	PAVE	0.35	3,696
RUTLAND COUNTY	WELLS	TH-3	WEST LAKE RD	PAVE	0.26	2,746
RUTLAND COUNTY	WEST HAVEN	TH-1	MAIN ST	PAVE	2.03	21,437
RUTLAND COUNTY	WEST HAVEN	TH-1	STAGE RD	PAVE	0.17	1,795
RUTLAND COUNTY	WEST HAVEN	TH-2	MAIN ST	PAVE	3.91	41,290
RUTLAND COUNTY	WEST HAVEN	TH-3	BOOK RD	PAVE	2.18	23,021
RUTLAND COUNTY	WEST RUTLAND	TH-3	WHIPPLE HOLLOW RD	PAVE	2.42	25,555
RUTLAND COUNTY	WEST RUTLAND	TH-3	MARBLE ST	PAVE	1.13	11,933
RUTLAND COUNTY	WEST RUTLAND	TH-4	WHIPPLE HOLLOW RD	PAVE	1.90	20,064
RUTLAND COUNTY SHEET 4 TOTAL					68.74	725,894
RUTLAND COUNTY SHEET 1 TOTAL					95.77	1,011,331
RUTLAND COUNTY SHEET 2 TOTAL					73.59	777,110
RUTLAND COUNTY SHEET 3 TOTAL					39.44	416,486
RUTLAND COUNTY SHEET 4 TOTAL					68.74	725,894
RUTLAND COUNTY TOTALS					277.54	2,930,822

PROJECT NAME:	STATEWIDE
PROJECT NUMBER:	HES MARK(404)
FILE NAME: +14+186.dgn	PLOT DATE: 1/29/2015
PROJECT LEADER: P. COBURN	DRAWN BY: K. RECORD
DESIGNED BY: K. SWEET	CHECKED BY: I. DEGUTIS
CLASS 2 TOWN HIGHWAY QUANTITIES 29	SHEET 33 OF 56

SUMMARY BY COUNTY OF CLASS 2 TOWN HIGHWAYS

COUNTY	TOWN	TH NUMBER	TH NAME	SURFACE	MILEAGE	LINEAR FT
WASHINGTON COUNTY	BARRE CITY	TH-4	MERCHANT ST	PAVE	0.76	8,026
WASHINGTON COUNTY	BARRE CITY	TH-5	HILL ST	PAVE	0.81	8,554
WASHINGTON COUNTY	BARRE CITY	TH-6	QUARRY HILL	PAVE	0.27	2,851
WASHINGTON COUNTY	BARRE CITY	TH-7	PROSPECT ST	PAVE	1.45	15,312
WASHINGTON COUNTY	BARRE CITY	TH-8	BERLIN ST	PAVE	0.71	7,498
WASHINGTON COUNTY	BARRE TOWN	TH-1	COGSWELL ST	PAVE	0.20	2,112
WASHINGTON COUNTY	BARRE TOWN	TH-1	GRANITEVILLE RD	PAVE	2.54	26,822
WASHINGTON COUNTY	BARRE TOWN	TH-1	QUARRY HILL	PAVE	1.11	11,722
WASHINGTON COUNTY	BARRE TOWN	TH-2	MILL ST	PAVE	0.16	1,690
WASHINGTON COUNTY	BARRE TOWN	TH-2	WEBSTERVILLE RD	PAVE	2.50	26,400
WASHINGTON COUNTY	BARRE TOWN	TH-3	CHURCH HILL RD	PAVE	1.27	13,411
WASHINGTON COUNTY	BARRE TOWN	TH-4	MIDDLE RD	PAVE	1.59	16,790
WASHINGTON COUNTY	BARRE TOWN	TH-5	PLAINFIELD BROOK RD	PAVE	1.58	16,685
WASHINGTON COUNTY	BARRE TOWN	TH-6	MILLER RD	PAVE	0.38	4,013
WASHINGTON COUNTY	BARRE TOWN	TH-6	UPPER PROSPECT ST	PAVE	0.25	2,640
WASHINGTON COUNTY	BARRE TOWN	TH-6	AIRPORT RD	PAVE	0.90	9,504
WASHINGTON COUNTY	BARRE TOWN	TH-7	BRIDGE ST	PAVE	0.65	6,864
WASHINGTON COUNTY	BARRE TOWN	TH-7	MORRISON RD	PAVE	0.80	8,448
WASHINGTON COUNTY	BARRE TOWN	TH-8	HILL ST	PAVE	0.28	2,957
WASHINGTON COUNTY	BARRE TOWN	TH-8	WINDY WOOD RD	PAVE	2.26	23,866
WASHINGTON COUNTY	BARRE TOWN	TH-8	CUMMINGS RD	PAVE	0.78	8,237
WASHINGTON COUNTY	BARRE TOWN	TH-9	MILLER RD	PAVE	1.56	16,474
WASHINGTON COUNTY	BARRE TOWN	TH-10	BAPTIST ST	PAVE	0.54	5,702
WASHINGTON COUNTY	BARRE TOWN	TH-12	FARWELL ST	PAVE	1.64	17,318
WASHINGTON COUNTY	BERLIN	TH-1	CROSSTOWN RD	PAVE	0.38	4,013
WASHINGTON COUNTY	BERLIN	TH-1	PAINE TURNPIKE NORTH	PAVE	2.16	22,810
WASHINGTON COUNTY	BERLIN	TH-2	JUNCTION RD	PAVE	0.55	5,808
WASHINGTON COUNTY	BERLIN	TH-3	COXBROOK RD	PAVE	0.87	9,187
WASHINGTON COUNTY	BERLIN	TH-4	AIRPORT RD	PAVE	1.39	14,678
WASHINGTON COUNTY	BERLIN	TH-5	SCOTT HILL RD	PAVE	1.98	20,909
WASHINGTON COUNTY	BERLIN	TH-6	FISCHER RD	PAVE	0.52	5,491
WASHINGTON COUNTY	CABOT	TH-1	ROUTE 215 SOUTH	PAVE	2.40	25,344
WASHINGTON COUNTY	CABOT	TH-1	ROUTE 215 NORTH	PAVE	3.35	35,376
WASHINGTON COUNTY	CABOT	TH-1	MAIN ST	PAVE	1.06	11,194
WASHINGTON COUNTY	CABOT	TH-2	SOUTH WALDEN RD	PAVE	3.85	40,656
WASHINGTON COUNTY	CALAIS	TH-1	COUNTY RD	PAVE	3.12	32,947
WASHINGTON COUNTY	CALAIS	TH-4	MARSHFIELD RD	PAVE	0.45	4,752
WASHINGTON COUNTY	CALAIS	TH-5	MOSCOW WOODS RD	PAVE	0.10	1,056
WASHINGTON COUNTY	CALAIS	TH-7	LIGHTING RODGE RD	PAVE	0.33	3,485
WASHINGTON COUNTY SHEET 1 TOTAL					47.50	501,600

PROJECT NAME: STATEWIDE	
PROJECT NUMBER: HES MARK(404)	
FILE NAME: +14+186.dgn	PLOT DATE: 1/29/2015
PROJECT LEADER: P. COBURN	DRAWN BY: K. RECORD
DESIGNED BY: K. SWEET	CHECKED BY: I. DEGUTIS
CLASS 2 TOWN HIGHWAY QUANTITIES 30	SHEET 34 OF 56

SUMMARY BY COUNTY OF CLASS 2 TOWN HIGHWAYS

COUNTY	TOWN	TH NUMBER	TH NAME	SURFACE	MILEAGE	LINEAR FT
WASHINGTON COUNTY	DUXBURY	TH-1	MAIN ST	PAVE	0.24	2,534
WASHINGTON COUNTY	DUXBURY	TH-1	RIVER RD	PAVE	1.29	13,622
WASHINGTON COUNTY	DUXBURY	TH-2	WINOOSKI ST	PAVE	0.03	317
WASHINGTON COUNTY	EAST MONTPELIER	TH-1	COUNTY RD	PAVE	4.83	51,005
WASHINGTON COUNTY	EAST MONTPELIER	TH-2	TOWNE HILL RD	PAVE	2.39	25,238
WASHINGTON COUNTY	EAST MONTPELIER	TH-3	CENTER RD	PAVE	1.67	17,635
WASHINGTON COUNTY	EAST MONTPELIER	TH-5	GALLISON HILL RD	PAVE	0.70	7,392
WASHINGTON COUNTY	FAYSTON	TH-1	NORTH FAYSTON RD	PAVE	2.36	24,922
WASHINGTON COUNTY	FAYSTON	TH-2	GERMAN FLATS RD	PAVE	2.60	27,456
WASHINGTON COUNTY	FAYSTON	TH-3	MT ELLEN RD	PAVE	0.63	6,653
WASHINGTON COUNTY	MARSHFIELD	TH-1	CABOT RD	PAVE	1.40	14,784
WASHINGTON COUNTY	MARSHFIELD	TH-2	CREAMERY ST	PAVE	0.55	5,808
WASHINGTON COUNTY	MARSHFIELD	TH-3	NAISMITH BROOK RD	PAVE	0.14	1,478
WASHINGTON COUNTY	MARSHFIELD	TH-4	HOLLISTER HILL RD	PAVE	0.16	1,690
WASHINGTON COUNTY	MIDDLESEX	TH-1	THREE MILE BRIDGE RD	PAVE	0.95	10,032
WASHINGTON COUNTY	MIDDLESEX	TH-2	SHADY HILL RD	PAVE	2.94	31,046
WASHINGTON COUNTY	MIDDLESEX	TH-2	MOLLY SUPPLE RD	PAVE	0.27	2,851
WASHINGTON COUNTY	MIDDLESEX	TH-2	CENTER RD	PAVE	1.15	12,144
WASHINGTON COUNTY	MONTPELIER	TH-8	MAIN ST	PAVE	1.64	17,318
WASHINGTON COUNTY	MONTPELIER	TH-9	TAYLOR ST	PAVE	0.12	1,267
WASHINGTON COUNTY	MONTPELIER	TH-10	PIONEER ST	PAVE	0.10	1,056
WASHINGTON COUNTY	MONTPELIER	TH-10	BARRE ST	PAVE	1.11	11,722
WASHINGTON COUNTY	MONTPELIER	TH-11	BERLIN ST	PAVE	1.10	11,616
WASHINGTON COUNTY	MONTPELIER	TH-12	BAILEY AVE	PAVE	0.12	1,267
WASHINGTON COUNTY	MONTPELIER	TH-12	TERRACE ST	PAVE	1.56	16,474
WASHINGTON COUNTY	MONTPELIER	TH-13	TOWNE HILL RD	PAVE	1.06	11,194
WASHINGTON COUNTY	MONTPELIER	TH-14	GRAVES ST	PAVE	0.19	2,006
WASHINGTON COUNTY	MONTPELIER	TH-15	ELM ST	PAVE	0.33	3,485
WASHINGTON COUNTY	MONTPELIER	TH-16	GALLISON HILL RD	PAVE	0.91	9,610
WASHINGTON COUNTY	MORETOWN	TH-1	MORETOWN MTN RD	PAVE	0.15	1,584
WASHINGTON COUNTY	MORETOWN	TH-2	RIVER RD	PAVE	0.50	5,280
WASHINGTON COUNTY	NORTHFIELD	TH-3	COX BROOK RD	PAVE	1.35	14,256
WASHINGTON COUNTY	NORTHFIELD	TH-4	BERLIN POND RD	PAVE	0.77	8,131
WASHINGTON COUNTY	NORTHFIELD	TH-5	LOVERS LANE	PAVE	0.12	1,267
WASHINGTON COUNTY	PLAINFIELD	TH-1	BARRE HILL	PAVE	0.49	5,174
WASHINGTON COUNTY	PLAINFIELD	TH-1	MIDDLE RD	PAVE	0.14	1,478
WASHINGTON COUNTY	PLAINFIELD	TH-1	MILL ST	PAVE	0.15	1,584
WASHINGTON COUNTY	PLAINFIELD	TH-2	BROOK RD	PAVE	1.40	14,784
WASHINGTON COUNTY	PLAINFIELD	TH-3	MAIN ST	PAVE	0.21	2,218
WASHINGTON COUNTY SHEET 2 TOTAL					37.82	399,379

PROJECT NAME: STATEWIDE	
PROJECT NUMBER: HES MARK(404)	
FILE NAME: t14t186.dgn	PLOT DATE: 1/29/2015
PROJECT LEADER: P. COBURN	DRAWN BY: K. RECORD
DESIGNED BY: K. SWEET	CHECKED BY: I. DEGUTIS
CLASS 2 TOWN HIGHWAY QUANTITIES 31	SHEET 35 OF 56

SUMMARY BY COUNTY OF CLASS 2 TOWN HIGHWAYS

COUNTY	TOWN	TH NUMBER	TH NAME	SURFACE	MILEAGE	LINEAR FT
WASHINGTON COUNTY	ROXBURY	TH-1	WARREN MTN RD	PAVE	1.73	18,269
WASHINGTON COUNTY	WAITSFIELD	TH-1	BRIDGE ST	PAVE	0.43	4,541
WASHINGTON COUNTY	WAITSFIELD	TH-1	EAST WARREN RD	PAVE	3.62	38,227
WASHINGTON COUNTY	WAITSFIELD	TH-2	NORTH FAYSTON RD	PAVE	0.70	7,392
WASHINGTON COUNTY	WAITSFIELD	TH-3	JOSLIN HILL RD	PAVE	1.30	13,728
WASHINGTON COUNTY	WAITSFIELD	TH-3	NORTH RD	PAVE	0.90	9,504
WASHINGTON COUNTY	WARREN	TH-1	BROOK RD	PAVE	2.36	24,922
WASHINGTON COUNTY	WARREN	TH-1	ROXBURY MTN RD	PAVE	1.68	17,741
WASHINGTON COUNTY	WARREN	TH-2	EAST WARREN RD	PAVE	2.17	22,915
WASHINGTON COUNTY	WARREN	TH-3	COVERED BRIDGE RD	PAVE	0.08	845
WASHINGTON COUNTY	WARREN	TH-3	LINCOLN GAP RD	PAVE	2.68	28,301
WASHINGTON COUNTY	WARREN	TH-4	MAIN ST	PAVE	1.00	10,560
WASHINGTON COUNTY	WARREN	TH-5	SUGARBUSH ACCESS RD	PAVE	3.04	32,102
WASHINGTON COUNTY	WARREN	TH-6	GERMAN FLATS RD	PAVE	1.00	10,560
WASHINGTON COUNTY	WARREN	TH-7	PLUNKTON RD	PAVE	1.20	12,672
WASHINGTON COUNTY	WATERBURY	TH-1	GUPTIL HILL RD	PAVE	2.10	22,176
WASHINGTON COUNTY	WATERBURY	TH-1	HOWARD AVE	PAVE	0.39	4,118
WASHINGTON COUNTY	WATERBURY	TH-2	BLUSH HILL RD	PAVE	1.43	15,101
WASHINGTON COUNTY	WATERBURY	TH-2	STOWE ST	PAVE	0.77	8,131
WASHINGTON COUNTY	WATERBURY	TH-3	UNION ST	PAVE	0.26	2,746
WASHINGTON COUNTY	WATERBURY	TH-3	MAPLE ST	PAVE	1.44	15,206
WASHINGTON COUNTY	WATERBURY	TH-3	BARNES HILL RD	PAVE	0.66	6,970
WASHINGTON COUNTY	WATERBURY	TH-4	WINOOSKI ST	PAVE	0.36	3,802
WASHINGTON COUNTY	WATERBURY	TH-5	PARK ROW	PAVE	0.11	1,162
WASHINGTON COUNTY	WOODBURY	TH-1	FOSTER HILL RD	PAVE	0.30	3,168
WASHINGTON COUNTY	WOODBURY	TH-2	CABOT RD	PAVE	0.38	4,013
WASHINGTON COUNTY	WORCESTER	TH-1	CALAIS RD	PAVE	1.80	19,008
WASHINGTON COUNTY	WORCESTER	TH-2	MINISTER BROOK RD	PAVE	1.37	14,467
WASHINGTON COUNTY SHEET 3 TOTAL					35.26	372,346
WASHINGTON COUNTY SHEET 1 TOTAL						47.50
WASHINGTON COUNTY SHEET 2 TOTAL						37.82
WASHINGTON COUNTY SHEET 3 TOTAL						35.26
WASHINGTON COUNTY TOTALS					120.58	1,273,325

PROJECT NAME: STATEWIDE	
PROJECT NUMBER: HES MARK(404)	
FILE NAME: +14+186.dgn	PLOT DATE: 1/29/2015
PROJECT LEADER: P. COBURN	DRAWN BY: K. RECORD
DESIGNED BY: K. SWEET	CHECKED BY: I. DEGUTIS
CLASS 2 TOWN HIGHWAY QUANTITIES 32	SHEET 36 OF 56

SUMMARY BY COUNTY OF CLASS 2 TOWN HIGHWAYS

COUNTY	TOWN	TH NUMBER	TH NAME	SURFACE	MILEAGE	LINEAR FT
WINDHAM COUNTY	ATHENS	TH-1	ROUTE 35	PAVE	4.13	43,613
WINDHAM COUNTY	ATHENS	TH-2	BROOKLINE RD	PAVE	1.43	15,101
WINDHAM COUNTY	BRATTLEBORO	TH-5	UPPER DUMERSTON RD	PAVE	2.85	30,096
WINDHAM COUNTY	BRATTLEBORO	TH-6	GREENLEAF ST	PAVE	0.75	7,920
WINDHAM COUNTY	BRATTLEBORO	TH-6	HINESBURG RD	PAVE	3.05	32,208
WINDHAM COUNTY	BRATTLEBORO	TH-7	BRIDGE ST	PAVE	0.08	845
WINDHAM COUNTY	BRATTLEBORO	TH-9	OLD GUILFORD RD	PAVE	0.89	9,398
WINDHAM COUNTY	BRATTLEBORO	TH-9	SOUTH MAIN ST	PAVE	1.17	12,355
WINDHAM COUNTY	BRATTLEBORO	TH-10	GUILFORD ST	PAVE	0.47	4,963
WINDHAM COUNTY	BRATTLEBORO	TH-10	MAPLE ST	PAVE	0.70	7,392
WINDHAM COUNTY	BRATTLEBORO	TH-10	FAIRVIEW ST	PAVE	0.50	5,280
WINDHAM COUNTY	BRATTLEBORO	TH-11	ELM ST	PAVE	0.23	2,429
WINDHAM COUNTY	BRATTLEBORO	TH-11	ELLIOT ST	PAVE	0.17	1,795
WINDHAM COUNTY	BROOKLINE	TH-1	GRASSY BROOK RD	PAVE	4.95	52,272
WINDHAM COUNTY	DOVER	TH-1	DOVER HILL RD	PAVE	4.25	44,880
WINDHAM COUNTY	DOVER	TH-1	EAST DOVER RD	PAVE	0.12	1,267
WINDHAM COUNTY	DOVER	TH-2	HANDLE RD	PAVE	2.00	21,120
WINDHAM COUNTY	DOVER	TH-3	HANDLE RD	PAVE	0.79	8,342
WINDHAM COUNTY	DOVER	TH-3	SOUTH ACCES RD	PAVE	0.23	2,429
WINDHAM COUNTY	DOVER	TH-3	TANNERY RD	PAVE	0.52	5,491
WINDHAM COUNTY	DOVER	TH-4	DORR FITCH RD	PAVE	1.38	14,573
WINDHAM COUNTY	DOVER	TH-5	NORTH ACESS RD	PAVE	0.07	739
WINDHAM COUNTY	DOVER	TH-5	UPPER HANDLE RD	PAVE	0.34	3,590
WINDHAM COUNTY	DOVER	TH-5	HANDLE RD	PAVE	0.52	5,491
WINDHAM COUNTY	DUMMERSTON	TH-1	EAST-WEST RD	PAVE	4.43	46,781
WINDHAM COUNTY	DUMMERSTON	TH-1	BRIDGE	PAVE	0.06	634
WINDHAM COUNTY	DUMMERSTON	TH-2	BUNKER RD	PAVE	0.37	3,907
WINDHAM COUNTY	DUMMERSTON	TH-2	MIDDLE RD	PAVE	3.20	33,792
WINDHAM COUNTY	DUMMERSTON	TH-3	SCHOOL HOUSE RD	PAVE	0.88	9,293
WINDHAM COUNTY	DUMMERSTON	TH-4	UPPER DUMMERSTON RD	PAVE	0.80	8,448
WINDHAM COUNTY	DUMMERSTON	TH-5	WILLIAMSVILLE RD	PAVE	0.06	634
WINDHAM COUNTY	DUMMERSTON	TH-6	HOUGHTON BROOK RD	PAVE	0.39	4,118
WINDHAM COUNTY	DUMMERSTON	TH-6	JOHNSONS CURVE RD	PAVE	0.27	2,851
WINDHAM COUNTY	GRAFTON	TH-1	MAIN ST	PAVE	0.21	2,218
WINDHAM COUNTY	GRAFTON	TH-1	ROUTE 121 EAST	PAVE	4.07	42,979
WINDHAM COUNTY	GRAFTON	TH-1	HOUGHTONVILLE RD	PAVE	1.92	20,275
WINDHAM COUNTY	GRAFTON	TH-2	TOWNSEND RD	PAVE	3.73	39,389
WINDHAM COUNTY	GRAFTON	TH-3	CHESTER RD	PAVE	4.54	47,942
WINDHAM COUNTY	GRAFTON	TH-4	ATHENS RD	PAVE	0.26	2,746
WINDHAM COUNTY	GUILFORD	TH-1	GUILFORD CENTER RD	PAVE	4.72	49,843
WINDHAM COUNTY	GUILFORD	TH-2	HINESBURG RD	PAVE	2.37	25,027
WINDHAM COUNTY	GUILFORD	TH-3	TYLER HILL RD	PAVE	0.21	2,218
WINDHAM COUNTY	GUILFORD	TH-4	WEATHERHEAD HOLLOW RD	PAVE	4.74	50,054
WINDHAM COUNTY SHEET 1 TOTAL					68.82	726,739

PROJECT NAME: STATEWIDE	
PROJECT NUMBER: HES MARK(404)	
FILE NAME: +14+186.dgn	PLOT DATE: 1/29/2015
PROJECT LEADER: P. COBURN	DRAWN BY: K. RECORD
DESIGNED BY: K. SWEET	CHECKED BY: I. DEGUTIS
CLASS 2 TOWN HIGHWAY QUANTITIES 33	SHEET 37 OF 56

SUMMARY BY COUNTY OF CLASS 2 TOWN HIGHWAYS

COUNTY	TOWN	TH NUMBER	TH NAME	SURFACE	MILEAGE	LINEAR FT
WINDHAM COUNTY	HALIFAX	TH-1	BROOK RD	PAVE	2.51	26,506
WINDHAM COUNTY	HALIFAX	TH-1	GREEN RIVER RD	PAVE	0.17	1,795
WINDHAM COUNTY	HALIFAX	TH-1	BRANCH RD	PAVE	2.22	23,443
WINDHAM COUNTY	HALIFAX	TH-2	JACKSONVILLE STAGE RD	PAVE	0.55	5,808
WINDHAM COUNTY	JAMAICA	TH-1	PIKES FALLS RD	PAVE	4.34	45,830
WINDHAM COUNTY	JAMAICA	TH-2	WINDHAM HILL RD	PAVE	0.44	4,646
WINDHAM COUNTY	LONDONDERRY	TH-1	LANDGROVE RD	PAVE	2.55	26,928
WINDHAM COUNTY	LONDONDERRY	TH-2	MAIN ST	PAVE	0.67	7,075
WINDHAM COUNTY	LONDONDERRY	TH-2	THOMPSONBURG RD	PAVE	2.53	26,717
WINDHAM COUNTY	LONDONDERRY	TH-3	ROUTE 121	PAVE	0.34	3,590
WINDHAM COUNTY	LONDONDERRY	TH-4	MAGIC MTN ACCESS RD	PAVE	0.47	4,963
WINDHAM COUNTY	LONDONDERRY	TH-5	MIDDLETOWN RD	PAVE	2.59	27,350
WINDHAM COUNTY	LONDONDERRY	TH-6	WINHALL HOLLOW RD	PAVE	3.02	31,891
WINDHAM COUNTY	LONDONDERRY	TH-59	OLD STONE WALL HILL RD	PAVE	0.43	4,541
WINDHAM COUNTY	MARLBORO	TH-1	AUGER HOLE RD	PAVE	1.68	17,741
WINDHAM COUNTY	MARLBORO	TH-2	HIGLEY HILL RD	PAVE	1.48	15,629
WINDHAM COUNTY	MARLBORO	TH-3	SOUTH RD	PAVE	2.71	28,618
WINDHAM COUNTY	NEWFANE	TH-1	COURT ST	PAVE	0.07	739
WINDHAM COUNTY	NEWFANE	TH-1	SOUTH WARDSBORO RD	PAVE	2.05	21,648
WINDHAM COUNTY	NEWFANE	TH-1	WEST ST	PAVE	0.25	2,640
WINDHAM COUNTY	NEWFANE	TH-2	DEPOT RD	PAVE	1.91	20,170
WINDHAM COUNTY	NEWFANE	TH-2	DOVER RD	PAVE	5.55	58,608
WINDHAM COUNTY	NEWFANE	TH-3	AUGER HOLE RD	PAVE	0.98	10,349
WINDHAM COUNTY	NEWFANE	TH-4	RADWAY HILL RD	PAVE	0.53	5,597
WINDHAM COUNTY	NEWFANE	TH-5	GRIMES HILL RD	PAVE	1.66	17,530
WINDHAM COUNTY	PUTNEY	TH-1	KIMBALL HILL	PAVE	0.30	3,168
WINDHAM COUNTY	PUTNEY	TH-1	WESTMINSTER RD	PAVE	3.18	33,581
WINDHAM COUNTY	PUTNEY	TH-2	WEST HILL	PAVE	3.43	36,221
WINDHAM COUNTY	PUTNEY	TH-3	RIVER RD SOUTH	PAVE	3.82	40,339
WINDHAM COUNTY	PUTNEY	TH-4	HOUGHTON BROOK RD	PAVE	0.42	4,435
WINDHAM COUNTY	ROCKINGHAM	TH-1	MAIN ST	PAVE	0.70	7,392
WINDHAM COUNTY	ROCKINGHAM	TH-1	SAXTONS RIVER RD	PAVE	4.49	47,414
WINDHAM COUNTY	ROCKINGHAM	TH-2	PLEASANT VALLEY RD	PAVE	4.67	49,315
WINDHAM COUNTY	ROCKINGHAM	TH-3	WESTMINSTER WEST RD	PAVE	1.00	10,560
WINDHAM COUNTY	ROCKINGHAM	TH-3	WESTMINSTER ST	PAVE	0.32	3,379
WINDHAM COUNTY	ROCKINGHAM	TH-4	BROCKAWAY MILLS RD	PAVE	2.74	28,934
WINDHAM COUNTY	ROCKINGHAM	TH-5	SAXTONS RIVER RD	PAVE	0.11	1,162
WINDHAM COUNTY	ROCKINGHAM	TH-5	OLD TERRACE	PAVE	0.25	2,640
WINDHAM COUNTY	ROCKINGHAM	TH-5	ROUTE 121	PAVE	0.61	6,442
WINDHAM COUNTY	ROCKINGHAM	TH-5	WESTMINSTER ST	PAVE	0.34	3,590
WINDHAM COUNTY	ROCKINGHAM	TH-6	BRIDGE ST	PAVE	0.29	3,062
WINDHAM COUNTY SHEET 2 TOTAL					68.37	721,987

PROJECT NAME: STATEWIDE	
PROJECT NUMBER: HES MARK(404)	
FILE NAME: +14+186.dgn	PLOT DATE: 1/29/2015
PROJECT LEADER: P. COBURN	DRAWN BY: K. RECORD
DESIGNED BY: K. SWEET	CHECKED BY: I. DEGUTIS
CLASS 2 TOWN HIGHWAY QUANTITIES 34	SHEET 38 OF 56

SUMMARY BY COUNTY OF CLASS 2 TOWN HIGHWAYS

COUNTY	TOWN	TH NUMBER	TH NAME	SURFACE	MILEAGE	LINEAR FT
WINDHAM COUNTY	STRATTON	TH-1	STRATTON-ARLINGTON RD	PAVE	5.00	52,800
WINDHAM COUNTY	STRATTON	TH-2	PIKE FALLS RD	PAVE	0.53	5,597
WINDHAM COUNTY	STRATTON	TH-2	STRATTON MTN ACCESS RD	PAVE	1.23	12,989
WINDHAM COUNTY	STRATTON	TH-2	BRAZERS WAY	PAVE	0.82	8,659
WINDHAM COUNTY	STRATTON	TH-3	WEST JAMAICA RD	PAVE	2.20	23,232
WINDHAM COUNTY	STRATTON	TH-3	MOUNTAIN RD	PAVE	4.46	47,098
WINDHAM COUNTY	TOWNSEND	TH-1	GRAFTON RD	PAVE	6.33	66,845
WINDHAM COUNTY	TOWNSEND	TH-2	ATHENS RD	PAVE	1.62	17,107
WINDHAM COUNTY	TOWNSEND	TH-3	WINDHAM HILL RD	PAVE	2.67	28,195
WINDHAM COUNTY	VERNON	TH-1	TYLER HILL RD	PAVE	2.15	22,704
WINDHAM COUNTY	VERNON	TH-2	POND RD	PAVE	3.89	41,078
WINDHAM COUNTY	VERNON	TH-3	HUCKLE HILL RD	PAVE	1.82	19,219
WINDHAM COUNTY	WARDSBORO	TH-1	STRATTON-ARLINGTON RD	PAVE	1.21	12,778
WINDHAM COUNTY	WARDSBORO	TH-2	SOUTH WARDSBORO RD	PAVE	3.01	31,786
WINDHAM COUNTY	WESTMINSTER	TH-1	ROUTE 121	PAVE	1.83	19,325
WINDHAM COUNTY	WESTMINSTER	TH-2	WESTMINSTER WEST RD	PAVE	7.90	83,424
WINDHAM COUNTY	WESTMINSTER	TH-3	SCHOOL ST	PAVE	0.52	5,491
WINDHAM COUNTY	WESTMINSTER	TH-3	WESTMINSTER HEIGHTS RD	PAVE	1.54	16,262
WINDHAM COUNTY	WESTMINSTER	TH-4	KURN HATTIN RD	PAVE	2.81	29,674
WINDHAM COUNTY	WESTMINSTER	TH-4	PATCH RD	PAVE	2.18	23,021
WINDHAM COUNTY	WESTMINSTER	TH-5	BACK WESTMINSTER RD	PAVE	3.07	32,419
WINDHAM COUNTY	WHITINGHAM	TH-1	ROUTE 8A	PAVE	3.30	34,848
WINDHAM COUNTY	WHITINGHAM	TH-2	TUNNEL ST	PAVE	1.27	13,411
WINDHAM COUNTY	WHITINGHAM	TH-3	POVERTY ROW	PAVE	0.67	7,075
WINDHAM COUNTY	WHITINGHAM	TH-3	TOWN HILL RD	PAVE	0.09	950
WINDHAM COUNTY	WHITINGHAM	TH-3	GOODNOW RD	PAVE	0.63	6,653
WINDHAM COUNTY	WHITINGHAM	TH-3	WILMINGTON CROSS RD	PAVE	2.03	21,437
WINDHAM COUNTY	WHITINGHAM	TH-3	KENTFIELD RD	PAVE	3.21	33,898
WINDHAM COUNTY	WILMINGTON	TH-1	COLDBROOK RD	PAVE	2.73	28,829
WINDHAM COUNTY	WILMINGTON	TH-2	EAST DOVER RD	PAVE	0.92	9,715
WINDHAM COUNTY	WILMINGTON	TH-3	HIGLEY HILL RD	PAVE	3.30	34,848
WINDHAM COUNTY	WILMINGTON	TH-4	LAKE RAPONDA RD	PAVE	0.61	6,442
WINDHAM COUNTY	WILMINGTON	TH-5	MANN RD	PAVE	1.70	17,952
WINDHAM COUNTY	WILMINGTON	TH-5	RAY HILL RD	PAVE	0.60	6,336
WINDHAM COUNTY	WILMINGTON	TH-5	HAYSTACK RD	PAVE	1.19	12,566
WINDHAM COUNTY	WINDHAM	TH-1	WINDHAM HILL RD	PAVE	5.18	54,701
WINDHAM COUNTY	WINDHAM	TH-2	ROUTE 121	PAVE	1.71	18,058
WINDHAM COUNTY SHEET 3 TOTAL					85.93	907,421
WINDHAM COUNTY SHEET 1 TOTAL					68.82	726,739
WINDHAM COUNTY SHEET 2 TOTAL					68.37	721,987
WINDHAM COUNTY SHEET 3 TOTAL					85.93	907,421
			WINDHAM COUNTY TOTALS		223.12	2,356,147

PROJECT NAME: STATEWIDE	
PROJECT NUMBER: HES MARK(404)	
FILE NAME: +14+186.dgn	PLOT DATE: 1/29/2015
PROJECT LEADER: P. COBURN	DRAWN BY: K. RECORD
DESIGNED BY: K. SWEET	CHECKED BY: I. DEGUTIS
CLASS 2 TOWN HIGHWAY QUANTITIES 35	SHEET 39 OF 56

SUMMARY BY COUNTY OF CLASS 2 TOWN HIGHWAYS

COUNTY	TOWN	TH NUMBER	TH NAME	SURFACE	MILEAGE	LINEAR FT
WINDSOR COUNTY	ANDOVER	TH-1	WESTON-ANDOVER RD	PAVE	4.83	51,005
WINDSOR COUNTY	ANDOVER	TH-2	EAST HILL RD	PAVE	2.04	21,542
WINDSOR COUNTY	BARNARD	TH-1	STAGE RD	PAVE	1.20	12,672
WINDSOR COUNTY	BARNARD	TH-2	ROYALTON TURNPIKE	PAVE	0.19	2,006
WINDSOR COUNTY	BARNARD	TH-3	NORTH RD	PAVE	3.95	41,712
WINDSOR COUNTY	BETHEL	TH-2	CAMP BROOK RD	PAVE	6.16	65,050
WINDSOR COUNTY	BETHEL	TH-3	FACTORY HILL RD	PAVE	0.12	1,267
WINDSOR COUNTY	BETHEL	TH-3	RANDOLPH CTR RD	PAVE	0.44	4,646
WINDSOR COUNTY	BETHEL	TH-4	NORTH RD	PAVE	0.89	9,398
WINDSOR COUNTY	BETHEL	TH-5	PEAVINE BLVD	PAVE	1.66	17,530
WINDSOR COUNTY	BETHEL	TH-6	CHRISTIAN HILL RD	PAVE	0.79	8,342
WINDSOR COUNTY	BRIDGEWATER	TH-1	BRIDGEWATER CTR RD	PAVE	2.44	25,766
WINDSOR COUNTY	BRIDGEWATER	TH-1	CHATEAUGUAY RD	PAVE	0.48	5,069
WINDSOR COUNTY	BRIDGEWATER	TH-2	NORTH BRIDGEWATER RD	PAVE	0.81	8,554
WINDSOR COUNTY	CAVENDISH	TH-1	DEPOT ST	PAVE	0.60	6,336
WINDSOR COUNTY	CAVENDISH	TH-2	TARBELL HILL RD	PAVE	3.12	32,947
WINDSOR COUNTY	CAVENDISH	TH-3	TWENTY MILE STREAM RD	PAVE	3.80	40,128
WINDSOR COUNTY	CAVENDISH	TH-4	MILL ST	PAVE	0.22	2,323
WINDSOR COUNTY	CHESTER	TH-3	GRAFTON RD	PAVE	2.61	27,562
WINDSOR COUNTY	CHESTER	TH-4	DEPOT ST	PAVE	0.19	2,006
WINDSOR COUNTY	CHESTER	TH-5	CHURCH ST	PAVE	0.95	10,032
WINDSOR COUNTY	CHESTER	TH-6	GREEN MTN TURNPIKE	PAVE	0.19	2,006
WINDSOR COUNTY	CHESTER	TH-6	PECK RD	PAVE	0.26	2,746
WINDSOR COUNTY	CHESTER	TH-7	ANDOVER RD	PAVE	1.48	15,629
WINDSOR COUNTY	CHESTER	TH-9	FLAMSTEAD RD	PAVE	2.68	28,301
WINDSOR COUNTY	HARTFORD	TH-2	BRIDGE ST	PAVE	0.20	2,112
WINDSOR COUNTY	HARTFORD	TH-2	NORTH MAIN ST	PAVE	0.25	2,640
WINDSOR COUNTY	HARTFORD	TH-3	QUECHEE MAIN ST	PAVE	5.30	55,968
WINDSOR COUNTY	HARTFORD	TH-4	DEWEYS MILLS RD	PAVE	0.87	9,187
WINDSOR COUNTY	HARTFORD	TH-4	QUECHEE-WEST HARTFORD RD	PAVE	5.22	55,123
WINDSOR COUNTY	HARTFORD	TH-5	POMFRET RD	PAVE	0.83	8,765
WINDSOR COUNTY	HARTFORD	TH-6	VA CUTOFF RD	PAVE	1.36	14,362
WINDSOR COUNTY	HARTFORD	TH-7	MILL RD	PAVE	0.57	6,019
WINDSOR COUNTY	HARTFORD	TH-8	WATERMAN HILL RD	PAVE	0.19	2,006
WINDSOR COUNTY	HARTFORD	TH-8	QUECHEE-HARTLAND RD	PAVE	1.60	16,896
WINDSOR COUNTY	HARTFORD	TH-9	CHRISTIAN ST	PAVE	2.27	23,971
WINDSOR COUNTY	HARTFORD	TH-10	SYKES MOUNTAIN AVE	PAVE	0.97	10,243
WINDSOR COUNTY	HARTLAND	TH-1	BROWNSVILLE RD	PAVE	2.52	26,611
WINDSOR COUNTY	HARTLAND	TH-2	QUECHEE RD	PAVE	5.26	55,546
WINDSOR COUNTY SHEET 1 TOTAL					69.51	734,026

PROJECT NAME: STATEWIDE	
PROJECT NUMBER: HES MARK(404)	
FILE NAME: +14+186.dgn	PLOT DATE: 1/29/2015
PROJECT LEADER: P. COBURN	DRAWN BY: K. RECORD
DESIGNED BY: K. SWEET	CHECKED BY: I. DEGUTIS
CLASS 2 TOWN HIGHWAY QUANTITIES 36	SHEET 40 OF 56

SUMMARY BY COUNTY OF CLASS 2 TOWN HIGHWAYS


COUNTY	TOWN	TH NUMBER	TH NAME	SURFACE	MILEAGE	LINEAR FT
WINDSOR COUNTY	HARTLAND	TH-3	COUNTY RD	PAVE	1.12	11,827
WINDSOR COUNTY	HARTLAND	TH-4	CLAY HILL RD	PAVE	2.85	30,096
WINDSOR COUNTY	LUDLOW	TH-1	ANDOVER RD	PAVE	0.41	4,330
WINDSOR COUNTY	LUDLOW	TH-2	MOUNTAIN RD	PAVE	0.41	4,330
WINDSOR COUNTY	LUDLOW	TH-3	DUG RD	PAVE	0.22	2,323
WINDSOR COUNTY	LUDLOW	TH-3	MOUNTAIN RD	PAVE	0.13	1,373
WINDSOR COUNTY	LUDLOW	TH-4	DUG RD	PAVE	0.22	2,323
WINDSOR COUNTY	LUDLOW	TH-4	MAIN ST	PAVE	0.08	845
WINDSOR COUNTY	LUDLOW	TH-4	HIGH ST	PAVE	0.53	5,597
WINDSOR COUNTY	NORWICH	TH-1	MAIN ST	PAVE	0.68	7,181
WINDSOR COUNTY	NORWICH	TH-1	UNION VILLAGE RD	PAVE	5.01	52,906
WINDSOR COUNTY	NORWICH	TH-2	BEAVER MEADOW RD	PAVE	5.63	59,453
WINDSOR COUNTY	NORWICH	TH-3	ROUTE 132	PAVE	2.83	29,885
WINDSOR COUNTY	NORWICH	TH-4	ACADEMY RD	PAVE	0.40	4,224
WINDSOR COUNTY	PLYMOUTH	TH-1	COOLIDGE MEMORIAL RD	PAVE	0.41	4,330
WINDSOR COUNTY	PLYMOUTH	TH-2	KINGDOM RD	PAVE	2.70	28,512
WINDSOR COUNTY	PLYMOUTH	TH-3	BUSHNELL RD	PAVE	0.64	6,758
WINDSOR COUNTY	POMFRET	TH-1	POMFRET RD	PAVE	10.15	107,184
WINDSOR COUNTY	POMFRET	TH-2	STAGE RD	PAVE	2.73	28,829
WINDSOR COUNTY	POMFRET	TH-3	HOWE HILL RD	PAVE	1.77	18,691
WINDSOR COUNTY	READING	TH-1	TYSON RD	PAVE	7.25	76,560
WINDSOR COUNTY	ROCHESTER	TH-1	BETHEL MOUNTAIN RD	PAVE	4.10	43,296
WINDSOR COUNTY	ROCHESTER	TH-2	MIDDLE HOLLOW RD	PAVE	1.47	15,523
WINDSOR COUNTY	ROCHESTER	TH-3	QUARRY HILL RD	PAVE	1.79	18,902
WINDSOR COUNTY	ROYALTON	TH-1	CHELSEA ST.	PAVE	0.22	2,323
WINDSOR COUNTY	ROYALTON	TH-1	SOUTH WINDSOR ST	PAVE	2.37	25,027
WINDSOR COUNTY	ROYALTON	TH-2	BROAD BROOK RD	PAVE	0.55	5,808
WINDSOR COUNTY	ROYALTON	TH-3	DIARY HILL RD	PAVE	1.84	19,430
WINDSOR COUNTY	ROYALTON	TH-4	NORTH RD	PAVE	2.22	23,443
WINDSOR COUNTY	ROYALTON	TH-5	NORTH WINDSOR ST	PAVE	1.16	12,250
WINDSOR COUNTY	ROYALTON	TH-5	BRIDGE ST	PAVE	0.20	2,112
WINDSOR COUNTY	ROYALTON	TH-6	ROYALTON HILL RD	PAVE	1.16	12,250
WINDSOR COUNTY	ROYALTON	TH-7	CHRISTIAN HILL RD	PAVE	0.04	422
WINDSOR COUNTY	SHARON	TH-1	BEAVER MEADOW RD	PAVE	0.53	5,597
WINDSOR COUNTY	SHARON	TH-2	ROUTE 132	PAVE	4.02	42,451
WINDSOR COUNTY	SHARON	TH-3	RIVER RD	PAVE	2.43	25,661
WINDSOR COUNTY	SHARON	TH-4	BROAD BROOK RD	PAVE	0.30	3,168
WINDSOR COUNTY	SHARON	TH-5	HOWE HILL RD	PAVE	2.72	28,723
WINDSOR COUNTY	SPRINGFIELD	TH-3	SUMMER ST	PAVE	1.19	12,566
WINDSOR COUNTY	SPRINGFIELD	TH-3	SKITCHEWAUG TRAIL	PAVE	4.56	48,154
WINDSOR COUNTY	SPRINGFIELD	TH-4	BROCKAWAY MILLS RD	PAVE	2.83	29,885
WINDSOR COUNTY SHEET 2 TOTAL					81.87	864,547

PROJECT NAME: STATEWIDE	
PROJECT NUMBER: HES MARK(404)	
FILE NAME: +14+186.dgn	PLOT DATE: 1/29/2015
PROJECT LEADER: P. COBURN	DRAWN BY: K. RECORD
DESIGNED BY: K. SWEET	CHECKED BY: I. DEGUTIS
CLASS 2 TOWN HIGHWAY QUANTITIES 37	SHEET 41 OF 56

SUMMARY BY COUNTY OF CLASS 2 TOWN HIGHWAYS

COUNTY	TOWN	TH NUMBER	TH NAME	SURFACE	MILEAGE	LINEAR FT
WINDSOR COUNTY	SPRINGFIELD	TH-4	SOUTH ST	PAVE	2.42	25,555
WINDSOR COUNTY	SPRINGFIELD	TH-5	BROOK RD	PAVE	2.20	23,232
WINDSOR COUNTY	SPRINGFIELD	TH-5	VALLEY ST	PAVE	0.97	10,243
WINDSOR COUNTY	SPRINGFIELD	TH-6	MAIN ST NS	PAVE	1.48	15,629
WINDSOR COUNTY	SPRINGFIELD	TH-6	MILL RD	PAVE	0.12	1,267
WINDSOR COUNTY	SPRINGFIELD	TH-7	AIRPORT RD	PAVE	0.12	1,267
WINDSOR COUNTY	SPRINGFIELD	TH-8	BALTIMORE RD	PAVE	0.81	8,554
WINDSOR COUNTY	SPRINGFIELD	TH-9	RESERVOIR RD	PAVE	1.25	13,200
WINDSOR COUNTY	SPRINGFIELD	TH-10	ELM ST	PAVE	0.33	3,485
WINDSOR COUNTY	SPRINGFIELD	TH-10	SPOONERVILLE RD	PAVE	0.40	4,224
WINDSOR COUNTY	STOCKBRIDGE	TH-1	BLACKMER BLVD	PAVE	2.62	27,667
WINDSOR COUNTY	STOCKBRIDGE	TH-2	BRIDGE ST	PAVE	0.13	1,373
WINDSOR COUNTY	STOCKBRIDGE	TH-2	RIVER RD	PAVE	0.39	4,118
WINDSOR COUNTY	WEATHERSFIELD	TH-1	WEATHERSFIELD CENTER RD	PAVE	5.25	55,440
WINDSOR COUNTY	WEATHERSFIELD	TH-3	AIRPORT RD	PAVE	0.48	5,069
WINDSOR COUNTY	WEATHERSFIELD	TH-4	RESERVOIR RD	PAVE	2.58	27,245
WINDSOR COUNTY	WEATHERSFIELD	TH-6	STOUGHTON POND RD	PAVE	1.32	13,939
WINDSOR COUNTY	WESTON	TH-1	CHESTER MOUNTAIN RD	PAVE	1.37	14,467
WINDSOR COUNTY	WESTON	TH-2	LANDGROVE RD	PAVE	0.35	3,696
WINDSOR COUNTY	WESTON	TH-2	LAWRENCE HILL RD	PAVE	0.26	2,746
WINDSOR COUNTY	WEST WINDSOR	TH-1	BROWNSVILLE-HARTLAND RD	PAVE	4.70	49,632
WINDSOR COUNTY	WEST WINDSOR	TH-2	SKI TOW RD	PAVE	0.82	8,659
WINDSOR COUNTY	WINDSOR	TH-3	COUNTY RD	PAVE	3.65	38,544
WINDSOR COUNTY	WINDSOR	TH-3	STATE ST	PAVE	0.72	7,603
WINDSOR COUNTY	WINDSOR	TH-4	BRIDGE ST	PAVE	0.22	2,323
WINDSOR COUNTY	WINDSOR	TH-5	ASCUTNEY ST	PAVE	0.26	2,746
WINDSOR COUNTY	WINDSOR	TH-6	COLE HILL RD	PAVE	0.45	4,752
WINDSOR COUNTY	WOODSTOCK	TH-1	POMFRET RD	PAVE	0.88	9,293
WINDSOR COUNTY	WOODSTOCK	TH-2	QUECHEE MAIN ST	PAVE	0.11	1,162
WINDSOR COUNTY	WOODSTOCK	TH-3	PROSPER RD	PAVE	0.13	1,373
WINDSOR COUNTY	WOODSTOCK	TH-4	CHURCH HILL RD	PAVE	1.83	19,325
WINDSOR COUNTY	WOODSTOCK	TH-5	HARTLAND HILL RD	PAVE	1.39	14,678
WINDSOR COUNTY	WOODSTOCK	TH-5	PLEASANT ST	PAVE	0.32	3,379
WINDSOR COUNTY	WOODSTOCK	TH-6	PROSPECT ST	PAVE	0.44	4,646
WINDSOR COUNTY SHEET 3 TOTAL					40.77	430,531
WINDSOR COUNTY SHEET 1 TOTAL					69.51	734,026
WINDSOR COUNTY SHEET 2 TOTAL					81.87	864,547
WINDSOR COUNTY SHEET 3 TOTAL					40.77	430,531
			WINDSOR COUNTY TOTALS		192.15	2,029,104

PROJECT NAME: STATEWIDE	
PROJECT NUMBER: HES MARK(404)	
FILE NAME: +14+186.dgn	PLOT DATE: 1/29/2015
PROJECT LEADER: P. COBURN	DRAWN BY: K. RECORD
DESIGNED BY: K. SWEET	CHECKED BY: I. DEGUTIS
CLASS 2 TOWN HIGHWAY QUANTITIES 38	SHEET 42 OF 56

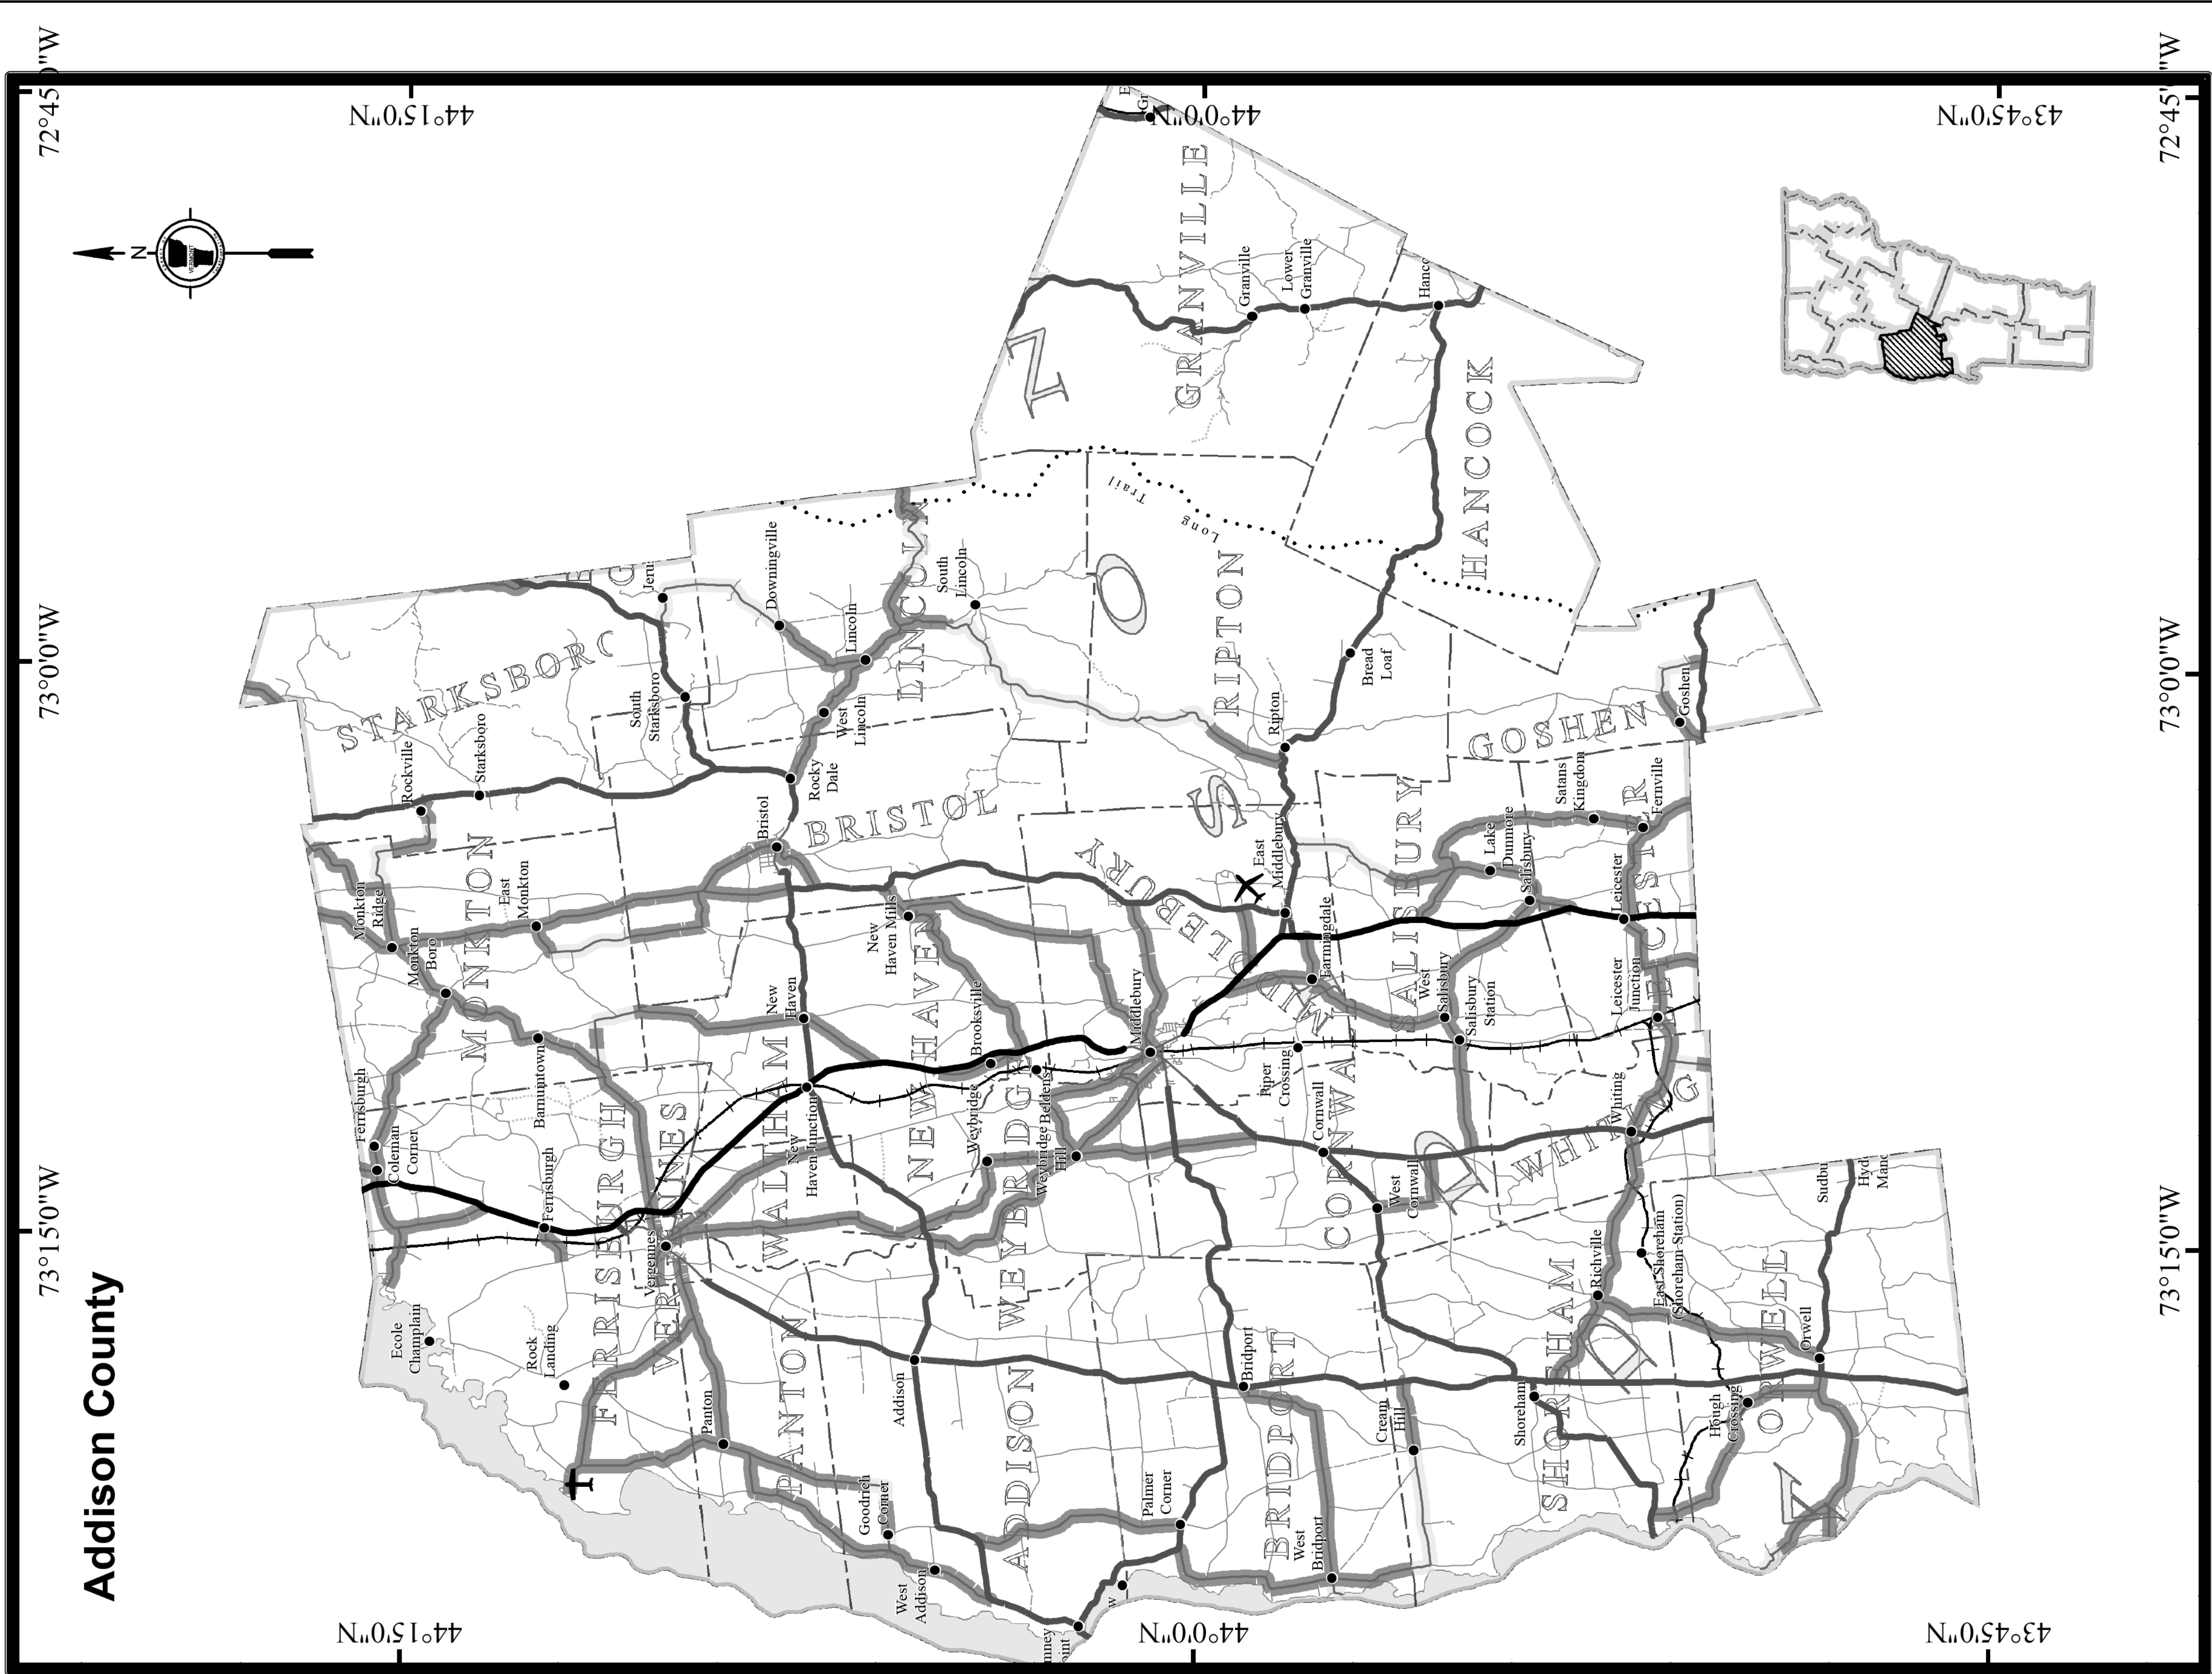

Class 2 Town Highways By Surface
SURFACETYPE


- Paved
- Gravel
- Soil or graded and drained earth

CLASS 2 TOWN HIGHWAYS BY SURFACE TYPE - ADDISON COUNTY

NOT TO SCALE

PROJECT NAME: STATEWIDE
PROJECT NUMBER: HES MARK(404)

FILE NAME: +14+186.dgn	PLOT DATE: 1/29/2015
PROJECT LEADER: P. COBURN	DRAWN BY: K. RECORD
DESIGNED BY: K. SWEET	CHECKED BY: I. DEGUTIS
TOWN HIGHWAY COUNTY MAP SHEET 1	SHEET 43 OF 56

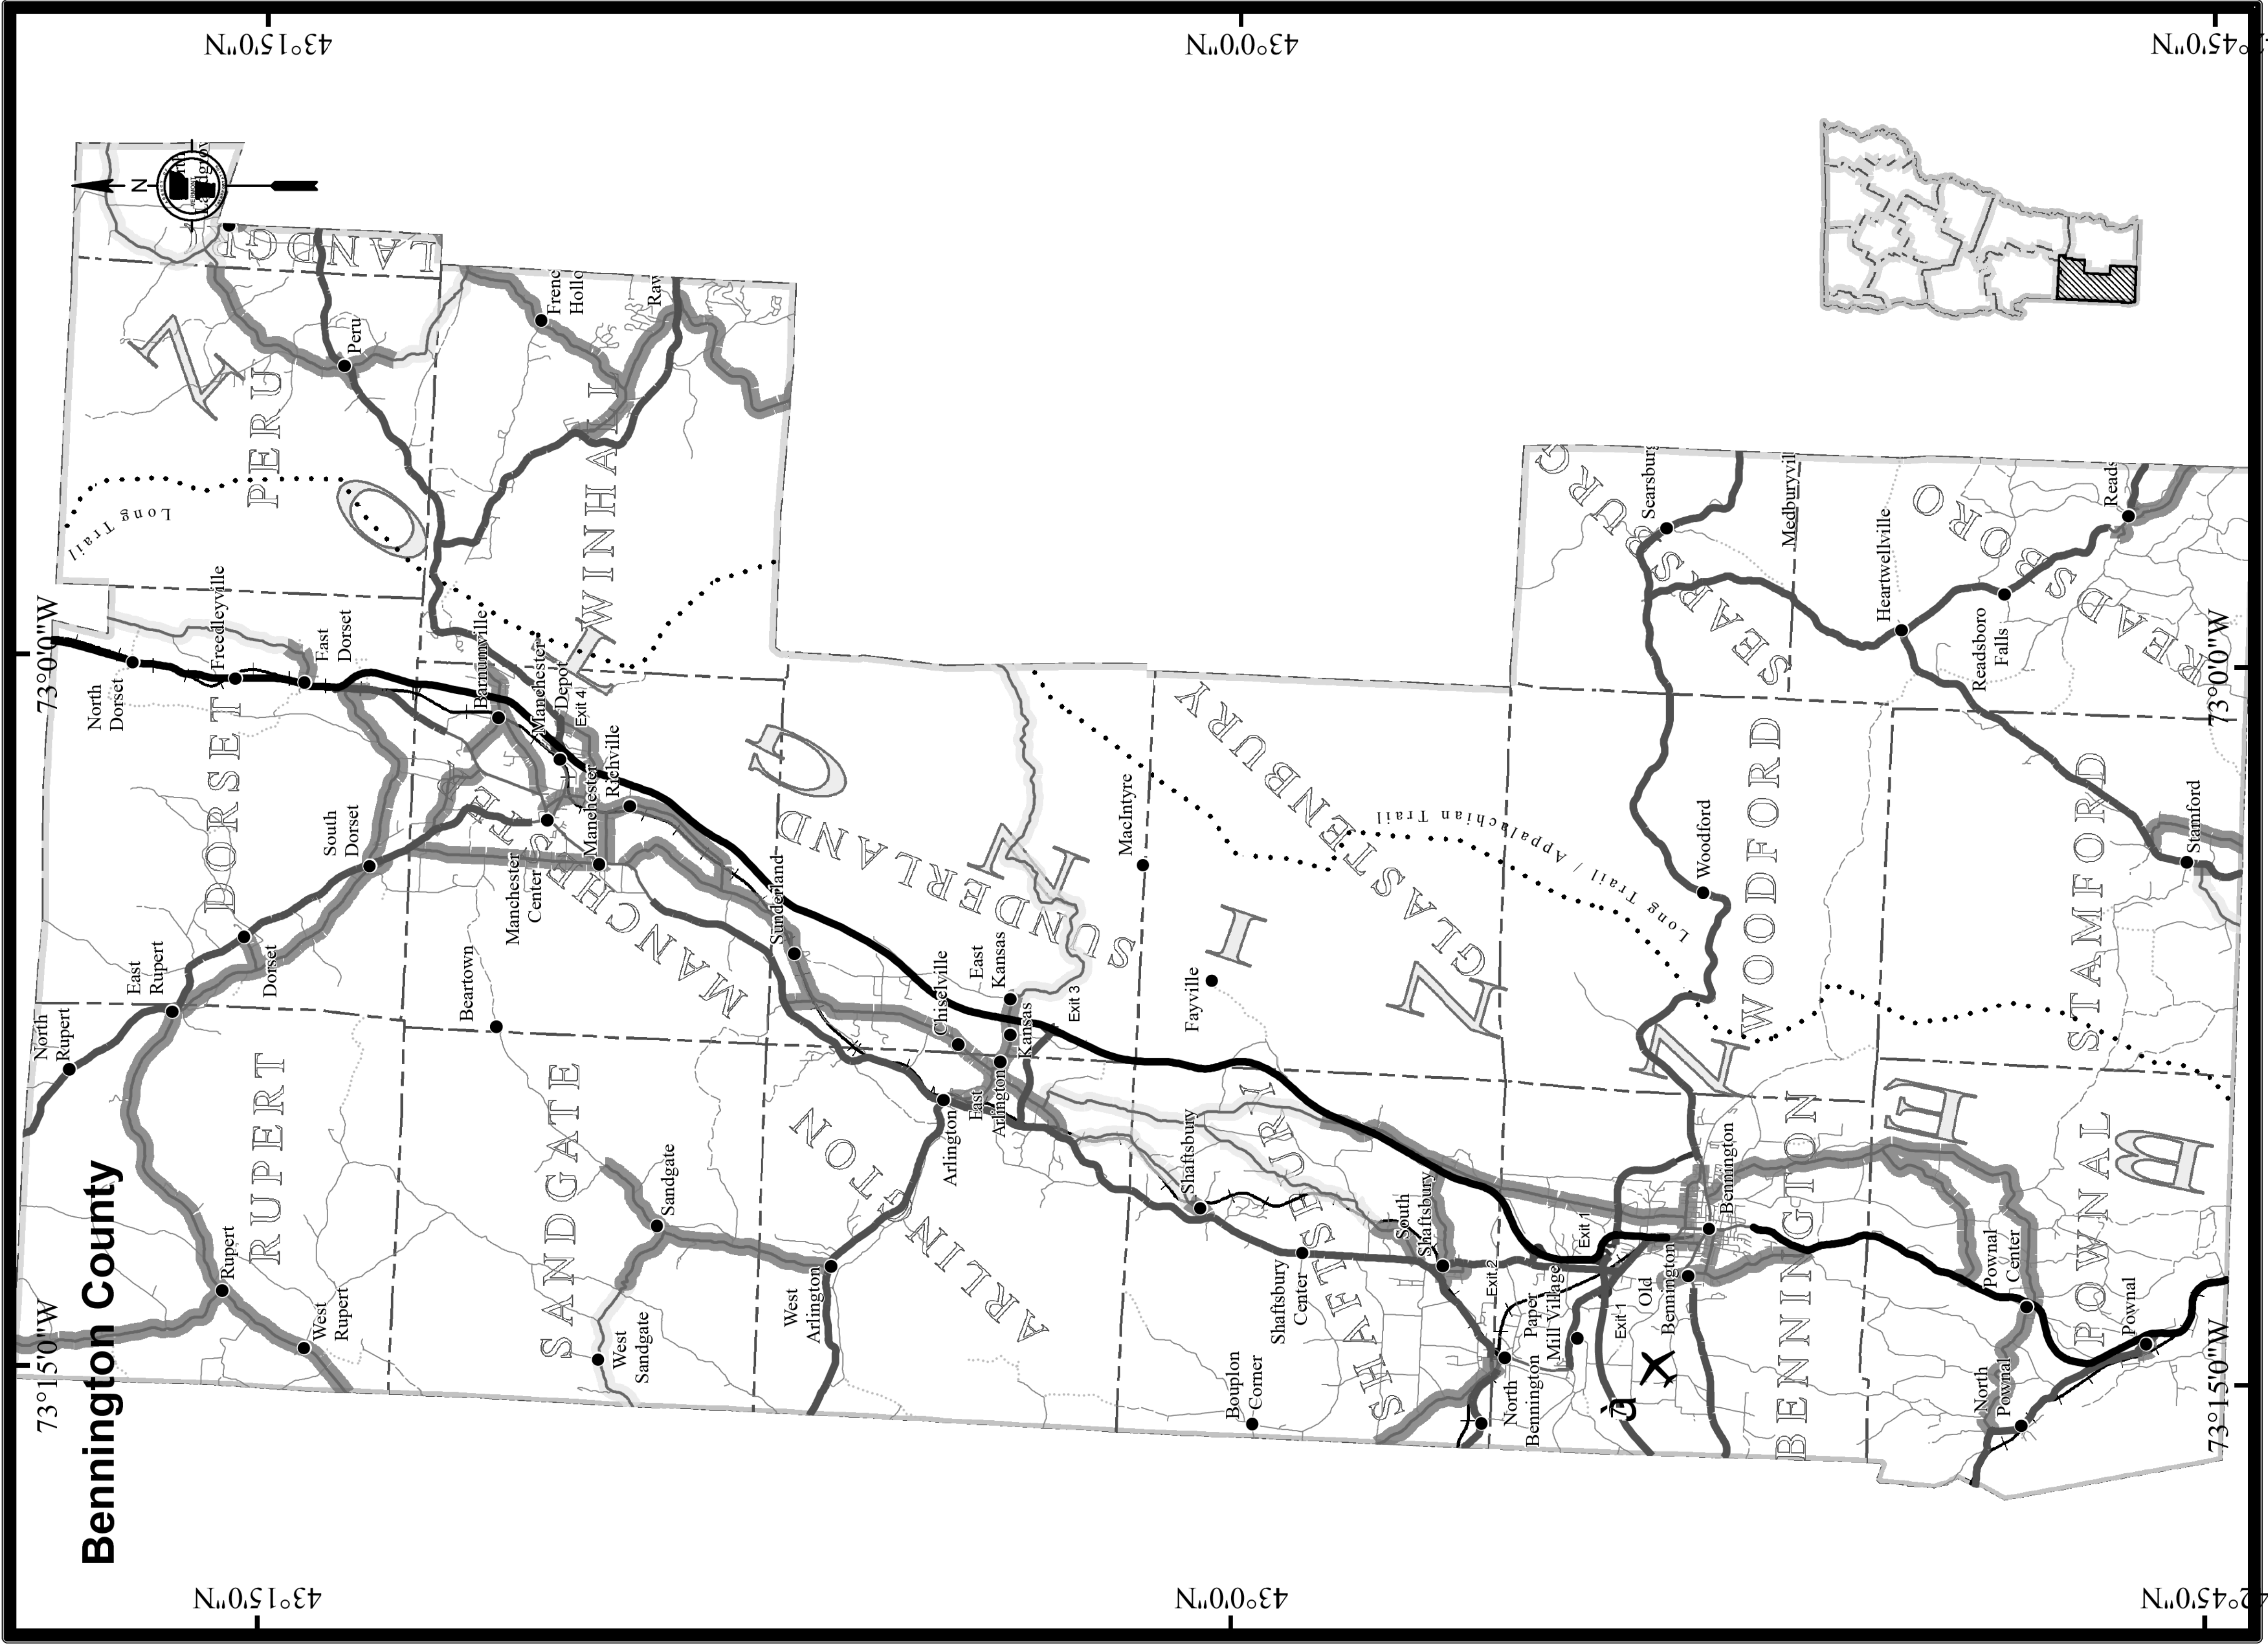


Class 2 Town Highways By Surface
SURFACETYPE

	Paved
	Gravel
	Soil or graded and drained earth

CLASS 2 TOWN HIGHWAYS BY SURFACE TYPE - BENNINGTON COUNTY

NOT TO SCALE

PROJECT NAME:	STATEWIDE
PROJECT NUMBER:	HES MARK(404)
FILE NAME: +14+186.dgn	PLOT DATE: 1/29/2015
PROJECT LEADER: P. COBURN	DRAWN BY: K. RECORD
DESIGNED BY: K. SWEET	CHECKED BY: I. DEGUTIS
TOWN HIGHWAY COUNTY MAP SHEET 2	SHEET 44 OF 56

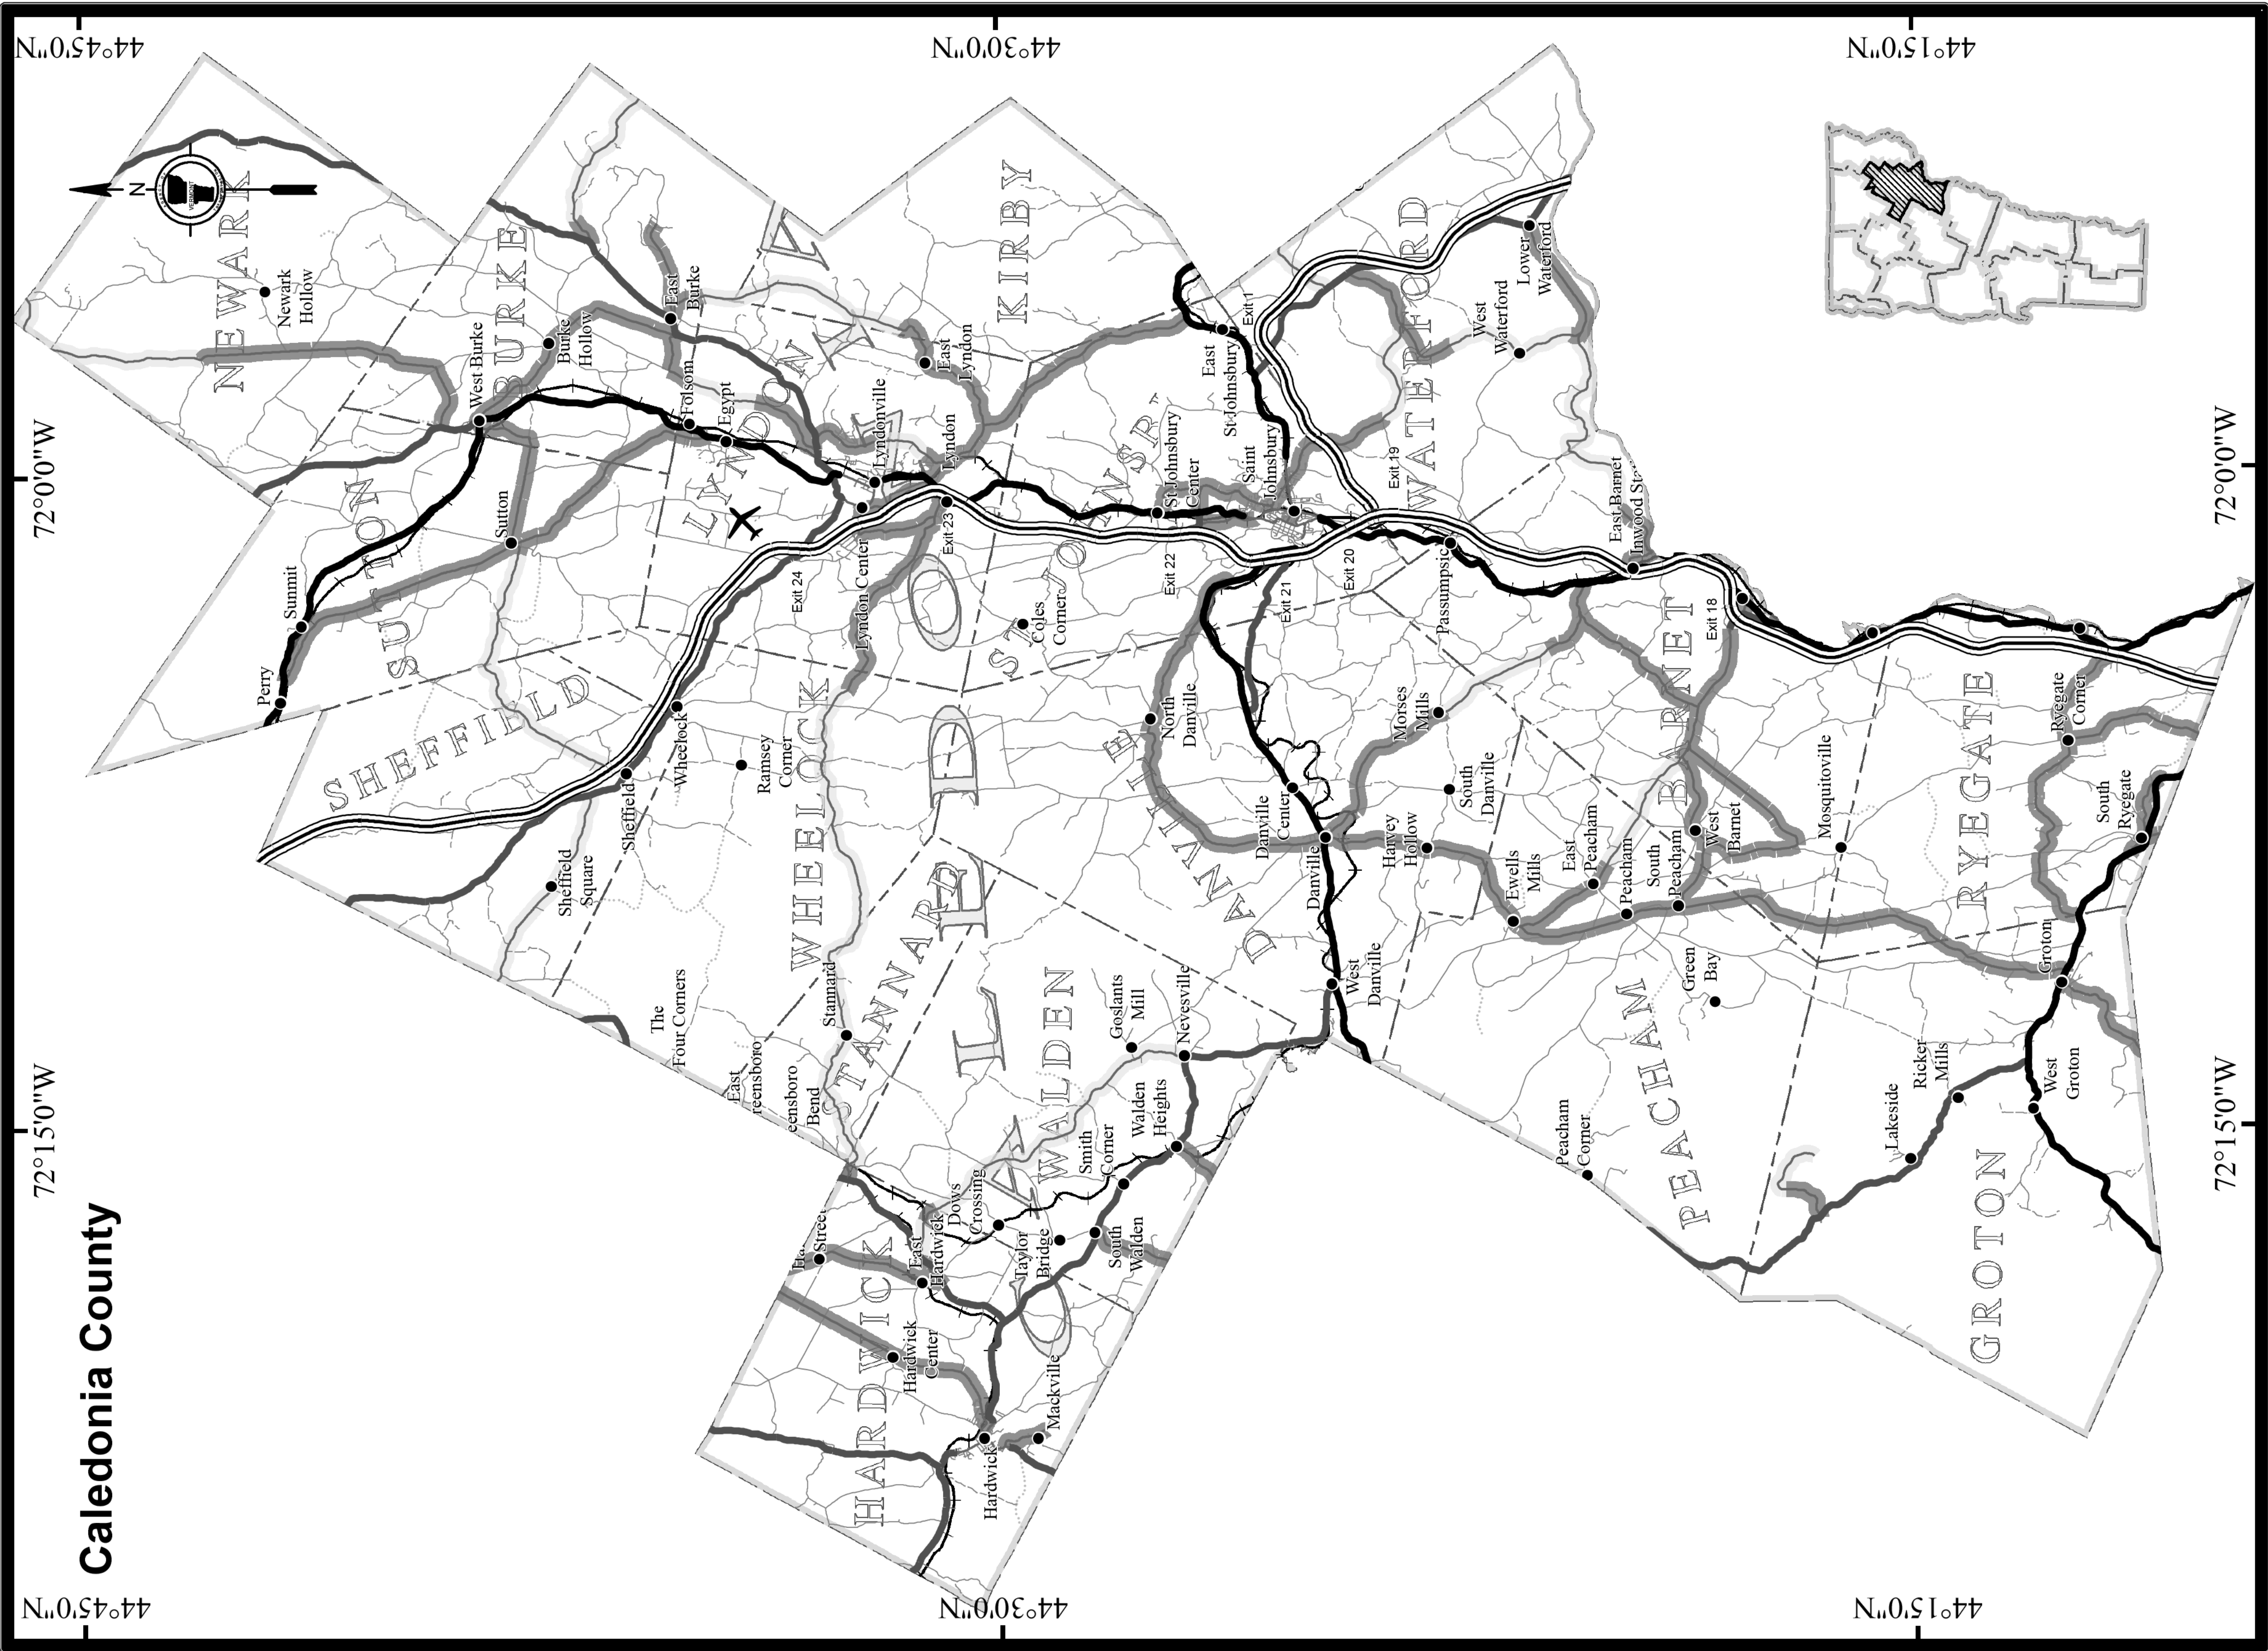


Class 2 Town Highways By Surface
SURFACETYPE

- Paved
- Gravel
- Soil or graded and drained earth

CLASS 2 TOWN HIGHWAYS BY SURFACE TYPE - CALEDONIA COUNTY

NOT TO SCALE

PROJECT NAME:	STATEWIDE
PROJECT NUMBER:	HES MARK(404)
FILE NAME: +14+186.dgn	PLOT DATE: 1/29/2015
PROJECT LEADER: P. COBURN	DRAWN BY: K. RECORD
DESIGNED BY: K. SWEET	CHECKED BY: I. DEGUTIS
TOWN HIGHWAY COUNTY MAP SHEET 3	SHEET 45 OF 56

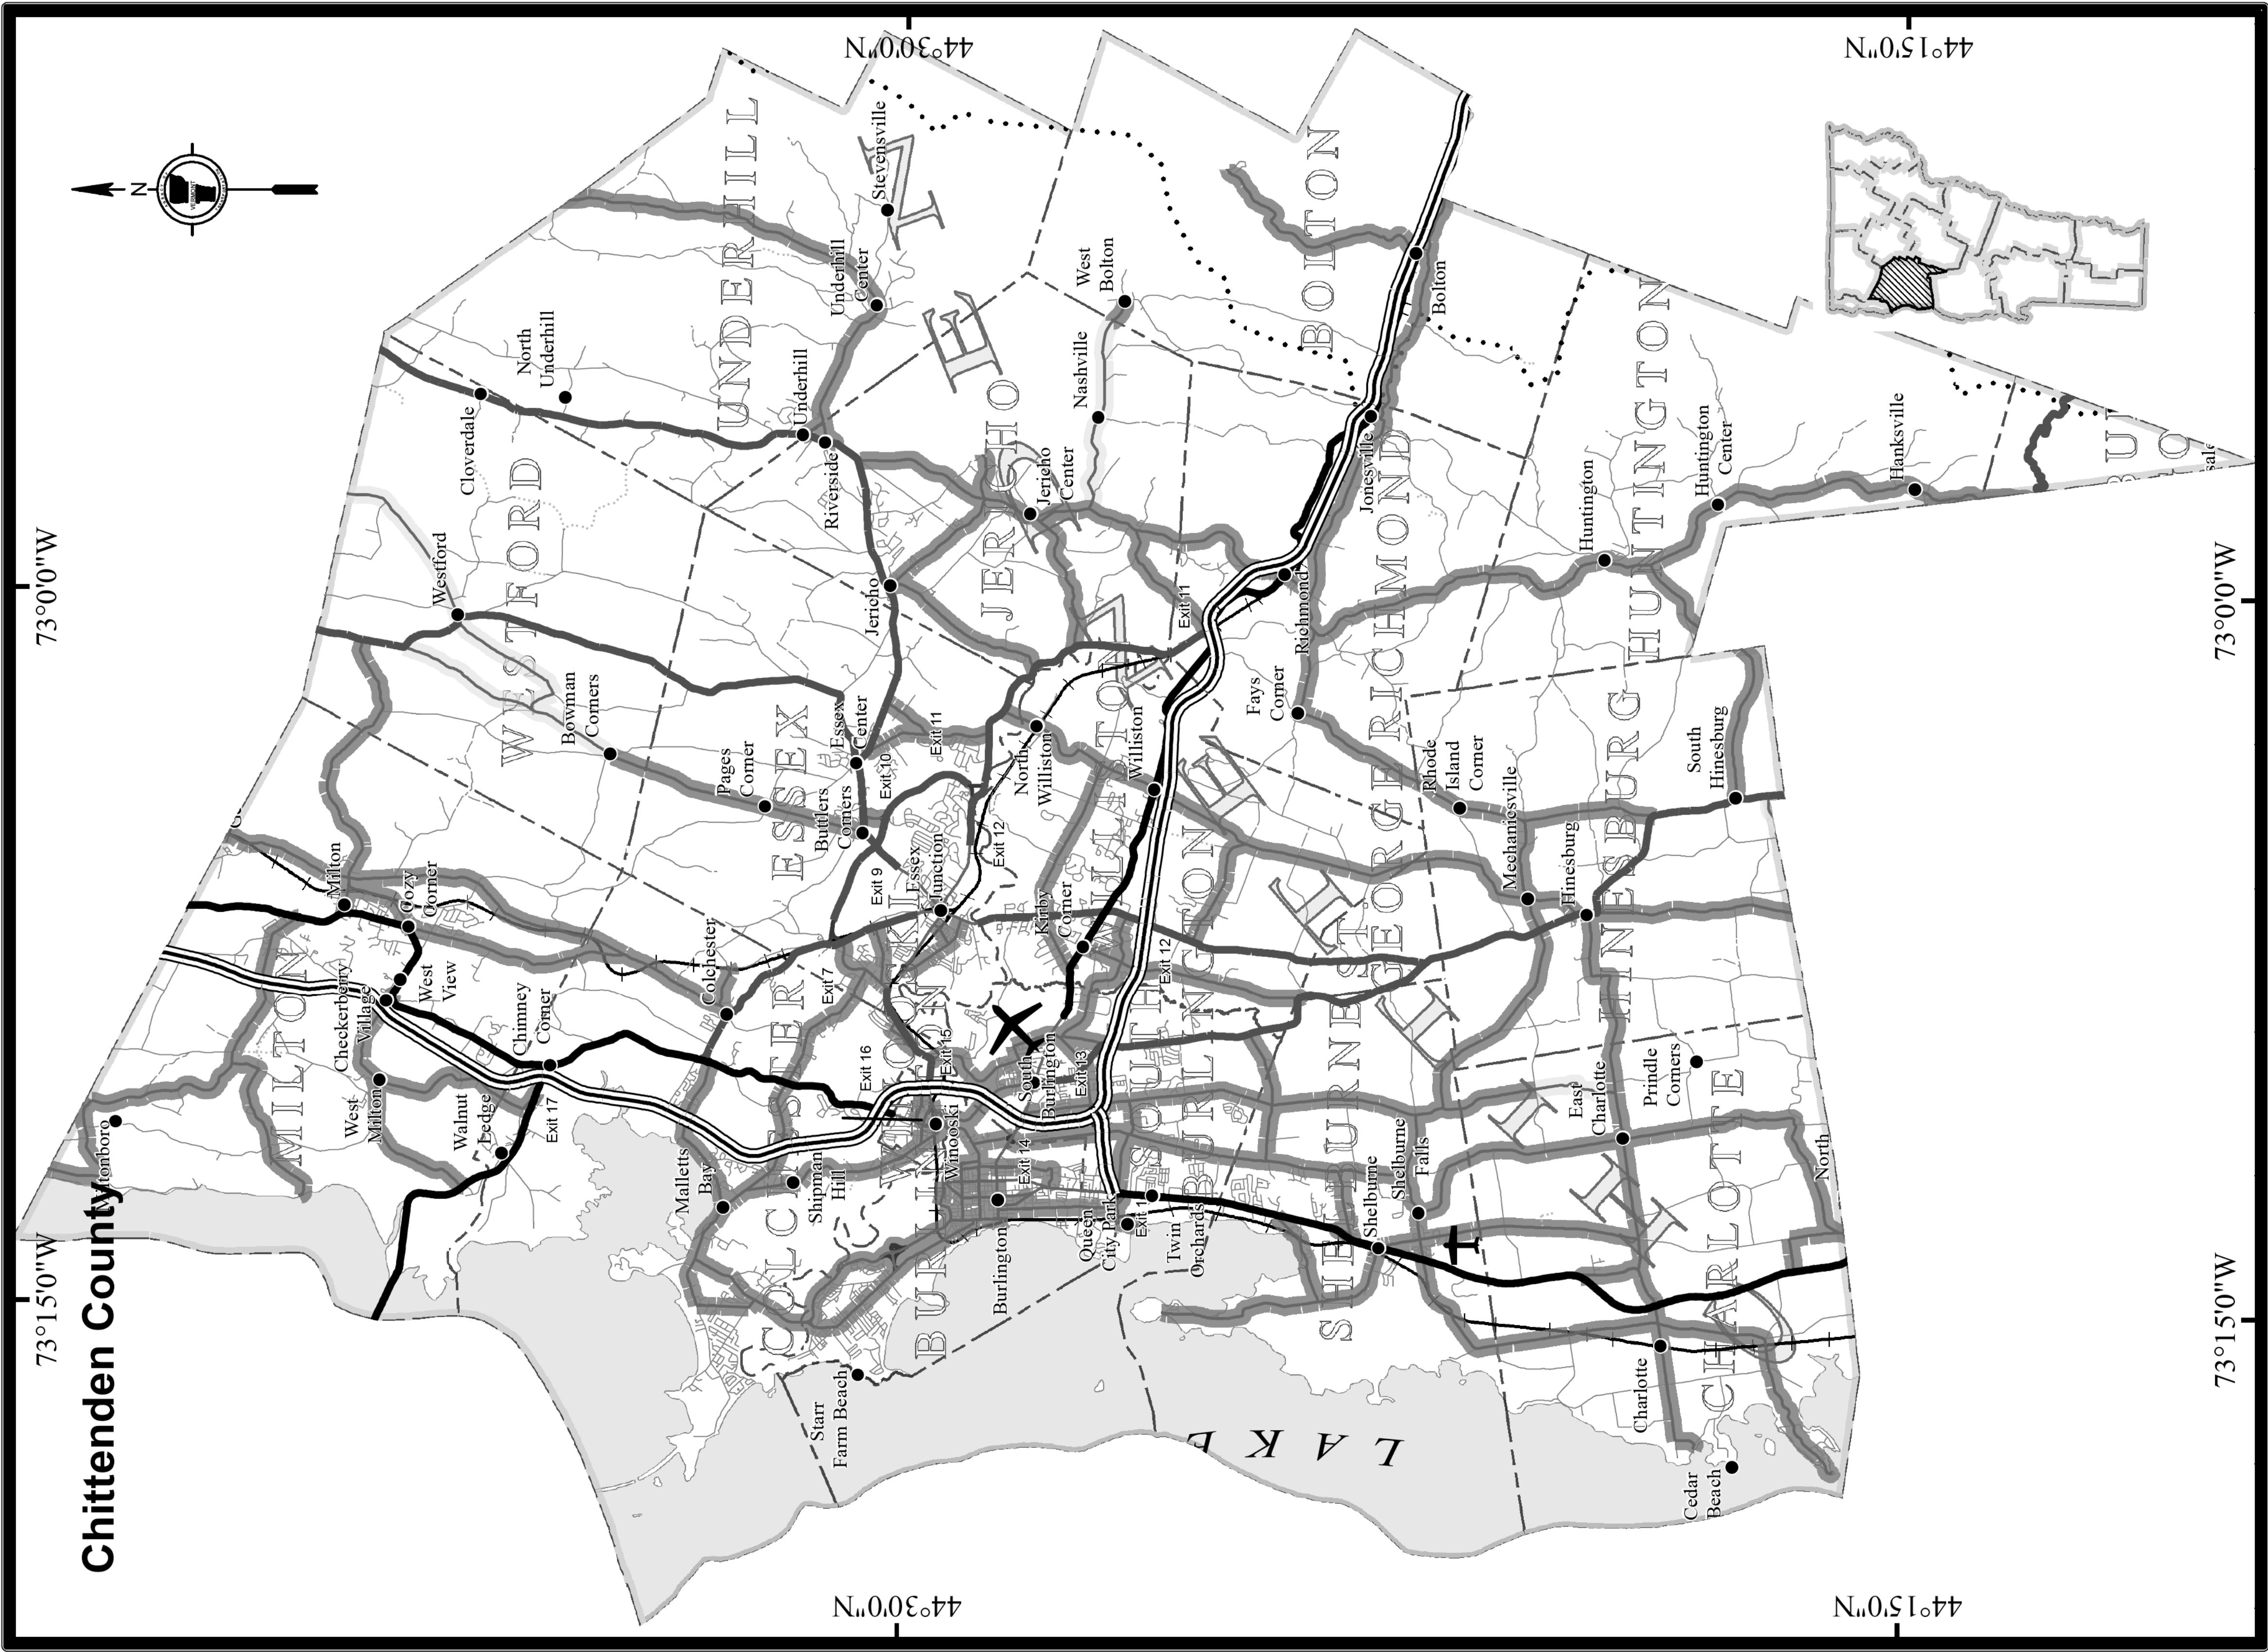


Class 2 Town Highways By Surface
SURFACETYPE

	Paved
	Gravel
	Soil or graded and drained earth

CLASS 2 TOWN HIGHWAYS BY SURFACE TYPE - CHITTENDEN COUNTY

NOT TO SCALE

PROJECT NAME:	STATEWIDE
PROJECT NUMBER:	HES MARK(404)
FILE NAME: +14+186.dgn	PLOT DATE: 1/29/2015
PROJECT LEADER: P. COBURN	DRAWN BY: K. RECORD
DESIGNED BY: K. SWEET	CHECKED BY: I. DEGUTIS
TOWN HIGHWAY COUNTY MAP SHEET 4	SHEET 46 OF 56

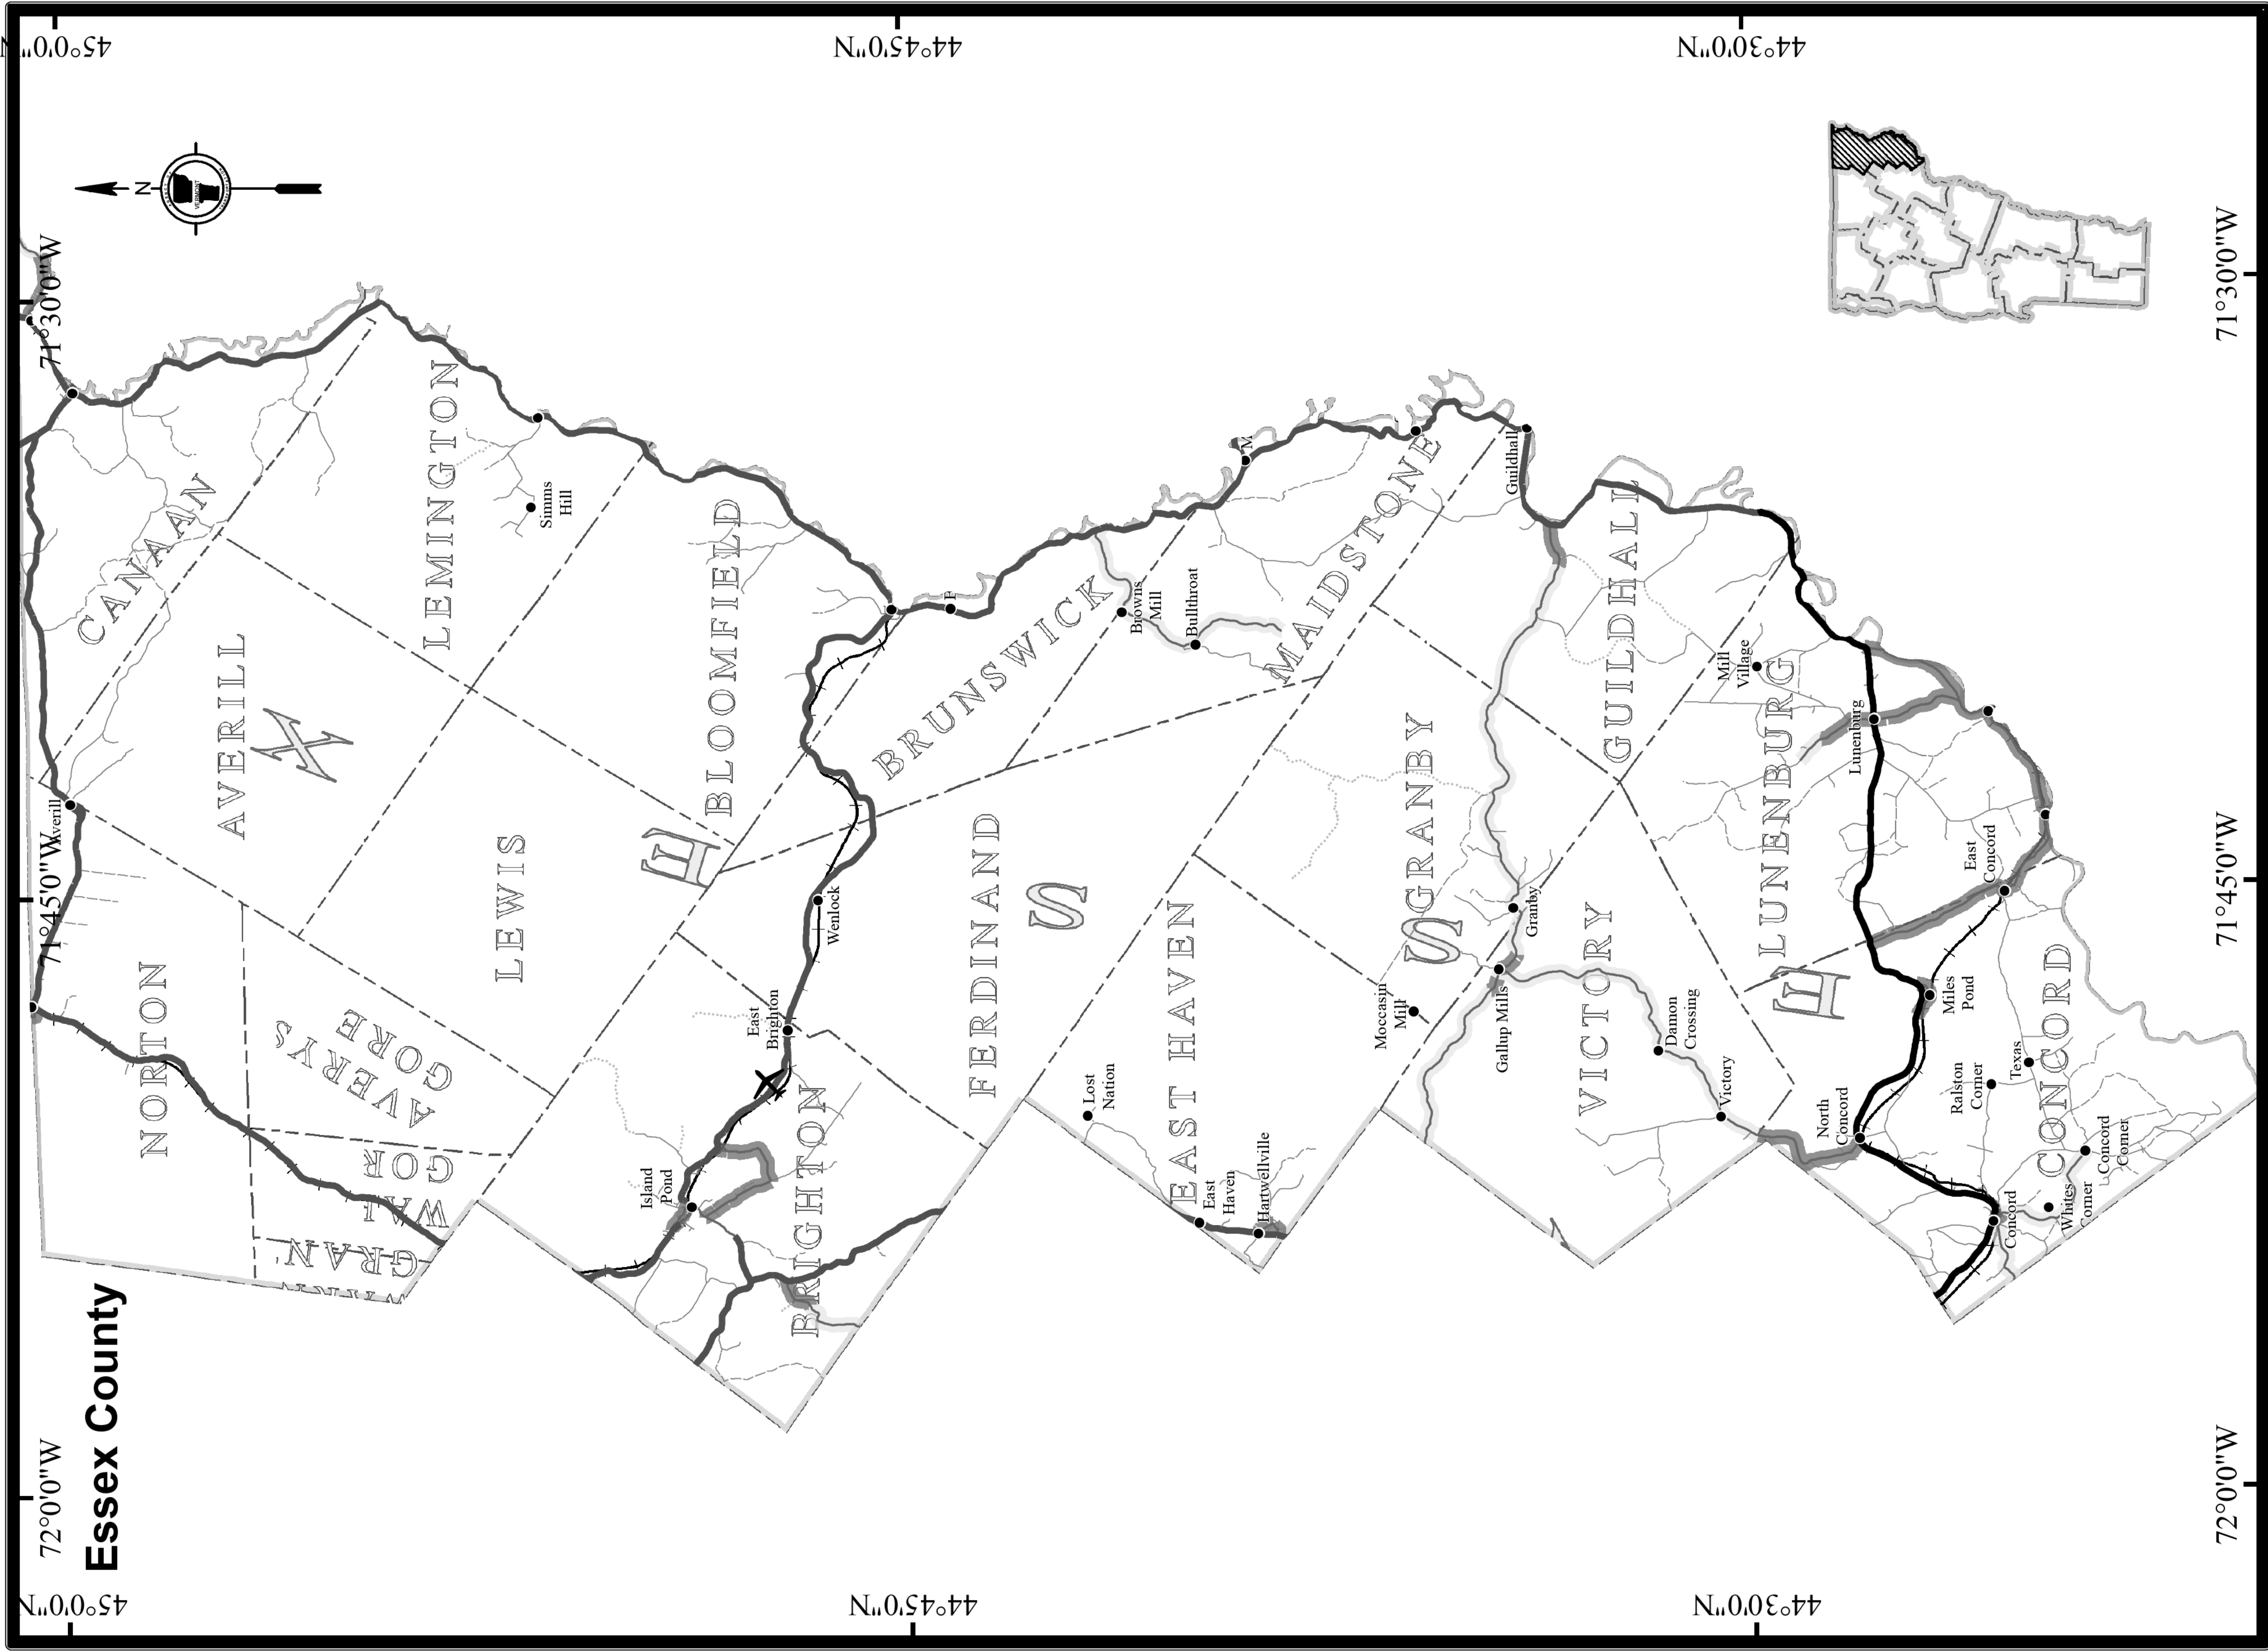


Class 2 Town Highways By Surface
SURFACETYPE

	Paved
	Gravel
	Soil or graded and drained earth

CLASS 2 TOWN HIGHWAYS BY SURFACE TYPE - ESSEX COUNTY

NOT TO SCALE

PROJECT NAME:	STATEWIDE
PROJECT NUMBER:	HES MARK(404)
FILE NAME: +14+186.dgn	PLOT DATE: 1/29/2015
PROJECT LEADER: P. COBURN	DRAWN BY: K. RECORD
DESIGNED BY: K. SWEET	CHECKED BY: I. DEGUTIS
TOWN HIGHWAY COUNTY MAP SHEET 5	SHEET 47 OF 56

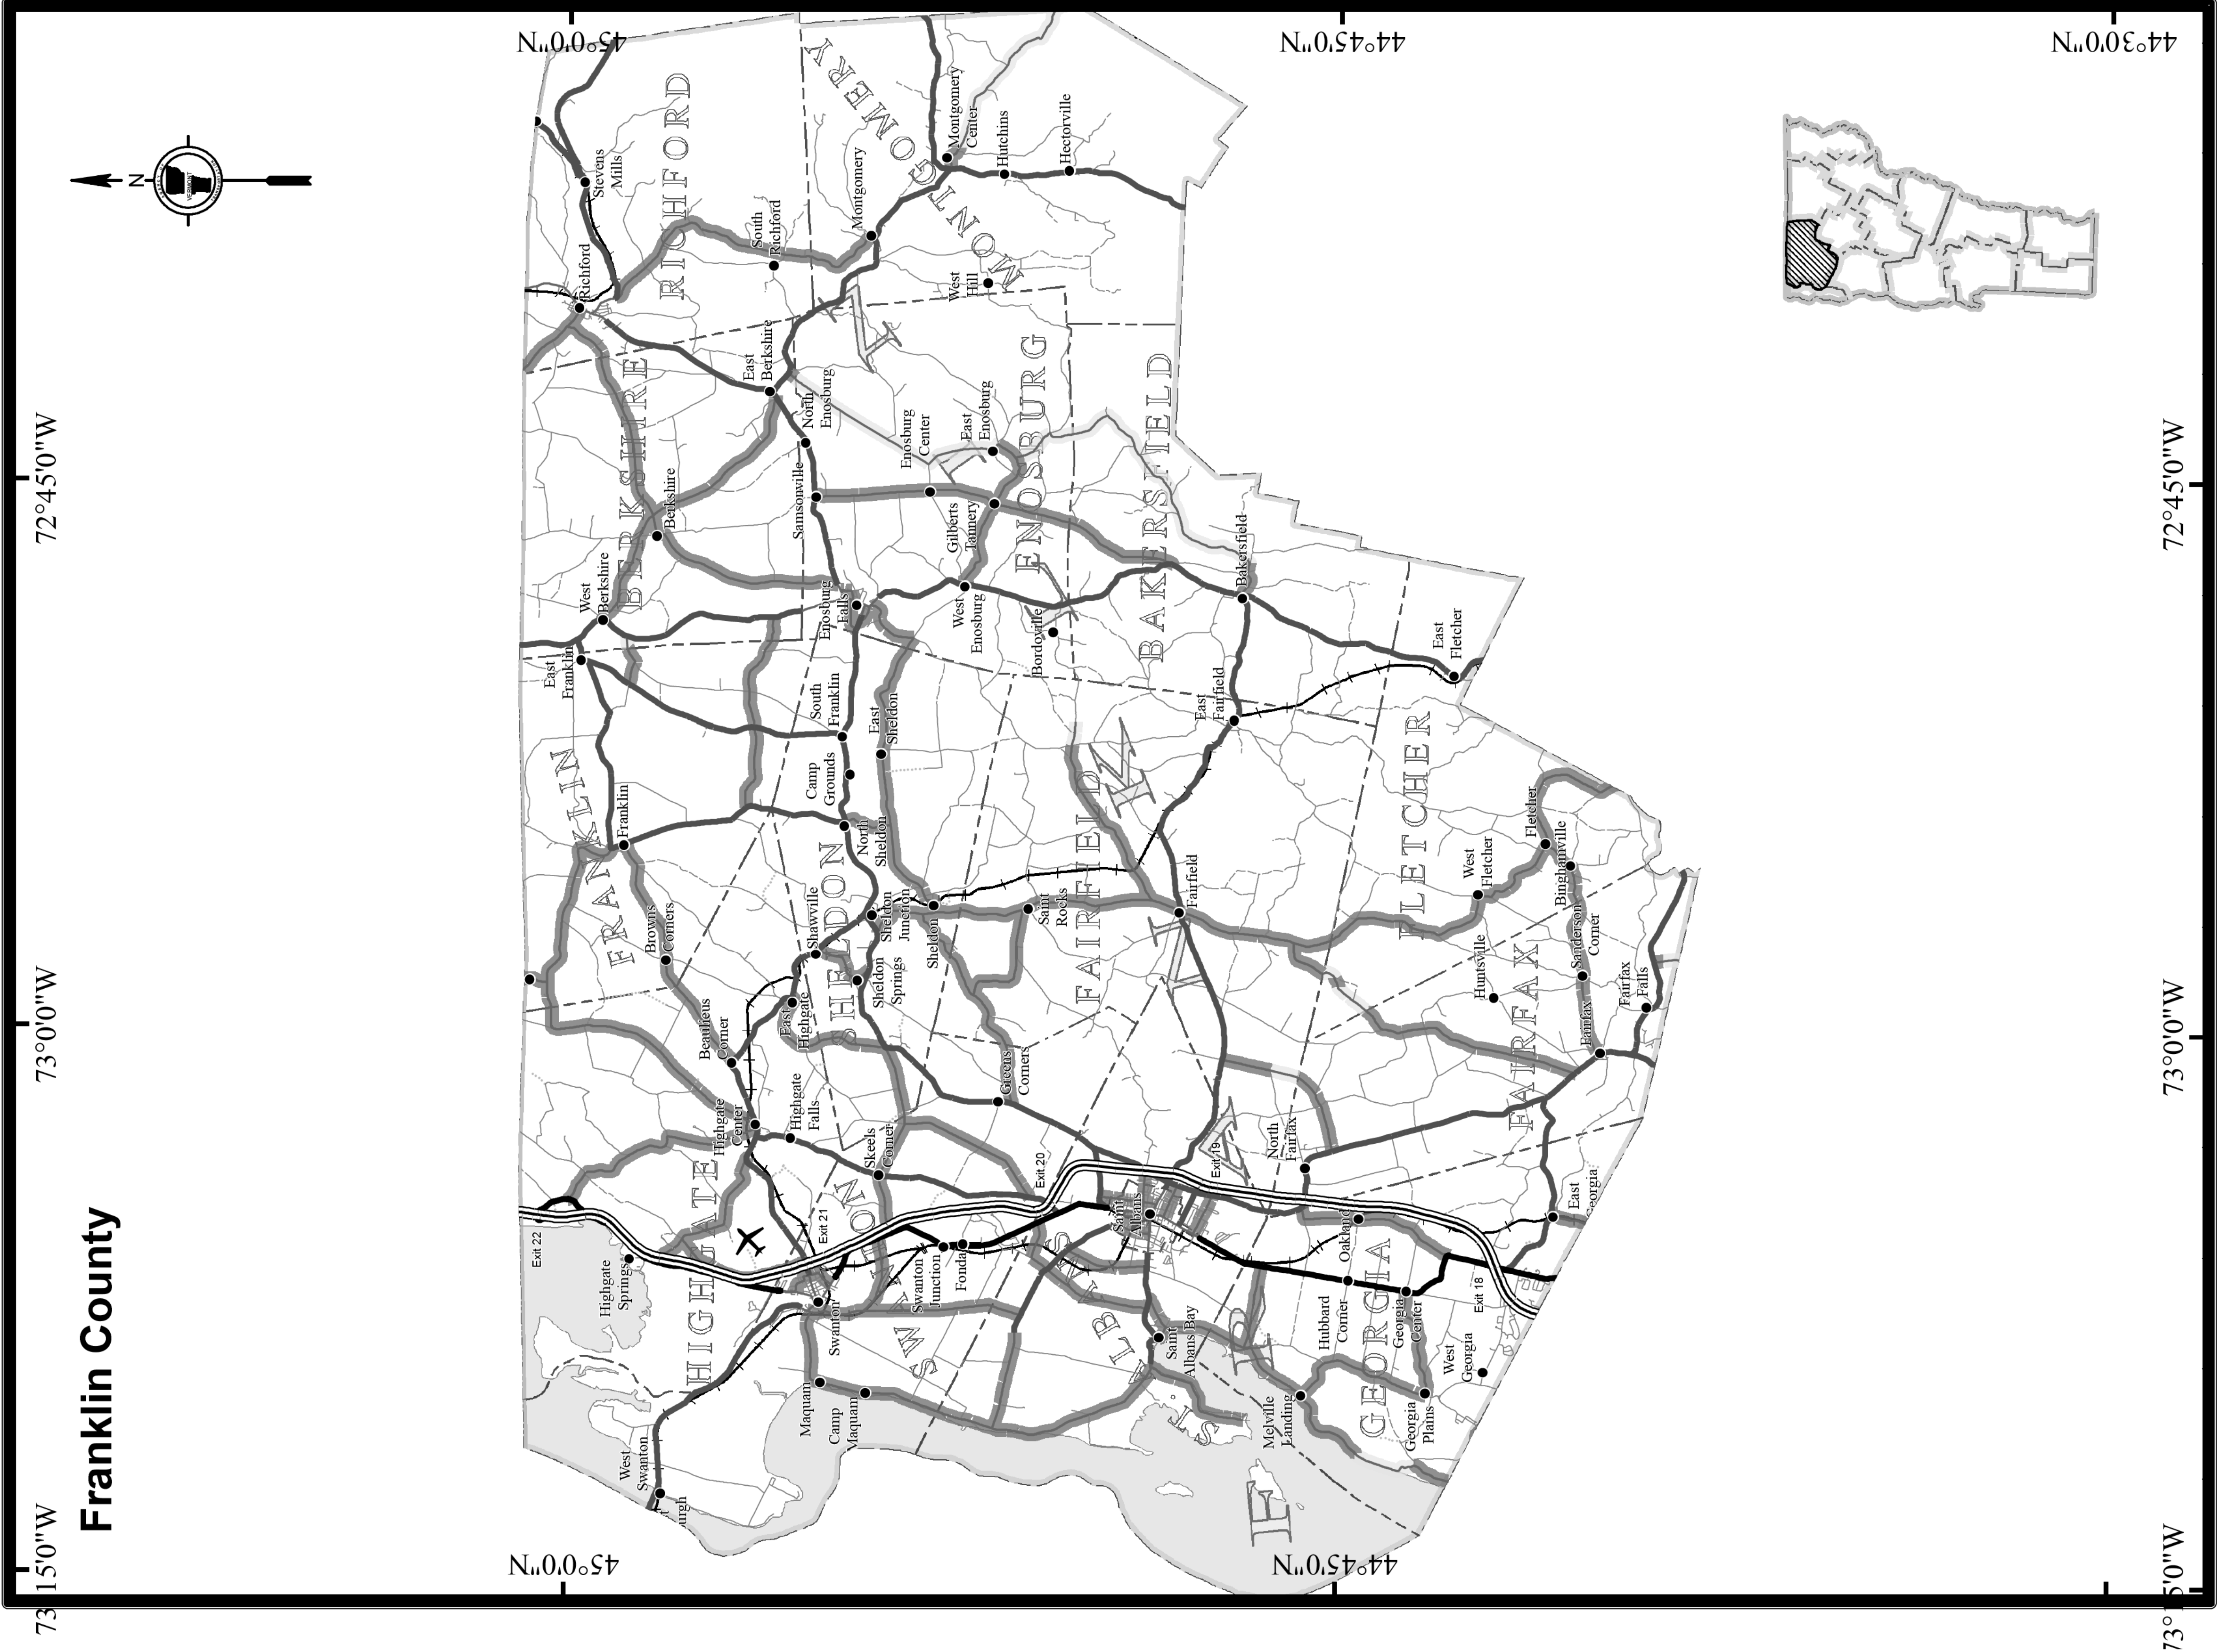


Class 2 Town Highways By Surface
SURFACETYPE

- Paved
- Gravel
- Soil or graded and drained earth

CLASS 2 TOWN HIGHWAYS BY SURFACE TYPE - FRANKLIN COUNTY

NOT TO SCALE

PROJECT NAME:	STATEWIDE
PROJECT NUMBER:	HES MARK(404)
FILE NAME: +14+186.dgn	PLOT DATE: 1/29/2015
PROJECT LEADER: P. COBURN	DRAWN BY: K. RECORD
DESIGNED BY: K. SWEET	CHECKED BY: I. DEGUTIS
TOWN HIGHWAY COUNTY MAP SHEET 6	SHEET 48 OF 56

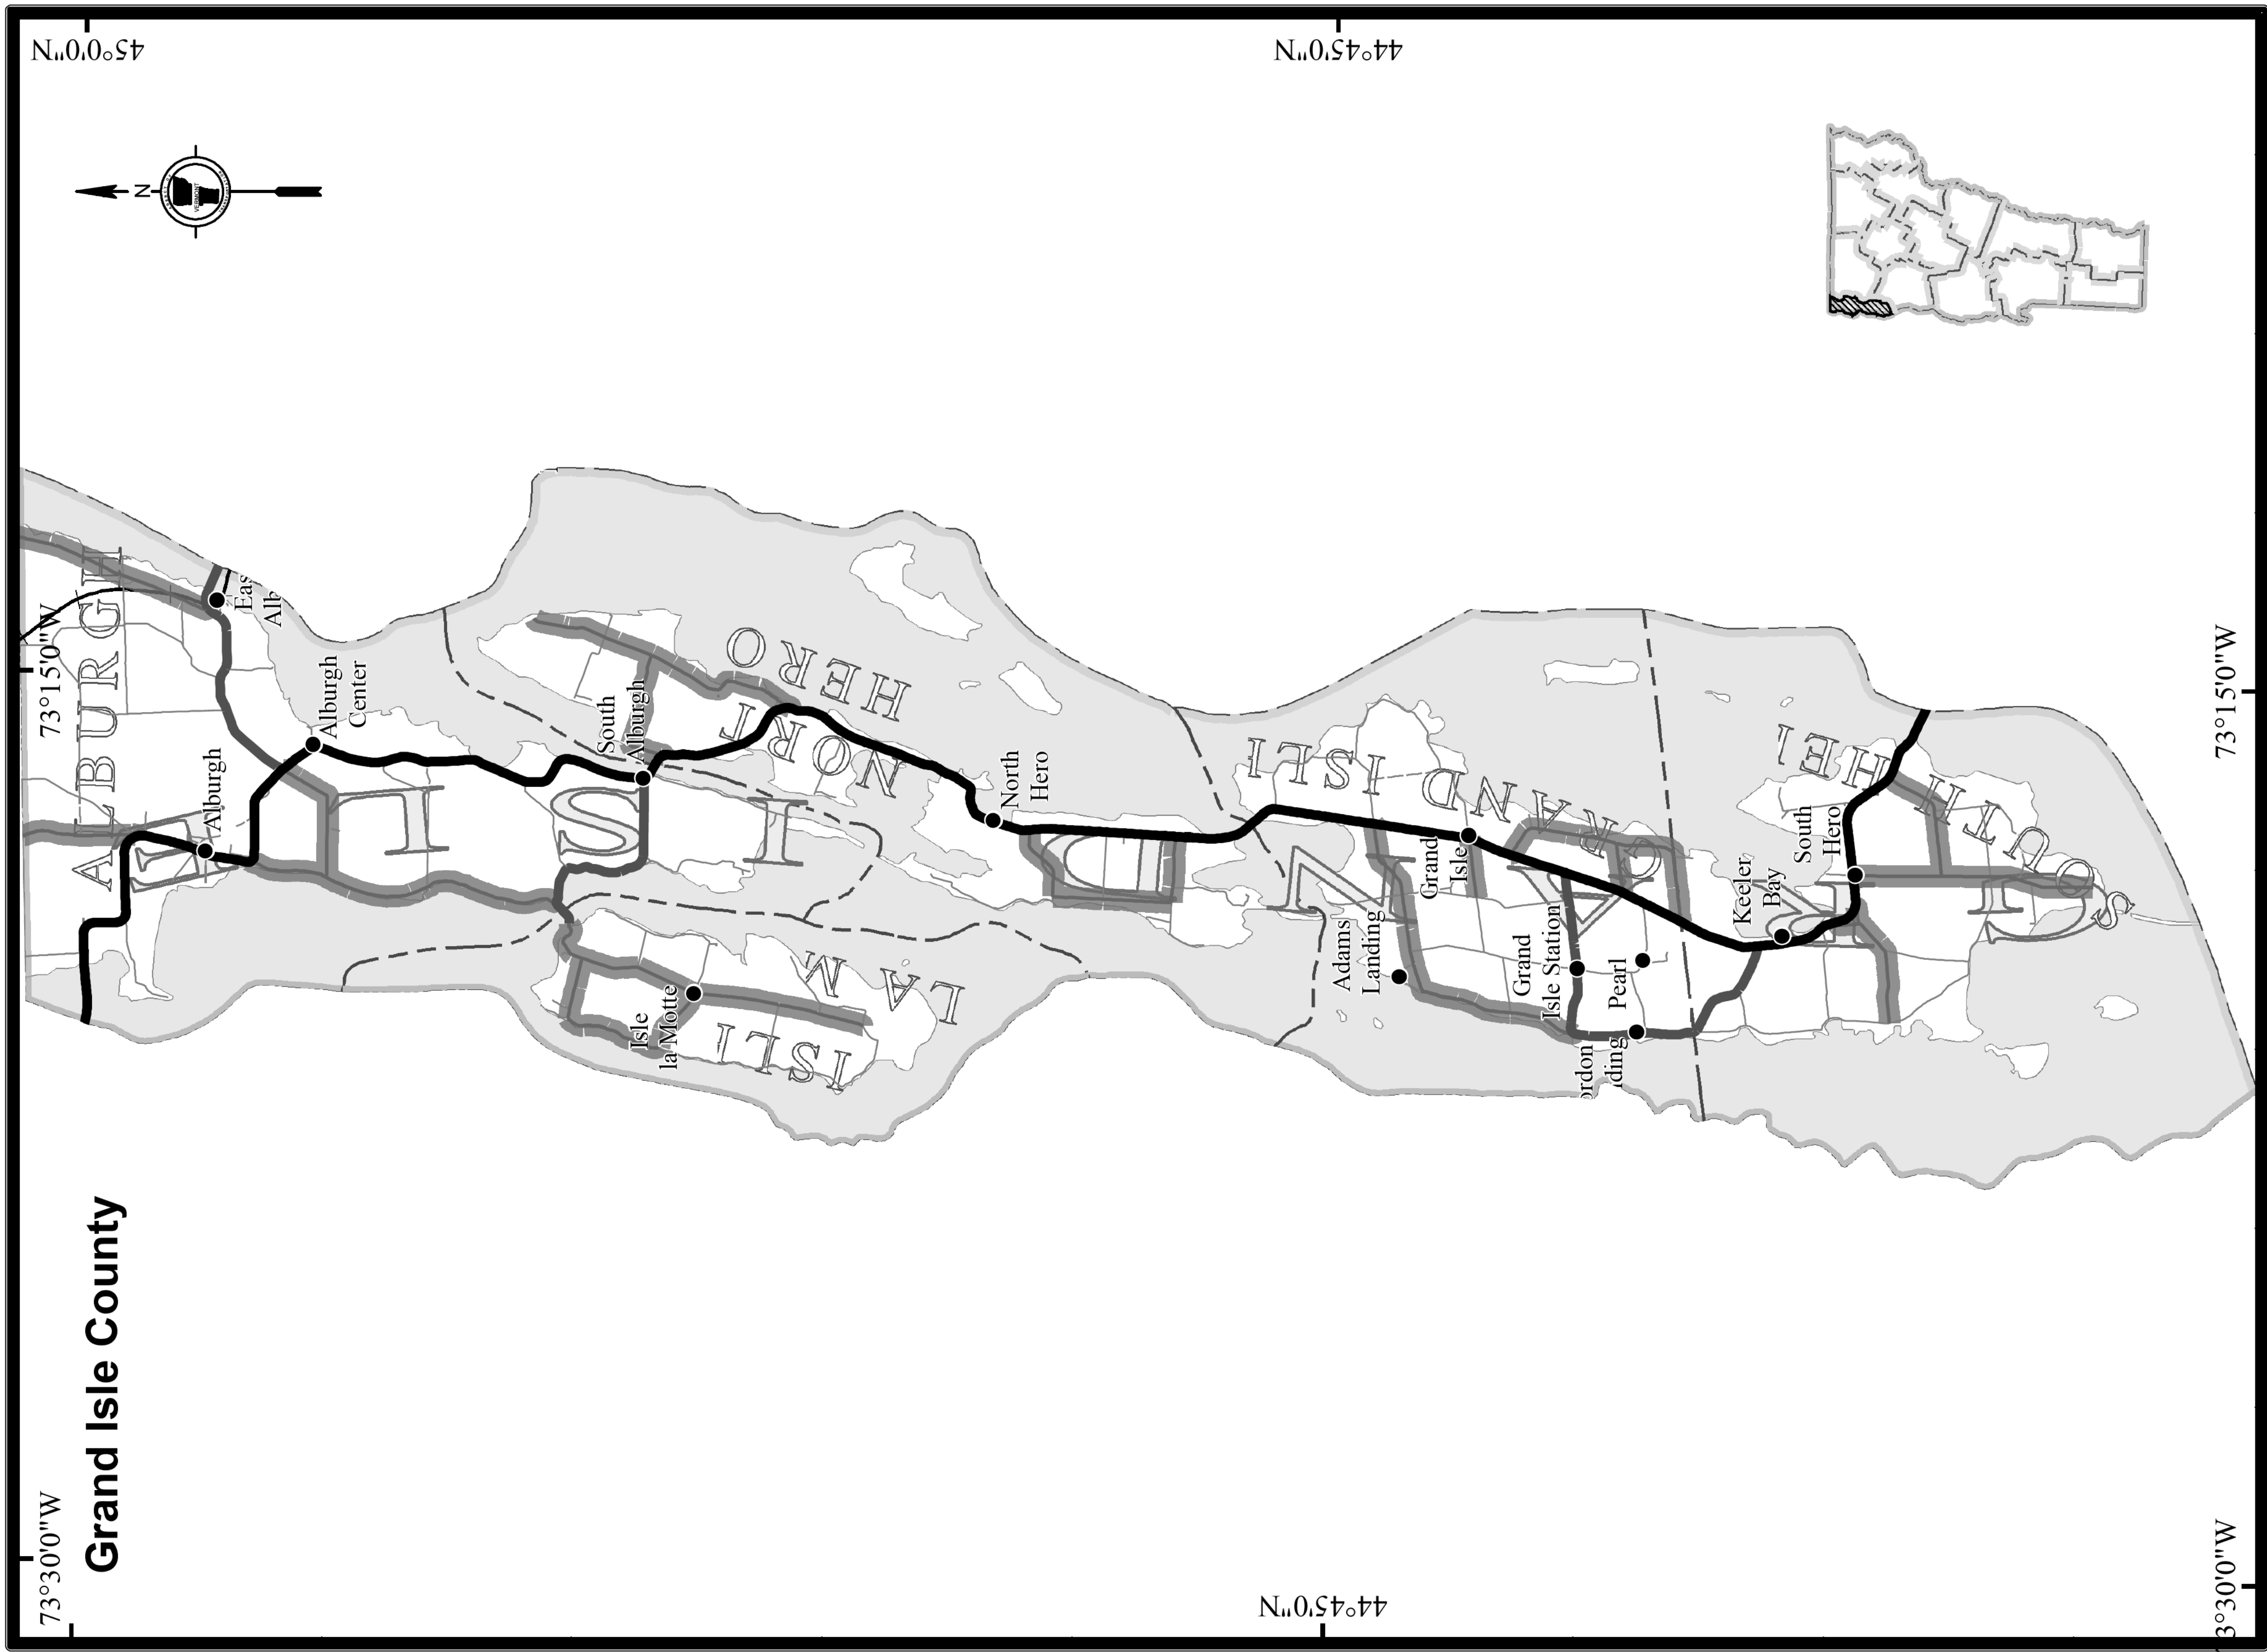


Class 2 Town Highways By Surface
SURFACETYPE

■	Paved
■	Gravel
■	Soil or graded and drained earth

CLASS 2 TOWN HIGHWAY BY SURFACE TYPE - GRAND ISLE COUNTY

NOT TO SCALE

PROJECT NAME:	STATEWIDE
PROJECT NUMBER:	HES MARK(404)
FILE NAME: +14+186.dgn	PLOT DATE: 1/29/2015
PROJECT LEADER: P. COBURN	DRAWN BY: K. RECORD
DESIGNED BY: K. SWEET	CHECKED BY: I. DEGUTIS
TOWN HIGHWAY COUNTY MAP SHHET 7	SHEET 49 OF 56

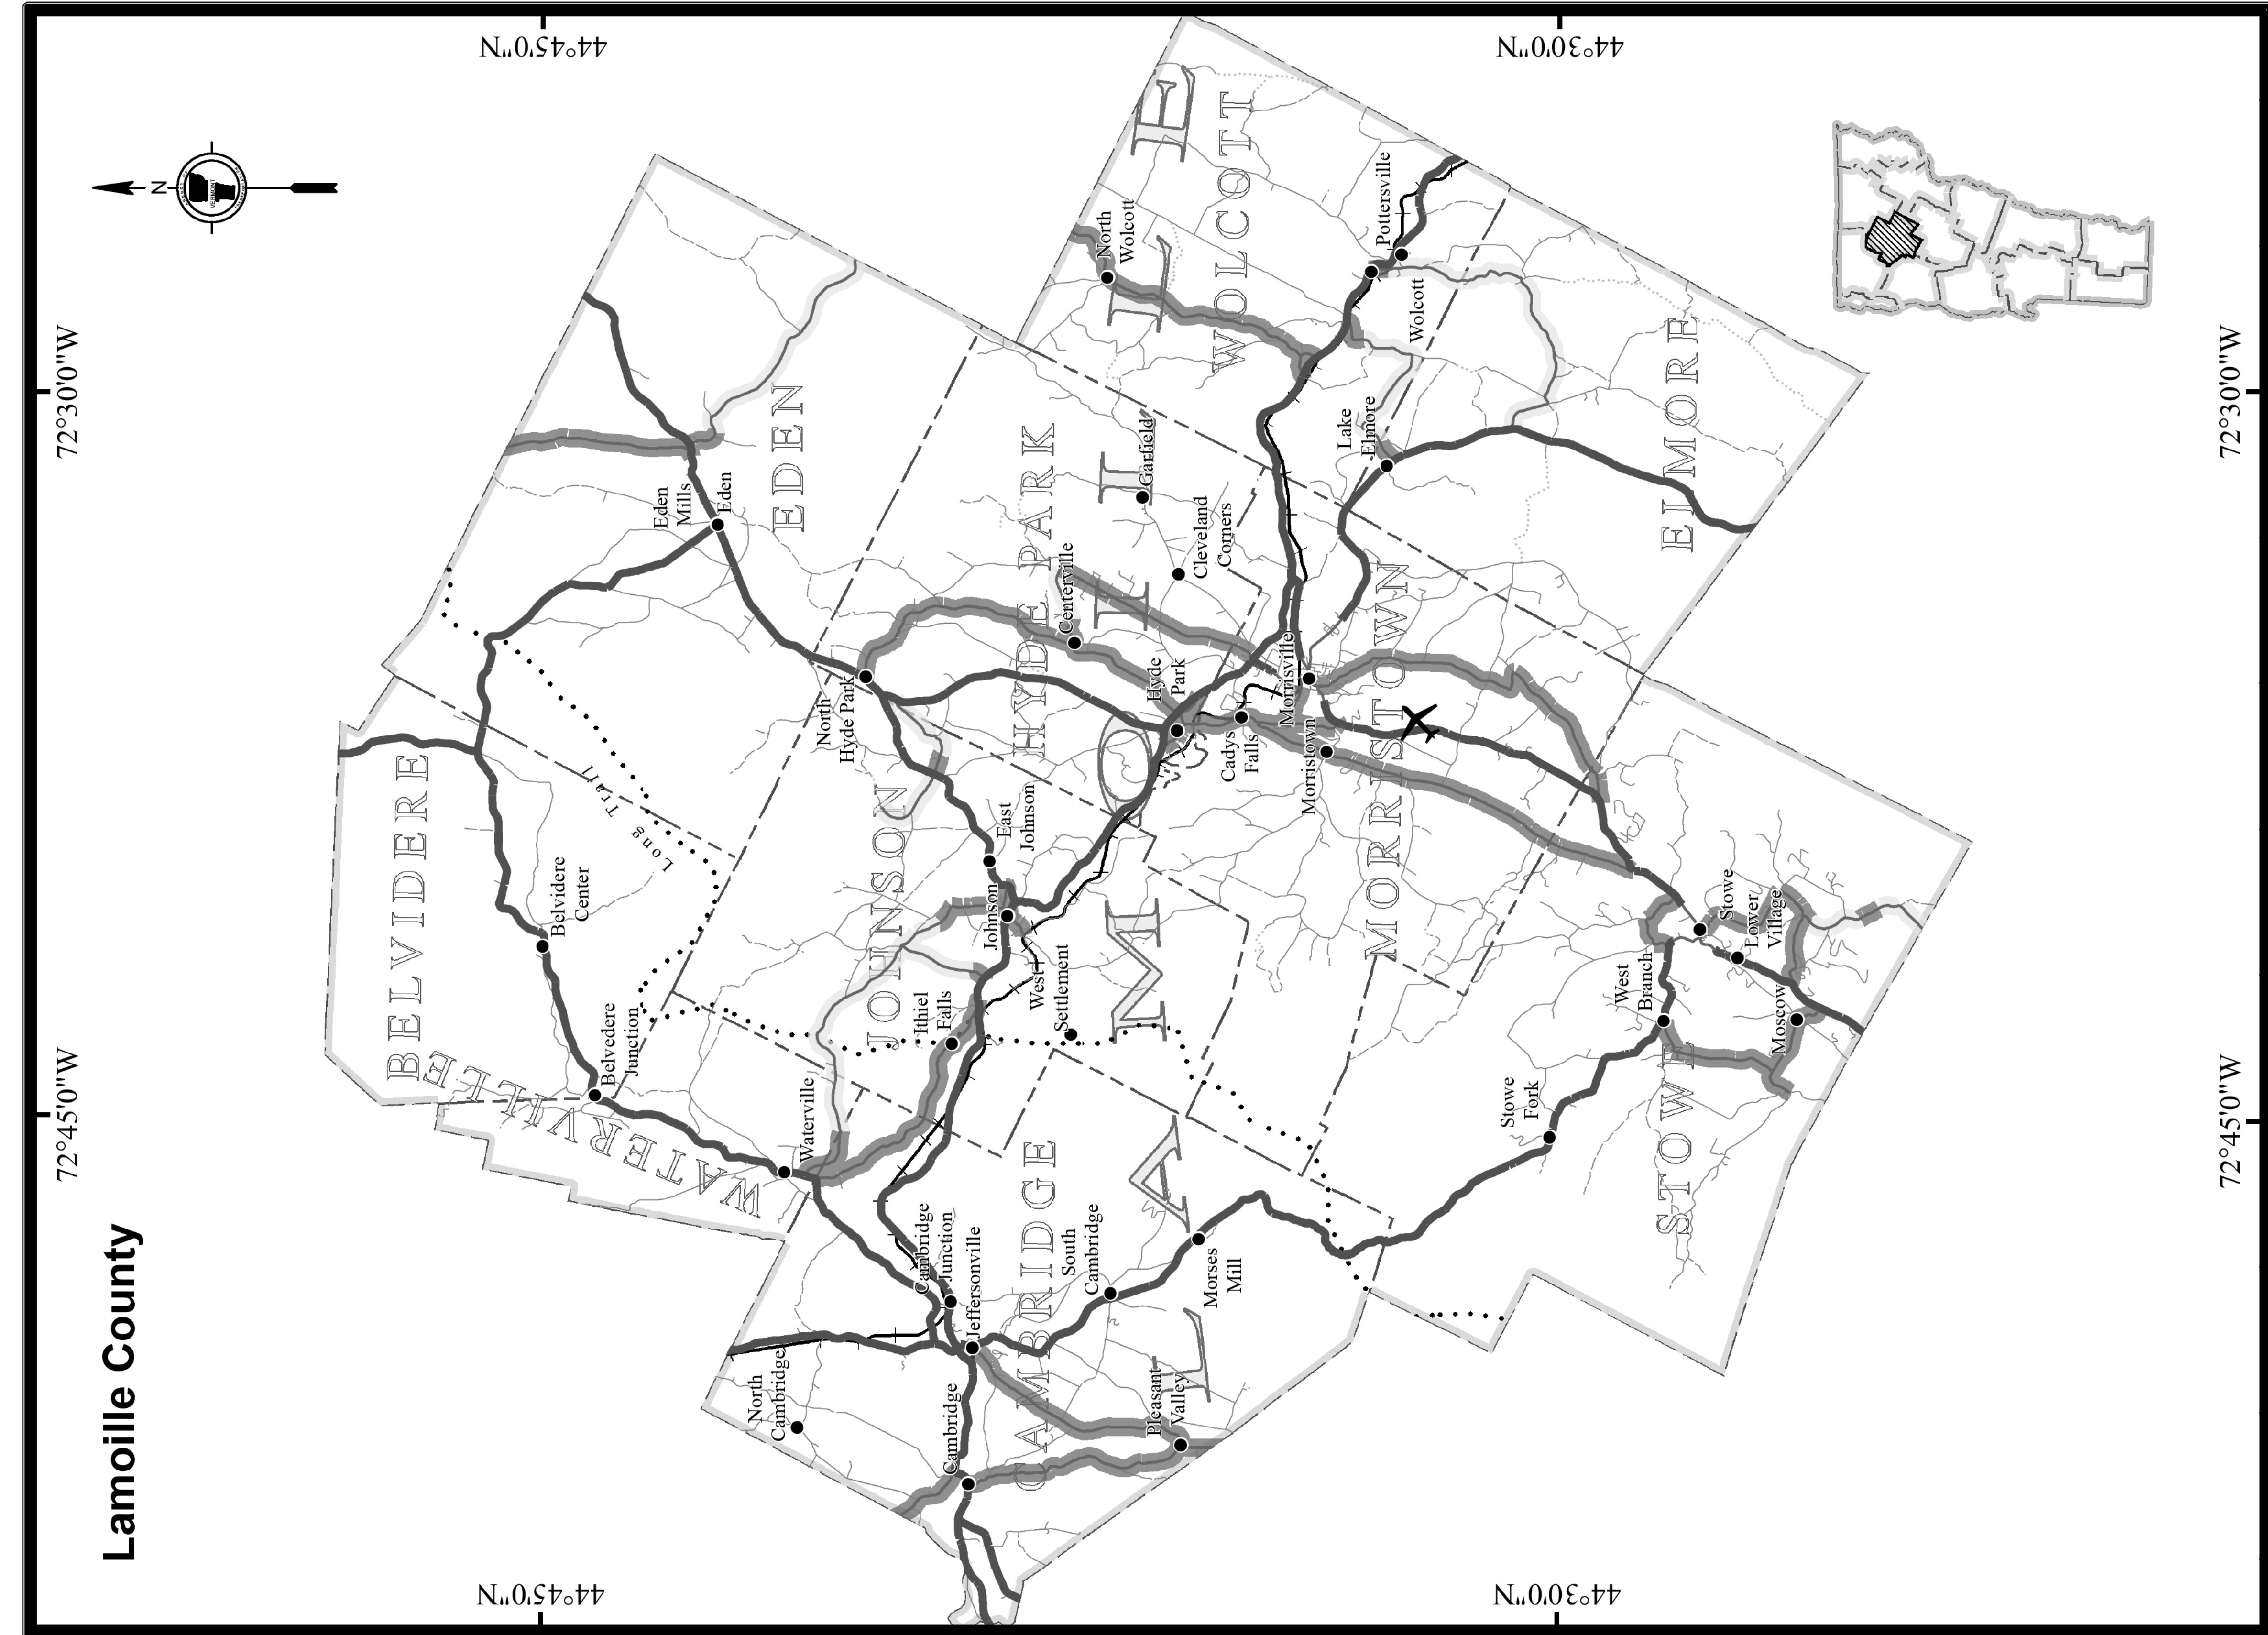


Class 2 Town Highways By Surface
SURFACETYPE

- Paved
- Gravel
- Soil or graded and drained earth

CLASS 2 TOWN HIGHWAYS BY SURFACE TYPE - LAMOILLE COUNTY

NOT TO SCALE

PROJECT NAME:	STATEWIDE
PROJECT NUMBER:	HES MARK(404)
FILE NAME: +14+186.dgn	PLOT DATE: 1/29/2015
PROJECT LEADER: P. COBURN	DRAWN BY: K. RECORD
DESIGNED BY: K. SWEET	CHECKED BY: I. DEGUTIS
TOWN HIGHWAY COUNTY MAP SHEET 8	SHEET 50 OF 56

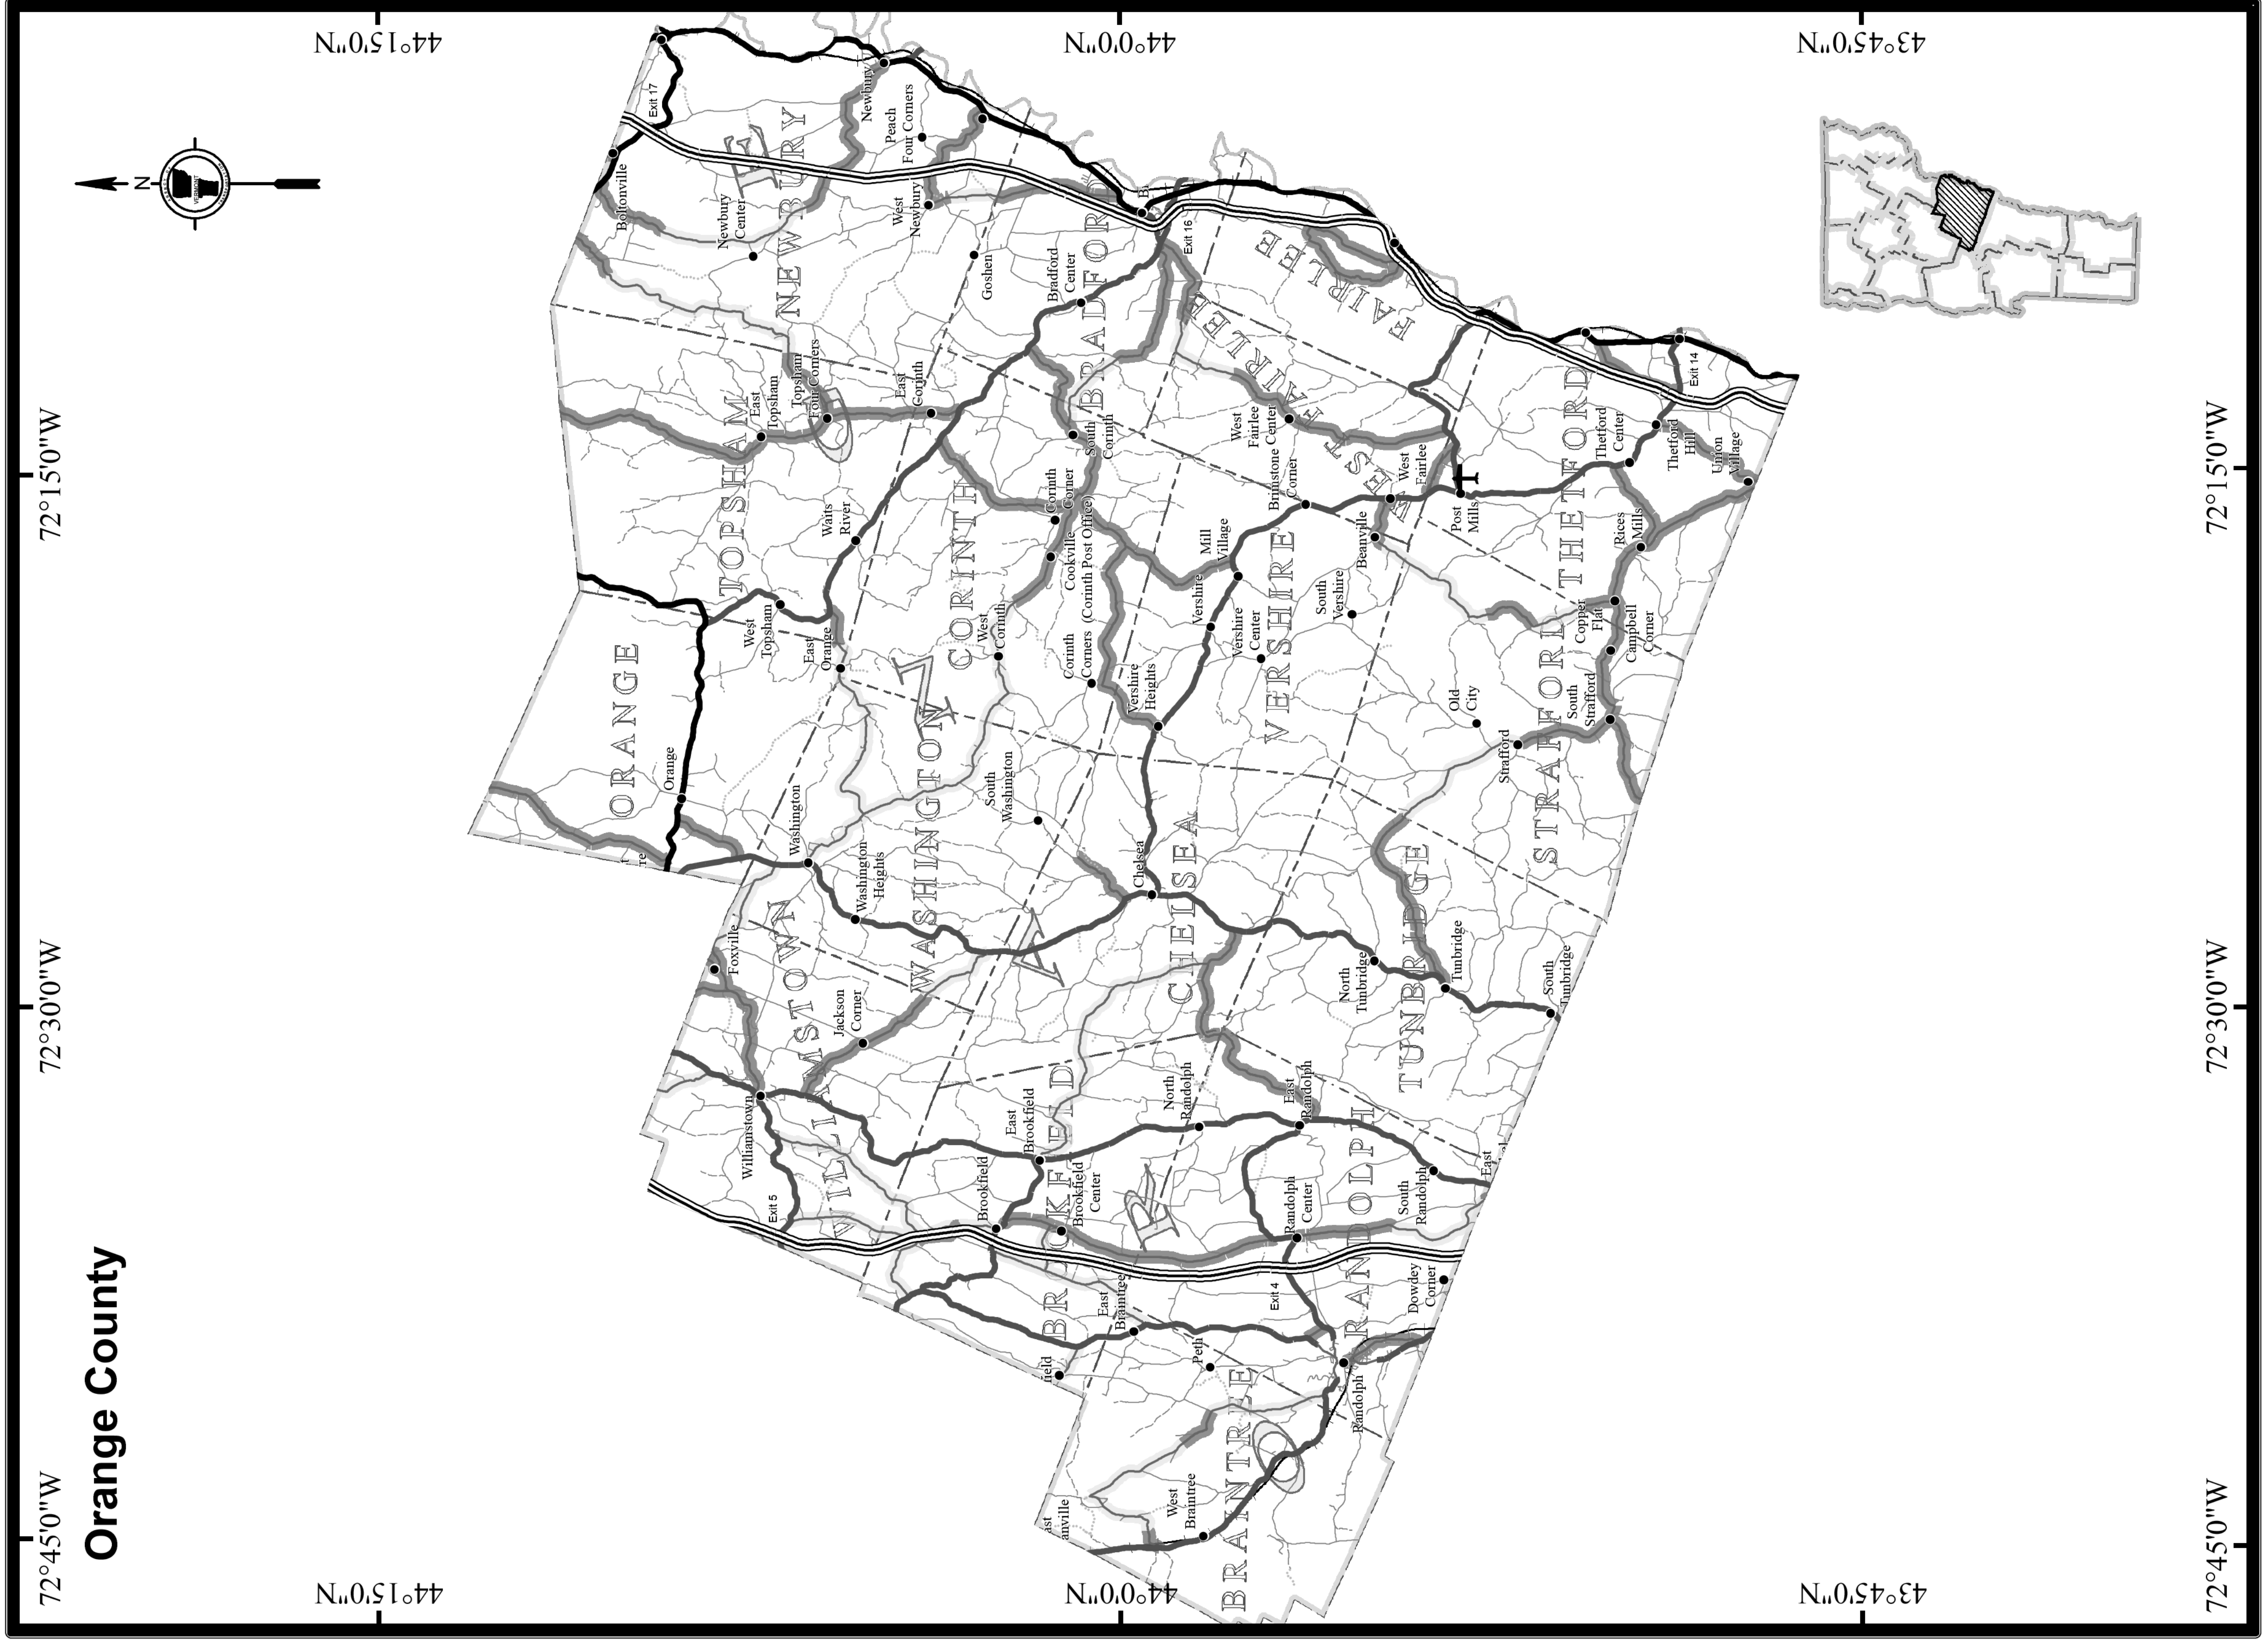


Class 2 Town Highways By Surface
SURFACETYPE

	Paved
	Gravel
	Soil or graded and drained earth

CLASS 2 TOWN HIGHWAYS BY SURFACE TYPE - ORANGE COUNTY

NOT TO SCALE

PROJECT NAME: STATEWIDE	
PROJECT NUMBER: HES MARK(404)	
FILE NAME: +14+186.dgn	PLOT DATE: 1/29/2015
PROJECT LEADER: P. COBURN	DRAWN BY: K. RECORD
DESIGNED BY: K. SWEET	CHECKED BY: I. DEGUTIS
TOWN HIGHWAY COUNTY MAP SHEET 9	SHEET 51 OF 56

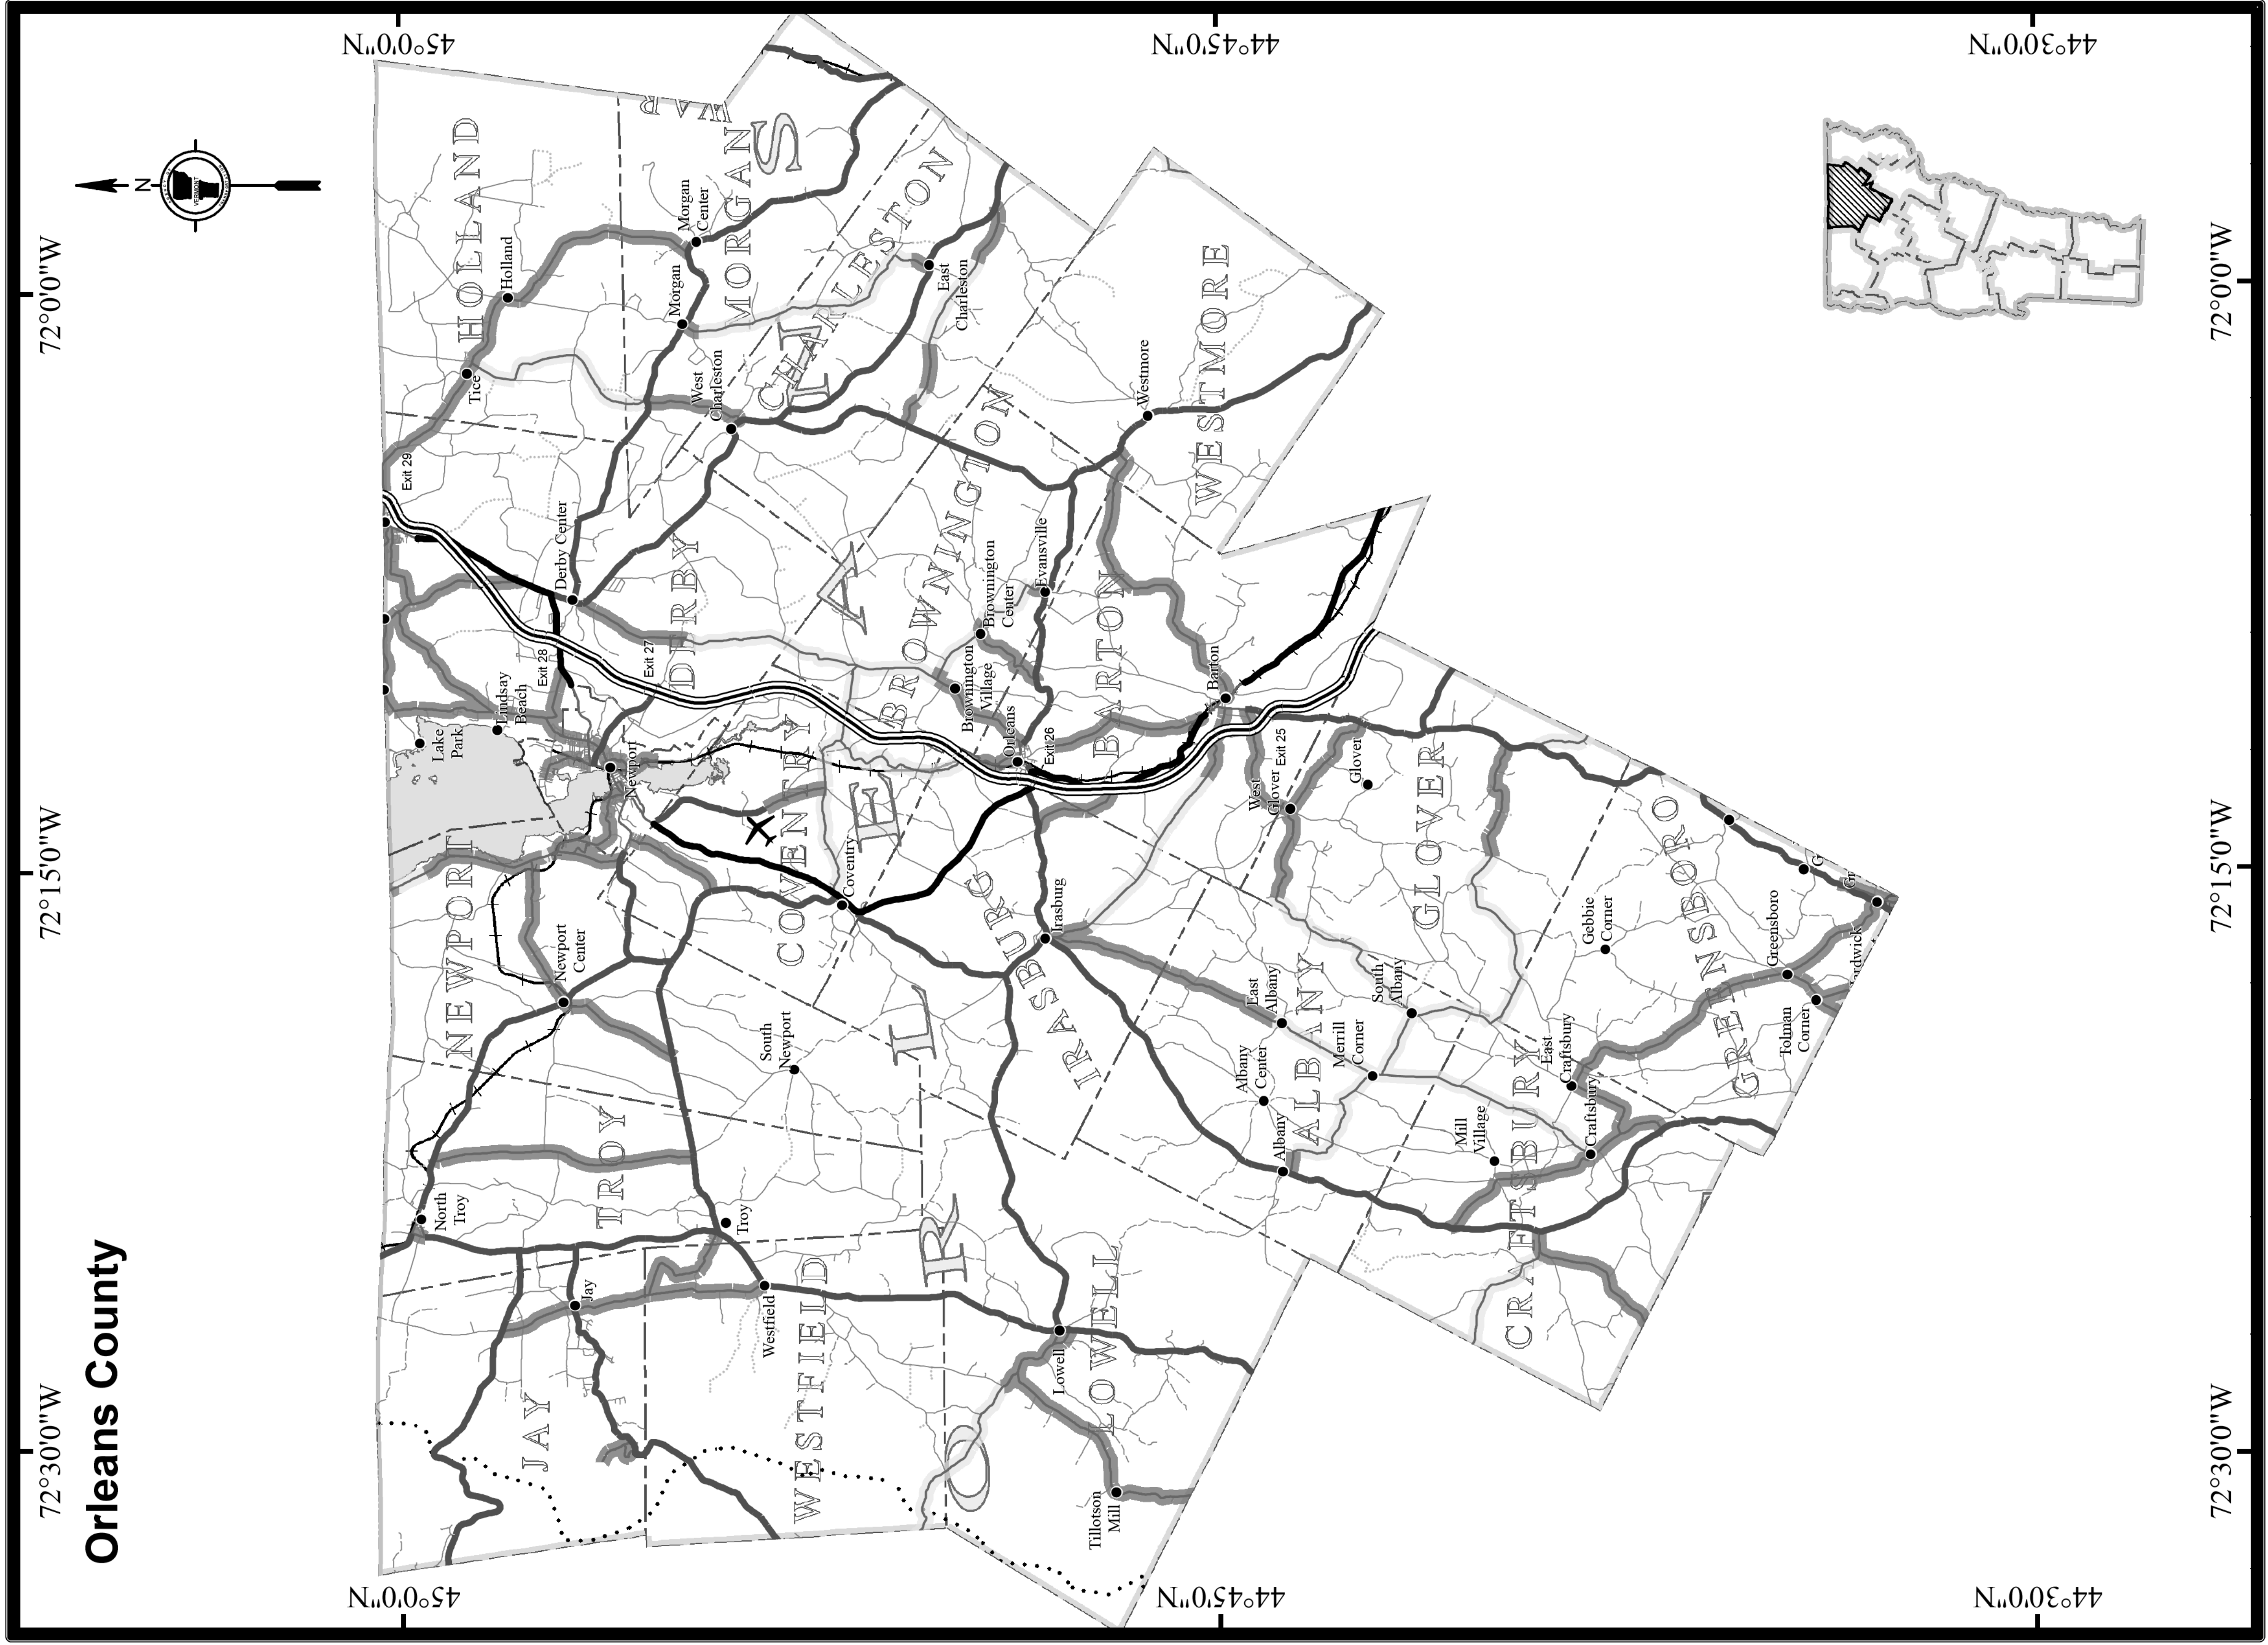


Class 2 Town Highways By Surface
SURFACETYPE

	Paved
	Gravel
	Soil or graded and drained earth

CLASS 2 TOWN HIGHWAYS BY SURFACE TYPE - ORLEANS COUNTY

NOT TO SCALE

PROJECT NAME:	STATEWIDE
PROJECT NUMBER:	HES MARK(404)
FILE NAME: +14+186.dgn	PLOT DATE: 1/29/2015
PROJECT LEADER: P. COBURN	DRAWN BY: K. RECORD
DESIGNED BY: K. SWEET	CHECKED BY: I. DEGUTIS
TOWN HIGHWAY COUNTY MAP SHEET 10	SHEET 52 OF 56

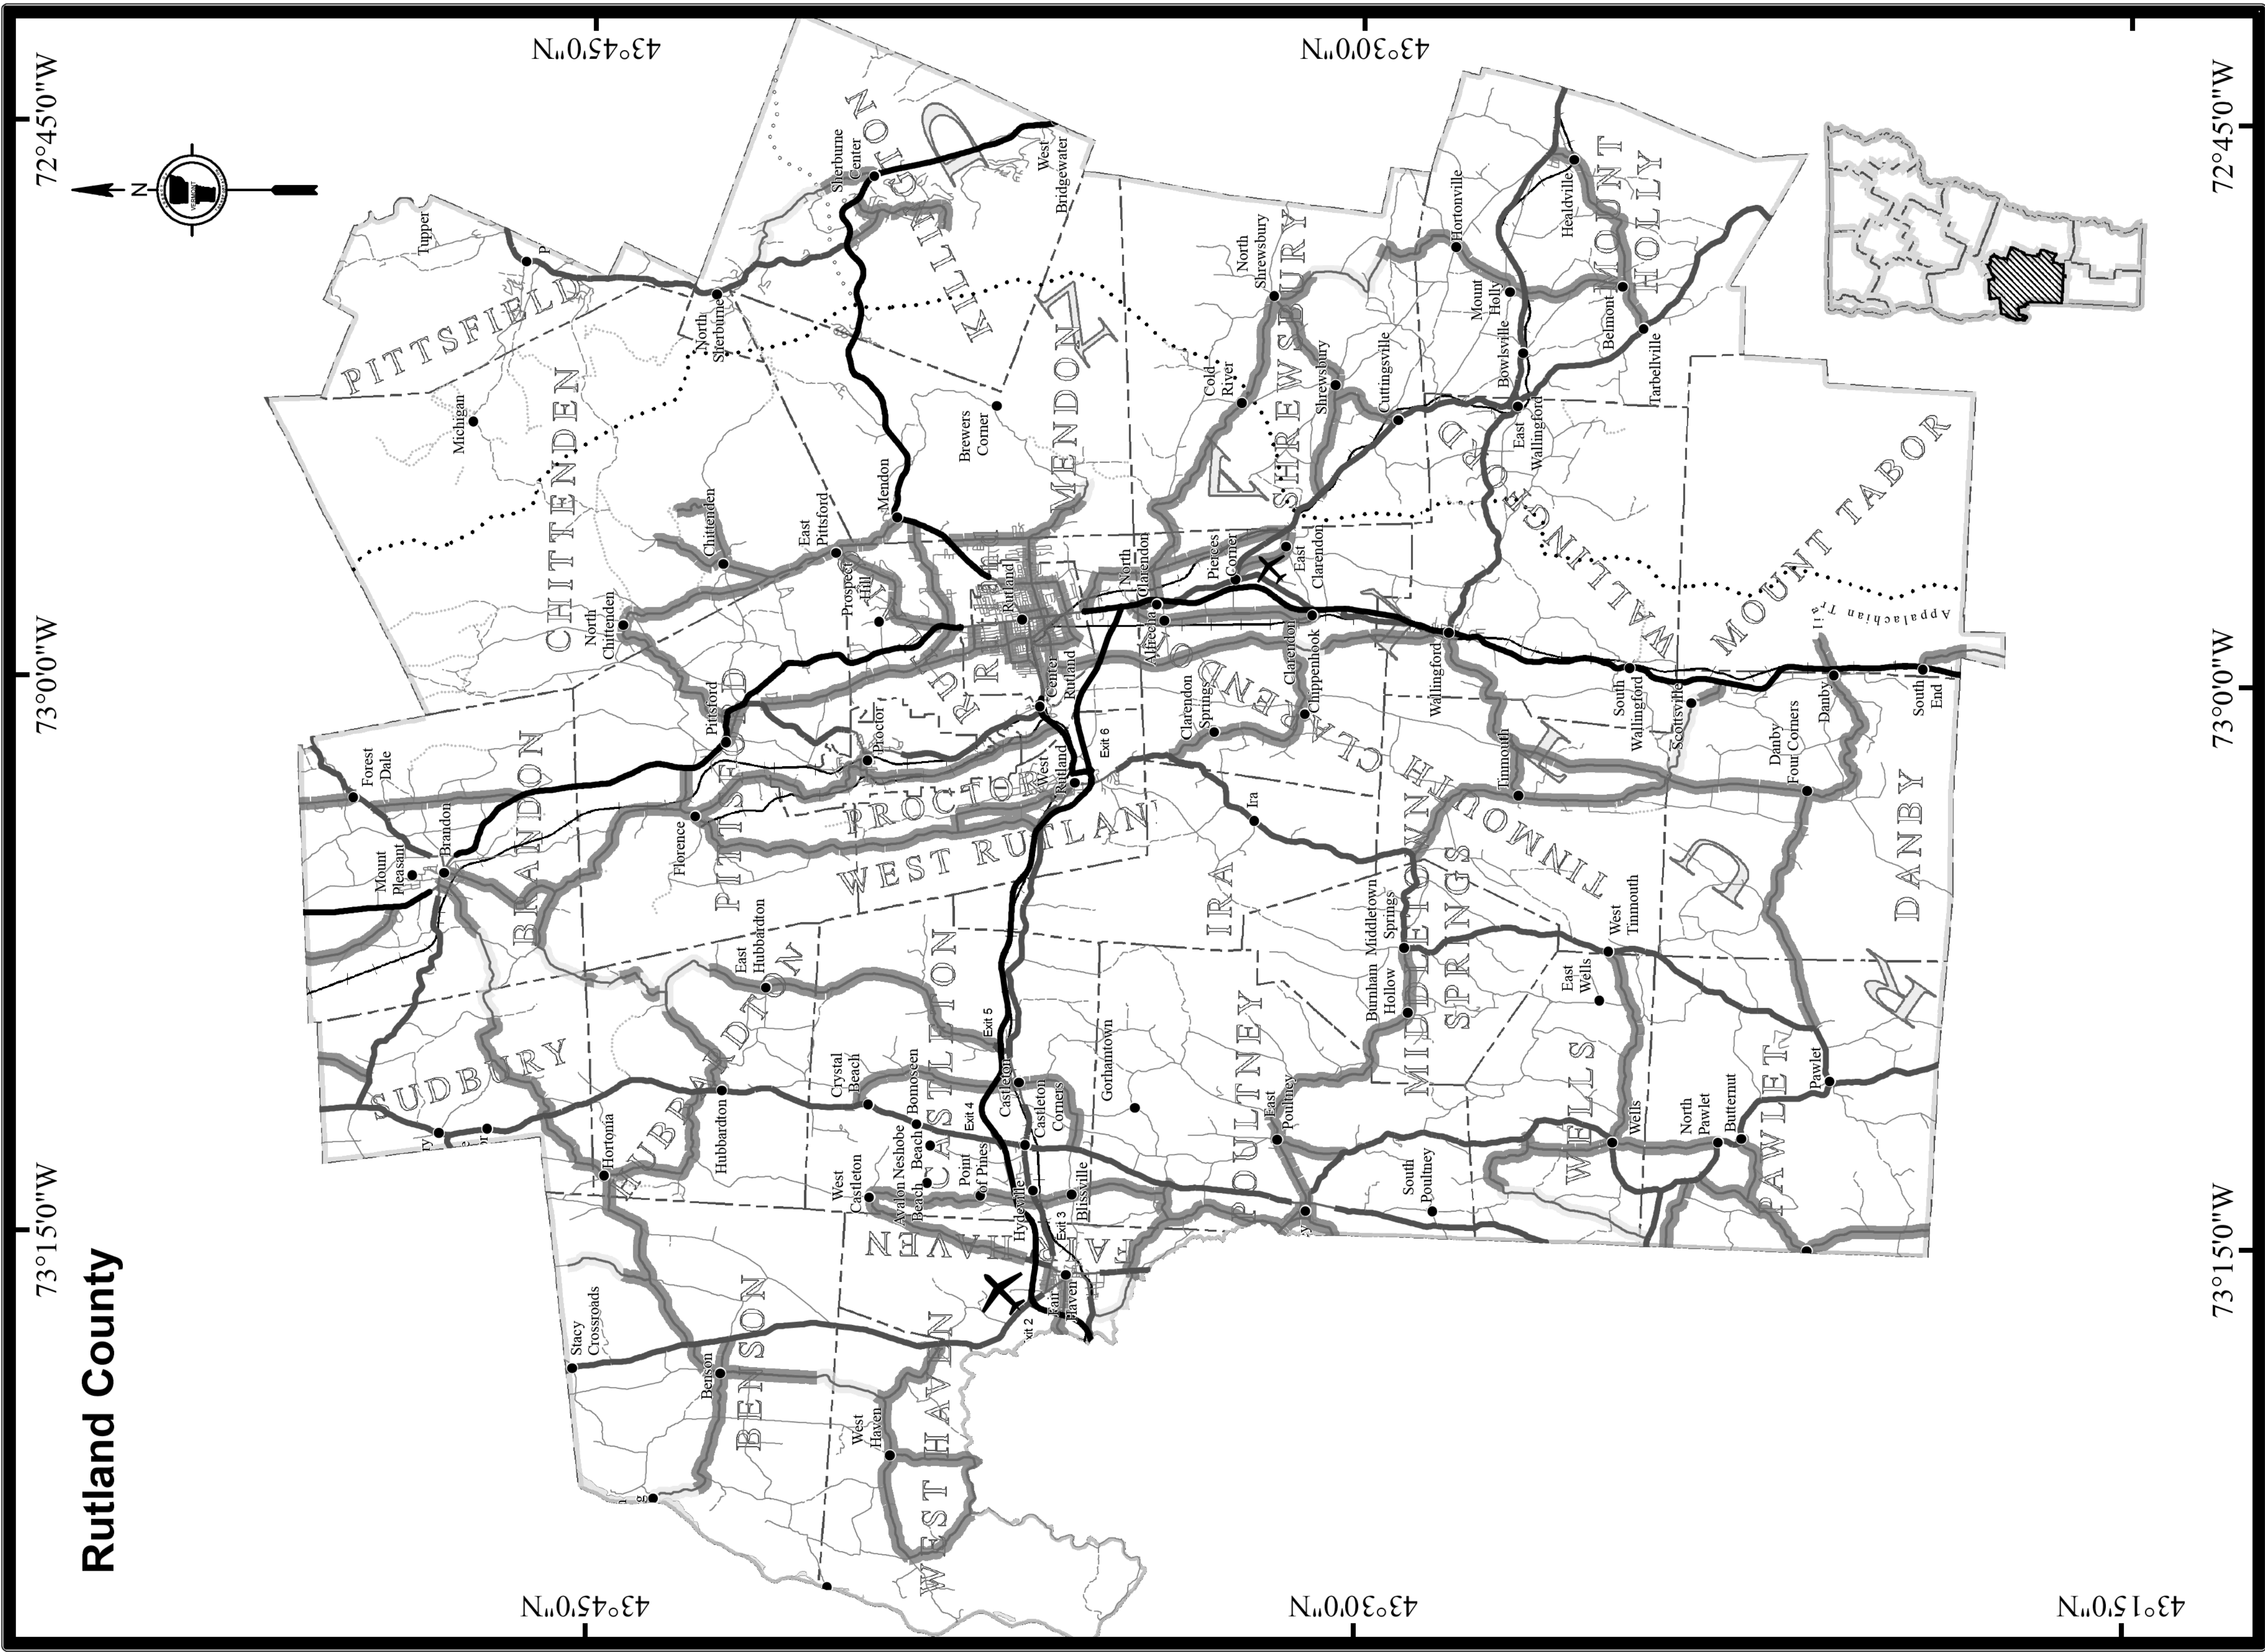


Class 2 Town Highways By Surface
SURFACETYPE

Dark Grey	Paved
Light Grey	Gravel
Medium Grey	Soil or graded and drained earth

CLASS 2 TOWN HIGHWAYS BY SURFACE TYPE - RUTLAND COUNTY

NOT TO SCALE

PROJECT NAME:	STATEWIDE
PROJECT NUMBER:	HES MARK(404)
FILE NAME: +14+186.dgn	PLOT DATE: 1/29/2015
PROJECT LEADER: P. COBURN	DRAWN BY: K. RECORD
DESIGNED BY: K. SWEET	CHECKED BY: I. DEGUTIS
TOWN HIGHWAY COUNTY MAP SHEET II	SHEET 53 OF 56

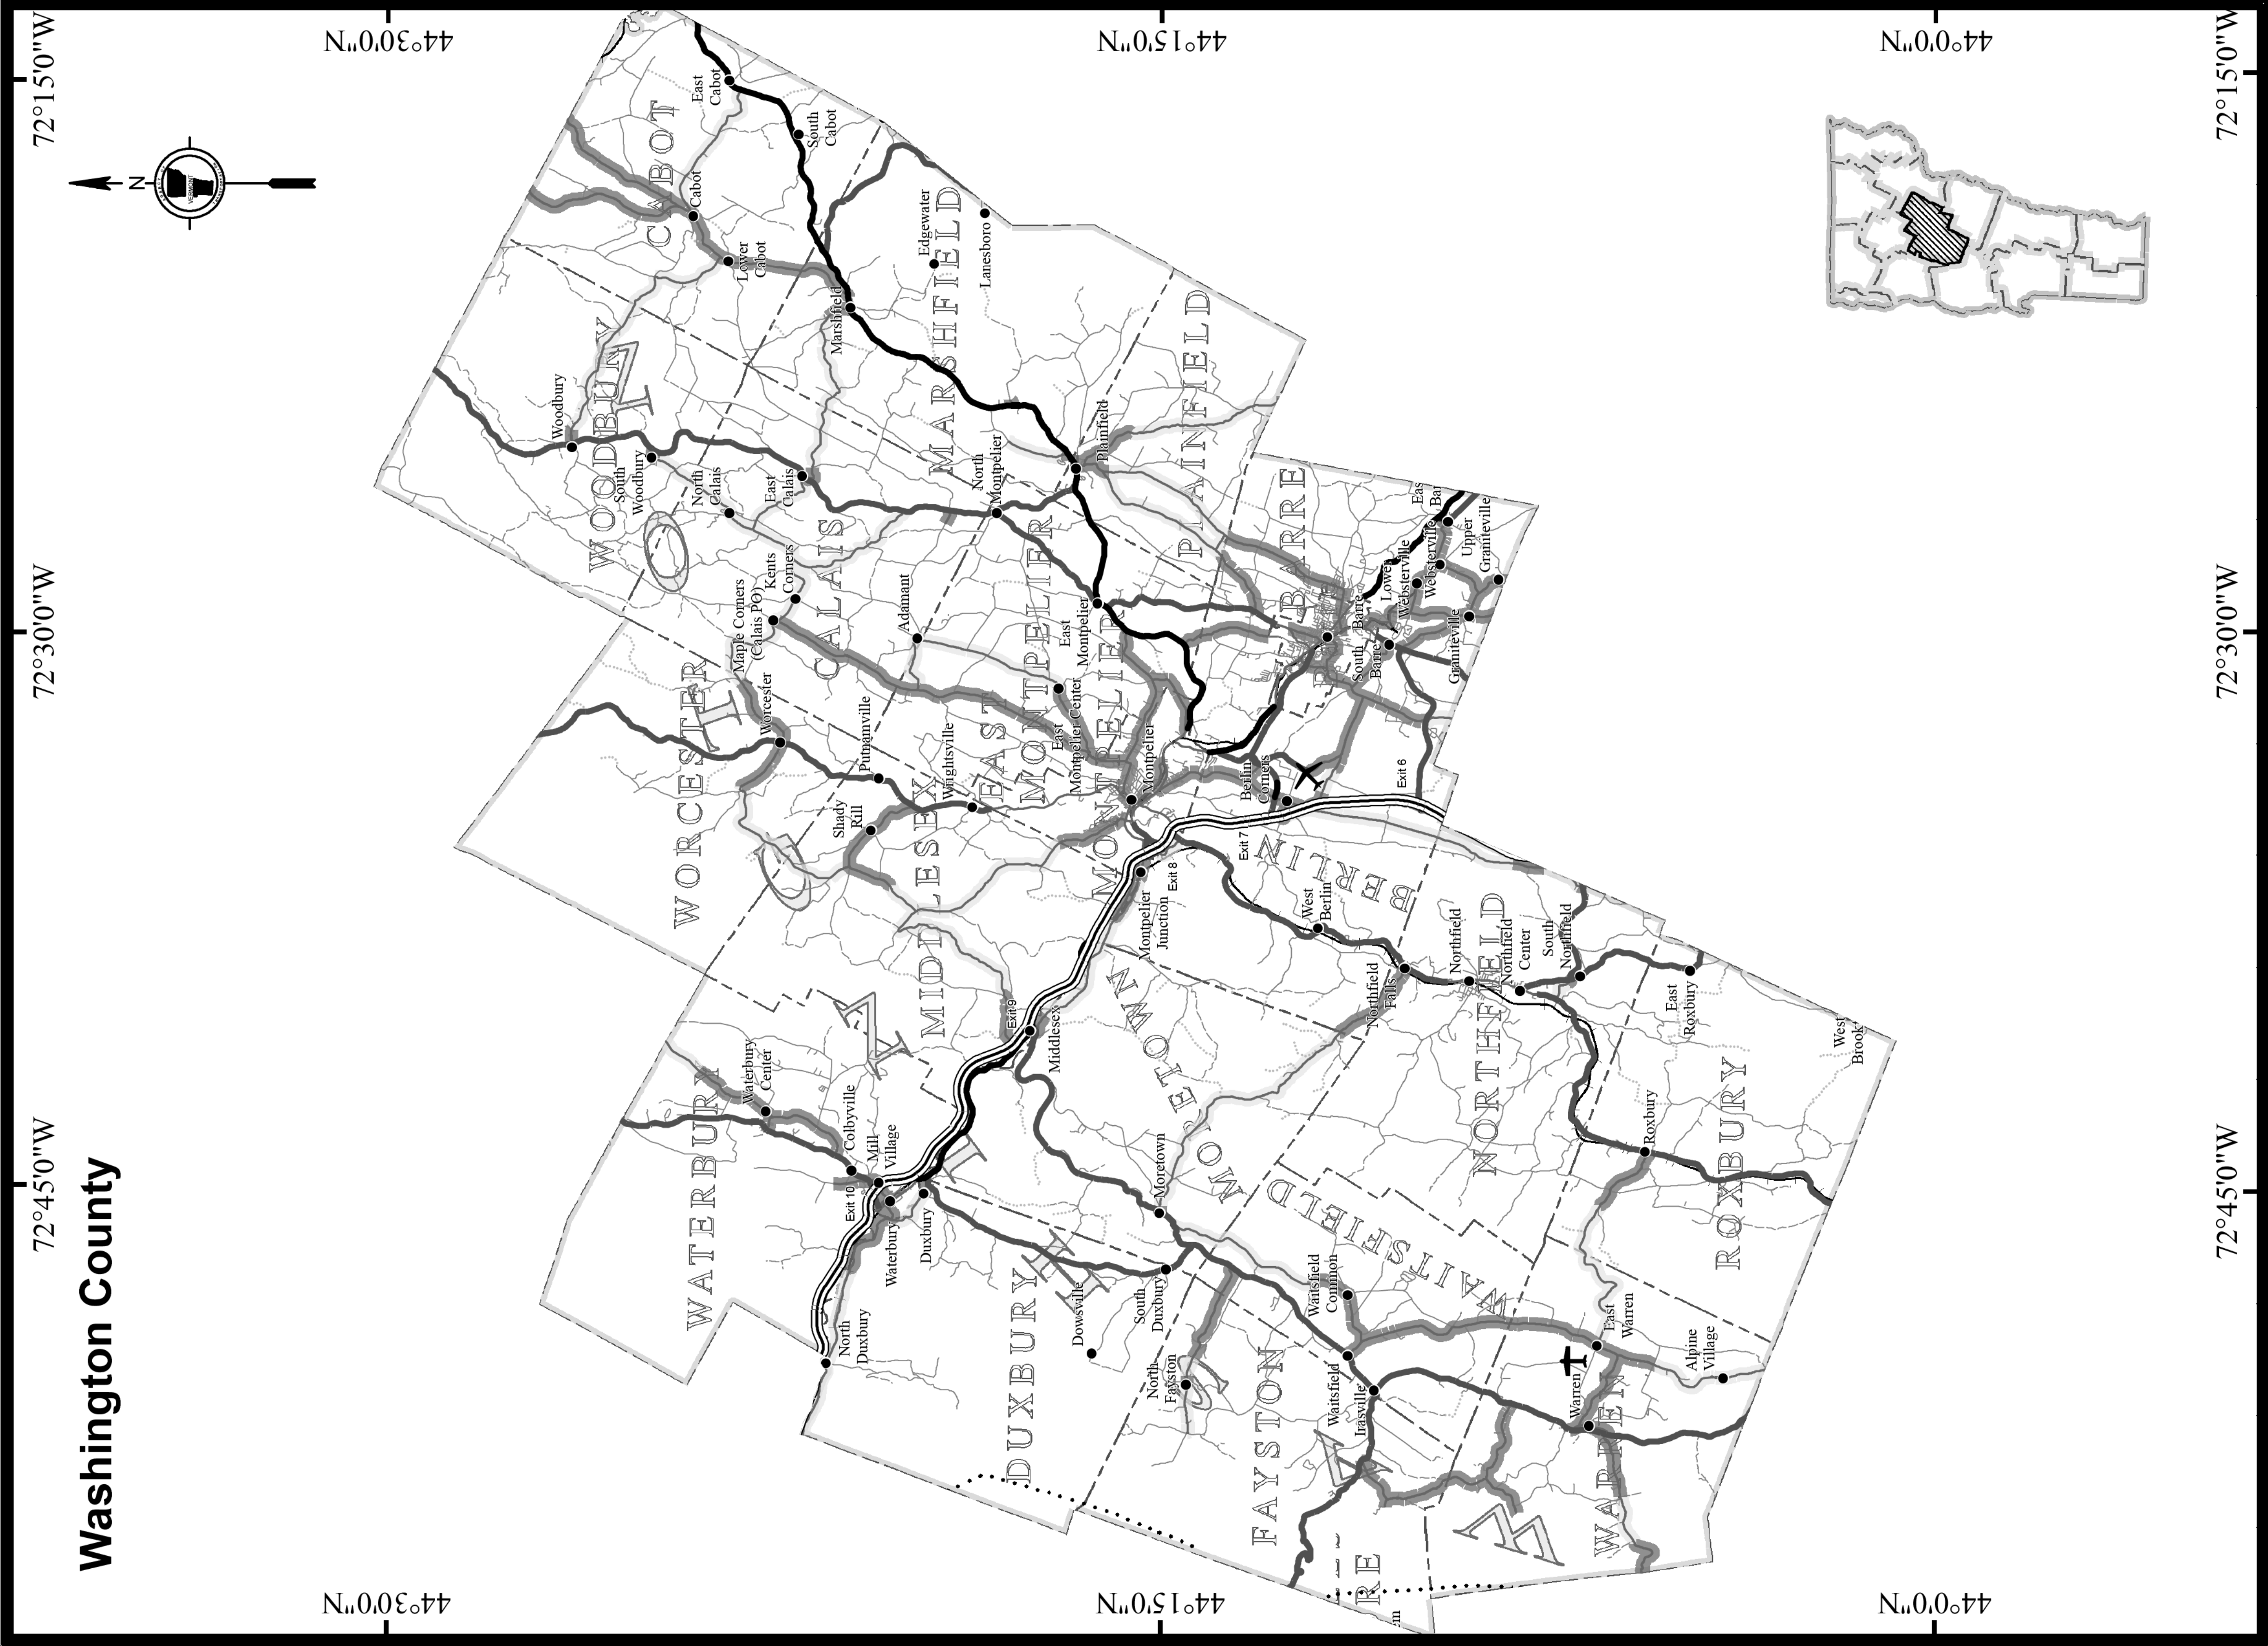


Class 2 Town Highways By Surface
SURFACETYPE

	Paved
	Gravel
	Soil or graded and drained earth

CLASS 2 TOWN HIGHWAYS BY SURFACE TYPE - WASHINGTON COUNTY

NOT TO SCALE

PROJECT NAME:	STATEWIDE
PROJECT NUMBER:	HES MARK(404)
FILE NAME: +14+186.dgn	PLOT DATE: 1/29/2015
PROJECT LEADER: P. COBURN	DRAWN BY: K. RECORD
DESIGNED BY: K. SWEET	CHECKED BY: I. DEGUTIS
TOWN HIGHWAY COUNTY MAP SHEET 12	SHEET 54 OF 56

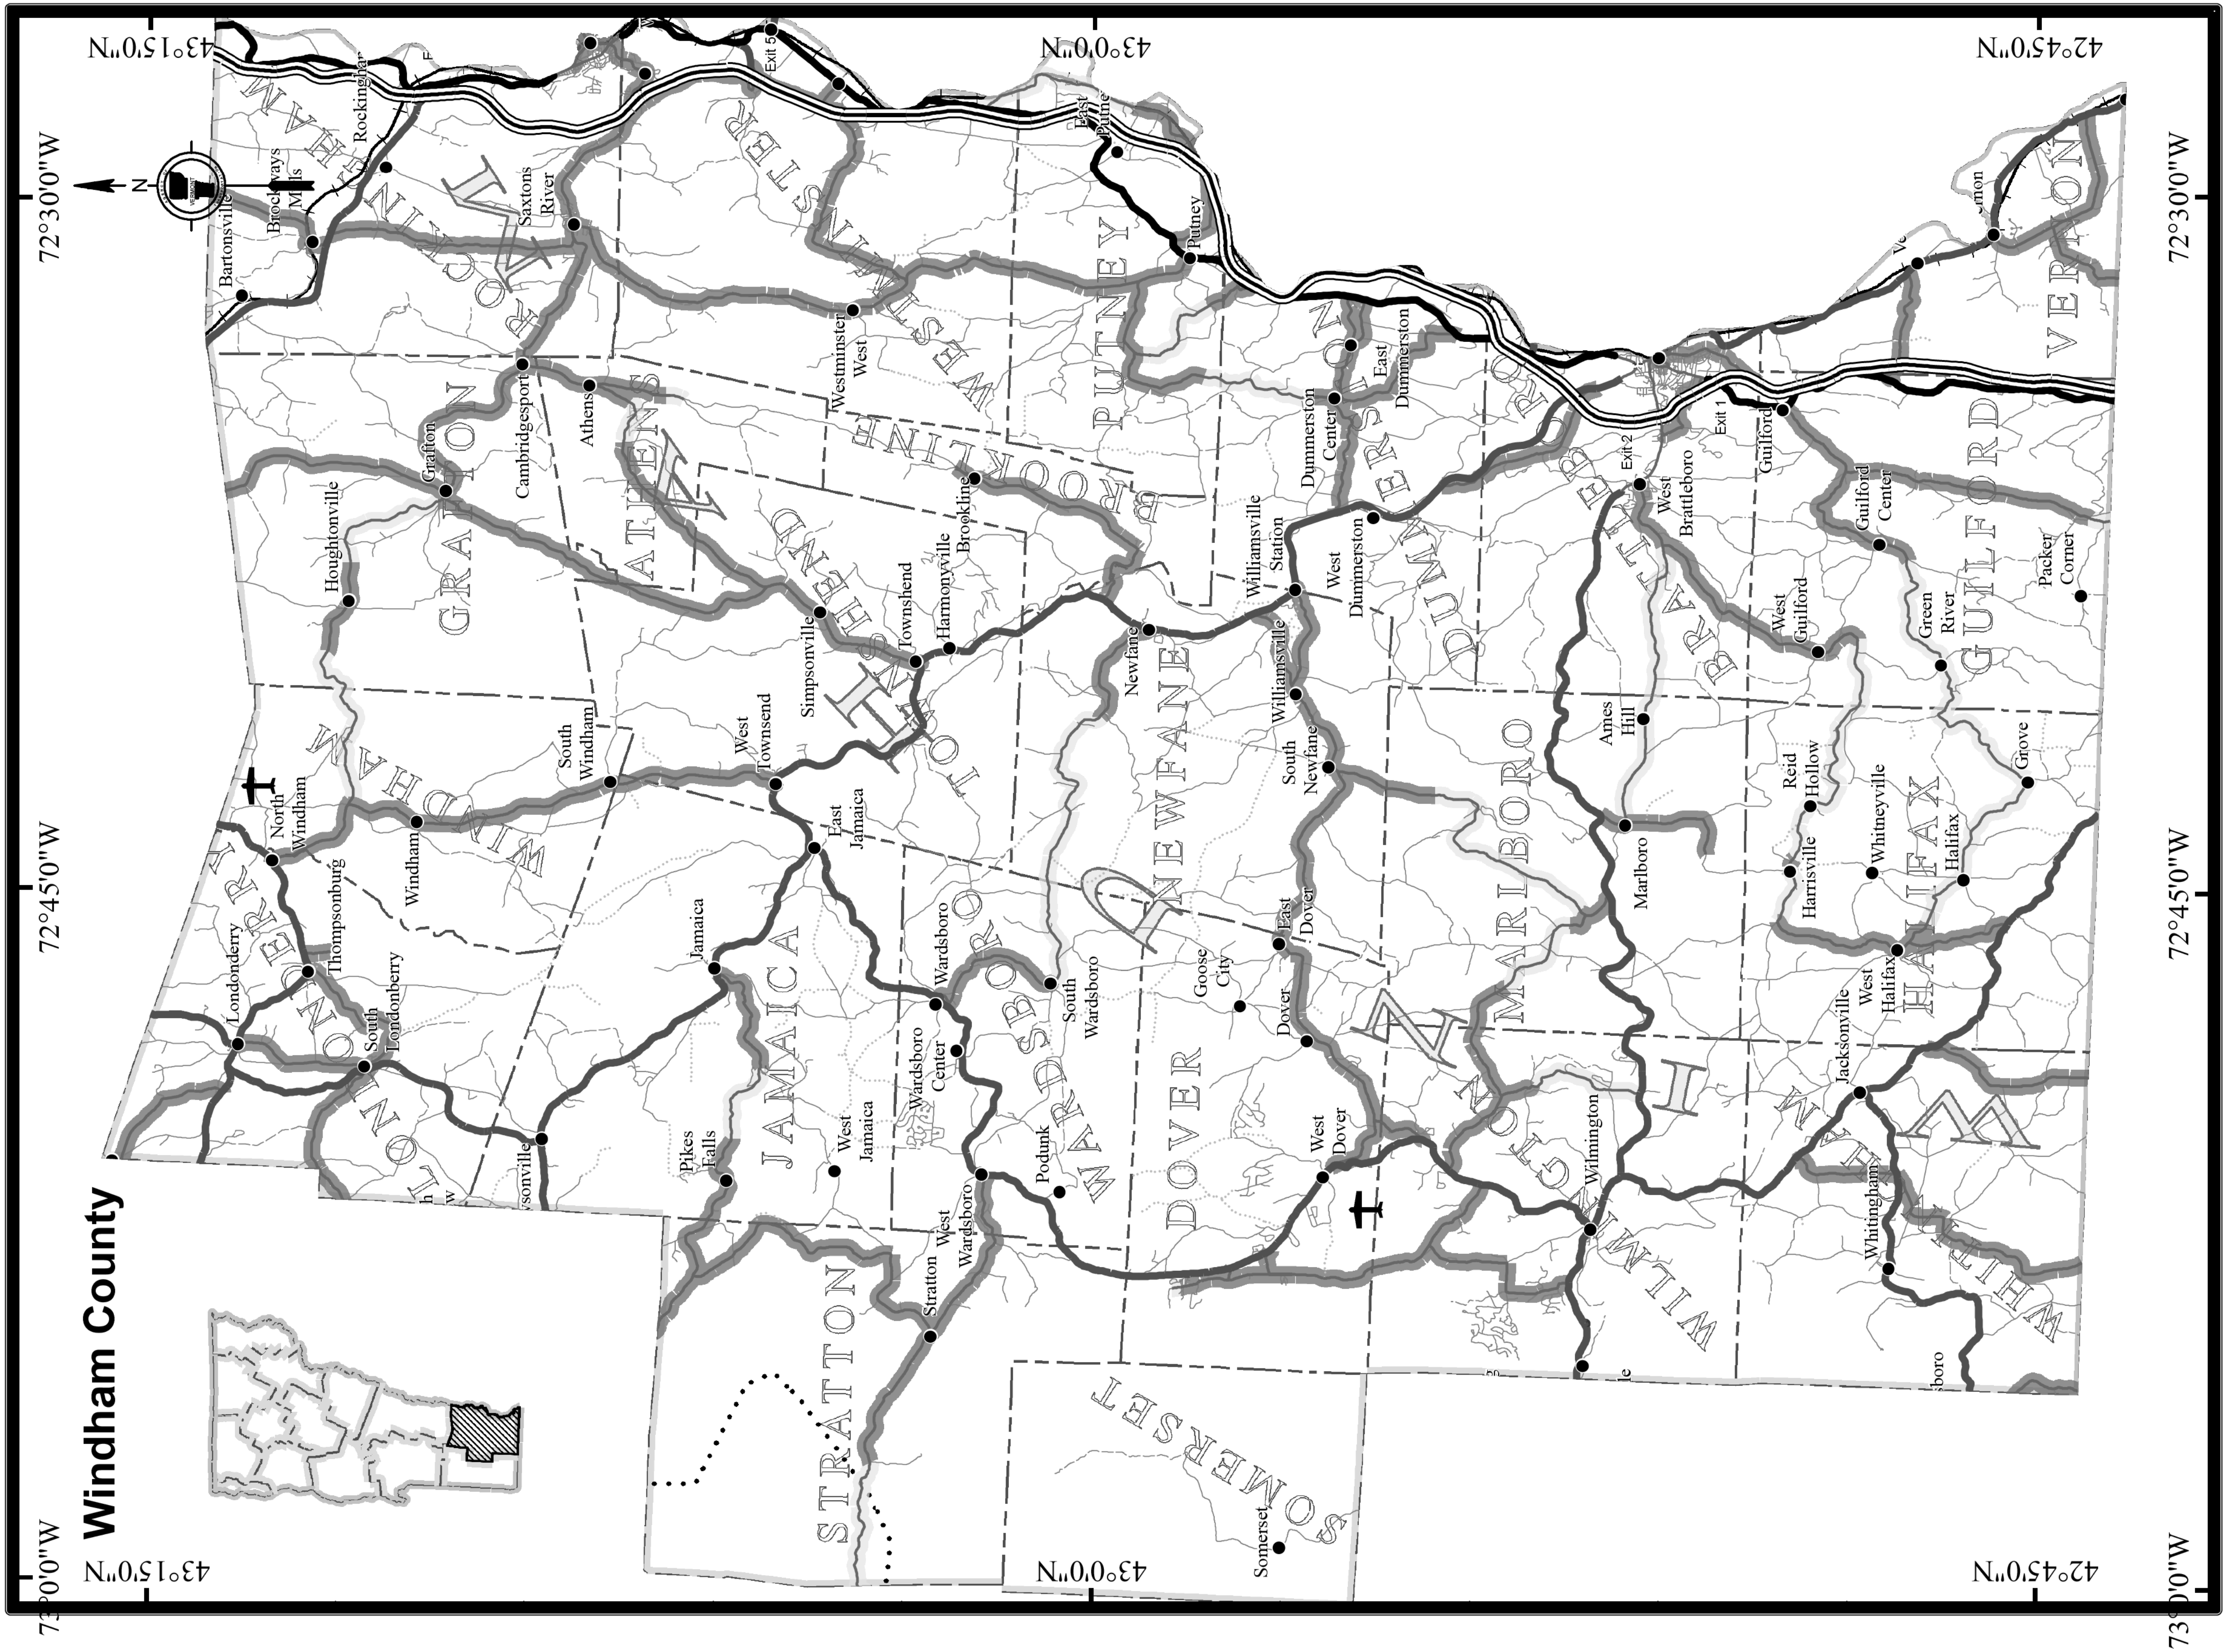


Class 2 Town Highways By Surface
SURFACETYPE

- Paved
- Gravel
- Soil or graded and drained earth

CLASS 2 TOWN HIGHWAYS BY SURFACE TYPE - WINDHAM COUNTY

NOT TO SCALE

PROJECT NAME:	STATEWIDE
PROJECT NUMBER:	HES MARK(404)
FILE NAME: +14+186.dgn	PLOT DATE: 1/29/2015
PROJECT LEADER: P. COBURN	DRAWN BY: K. RECORD
DESIGNED BY: K. SWEET	CHECKED BY: I. DEGUTIS
TOWN HIGHWAY COUNTY MAP SHEET 13	SHEET 55 OF 56

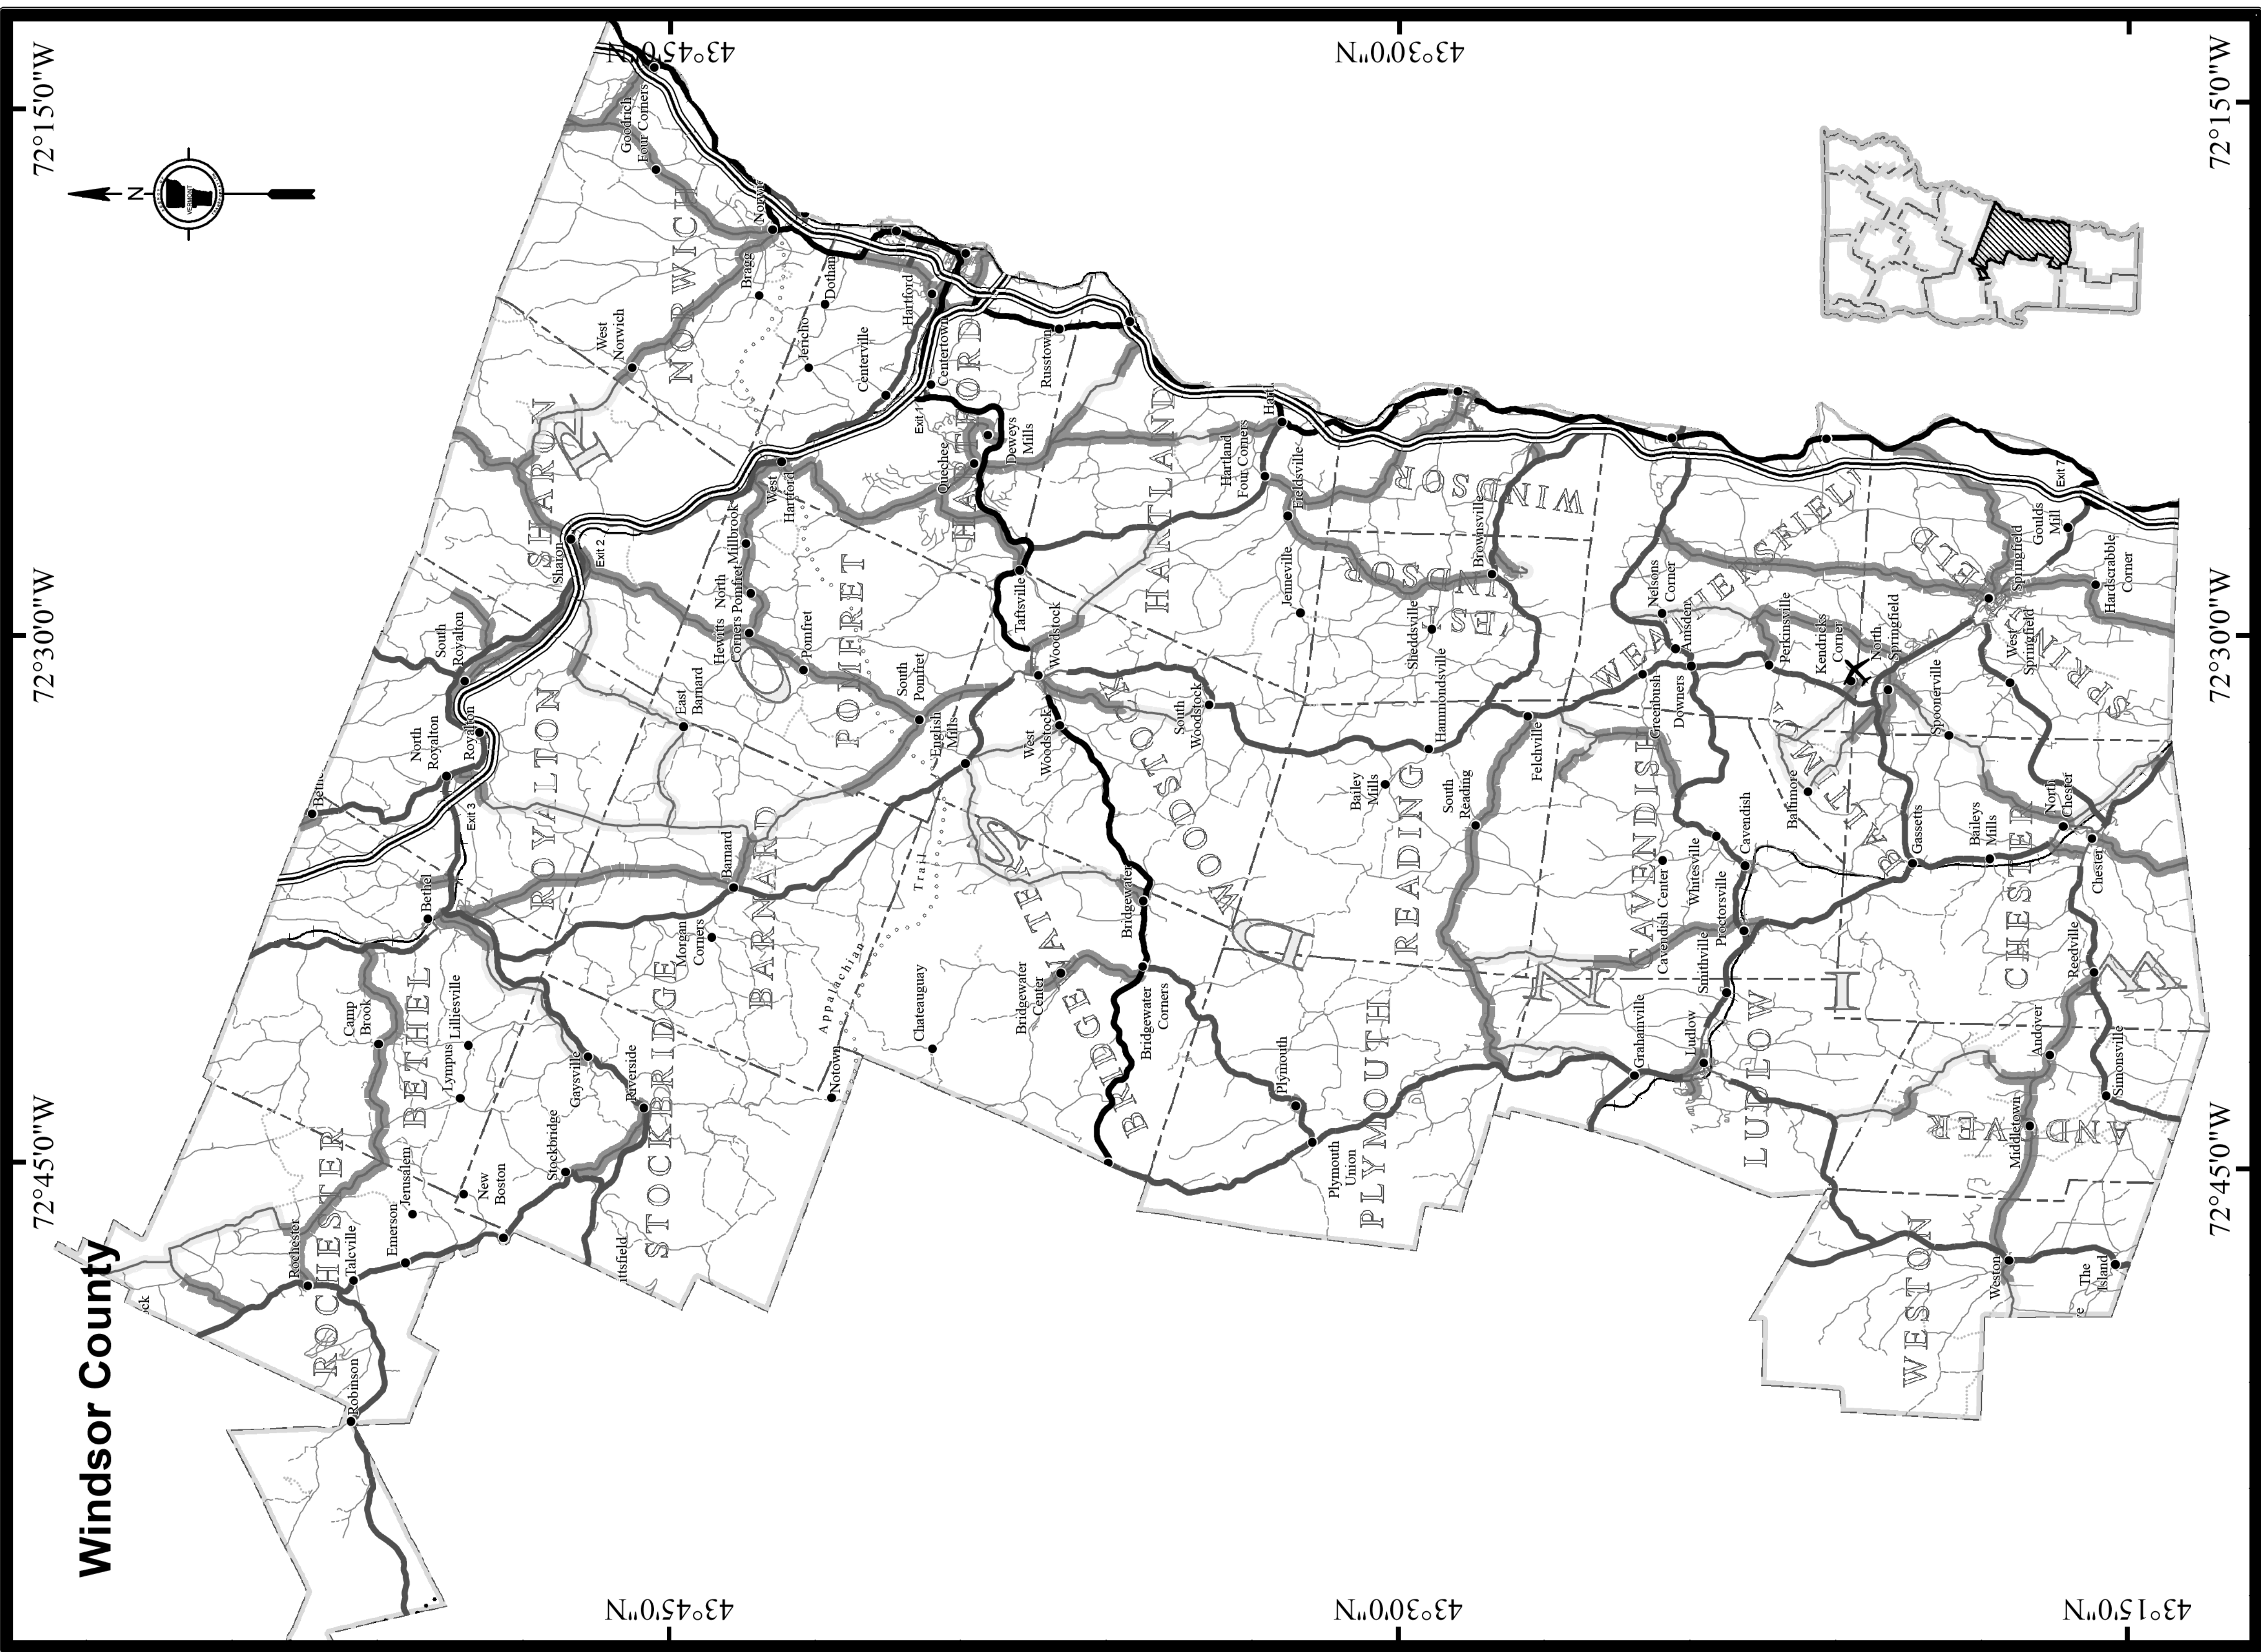

Class 2 Town Highways By Surface
SURFACETYPE

- Paved
- Gravel
- Soil or graded and drained earth

CLASS 2 TOWN HIGHWAYS BY SURFACE TYPE - WINDSOR COUNTY

NOT TO SCALE

PROJECT NAME:	STATEWIDE
PROJECT NUMBER:	HES MARK(404)
FILE NAME: +14+186.dgn	PLOT DATE: 1/29/2015
PROJECT LEADER: P. COBURN	DRAWN BY: K. RECORD
DESIGNED BY: K. SWEET	CHECKED BY: I. DEGUTIS
TOWN HIGHWAY COUNTY MAP SHEET 14	SHEET 56 OF 56