


9/30/53
7/11/54
Perry
Barn

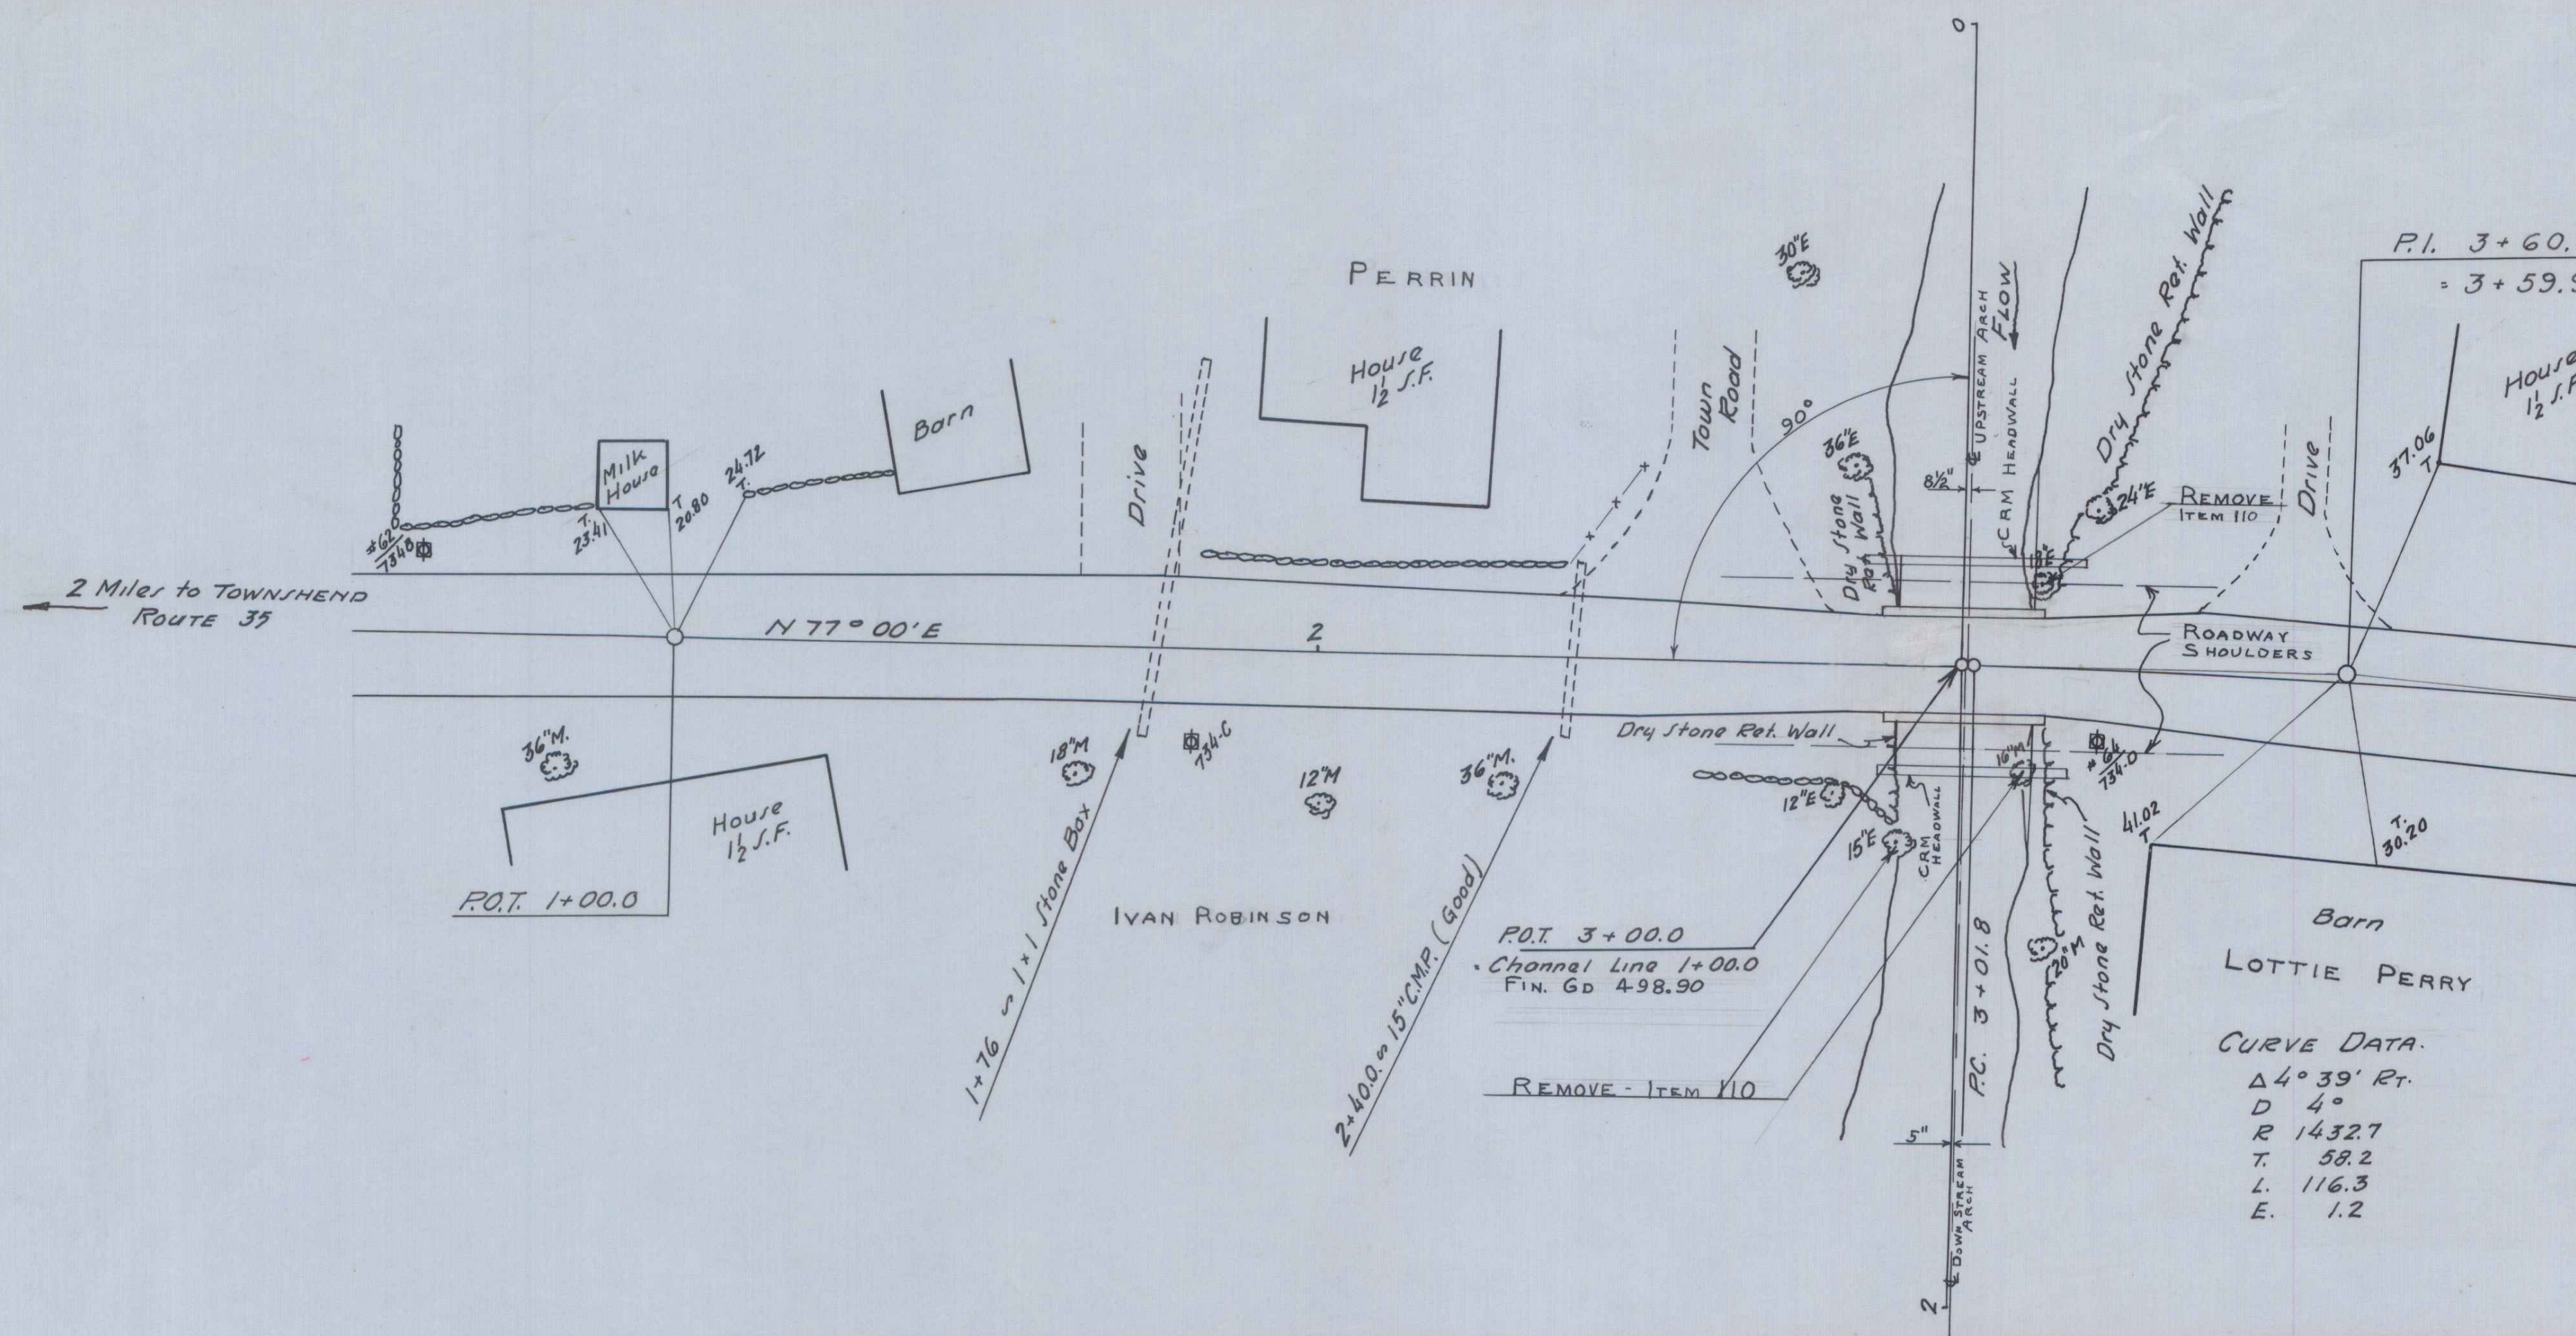

500

490

480

LIST OF SHEETS (BA ONLY)	
SHEET 1 OF 10	PLAN AND PROFILE
2 & 3 OF 10	DETAILS OF CORR. GALV. METAL PLATE PIPE ARCHES
4 OF 10	REINFORCING STEEL QUANTITIES AND DETAILS
5 OF 10	EARTHWORK SHEET
6 OF 10	BARRICADES SIGNS AND LIGHTS STANDARD SB-11
7 OF 10	CABLE GUARD RAIL STANDARD S-30 ITEM 80-A
8 & 9 OF 10	ROADWAY SECTIONS
10 OF 10	CHANNEL SECTIONS

APPROVED
DISTRICT ENGINEER
CORRECT
BRIDGE ENGINEER
APPROVED
CHIEF ENGINEER

PROJECT Townshend

NUMBER SA-17-1953 LENGTH MI.

TYPE C.G.M.P.P.A. Extension

CONTRACTOR _____ YEAR 19 _____

LOCATION SA-Rd. #1 ~
Bridge # 4

