
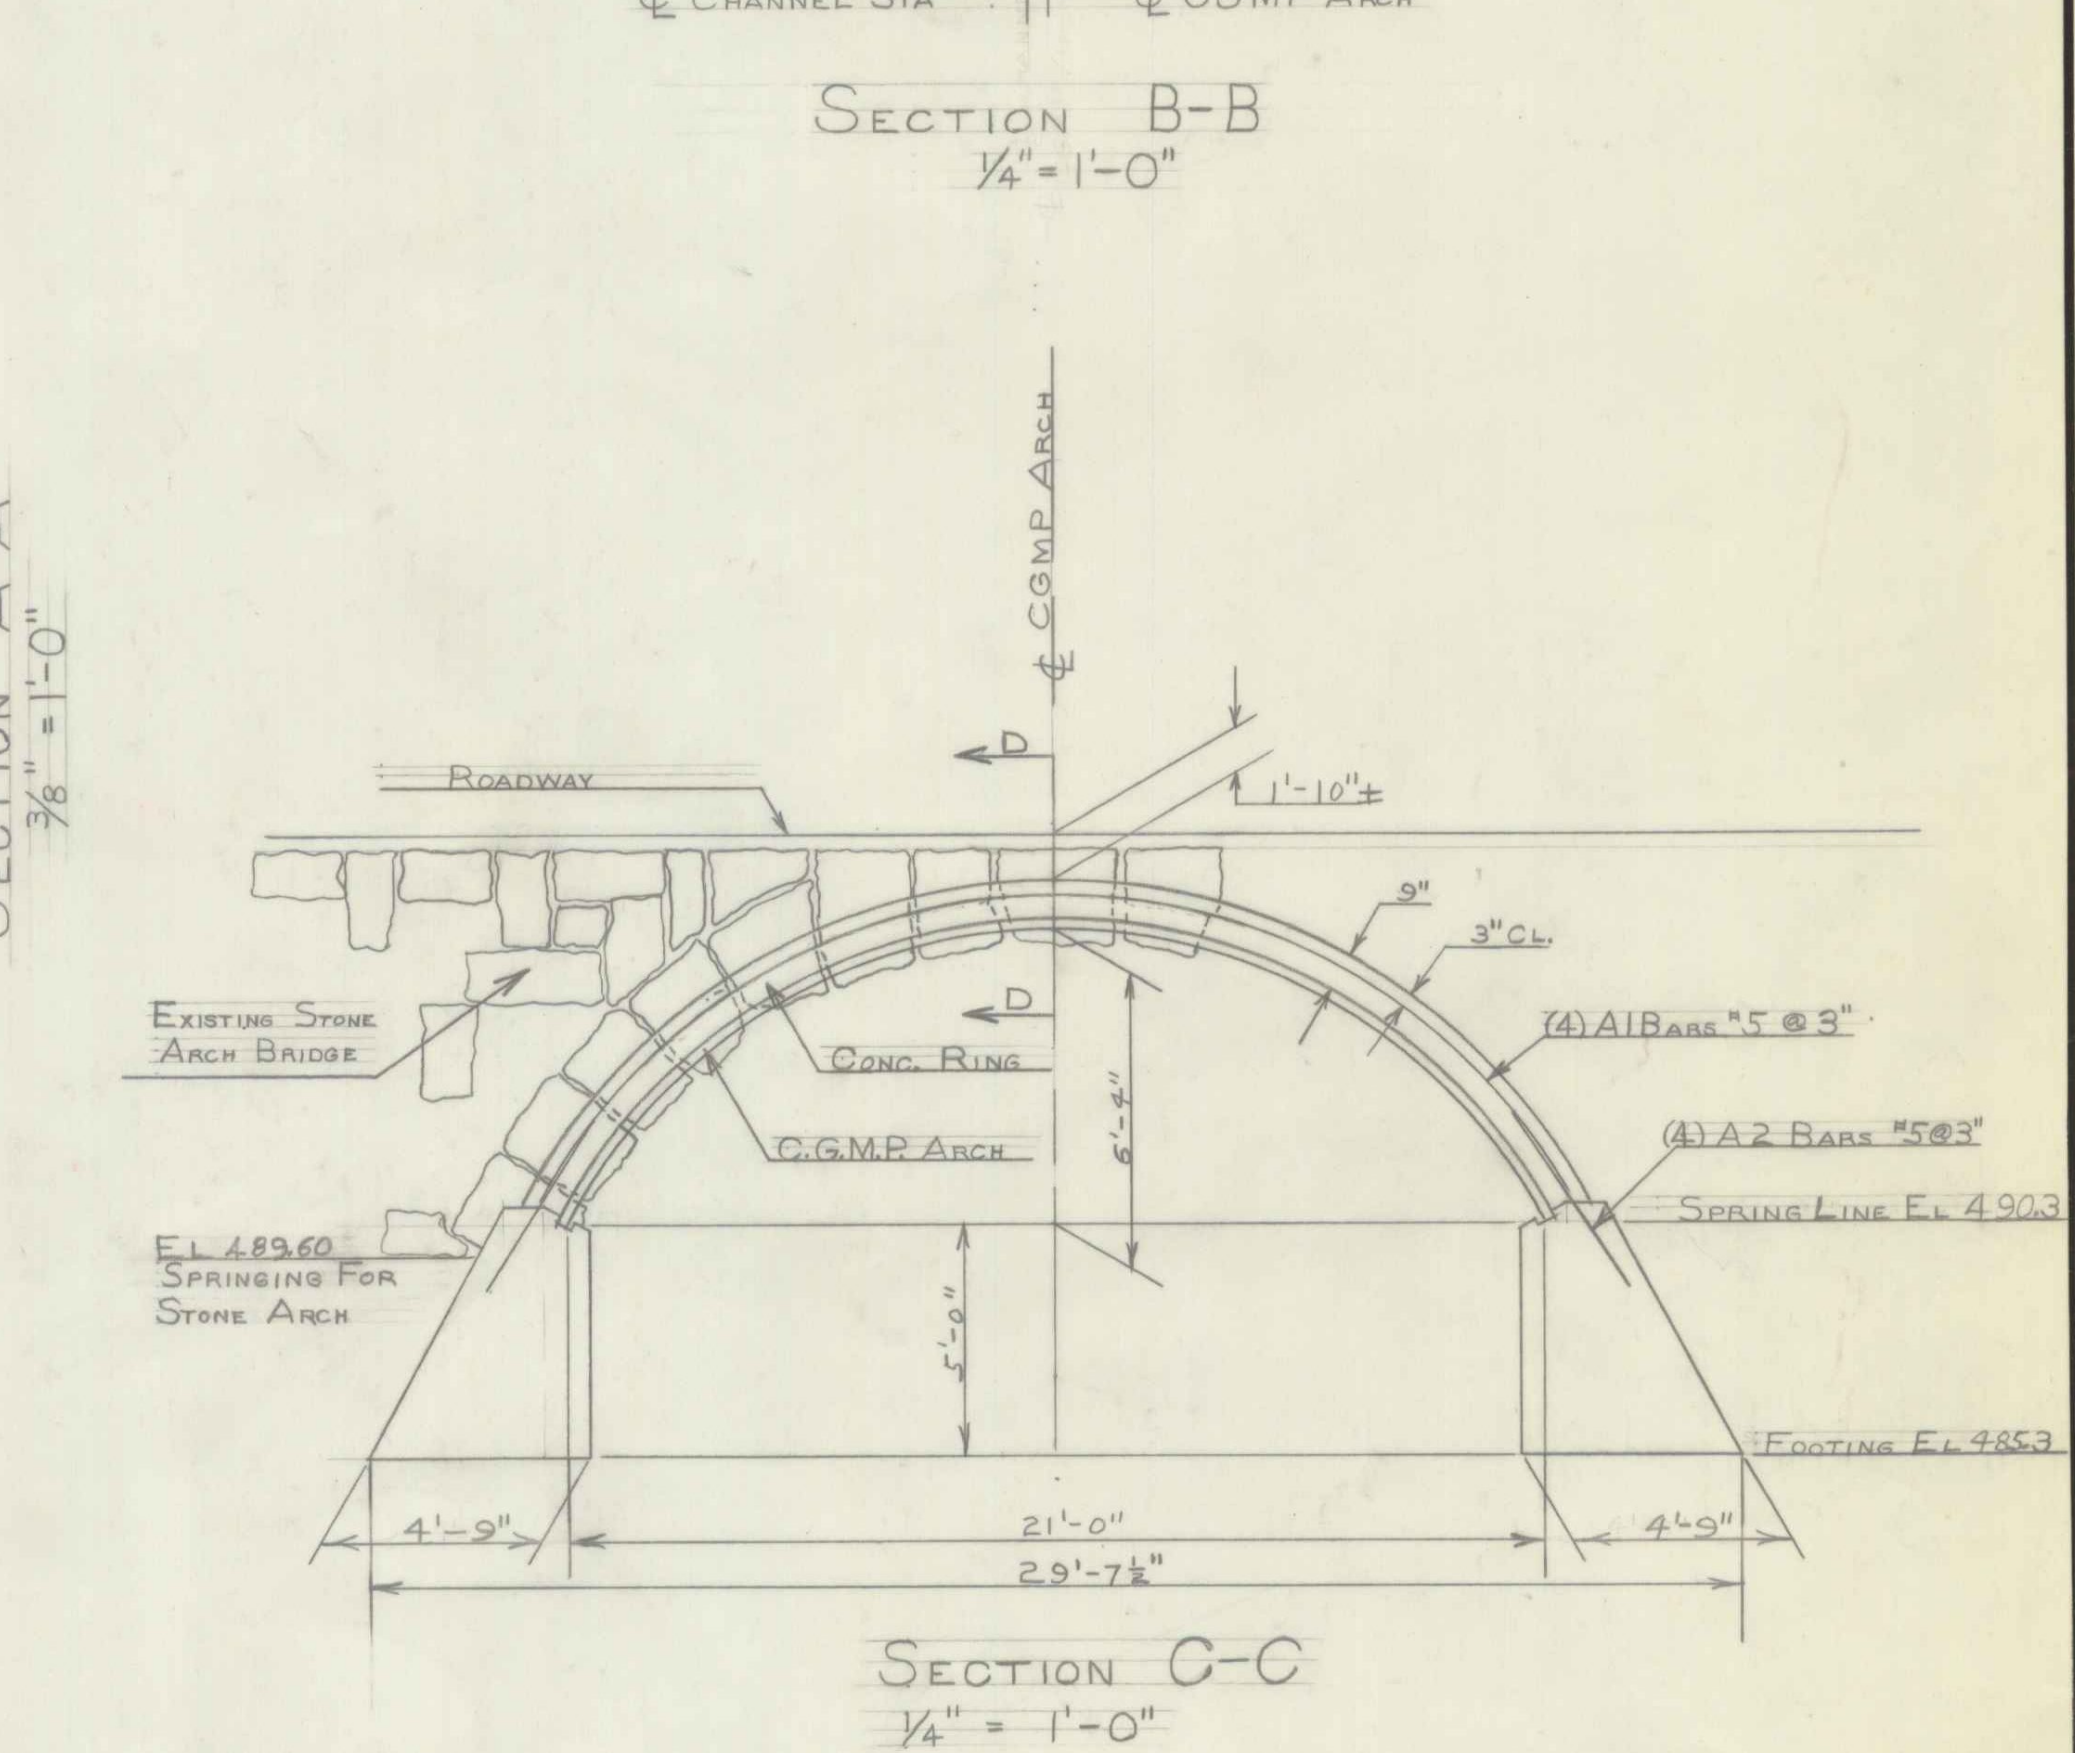
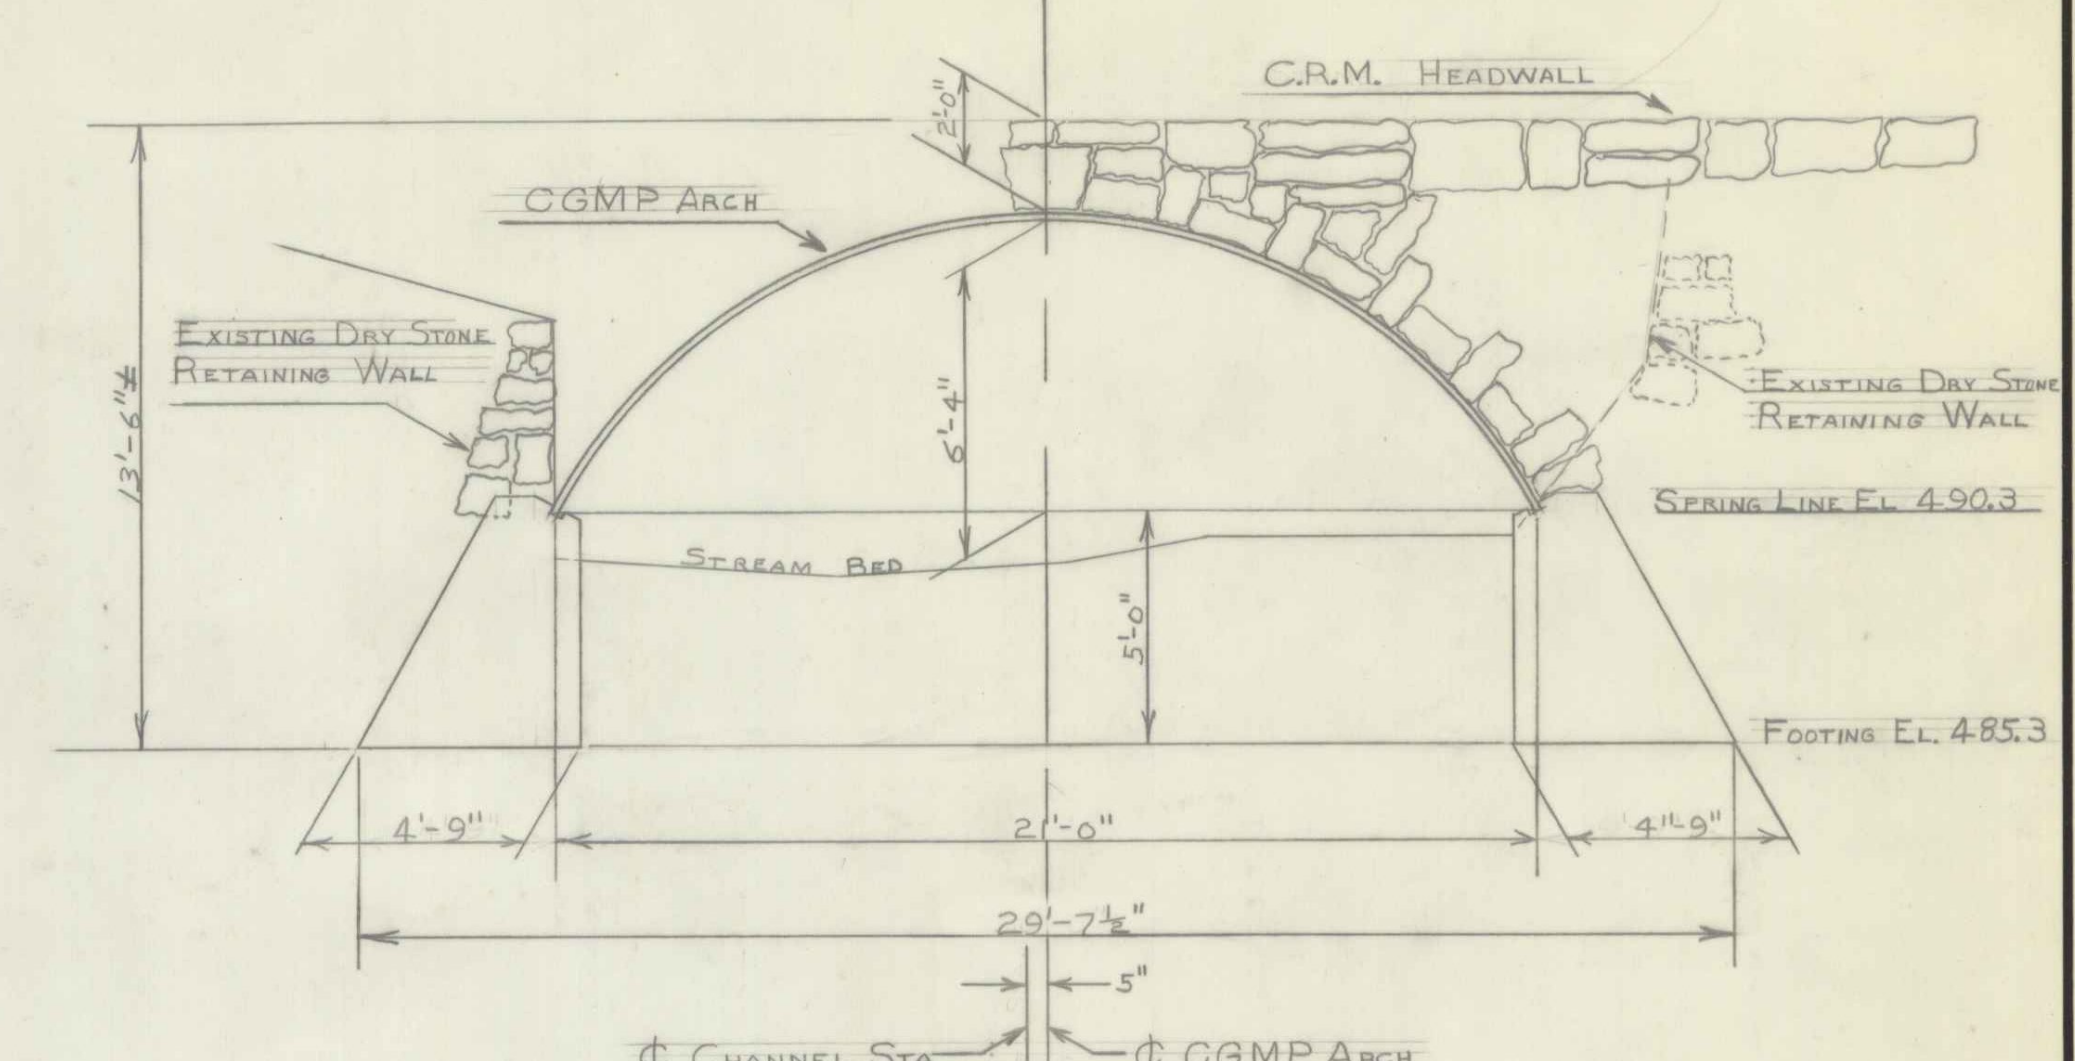


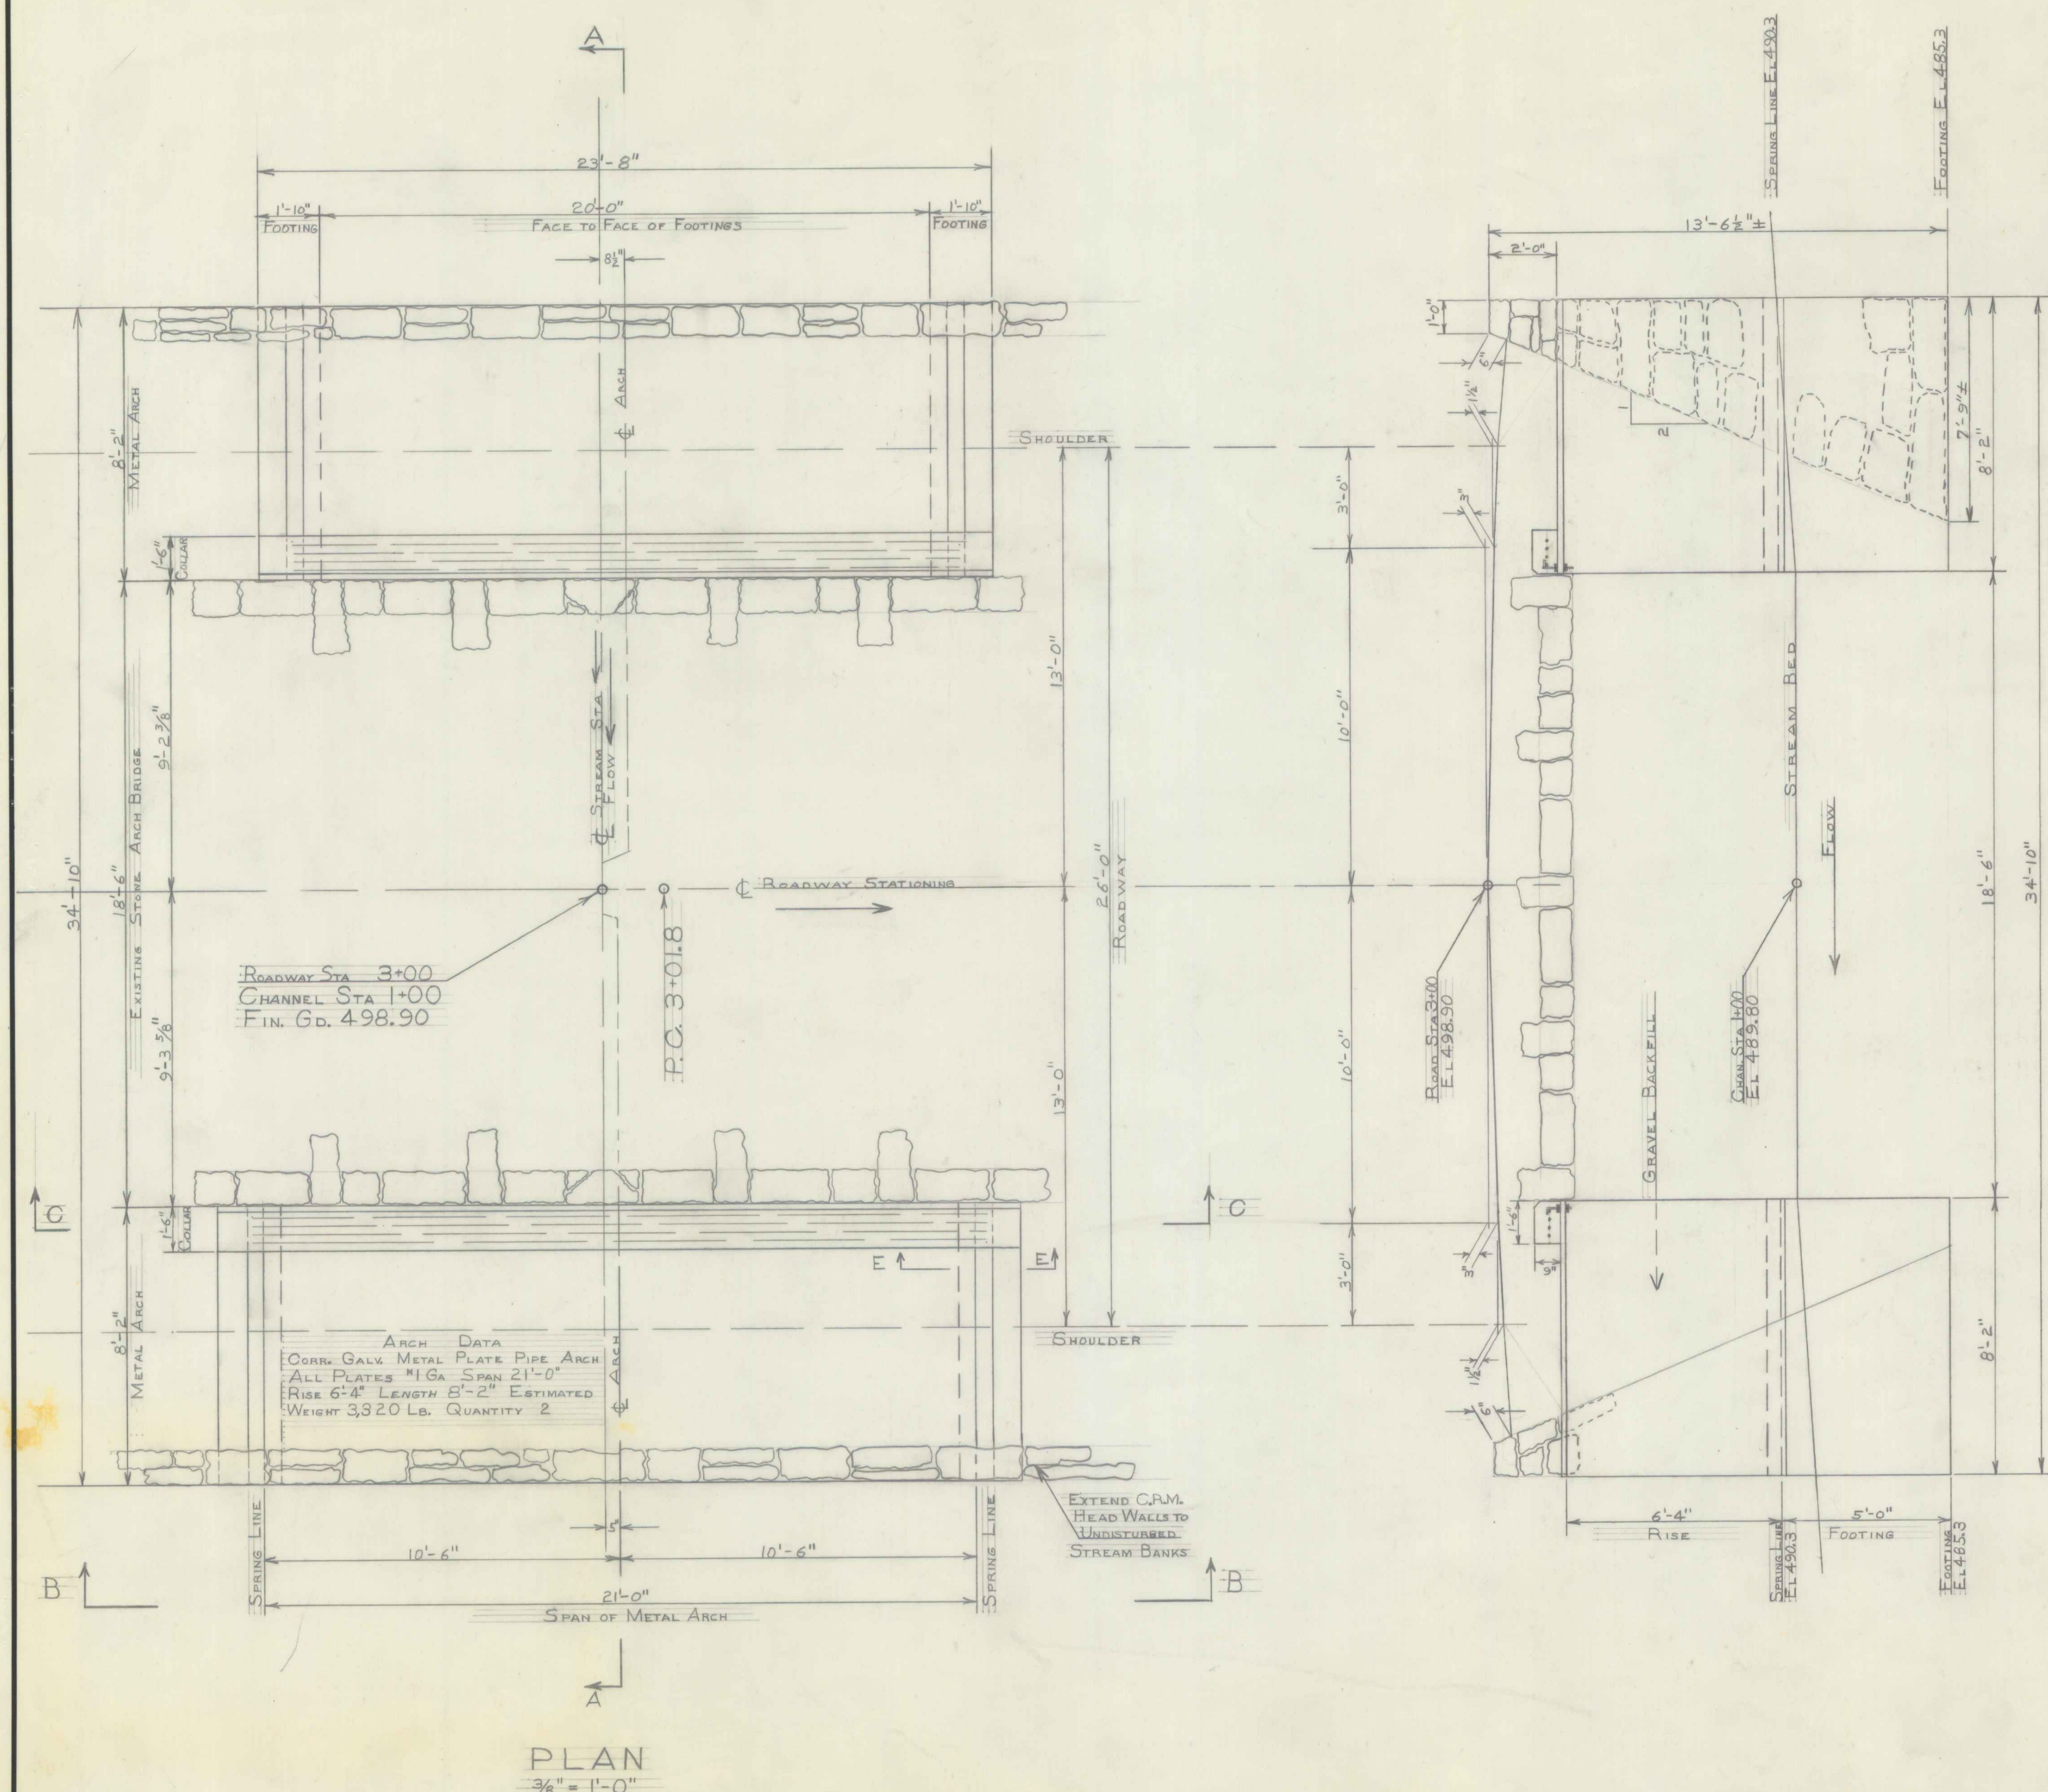

STATE OF VERMONT	
DEPARTMENT OF HIGHWAYS	
TOWN OF <u>TOWNSHEND</u>	
ROAD NO. <u>1</u>	BRIDGE NO. <u>4</u>
<u>CORR. GALV. METAL PLATE PIPE ARCH</u>	
<u>EXTENSION OF EXISTING STONE ARCH</u>	
SCALE <u>As NOTED</u>	
SURVEYED BY <u>POGAR</u>	
DRAWN BY <u>MLJ</u> CHECKED BY <u>R.B.M.</u>	
PROJECT NO. <u>SA17-1953</u>	
SHEET <u>2</u> OF <u>10</u>	