


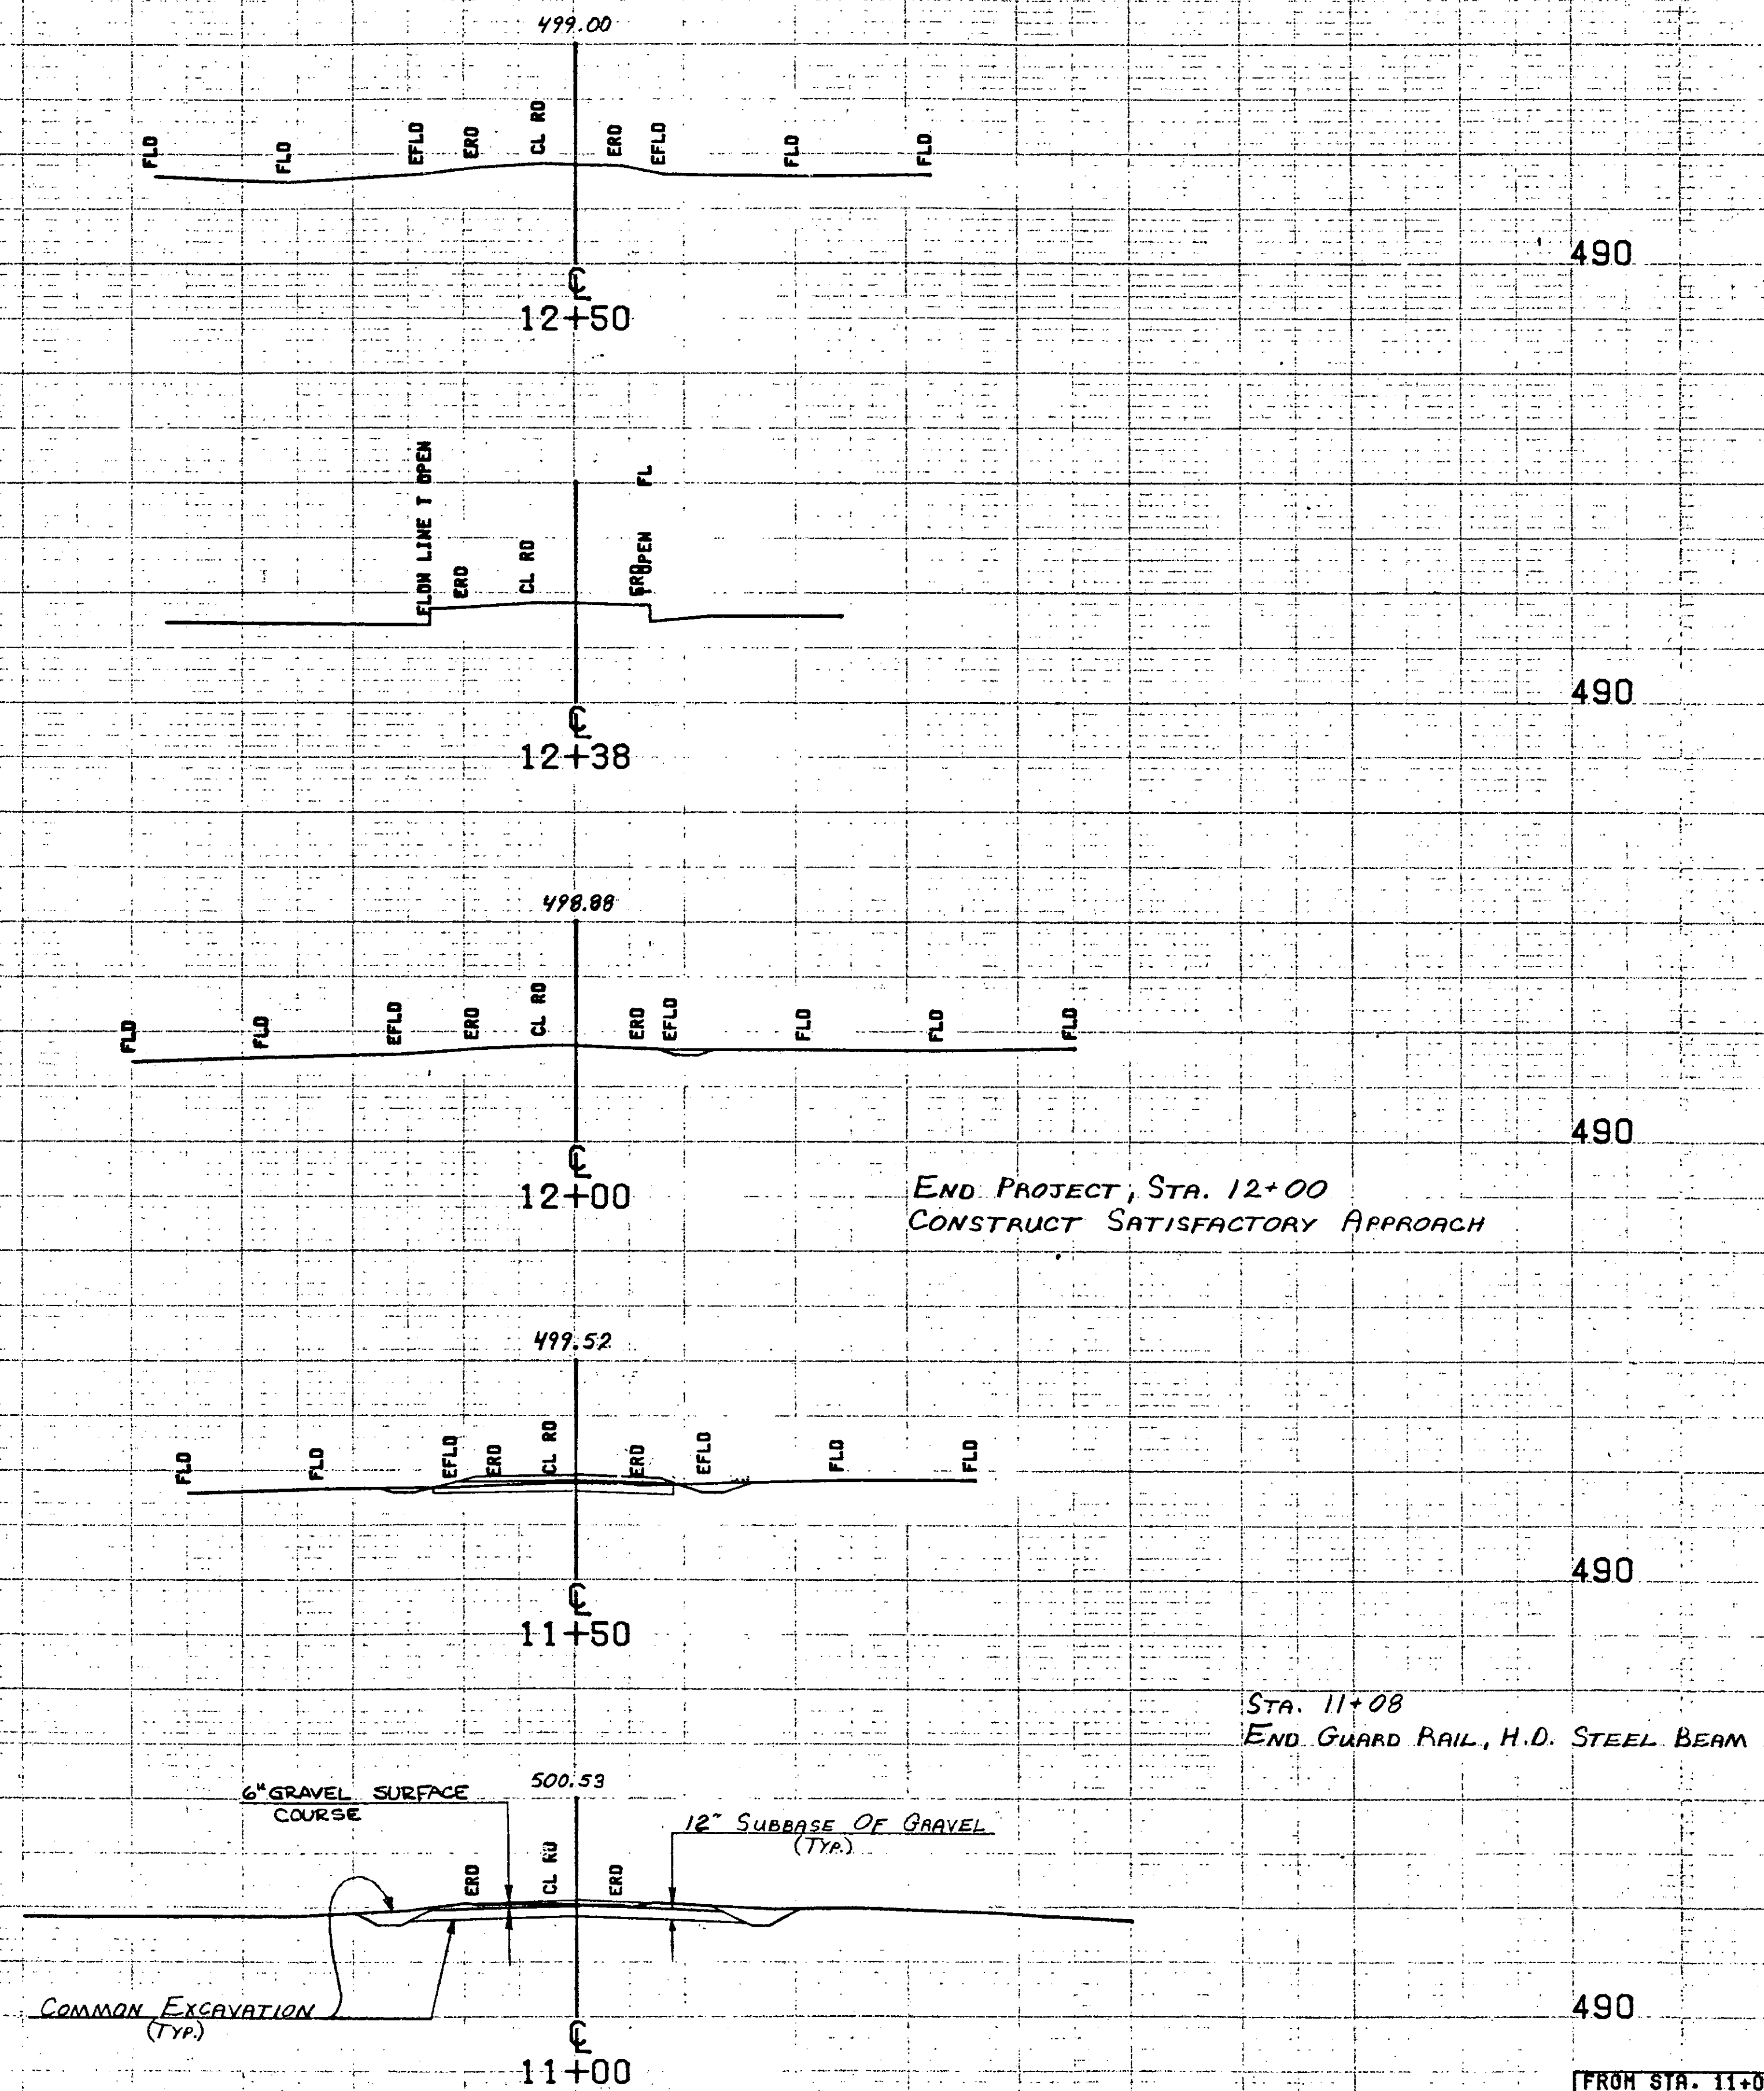

SCALE 10 FEET

FROM STA. 11+00	TO STA. 12+50
PROJECT NAME	CHESTER MAIN T.H. 57
NO.	BR21442(2)
SURVEYED BY	TESSIER
SHEET	OF 13 SHEETS 32
	PLOTTED 02/26/80
	DEC. 1979