
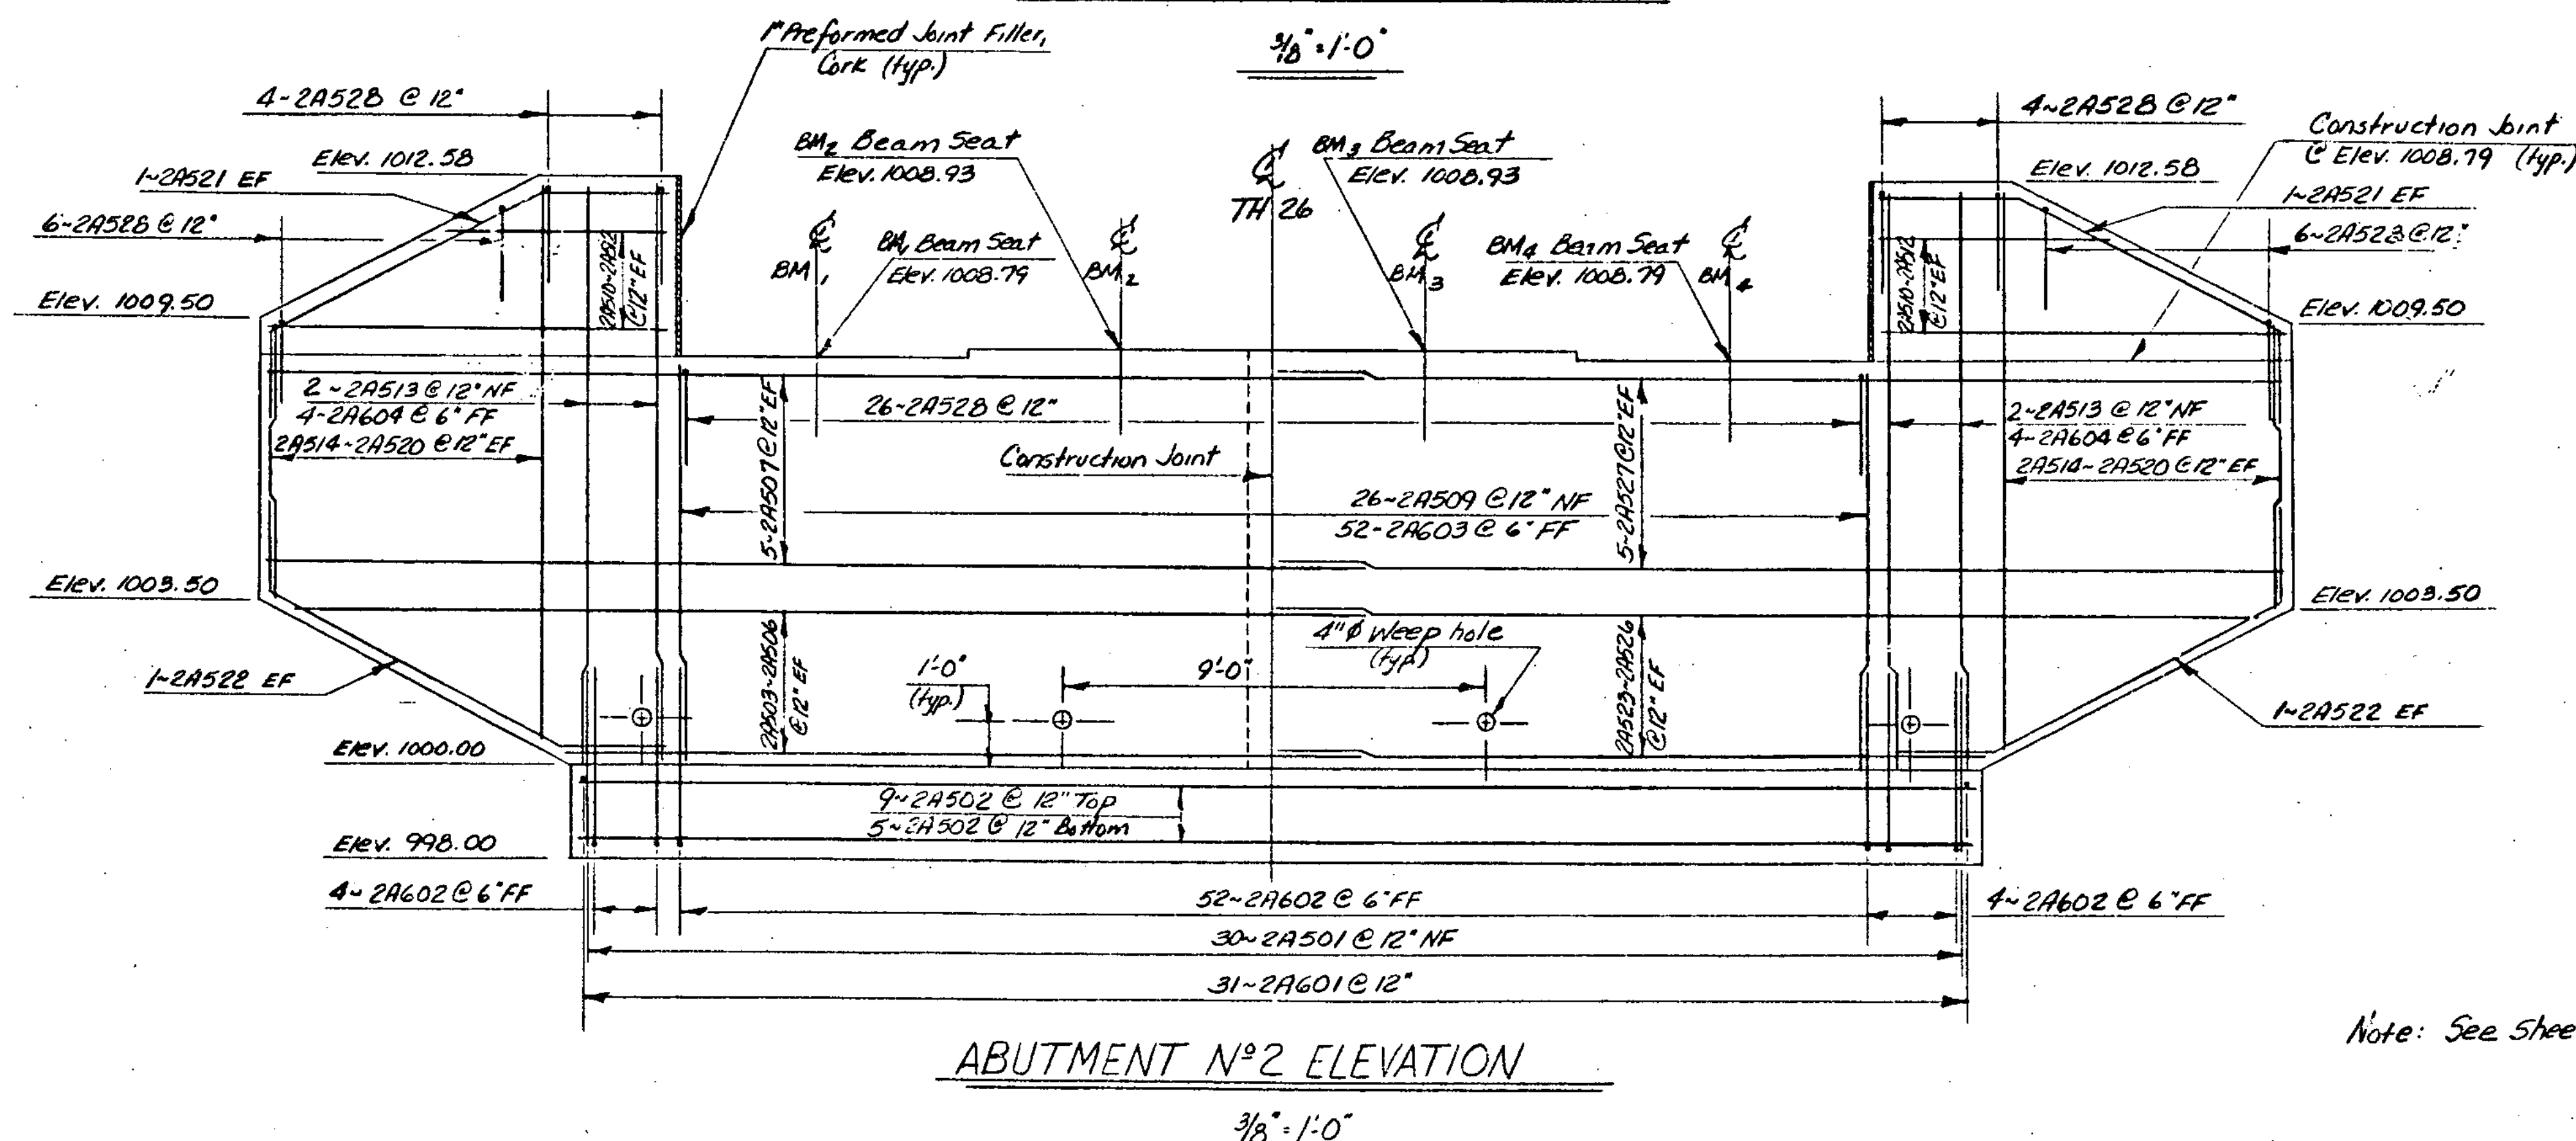
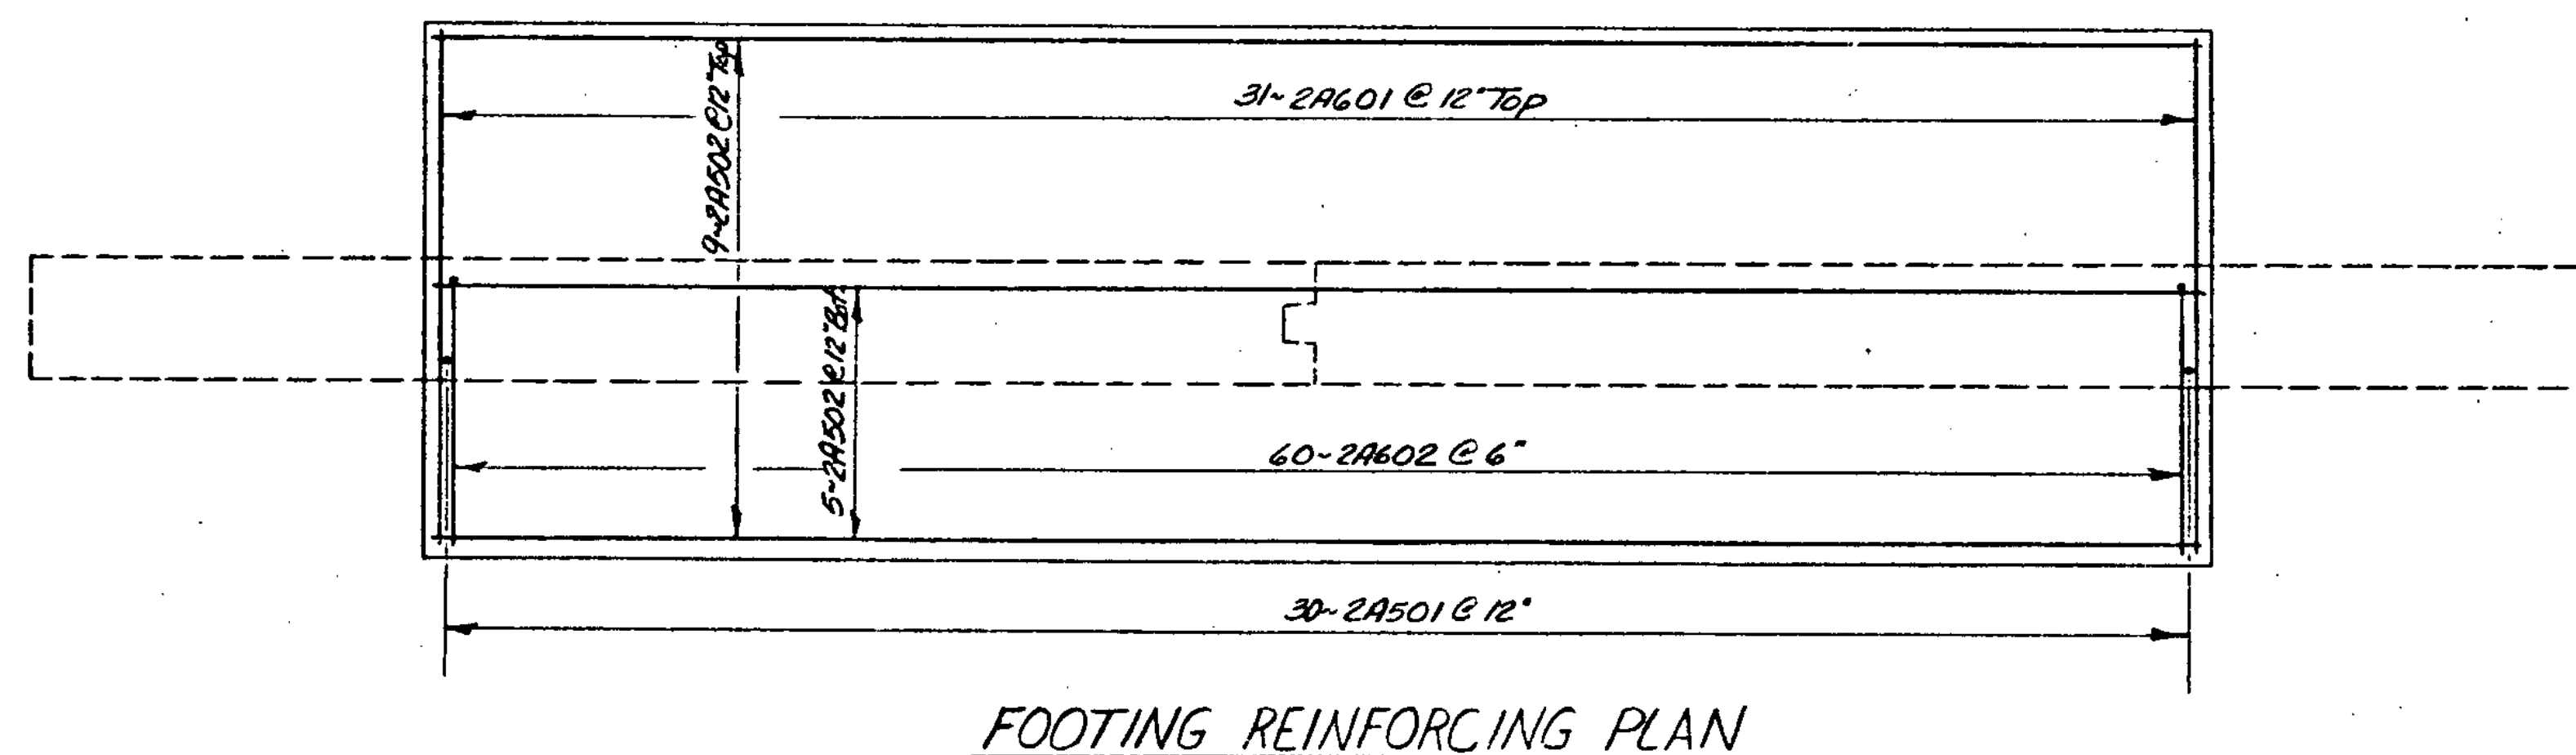


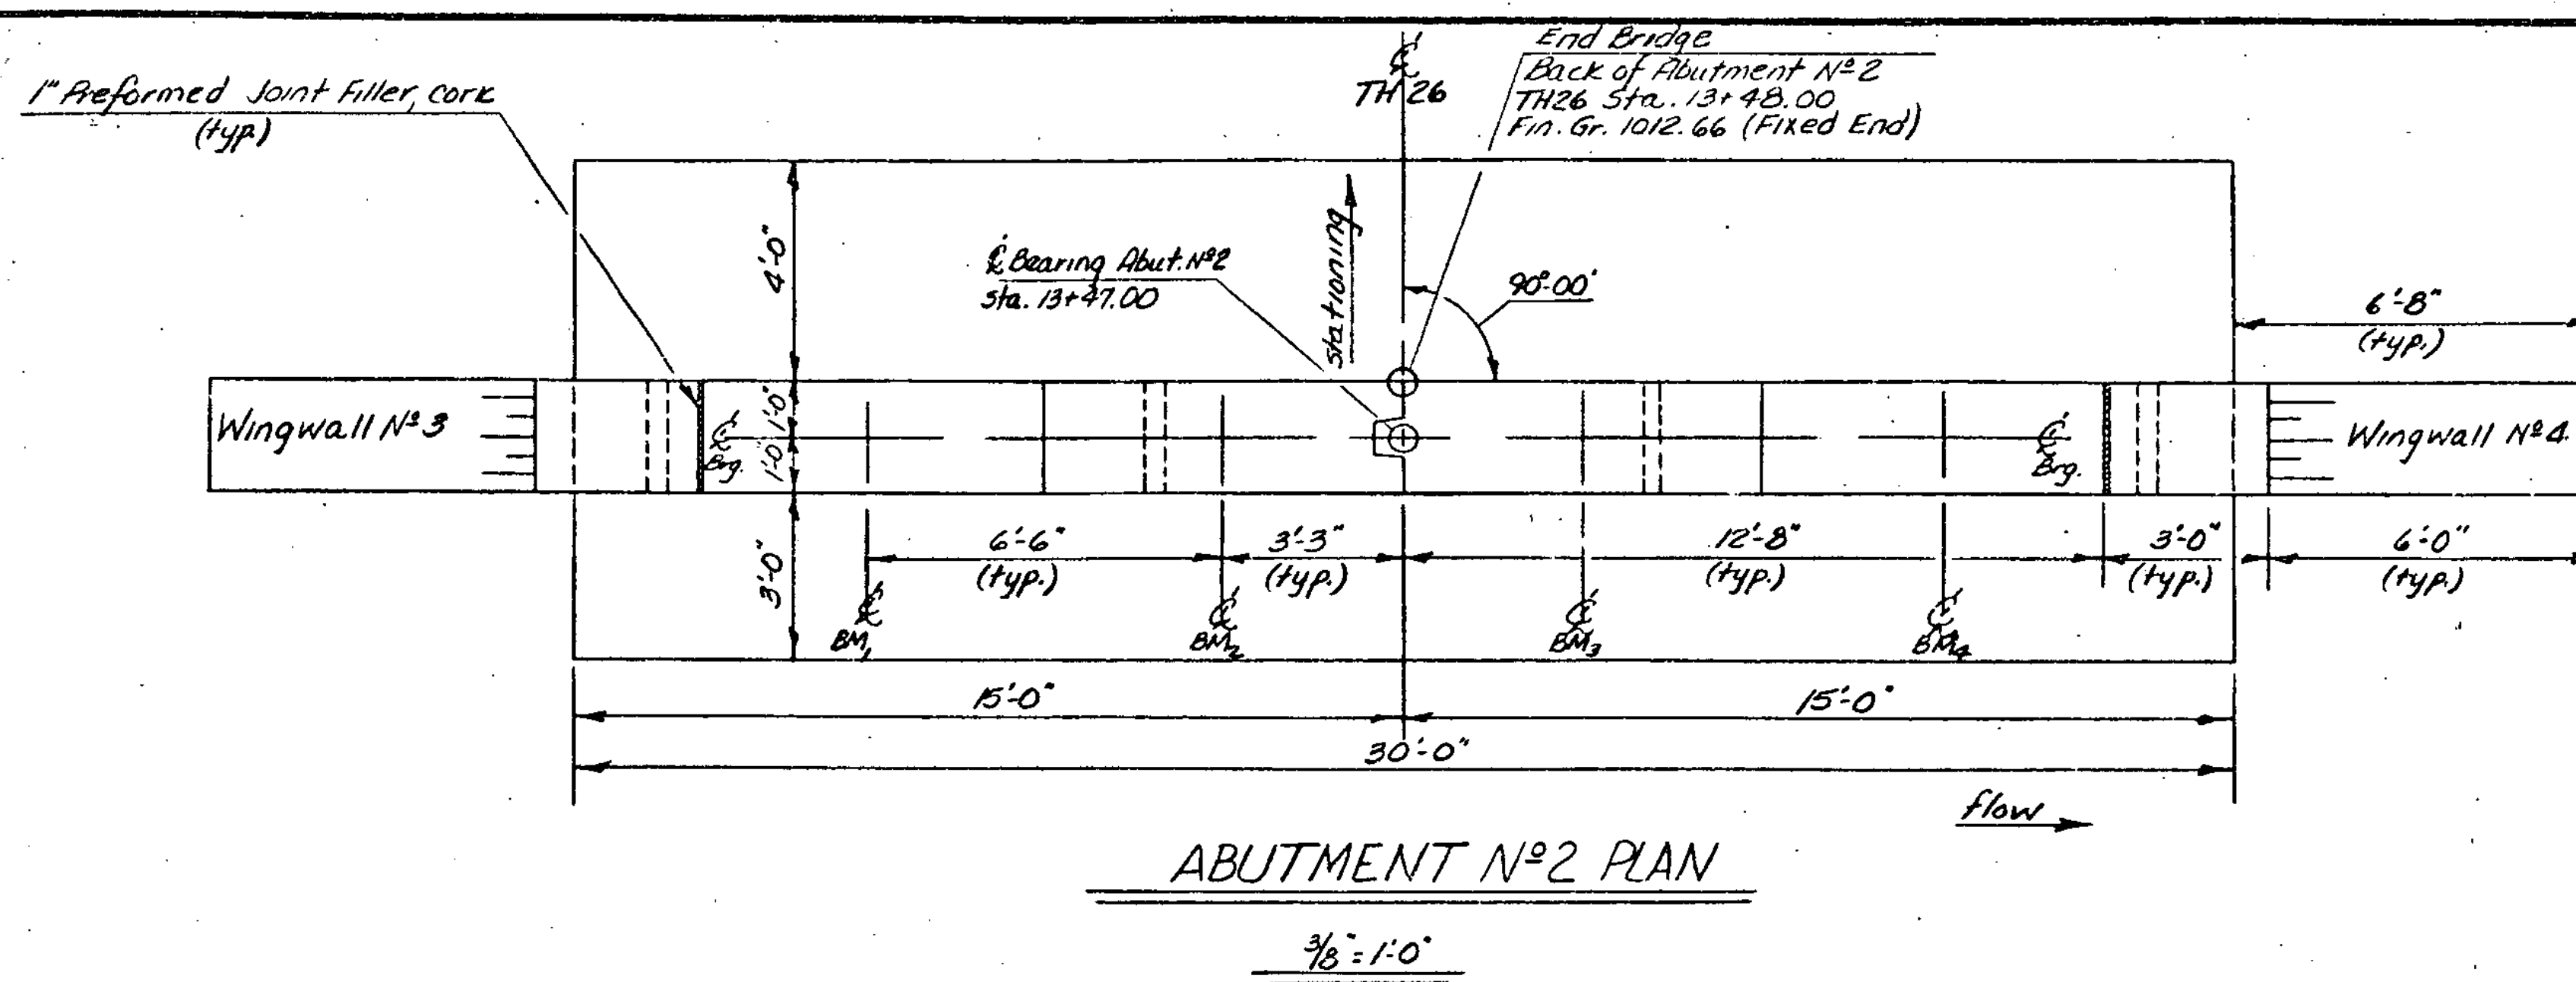

Note: See Sheet N° 13 for typical abutment and wingwall sections.

STATE OF VERMONT			
AGENCY OF TRANSPORTATION			
TOWN OF	GRANVILLE	Bridge No.	23
HIGHWAY NO.	TOWN HIGHWAY N° 26	Log Sta.	
		Surv. Sta.	13+18
TOWN HIGHWAY N° 26 OVER WHITE RIVER			
ABUTMENT N° 2 DETAILS			
Designed by	G.S. ROGERS	Drawn by	D.W. NEWTON
Checked by	L.C. GATES	Bridge Design Supervisor	
	date 3/84	FW. Bolcum	date 4/84
PROJECT	GRANVILLE	PROJECT NO.	BRZ 1444(9)
Bridge Sheet No.		Sheet	14 of 91