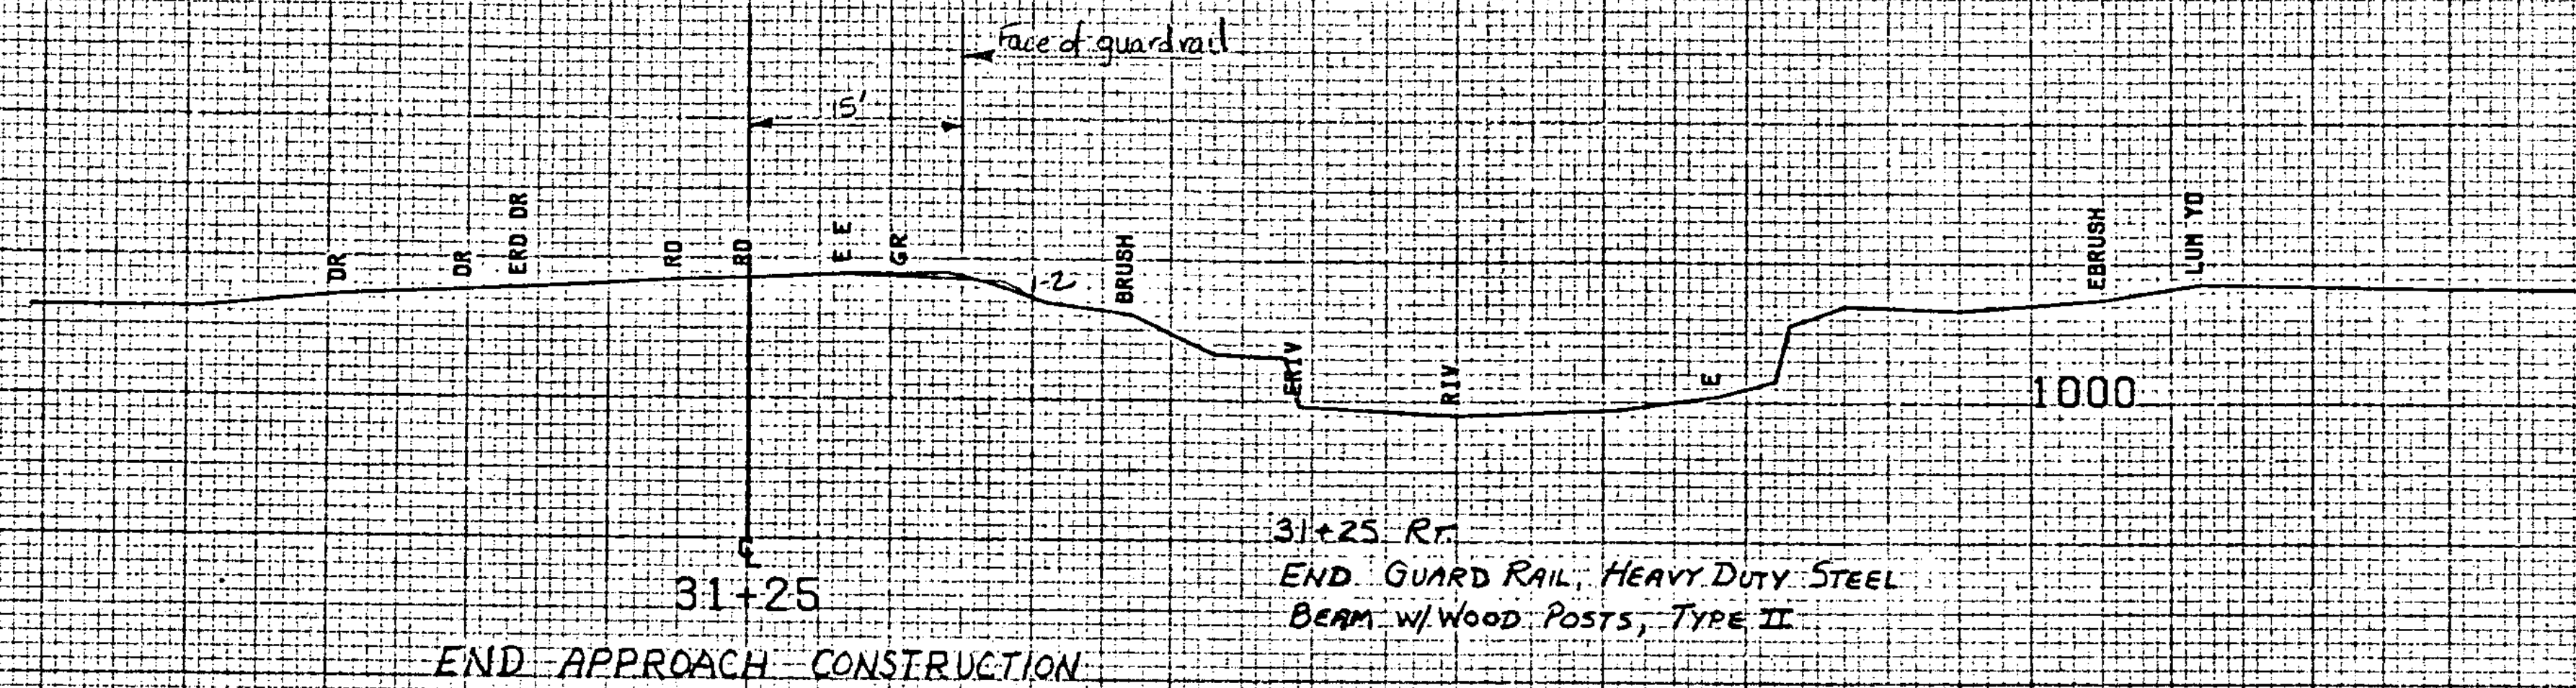


FROM STA. 30+75 TO STA. 31+25
 PROJECT NAME GRANVILLE TH4
 NO. BRZ1444(9) PLOTTED 11/16/82
 SURVEYED BY FANTONI JUNE 1982
 SHEET 27 OF 41 SHEETS

SCALE 1" = 10 FEET