
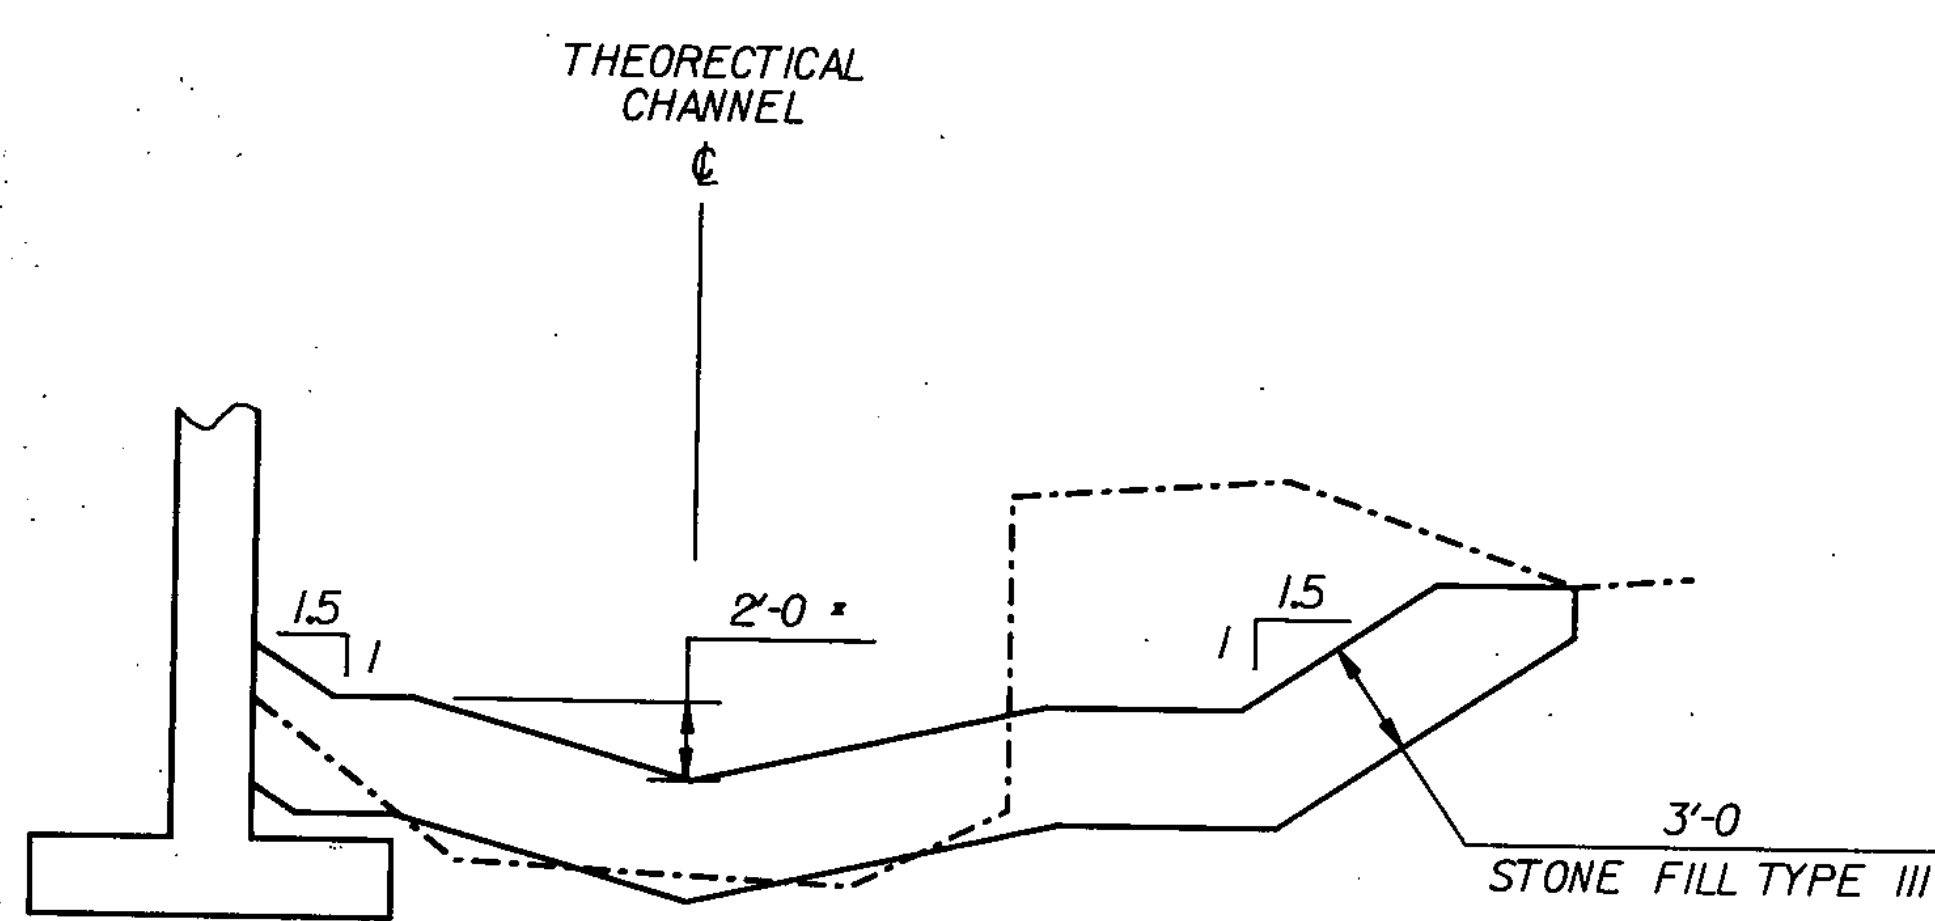


ALLOWABLE STRESS FOR REINFORCING STEEL GRADE 60
 TENSION 24,000 PSI COMPRESSION 20,000 PSI
 ALLOWABLE STRESS FOR CONCRETE, CLASS B
 F'c 3,500 PSI Fc 1,400 PSI

HYDRAULIC DATA



Q10-750 CFS HW. EL. 1004.5
 Q25-1000 CFS HW. EL. 1005.6
 Q50-1250 CFS HW. EL. 1006.7
 Q100-1500 CFS HW. EL. 1007.2
 DRAINAGE AREA = 14.9 SQ. MI.
 TAILWATER DEPTH @ Q25 = 4.3'
 OUTLET VELOCITY @ Q25 = 11.6 F.P.S.
 THE ROADWAY WILL NOT OVERFLOW
 UNTIL A Q40 OR ABOUT 1150 C.F.S.

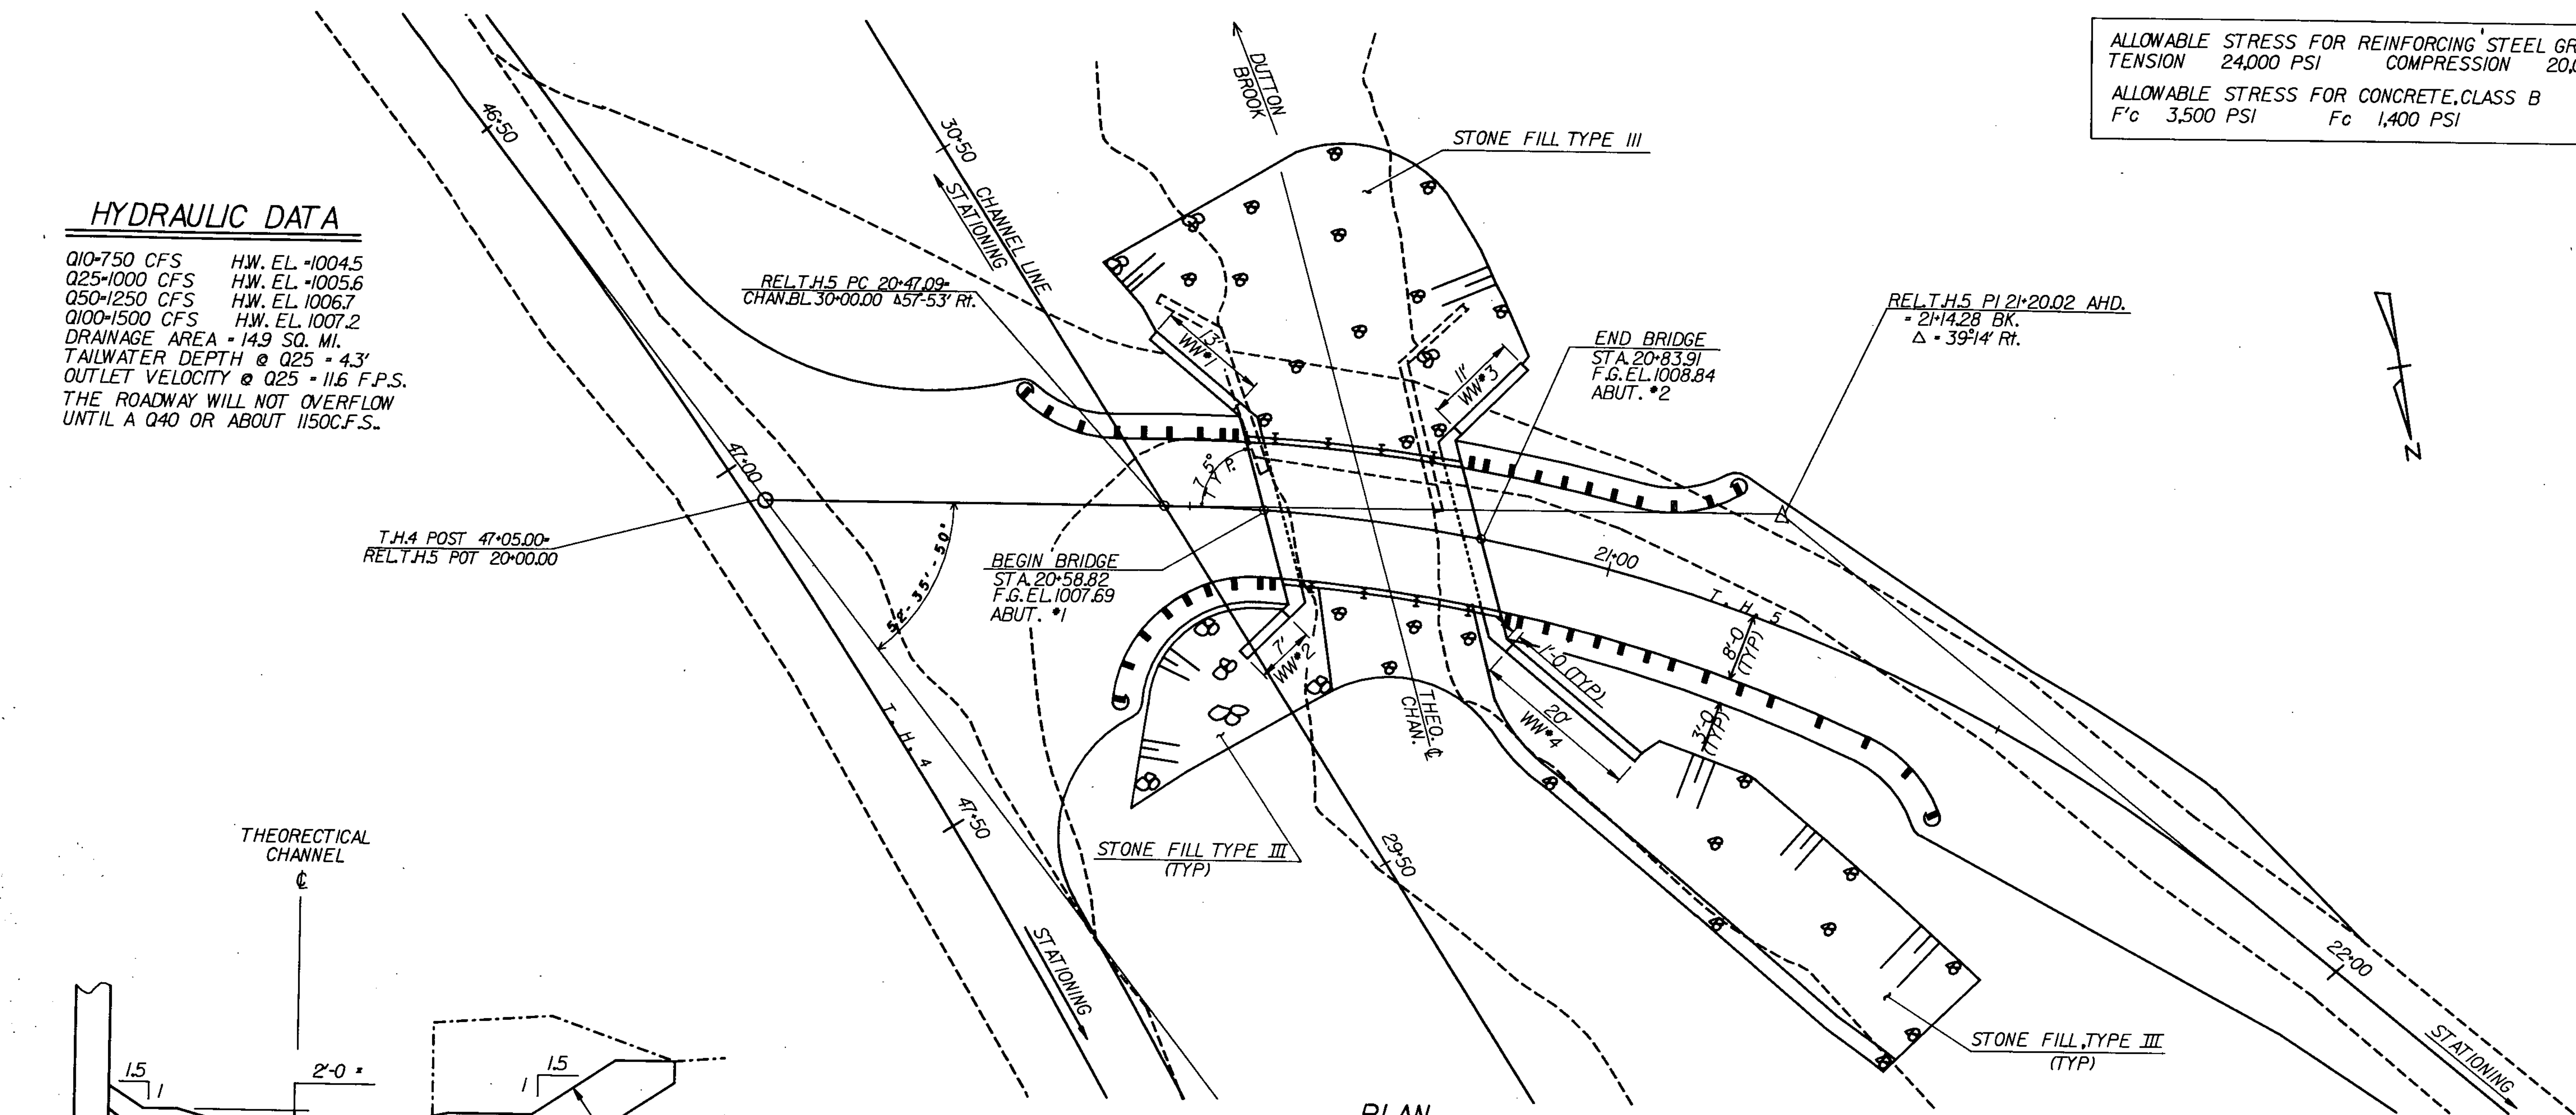

TYPICAL CHANNEL SECTION

Scale 1"=5'-0"

* 2'-0" DIMENSION IS SET @ CHANNEL
 STATION 30+00. MATCH INTO EXISTING
 CHANNEL ELEVATION AT STONE FILL LIMITS.

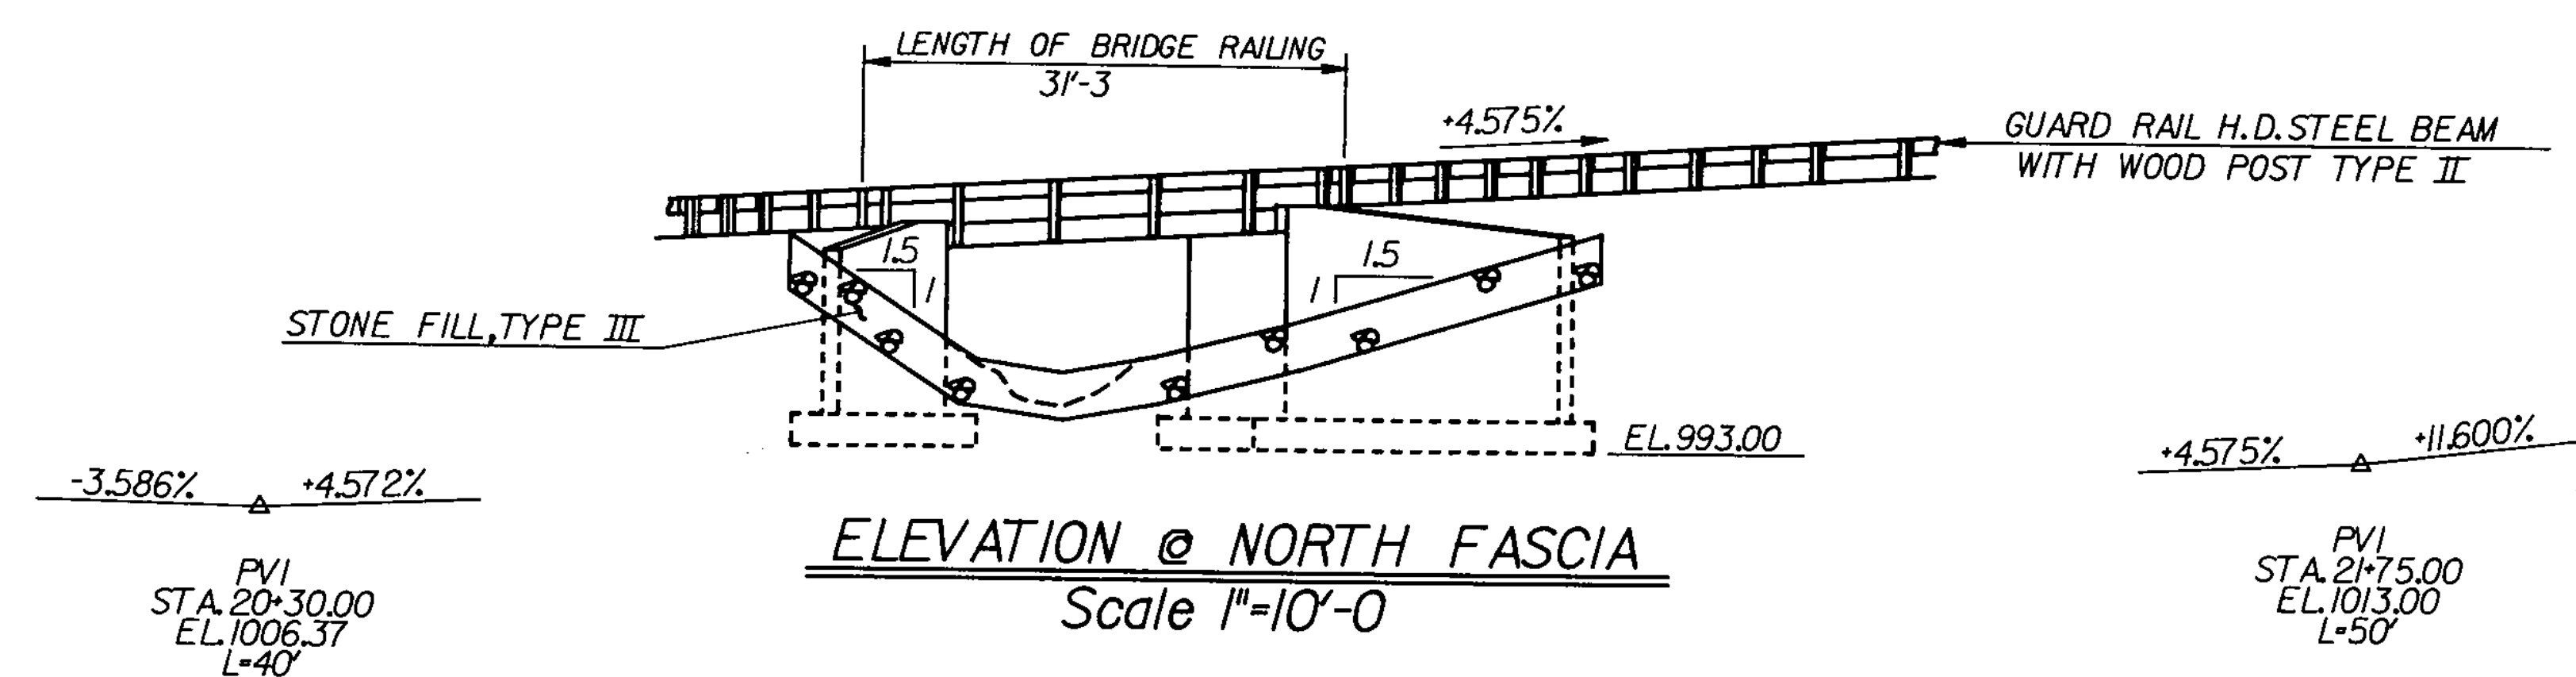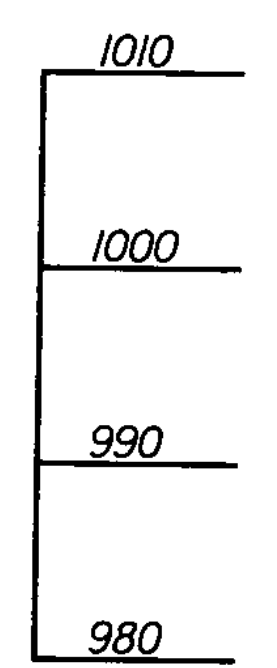

ELEVATION @ NORTH FASCIA

Scale 1"=10'-0"

STATE OF VERMONT AGENCY OF TRANSPORTATION			
Town of	MAIDSTONE	Bridge No.	6
Highway No.	T. H. 5	Log Sta.	
		Surv. Sta.	
PLAN AND ELEVATION			
T.H. 5 OVER DUTTON BROOK			
Designed By	G. SPILAK	Drawn By	D. WILLEY
Checked By	J. POTTER	Bridge Design Supervisor	R. S. HAUPT
Date	3-84	Date	3-84
PROJECT	MAIDSTONE	PROJECT NO.	BRZ 1447 (4)
LG.C. Info.	QSAI:30,251630225PE.DGN		
Bridge Sheet No.		Sheet	8 of 31