

BRIDGE RAILING, H.D. STEEL BEAM, TYPE D
T.H. 57 STA. 10+35 TO STA. 10+81 RT. & LT.


GUARD RAIL, H.D. STEEL BEAM WITH WOOD POST,
TYPE II (A532 STEEL) (6" POST SPACING TYPICAL)
VT. 11 STA. 4+14 RT. TO T.H. 57 STA. 10+35 RT.
T.H. 57 STA. 10+35 LT. TO VT. 11 STA. 5+62 RT.
T.H. 57 STA. 10+81 TO STA. 11+08 RT. & LT.

STONE FILL, TYPE II
CHAN. STA. 4+72 TO 5+25 RT.

TEMPORARY BRIDGE NOTES:

1. TEMPORARY BRIDGE IS TO BE LOCATED IN APPROXIMATE LOCATION AS PREVIOUS TEMPORARY CROSSINGS AND APPROXIMATELY AS SHOWN ON THIS DRAWING.
2. EVERY EFFORT SHALL BE MADE TO SAVE AS MANY TREES AS POSSIBLE.
3. FINAL LOCATION OF TEMPORARY BRIDGE, ACCESS ROAD, AND CONST. EASEMENTS SHALL MEET THE APPROVAL OF THE PROPERTY OWNER.

VT. TEL. CO.
6 87-1
95-1

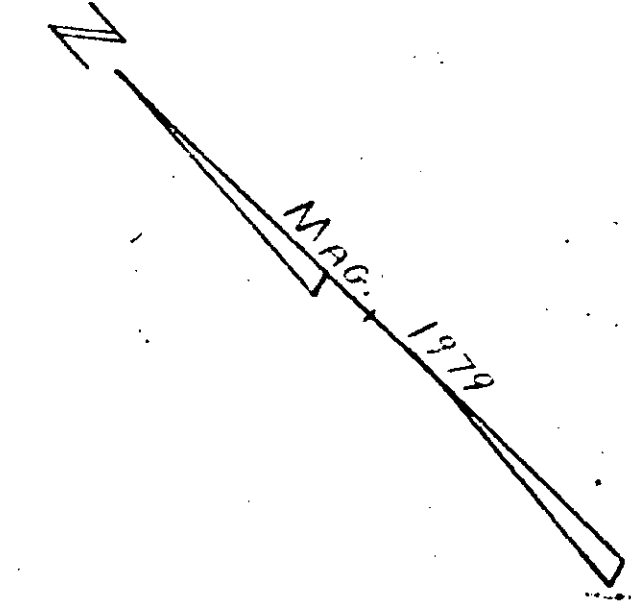

BEGIN R.O.W. PROJECT
BRZ 1442 (2) STA. 10+00 CL

BEGIN PROJECT
M/L 10+02.00 CHAN. 5+02.00
Δ = 90° 19' 15" LT.

END SIDELINE STA. 6+00
CONSTRUCT SATISFACTORY APPROACH

STOP RAILROAD
FEELING CROSS
STA. 10+35.00
F.G. EL. 502.10

MASON, MARTHA D.

END PROJECT, STA. 12+00
CONSTRUCT SATISFACTORY APPROACH

END APPROACH, STA. 13+00

END R.O.W. PROJECT
BRZ 1442 (2) STA. 12+00 CL

NOTE

THIS SHEET IS FOR R.O.W. LIMIT
DETAILS ONLY. REFER TO THE
REMAINING PLAN SHEETS FOR
ALL OTHER CONTRACT DETAILS.

0 10 20 40
SCALE IN FEET

SURVEYED BY	TESSIER	DATE	12/79
DRAWN BY	CRVIS	DATE	2/80
TRACED BY	PRGE	DATE	2/80
PROJ. CHESTER			
NO. BRZ 1442 (2)			
SHEET 5 OF 32			