


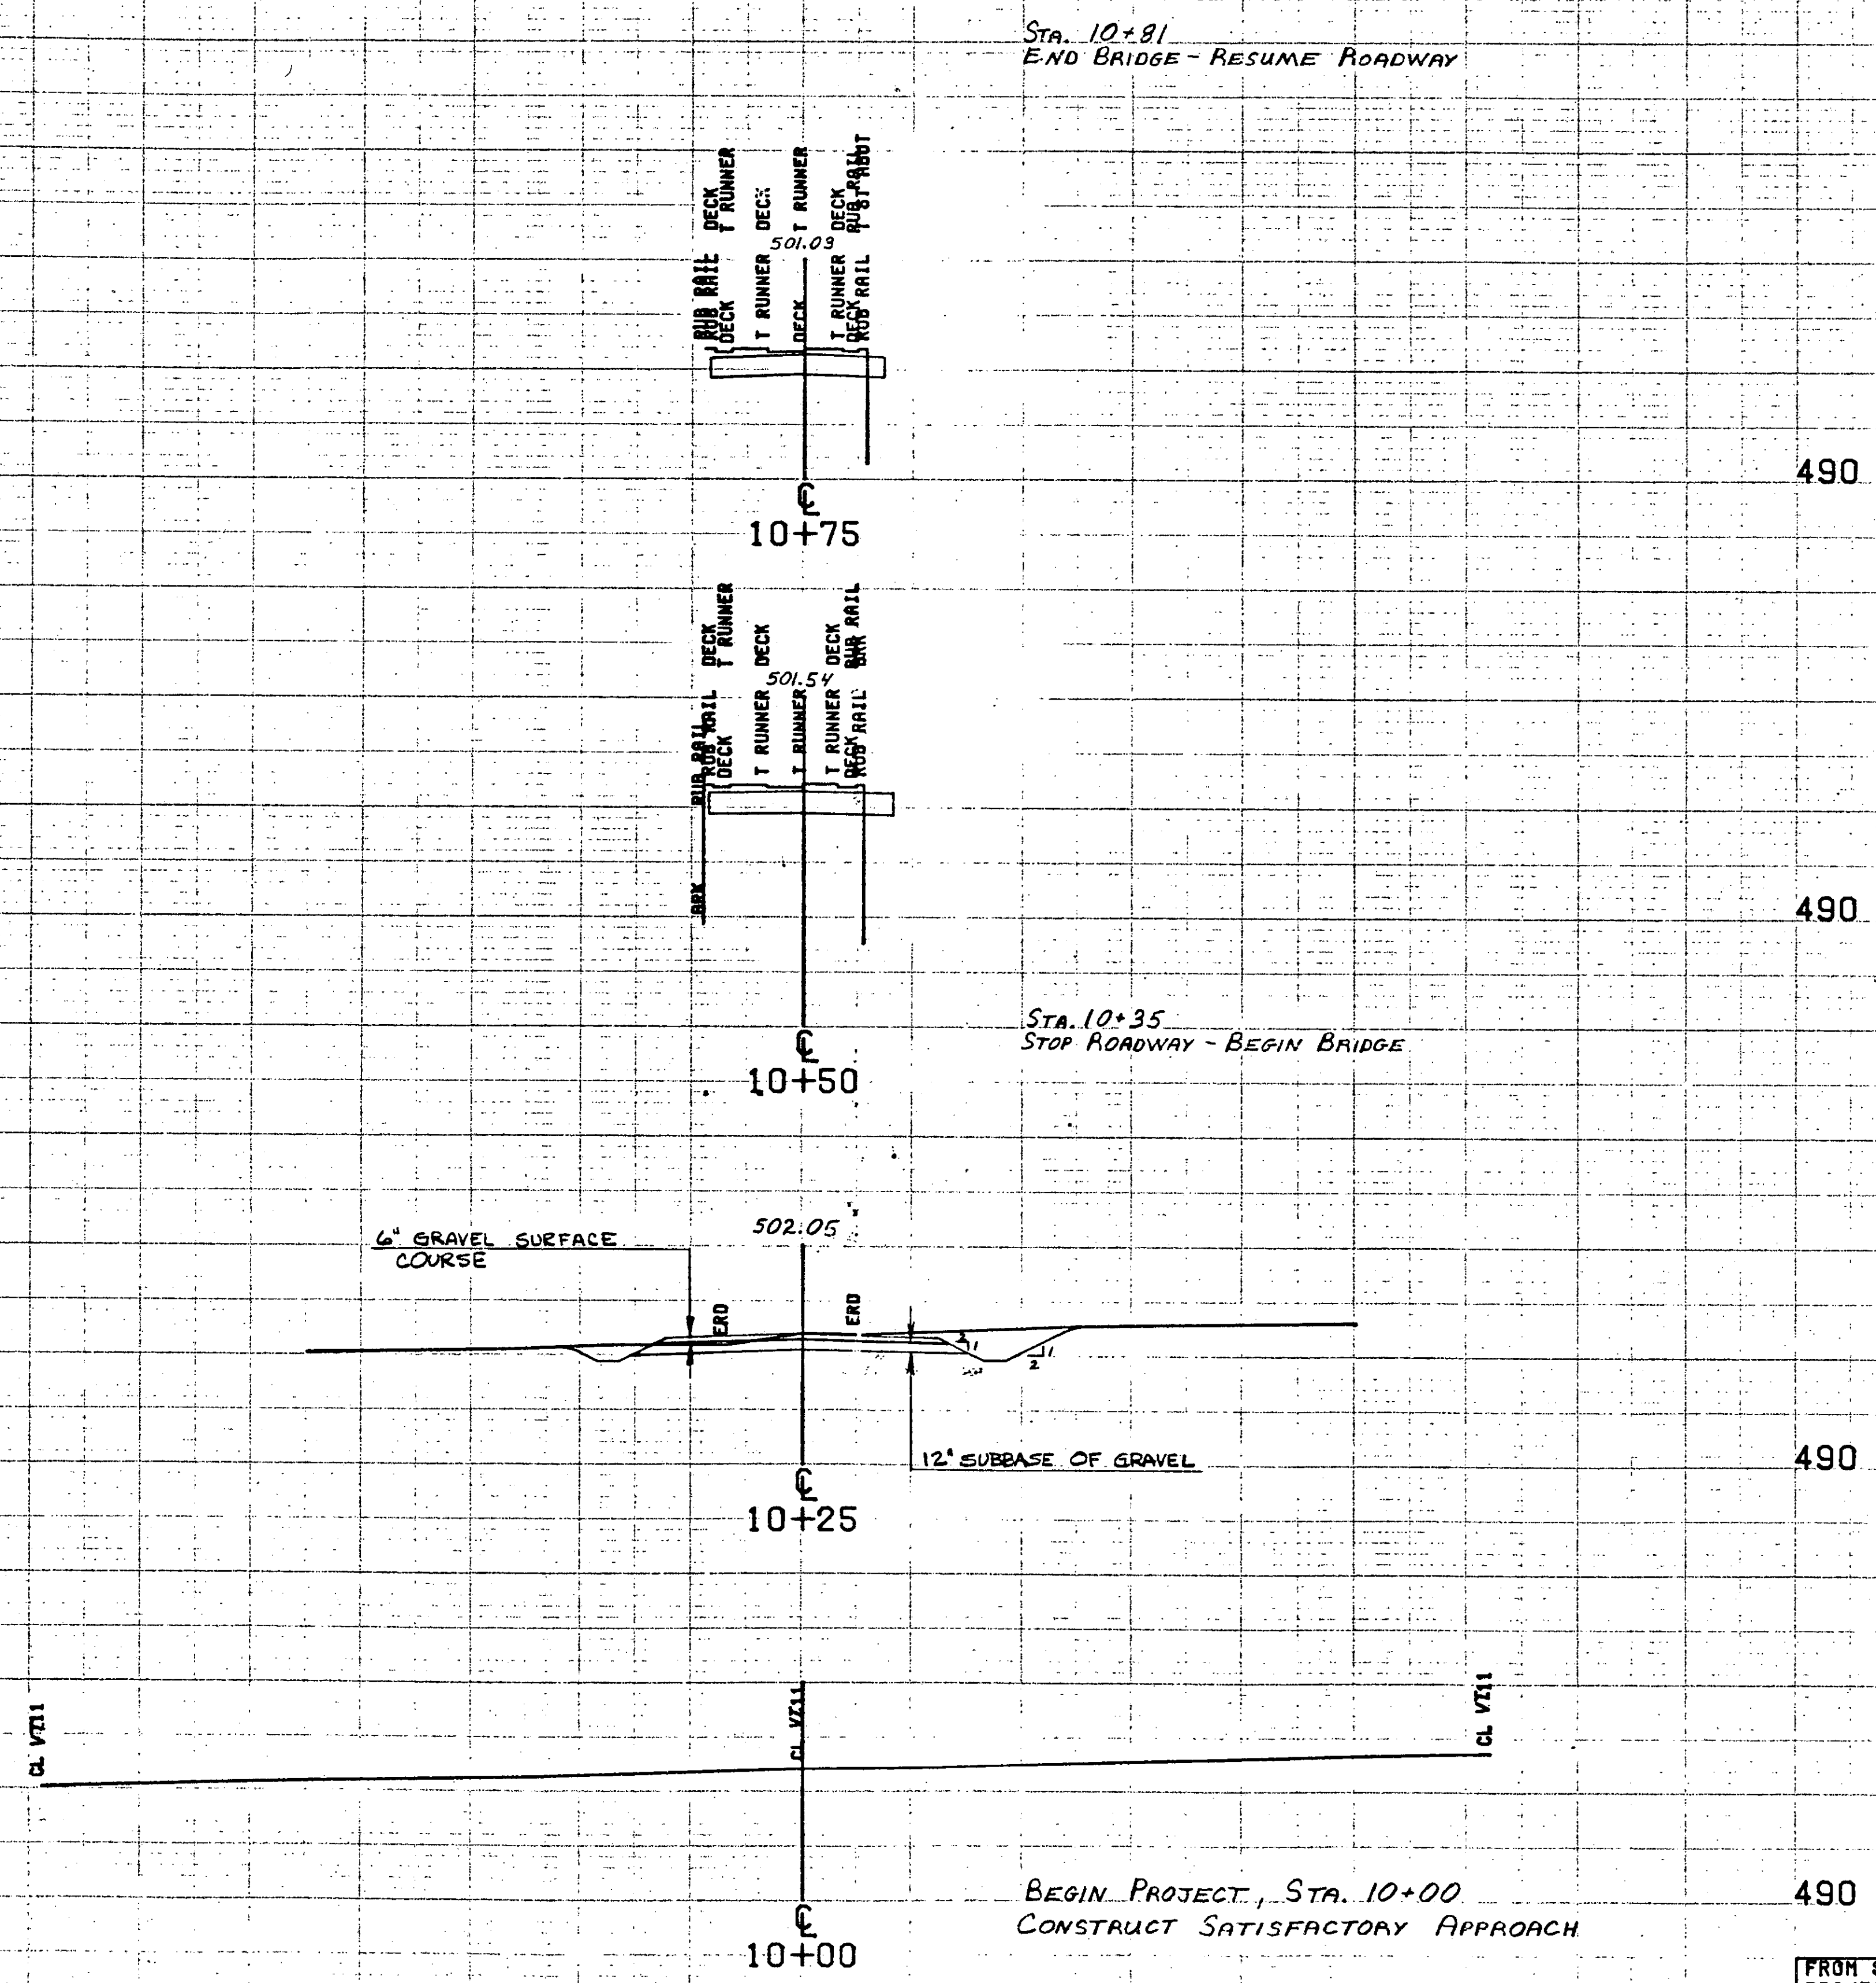

SCALE 1" = 10 FEET

FROM STA. 10+00	TO STA. 10+75
PROJECT NAME	CHESTER MAIN T.H. 57
NO.	BRZ1442(2)
SURVEYED BY	TESSIER
SHEET	OF 12 SHEETS 32
	PLOTTED 02/25/80
	DEC. 1979