




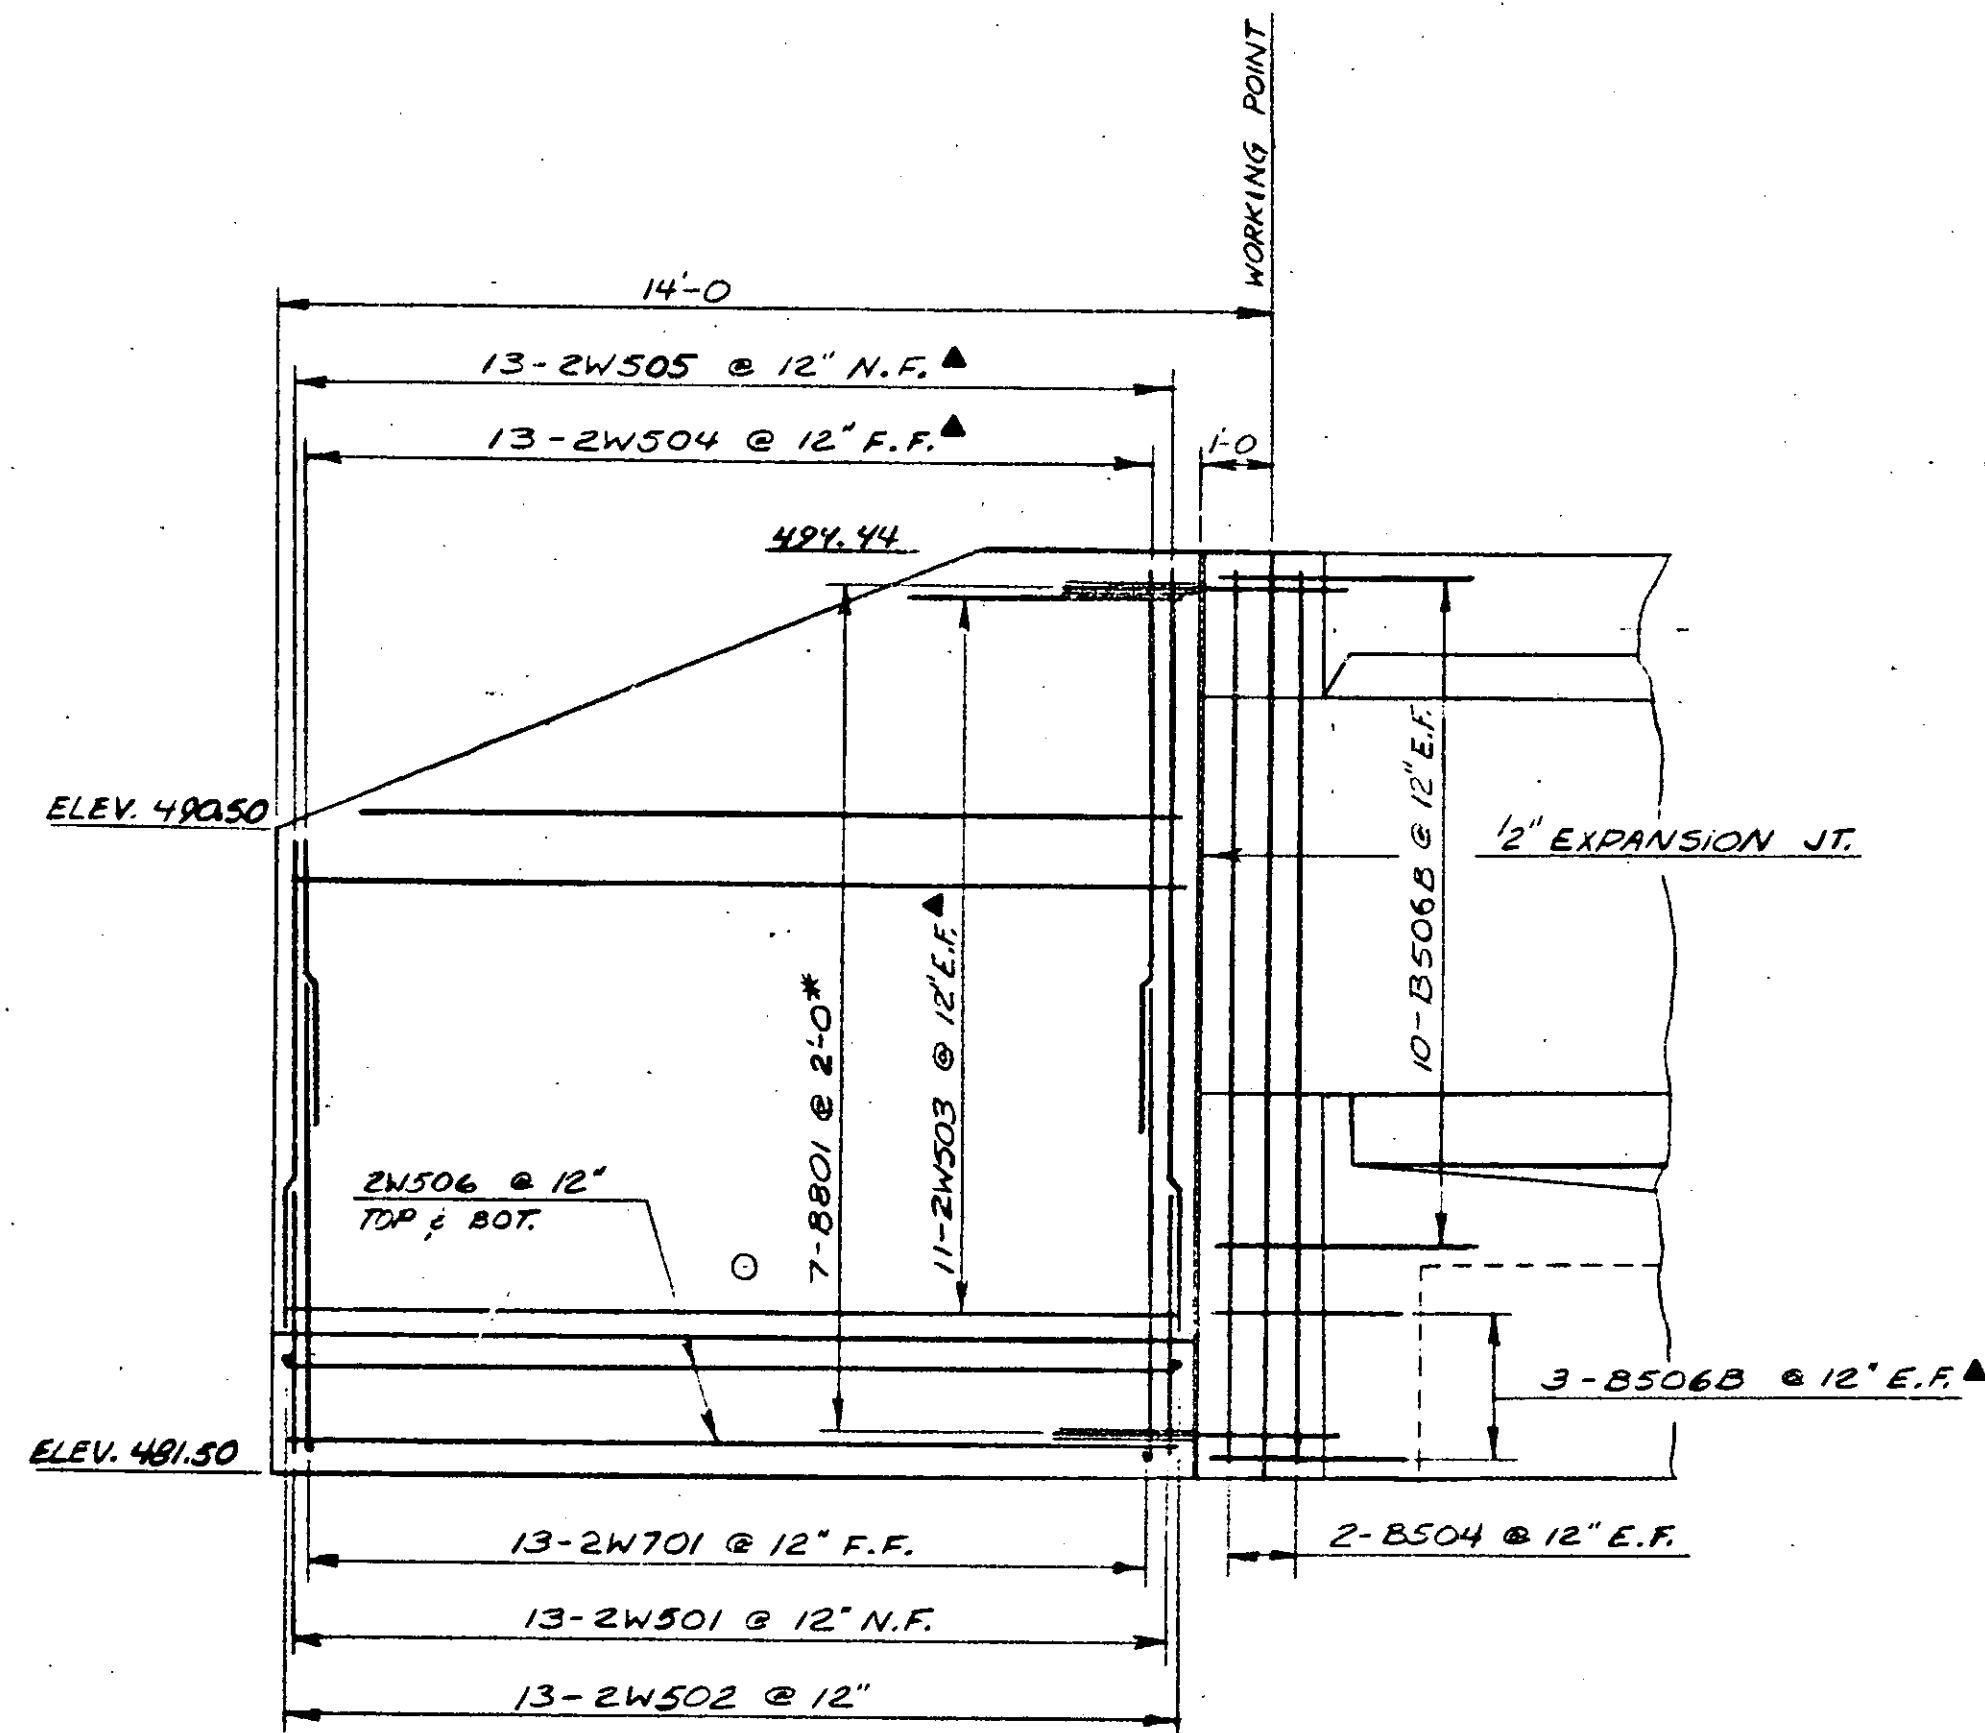


W.W. #2 ELEVATION
SCALE: $\frac{3}{8}'' = 1'-0''$

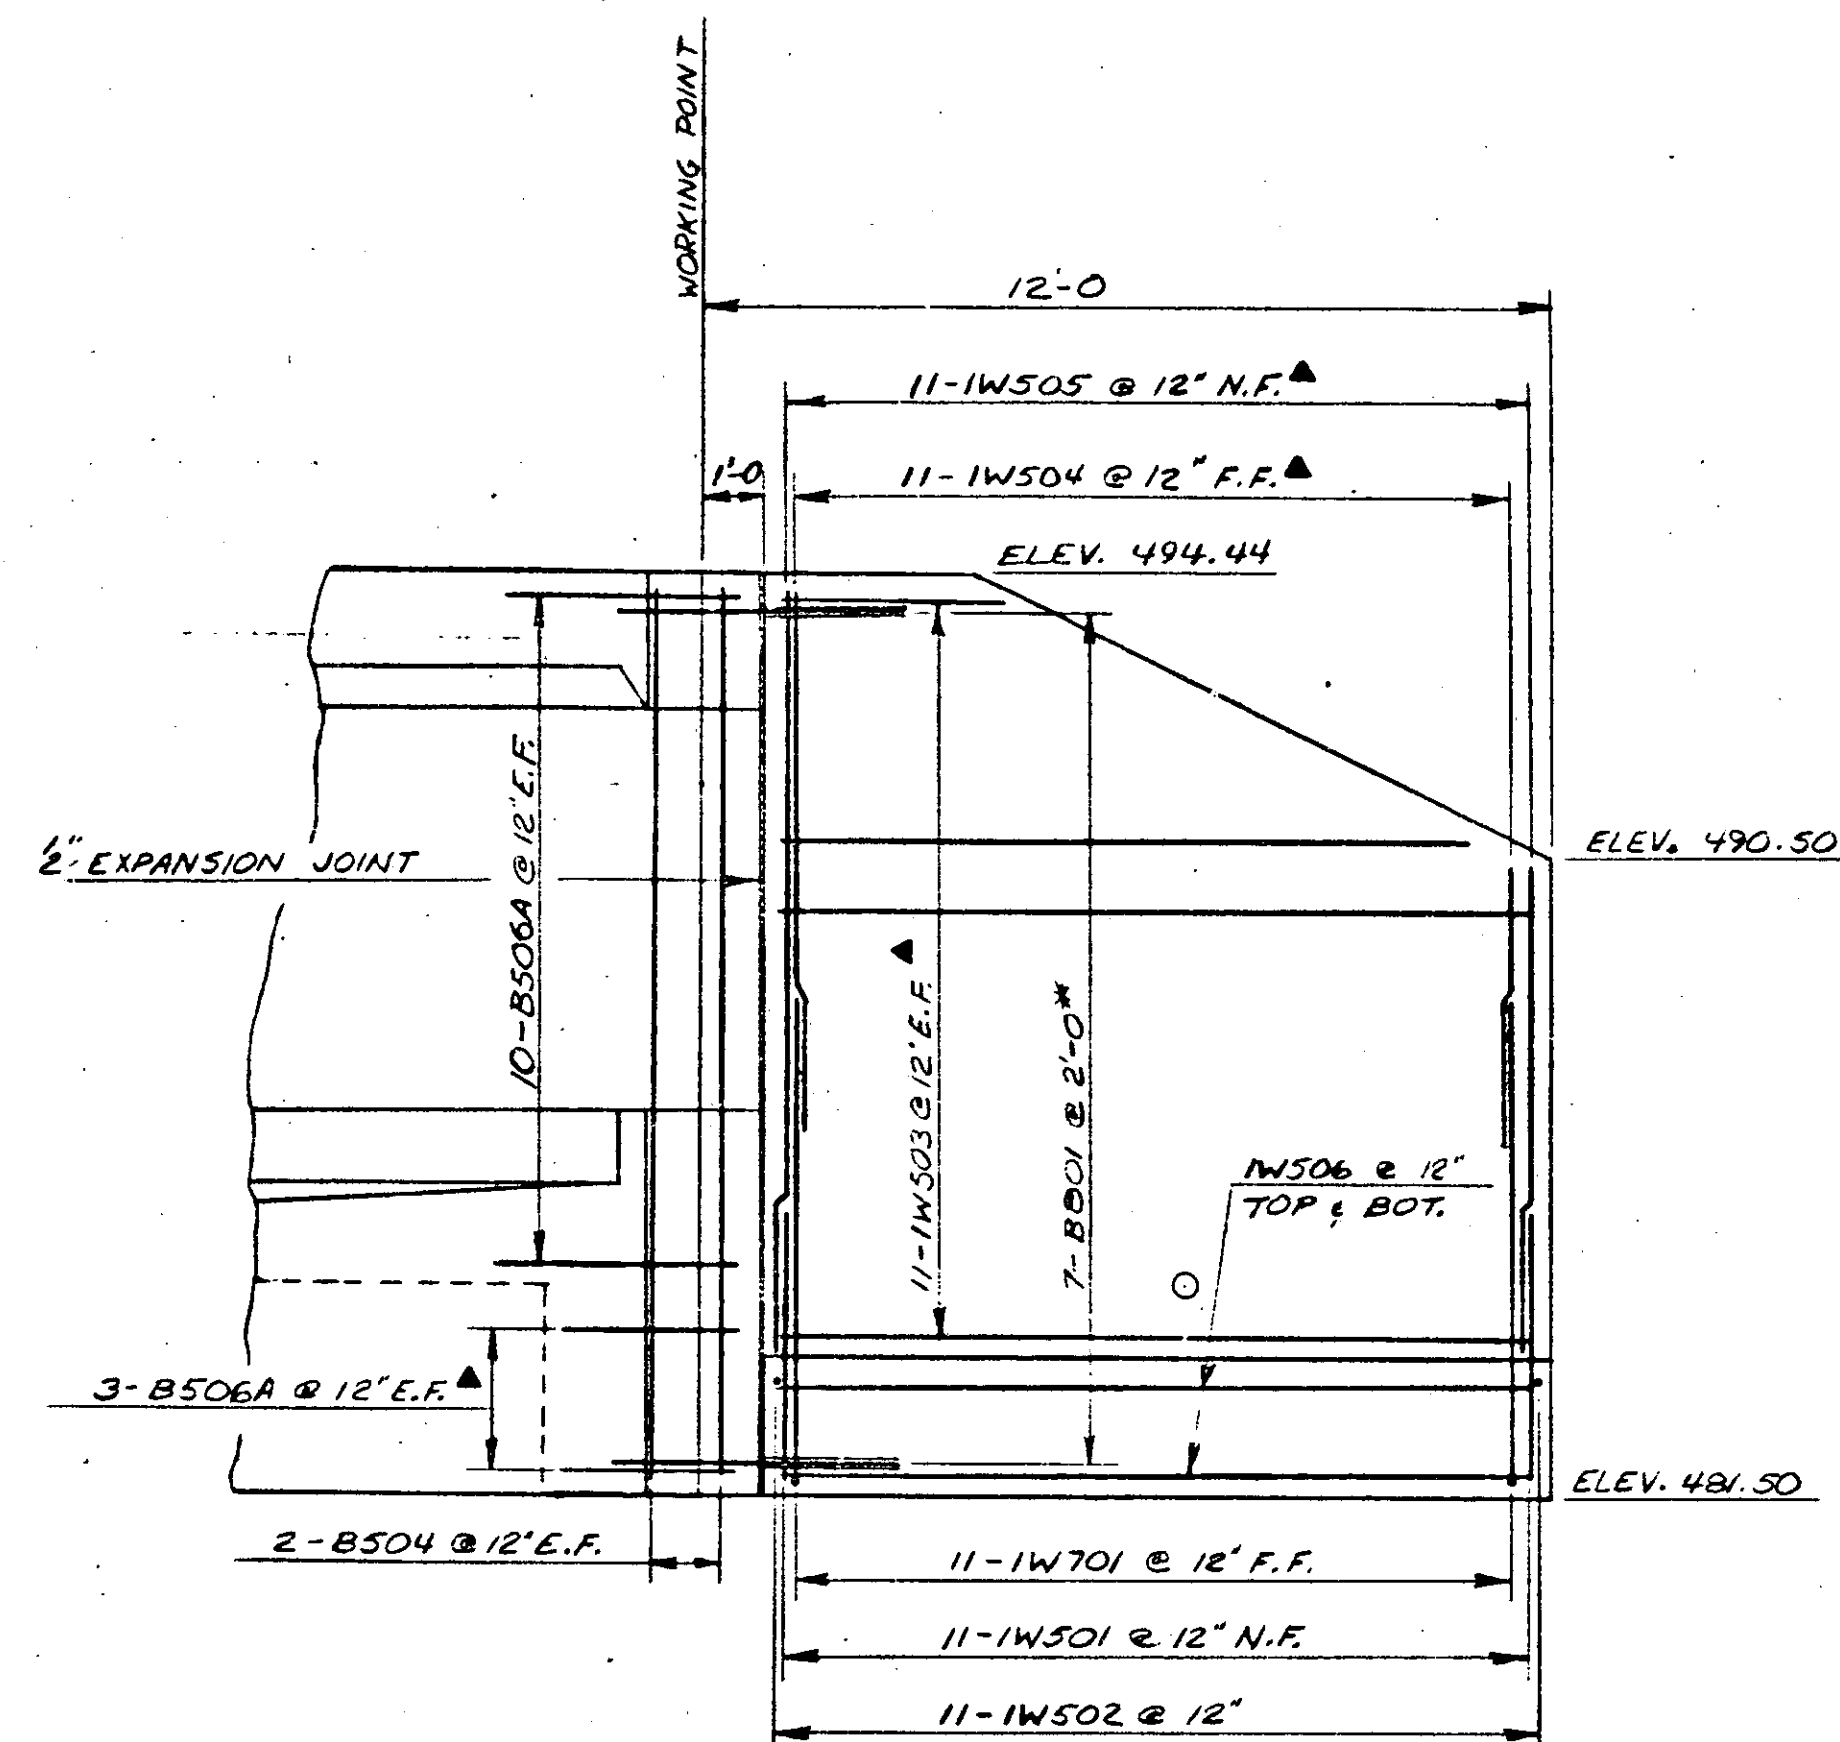


W.W. #1 ELEVATION
SCALE: $\frac{3}{8}'' = 1'-0''$

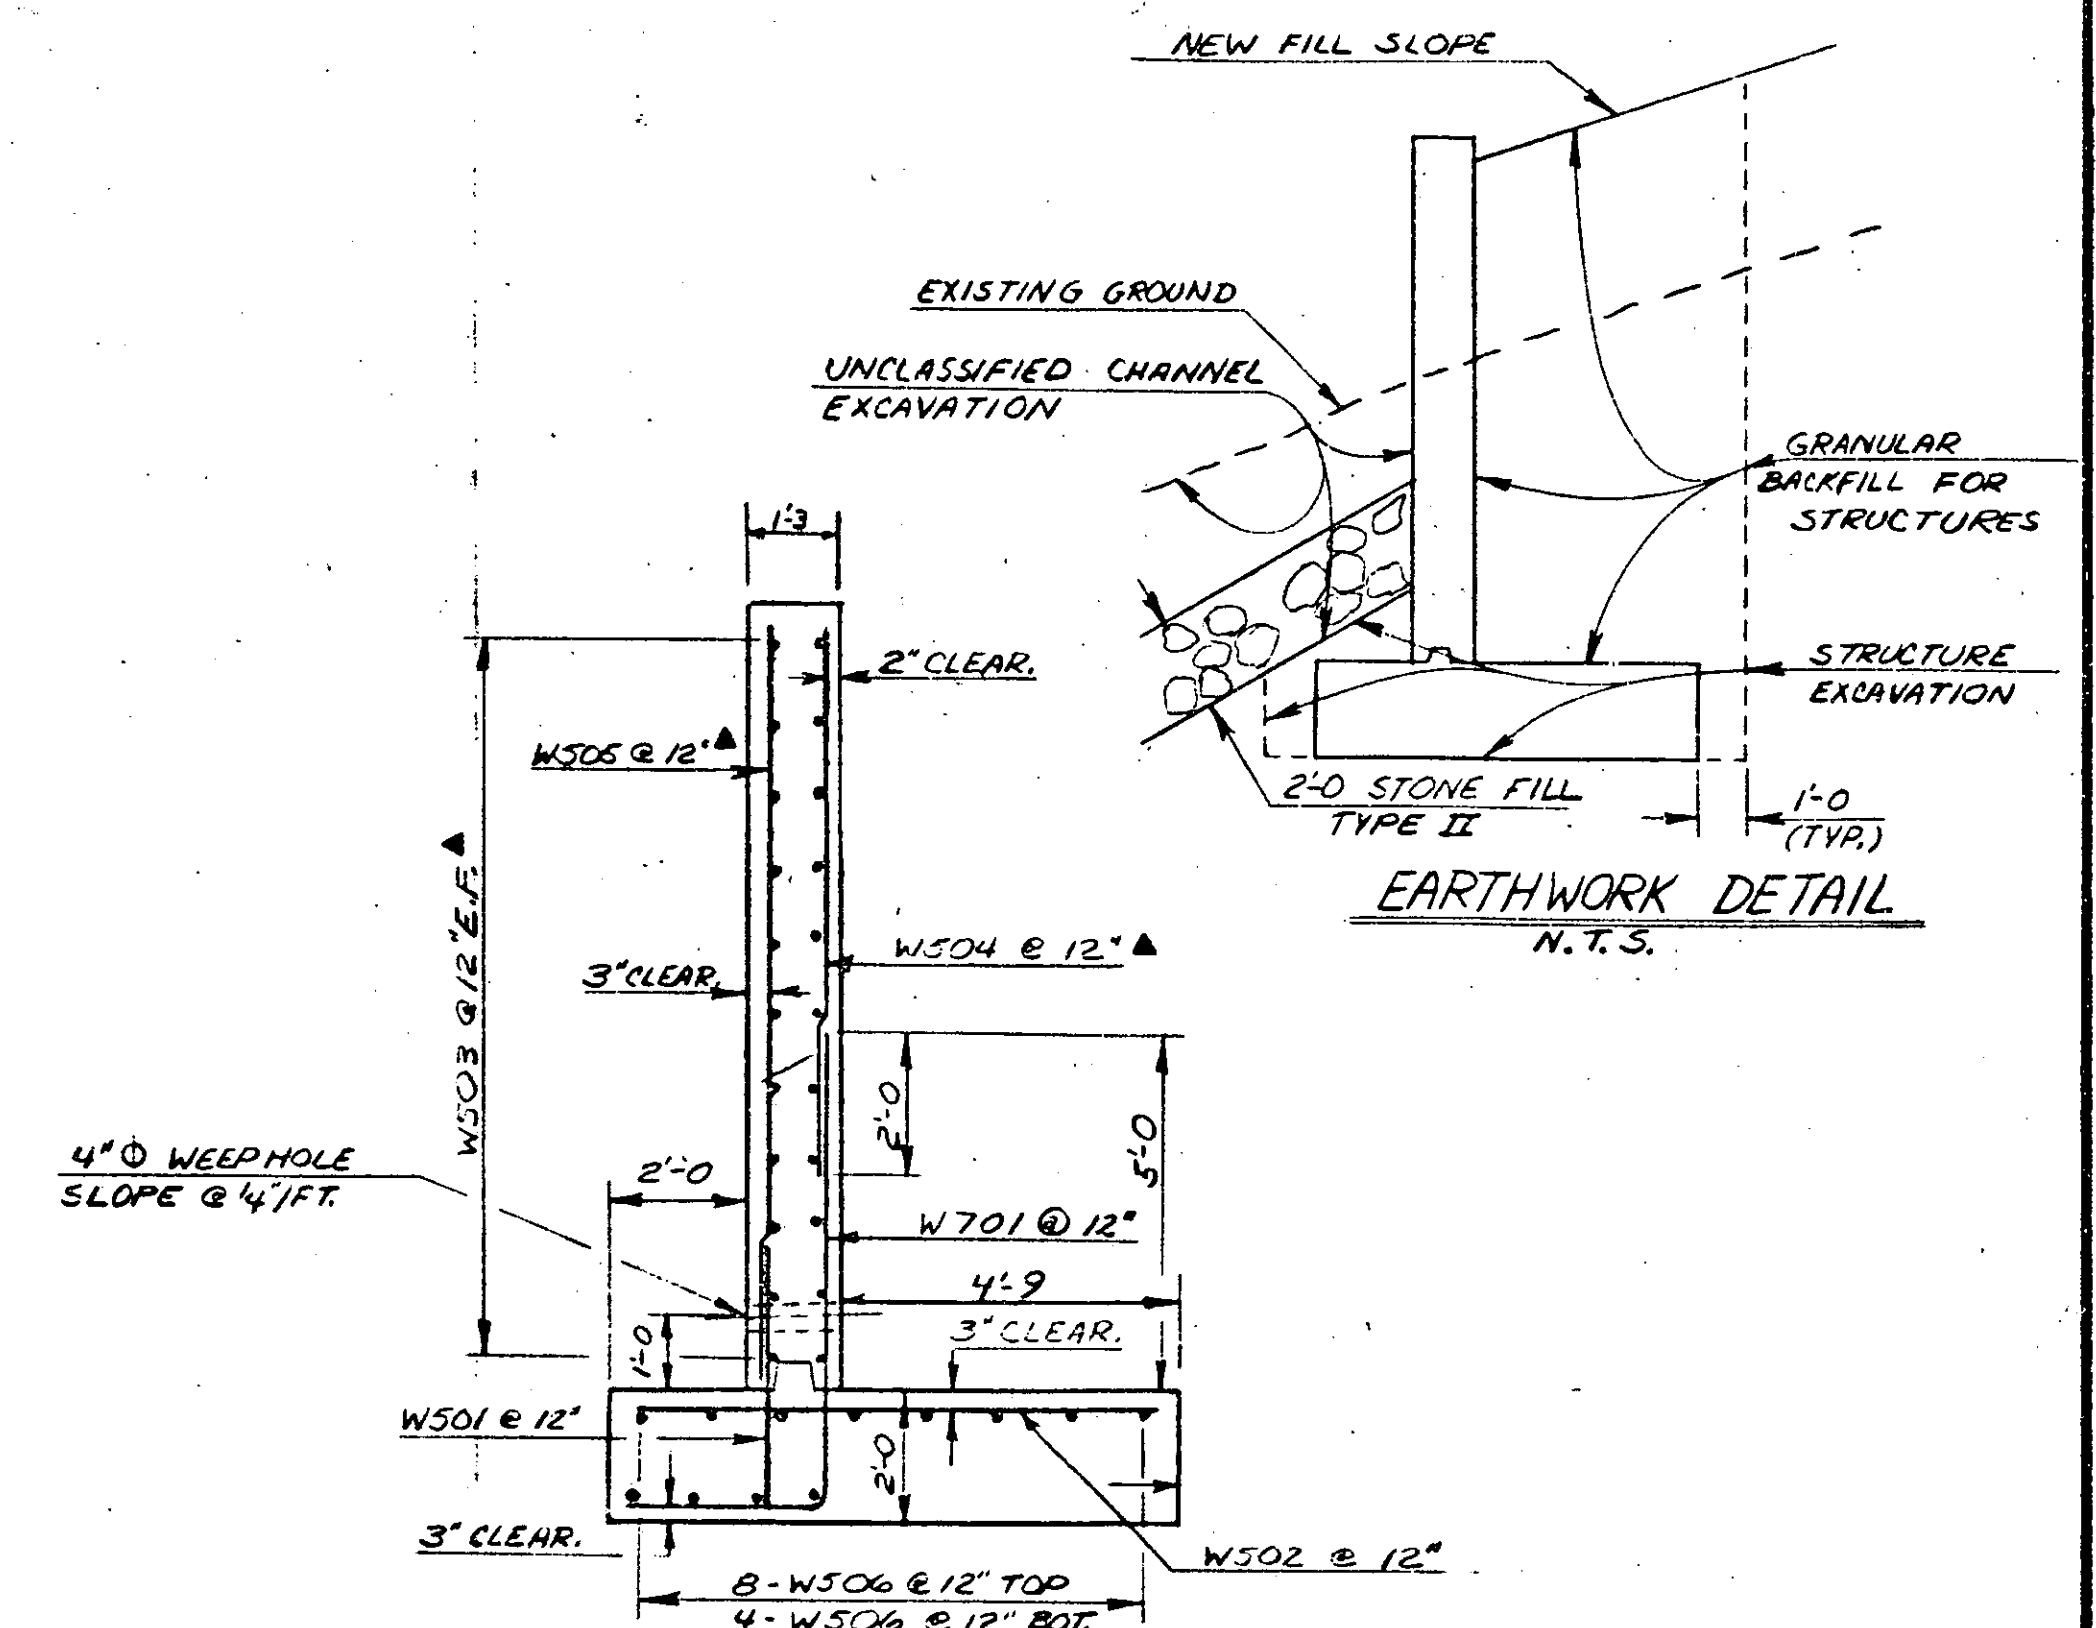


WINGWALL TYPICAL SECTION
SCALE: $\frac{3}{8}'' = 1'-0''$

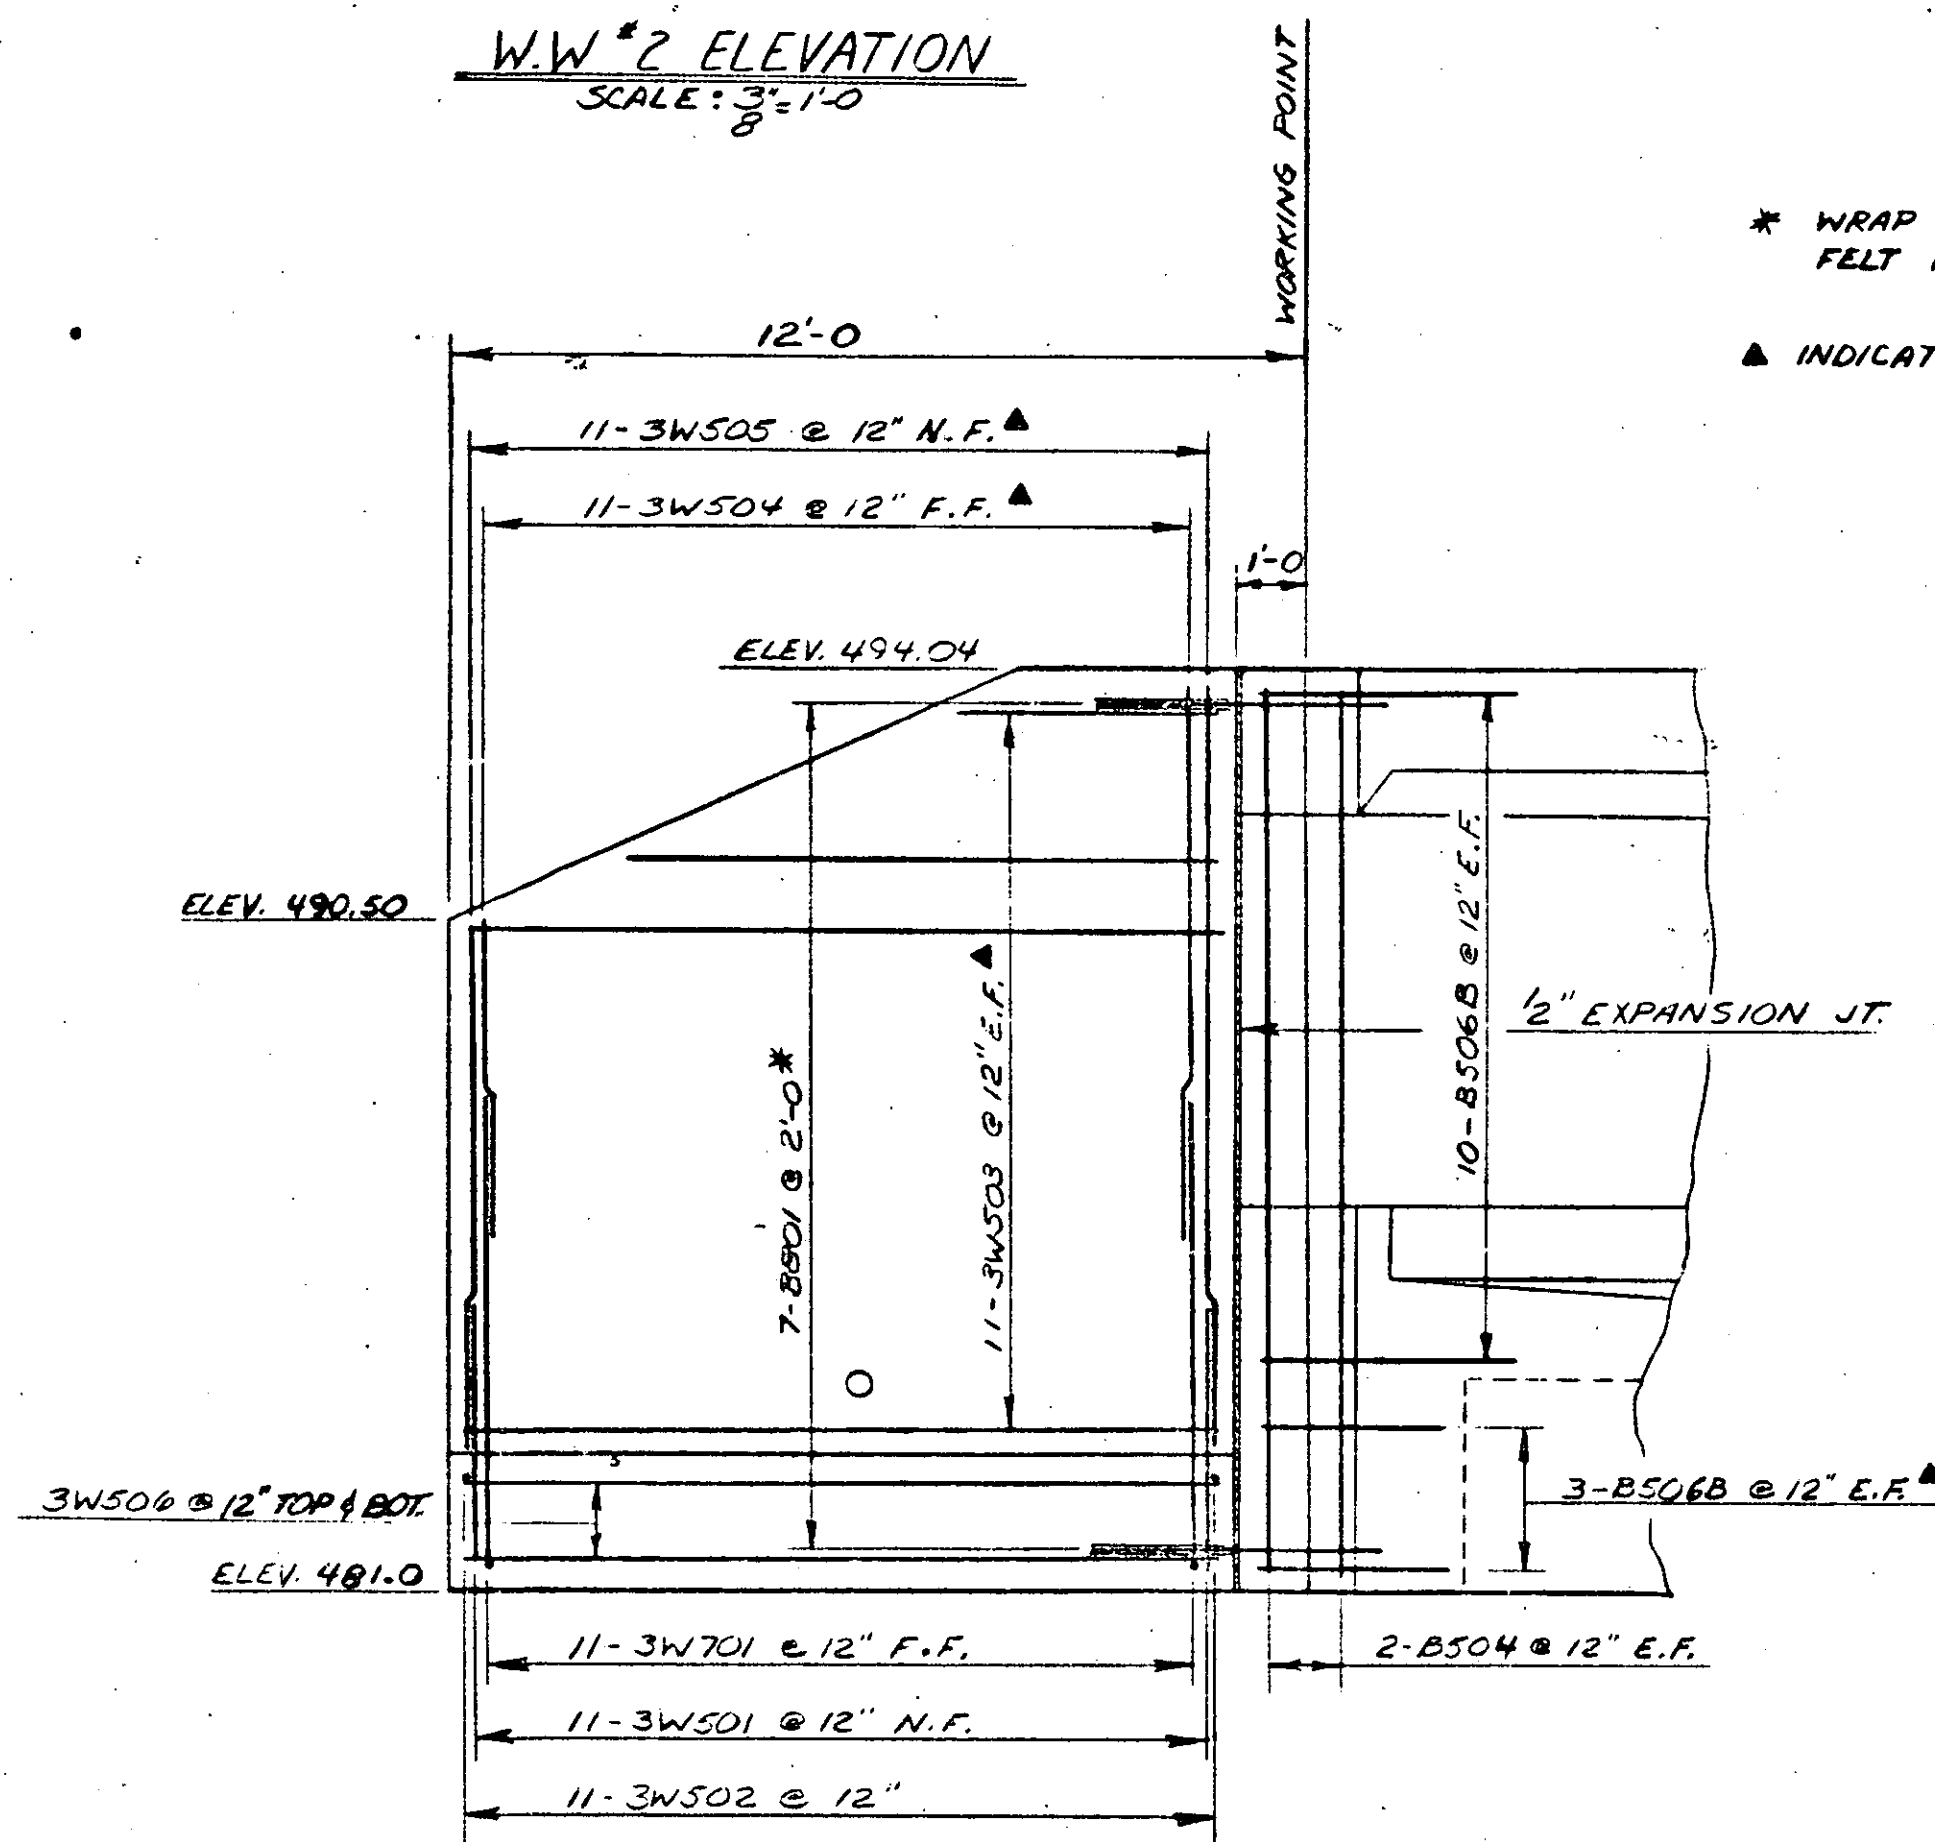

W.W. #3 ELEVATION
SCALE: $\frac{3}{8}'' = 1'-0''$

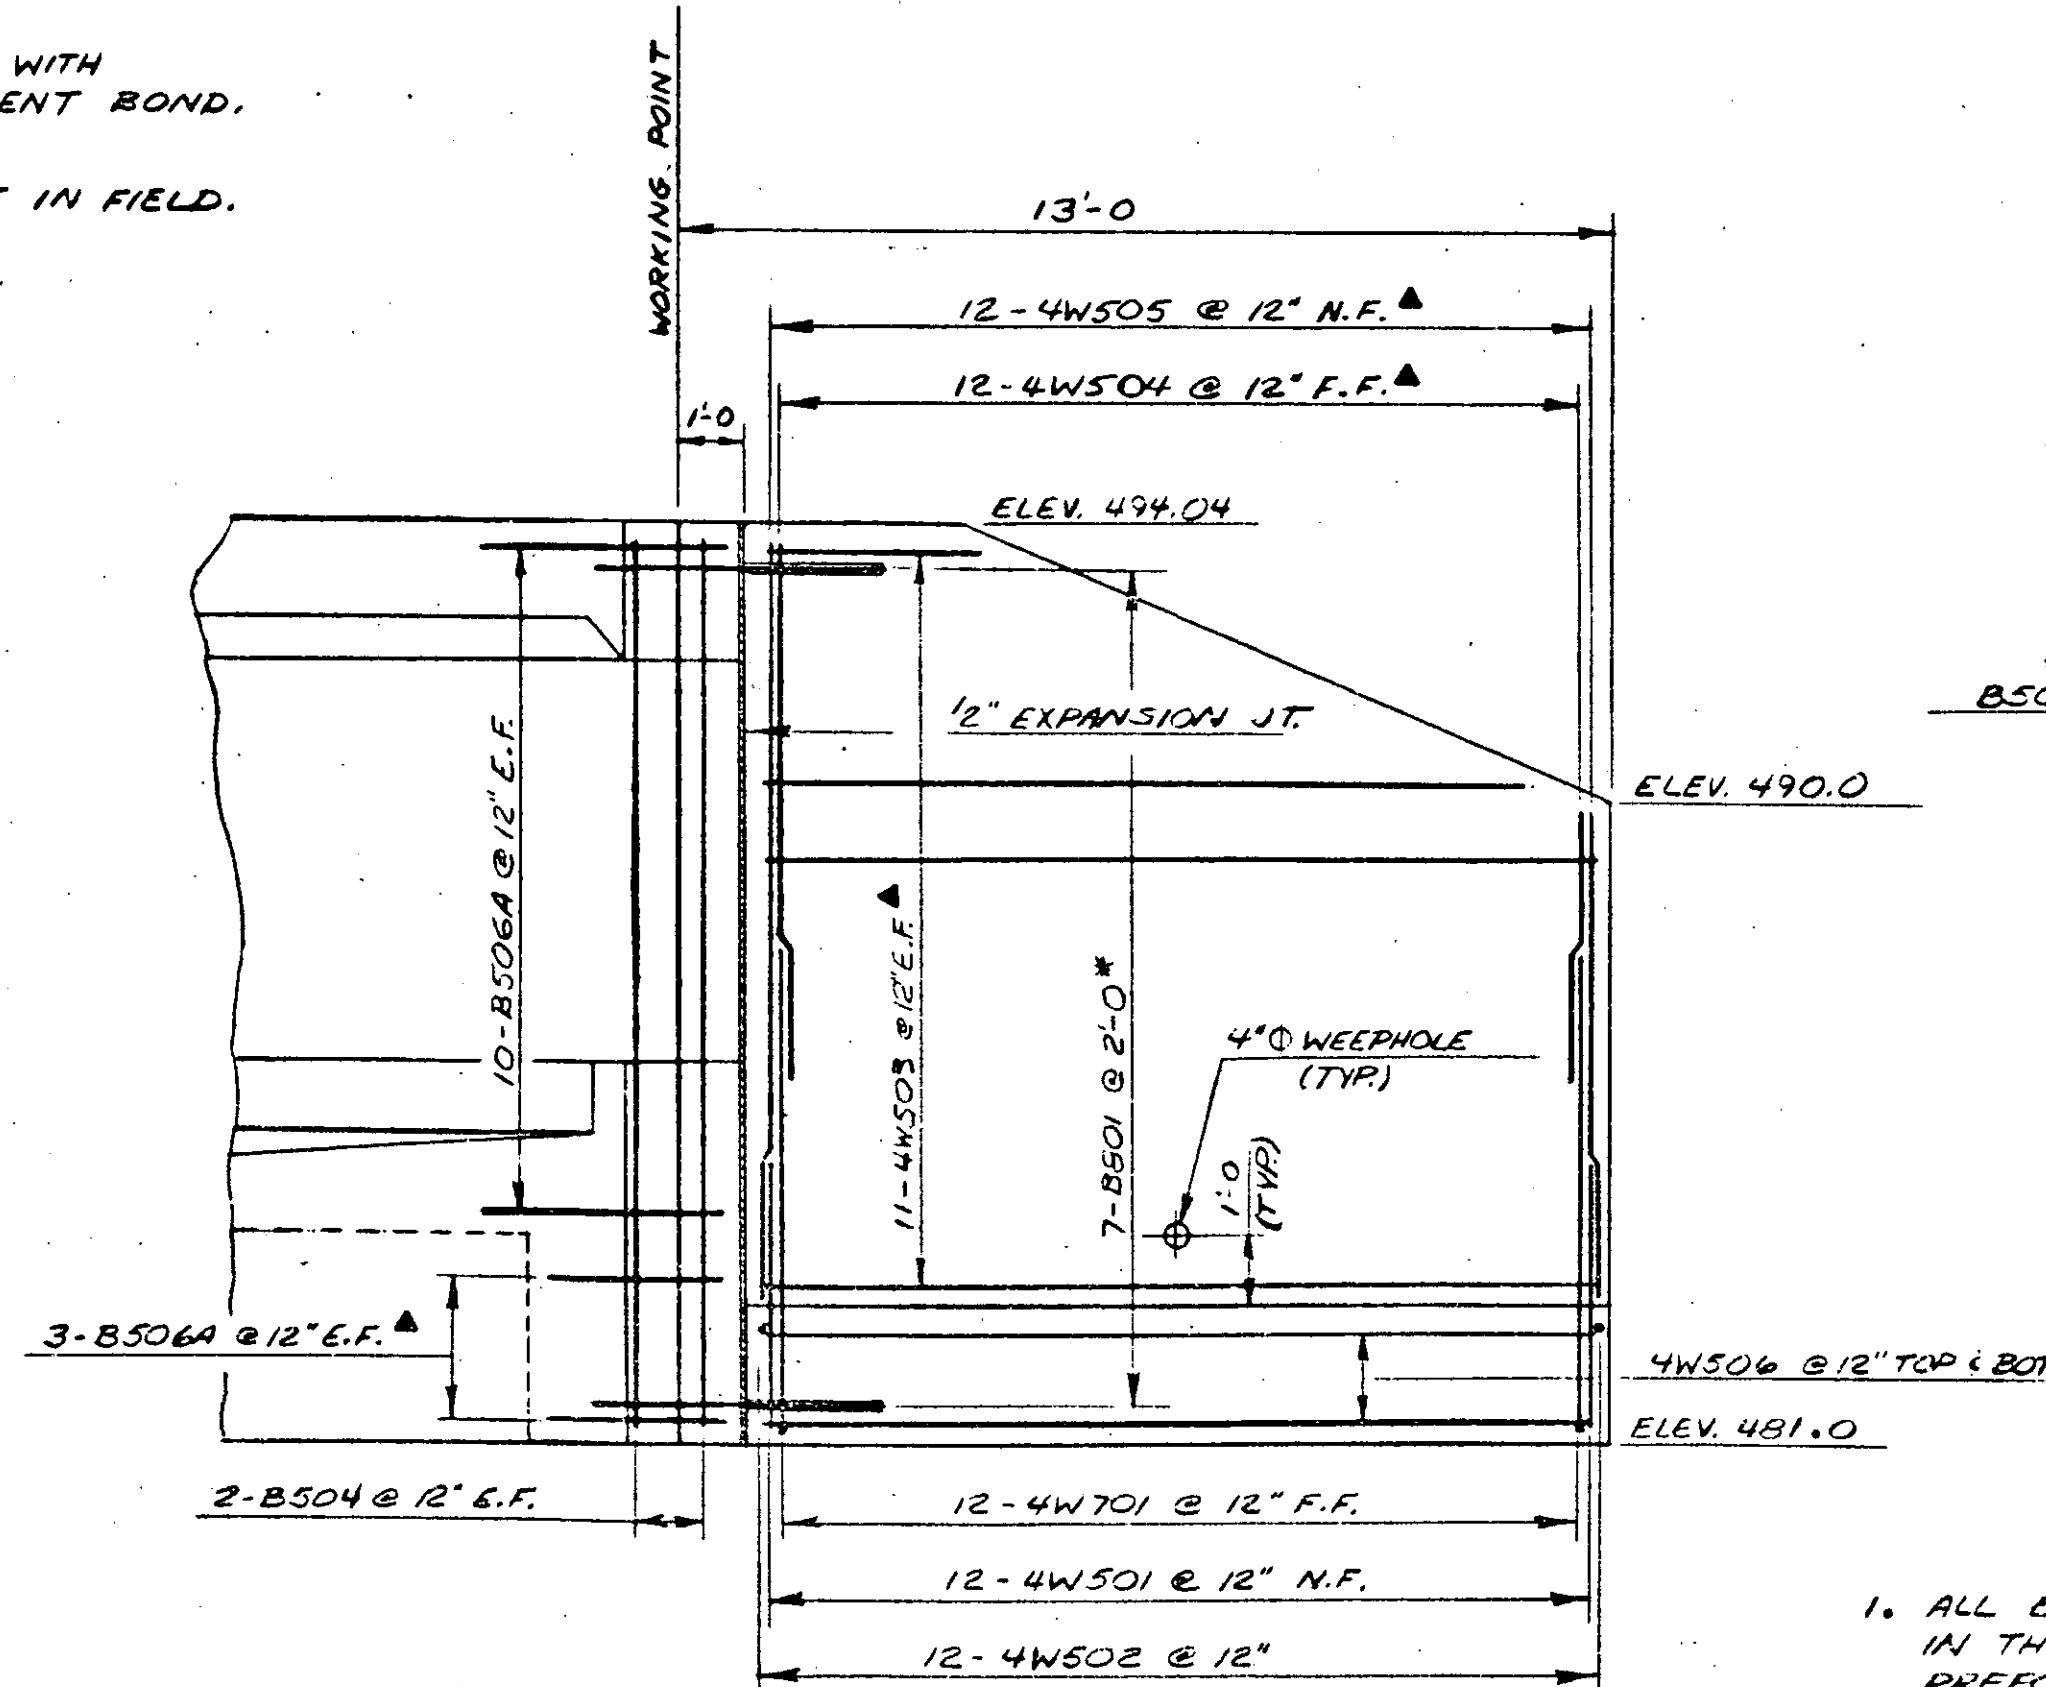

W.W. #4 ELEVATION
SCALE: $\frac{3}{8}'' = 1'-0''$

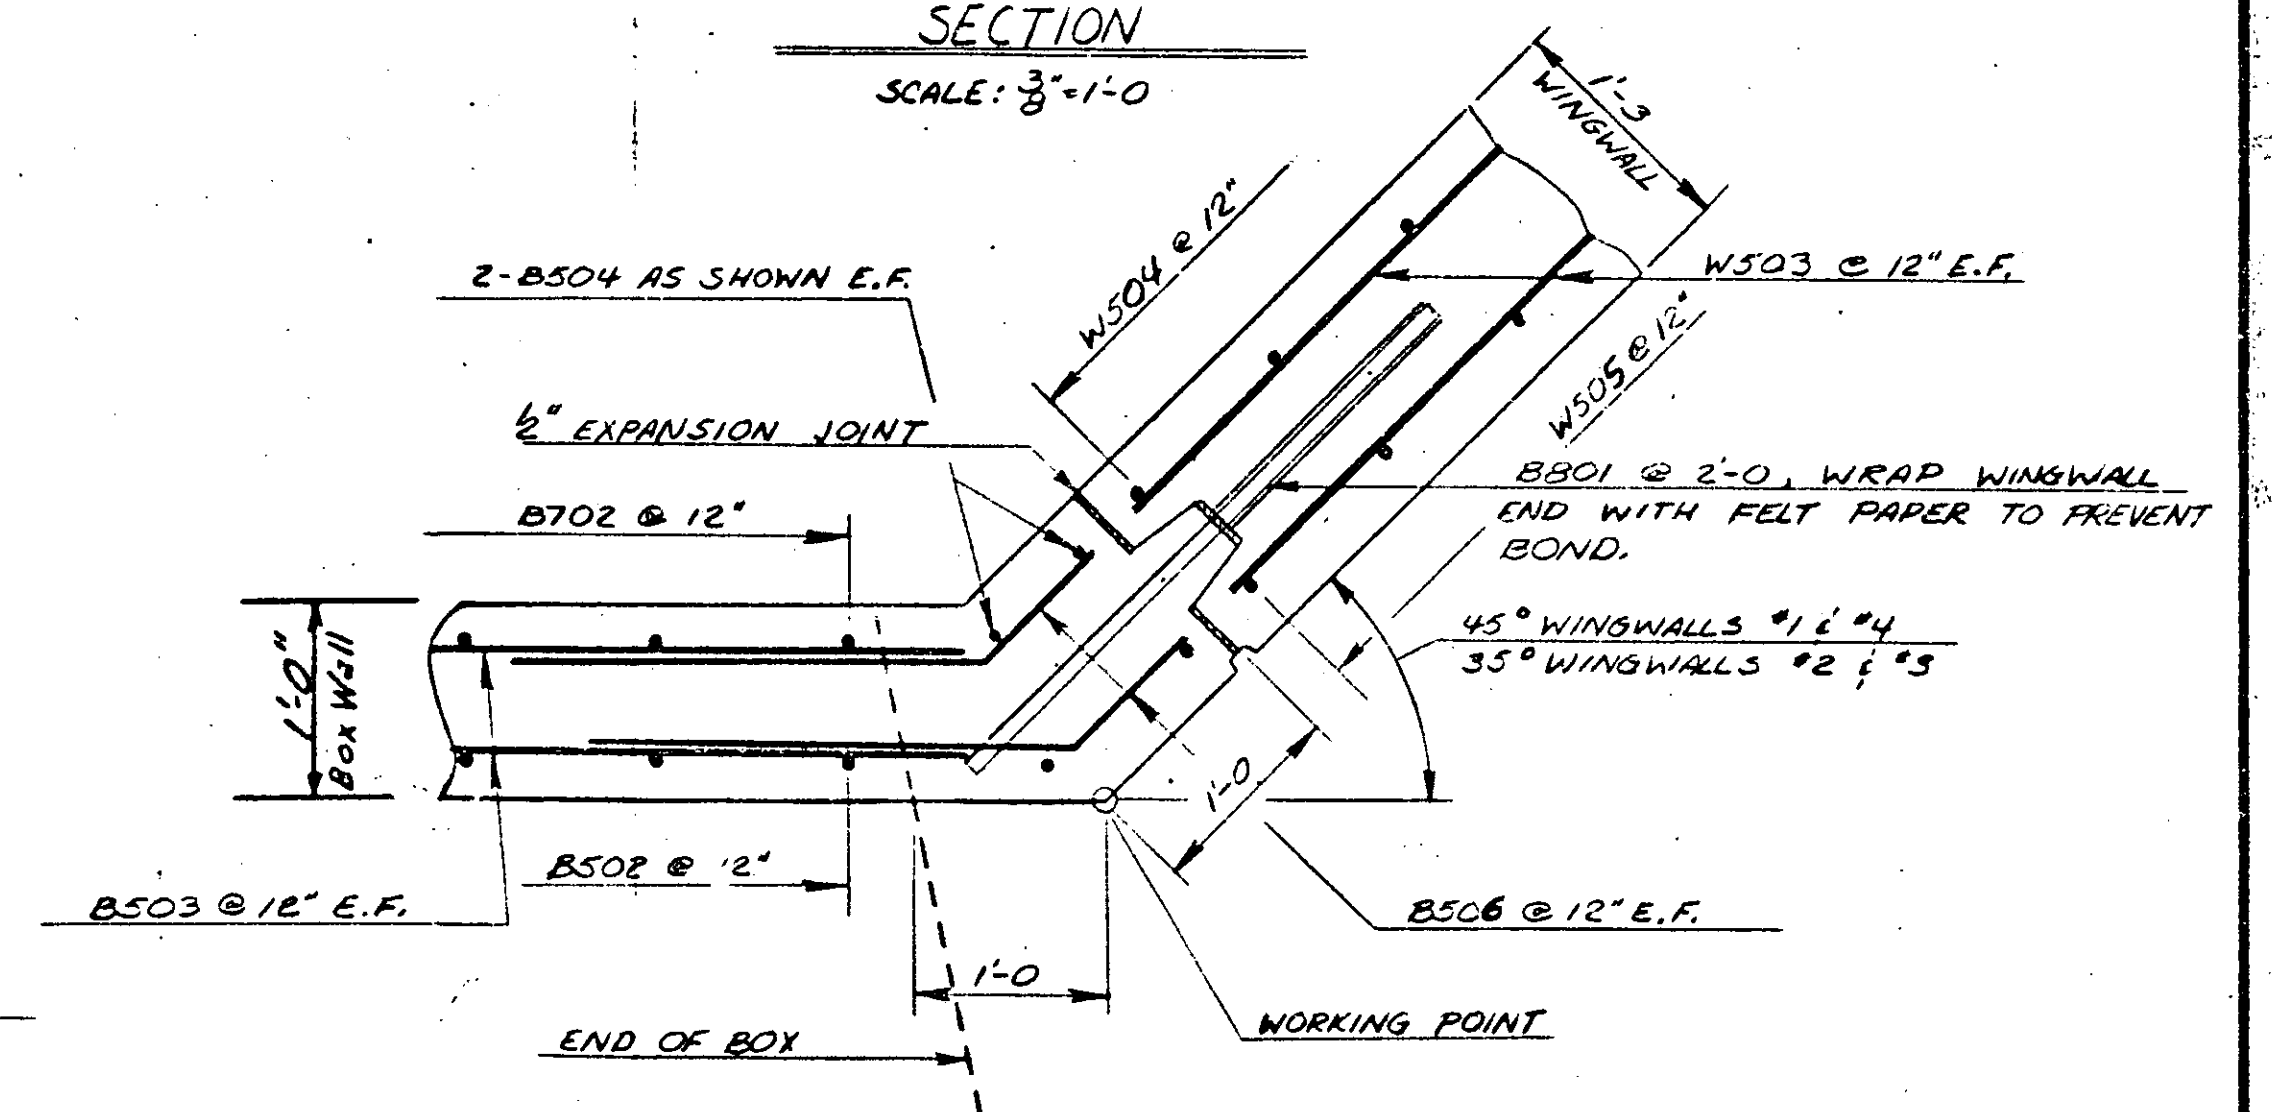

CORNER TYPICAL
SCALE: $1'' = 1'-0''$

NOTES

1. ALL EXPANSION MATERIAL TO BE USED IN THE EXPANSION JOINTS SHALL BE PREFORMED, CLOSED CELL FOAM EXPANSION MATERIAL.
2. SEE SCB-D6-73 FOR DETAILS OF CONSTRUCTION JOINTS AND VERTICAL EXPANSION JOINTS.

STATE OF VERMONT AGENCY OF TRANSPORTATION	
TOWN OF CHESTER	Bridge No. 60
HIGHWAY NO. TH 24	Log Sta. 12+19
TH 24 OVER BROOK	
WING DETAIL : REINFORCEMENT	
Designed by W. J. JEFFS	Drawn by G. SCHULLEY
Checked by D.C. WILLEY date 7-83	Bridge Design Supervisor R.L. Osley date 9-83
PROJECT CHESTER	PROJECT NO. BRZ 1442 (8)
Bridge Sheet No. 25	Sheet 25 of 32