


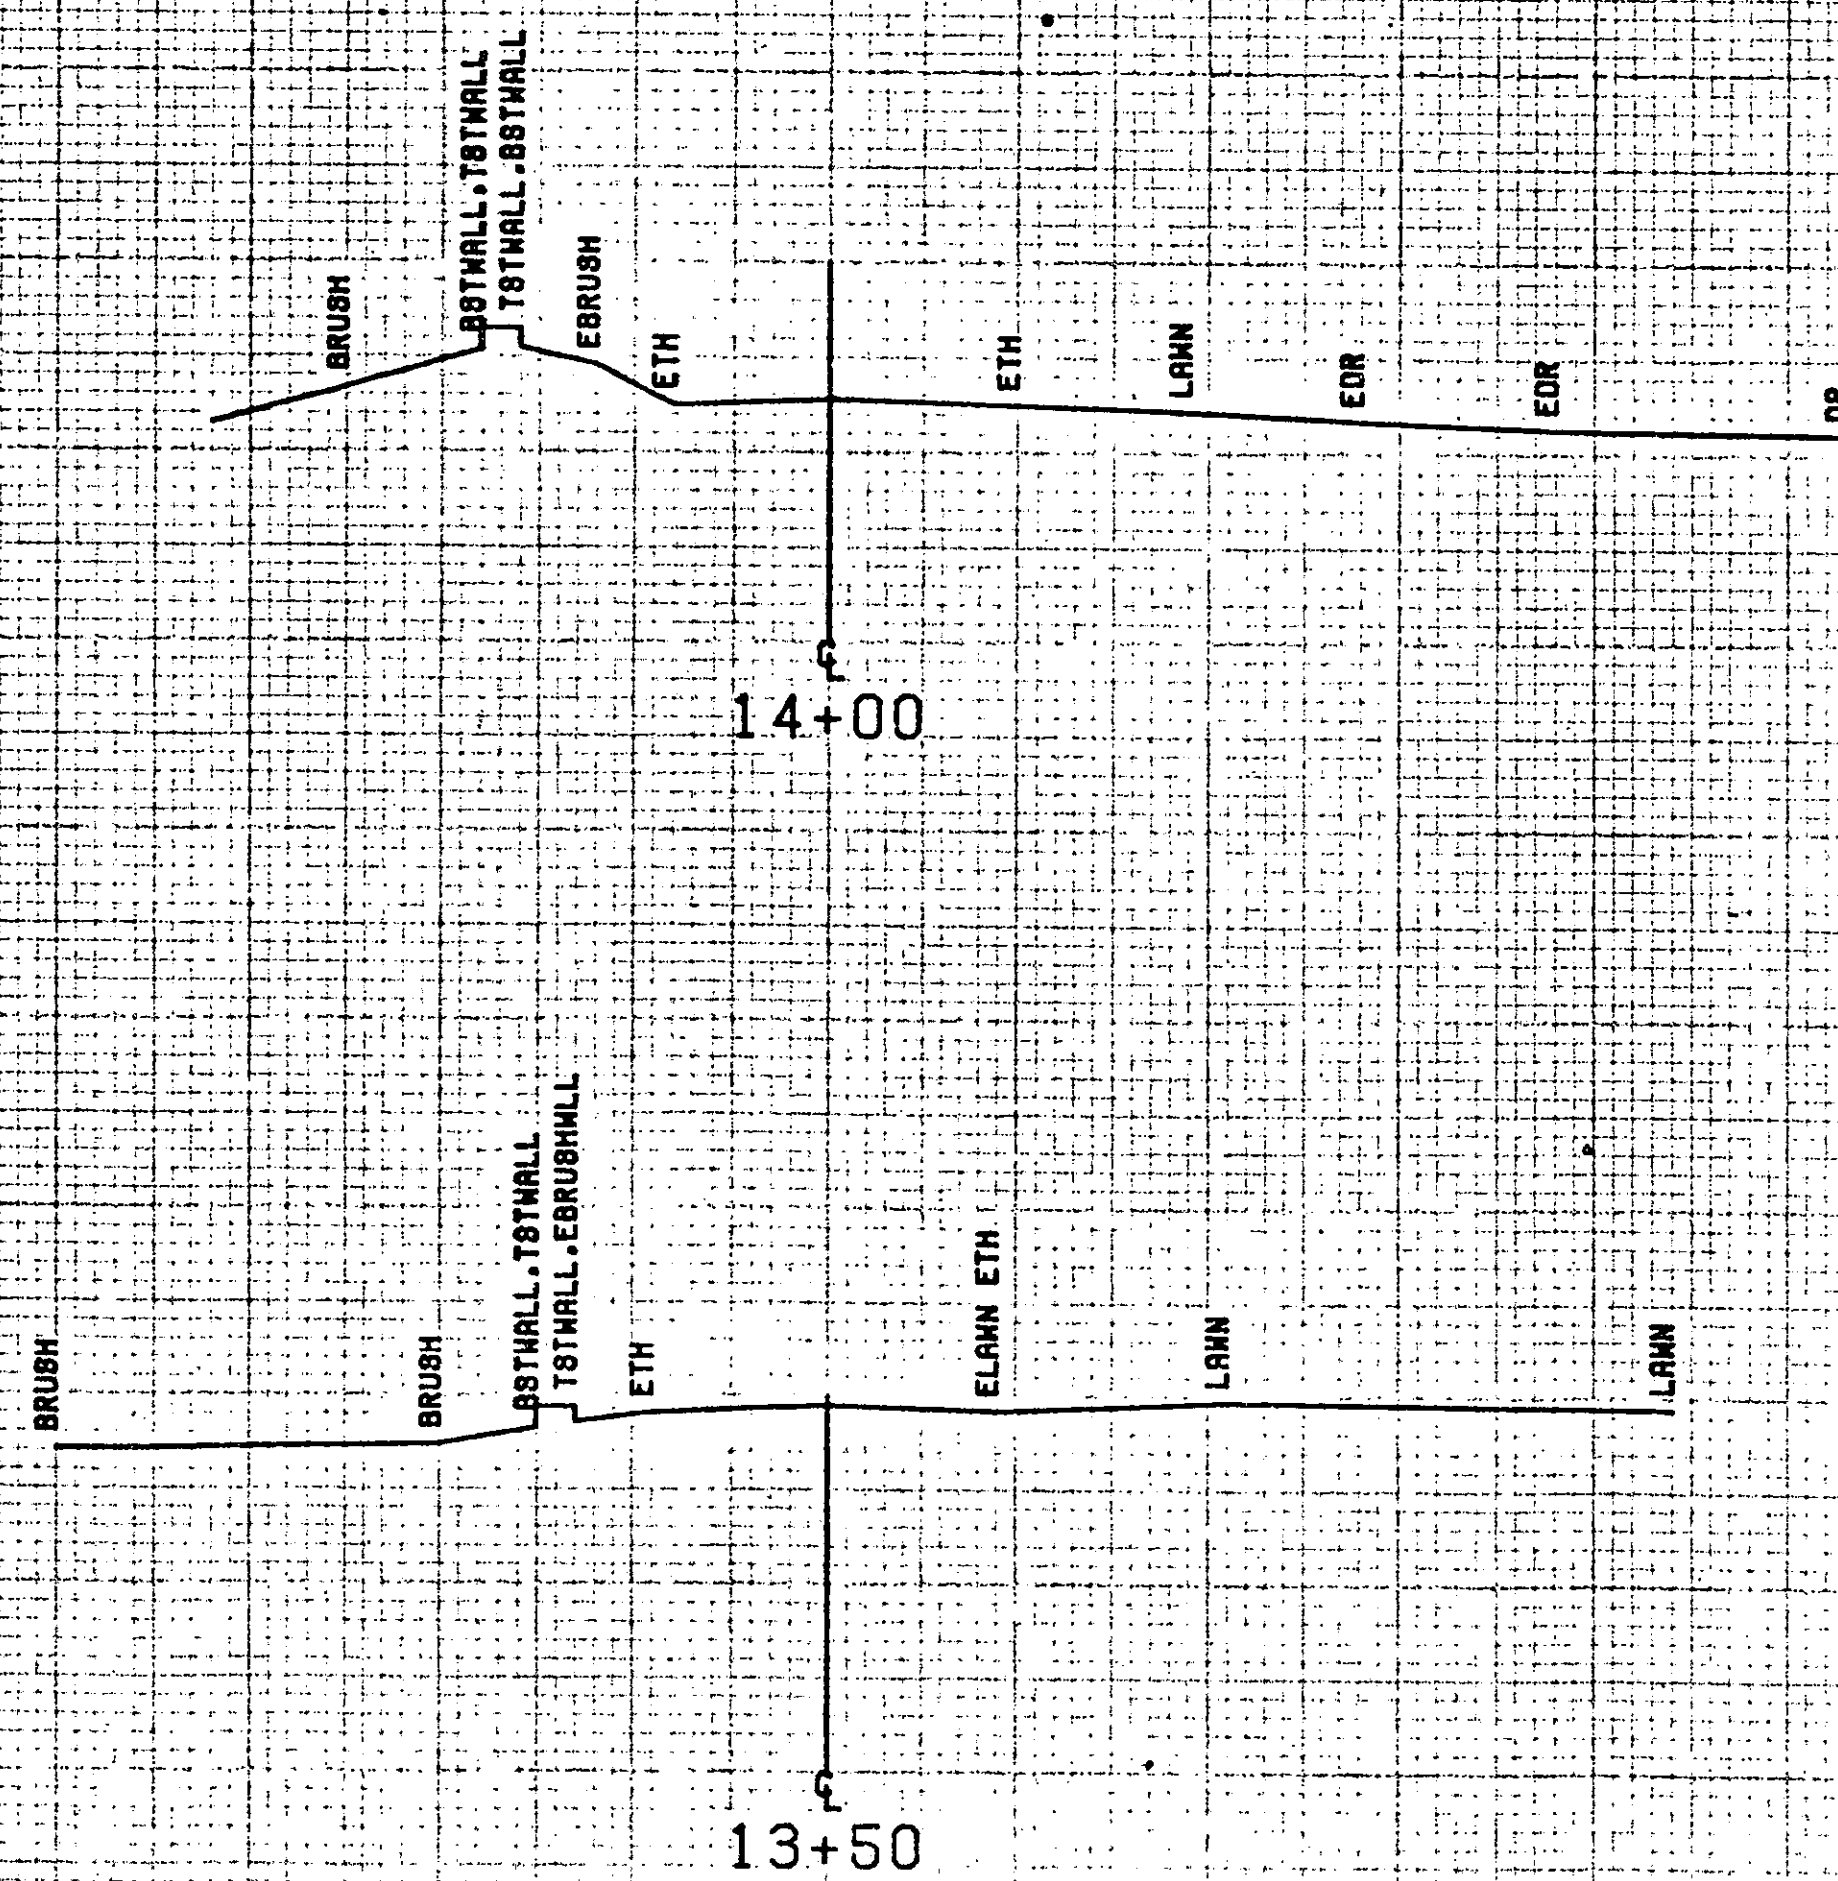

500

490

SCALE 10 FEET

FROM STA. 13+50	TO STA. 14+00
PROJECT NAME	CHESTER MAIN
NO.	BR21442(8)
SURVEYED BY	O COLBY
SHEET 29 OF 32	PLOTTED 01/29/82 12/04/81