
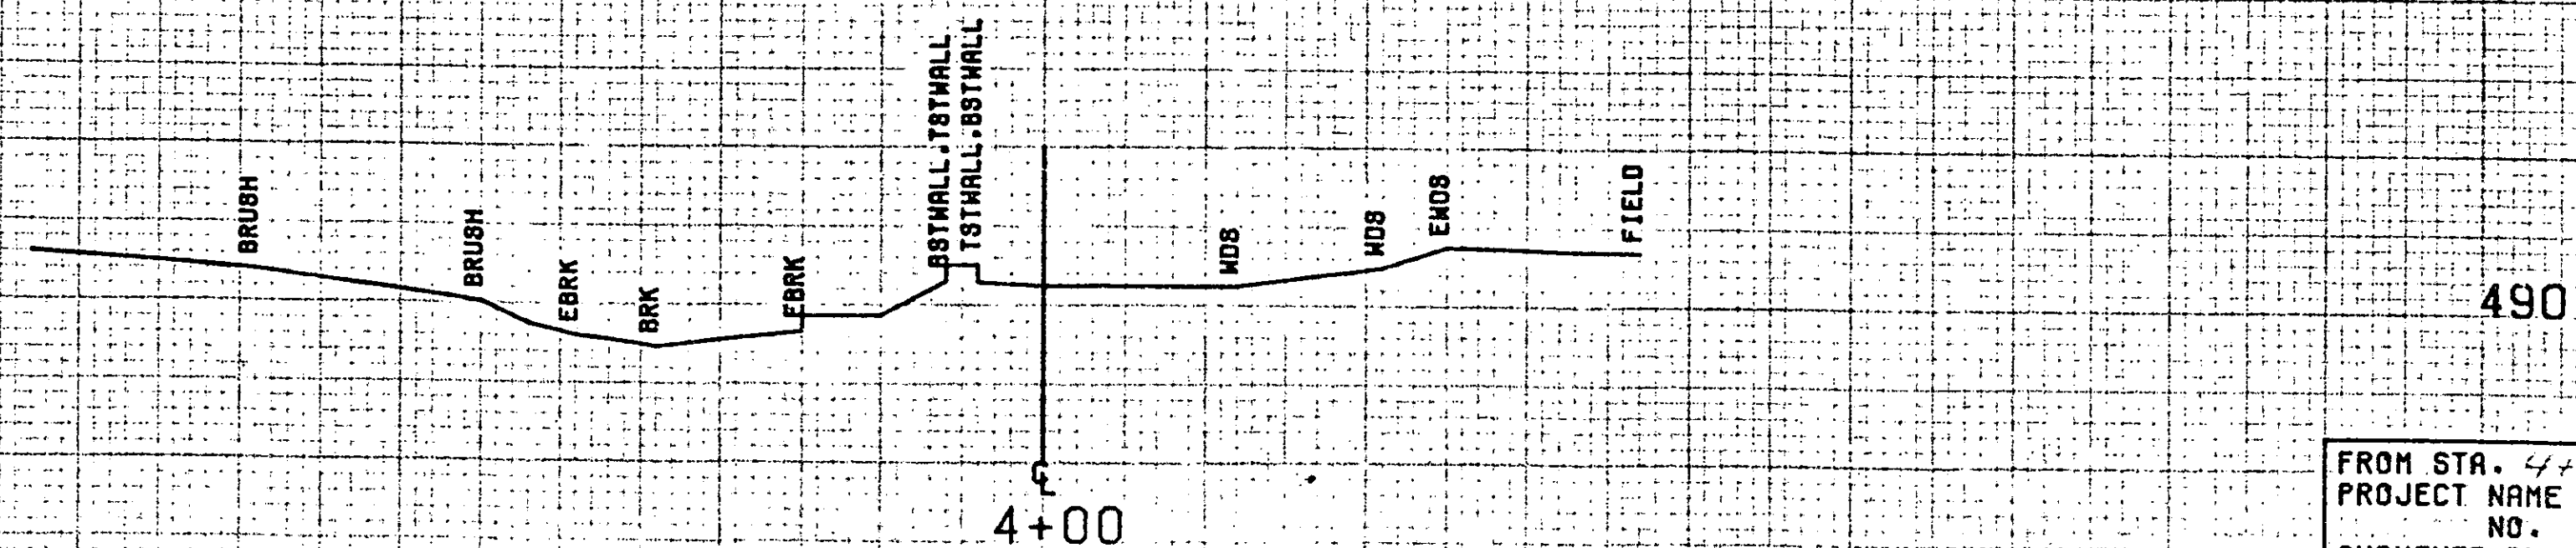
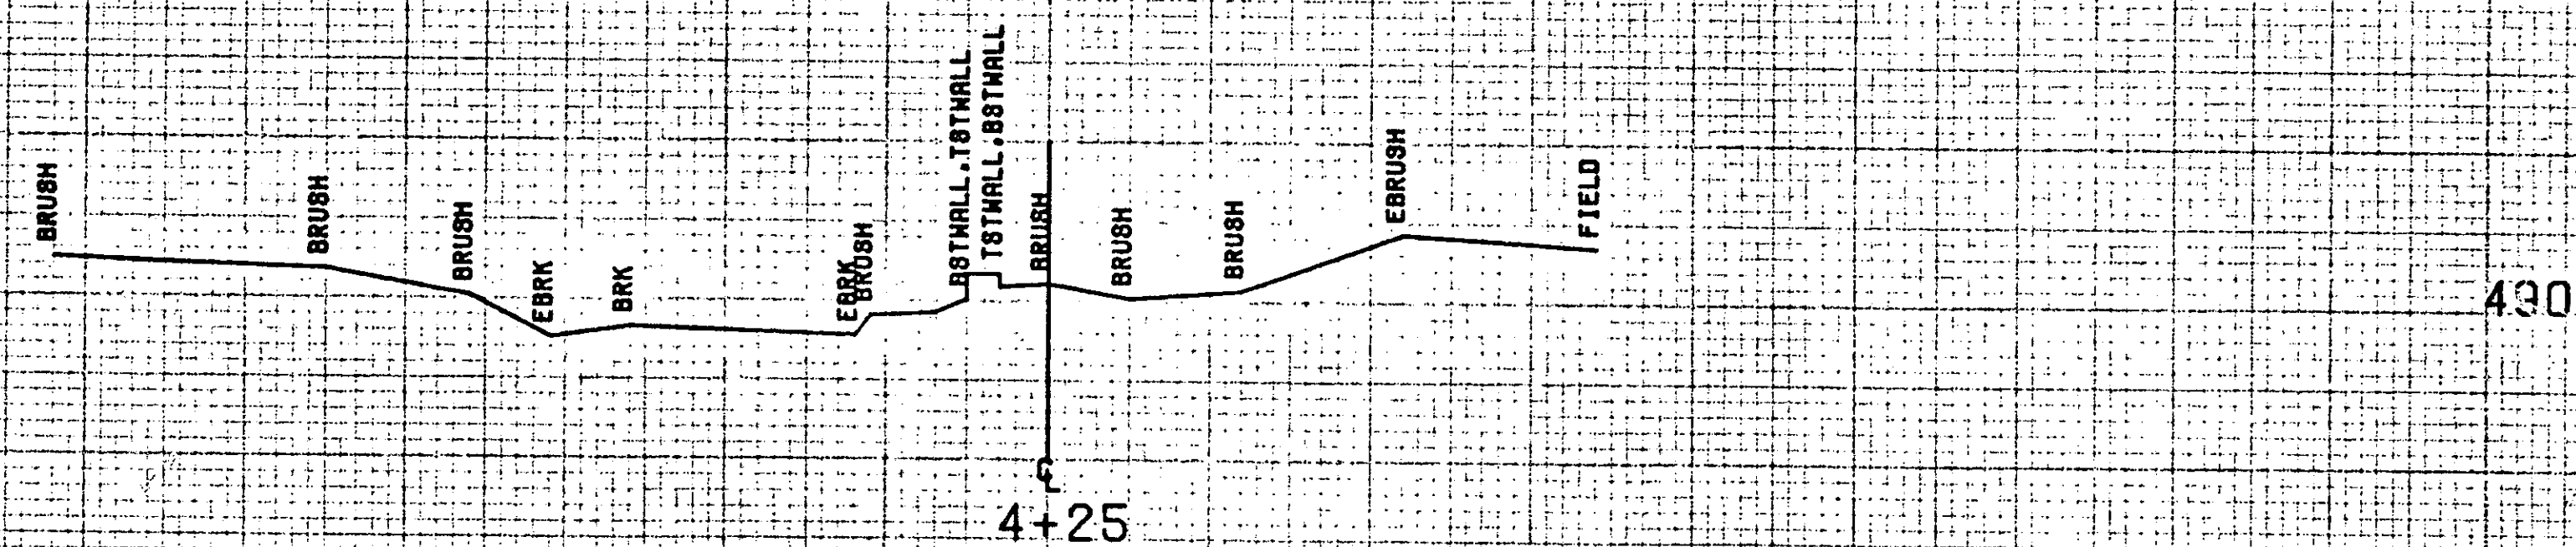


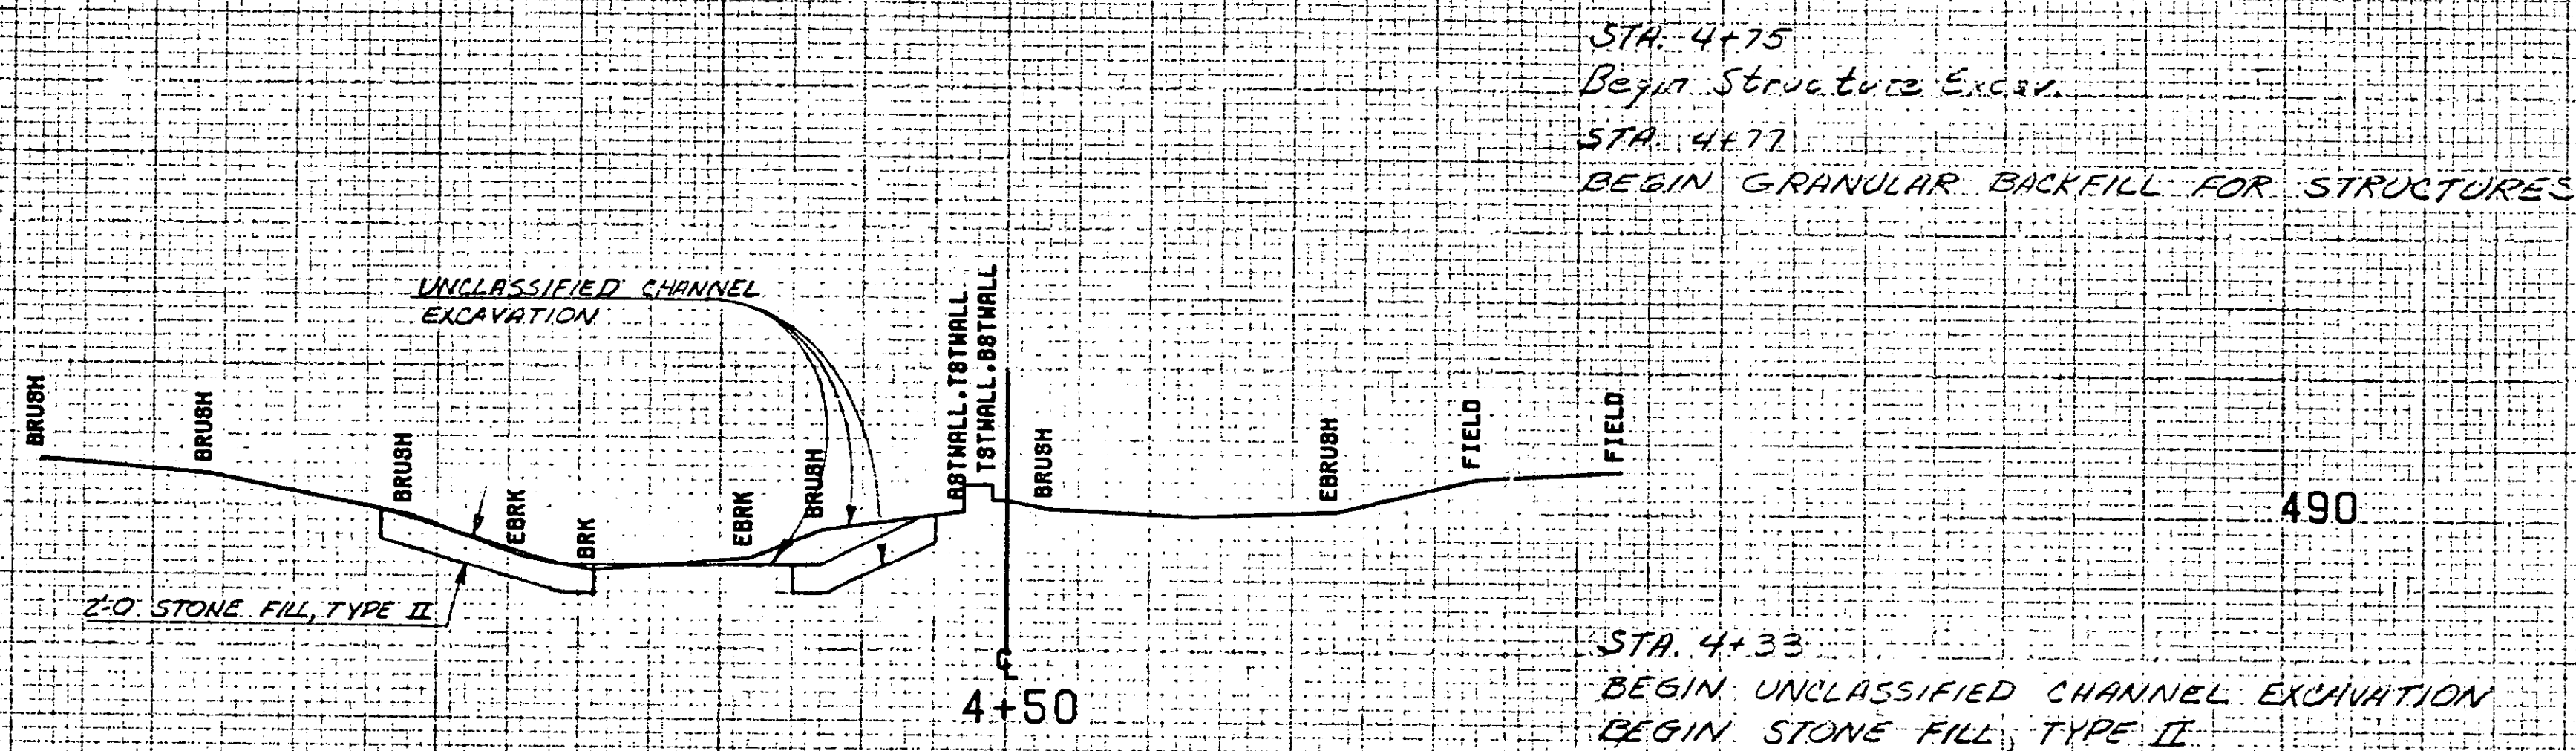

SCALE 10 FEET

FROM STA. 4+00 TO STA. 4+50
PROJECT NAME CHESTER CHAN
NO. BRZ1442(8)
SURVEYED BY G COLBY
SHEET 30 OF 32 SHEETS
PLOTTED 01/29/82
12/04/81