


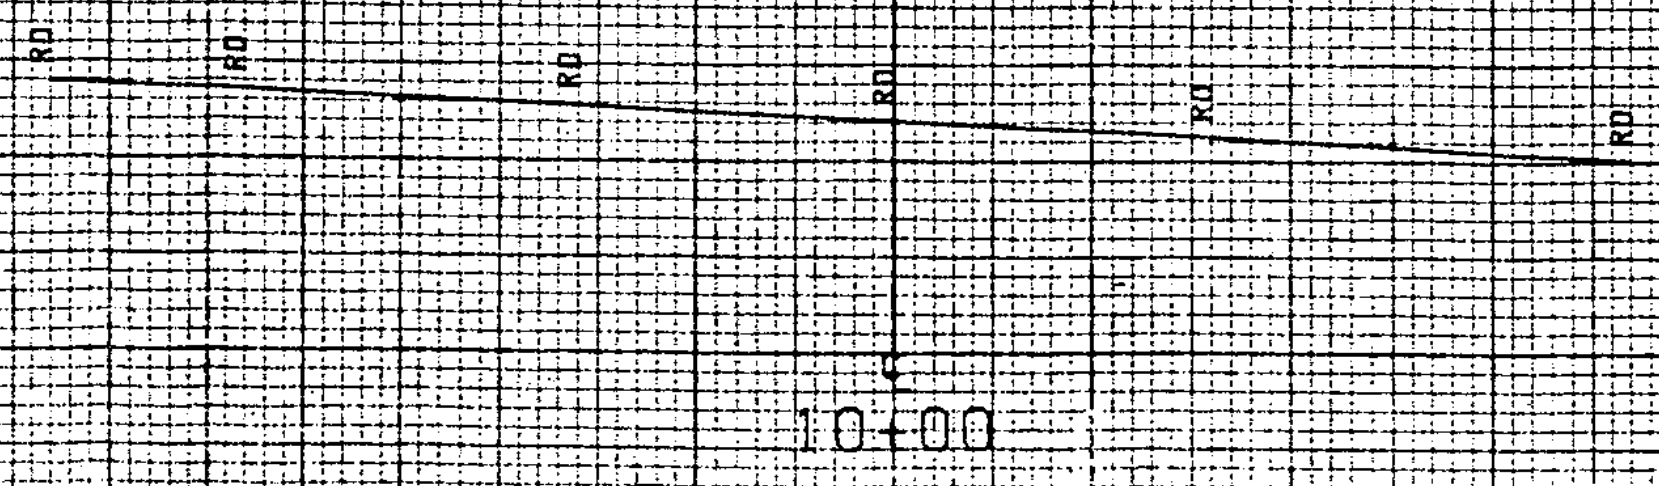

500

FROM STA.	10+00	TO STA.	10+00
PROJECT NAME	MORRISTOWN MAIN		
NO.	FTH3531		
SURVEYED BY	FANTONI		
			PLOTTED 07/20/84