



REV. 121+60 LT
End Stone Fill, Type I

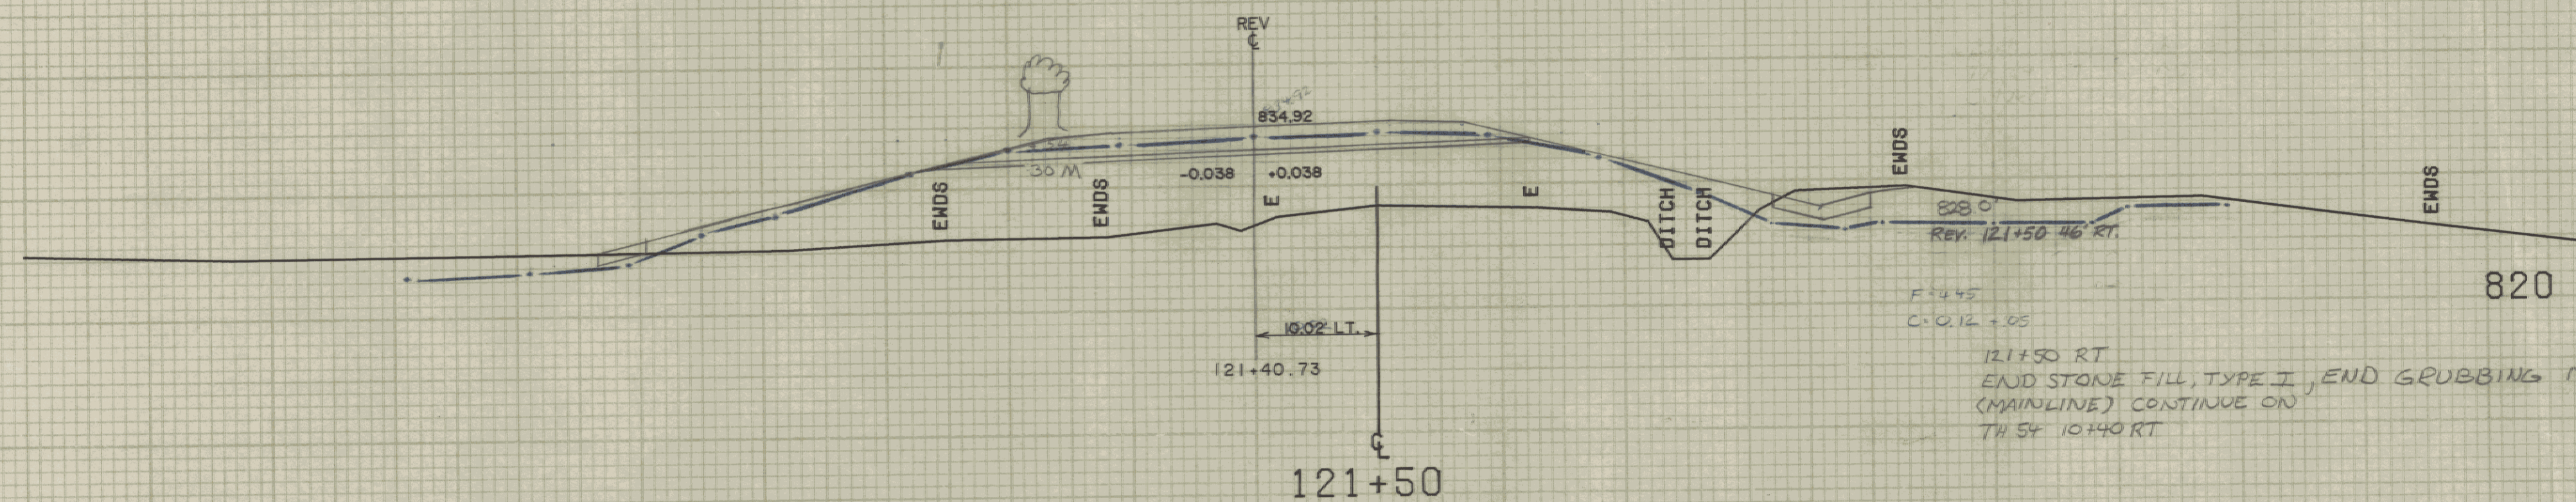


+34
6" M

+23
6" ASH

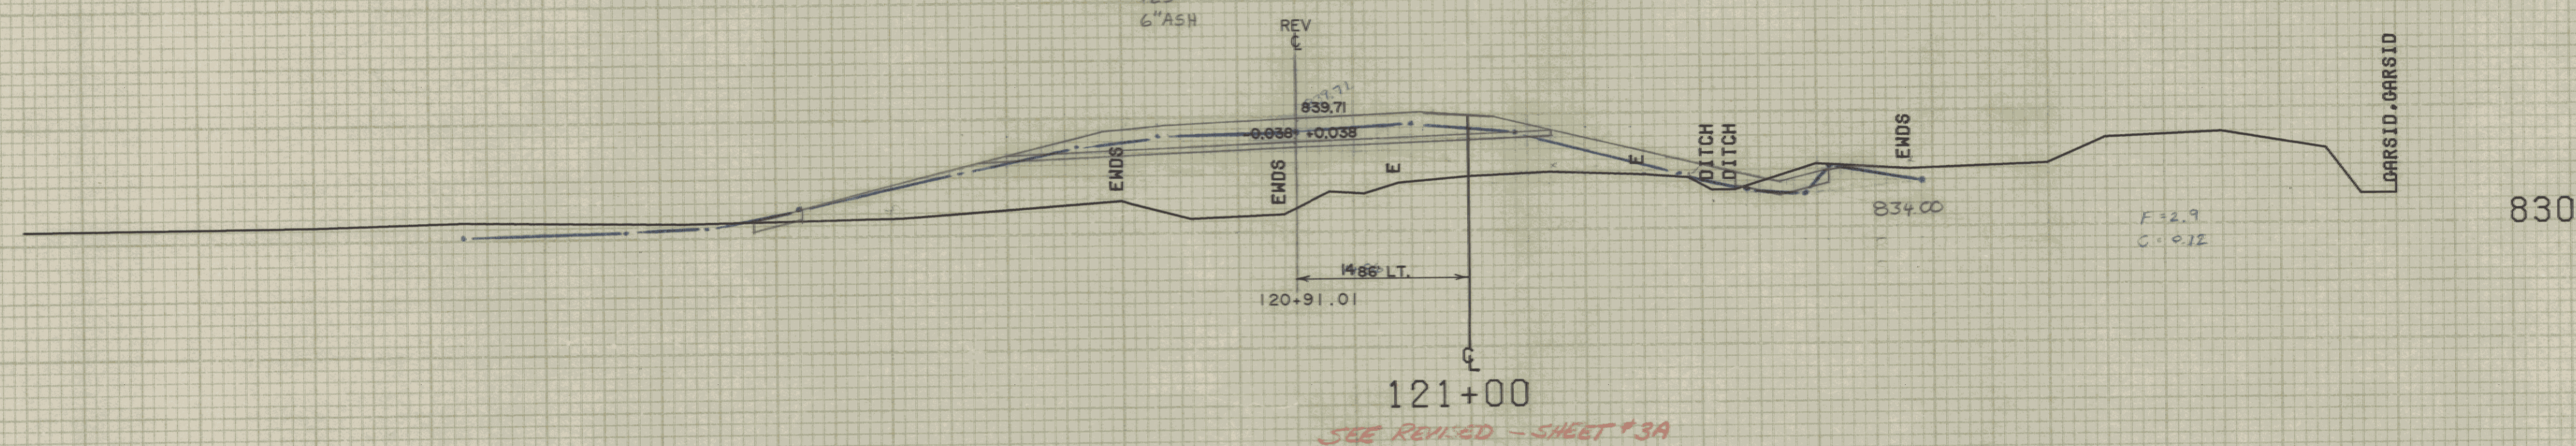

REV. 120+50 LT
End 6"x30" Carrier Pipe

REV. 120+50 RT
End 6"x30" Carrier Pipe

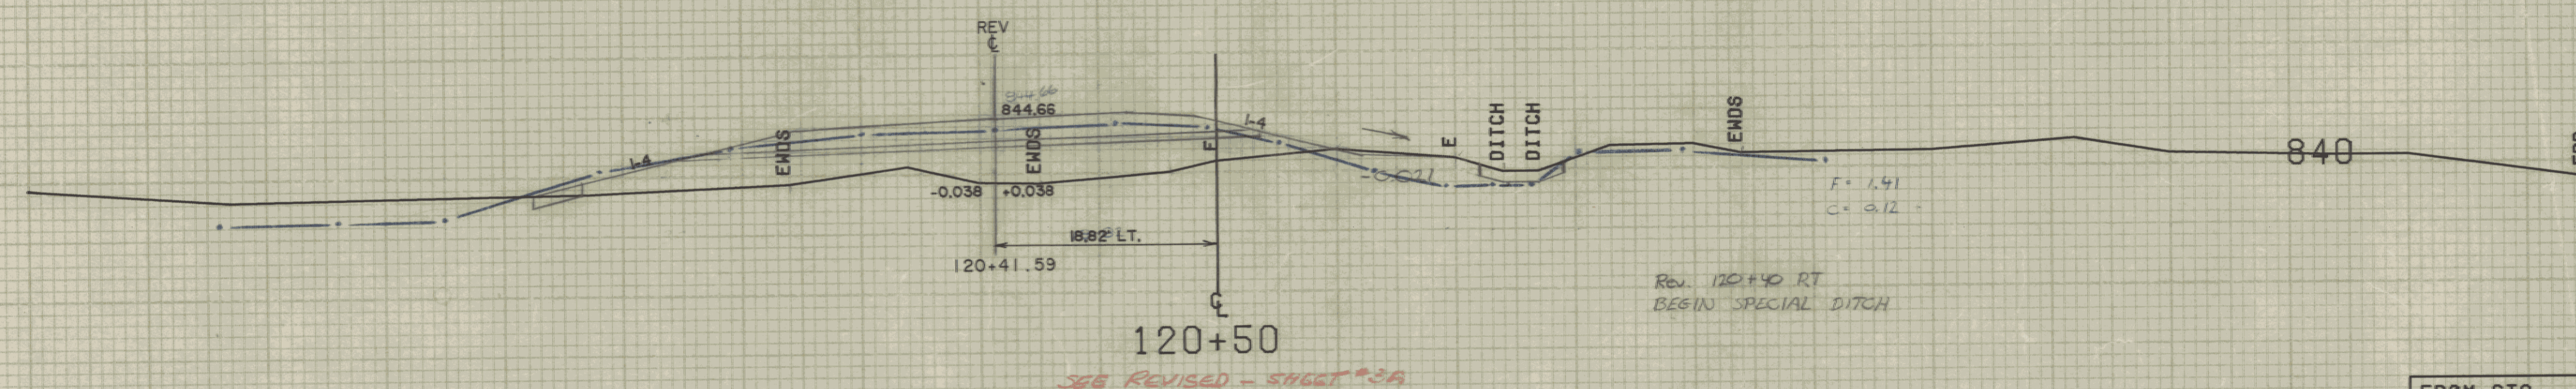

FROM STA.	120+50	TO STA.	121+50
PROJECT NAME	EAST MONTPELIER MAIN		
NO.	RS0246(1)	PLOTTED	02/24/83
SURVEYED BY	LAVALLEE	JAN82	
SHEET	42	OF 128	SHEETS

SCALE 10 FEET