




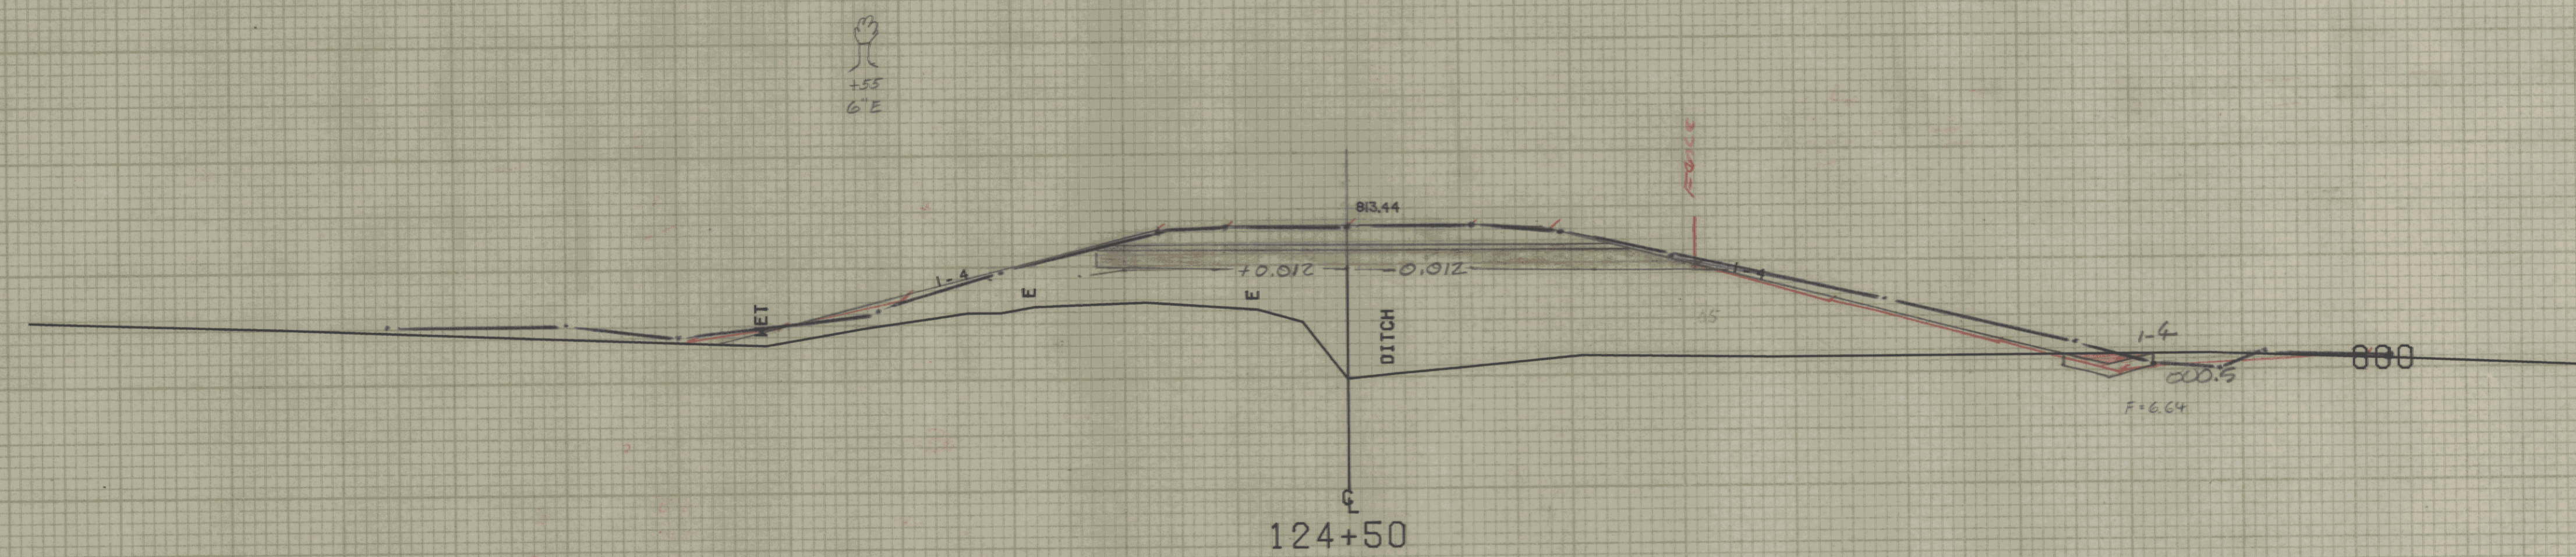

PC 124+34.55
D = 1°30' RT
BANK = 0.021 F/FT

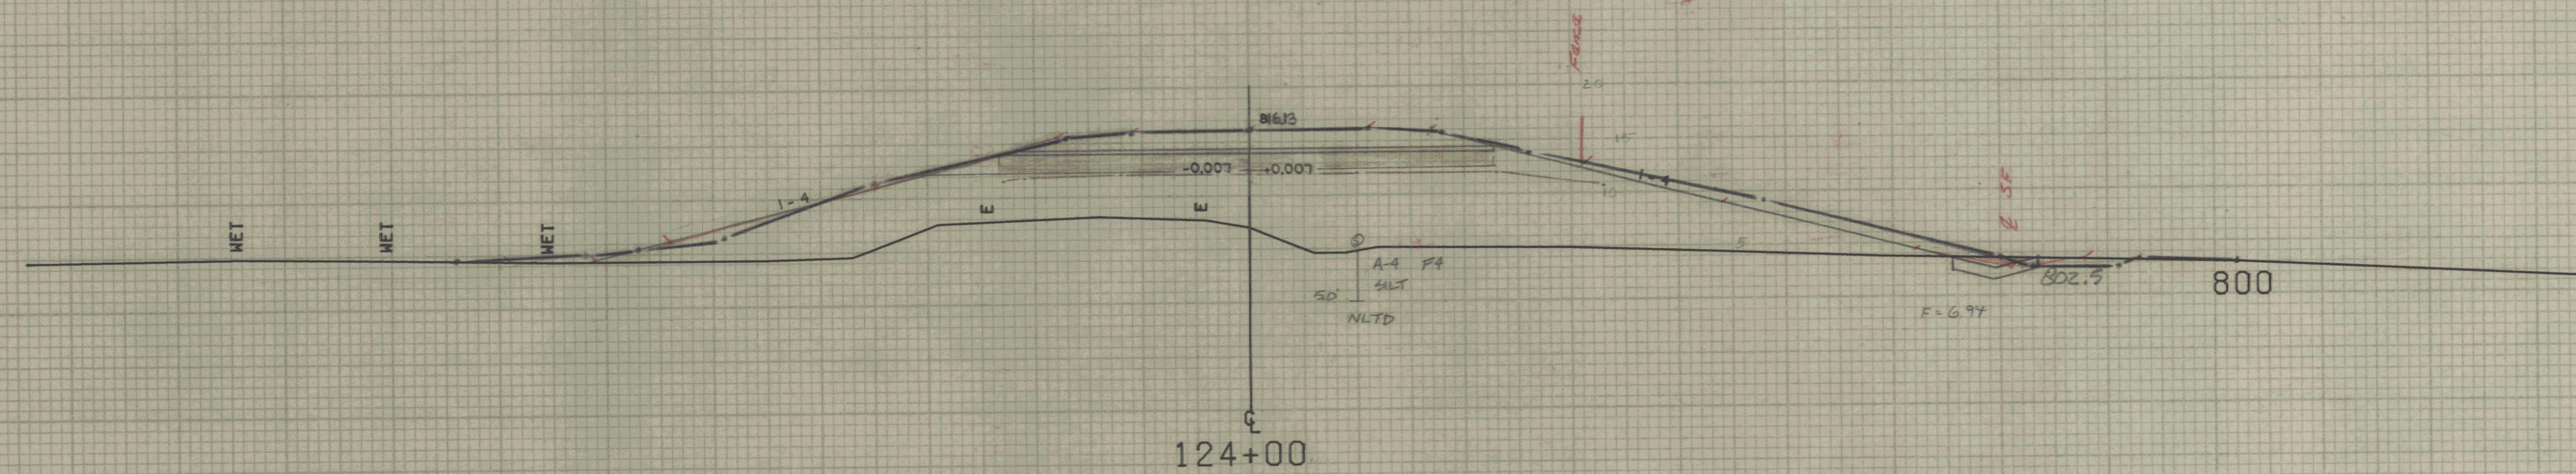

A-4
SILT
NLTD

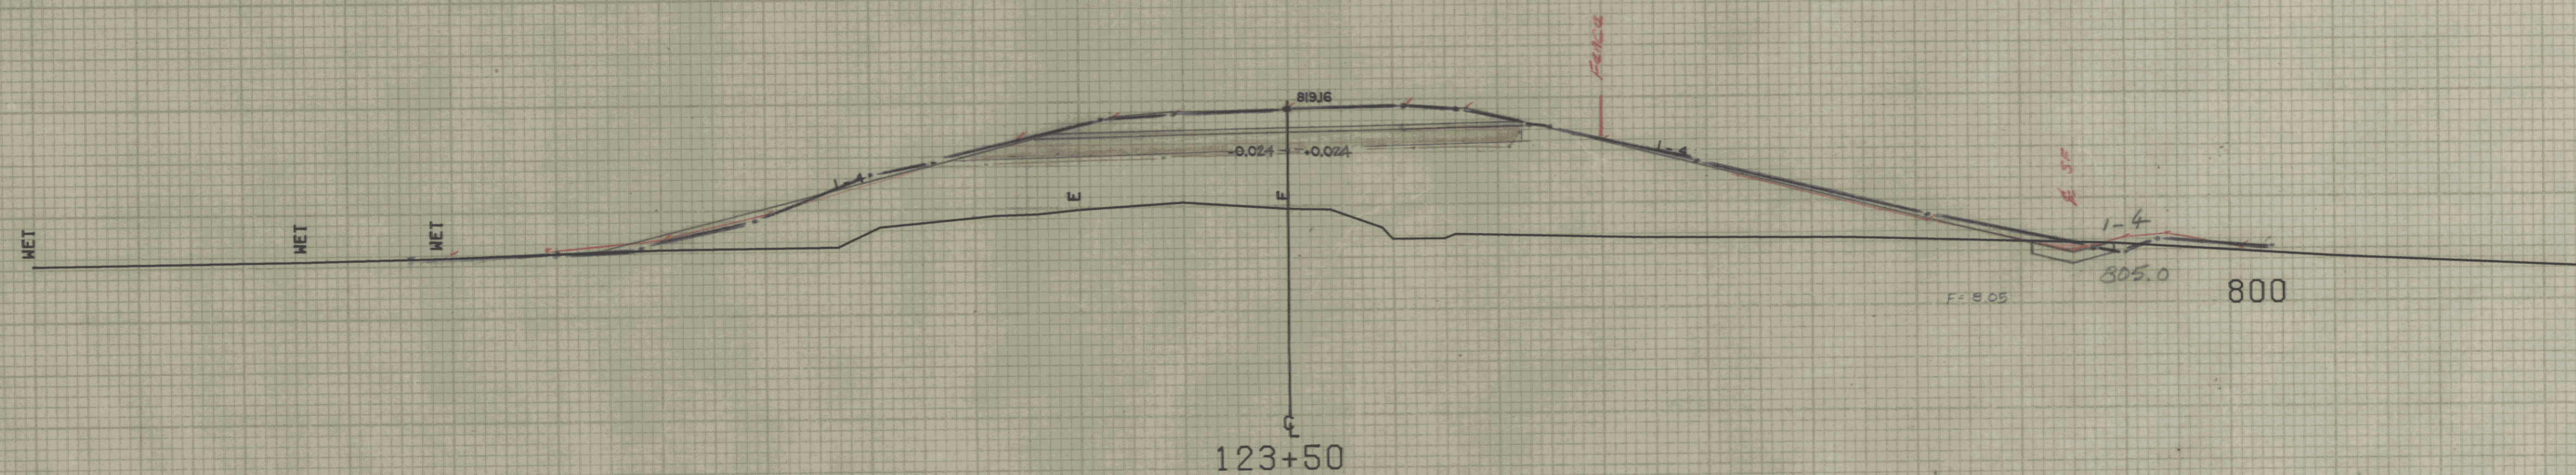

BLUE PLOT BY VT SURVEY - TAKEN 5/93 - PRIOR TO BUNKER COTE

FINALS PLOTTED BY ROOM 11-26-93
3000 PLOTTED BY ROOM 11-17-93

SCALE 1" = 10 FEET

FROM STA.	123+50	TO STA.	124+50
PROJECT NAME	EAST MONTPELIER MAIN		
NO.	R50246(1)	PLOTTED	02/24/83
SURVEYED BY	LAVALLEE	JAN82	
SHEET	44	OF 128	SHEETS