



±80
4' App.

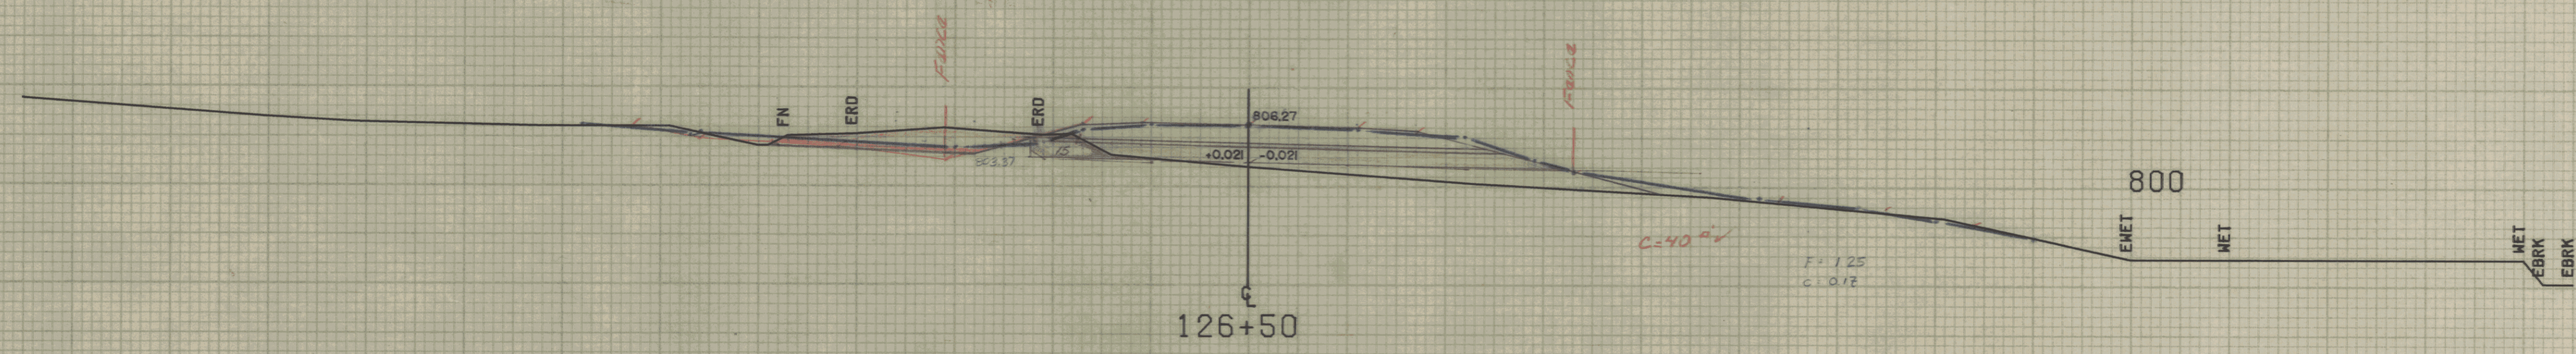

±87
8' E

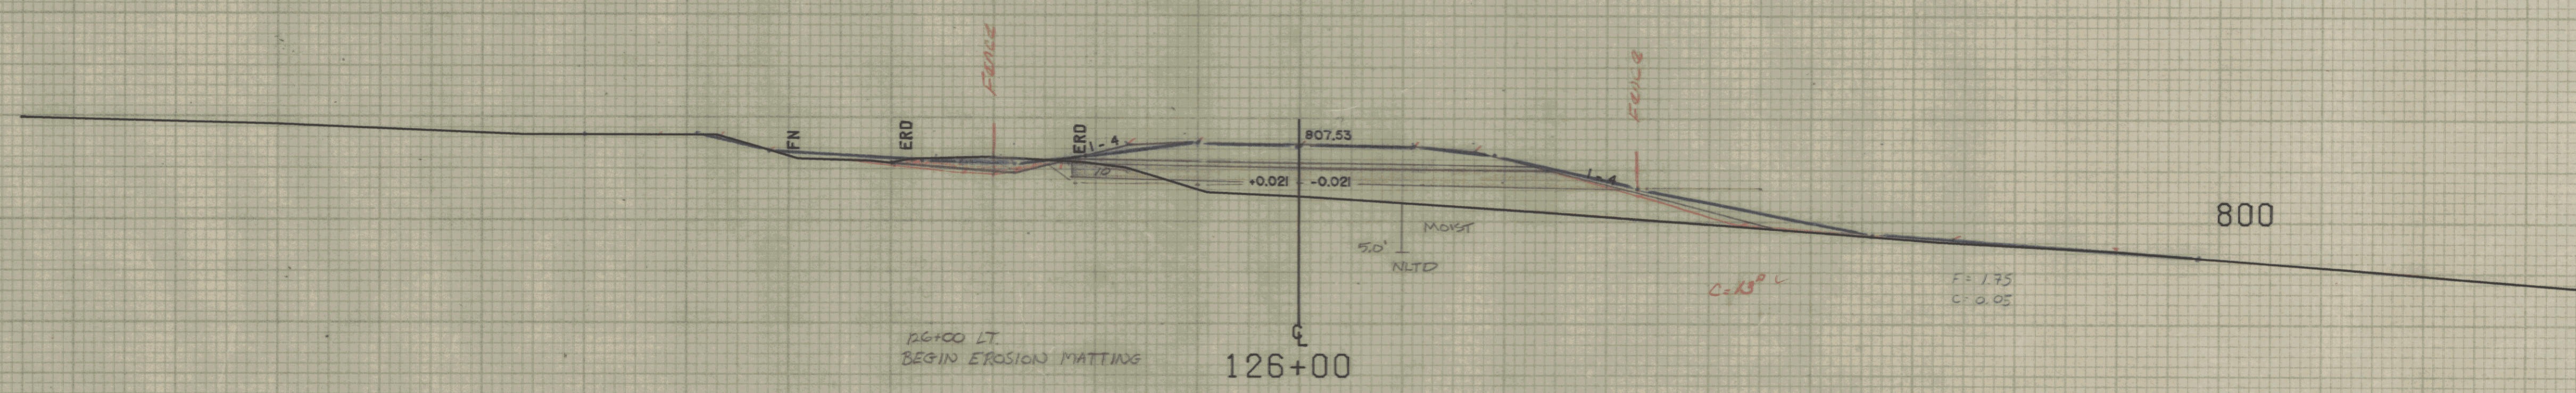

BLUE DOT BY VA SURVEY - TAKEN 5/93 - BEFORE BLOW & CUT

Final plotted by R.C.M. 11-27-93
and plotted by R.C.M. 11-17-93
planim. 11-20-93
ord. (plotted) by C.E. LORR 1-28-94

SCALE 10 FEET

FROM STA.	126+00	TO STA.	127+00
PROJECT NAME	EAST MONTPELIER MAIN		
NO.	RS0246(1)	PLOTTED 02/24/83	
SURVEYED BY	LAVALLEE	JAN82	
SHEET	46 OF 128 SHEETS		