
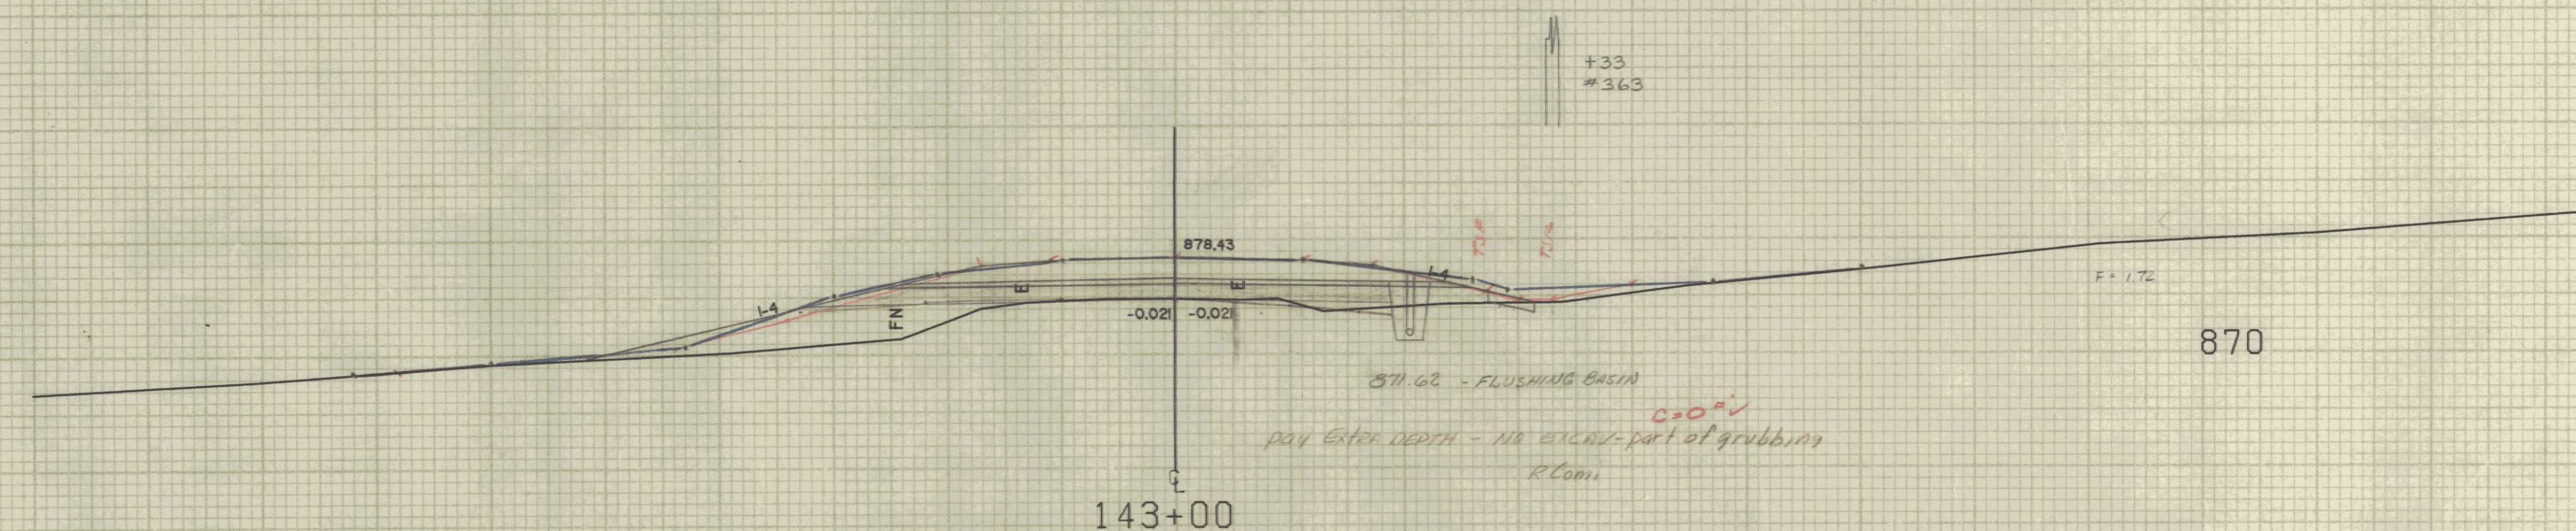
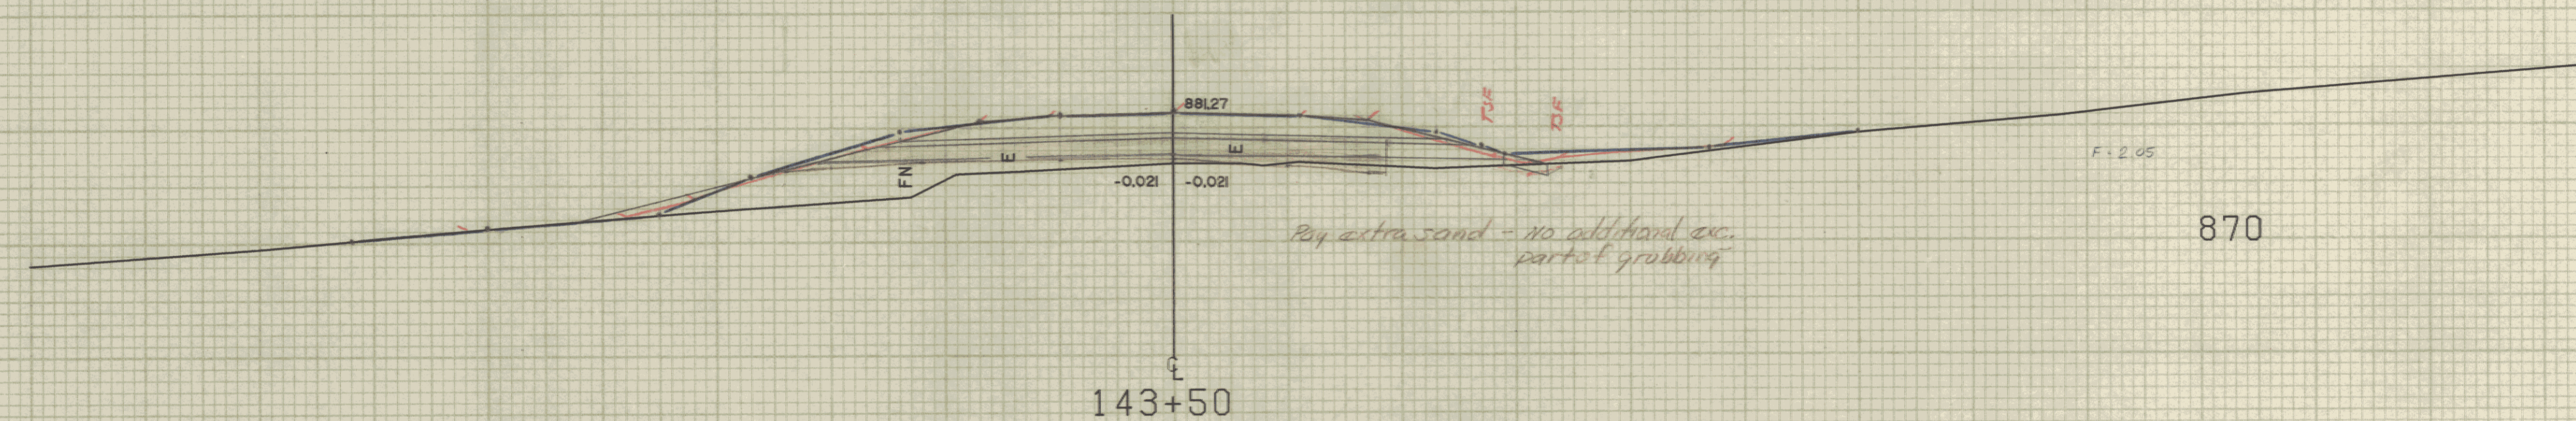


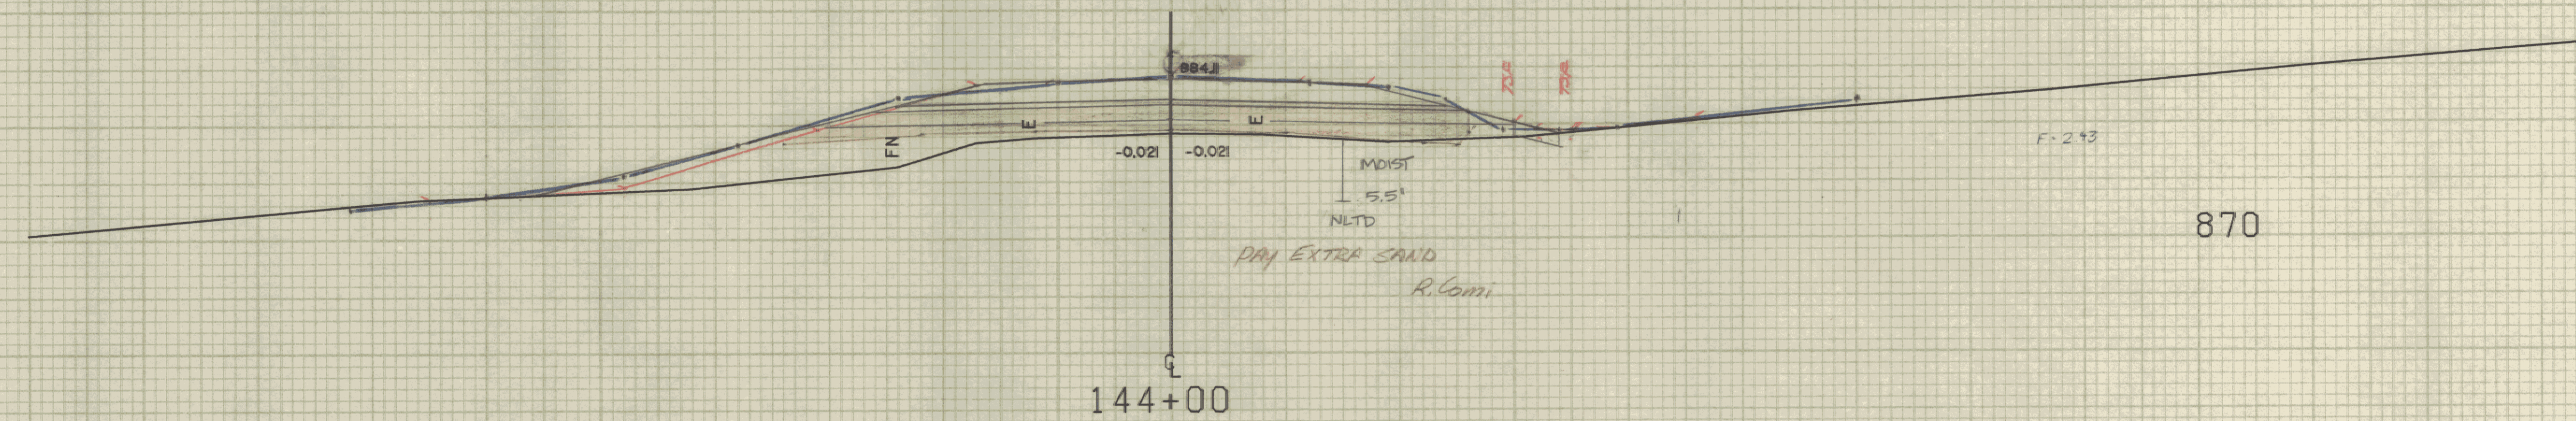

Base Plan by V.A. Survey - Sectioned May 1993 - Prior to Brown & Gore

Finals plotted by R. Conn. 11-5-93  
 Unrecorded plotted by R. Conn. 11-5-93  
 C.D. PLAN BY C.E. RHR 1-31-94

SCALE 10 FEET

|              |                      |         |          |
|--------------|----------------------|---------|----------|
| FROM STA.    | 143+00               | TO STA. | 144+00   |
| PROJECT NAME | EAST MONTPELIER MAIN |         |          |
| NO.          | RS0246(1)            |         |          |
| SURVEYED BY  | LAVALLÉE             | PLOTTED | 02/24/83 |
| SHEET        | 61                   | OF 128  | SHEETS   |