


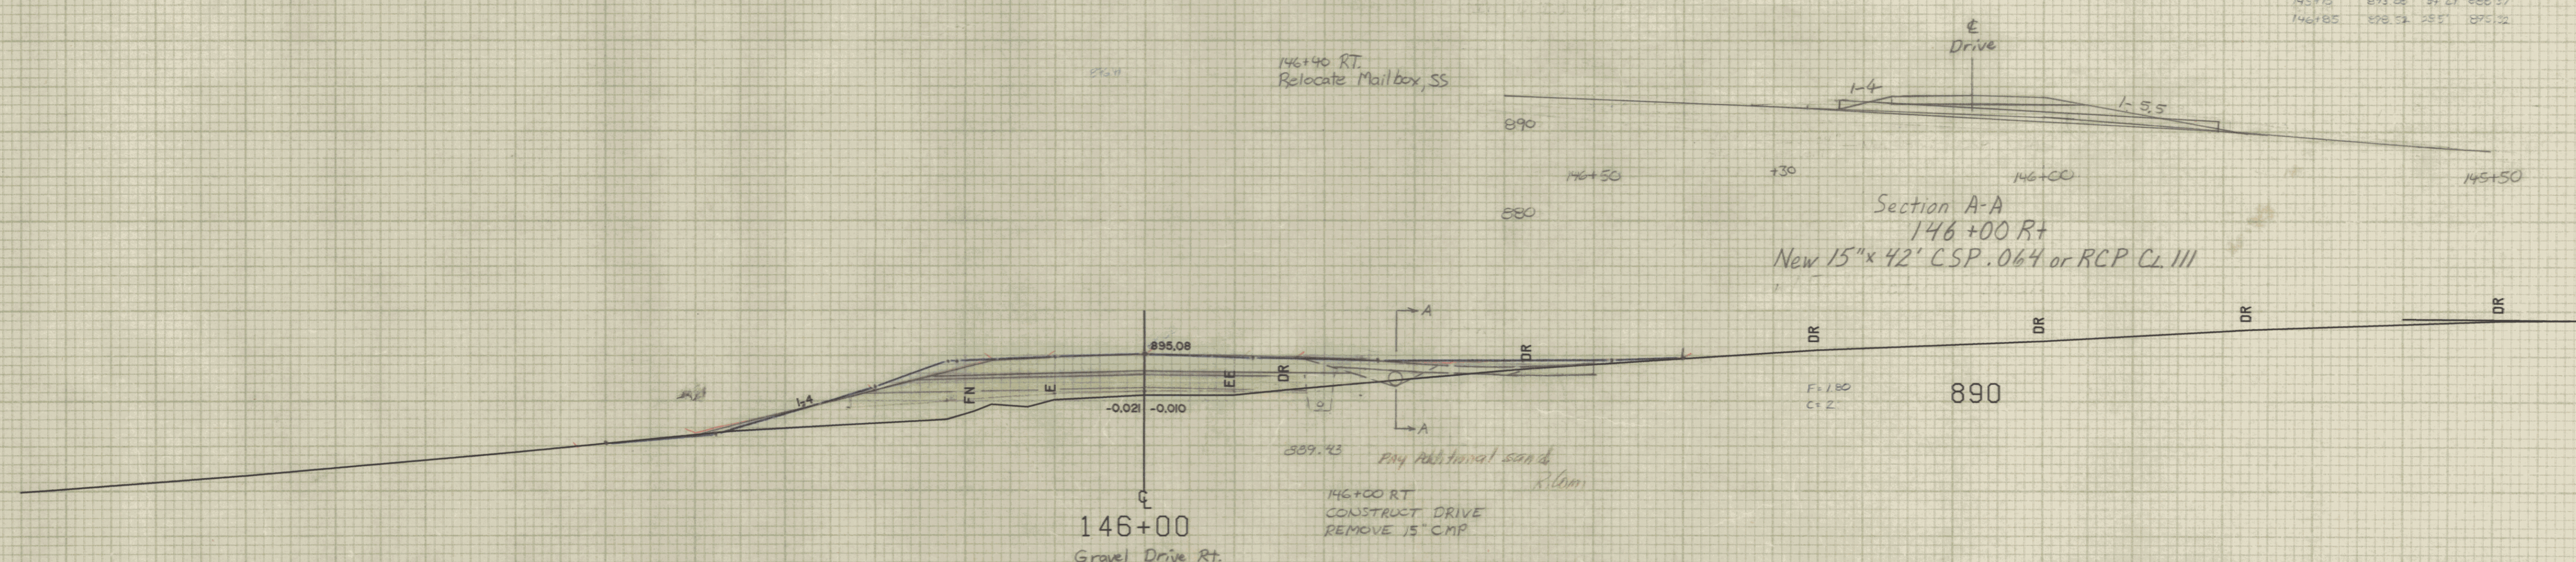

FROM STA.	146+00	TO STA.	147+00
PROJECT NAME	EAST MONTEPELIER	MAIN	
NO.	RS0246(1)	PLOTTED	02/24/83
SURVEYED BY	LAVALLEE	JAN82	
SHEET	63 OF 128	SHEETS	

SCALE 10 FEET