
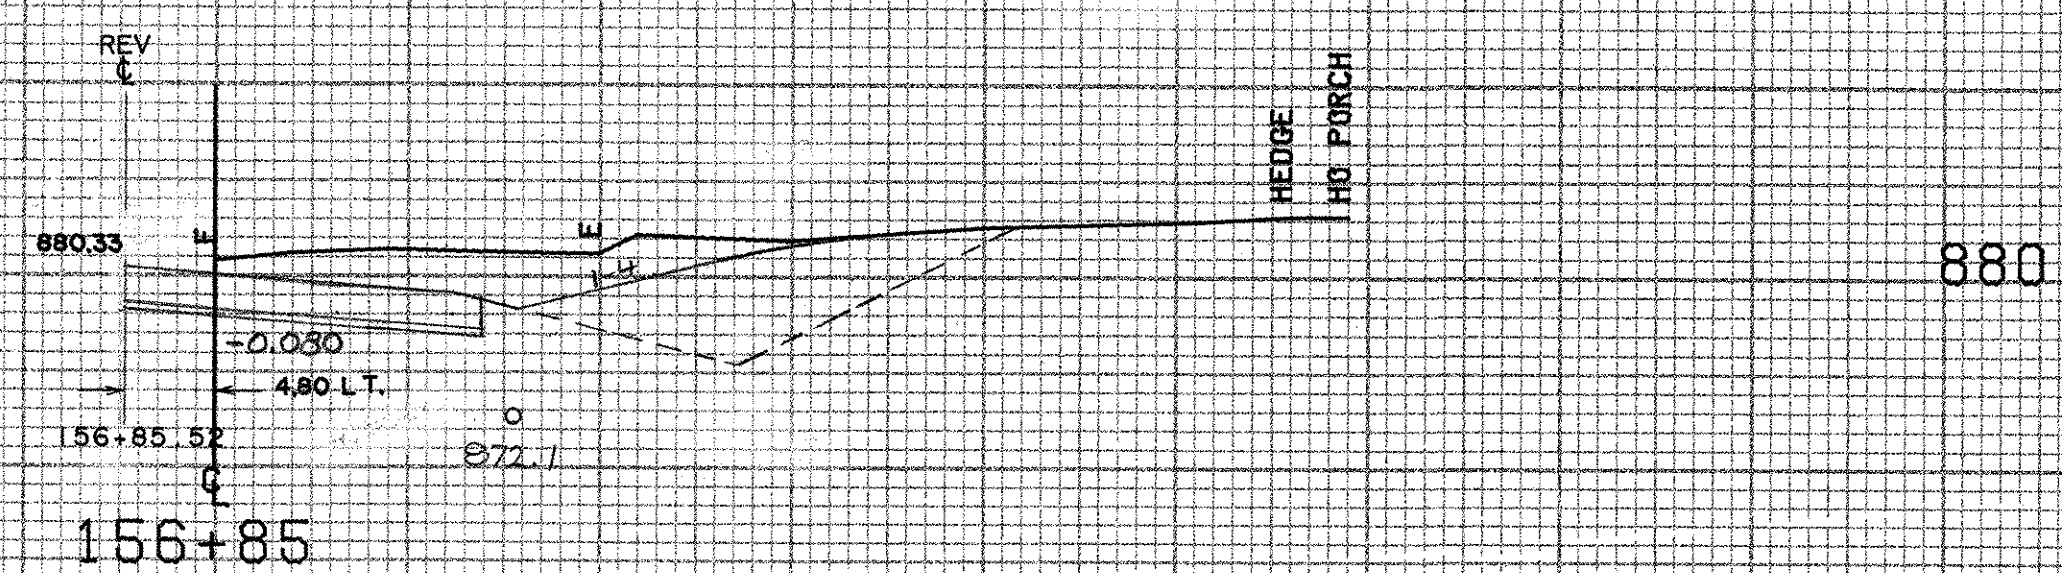
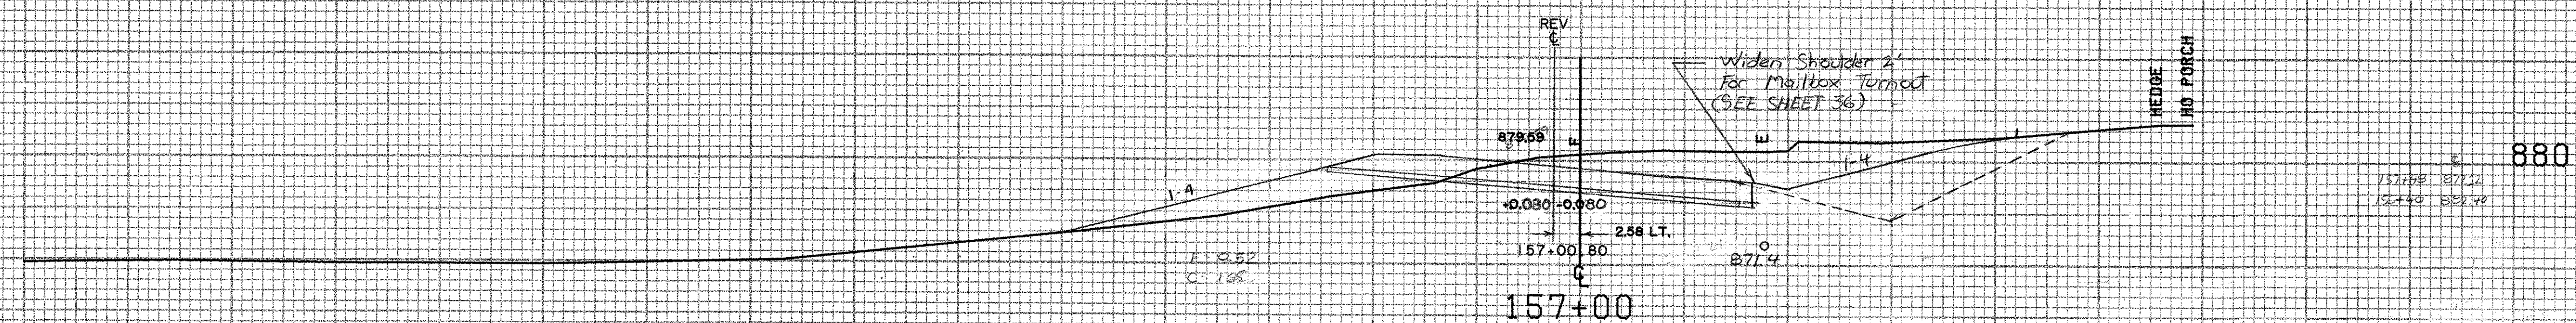


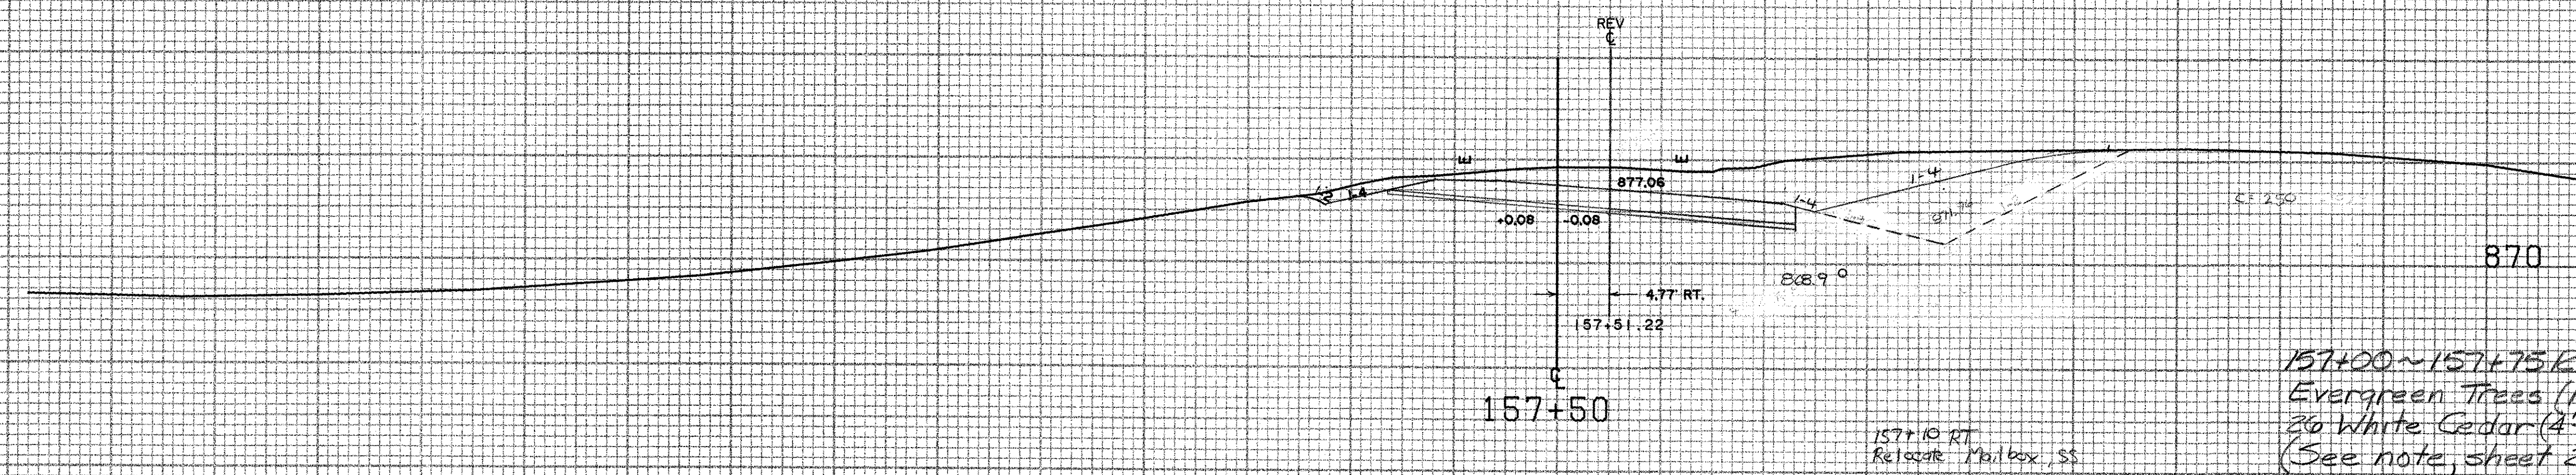

FROM STA.	156+85	TO STA.	158+00
PROJECT NAME	EAST MONTPELIER	MAIN2	
NO.	R80246(1)	PLOTTED	04/18/85
SURVEYED BY	FALL	APRIL	1985
SHEET	69	OF	126 SHEETS

SCALE 10 FEET