


EAST MONTPELIER
RSEGC-RS 0246(1)
SEWER MANHOLES

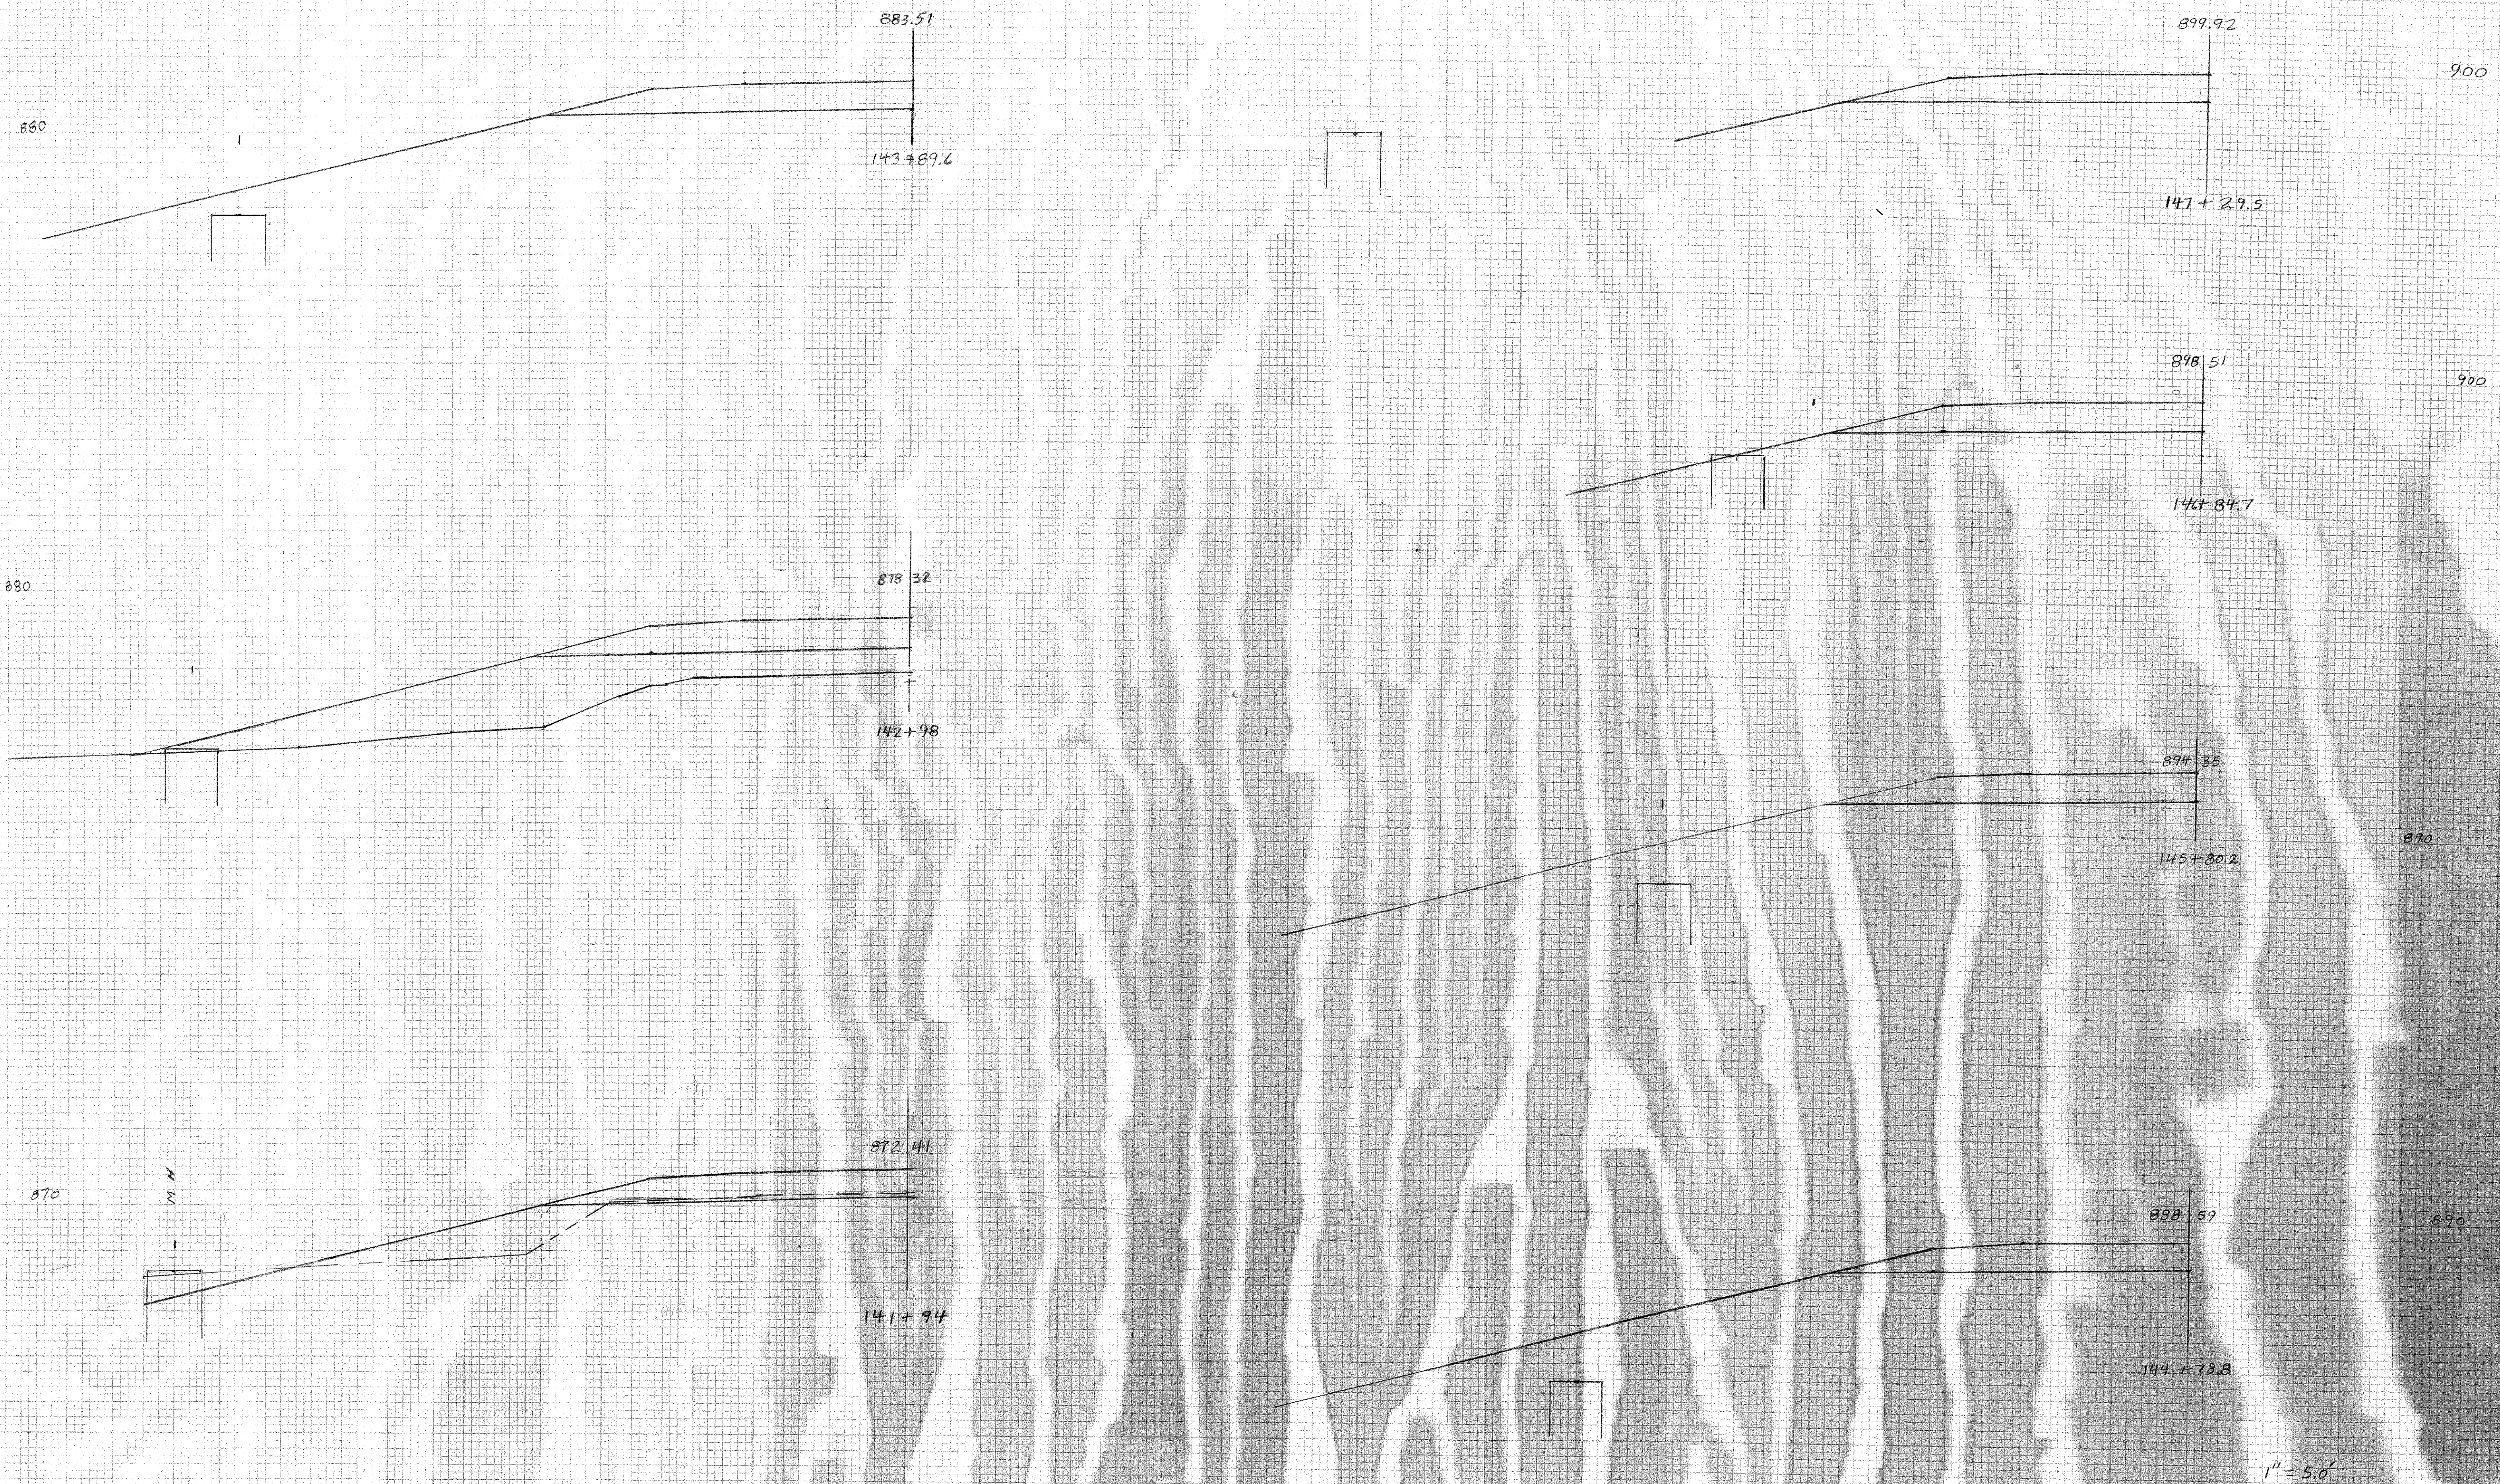

DATE	BY	DATE
PROJECT	BY	DATE
REVISION	BY	DATE
REVISION	BY	DATE
REVISION	BY	DATE

DATE	BY	DATE
PROJECT	BY	DATE
REVISION	BY	DATE
REVISION	BY	DATE
REVISION	BY	DATE