

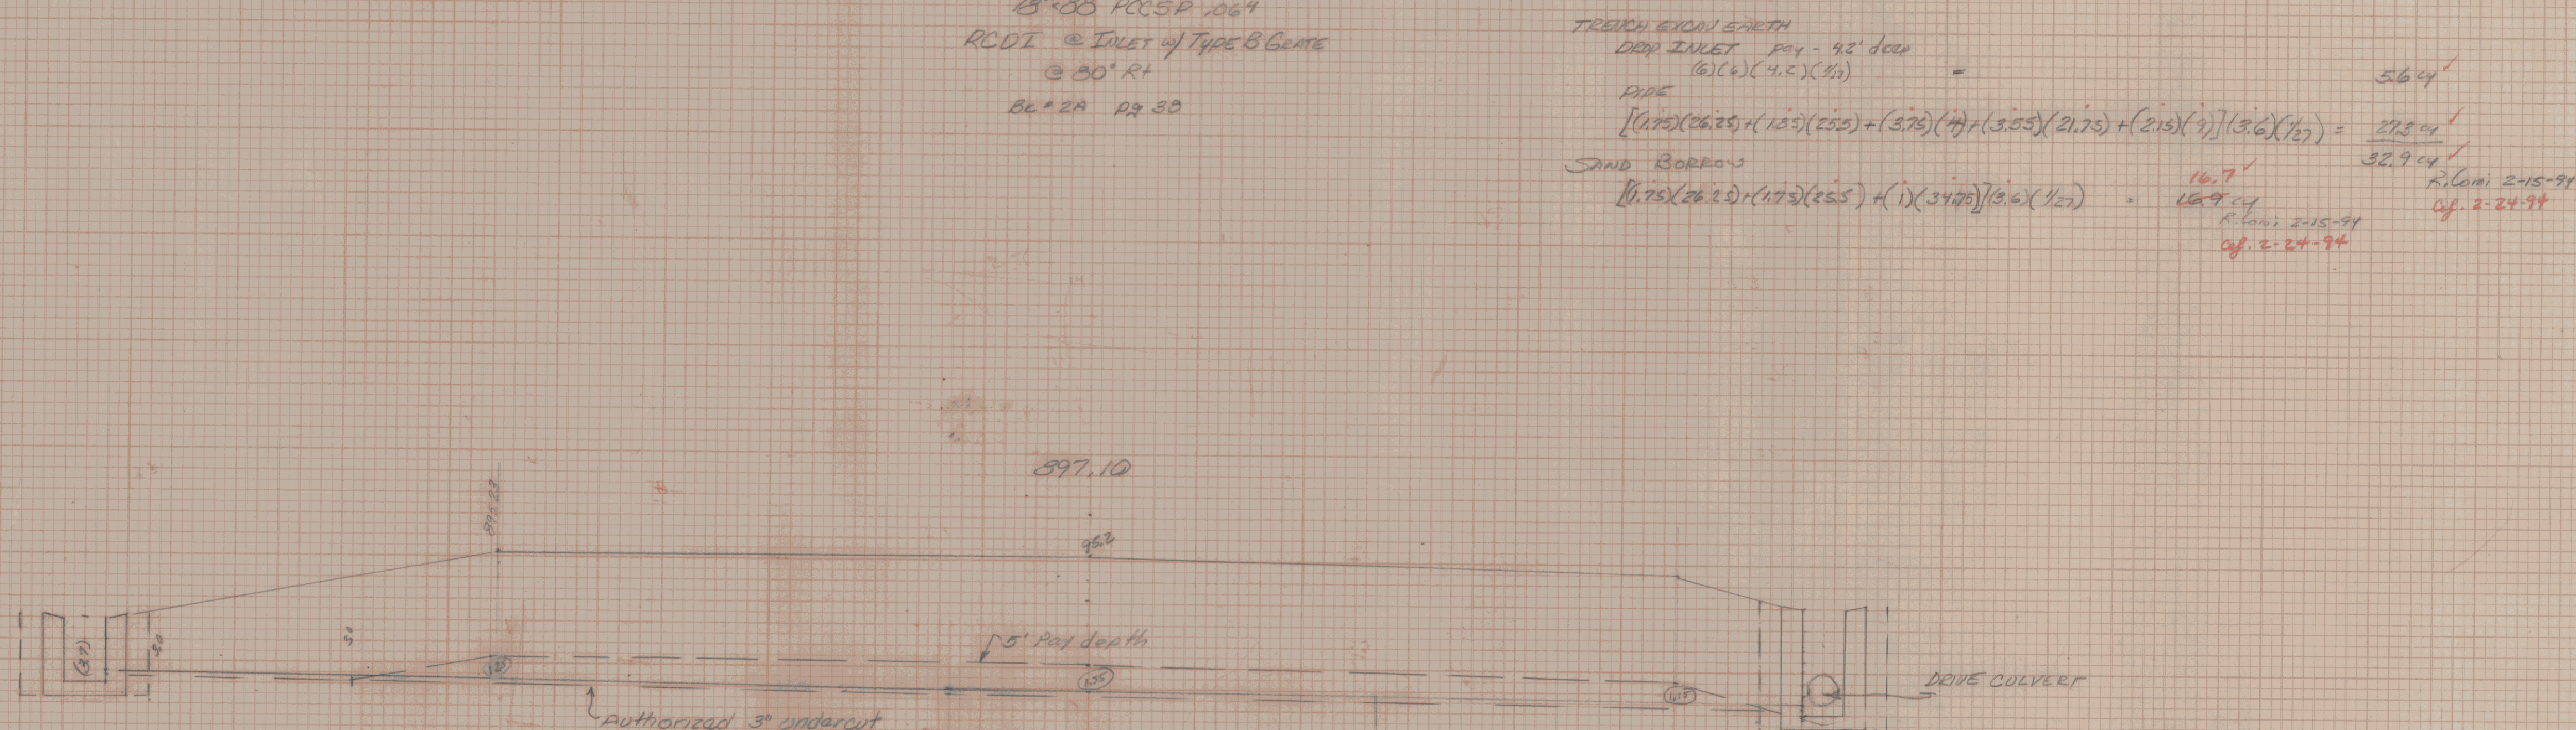


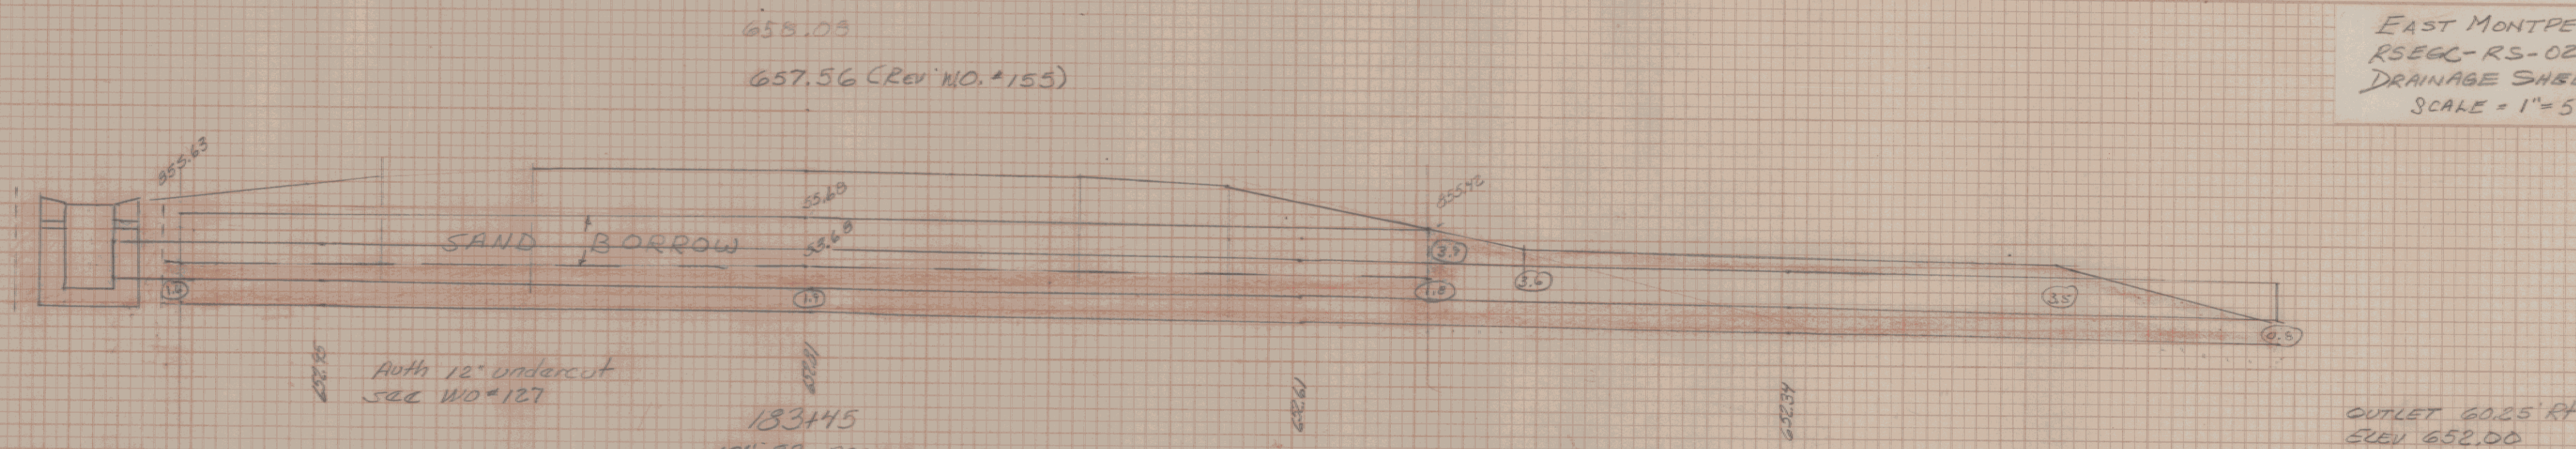

This culvert was designed and installed after sand borrow was in place. Pay excavation to subgrade - as shown R.L.M.

* Culvert will not scale - so needed to accommodate skew

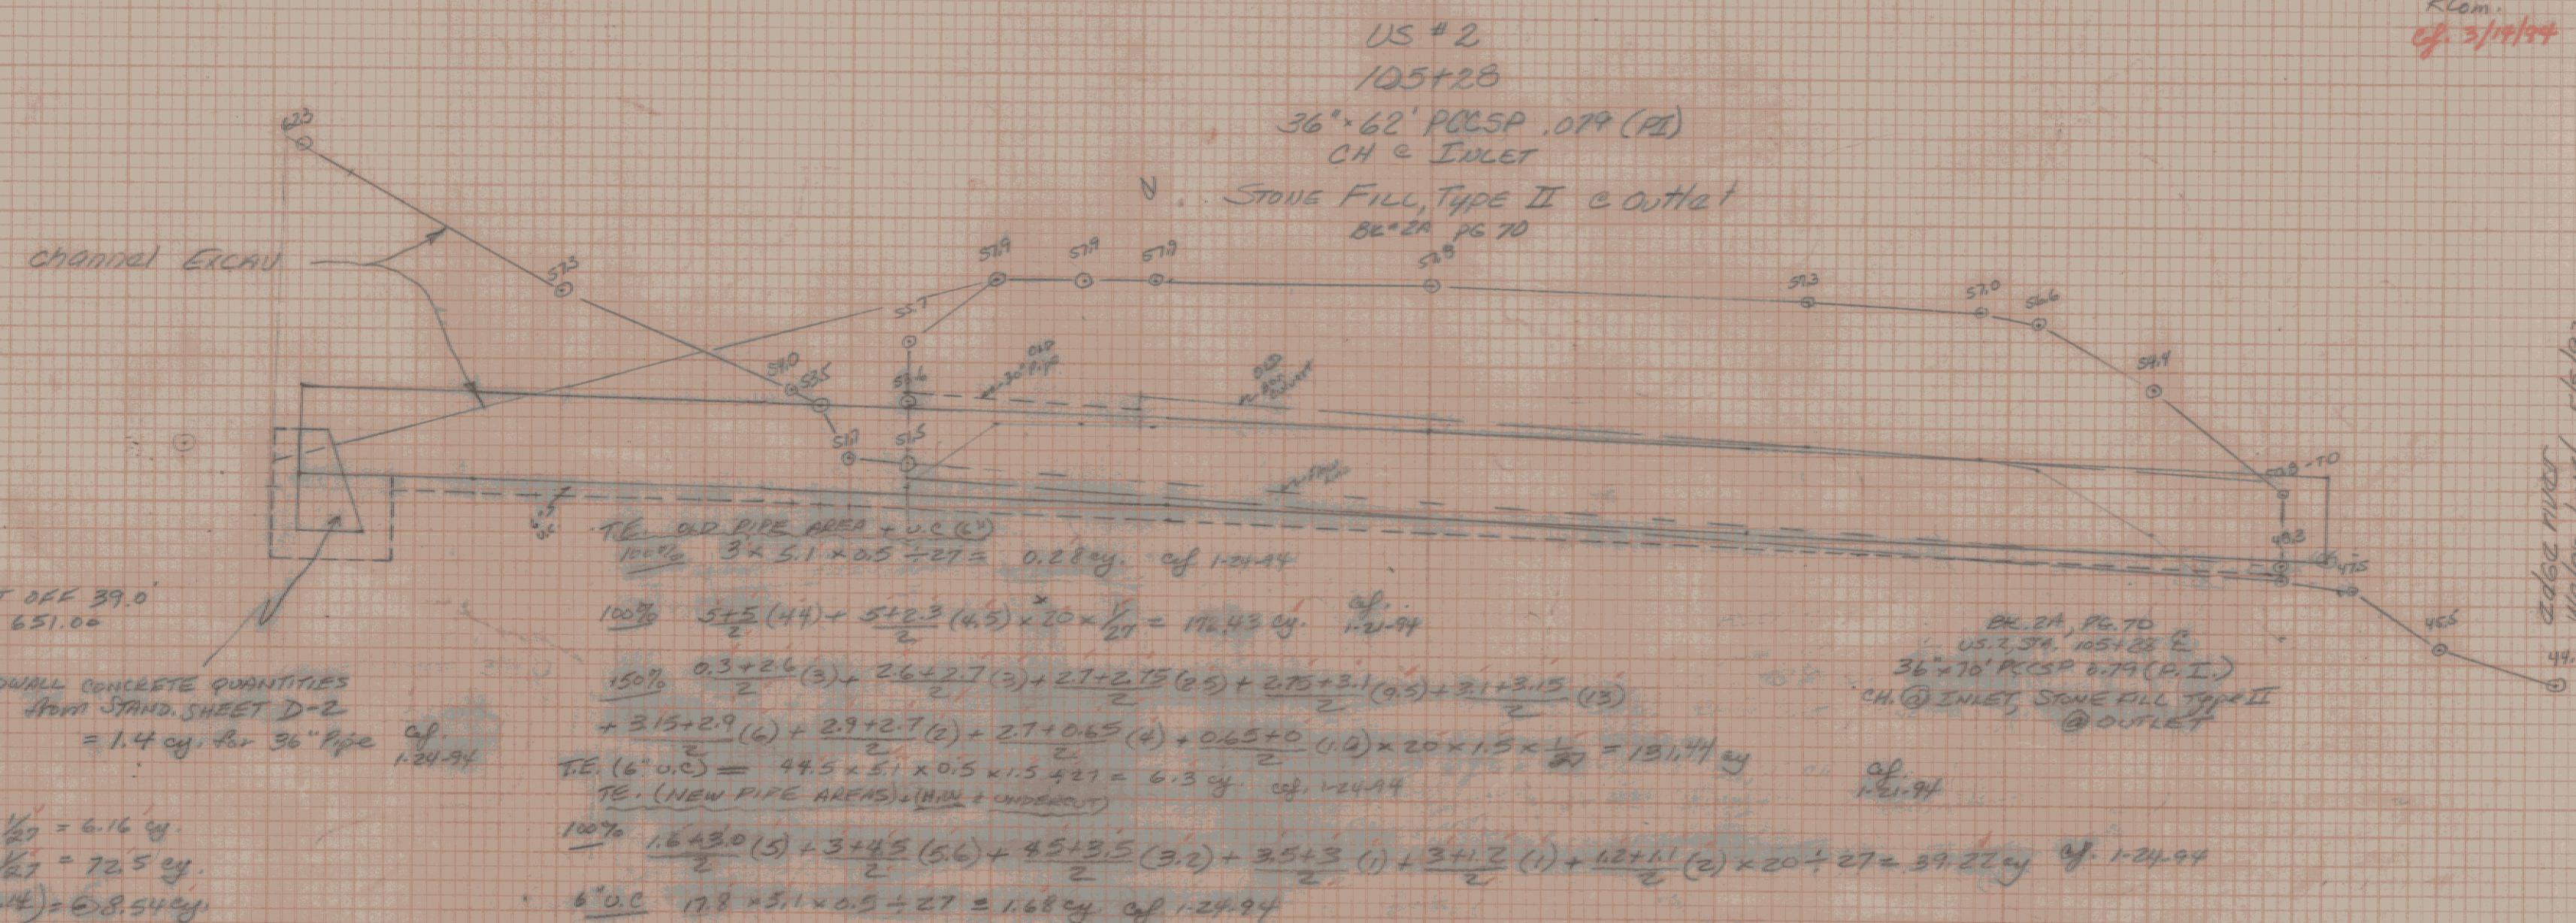

* Authorized additional width to permit use of vibratory compactor R.L.M.