
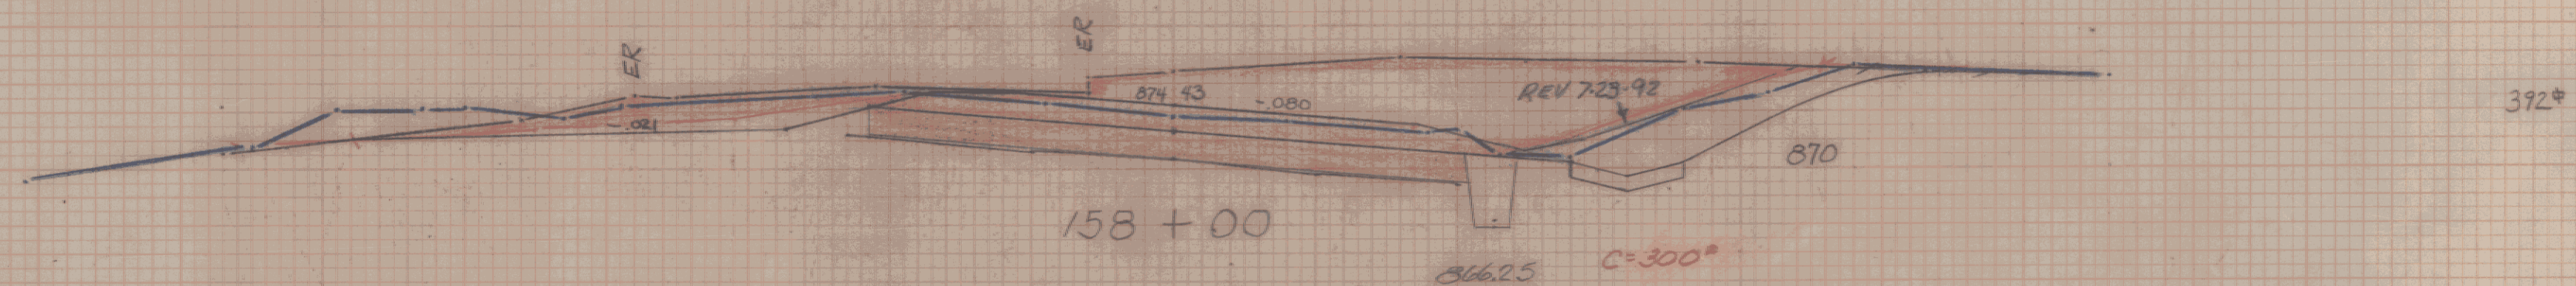
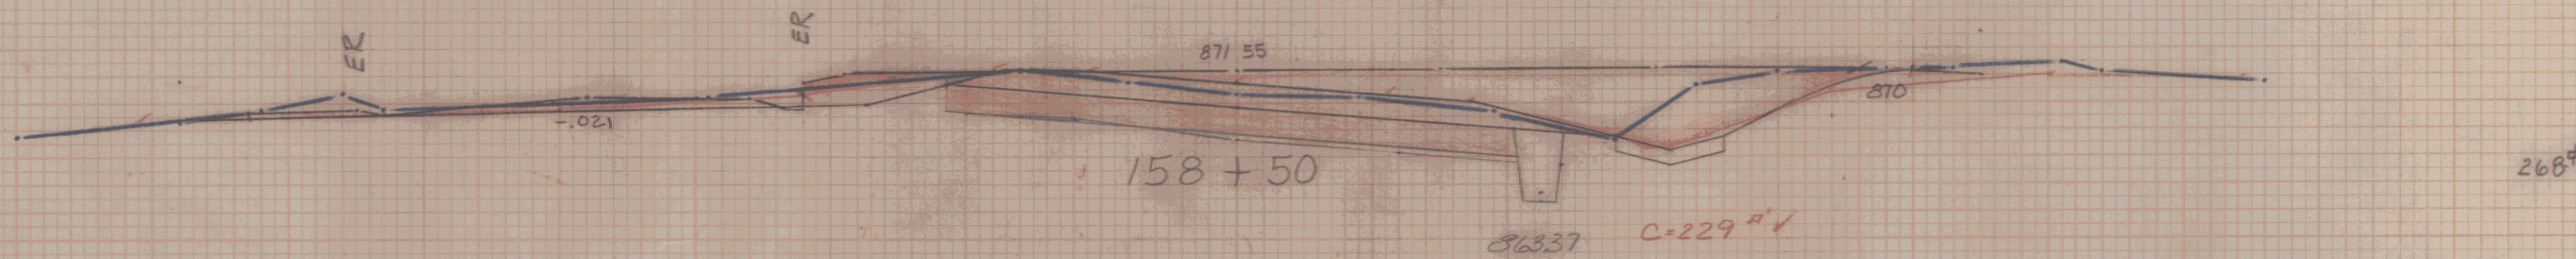
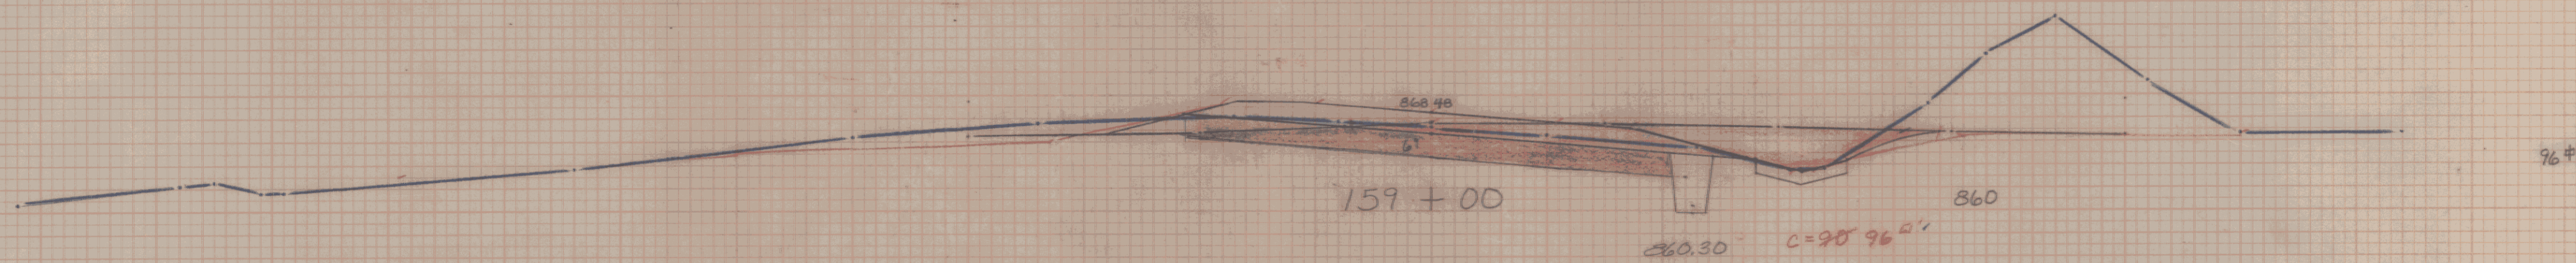
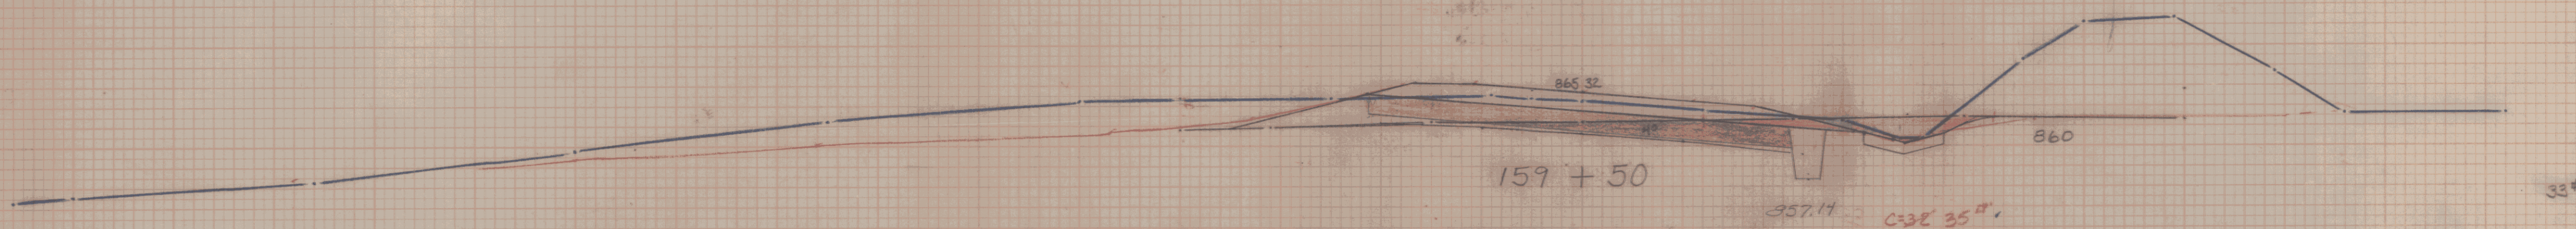
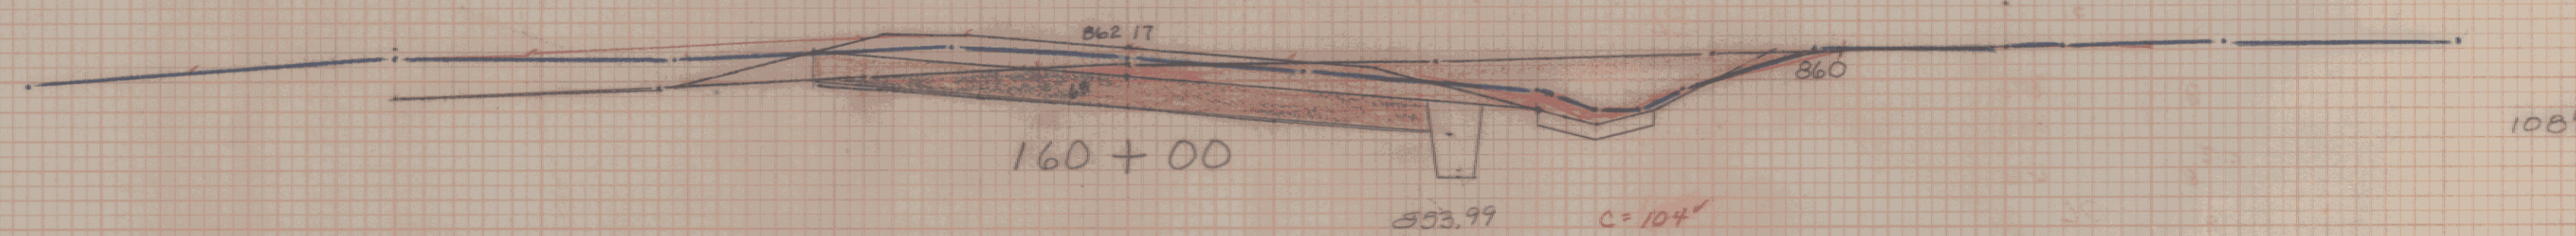


DATE	BY	PROJECT	NO.
12-18-93	RAC, TAC, VLS	TAC	
DESIGNED	CHECKED	DATE	NO.
12-18-93	12-18-93		

DATE	BY	PROJECT	NO.
12-18-93	RAC, TAC, VLS	TAC	
DESIGNED	CHECKED	DATE	NO.
12-18-93	12-18-93		

Base Plot By: H. Survey - Sectioned May 1993 - Boring Boring Core

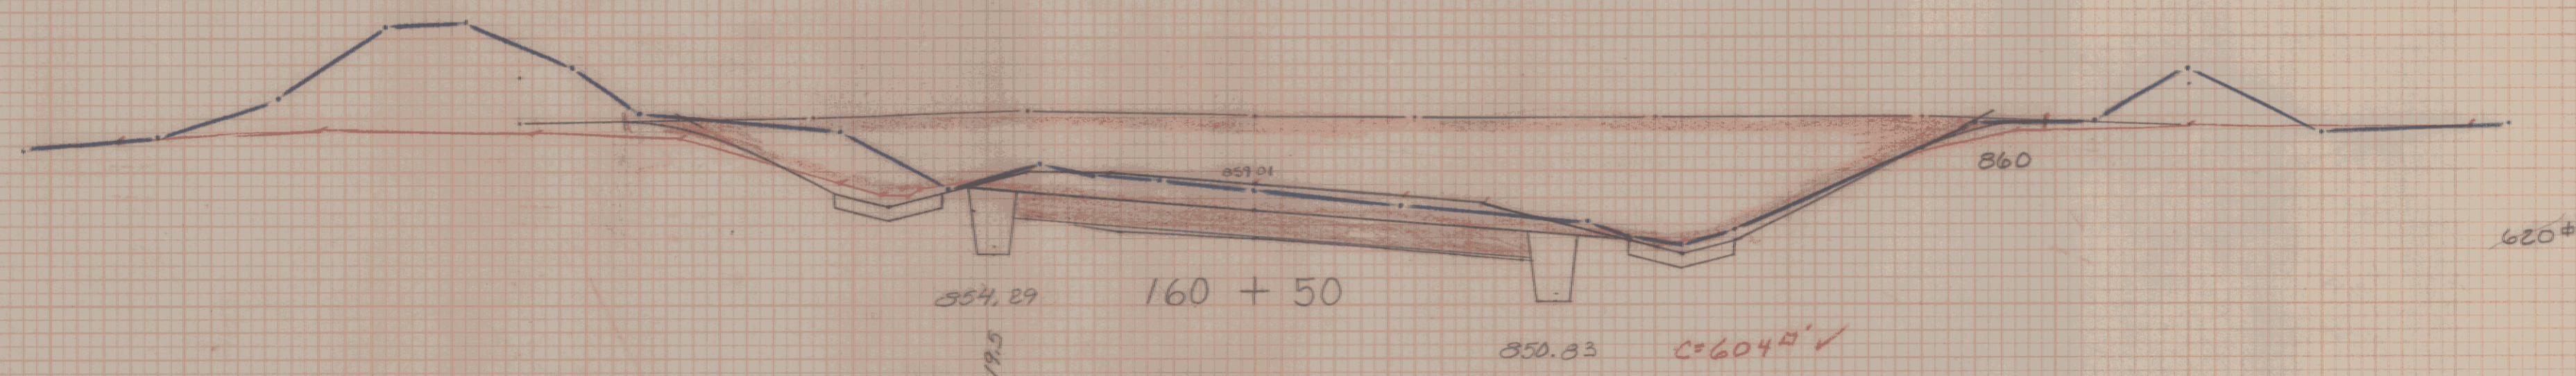

UNDERDRAIN & UNDERCUT (SAND BORROW) TEMPLATED BY R.L.M. 1-6-93
 FINISHES PLATTED BY R.L.M. 11-10-93
 SAND UNDERCUT " " " 11-22-93
 PLATTED " " " 12-21-93
 C&E PLATTED BY C&E 2-1-94
 R.L.M. 2-4-94

REV. SECTIONS
 STA 158+00~160+50
 EAST MONTPELIER
 RSEGC RS 0246(1)SA
 SHEET 8A OF 17A

Kaufel & Esser Company

PLATE CROSS SECTION 487056, Made in U.S.A.