


DATE	BY	REVIEWED	DATE
FINAL SURVEY	NOTED	NOTED	NOTED
NOTED	NOTED	NOTED	NOTED
NOTED	NOTED	NOTED	NOTED

DATE	BY	REVIEWED	DATE
ORIGINAL SURVEY	NOTED	NOTED	NOTED
NOTED	NOTED	NOTED	NOTED
NOTED	NOTED	NOTED	NOTED

✓ CKD. GRUBBING BY C.E. LHR 2-1-94
(SCALED)
✓ CKD. LEDE BY C.E. LHR 2-1-94

BLUE PLOTTED BY VA SURVEY - SECTIONED MAY 1993 - BEFORE BLIND # COTE

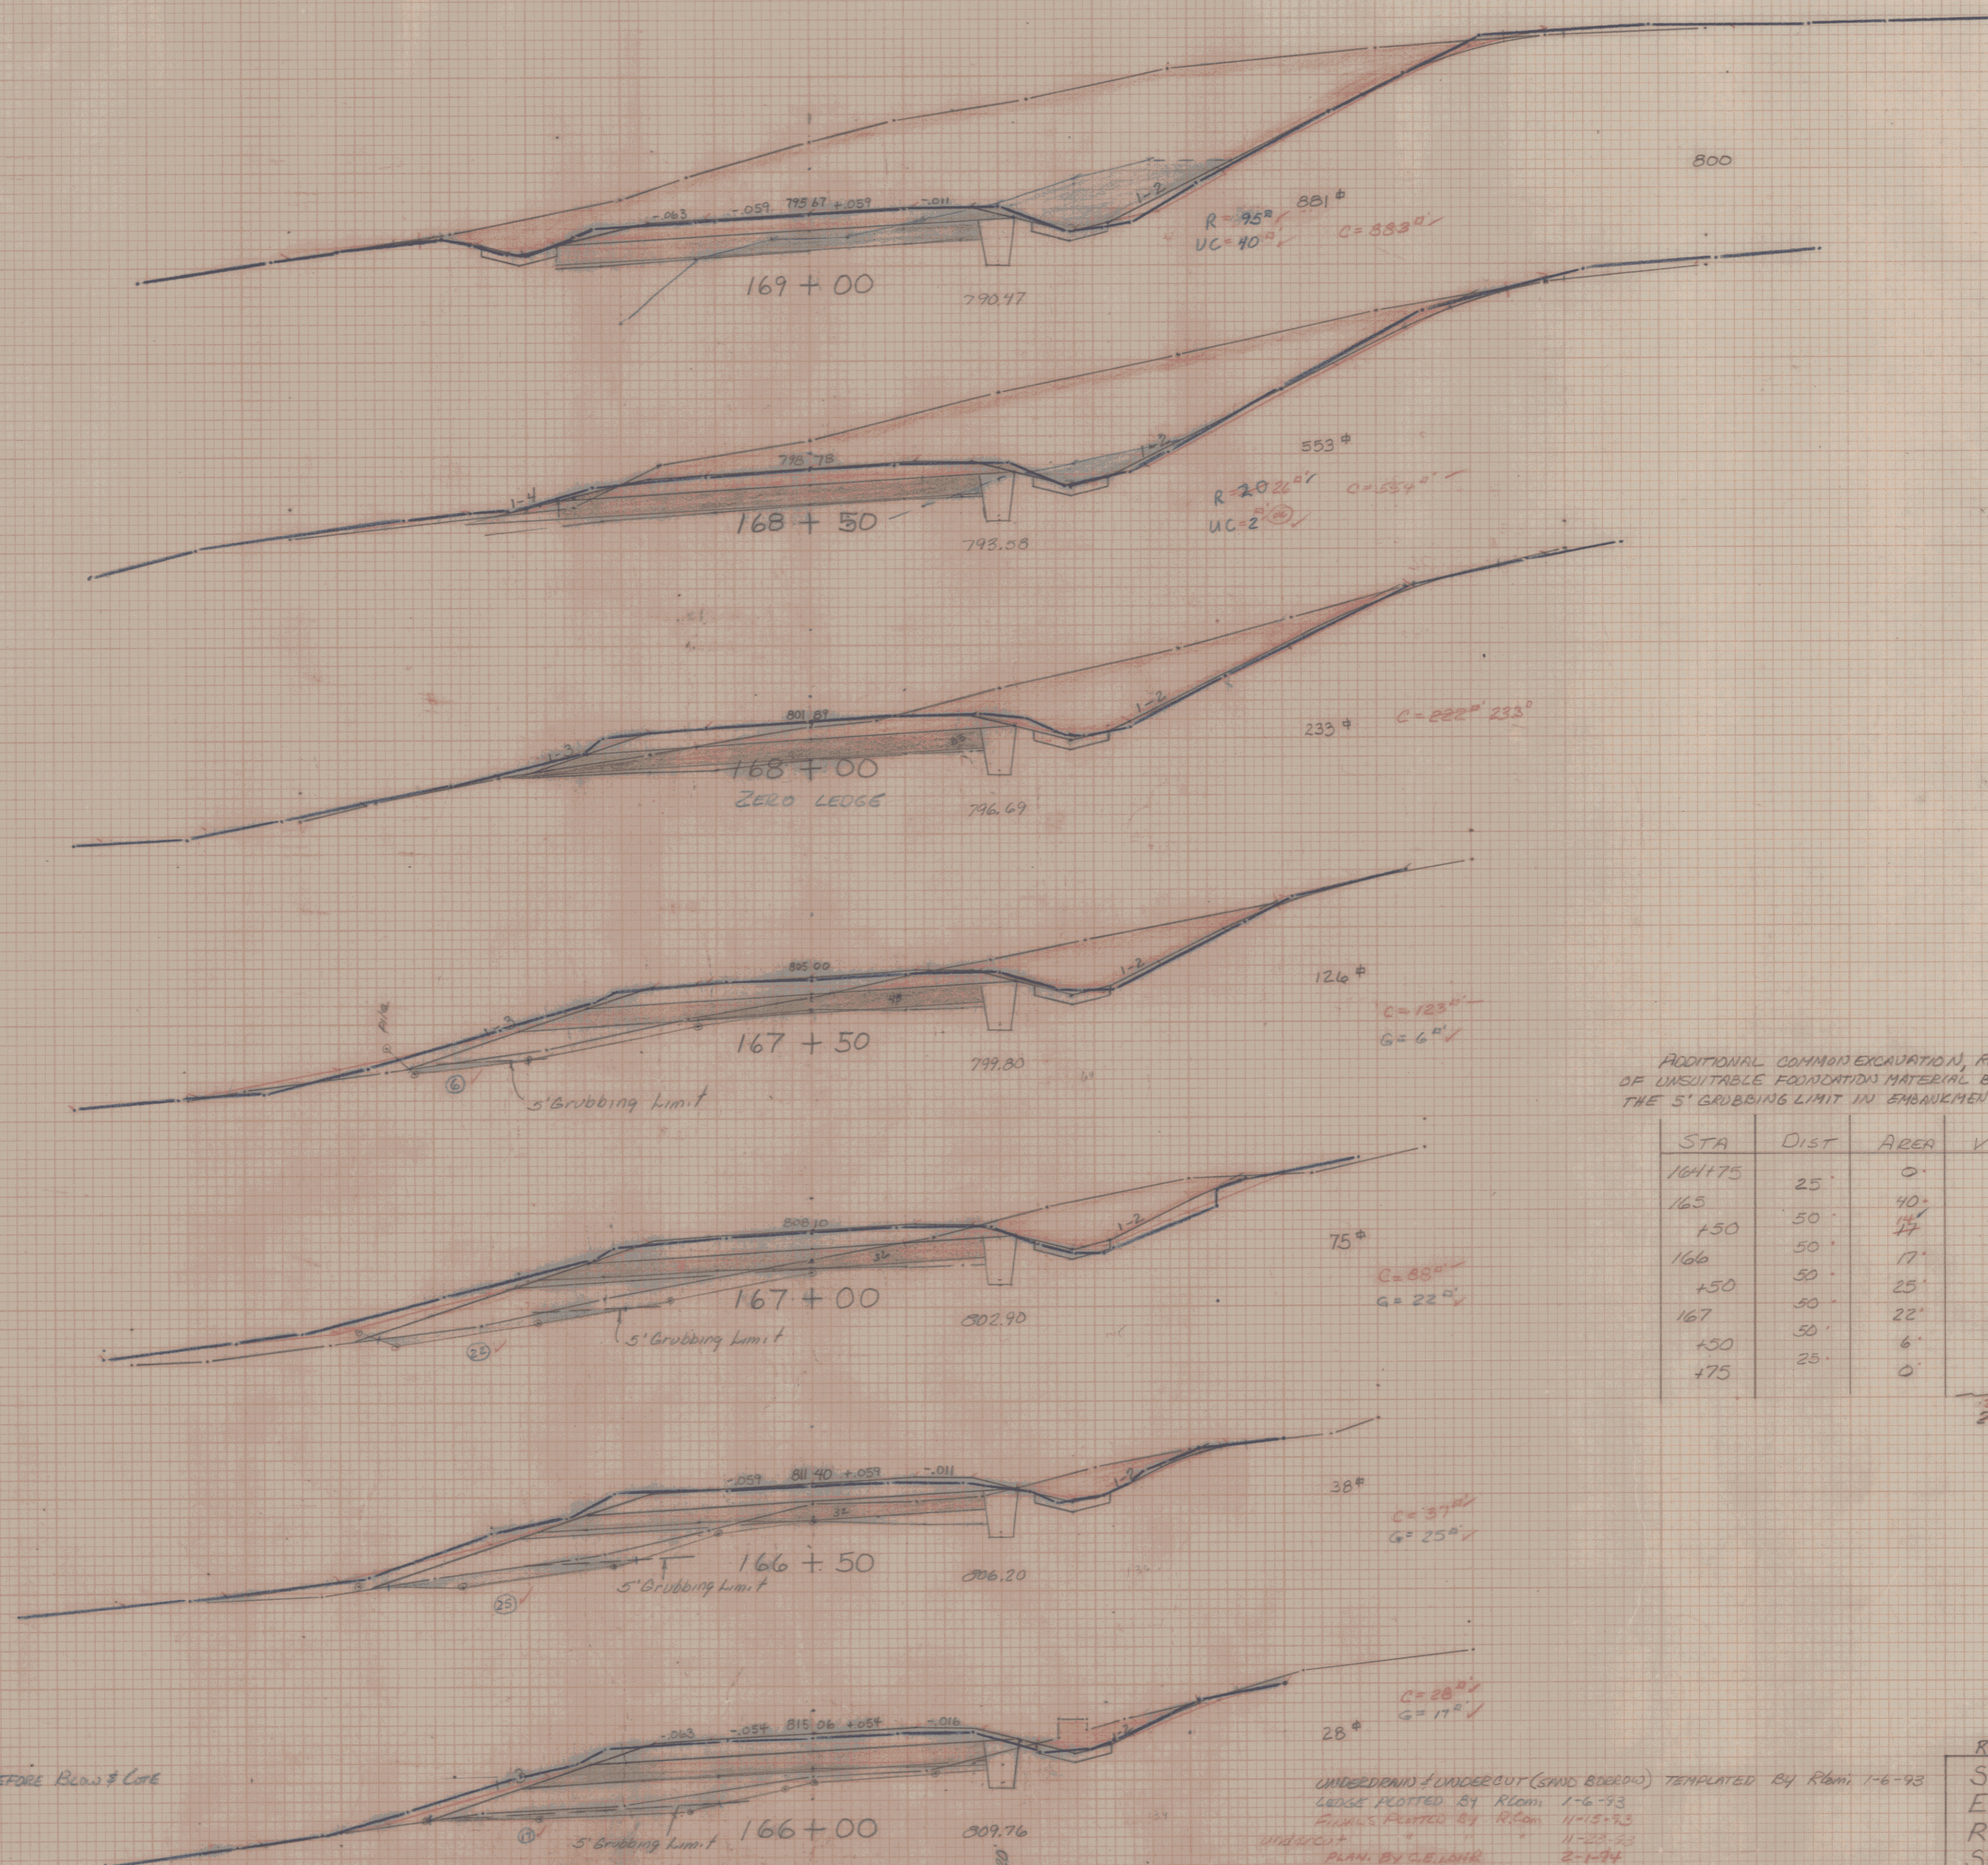

ADDITIONAL COMMON EXCAVATION, REMOVAL OF UNSUITABLE FOUNDATION MATERIAL BELOW THE 5' GRUBBING LIMIT IN EMBANKMENT AREA

STA	DIST	AREA	VOL
164+75	25'	0'	19'
165	40'	50'	50'
150	50'	17'	31'
166	50'	17'	39'
150	50'	25'	44'
167	50'	22'	36'
150	50'	6'	3'
175	25'	0'	3'

210'
215' C/L
R. L. L. 1-20-94
C/L 2-1-94
R. L. L. 2-4-94

UNDERPAINT UNDERCUT (SHED BORDERS) TEMPORARY BY R. L. L. 1-6-93
LEDGE PLOTTED BY R. L. L. 1-6-93
FUNDUS PLOTTED BY R. L. L. 1-15-93
UNDERCUT
PLAN BY C. E. LHR 2-1-94
Rev R. L. L. 2-4-94

REV. SECTIONS
STA 166+00 ~ 169+00
EAST MONTPELIER
RSEGC RS 0246
SHEET 11A OF 17A