


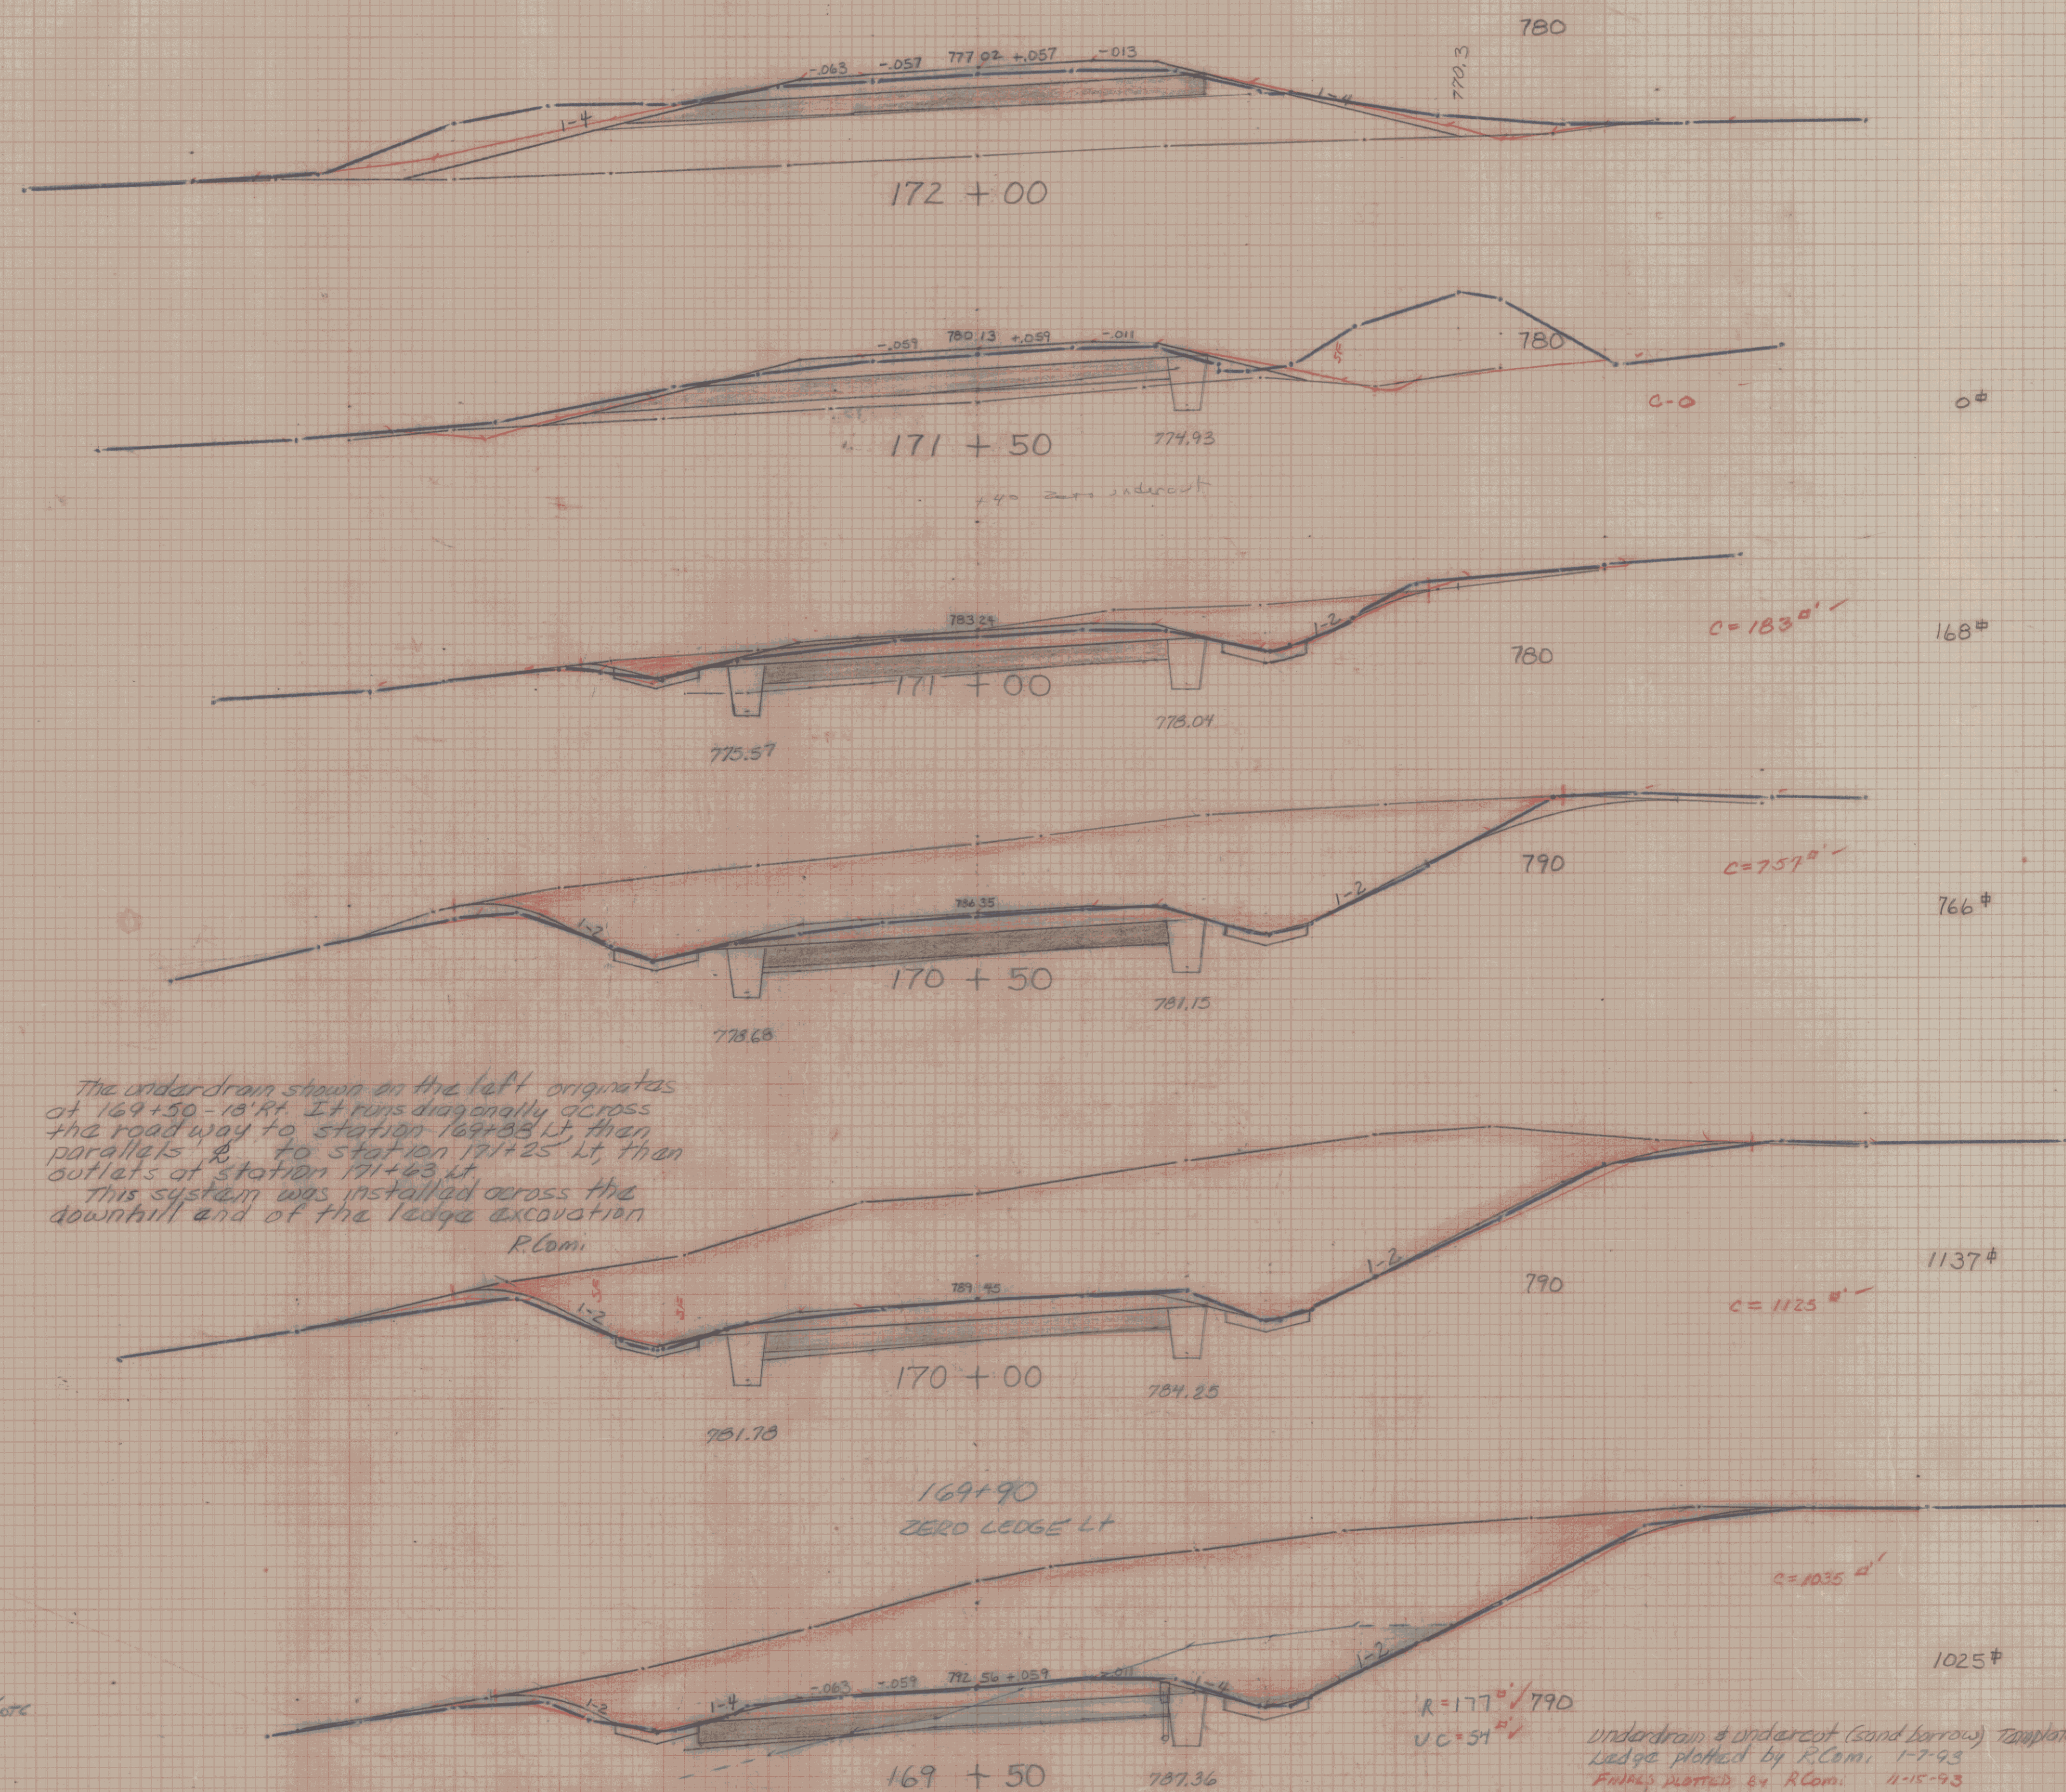

BLUE PLOTTED by V.A. SURVEY - SECTIONED May 1993 - BEFORE BLOW & LOGG

$R = 177 \checkmark$ 790
 $UC = 54 \checkmark$

54 P¹ Underdraw & undercut (Sand borrow) Translated by KCom. 17-95
Ledge plotted by KCom. 1-7-95
Fishes plotted by KCom. 1-15-95
UNDERCUT & sand " " 11-23-93
RAV. BY C.B.LONG 2-2-94
C.B.LONG BY C.B.LONG 2-2-94
Plot KCom. 2-4-94

REV. SECTIONS
STA 169 + 50 ~ 172 + 00
EAST MONTPELIER
RSEGC RS0246(1)
SHEET 12A OF 17A