


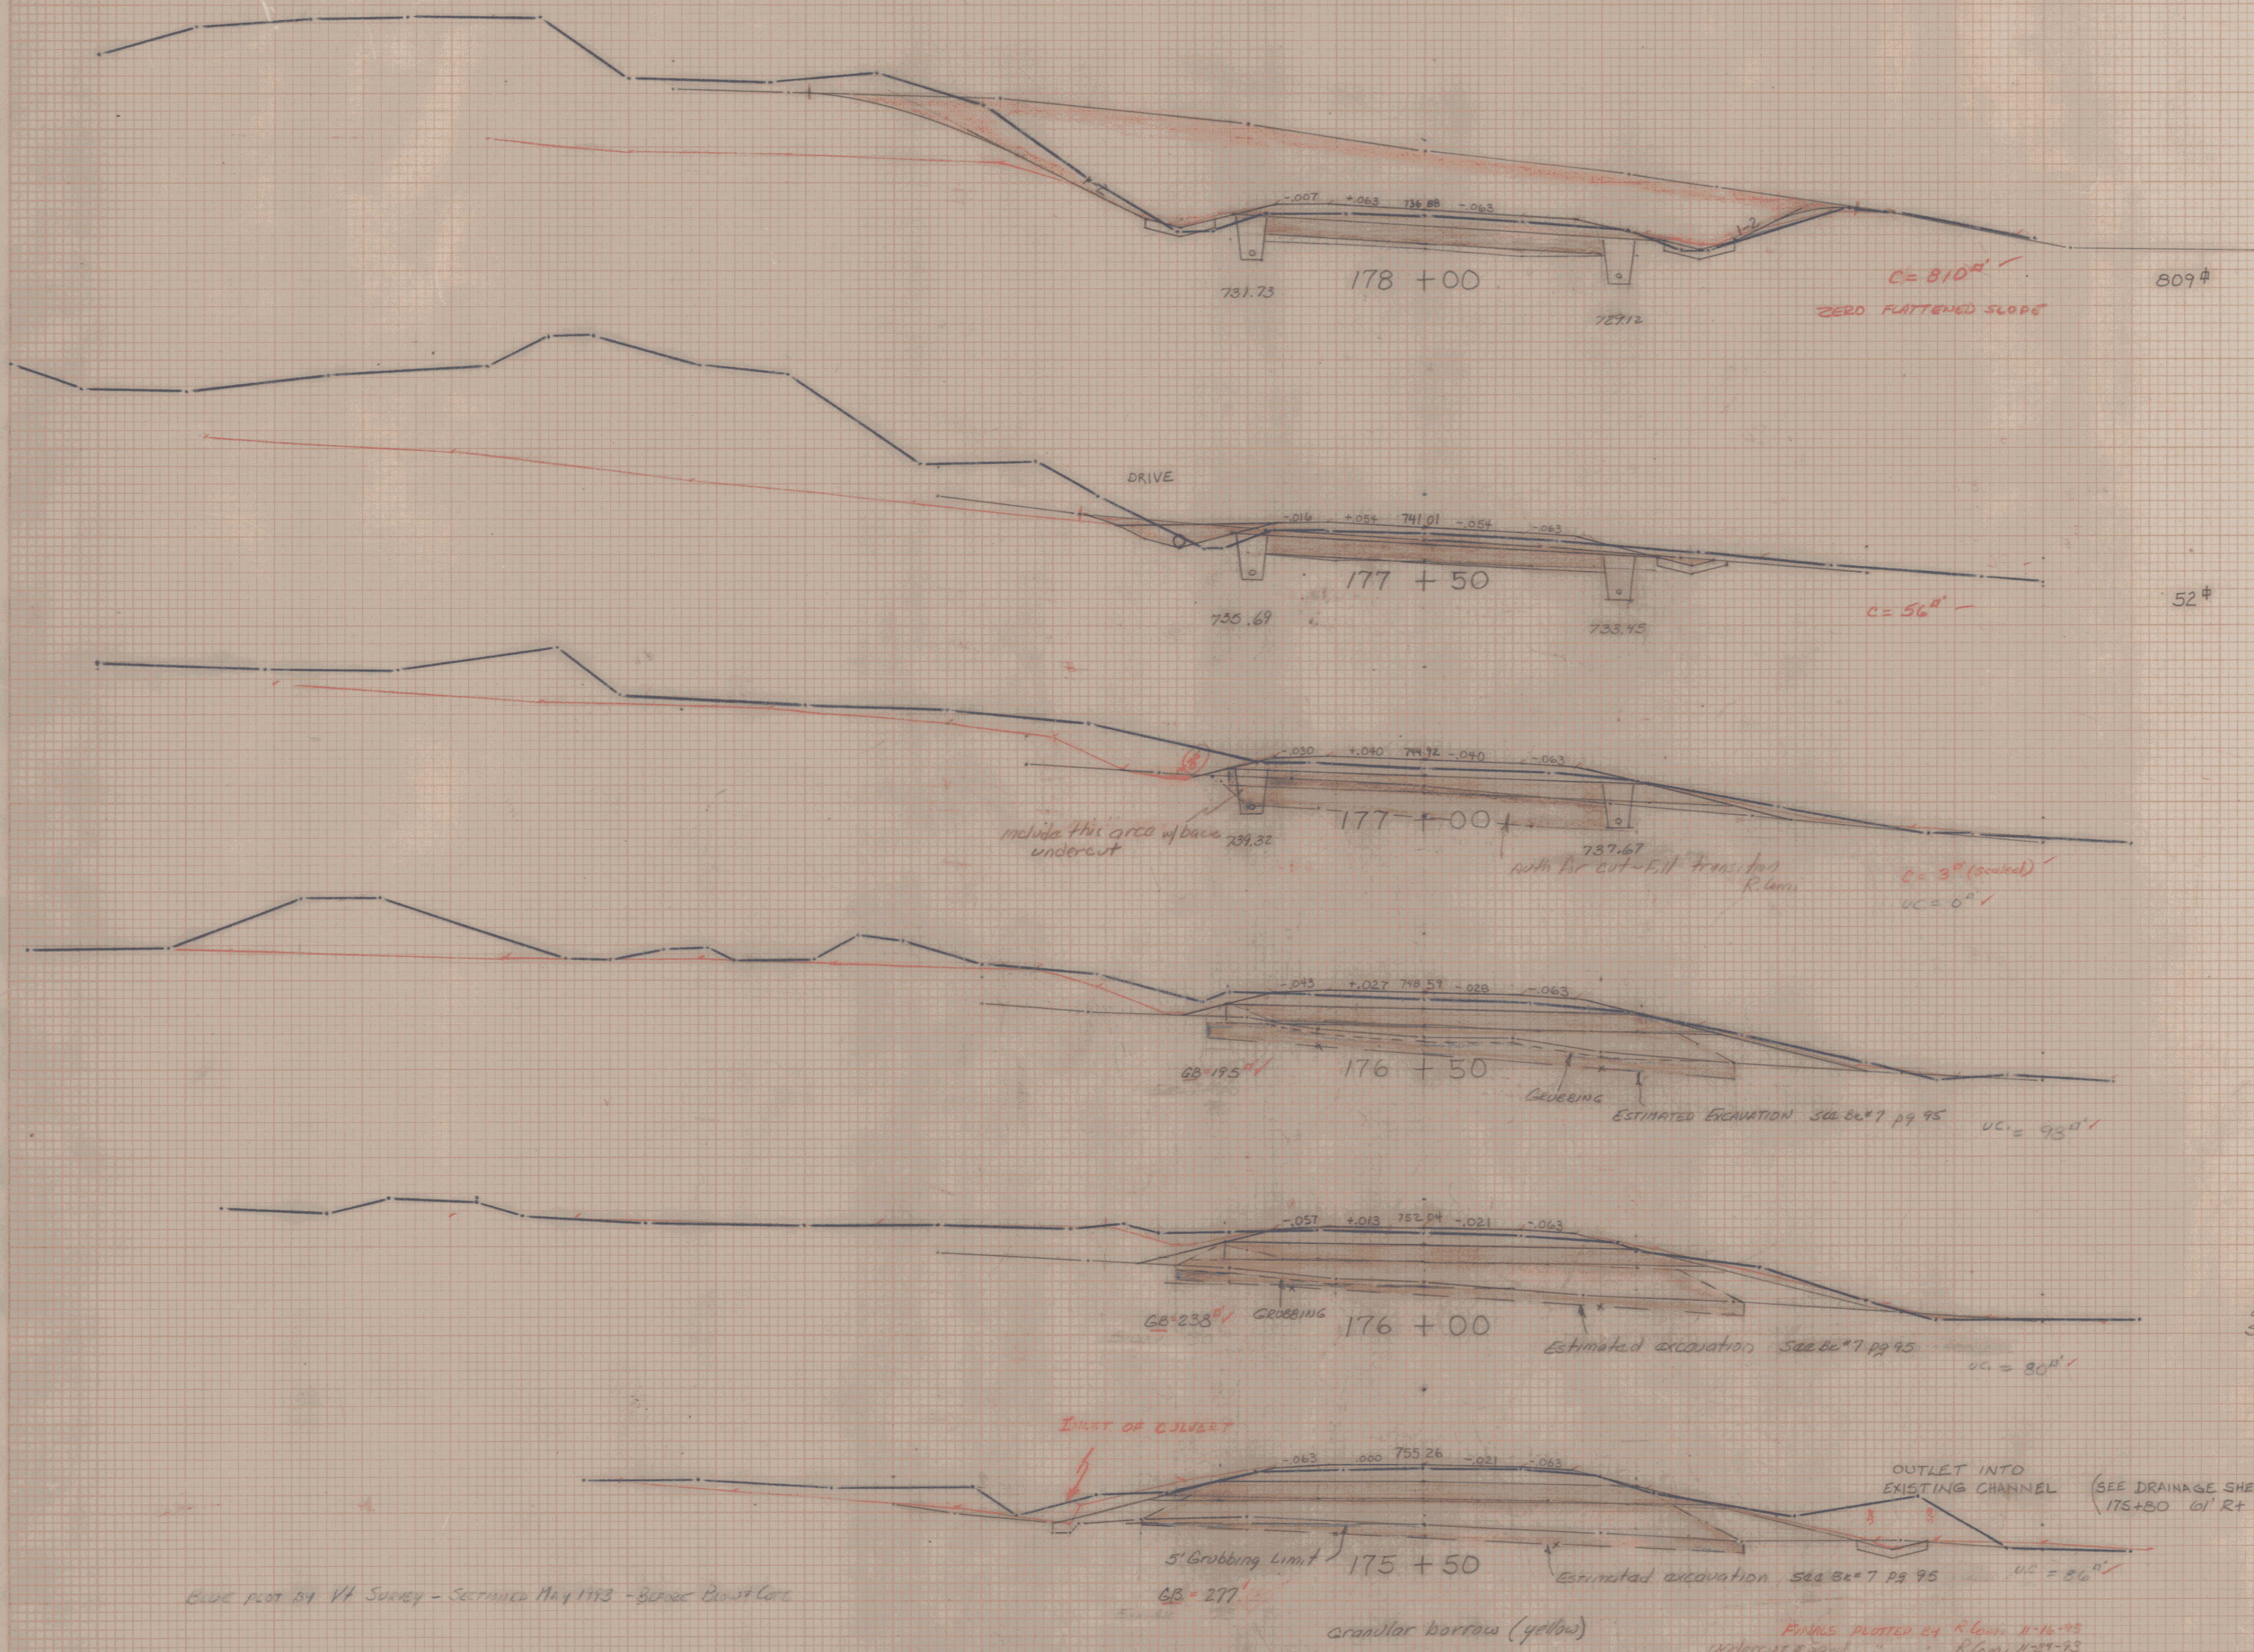

AUTHORIZED IN PLACE GRAVURE BORROW				EXCAVATION	
FROM 174+50 ~ 177+0				AREA	VOL
STA	DIST.	AREA	VOL	AREA	VOL
+50	50	0	225	0	32
175	50	243	481	89	162
+50	50	277	477	80	154
176	50	238	408	80	165
+50	50	195	181	98	91
177	50	0		0	
			1264 cu 1745 y	657 cu	
x 1.15			2089 cu 2030 y	R. Com. of 3/17/94	

grow back fill around
station 175+30
2 pg 5 ft x 9 ft 2 pg 176 (244 x 115) = 281
1749 cu
R. Com.
4.12.94

REV. SECTIONS

STA 175+50 ~ 178+00
EAST MONTPELIER
RSEG RS 0246(1)
SHEET 14A OF 17A

160 + 5