

INDEX OF SHEETS
SEE SHEET 2

RECORD PLANS

CONTRACTOR EARTH CONST INC - GROTON, VT.
FINISHED THRU BONDING CO. - ST PAUL MERC. INS. CO. (BOSTON, MA)
RESIDENT ENGINEER DUBOIS CONSTRUCTION INC FINISHED FOR BONDING CO.
LEON DUNN
CONSTRUCTION BEGAN 9-24-91
CONSTRUCTION COMPLETED 6-20-94
RECORD PLANS BY CONSTRUCTION CAD - JEFF COTA

I hereby certify that all the construction required
by this set of drawings has been accomplished as
indicated herein.

By [Signature] Resident Engineer

NOTE: Any further information concerning final quantities,
amounts or other details relative to this project may be found on
microfilm in central files.

STATE OF VERMONT AGENCY OF TRANSPORTATION




PROPOSED IMPROVEMENT CITY OF MONTPELIER COUNTY OF WASHINGTON BERLIN STREET (F.A.U.)

BEGINNING AT THE INTERSECTION OF BERLIN ST. AND U.S. RTE. 2 (RIVER ST.) IN THE CITY
OF MONTPELIER AND EXTENDING IN A SOUTHEASTERLY DIRECTION ALONG THE EXISTING
ALIGNMENT OF BERLIN ST. FOR 1.061 MILES TO A POINT WHICH IS LOCATED APPROXIMATELY
150' NORTHEASTERLY OF THE MONTPELIER CITY-BERLIN TOWN LINE.

LENGTH OF ROADWAY = 5604.31 FEET = 1.061 MILES
LENGTH OF PROJECT = 5604.31 FEET = 1.061 MILES

WORK TO BE PERFORMED ON THIS PROJECT CONSISTS OF GRADING, DRAINAGE, SUBBASE,
PAVEMENT, SIDEWALK, CURBING, REPLACEMENT OF WATER LINES, PARTIAL UNDERGROUND CONDUIT
FOR POWER AND COMMUNICATION LINES AND OTHER ASSOCIATED UTILITY RELOCATIONS FOR AN
URBAN ROADWAY ON EXISTING LOCATION.

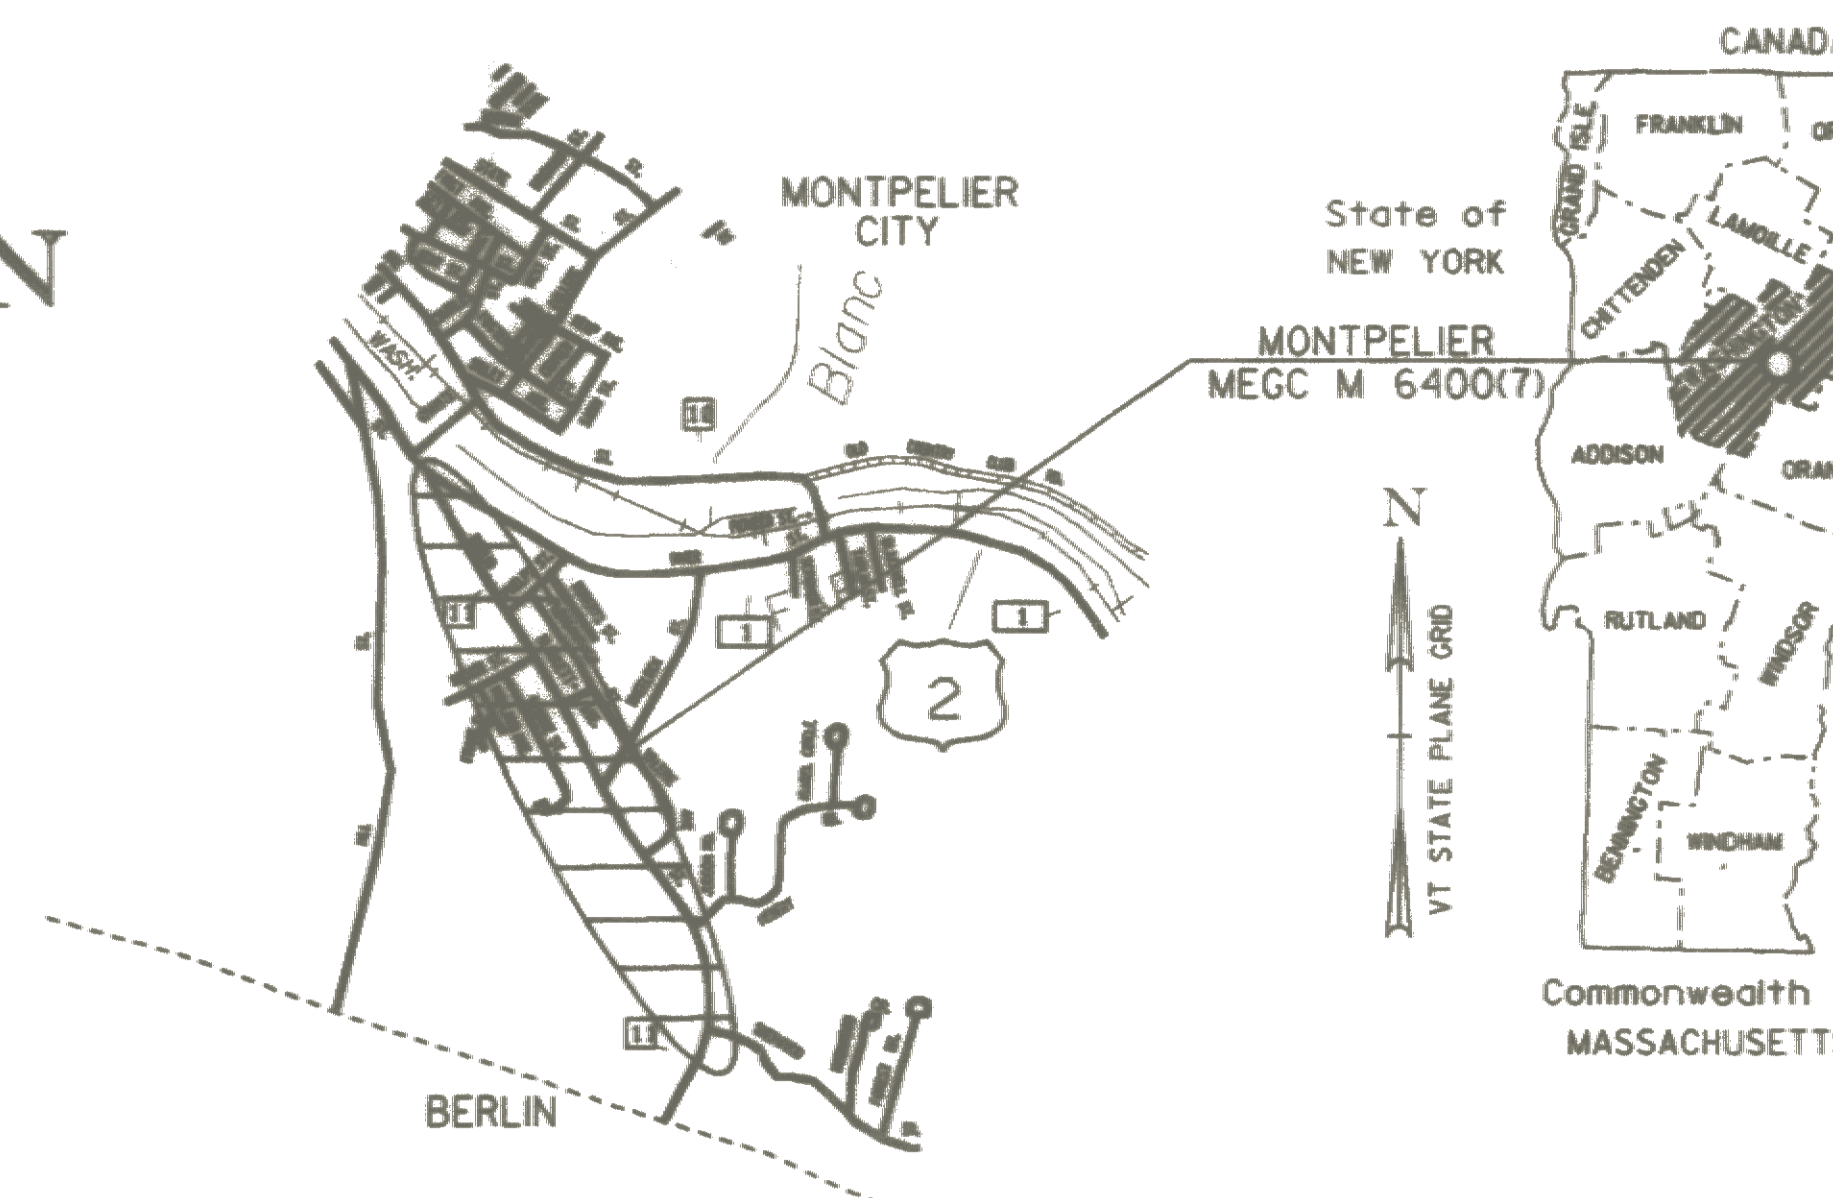

TRAFFIC
1991 ADT =
1991 DHV =
2011 ADT =
2011 DHV =
D
T
V
18 K ESAL =

