


TYPICAL SECTIONS

NOT TO SCALE

PAVEMENT	±1/4"
BASE COURSE	±1/2"
SUBBASE	±1"
SAND BORROW	±1"

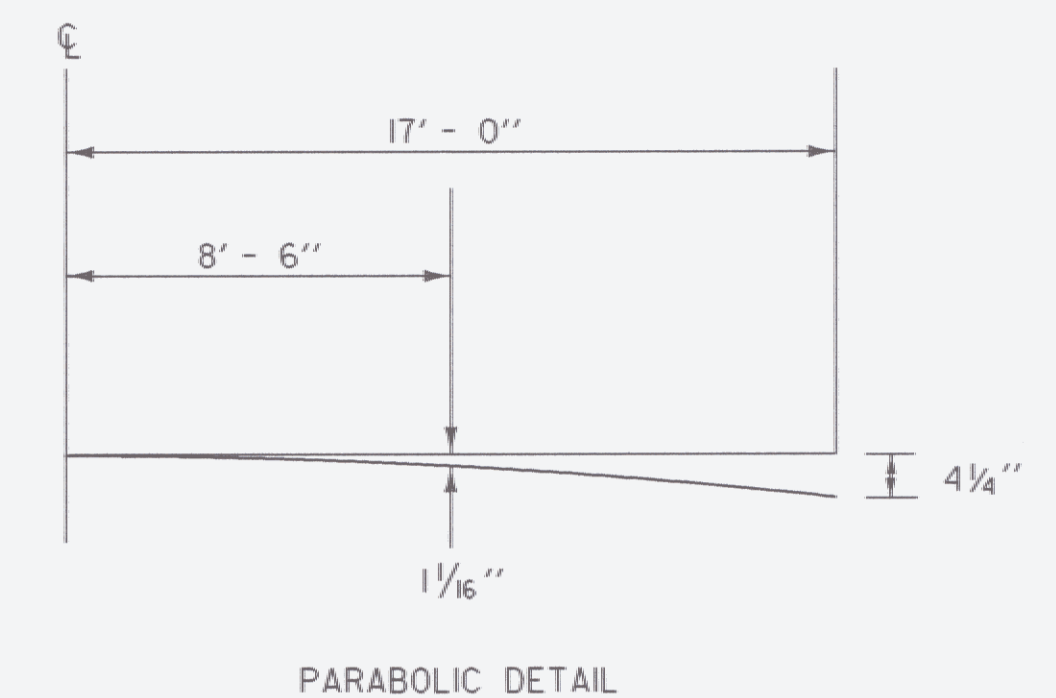

PARABOLIC DETAIL

