

Rev.	Description	By	Date
2	VALVE STA. 25+66	LB	3/19/90
1	HYDRANT 25+55	LB	1/5/89

CITY OF MONTPELIER
BERLIN STREET RESTORATION
WATER MAIN INSTALLATION PLAN
 STA 21+00 TO STA 27+00


DH
 Dufresne-Henry Inc.
 36 East State Street
 Montpelier, VT 05602

Client No. 616040
 Proj. Manager T.D. NESBITT
 Proj. Designer L.B. LACKEY
 Drawn By K.G. FLANDERS
 Checked By T.D. NESBITT
 Scale 1" = 20'
 Approved *[Signature]*
 Date APRIL 14, 1989

VERMONT
 Sheet 3 of 19
 D 616040-03



DATUM
 VERTICAL NGVD 1929
 HORIZONTAL N/A

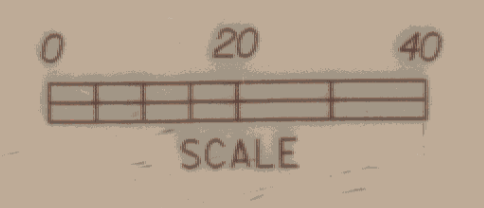

THIS SHEET FOR UTILITIES USE ONLY

NOTE
 The Owner reserves the right to delete any or all of the above utility relocation work and perform the relocation work with their own forces. The contractor should confirm material and quantities prior to ordering.

REV. CURVE #3
 Δ = 5° 16' 20" RT
 D = 2° 00' 00"
 R = 2864.79'
 T = 131.90'
 L = 263.61'
 E = 3.03'

15-FEB-1989

SURVEYED BY	MOREAU	DATE	7-85
DRAWN BY	DAYE/REDMOND	DATE	4-88
SQUAD LEADER	SHERIDAN		
DESIGN FILE NO.	76B033	DATE PLOTTED	
PROJ. NAME	MONTPELIER		
PROJ. NO.	MEGC-M6400(7)		
SHEET 85 OF 325 SHEETS			