

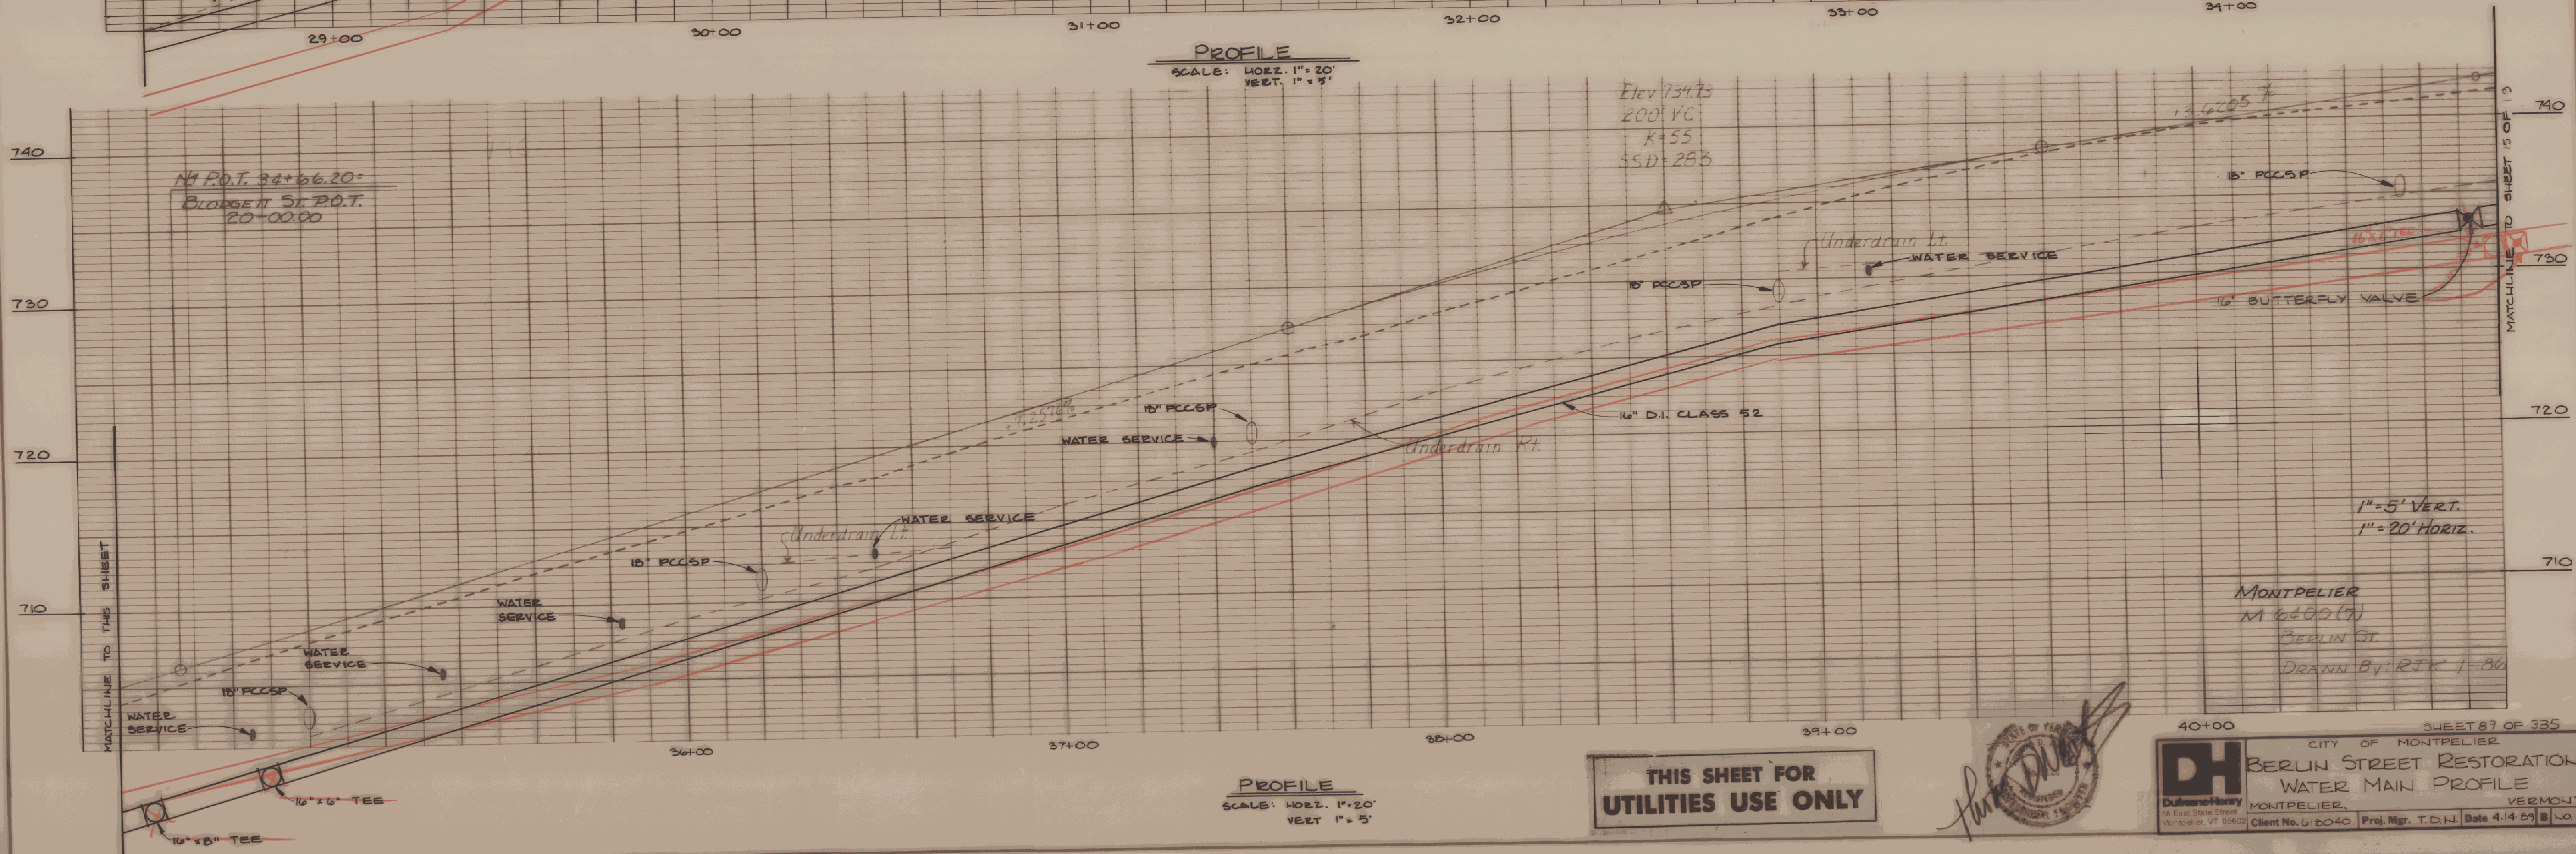


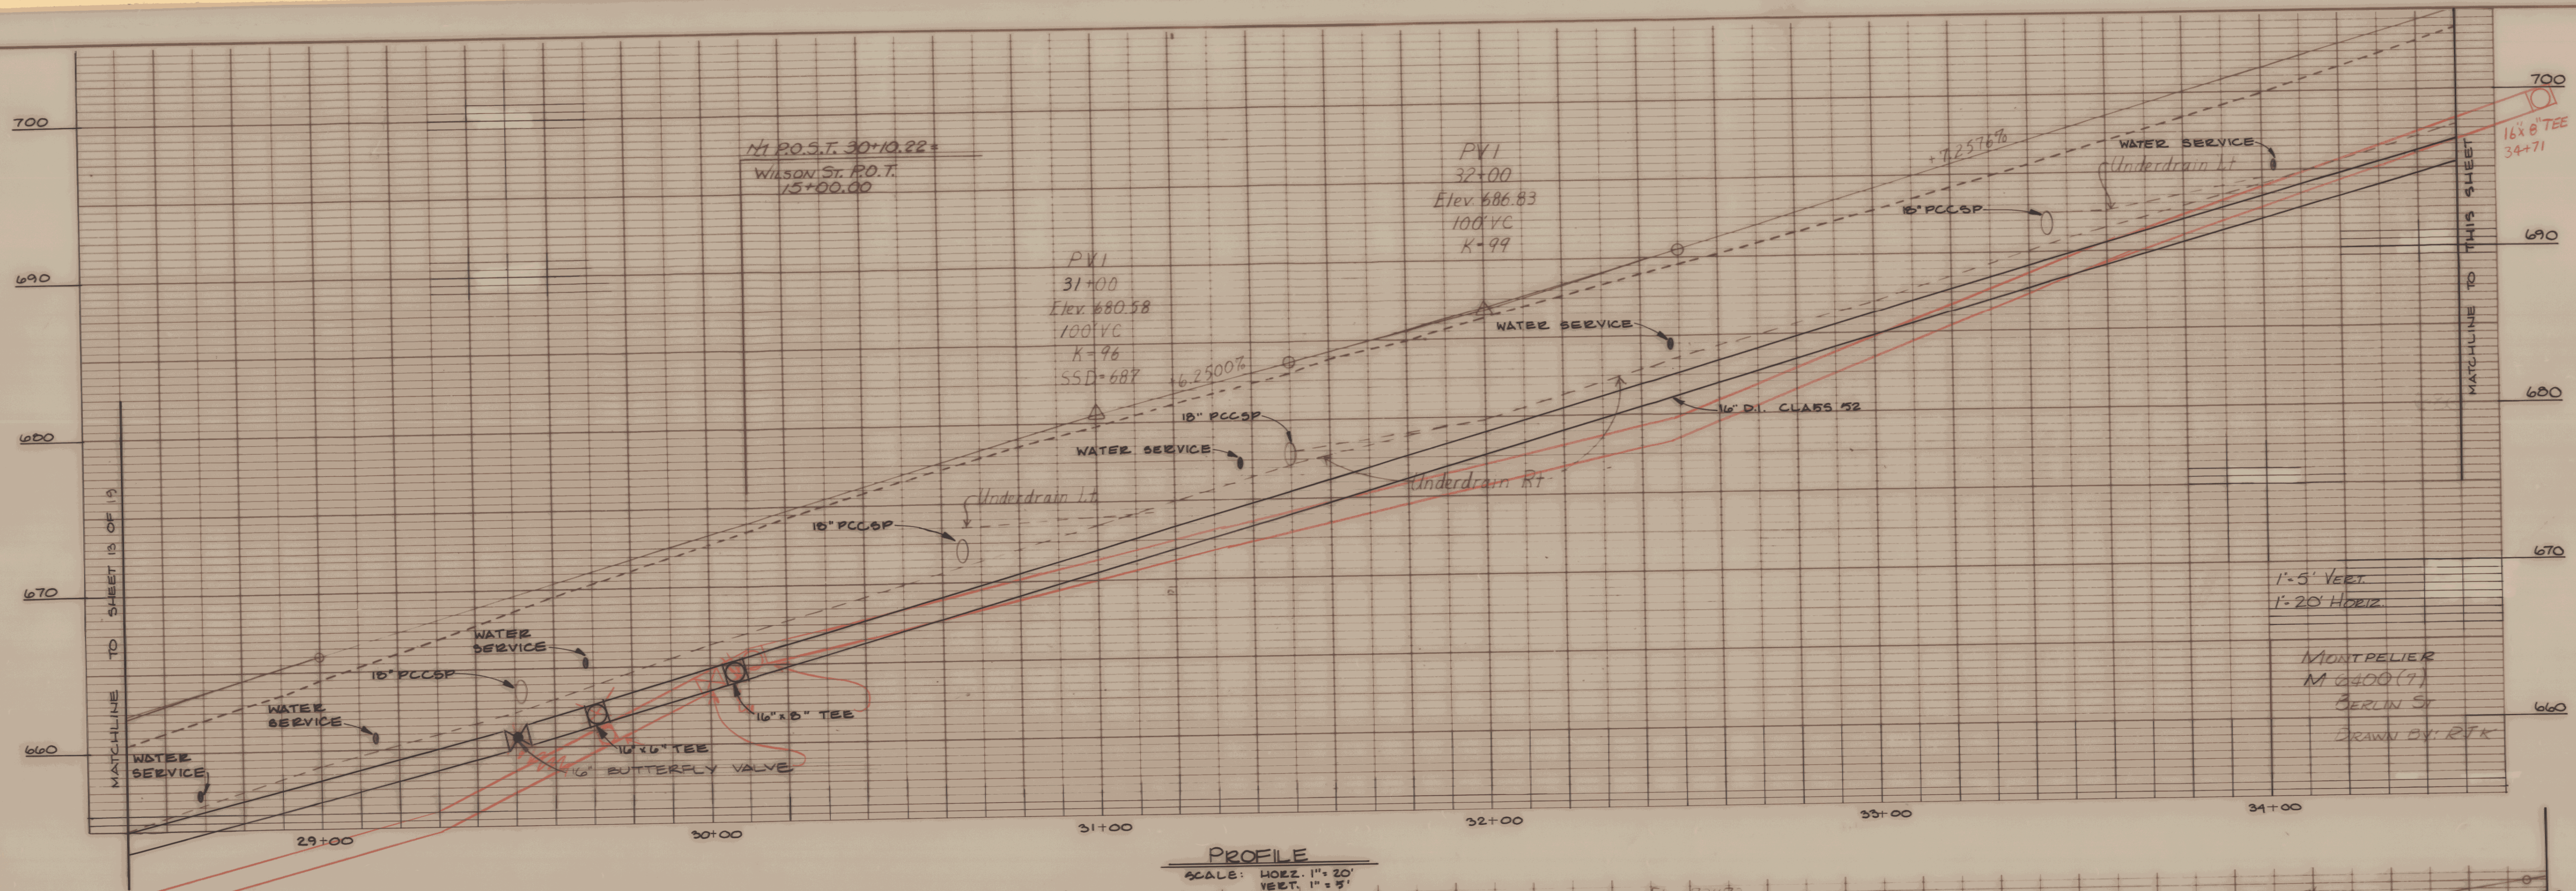

THIS SHEET FOR
 UTILITIES USE ONLY

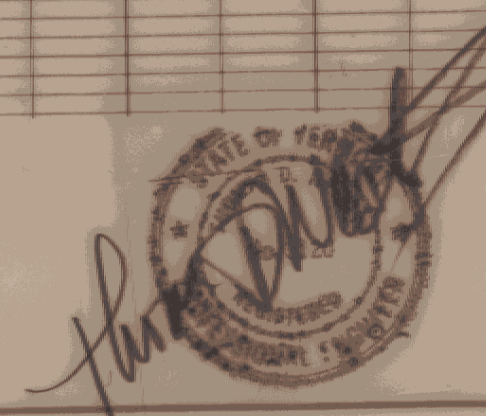

CITY OF MONTPELIER
 BERLIN STREET RESTORATION
 WATER MAIN PROFILE
 MONTPELIER, VERMONT
 Client No. G16040 Proj. Mgr. T.D.N. Date 4-14-85