


Rev.	Description	By	Date

CITY OF MONTPELIER	
BERLIN STREET RESTORATION	
WATER MAIN INSTALLATION PLAN	
STA. 56+50 TO STA. 62+00	
MONTPELIER, VERMONT	
Client No. 61040	Proj. Manager TD NESBITT
Proj. Designer L BLACKLEY	Drawn By K GFLANDERS
Checked By TD NESBITT	Scale 1" = 20'
Approved <i>[Signature]</i>	Sheet 9 of 19
Date APRIL 14, 1989	D 61040-09


Dufresne-Henry Inc.
58 East State Street
Montpelier, VT 05602

TO SHEET 8 OF 19

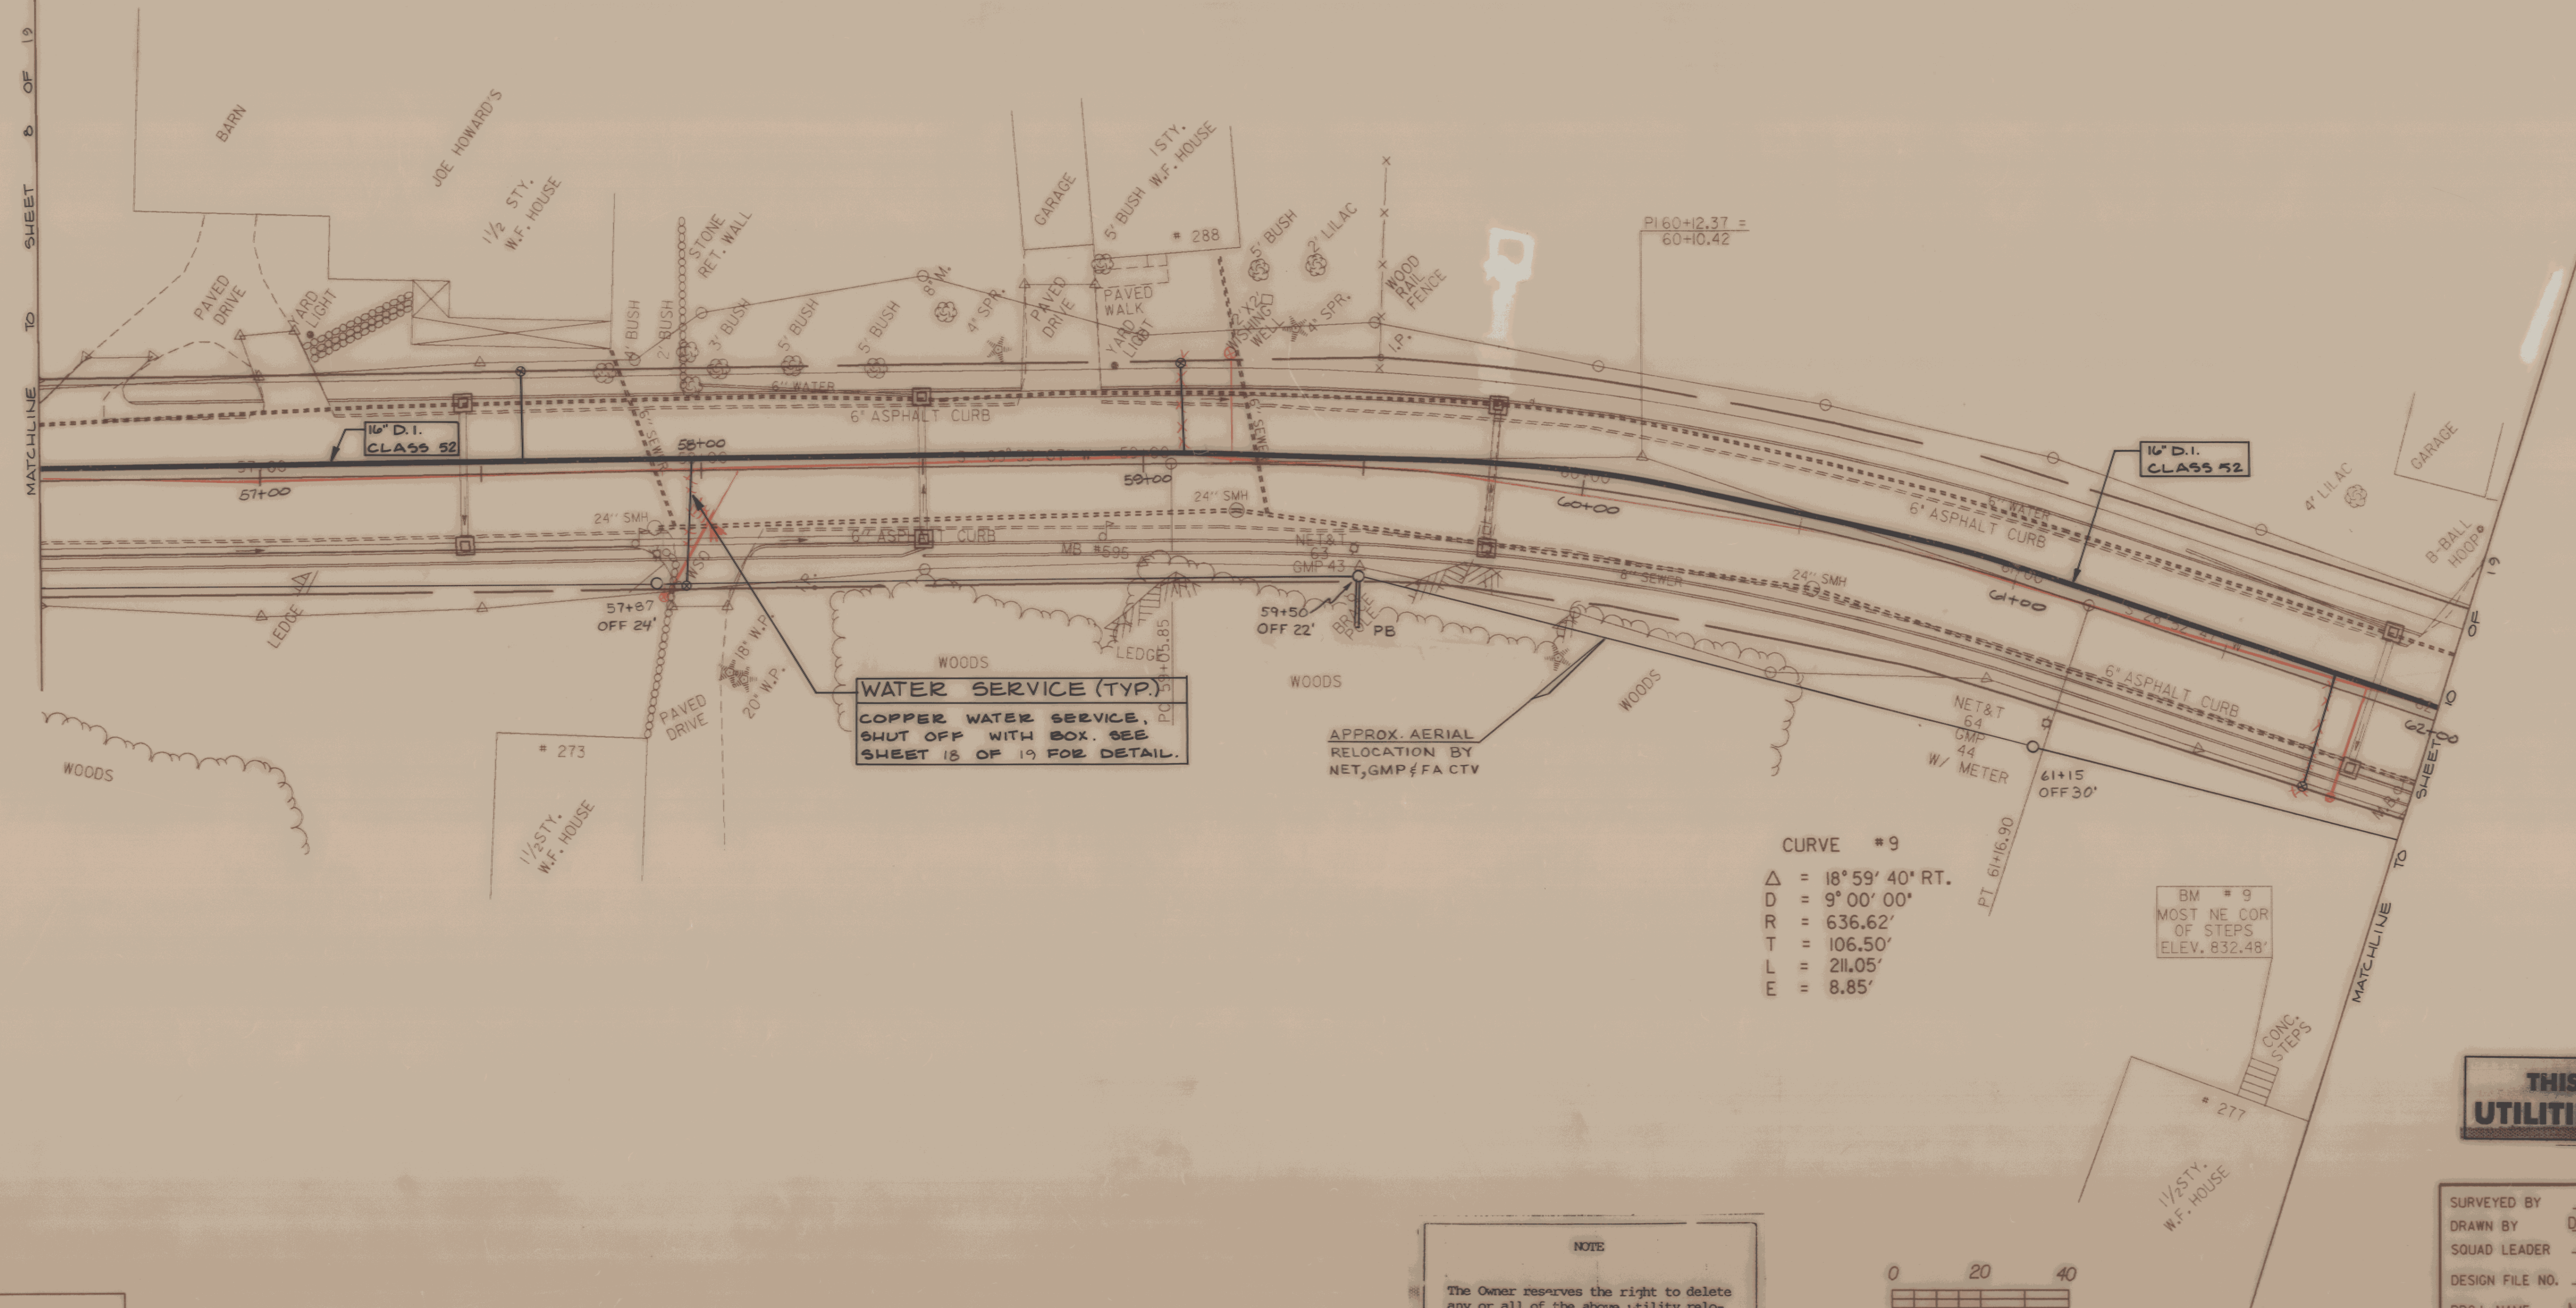

DATUM
VERTICAL NGVD 1929
HORIZONTAL N/A

NOTE
The Owner reserves the right to delete any or all of the above utility relocation work and perform the relocation work with their own forces. The contractor should confirm material and quantities prior to ordering.

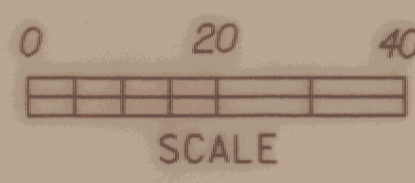

THIS SHEET FOR
UTILITIES USE ONLY

SURVEYED BY MOREAU	DATE 7-85
DRAWN BY DAYE/REDMOND	DATE 4-88
SQUAD LEADER SHERIDAN	
DESIGN FILE NO. 76B033	DATE PLOTTED
PROJ. NAME MONTPELIER	
PROJ. NO. MEGC M6400(7)	
SHEET 94 OF 335 SHEETS	