
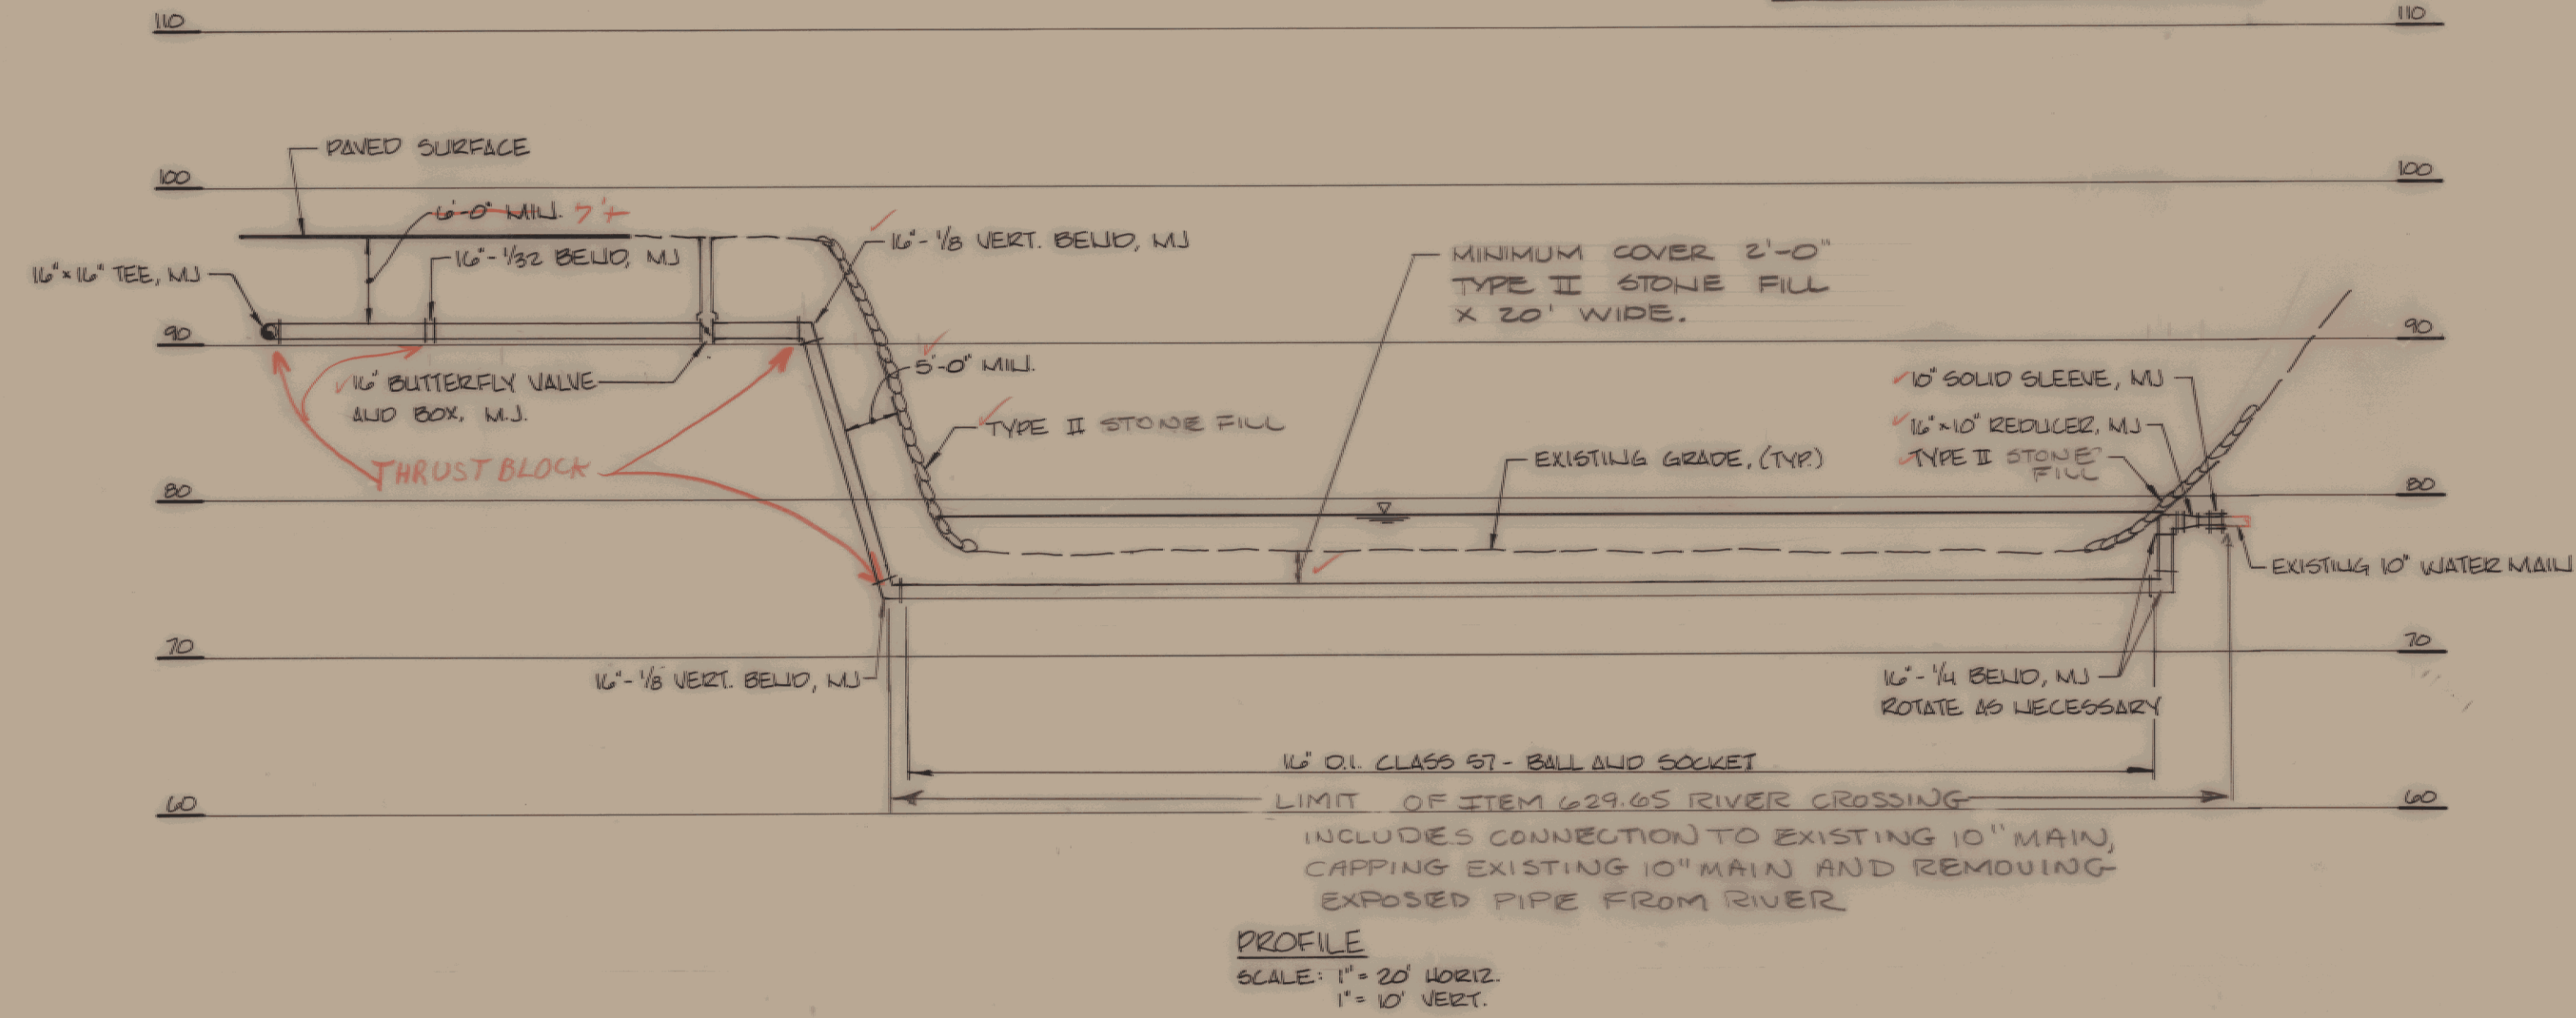


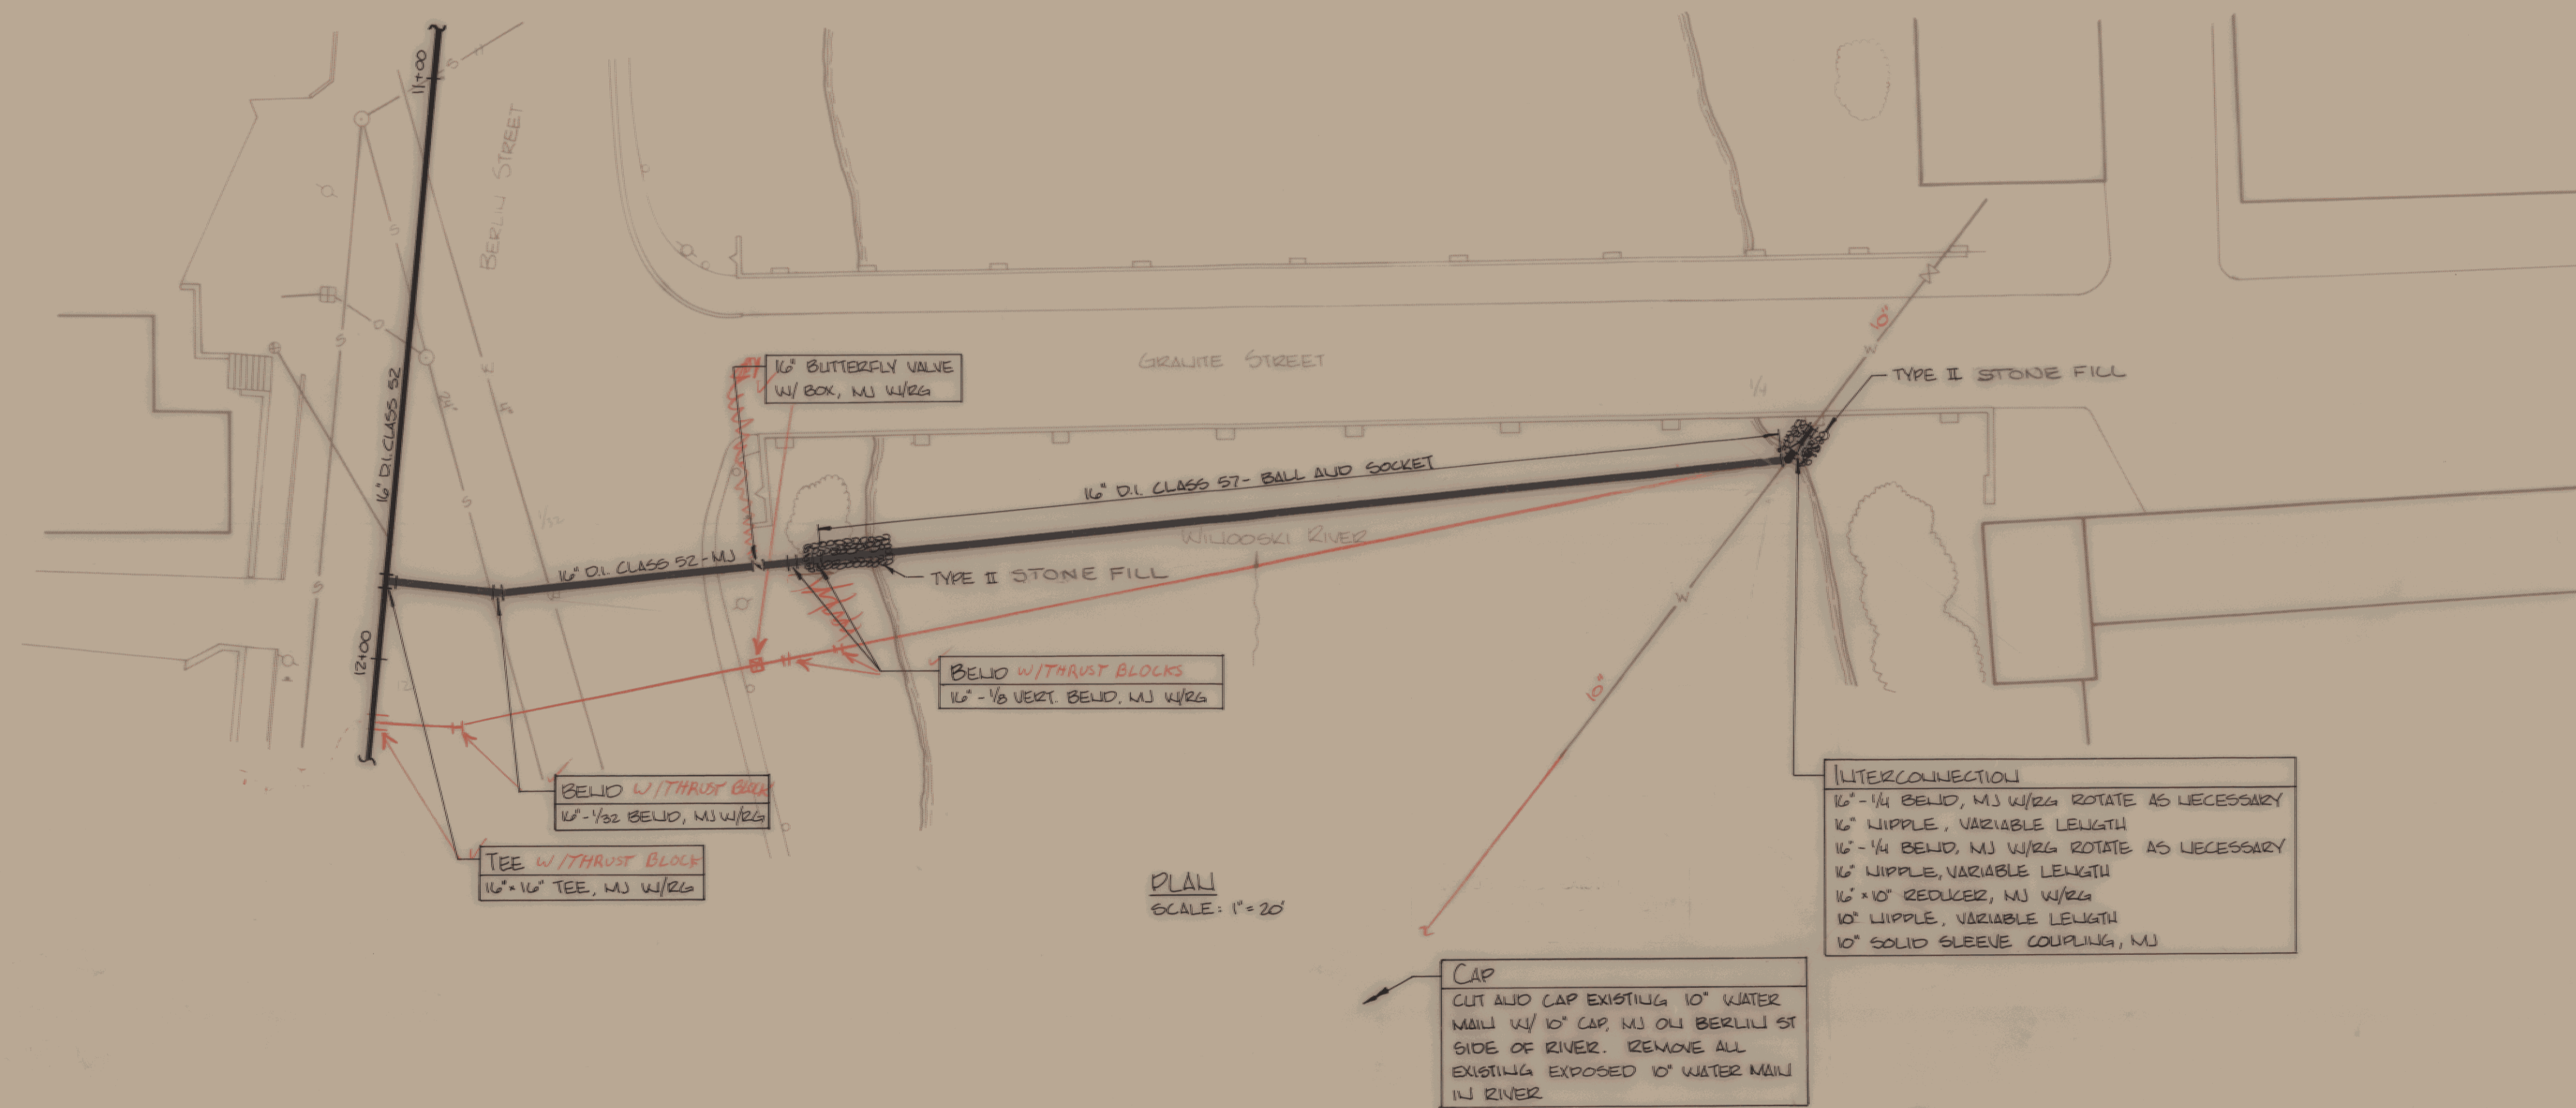

- NOTES:
1. CONTRACTOR TO RIP RAP (TYPE II) BULK ON ALL DISTURBED AREAS. (STONE FILL TYPE II)
 2. CONTRACTOR TO CONSTRUCT COFFER DAMS AS REQUIRED TO MAINTAIN RIVER FLOW DURING CONSTRUCTION OF WATER MAIN.
 3. ALL WORK TO BE DONE IN ACCORDANCE WITH STREAM ALTERATION PERMIT.
 4. REFER TO SHEET 1 OF 19 FOR GENERAL NOTES. REFER TO SHEET 19 OF 19 FOR MISCELLANEOUS DETAILS.

NOTE

The Owner reserves the right to delete any or all of the above utility relocation work and perform the relocation work with their own forces. The contractor should confirm material and quantities prior to ordering.

SHEET 100A OF 335 SHEETS

CITY OF MONTPELIER

WATERWORKS IMPROVEMENTS

WILLOOSKI RIVER CROSSING PLAN

MONTPELIER, VERMONT

Client No. 618040

Proj. Manager T.O. WESBITT

Proj. Designer C.S. PECOR

Drawn By D.R. CHELNEY

Checked By T.O. WESBITT

Scale AS SHOWN

Approved *[Signature]*

Date MARCH 18, 1991

Sheet 100A of 19

D 618040-19A

DH
Dufresne-Henry Inc.
Precision Park
No. Springfield,
Vermont 05150

STATE OF VERMONT
Professional Engineer
[Signature]
1000

Rev.	Description	By	Date
1	MINIMUM COVER PER STREAM ALT. PERMIT	UBL	10/26/91