




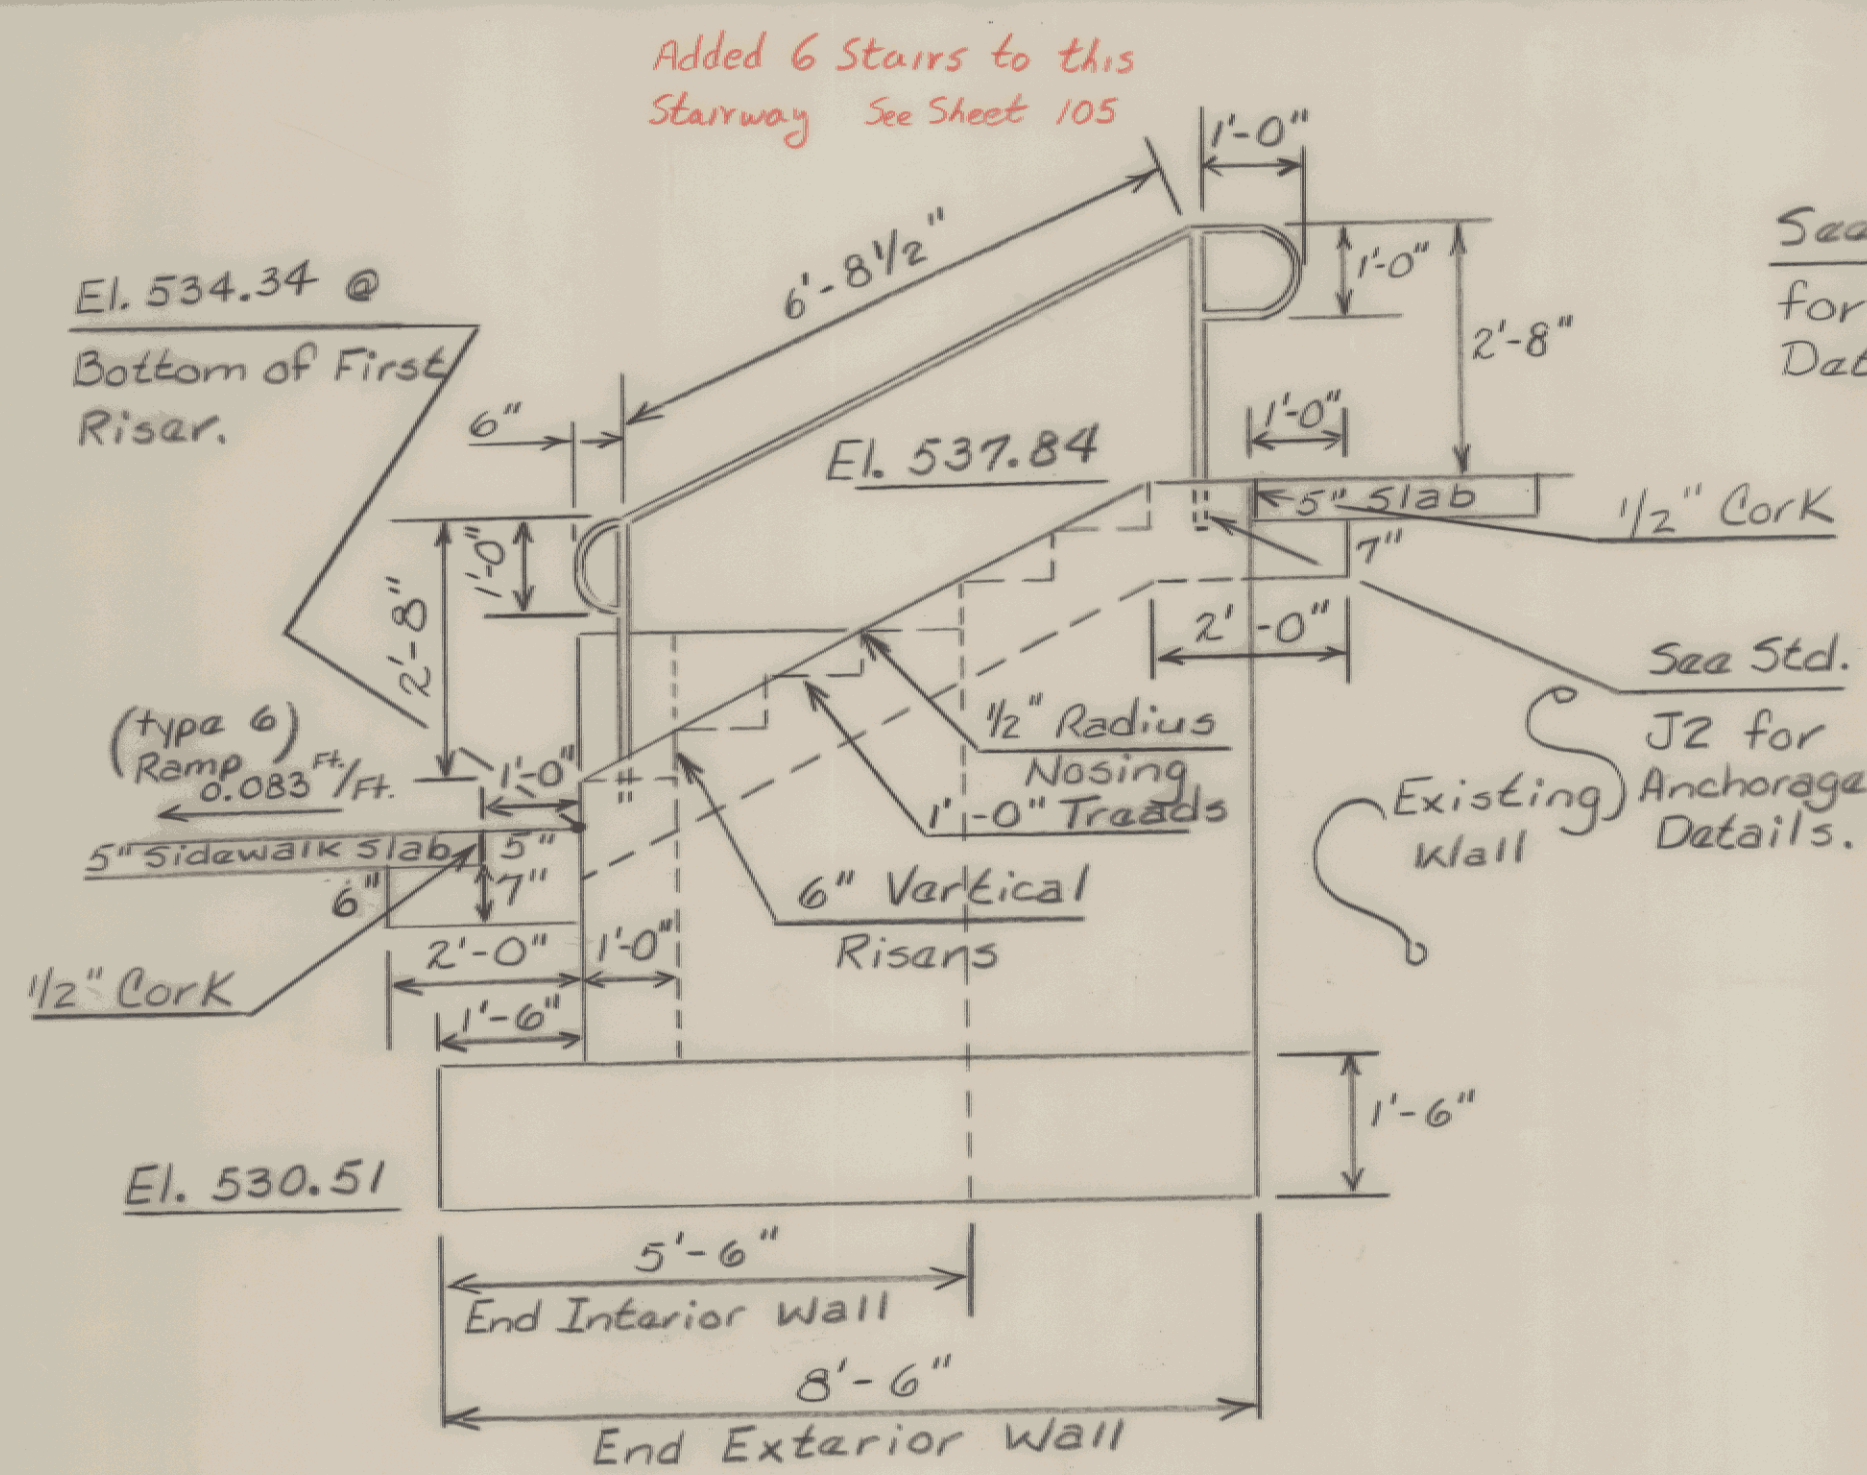


STAIRWAY AT STA. 11+47~11+53
STAIRWAY No. 1
SIDE VIEW SCALE 1" = 2'-0"

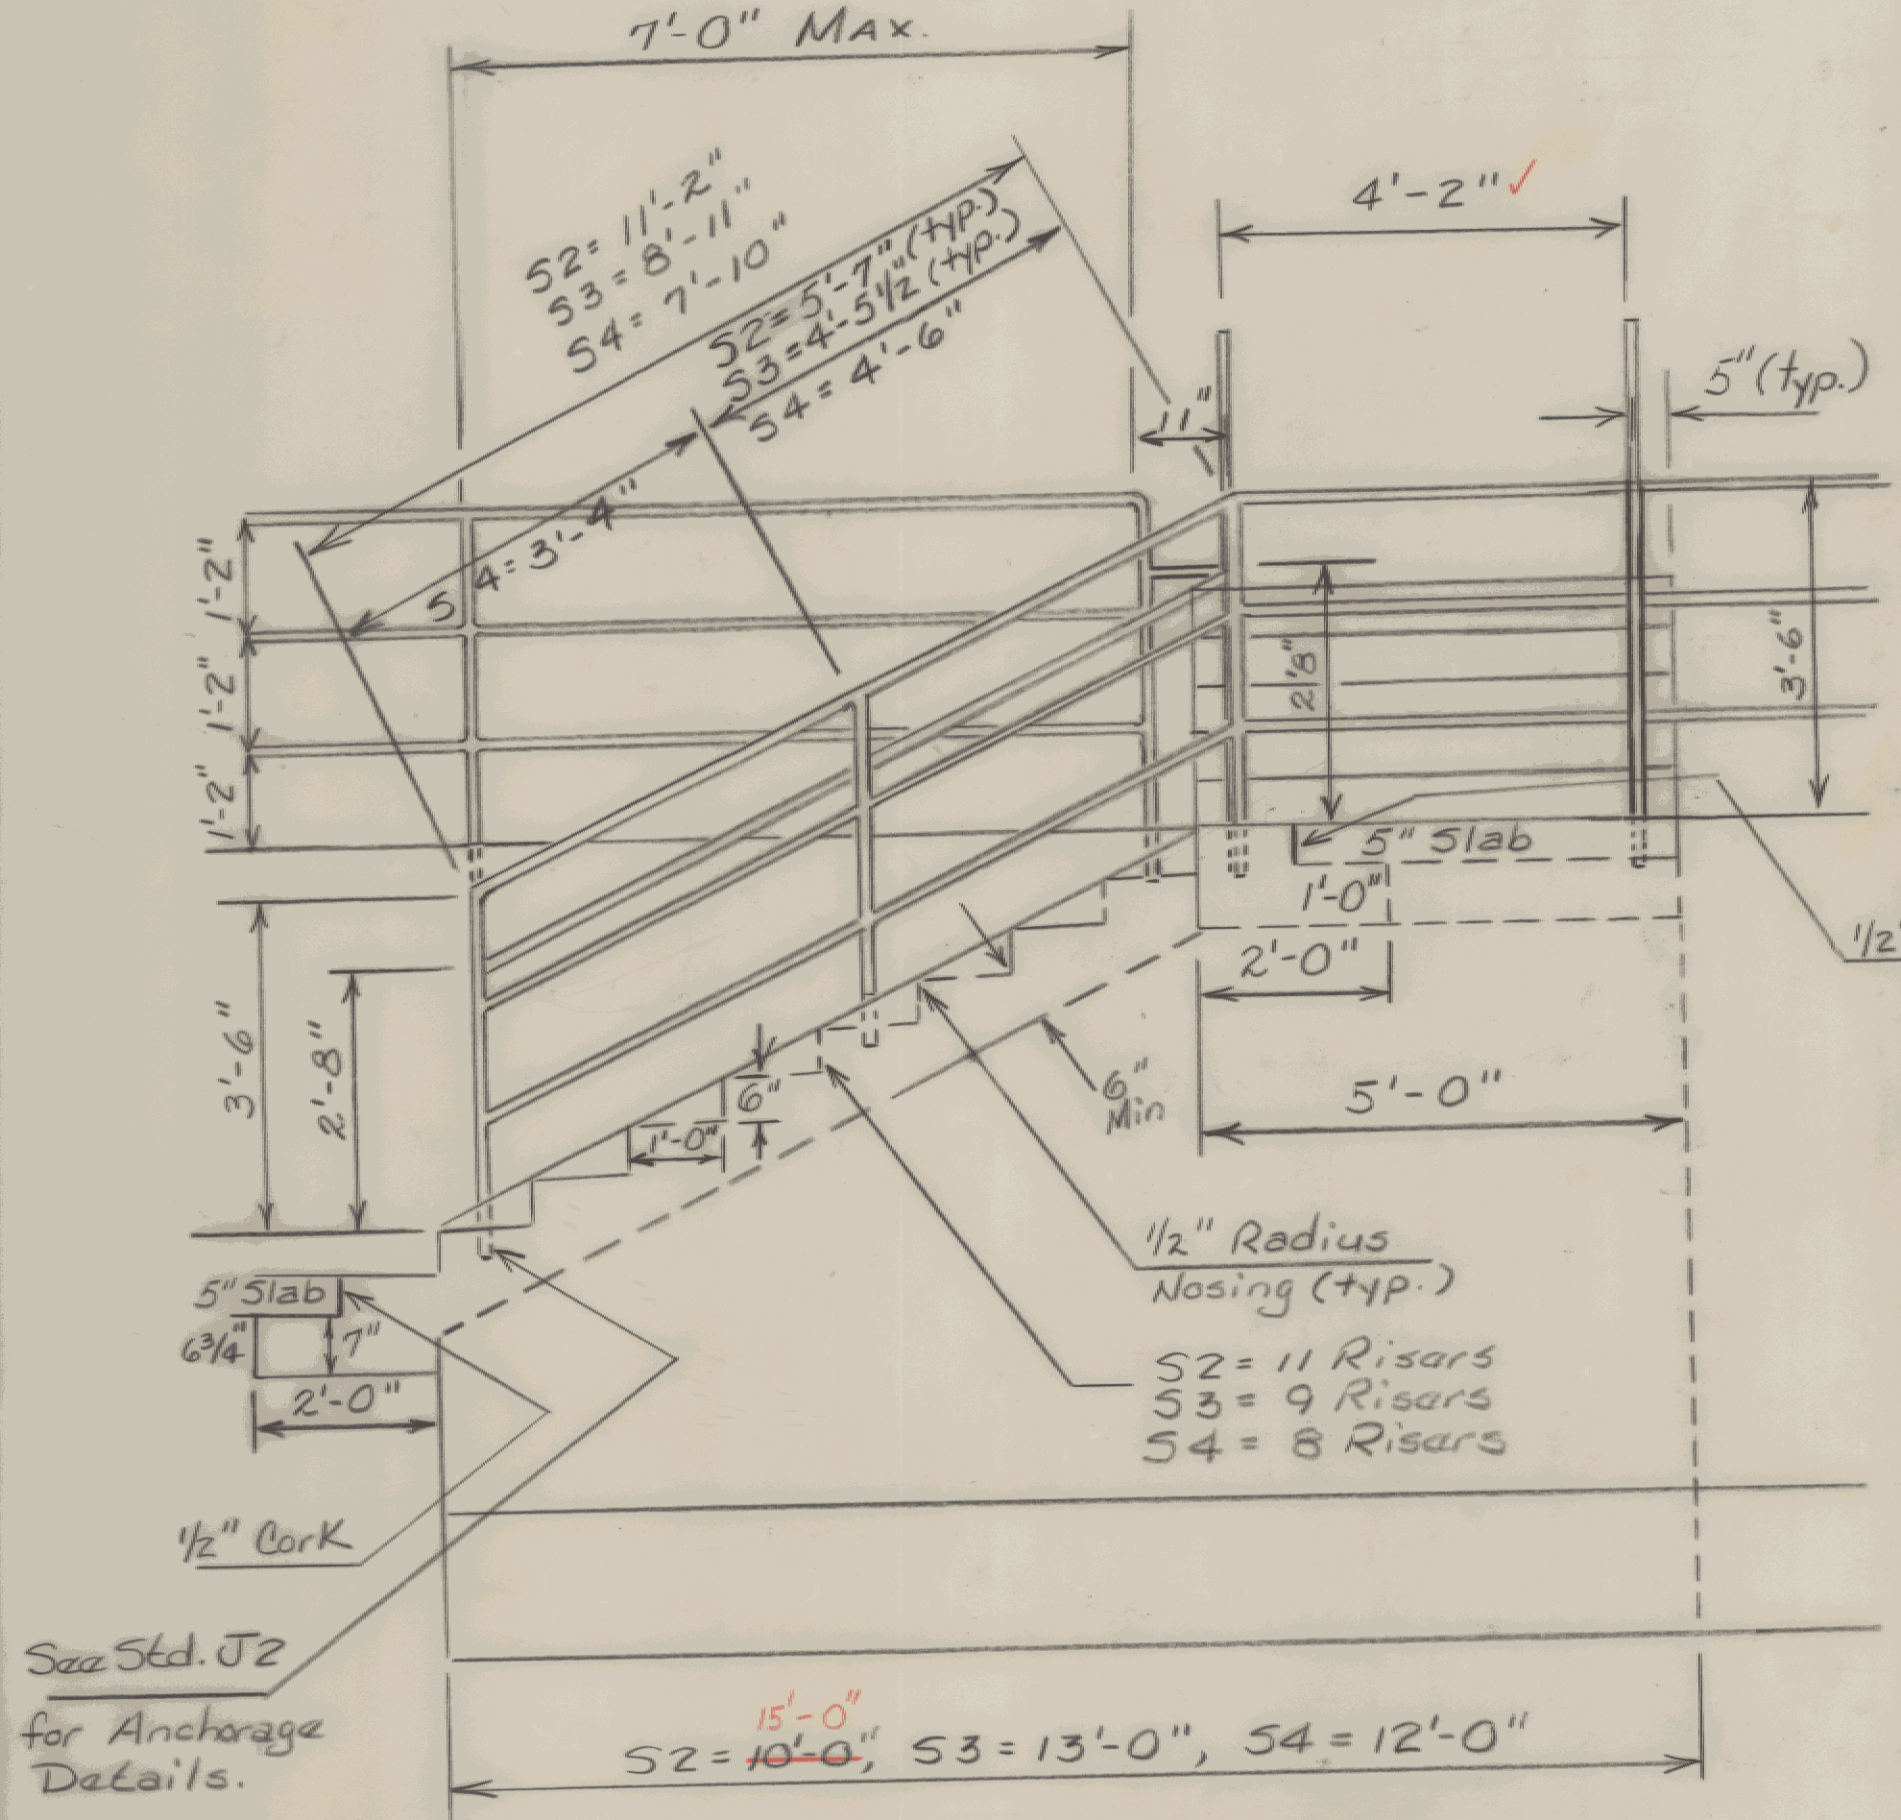

STAIRS PARALLEL TO ROADWAY
STAIRWAY NOS. 2, 3, & 4
FRONT VIEW SCALE 1" = 2'-0"

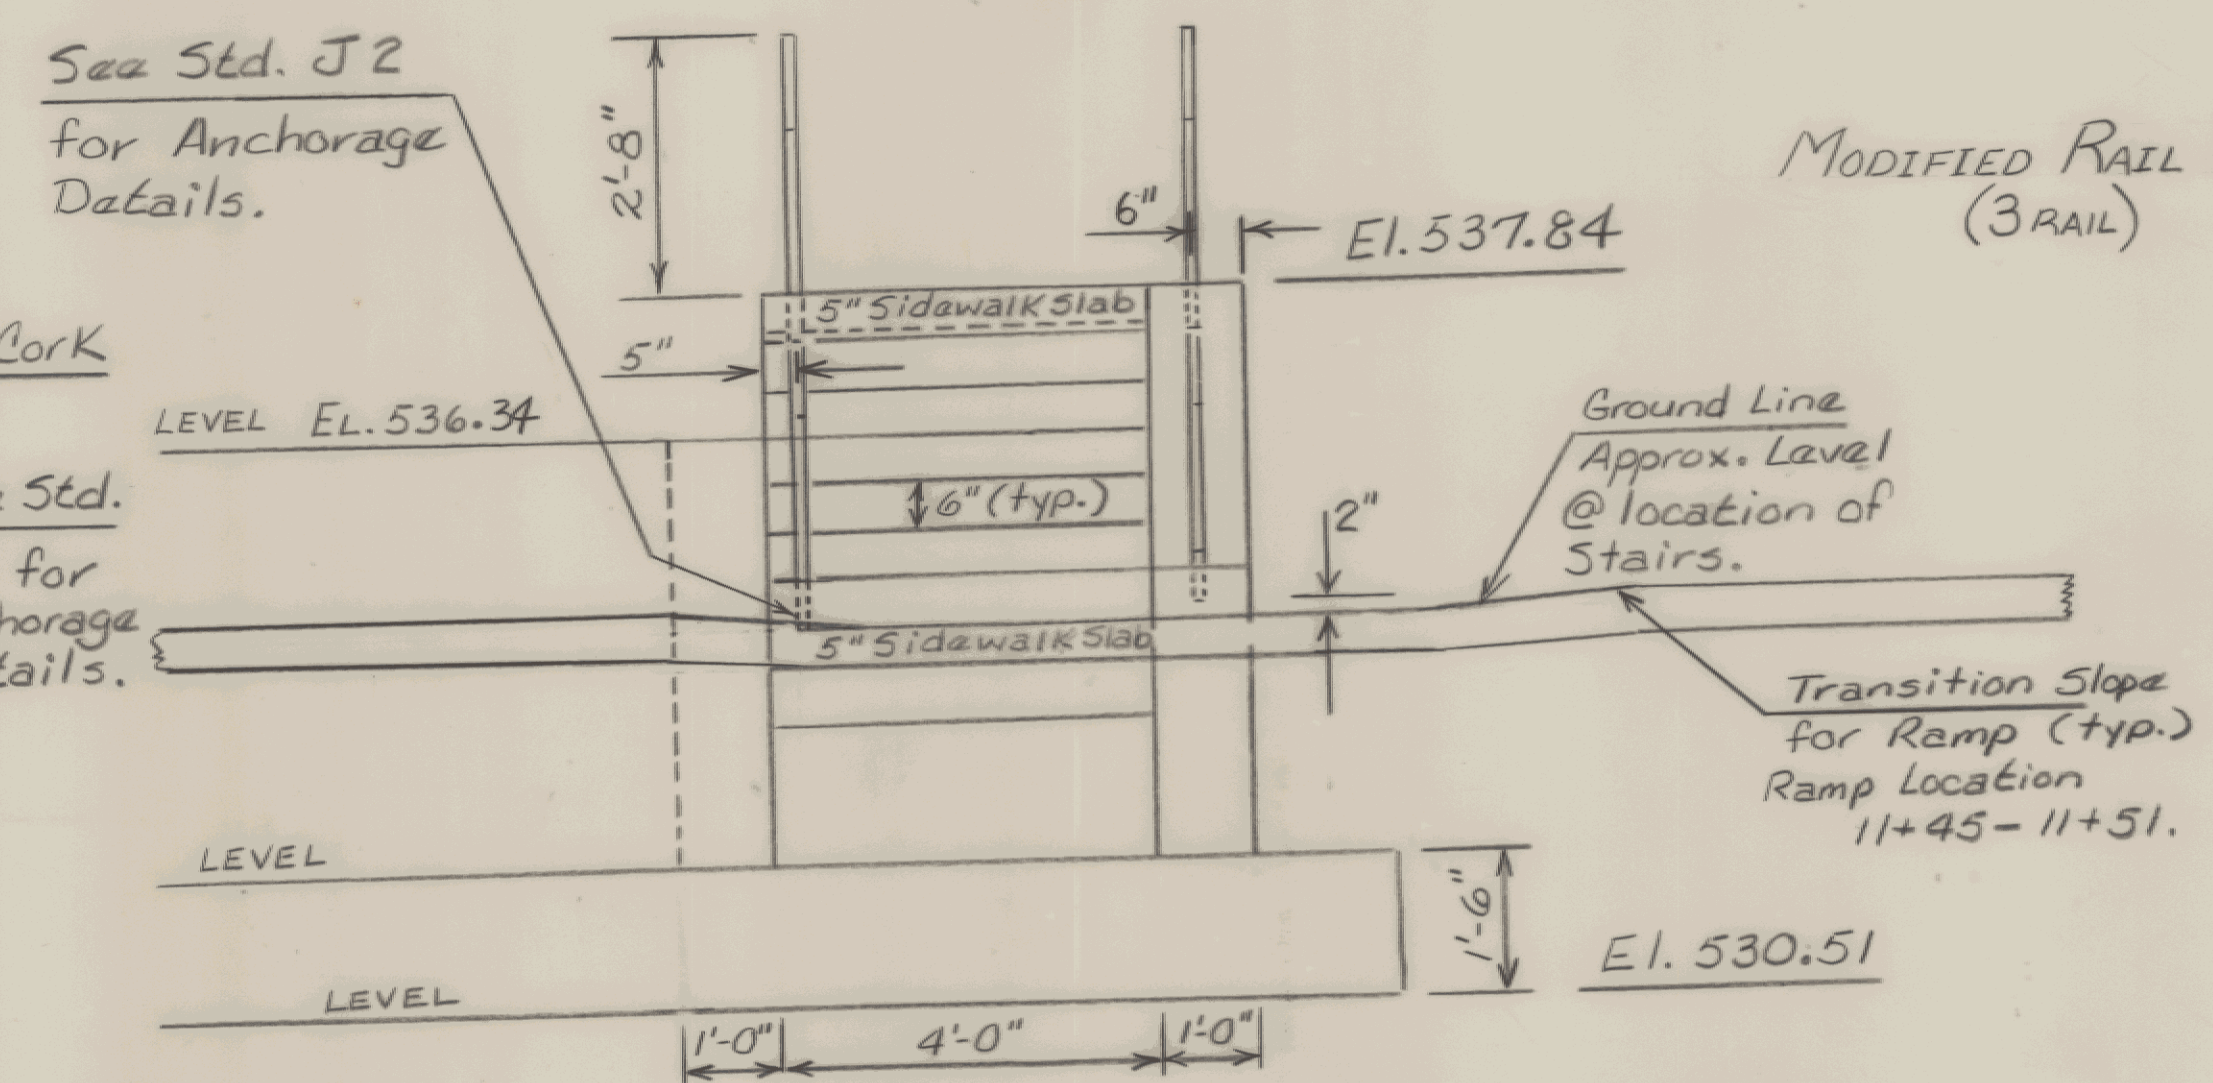


STAIRWAY AT STA. 11+47~11+53
STAIRWAY No. 1
FRONT VIEW SCALE 1" = 2'-0"

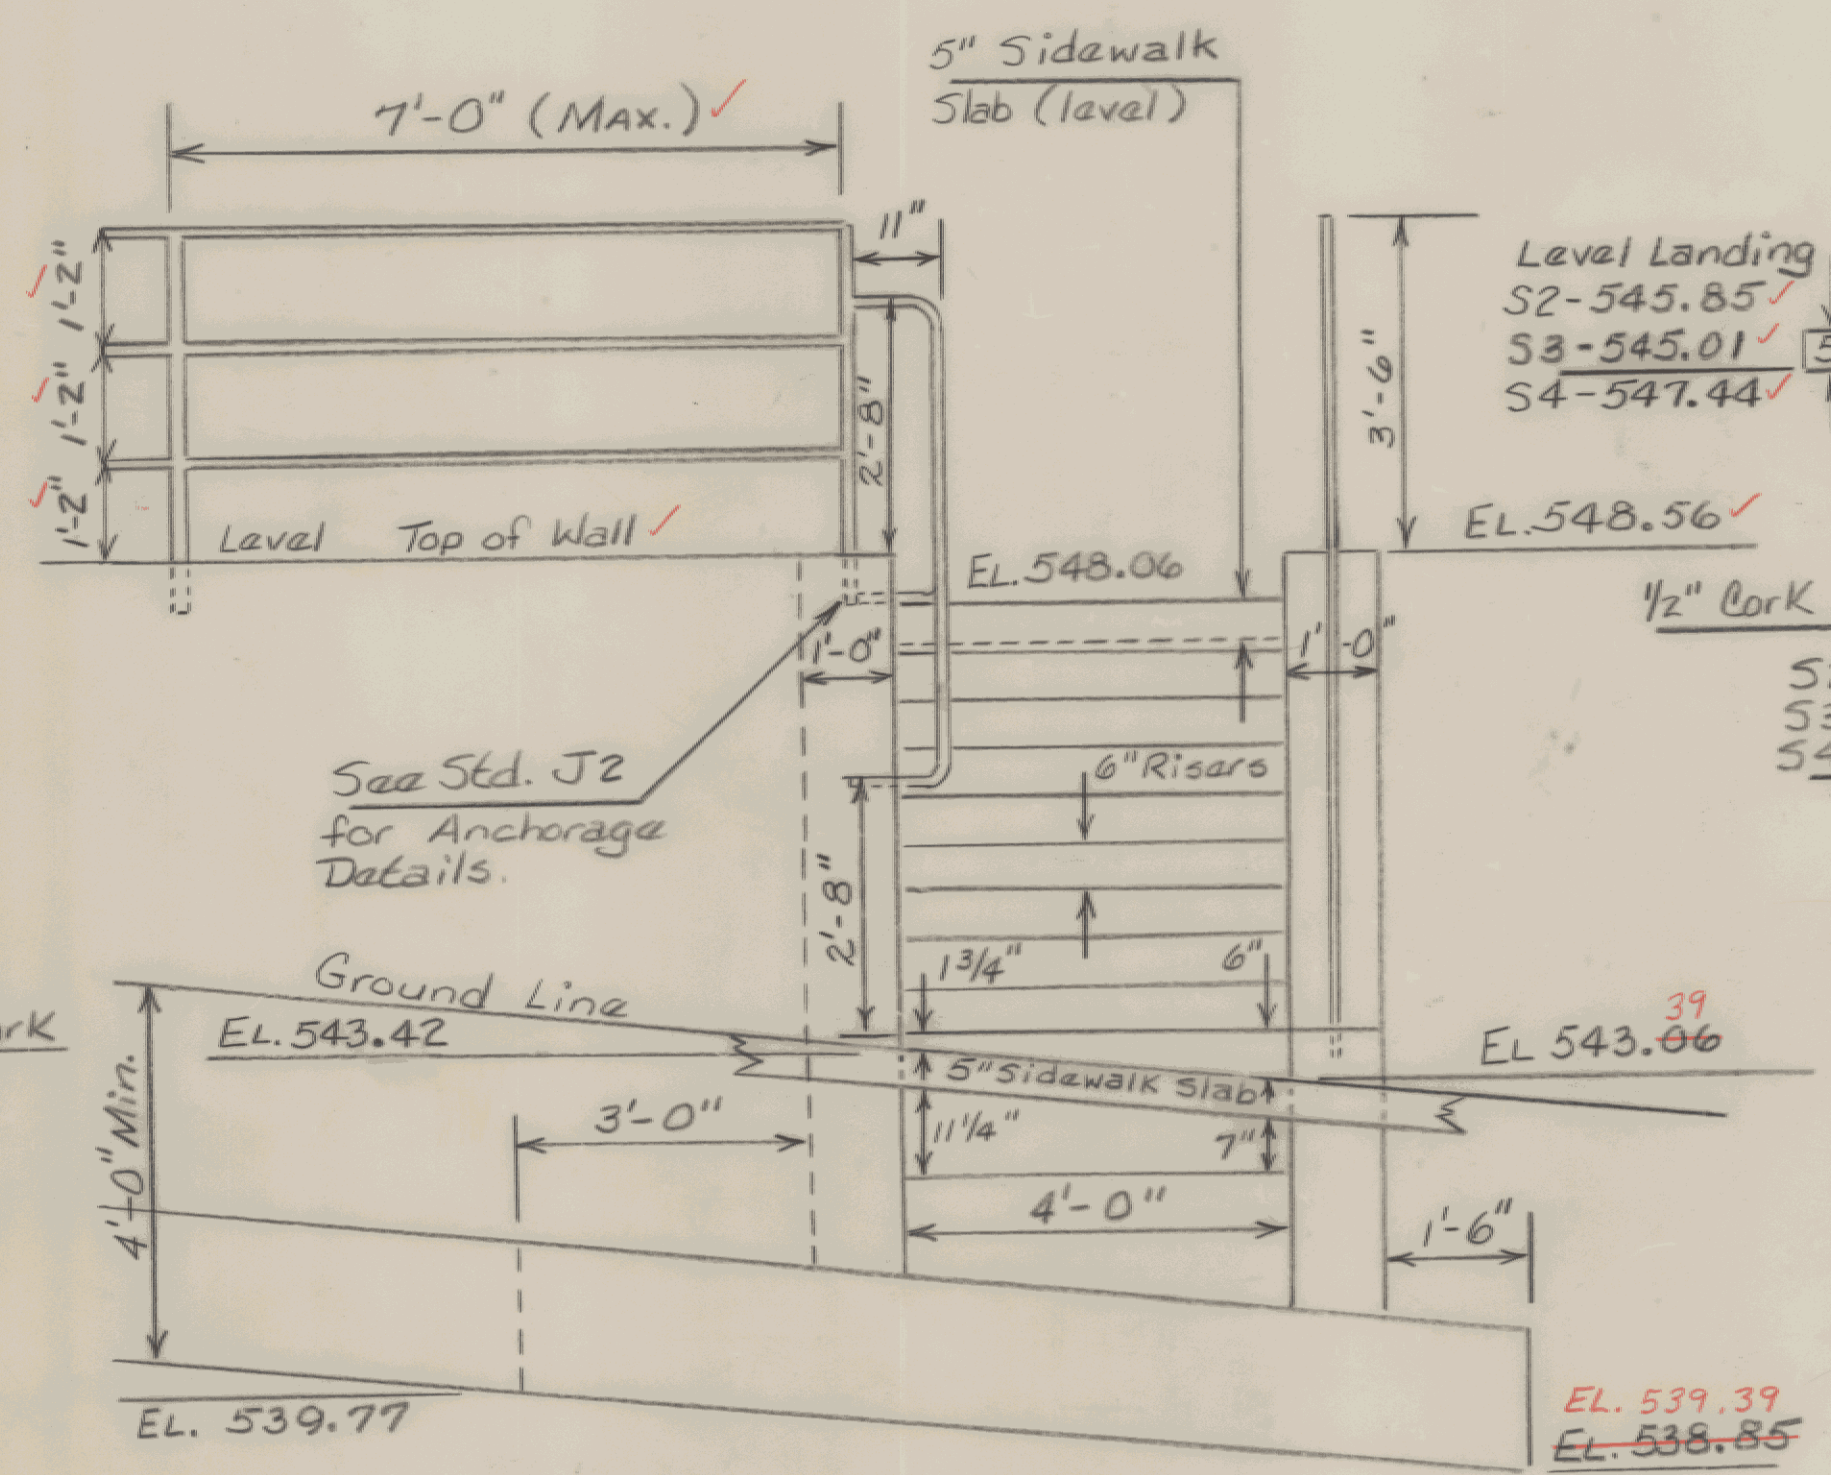


STAIRS PERPENDICULAR TO ROADWAY
STAIRWAY AT STA. 13+64~13+70
STAIRWAY No. 5
DETAILS SCALE 1" = 2'-0"

MODIFIED RAIL DETAIL
(3 RAIL)

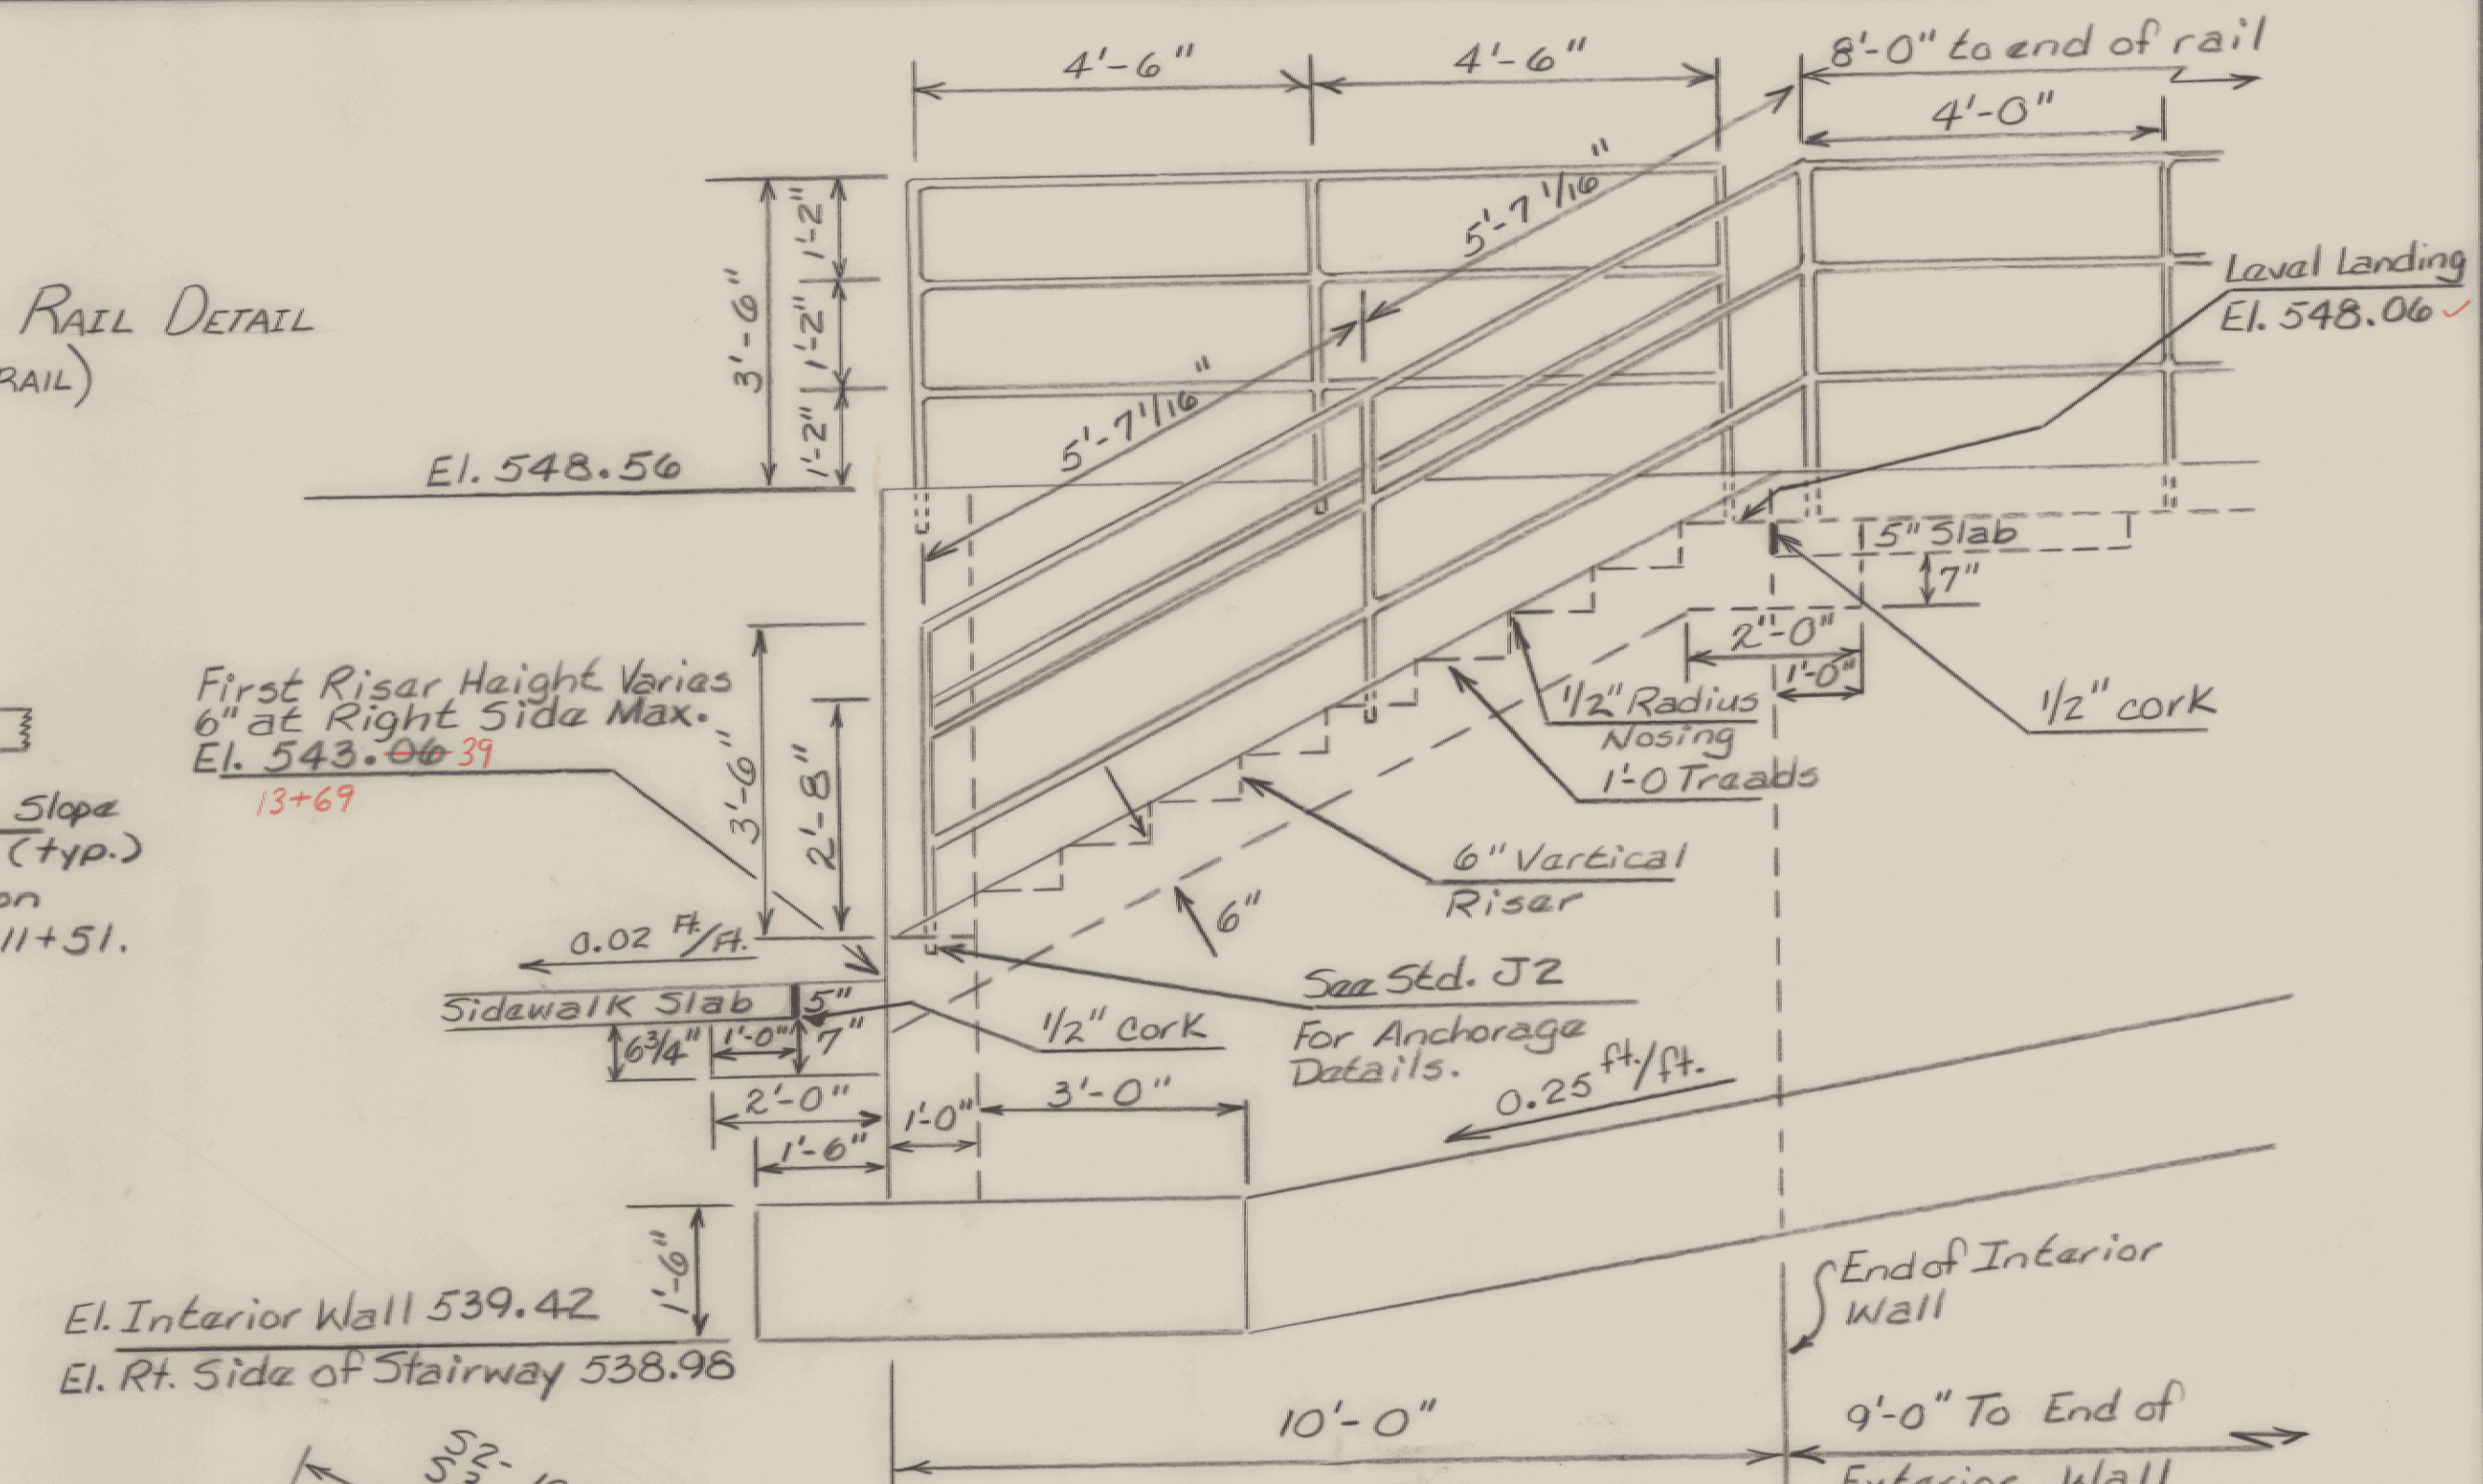

STAIRS PERPENDICULAR TO ROADWAY
STAIRWAY AT STA. 13+64~13+70
STAIRWAY No. 5
DETAILS SIDE VIEW SCALE 1" = 2'-0"

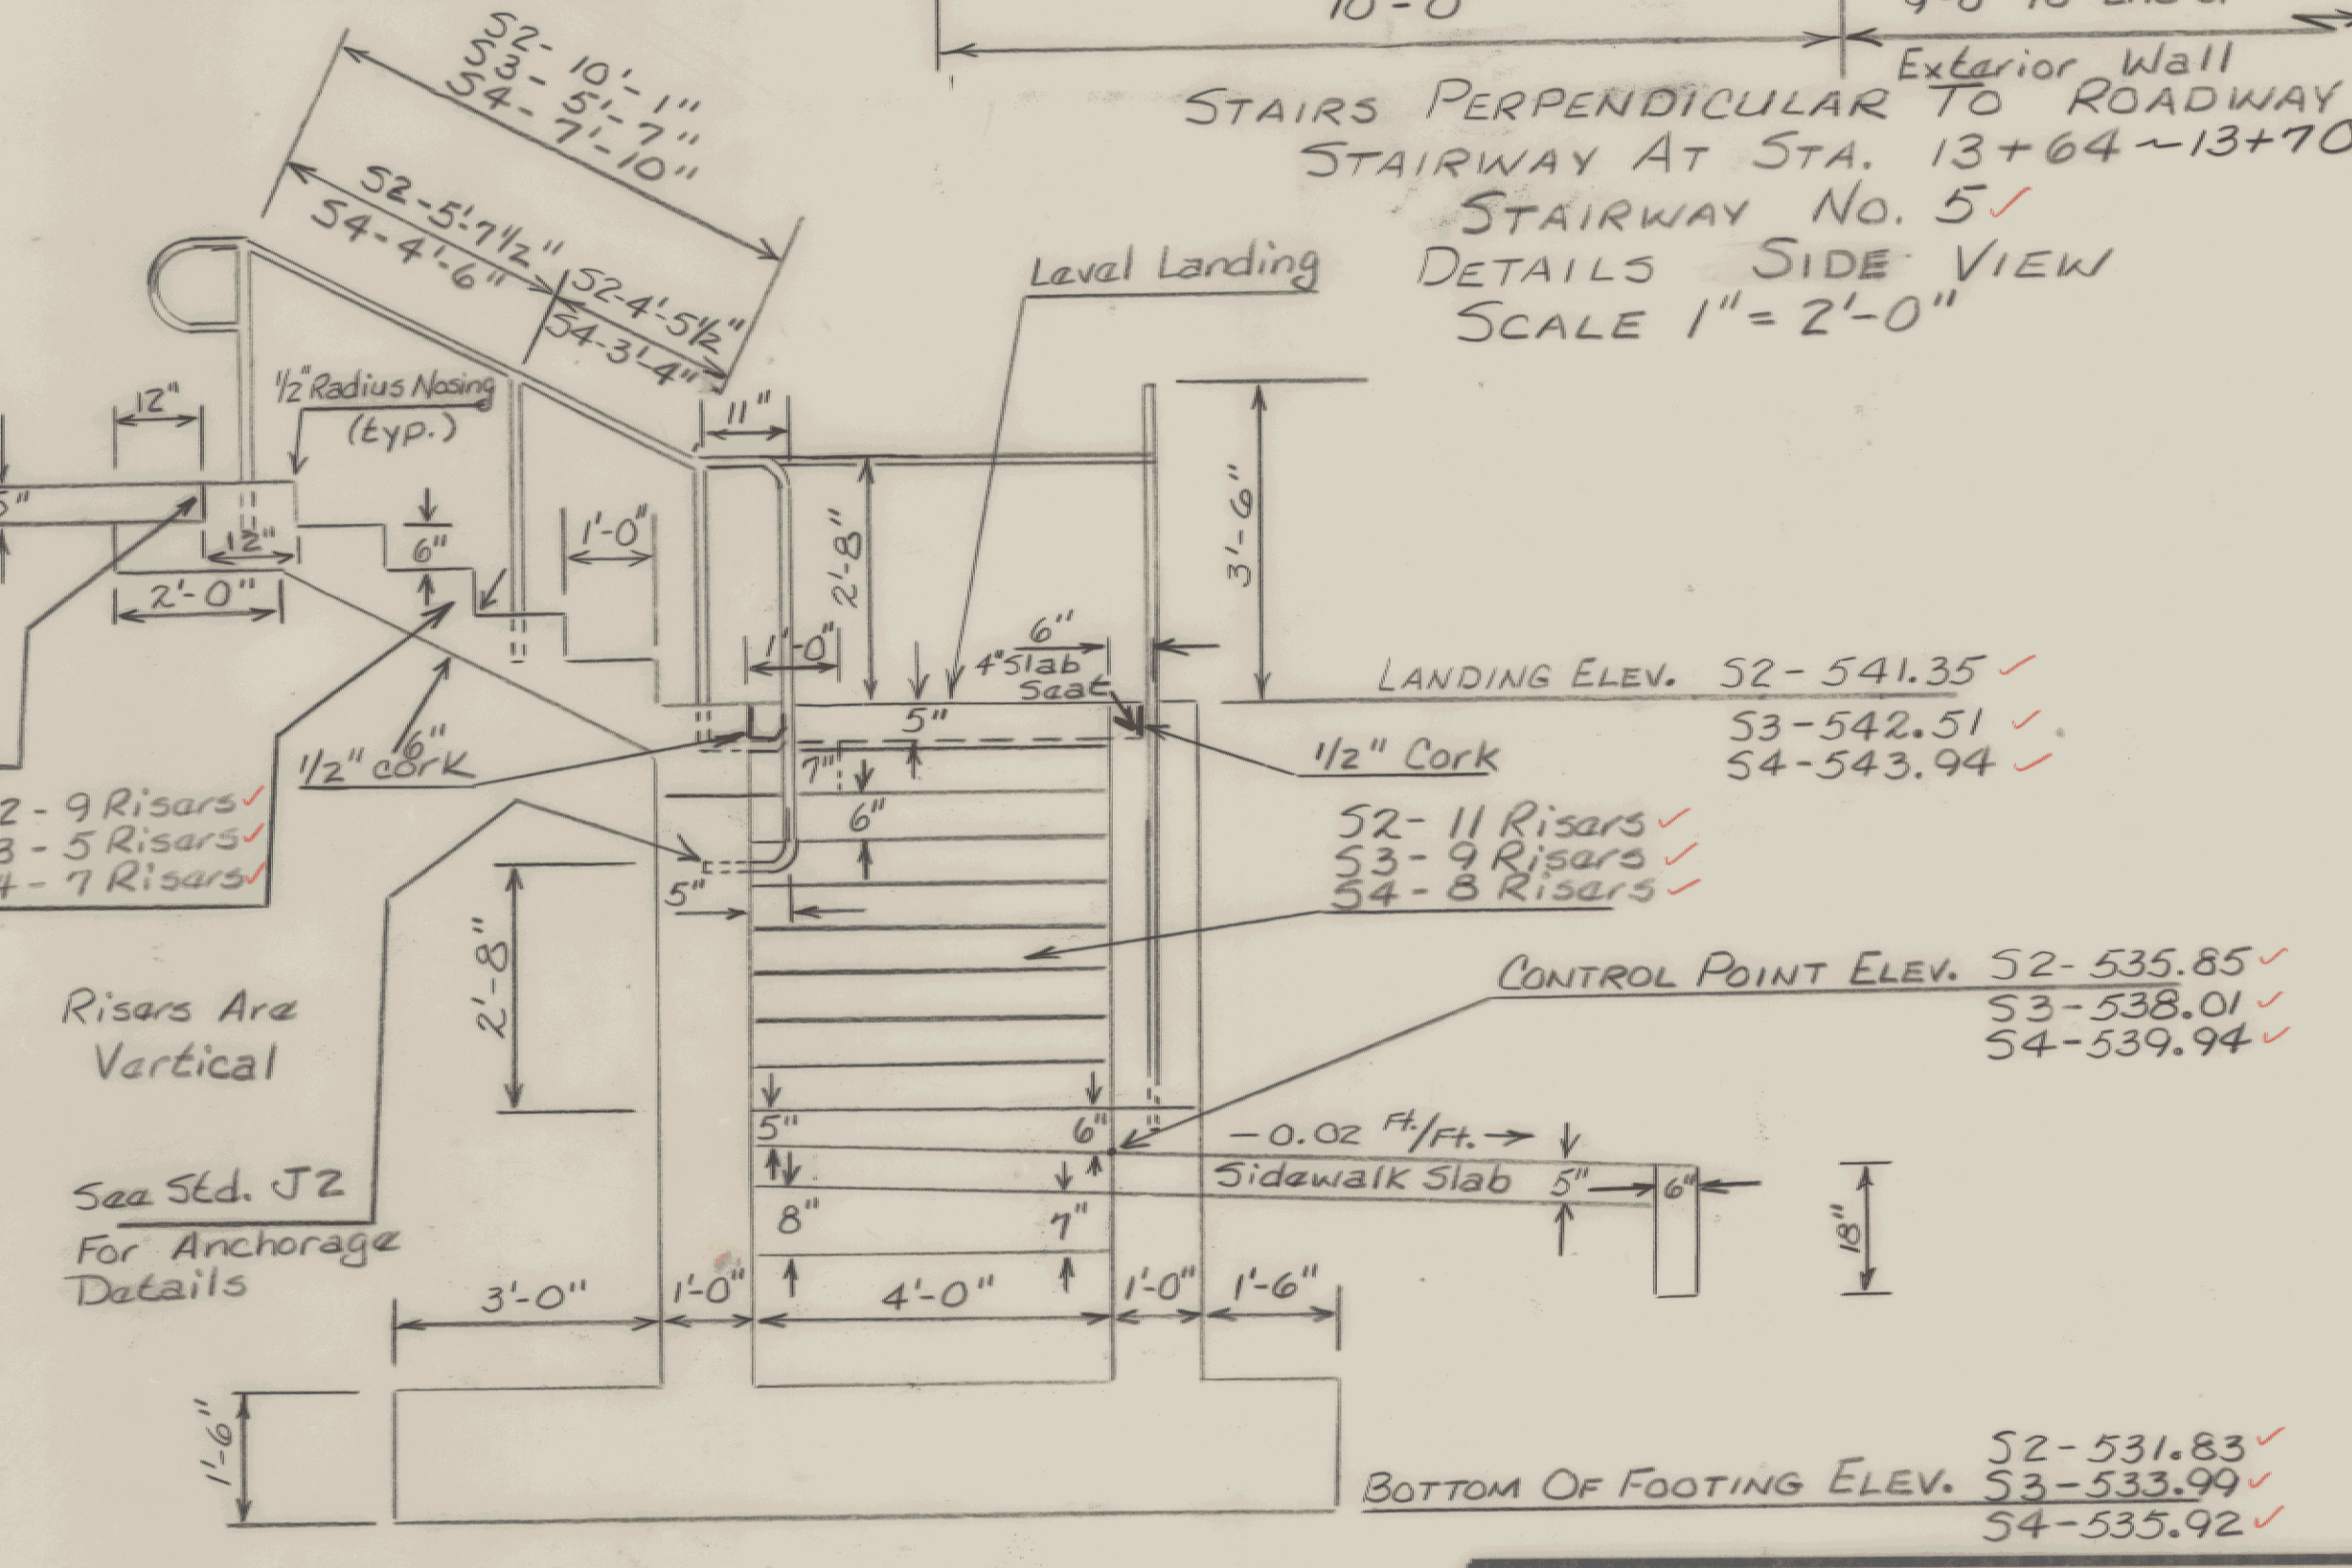

STAIRS PARALLEL TO ROADWAY
STAIRWAY NOS. 2, 3 & 4
SIDE VIEW SCALE 1" = 2'-0"

STATE OF VERMONT	
AGENCY OF TRANSPORTATION	
Town Of MONTPELIER	Bridge No. 108
Highway No. BERLIN ST.	Log Sta. 13+64
STAIRWAYS 1~5 DETAILS.	
Designed By P. PROVOST	Drawn By rmw
Checked By R.E. Provost	Bridge Design Supervisor R.P. Gendron
PROJECT MONTPELIER-BERLIN	PROJECT NO. MEGC M6400(1)
Bridge Sheet No. 6 OF 10 Sheet 108 of 335	