



14+28 AT ~ 14+50 AT
REMOVE EXISTING D.I.
NEW 12" x 20" CSP, .064 OR CAAP .060
CONNECT 6" CGMP INLET TO NEW D.I.
PLUG EXISTING 6" OUTLET

14+28 ~ 14+31 Rt.
Exist. DI - Adjust Elev.
New CI Cover w/ Frame Non-Gov't. Part.

540.12

NET (4'-4")

CATV (4', 3")

E 8"W


E 8"H

TOP OF T86 T/C

FOR COMP. 10

541.5

14+27.50

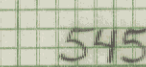

14+23 R+
CONSTRUCT DRIVE
12' WIDE PAVED



14+12 Rt
End Vertical Granite Curb

FROM STA. 14+18 TO STA. 14+31
PROJECT NAME MONTPELIER MAIN
NO. ~~11~~ ⁶⁴ M6400(7) PLOTTED 08/07/85
SURVEYED BY KASTNER-MOREAU JUNE 1985
SHEET 152 OF 335 SHEETS

SCALE 1" = 5 FEET