


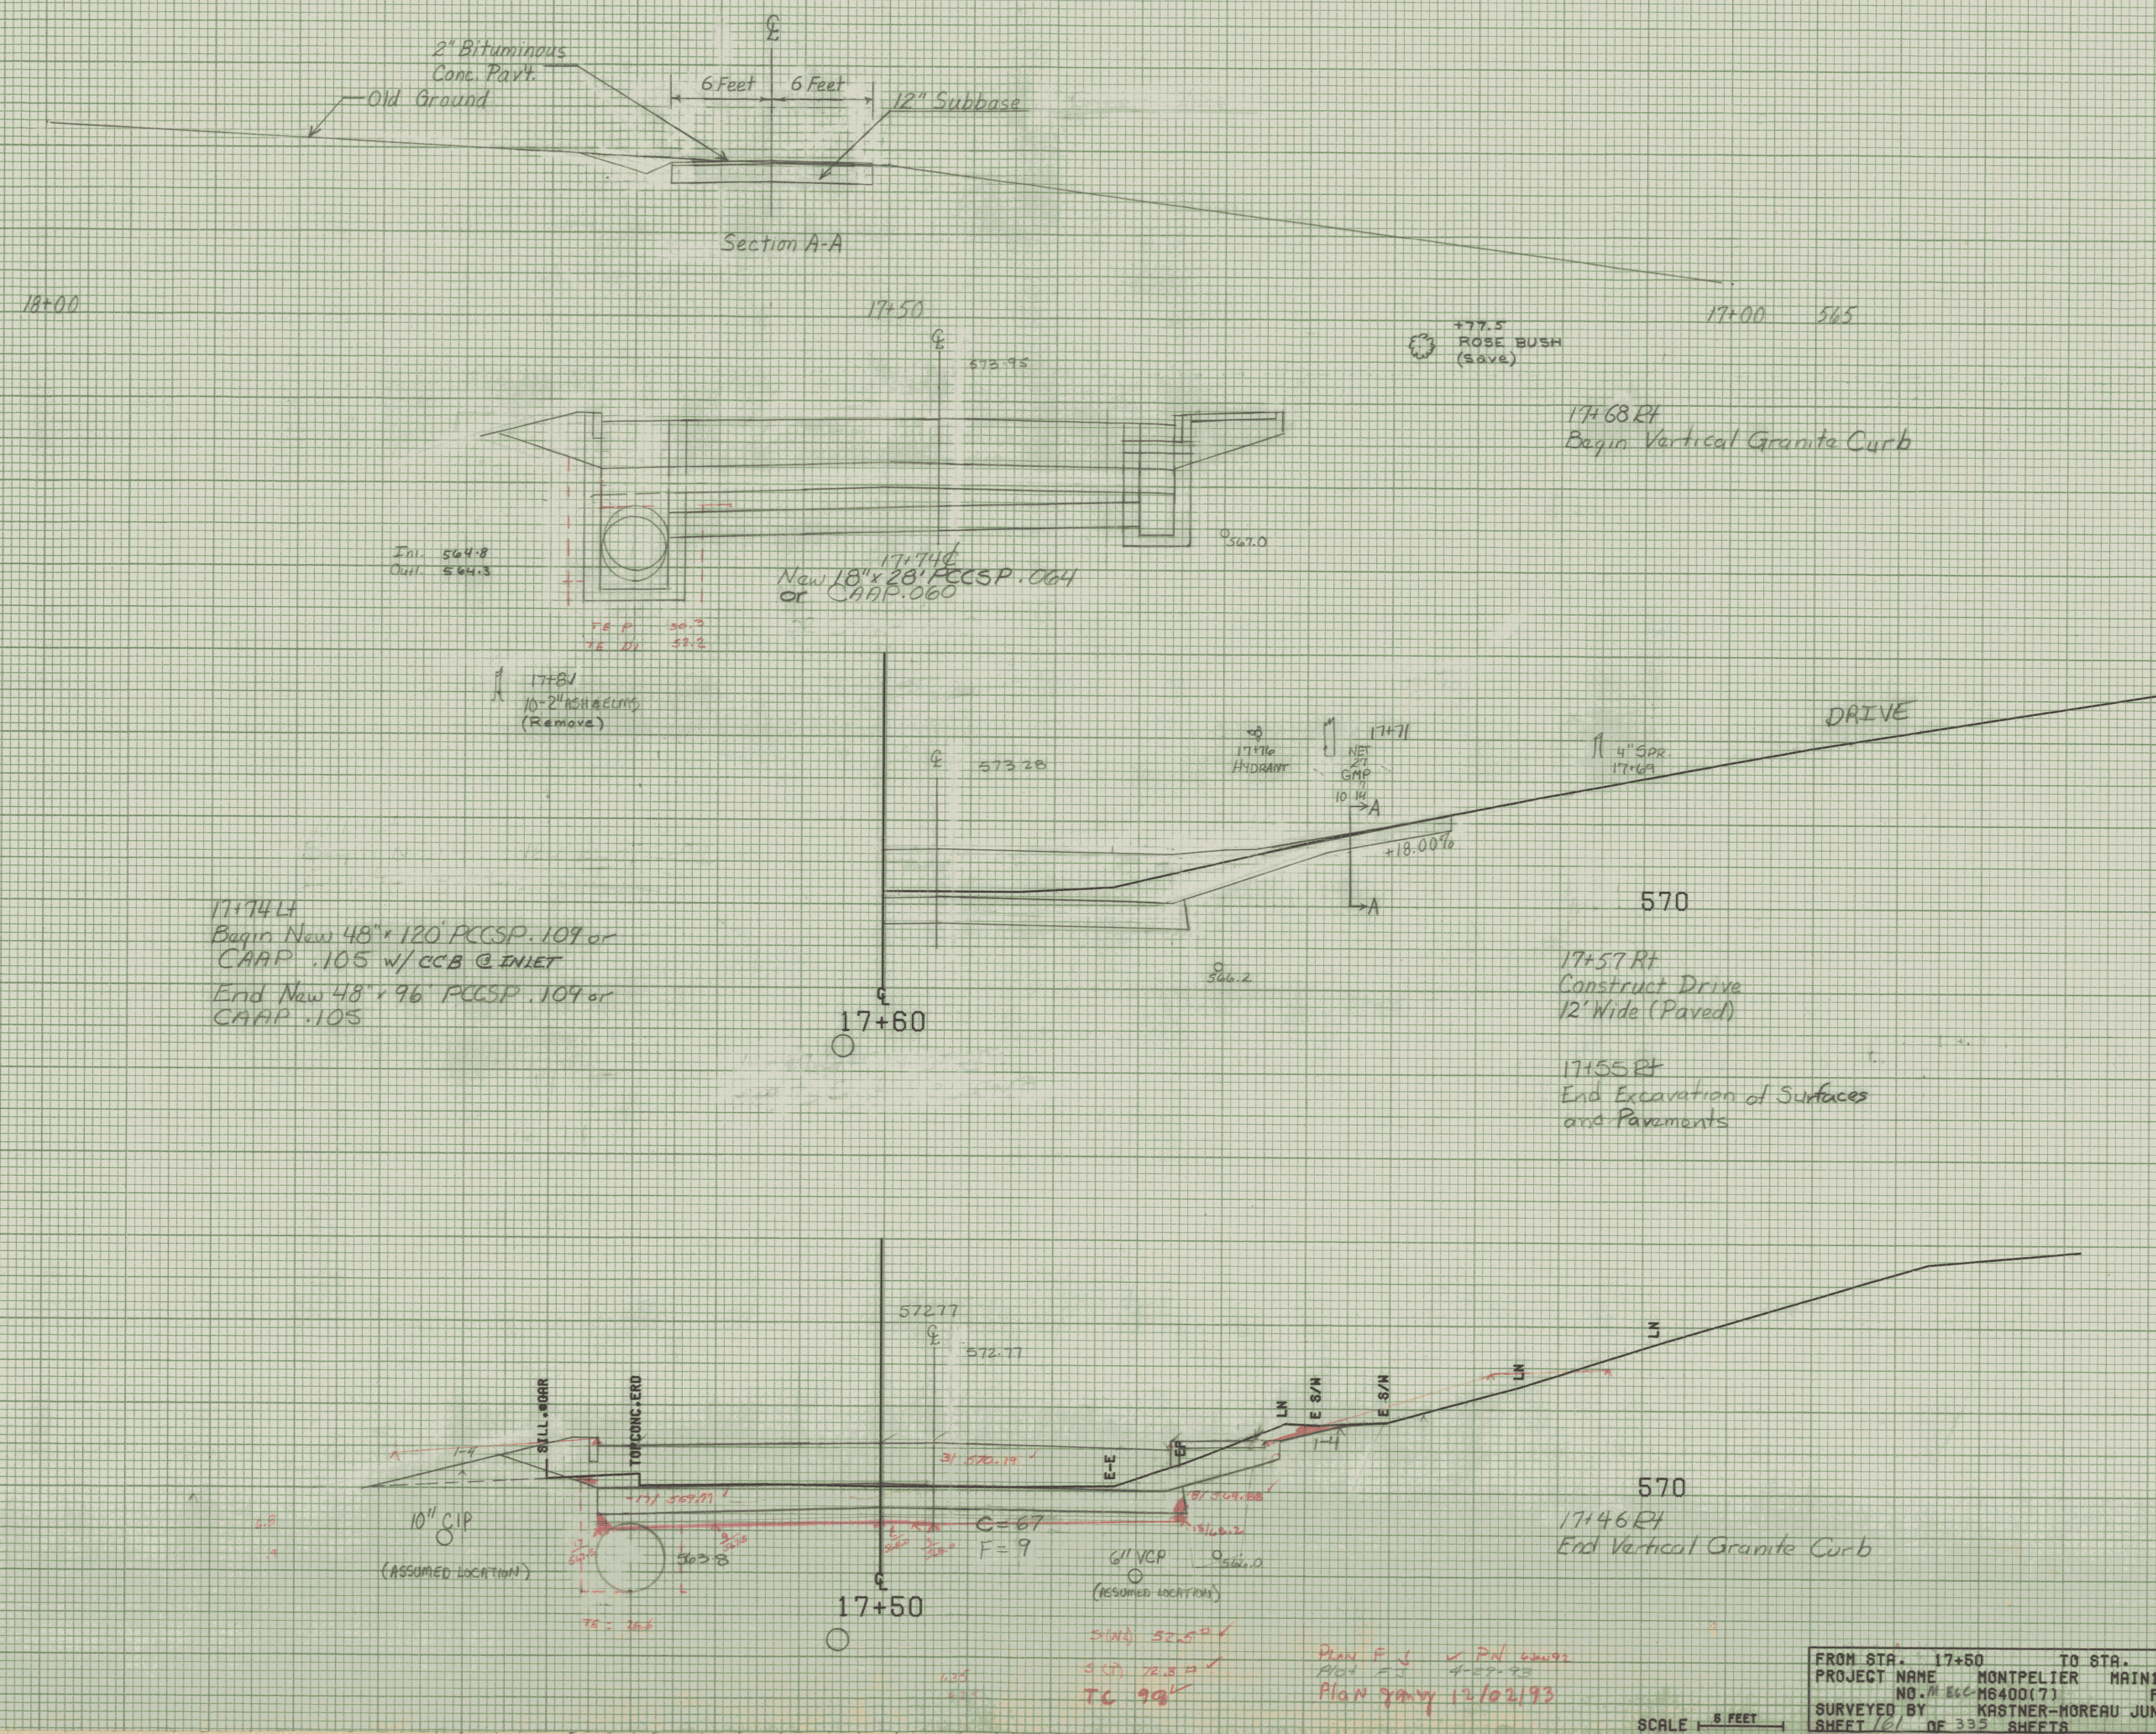

FROM STA. 17+50 TO STA. 17+60
PROJECT NAME MONTPELIER MAIN
NO. *M E C C* M6400(7) PLOTTED 06/07/85
SURVEYED BY KASTNER-MOREAU JUNE 1985
SHEET *161* OF 335 SHEETS