


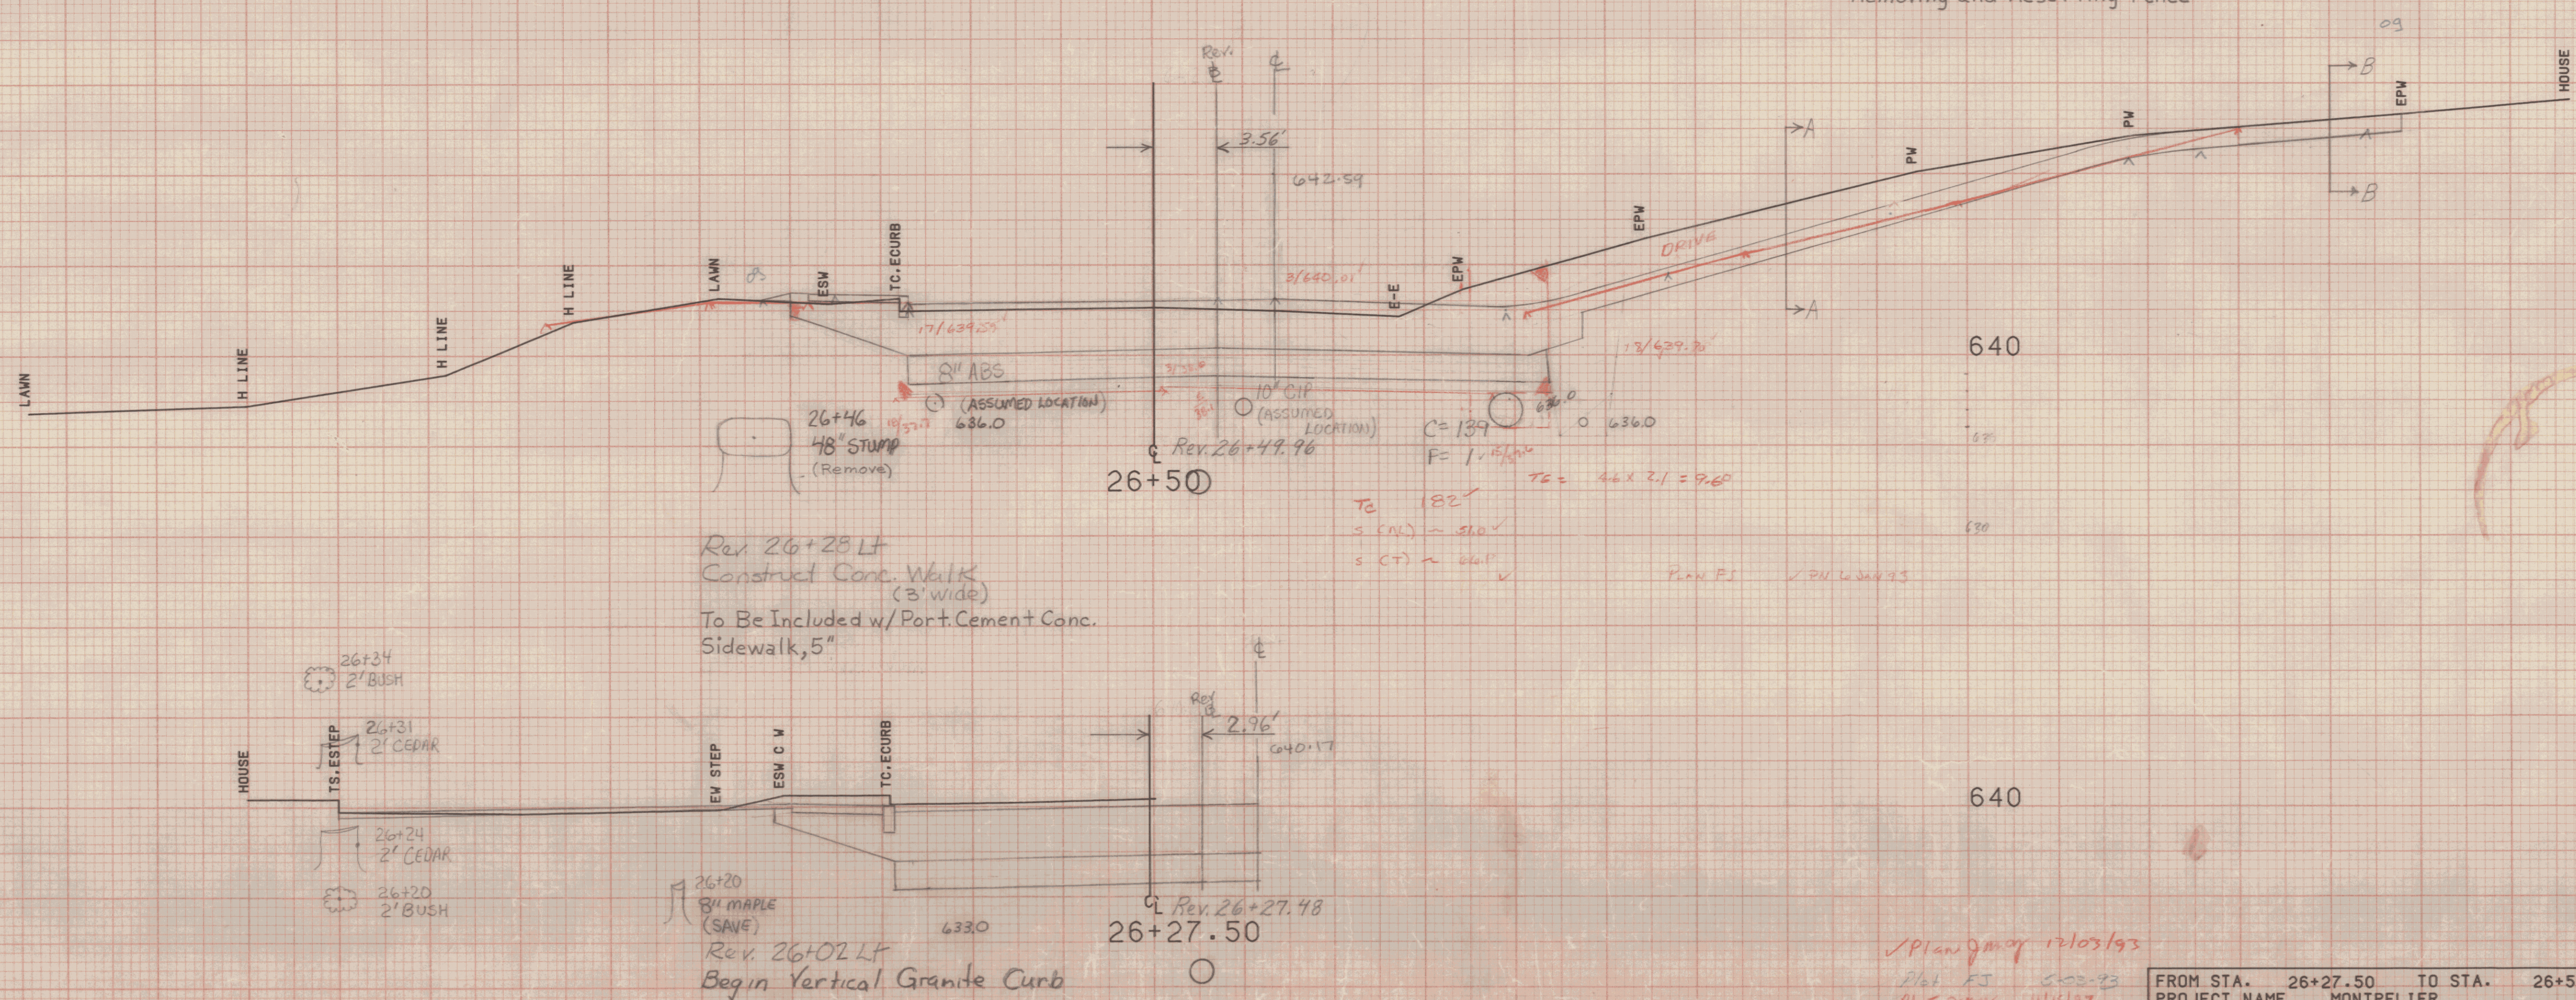

Rev. 26+60 Rt
Construct Drive 16' Wide (Paved)
Removing and Resetting Fence

Rev. 26+28 Lt
Construct Conc. Walk
(3' wide)
To Be Included w/ Port. Cement Conc.
Sidewalk, 5"

Rev. 26+02 LT
Begin Vertical Granite Curb

✓ Plan gmy 12/03/93
Plot FJ 6-03-93
✓ Plot gmy 11/15/93

FROM STA. 26+27.50 TO STA. 26+54
PROJECT NAME MONTPELIER
NO. *M 666* M6400 (7) PLOTTED 05/04/87
SURVEYED BY KASTNER-MOREAU 06/85
SHEET *179* OF 335 SHEETS