


27+55.5
6" PINE

27+56
6" PINE

27+56.5
6" PINE


IRON PIPE
27+60
27+57.5
6" MAPLE
(Save)

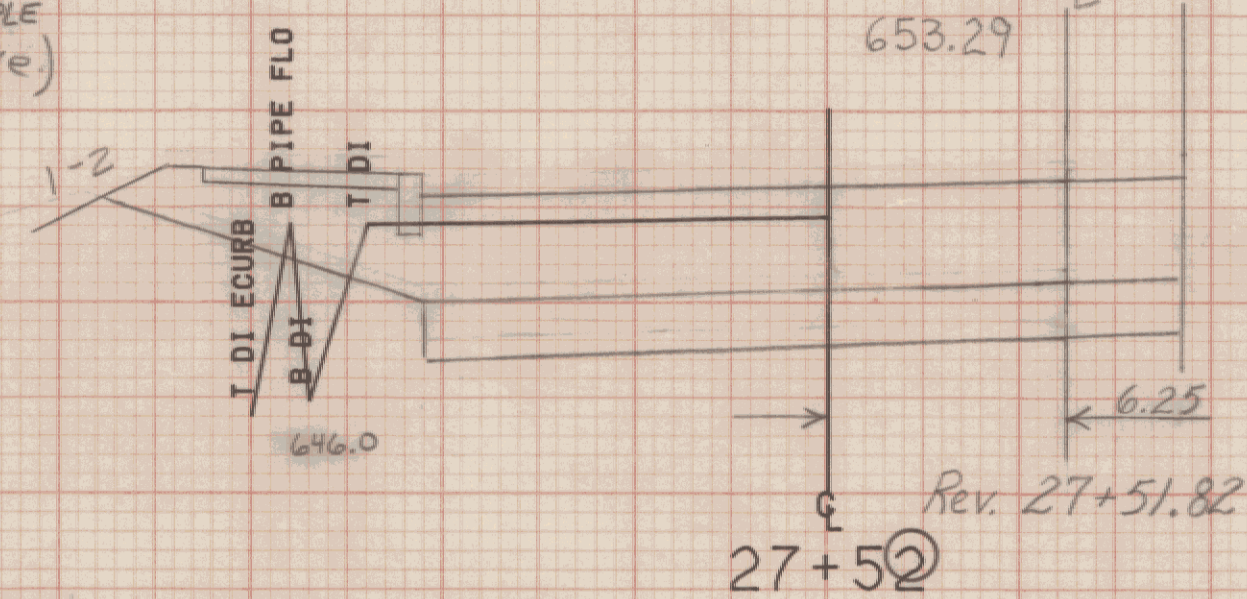

Rev 27+52 LT
Adjust Elev. of DI
New C.I. Cover w/frame
Non-Gov't. Part.


Rev 27+60 ~ 27+84 RT
Remove Existing 18" RCP Drive Culvert

650

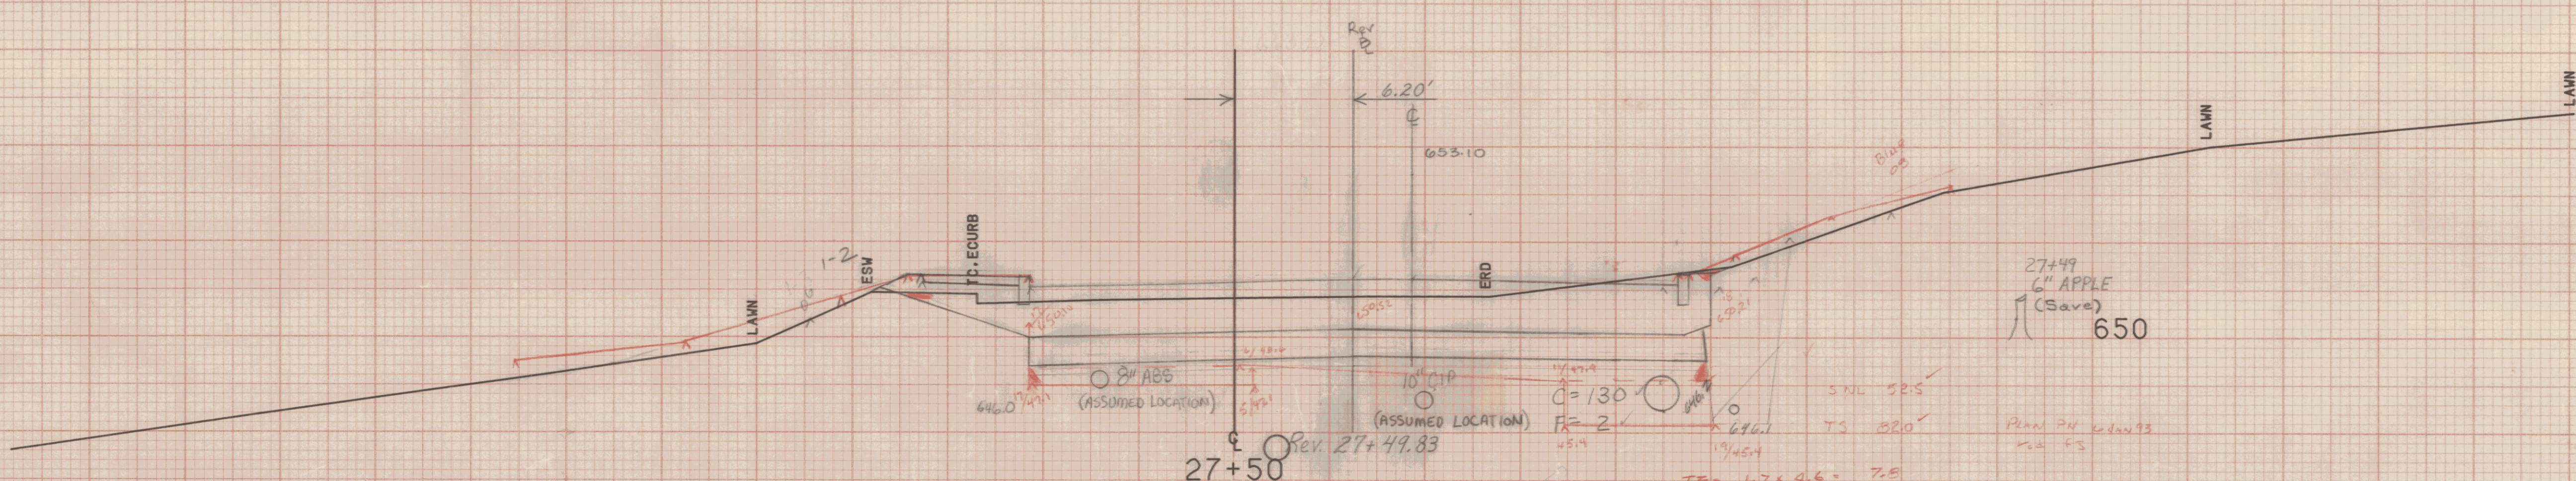

27+49
6" APPLE
(Save)
650

Rev. RT. 27+41.53
Dc. 2°00' RT
N.C.

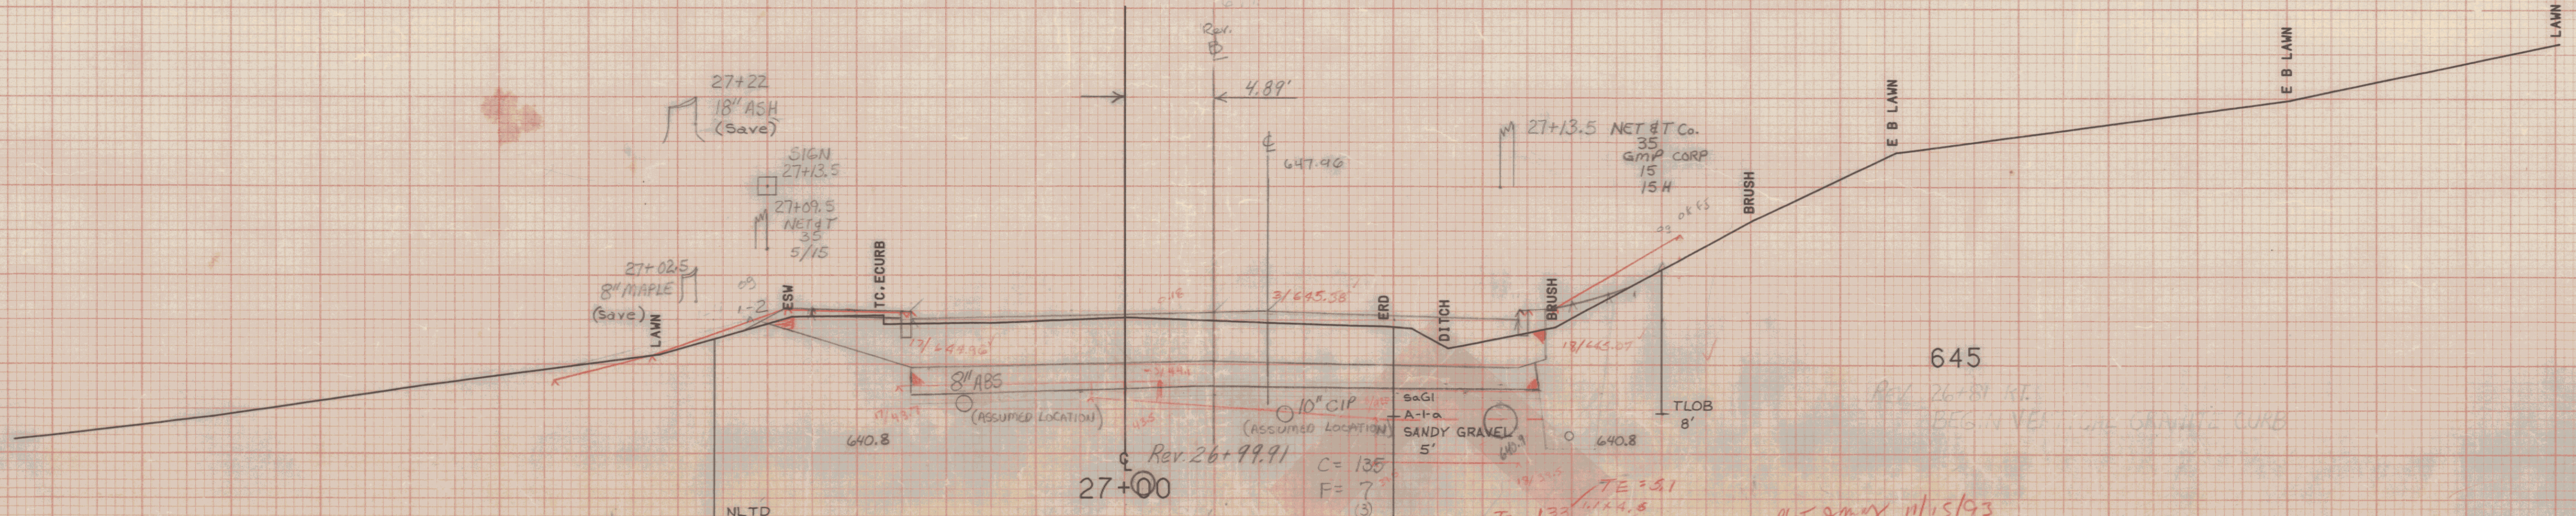

27+22
18" ASH
(Save)

SIGN
27+13.5
27+09.5
NET & T
35
5/15

27+02.5
8" MAPLE
(Save)

27+13.5 NET & T Co.
35
GMP CORP
15
15H

645

FROM STA.	27+00	TO STA.	27+52
PROJECT NAME	MONTPELIER		
NO. M&C	M6400 (7)	PLOTTED	05/04/87
SURVEYED BY	KASTNER-MOREAU 06/85		
SHEET	120	OF 335	SHEETS