


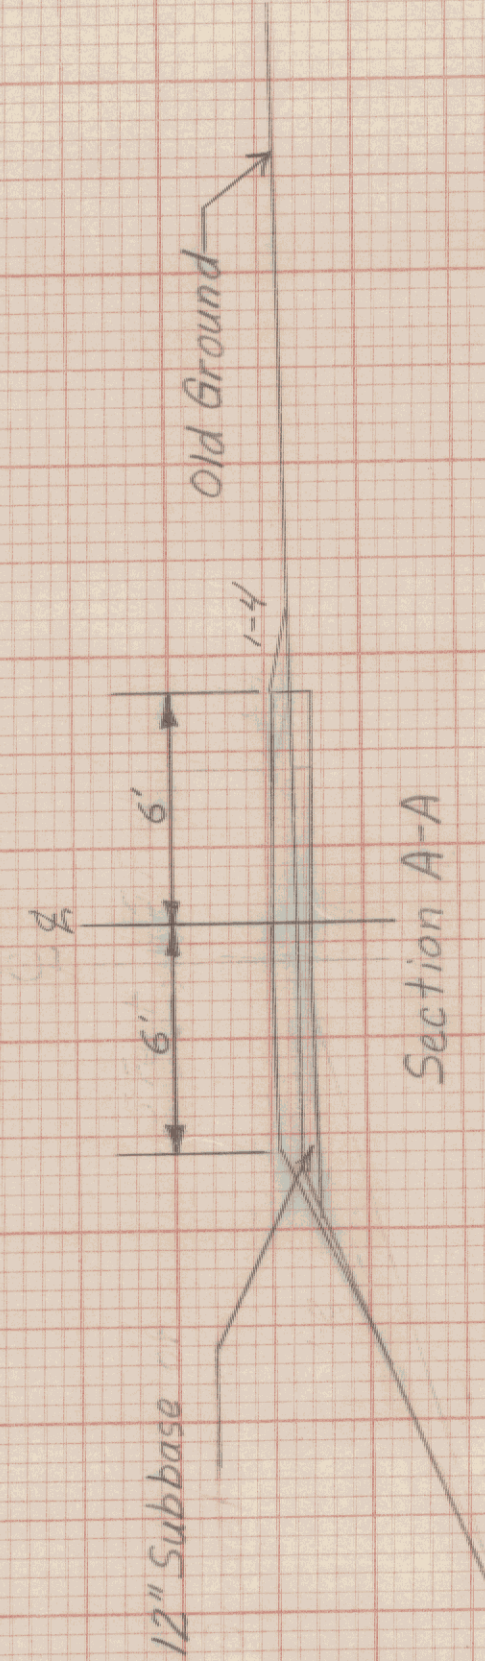


Rev. 28+78 Lt
Begin Vertical Granite Curb

28+78.5
4-2" Ced.

Rev. 28+67 Lt
Construct Drive
12' Wide (Gravel)

Rev. 28+56 Lt
End Vertical Granite Curb

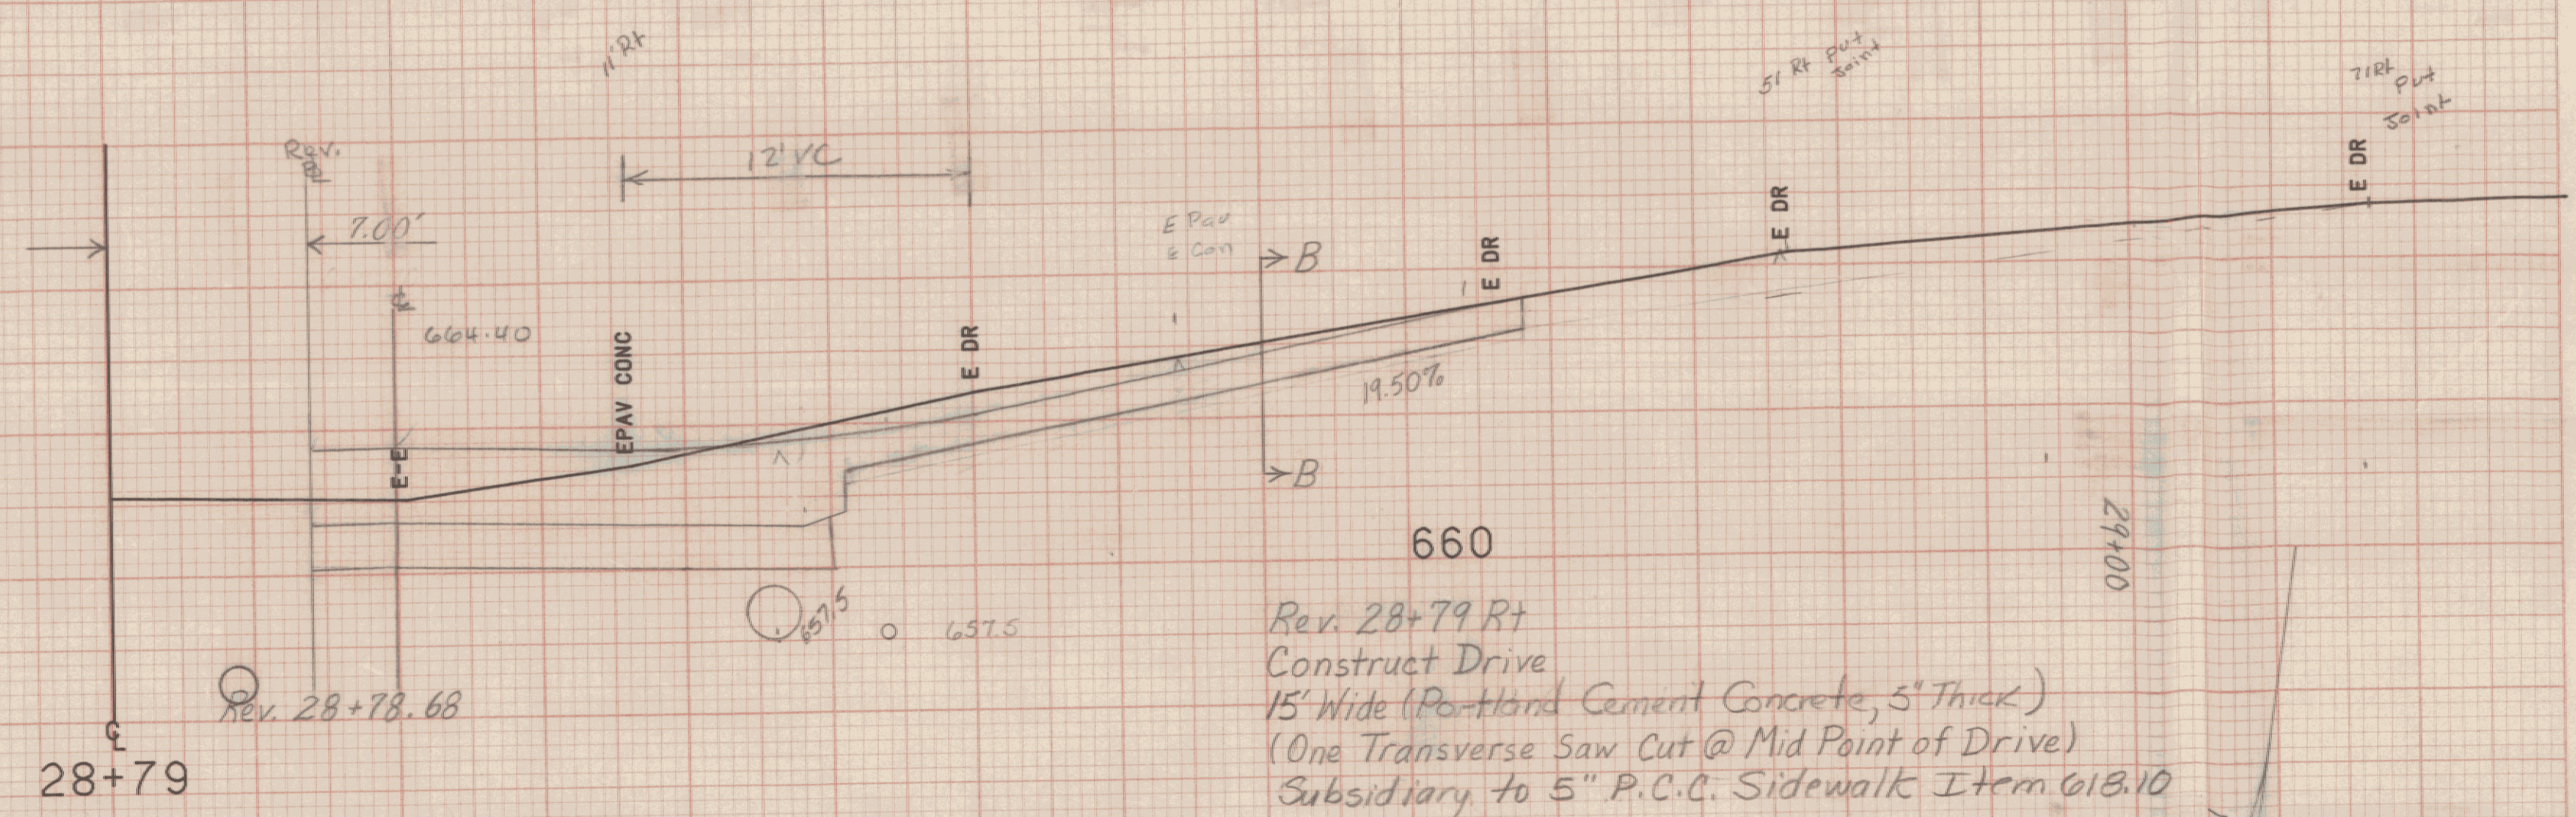

28+79


28+67

28+50

660
Rev. 28+79 Rt
Construct Drive
15' Wide (Portland Cement Concrete, 5" Thick)
(One Transverse Saw Cut @ Mid Point of Drive)
Subsidiary to 5" P.C.C. Sidewalk Item 618.10

Rev. 28+73 Rt.
End Vertical Granite Curb

660
Rev. 28+67 Rt
Remove & Reset Yard Light
The light will be relocated outside the City's R.O.W. Limits at a location mutually agreeable with the resident engineer and the property owner. The cost of work and necessary materials shall be paid under Item 679.25 (mod), removing and resetting light pole and shall be Non-Gov't. Participating.

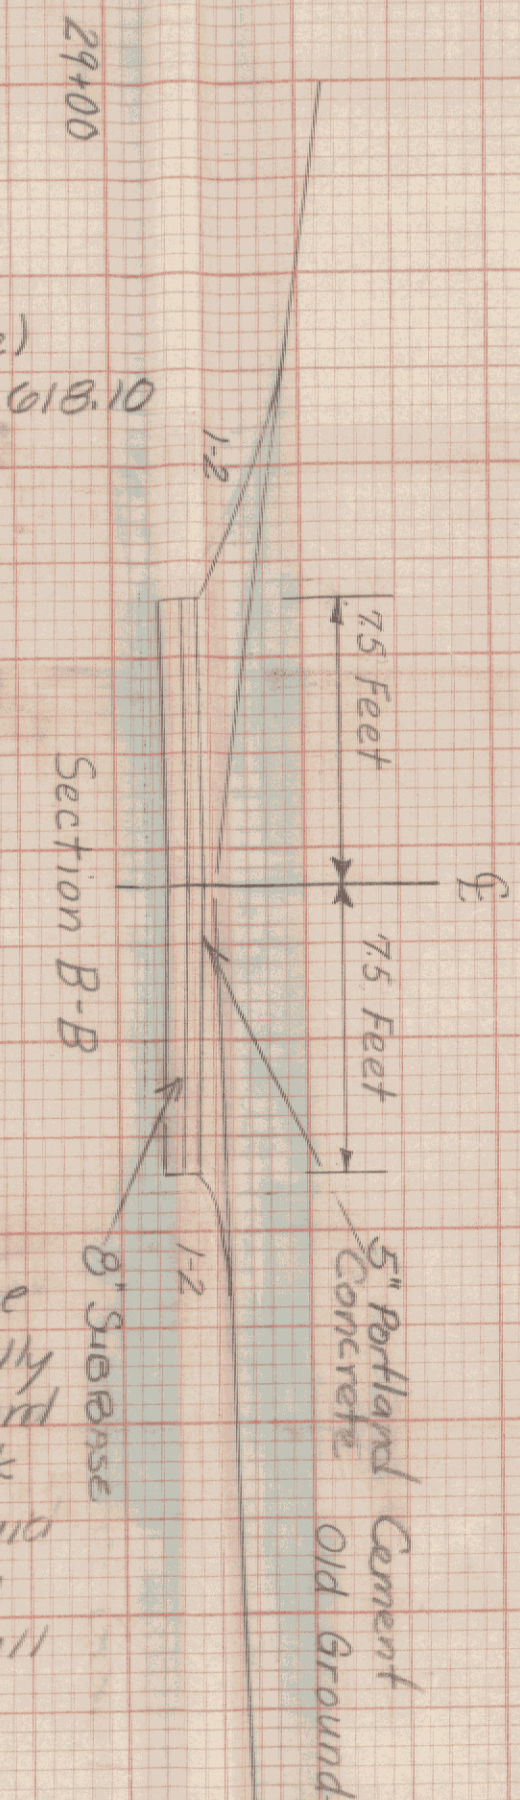

660

FROM STA. 28+50	TO STA. 28+79
PROJECT NAME	MONTPELIER
NO. MEGC-M6400 (7)	PLOTTED 05/04/87
SURVEYED BY	KASTNER-MOREAU 06/85
SHEET 182	OF 335 SHEETS