


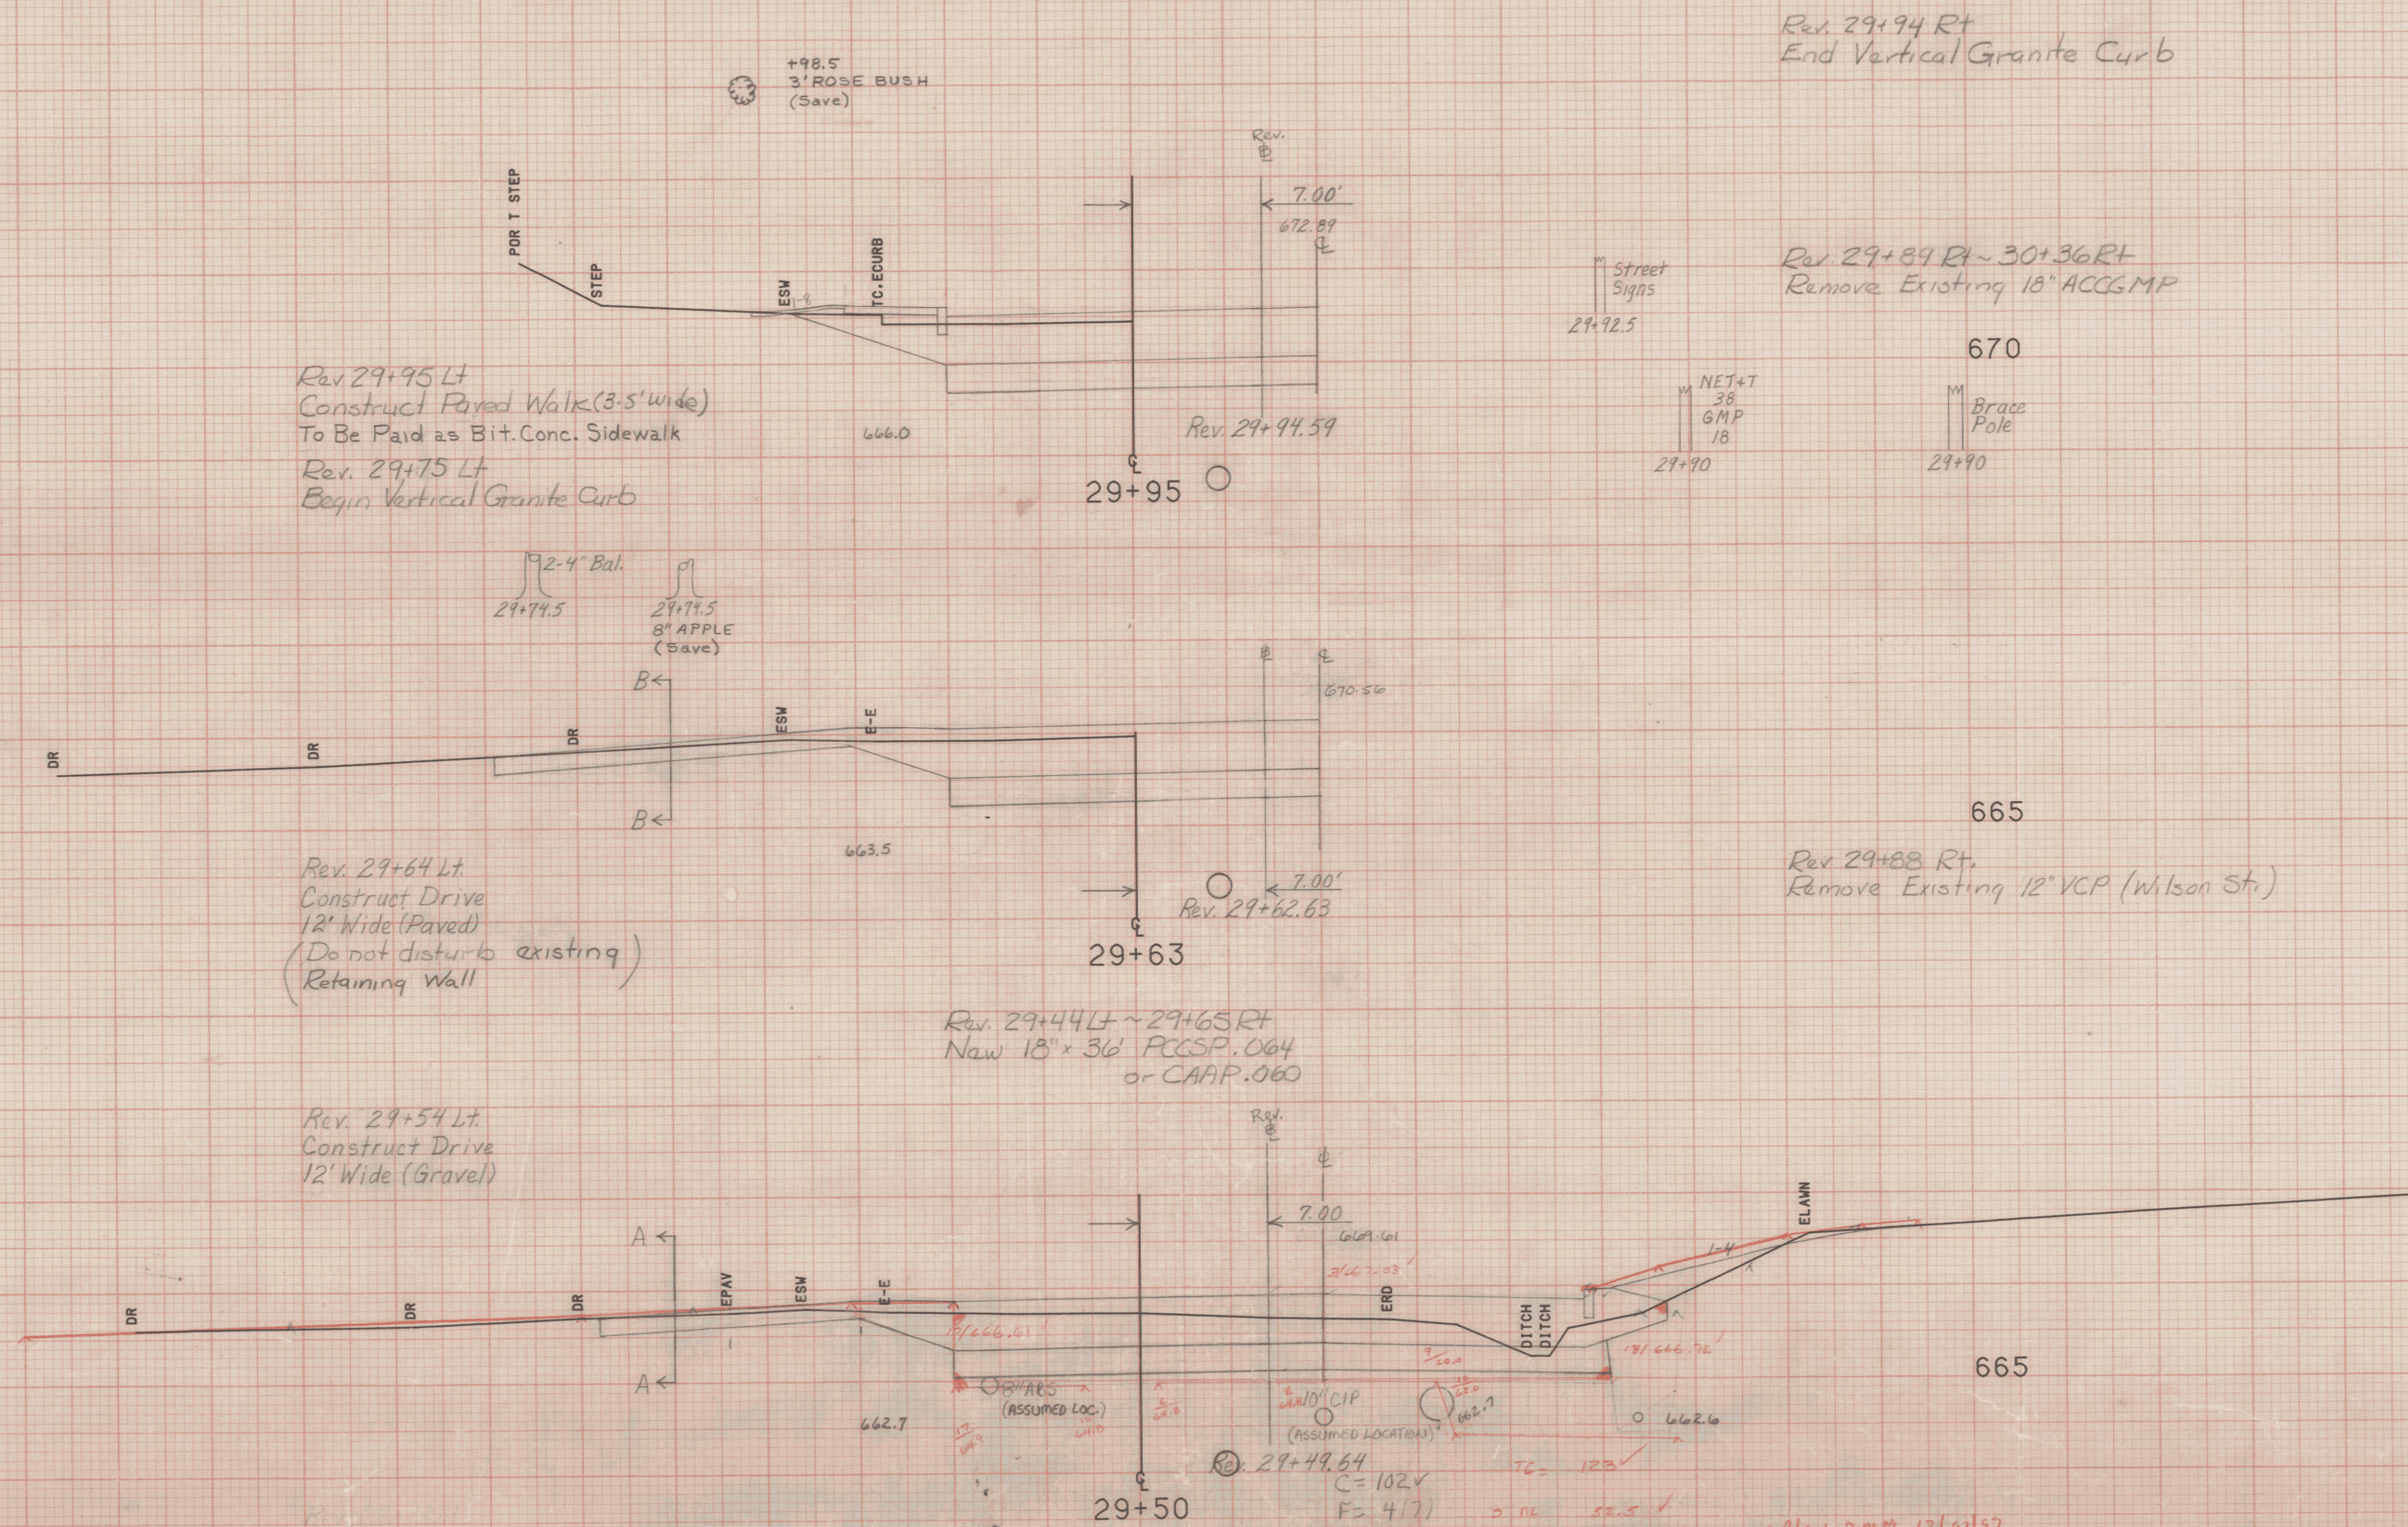

FROM STA.	29+50	TO STA.	29+95
PROJECT NAME	MONTPELIER		
NO.	ME6400(7)	PLOTTED	05/04/87
SURVEYED BY	KASTNER-MOREAU 06/85		
SHEET	184	OF	335 SHEETS

SCALE 5 FEET