


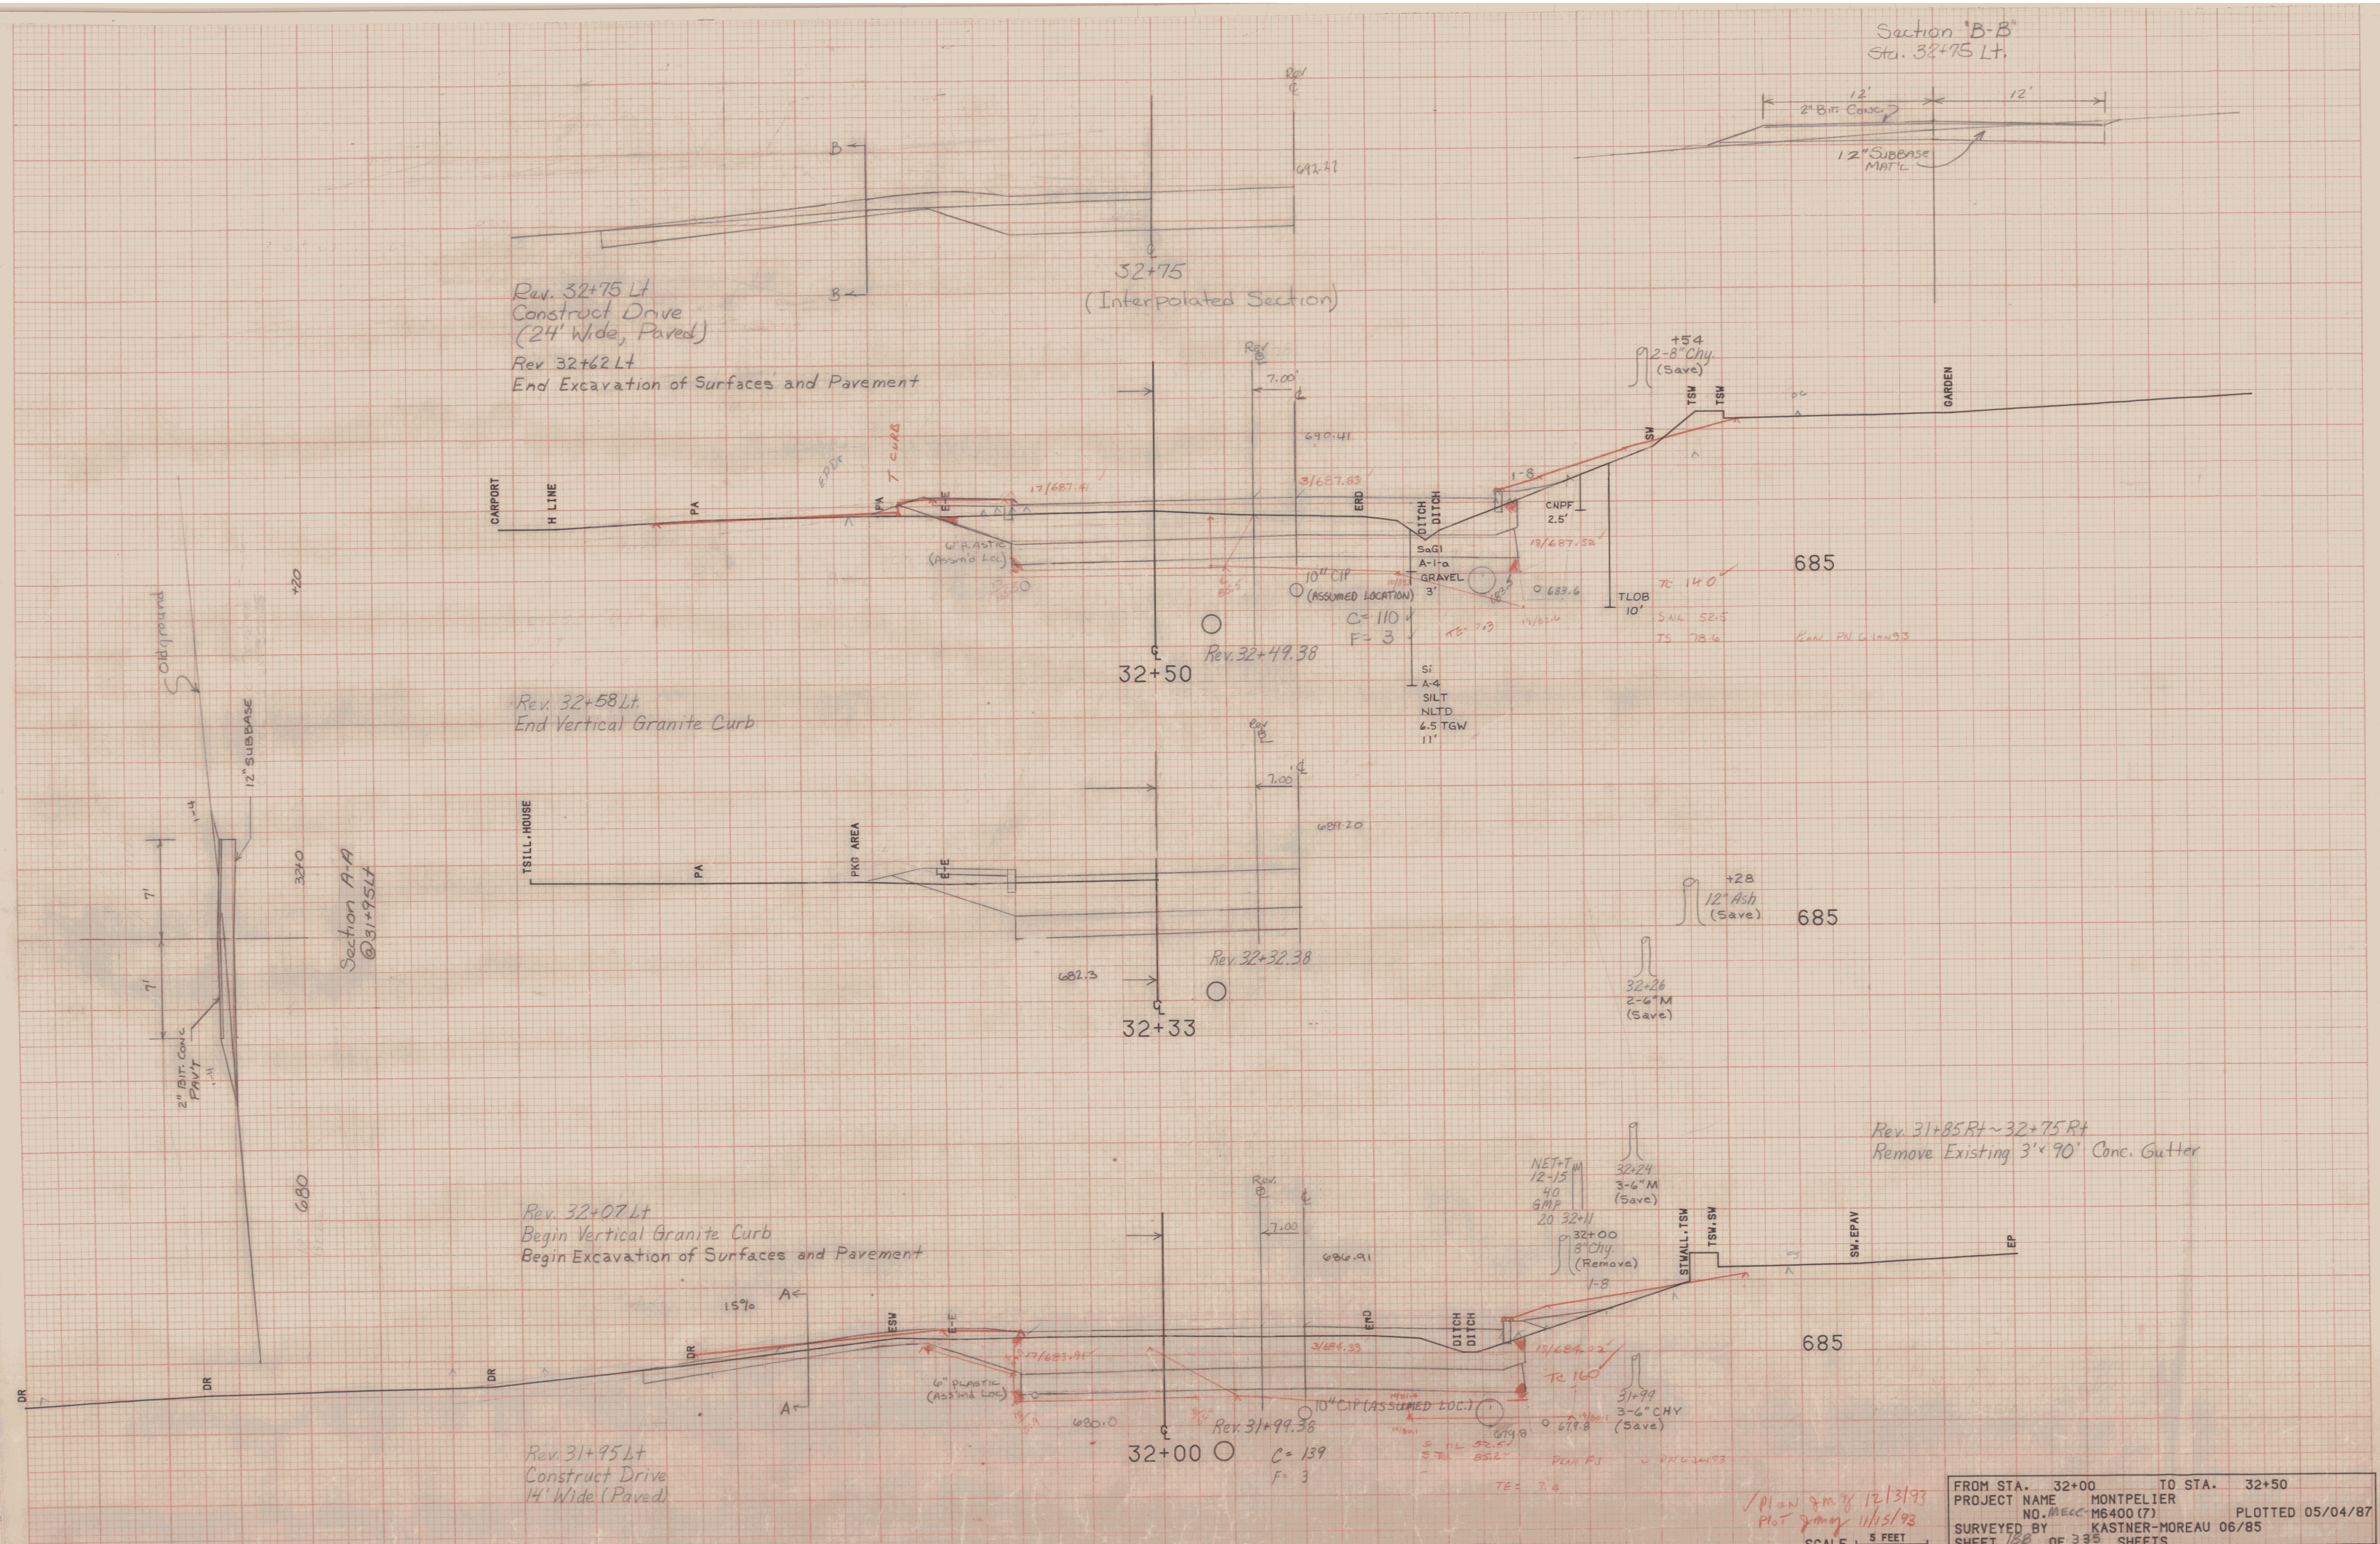

FROM STA.	32+00	TO STA.	32+50
PROJECT NAME	MONTPELIER		
NO. MECC	M6400 (7)		
SURVEYED BY	KASTNER-MOREAU 06/85		
SHEET	188	OF 335	SHEETS