


Rev. 36+53 Lt.
Begin Vertical Granite Curb.

+52
5' LILAC
(Save)

+42
2' BUSH
(Save)

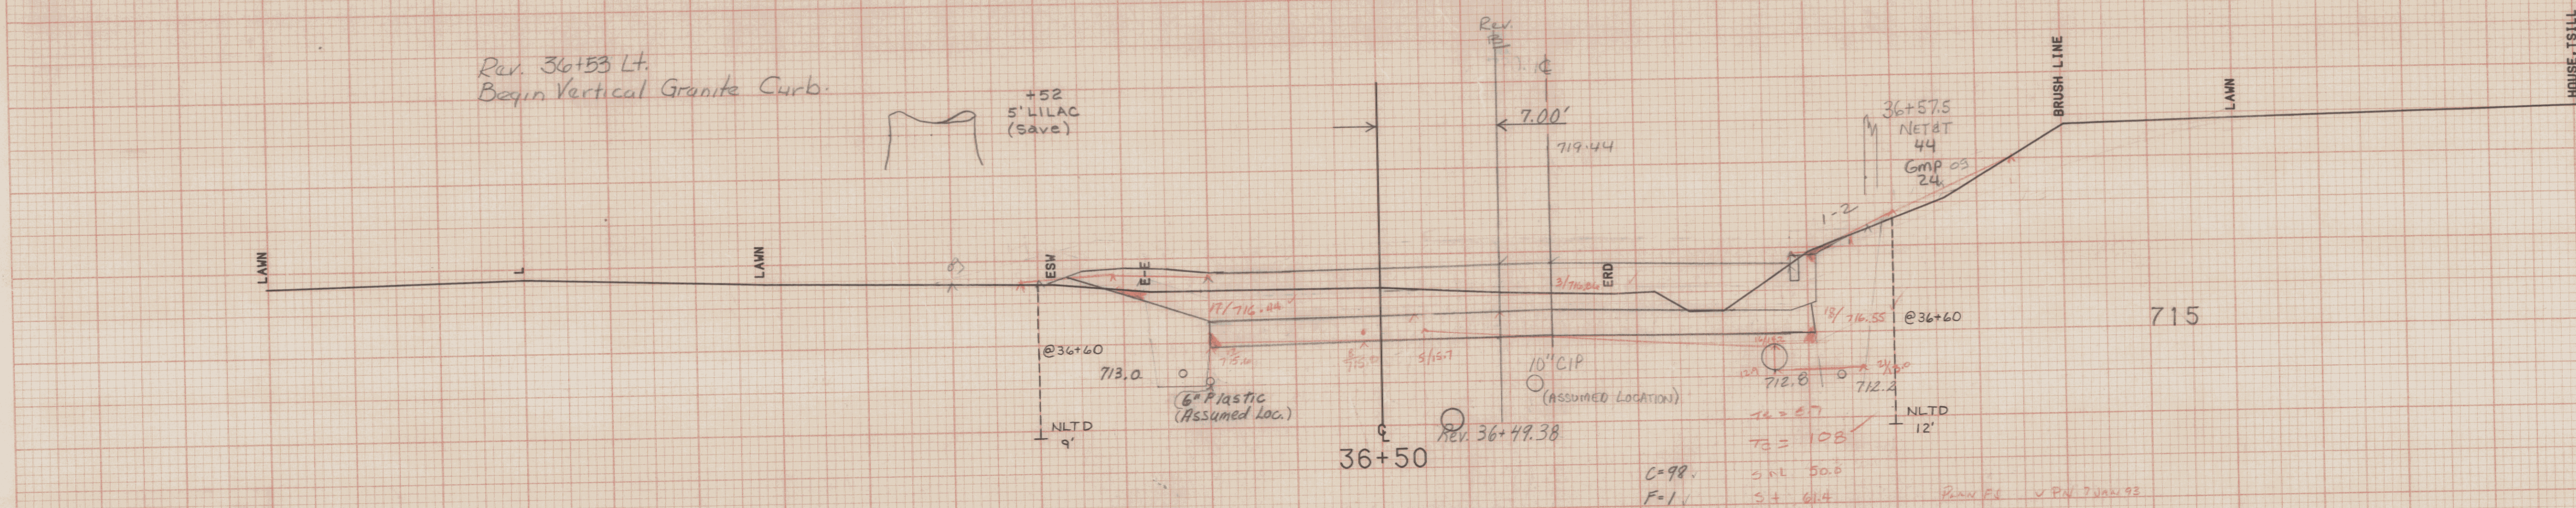

Rev. 36+40 Lt.
Construct Drive
(16' wide, Paved)
36+27 Lt.
End Vertical Granite Curb


Rev. 36+20 Lt.
Begin New 6\"/>

36+20
2' CEDAR
36+17
2' CEDAR
36+12
3' CEDAR
35+03
3' CEDAR

35+99
2' CEDAR

35+99
2' CEDAR

Rev. 35+71 Lt.
Begin Vertical Granite Curb.

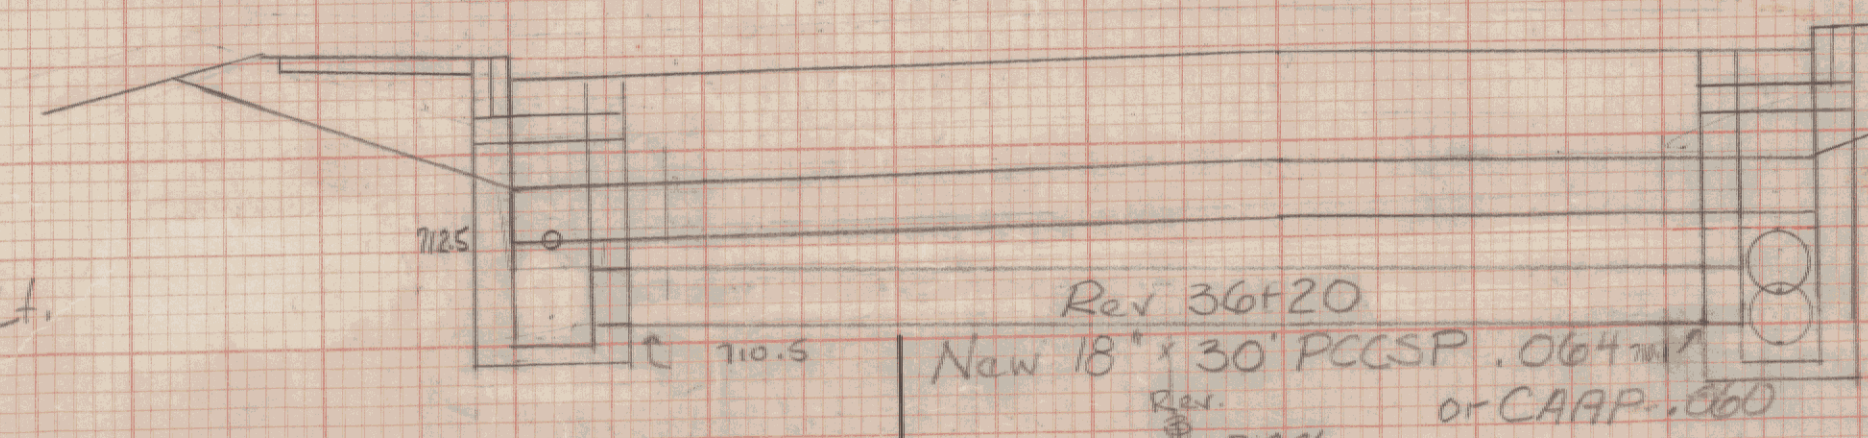

Rev. 36+20 Rt.
Begin New 18\"/>

36+21.5
24\"/>

Rev.
36+00
18\"/>

Rev. 35+63 Rt.
Begin Vertical Granite Curb

SCALE 1\"/>

FROM STA.	36+00	TO STA.	36+50
PROJECT NAME	MONTPELIER		
NO.	M6400 (7)		
SURVEYED BY	KASTNER-MOREAU 06/85		
SHEET	184	OF 335	SHEETS