


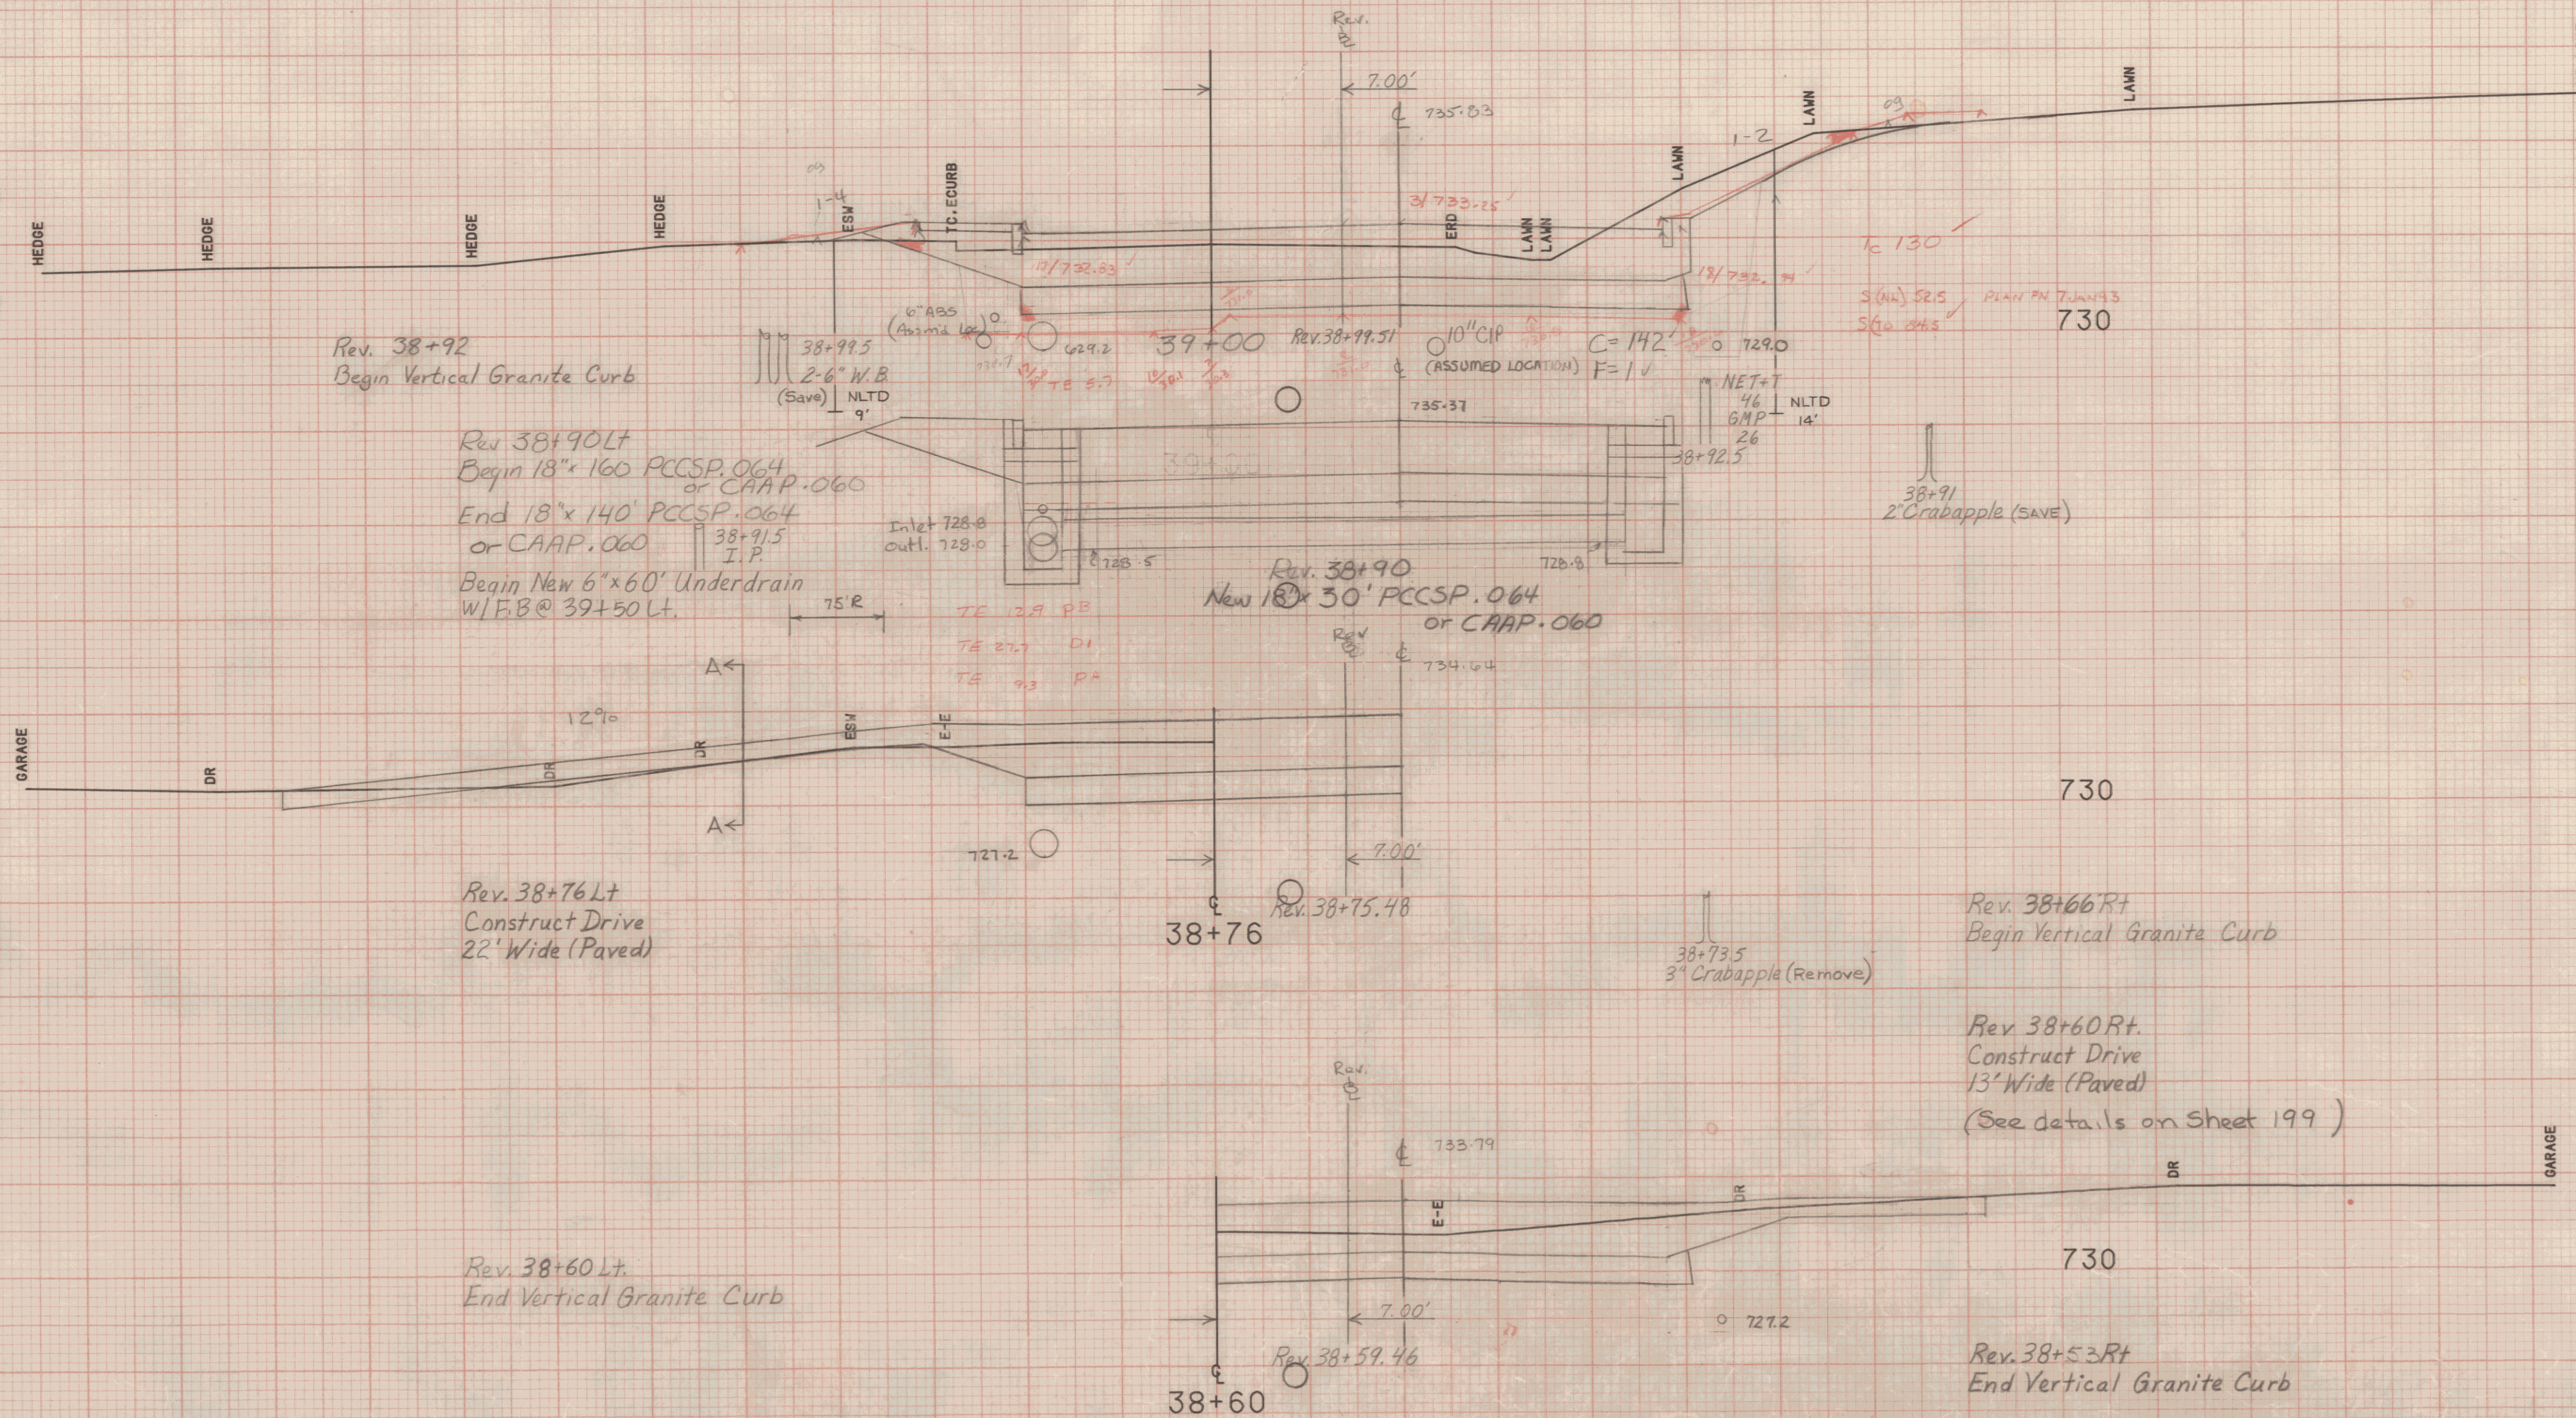

Finals Plot FJ
Plot FJ
✓ Plow g May 12/06/93

FROM STA.	38+60	TO STA.	39+00
PROJECT NAME	MONTPELIER		
NO.	ME6C-M6400 (7)	PLOTTED	05/04/87
SURVEYED BY	KASTNER-MOREAU		06/85
SHEET	128	OF	335 SHEETS