

Rev. 40+20 LT
End Excavation of Surfaces & Pavements



Rev. 40+13 LT
Construct Paved Walk (5' Wide)
To Be Paid as Bit. Conc. Sidewalk

40+30 Rt. Deciduous Tree
1 1/2" Crab Apple
Tree to be planted outside
of R.O.W. in a location of
mutual agreement with the
property owner and the
resident engineer

40+29 Rt.
8" Crabapple (Remove)

40+14 Rt.
1" Chy. (Remove)

40+14 Rt. Transplant
1" Chy. (See note
for tree @ 40+30 Rt)

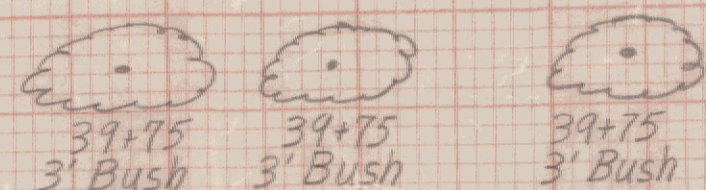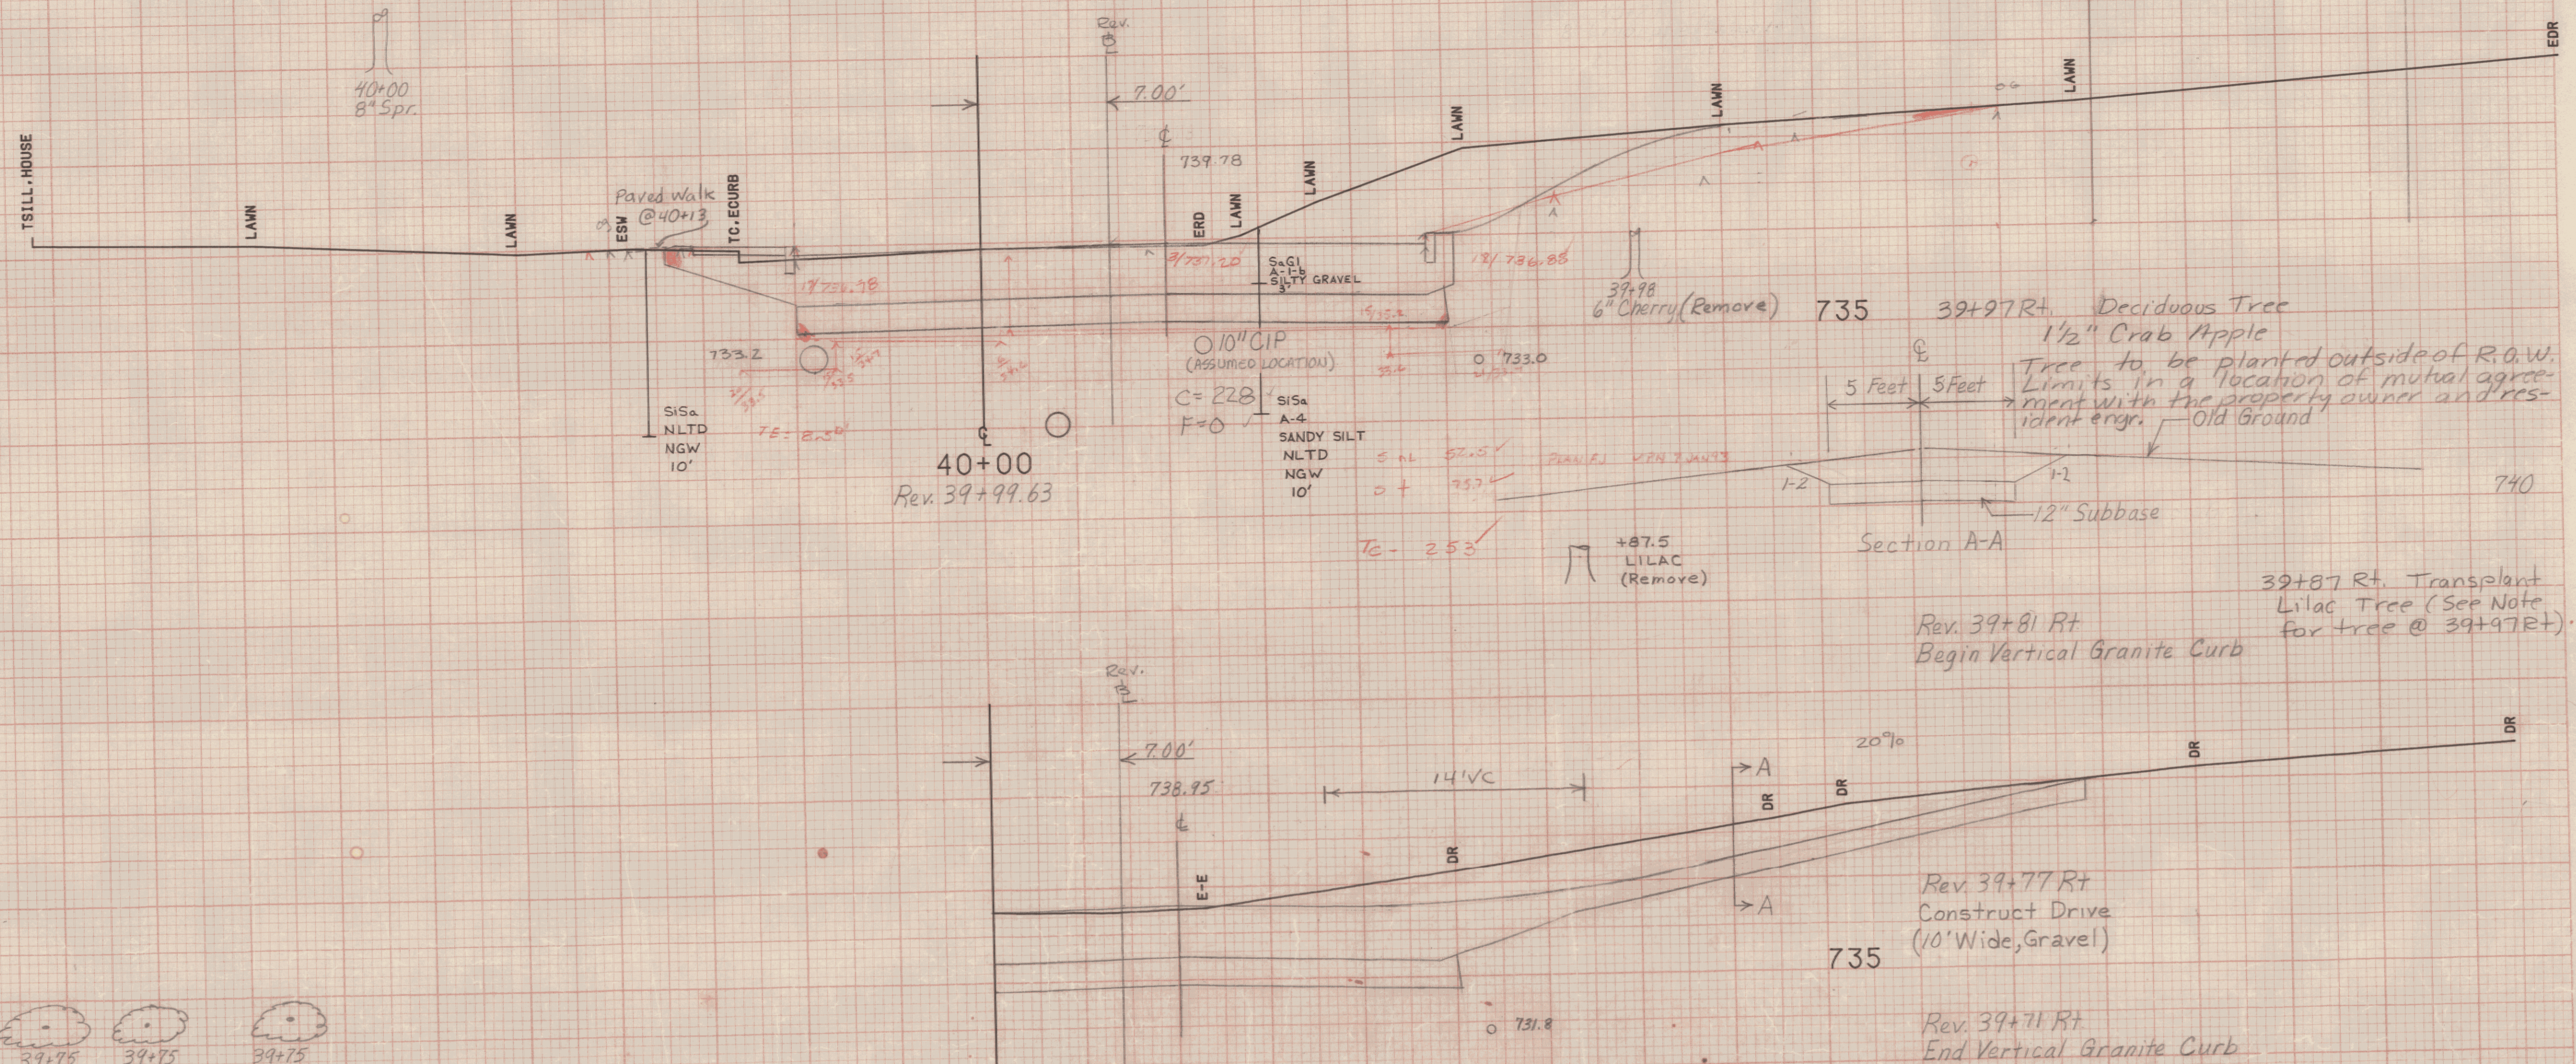

Rev. 39+79 LT
Begin Vertical Granite Curb

39+77
Rev. 39+76.60

Rev. 39+81 Rt
Begin Vertical Granite Curb

39+87 Rt. Transplant
Lilac Tree (See Note
for tree @ 39+97 Rt)

Rev. 39+77 Rt
Construct Drive
(10' Wide, Gravel)

Rev. 39+71 Rt
End Vertical Granite Curb

FROM STA. 39+77	TO STA. 40+00
PROJECT NAME MONTPELIER	
NO. M66 M6400 (7)	PLOTTED 05/04/87
SURVEYED BY KASTNER-MOREAU 06/85	
SHEET 201	OF 335 SHEETS

SCALE 5 FEET