


Rev. 41+57.4
Construct Wheelock St.
Approach

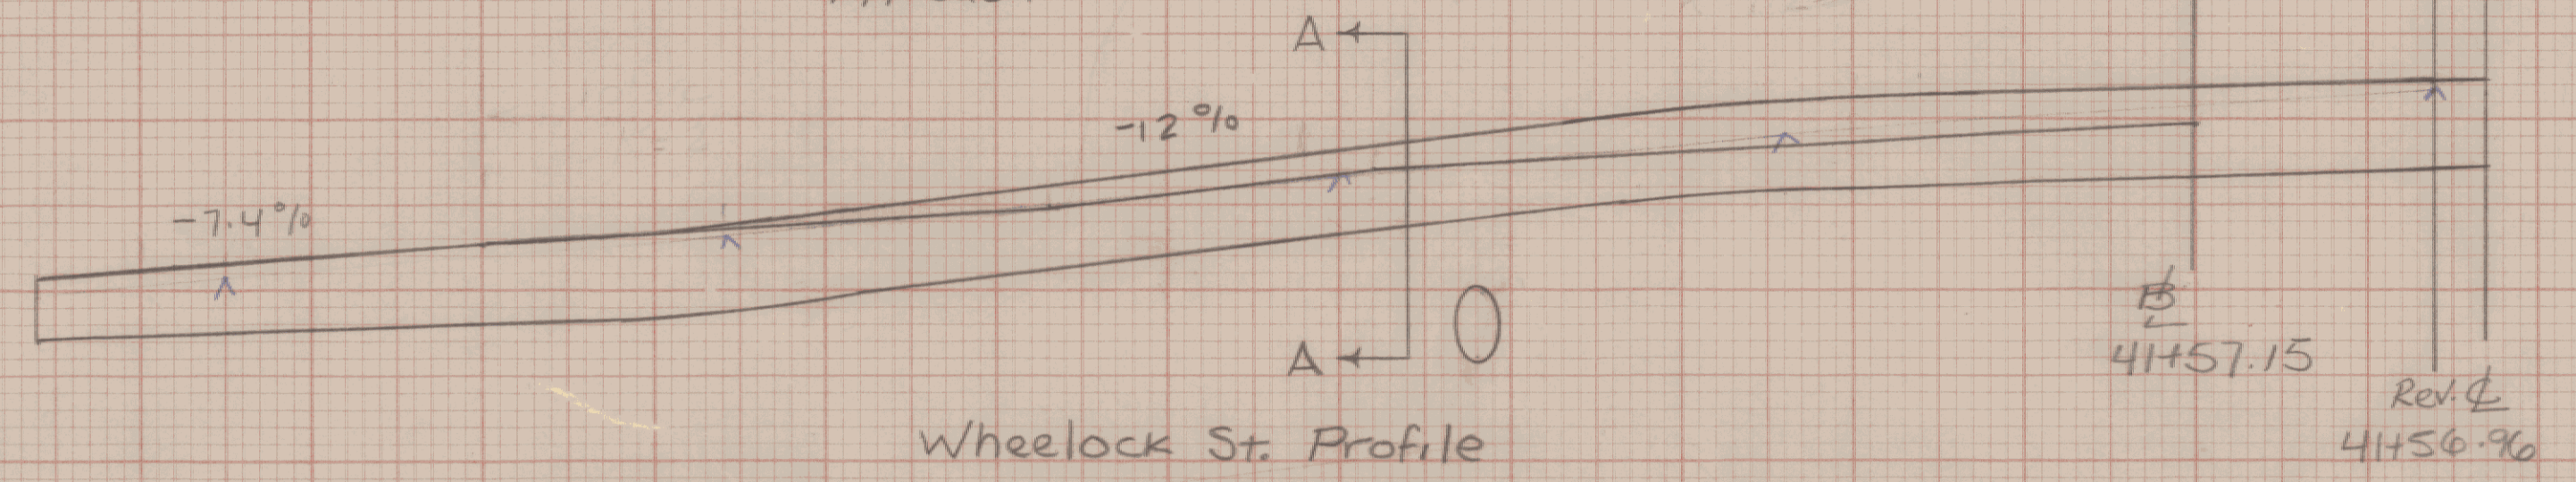

Rev. 41+67 RT
End Vertical/Granite Curb

6" App.
41+61

Iron
Pipe
41+48.5

Rev. 41+39.4
Begin Vertical/Granite Curb

Rev. PT
41+43.25
Dc=1'00' Lt
N.C.

Rev. 41+03-41+15
Vertical Granite Curb

Centerline Transition Detail
Scale: 1"=10'

Section A-A
WHEELLOCK ST.

FROM STA. 41+00 TO STA. 41+50
PROJECT NAME MONTPELIER
NO. ME66-M6400 (7) PLOTTED 05/04/87
SURVEYED BY KASTNER-MOREAU 06/85
SHEET 204 OF 335 SHEETS

SCALE 5 FEET