



Rev. 44+10 Lt
 Remove Existing 2'x2' DI
 & 12"x32' CMP

+39
 12' Spr
 (Save)
 44+21
 LILAC
 (Save)
 I.P.
 44+16.5

44+19.5
 NET
 51
 GMP
 31

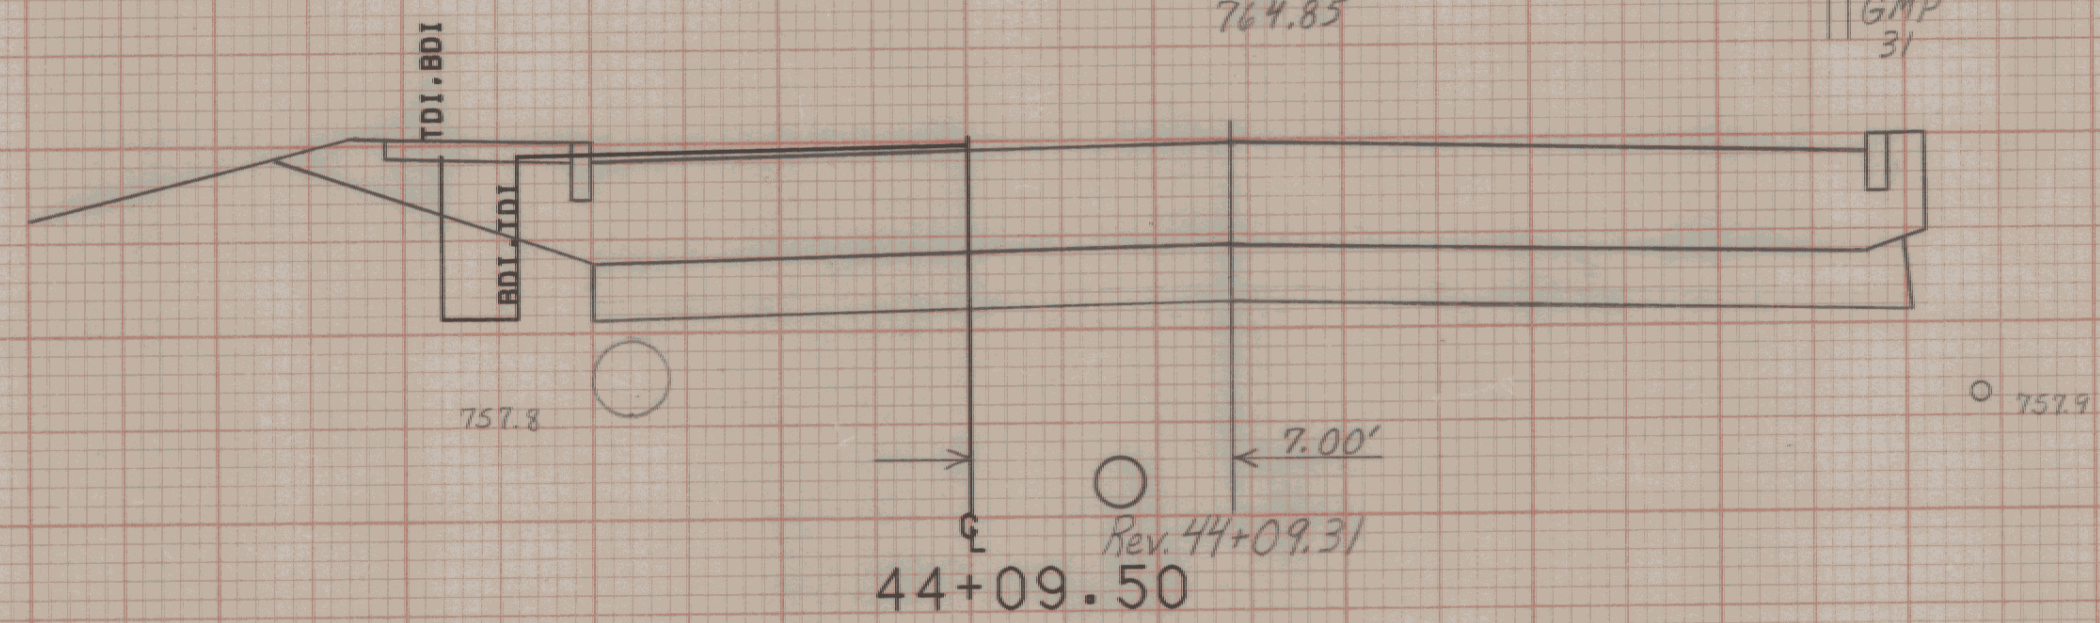


760

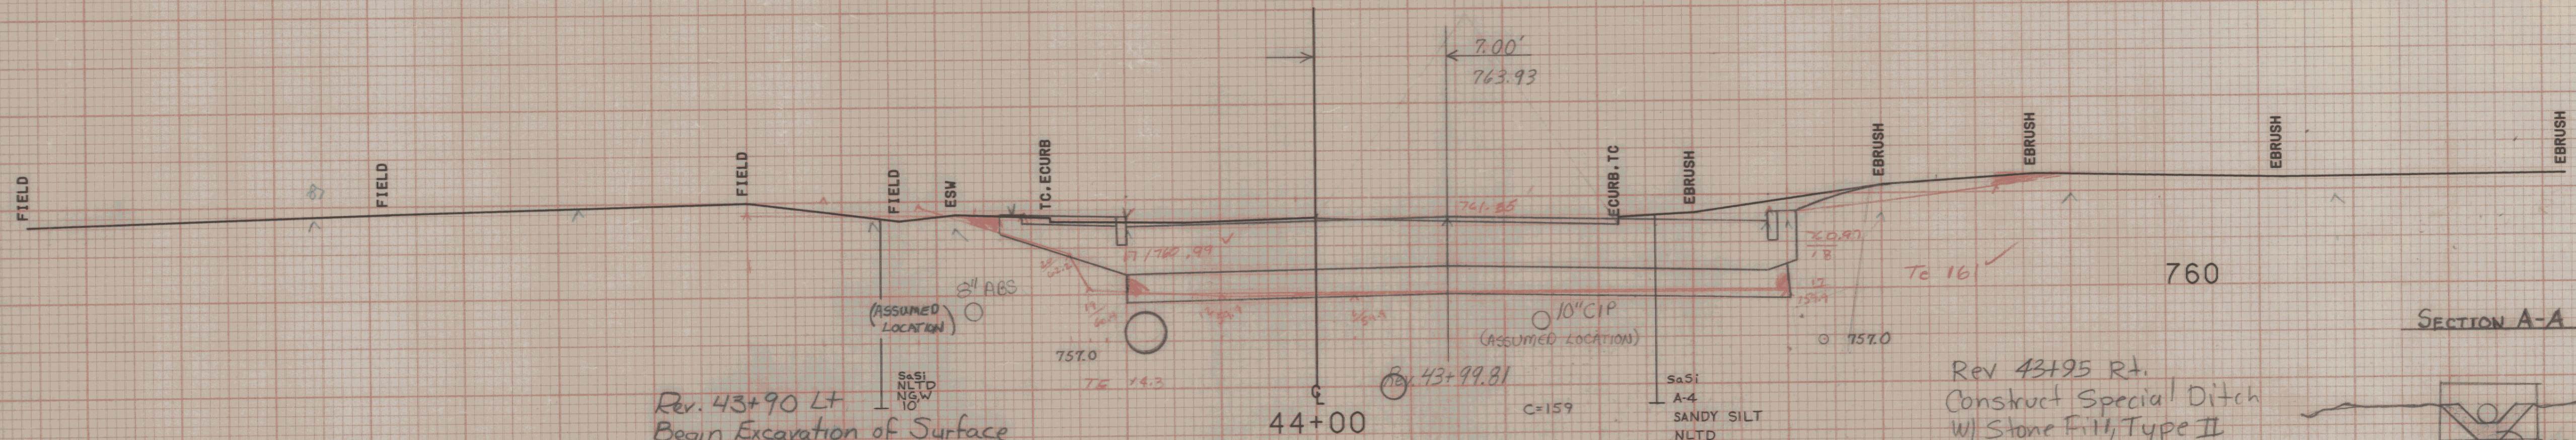


Rev. 43+90 Lt
 Begin Excavation of Surface
 & Pavements

Rev 43+95 Rt.
 Construct Special Ditch
 w/ Stone Fill, Type II

SECTION A-A

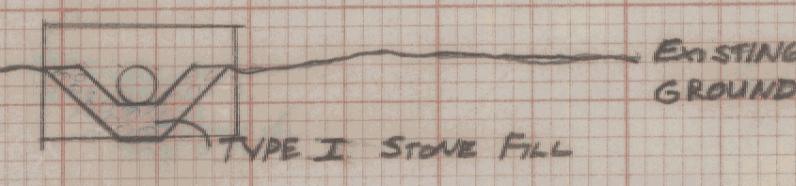

Rev 43+90 Rt ~ Rev 43+97 Rt.
 New 12"x12" CSP (.064) w/ Headwall and
 Inlet Ditch Lined w/ Stone Fill, Type I
 Rev 43+90 Rt.
 End New 18"x40" PCCSP (.064) or CAAP (.060)

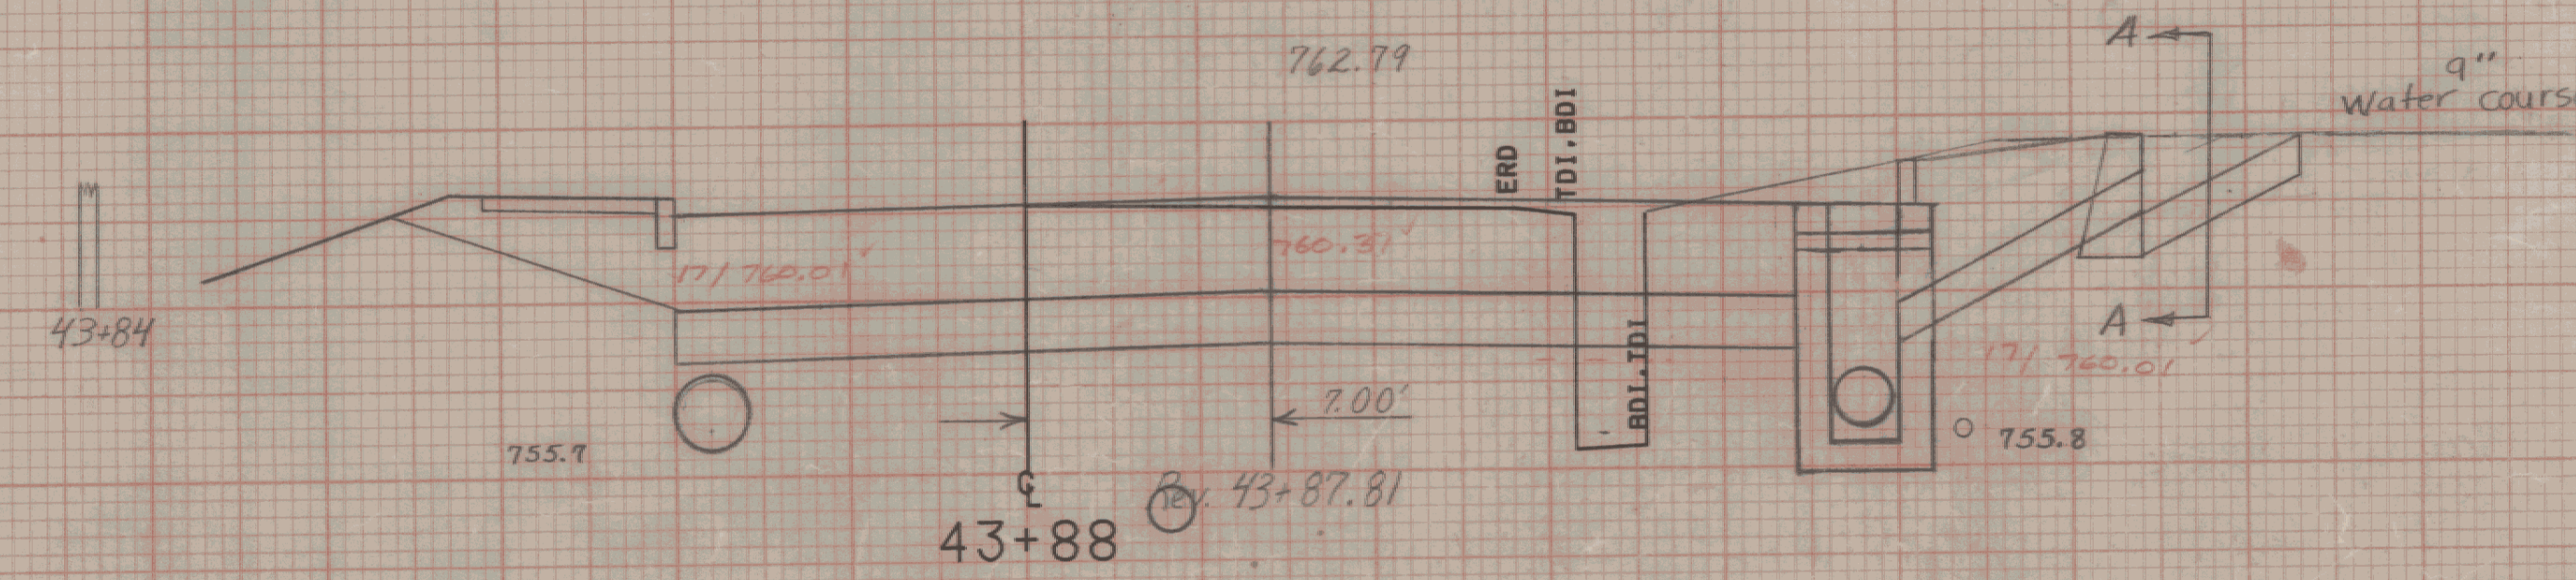

43+88

760

FROM STA.	43+88	TO STA.	44+09.50
PROJECT NAME	MONTPELIER		
NO.	M6400 (7)	PLOTTED	05/04/87
SURVEYED BY	KASTNER-MOREAU 06/85		
SHEET	201	OF	335 SHEETS

SCALE 5 FEET