




47+80 Rt ~ 50+95 Rt
 Remove Existing 15" x 315' CMP, 2 x 2 DI
 & 12" ABS Pipe.

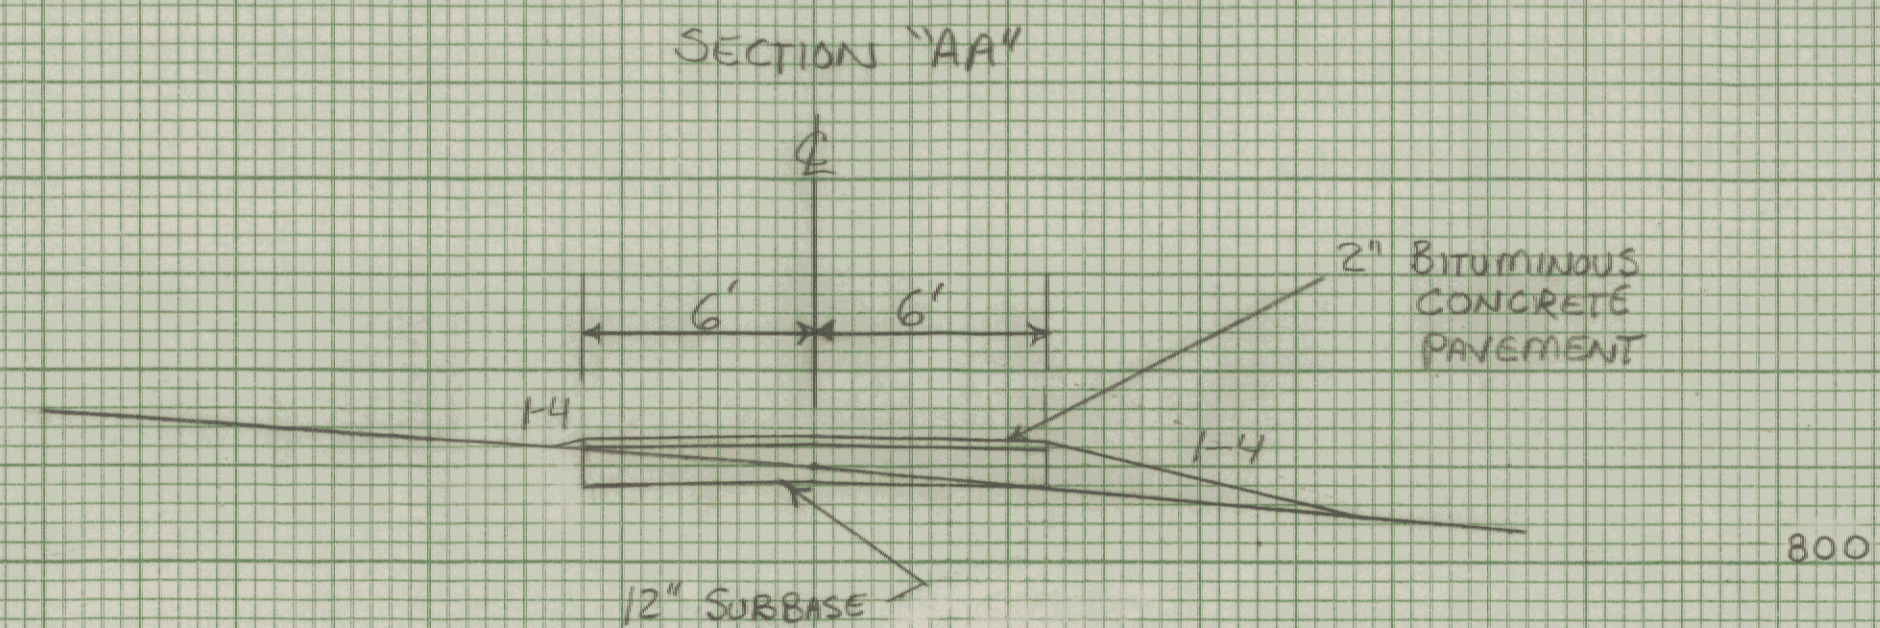